Nº 42095:-

http://www.adultpdf.com Created by TIFF To PDF trial version, to remove this mark, please register this software.

LAKE BREEZE ALLOTMENT

In Original Section number 30

AVON TOWNSHIP

LORAIN CO.


JUNE 1907

By Ralph. Hecker Surveyor.

Scale 100'=1"

EANE LAND

| Company | Com

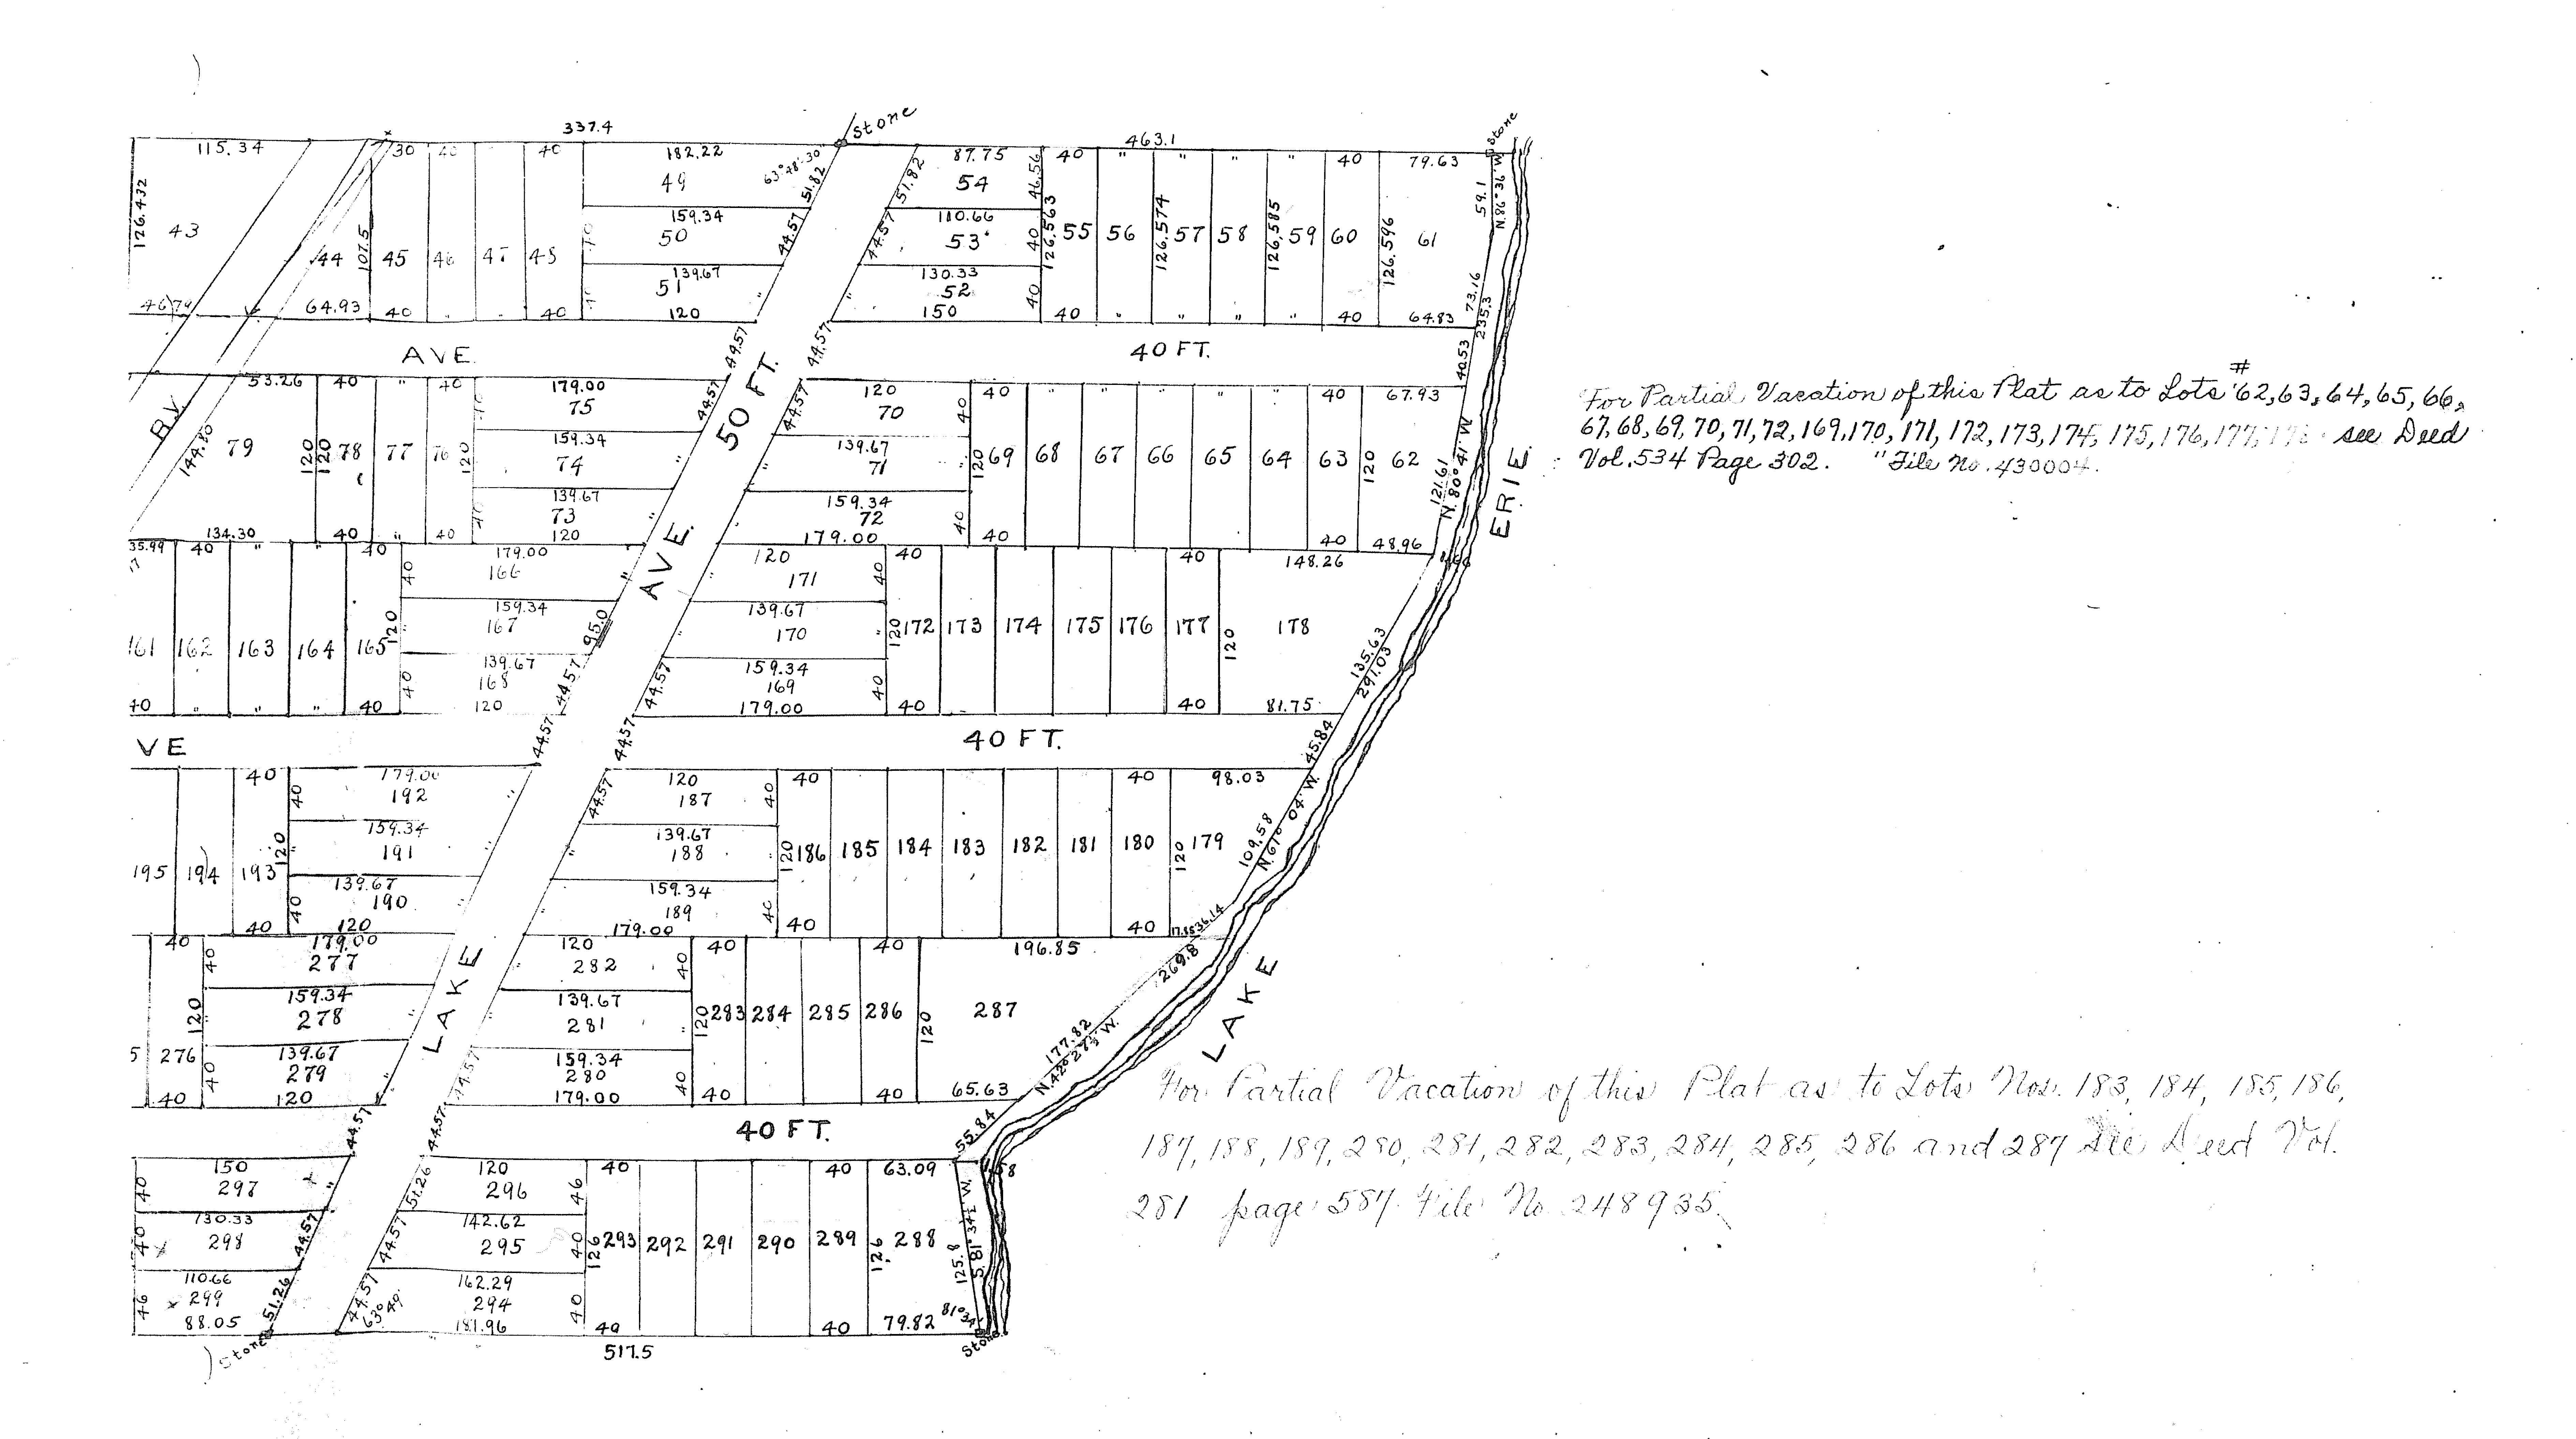

Created by TIFF To PDF trial version, to remove this mark, please register this software.