

1995
LORAIN COUNTY OHIO
OHIO NORTH ZONE(3401)
NAD_83

POINT NUMBER: LC086

LATITUDE: 41:04'08.49219" N LONGITUDE: 82:10'01.49685" W

EASTING(FT) 2060294.65 NORTHING(FT) 511087.02 ELEV(FT) 1048.99 NAVD_88


EASTING(M) 627979.066 NORTHING(M) 155779.634 ELEV(M) 319.732 NAVD_88

THETA: 0:13'07.357" COMBINATION FACTOR: 0.999888967

DESIGNATION: LC-86 1995 LORAIN CO GPS CONTROL POINT

MONUMENT TYPE: 5/8" dia aluminum rod monument with a 2 1/2" dia stamped aluminum survey cap encased in a PVC pipe with an aluminum access cover. Approx 6" below the surface of the ground.

PRINTED February 26, 1996

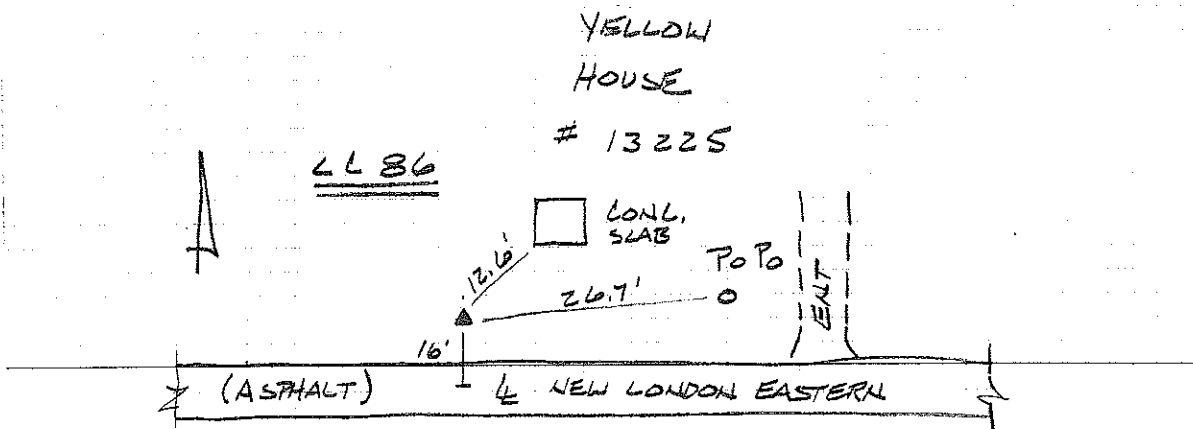

SET MONUMENT
DID NOT SET CARSONITE MARKER
AT REQUEST OF OWNER