


FED. RD. DIVISION	STATE	PROJECT
2	OHIO	

**LOCATION PLAN
LOR 57-(2.81-4.88)
LORAIN COUNTY, O.**

550905



CENTERLINE REFERENCE MONUMENTS HAVE BEEN SHOWN.

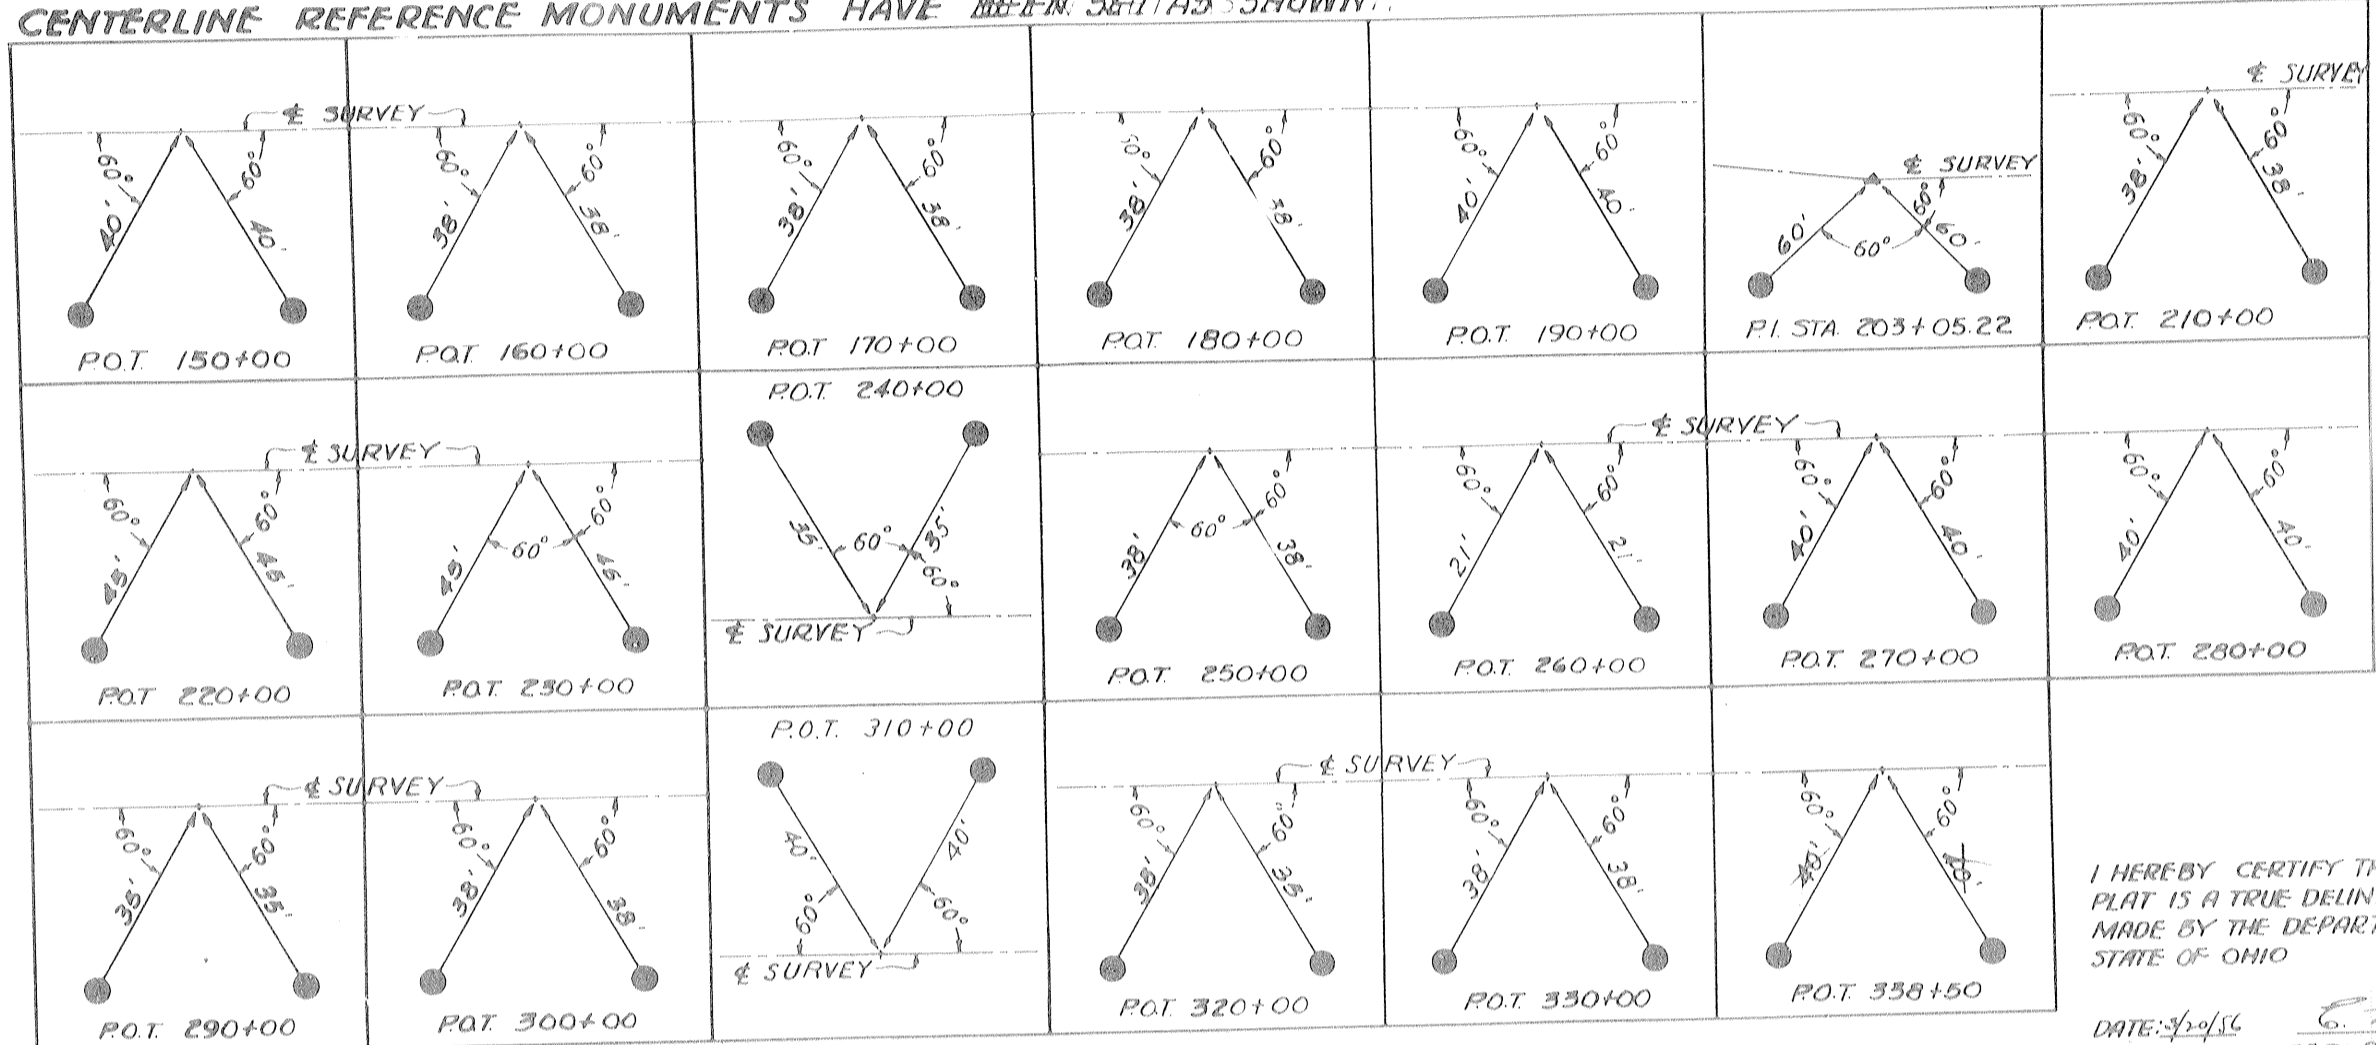

I HEREBY CERTIFY THAT THE ACCOMPANYING PLAT IS A TRUE DELINEATION OF A SURVEY MADE BY THE DEPARTMENT OF HIGHWAYS, STATE OF OHIO

DATE: 3-1-56
DIVISION ENGINEER - DIV 3 - PROF. ENG. #6311



RECEIVED FOR RECORD March 27 1956
RECORDED March 27 1956
PLAT BOOK 18 PAGE 370
FEE \$5.00 PAID NUMBER 501056
Leta B Mitchell
LORAIN COUNTY RECORDER

(Re-recorded changed monument location.)

RECEIVED Jan 30 1959 at 10:25 am
RECORDED Jan 30 1959
PLAT BOOK 21 PAGE 30
FEE \$5.00 PAID NUMBER
Leta B Mitchell
LORAIN COUNTY RECORDER

