



Donald E. Watson Edward A. Schmitt


EXHIBIT 'A' DRAWINGS FOR MILLS CREEK CONDOMINIUM  
OF  
MILLS CREEK SUBDIVISION, SECTION 'D'  
VOL. 25 OF MAPS, PAGES 41 & 42  
SCALE 1" = 30'

786222  
1936

LEGEND

- U.C.A. BOUNDARY
- PROPERTY LINE
- LIMITED COMMON AREAS
- COMMON AREAS AND PAINTERS UTILITY EASEMENT

WE, DONALD E. WATSON, REGISTERED SURVEYOR, OHIO 44220 AND EDWARD A. SCHMITT, REGISTERED ARCHITECT, OHIO 4104 HEREBY CERTIFY THAT THE WITHIN DRAWINGS FOR MILLS CREEK CONDOMINIUM (CONSISTING OF PAGES W THROUGH 77) ACCURATELY SHOW THE BUILDINGS AS CONSTRUCTED

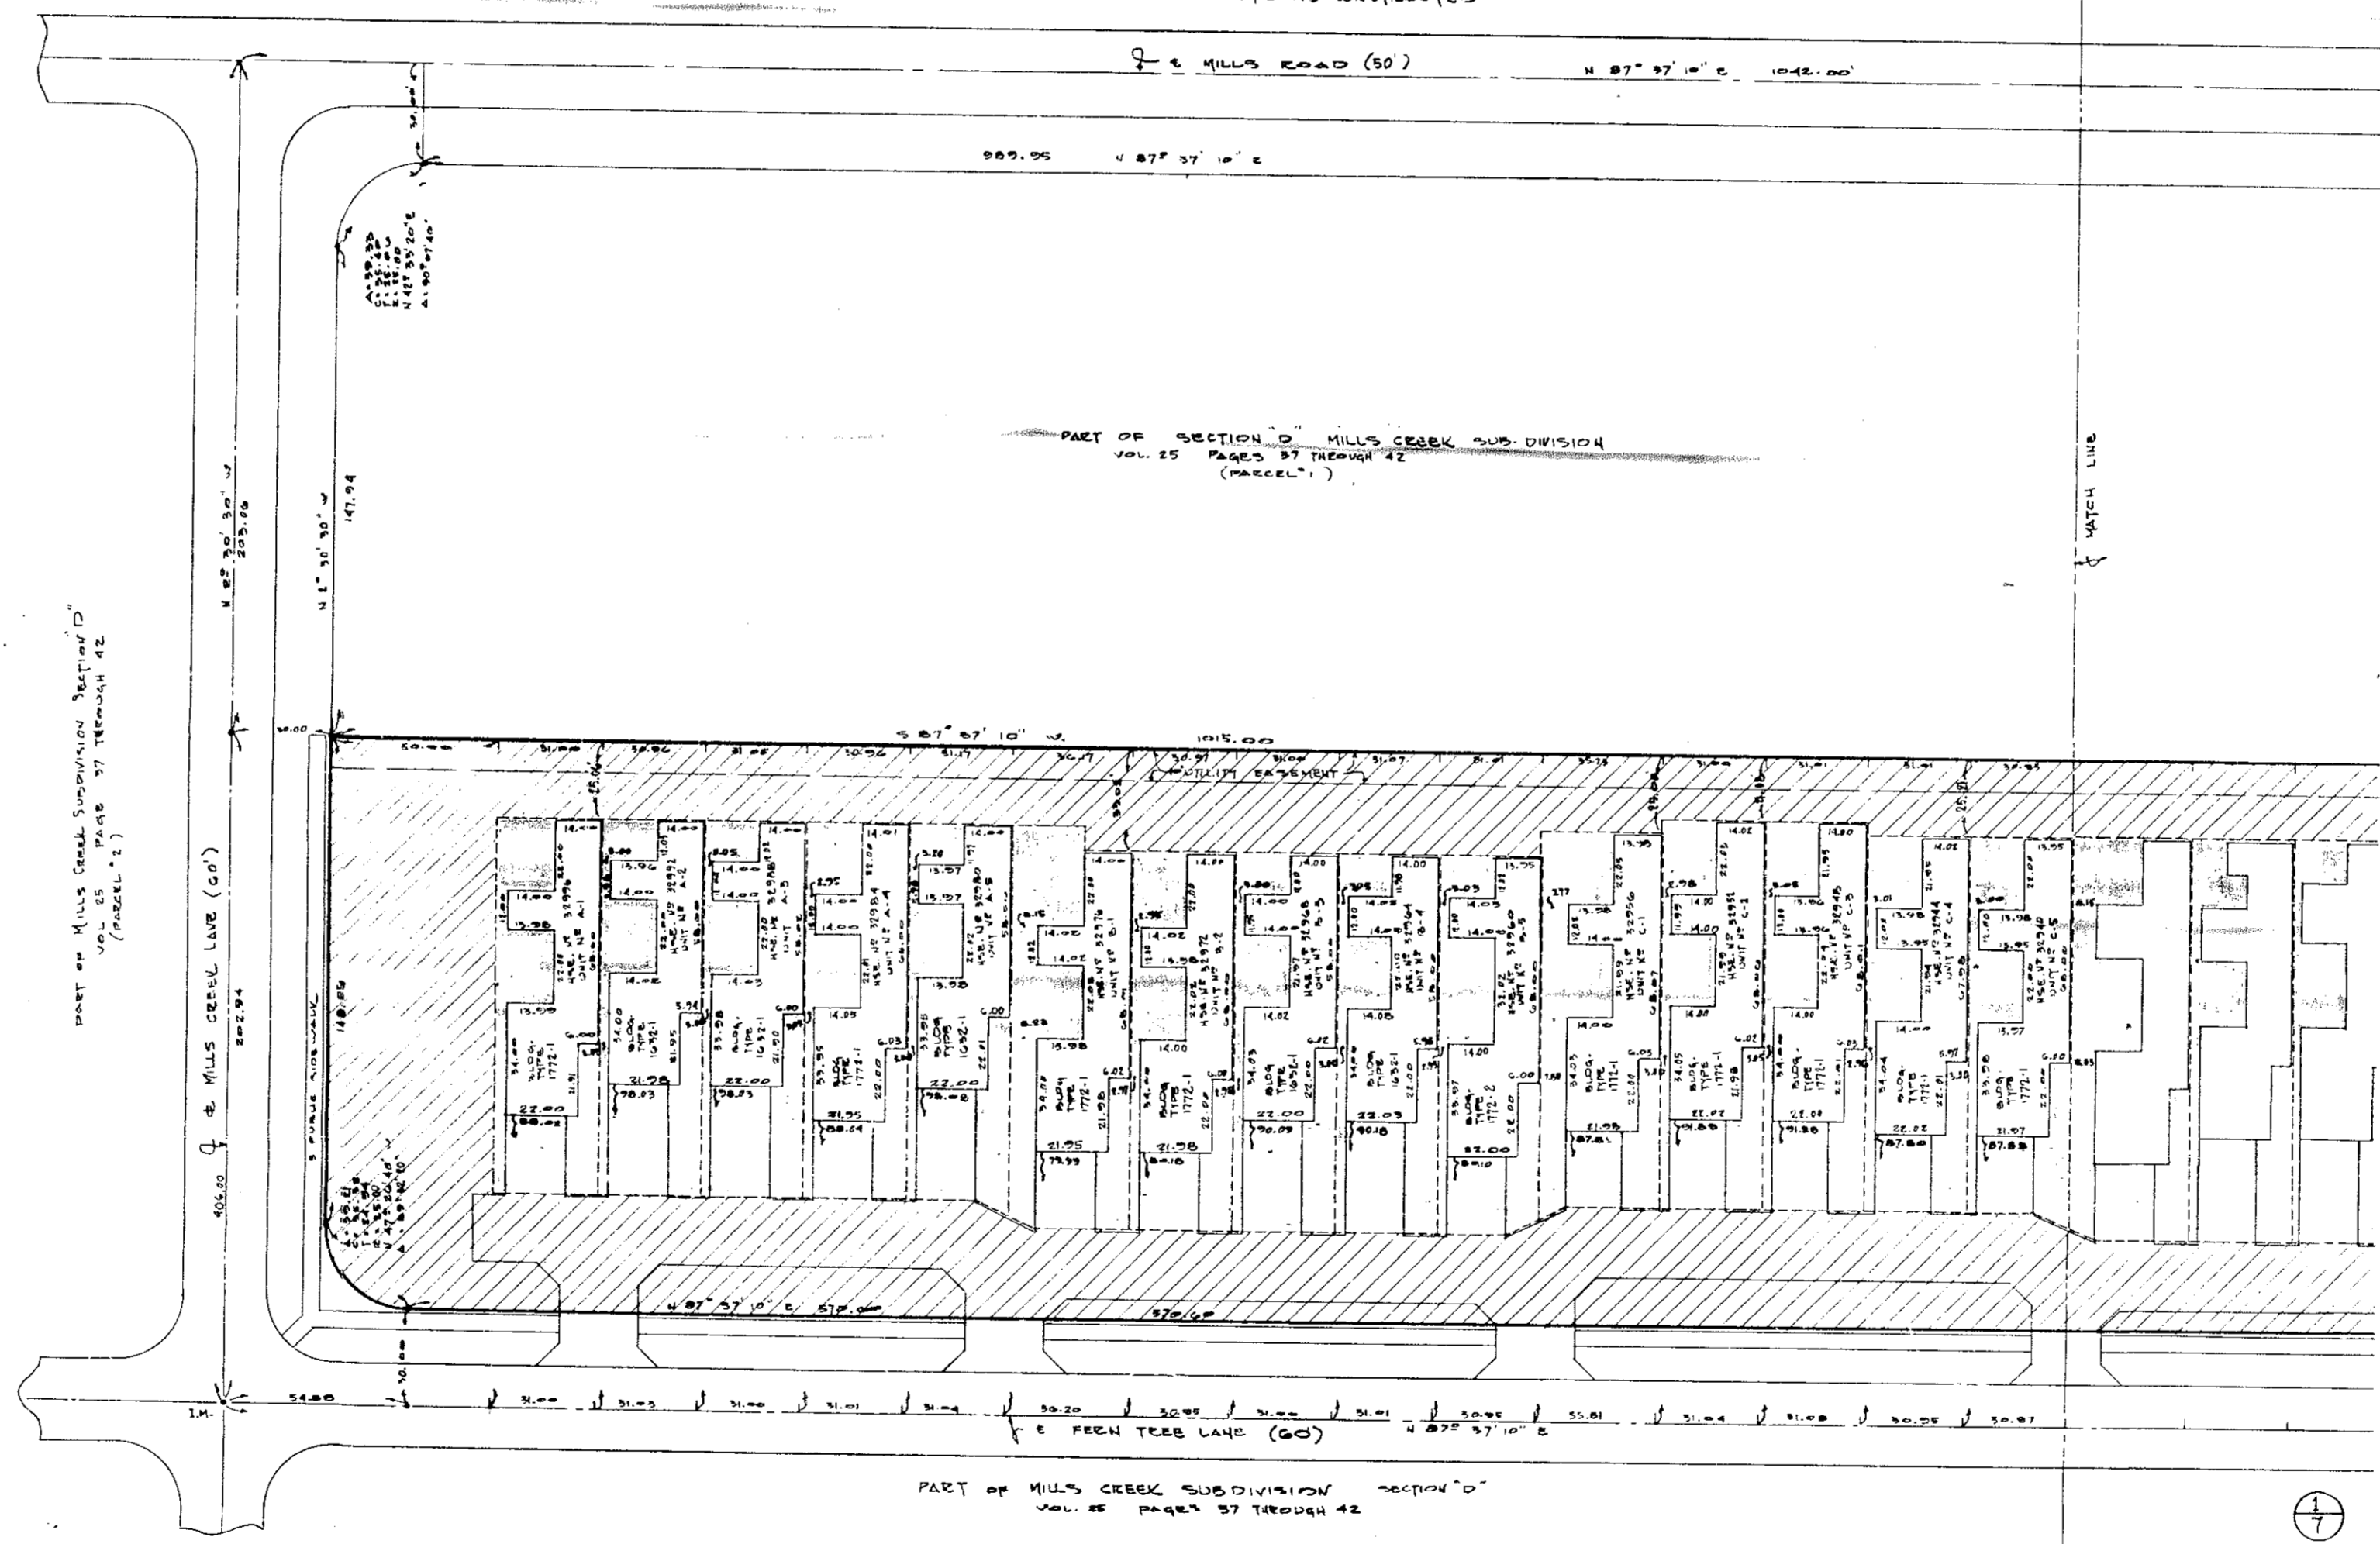

25/41

25/41