



Plot 25/88 # 165845
STATEMENT OF CERTIFICATION:
 I CERTIFY THAT THE ATTACHED DRAWINGS CORRECTLY REPRESENT THE DIMENSIONS OF THE BUILDINGS AS CONSTRUCTED AND THAT THERE ARE NO ENCROACHMENTS ON ANY ADJUTING PREMISES.

James H. Schmidt
 JAMES H. SCHMIDT
 REGISTERED SURVEYOR



STATEMENT OF CERTIFICATION:
 I CERTIFY THAT THE ATTACHED DRAWINGS CORRECTLY REPRESENT THE BUILDINGS AS CONSTRUCTED AND THAT THERE ARE NO ENCROACHMENTS ON ANY ADJUTING PREMISES.

Andre B. Buehler
 ANDRE B. BUEHLER
 REGISTERED ARCHITECT

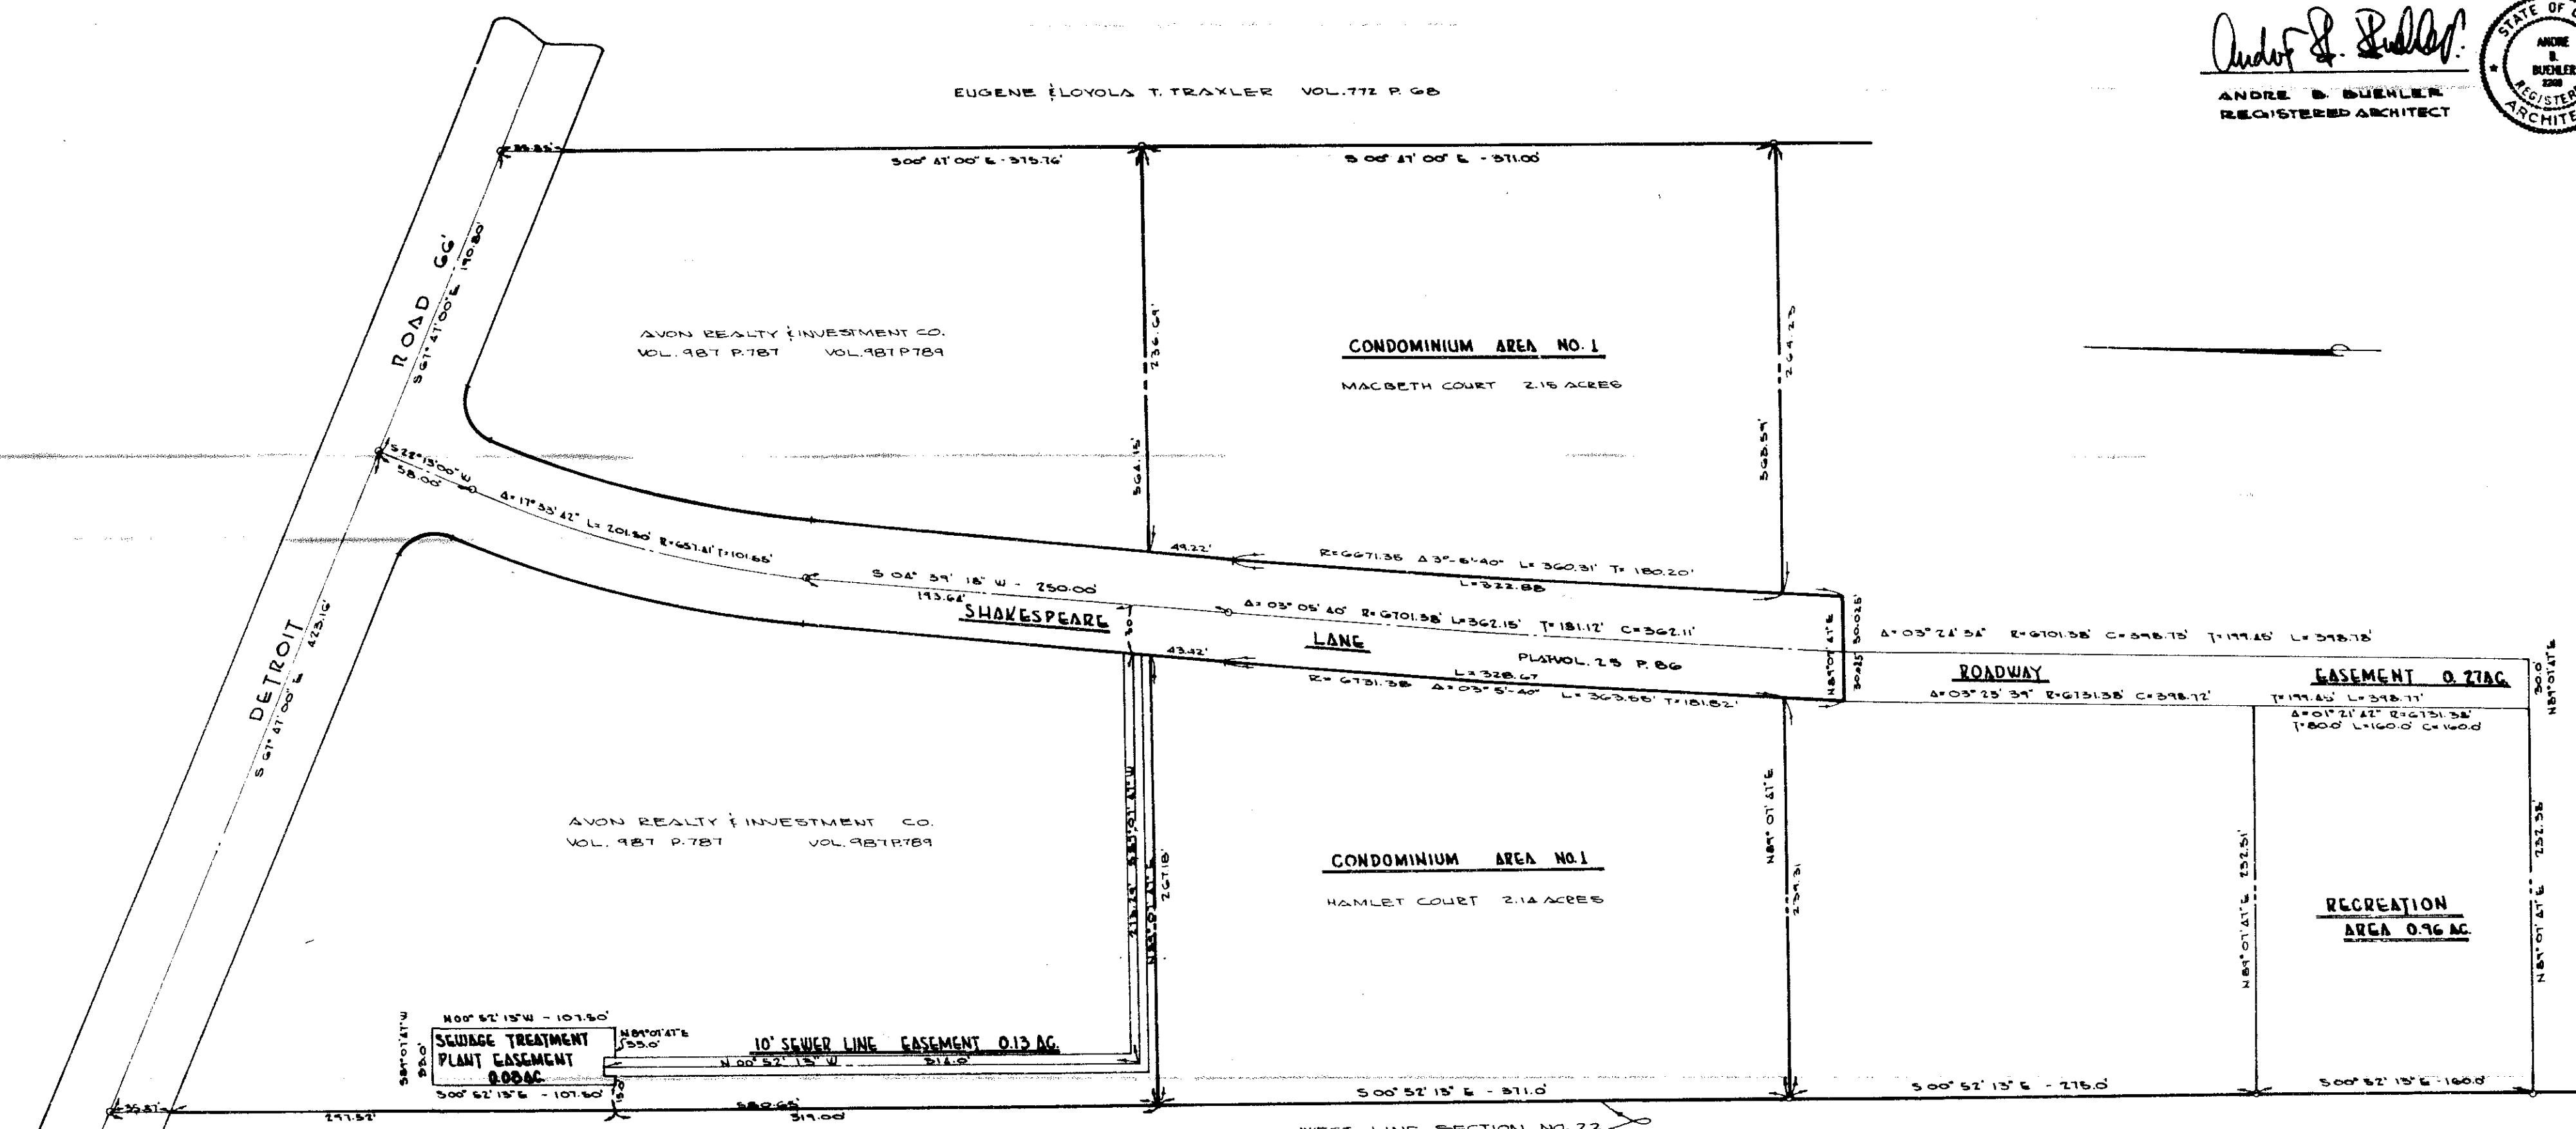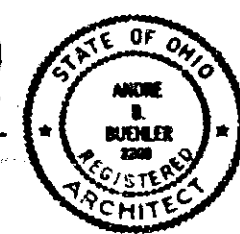

STRATFORD VILLAGE
 CONDOMINIUM DEVELOPMENT-DETROIT ROAD
 PART OF SECTION NO. 22 AVON TWP
 CITY OF AVON COUNTY OF LORAIN
 STATE OF OHIO

25/88

STRATFORD VILLAGE CONDOMINIUM NO. 1 AVON REALTY INVESTMENT CO. EXHIBIT A		BOUNDARY SURVEY	JOB NO. 6751
SCALE: 1" = 50'	DATE: JUNE 24, 1988	PREPARED BY: JAMES H. SCHMIDT	SHEET NO. 2 OF 11
DESIGN: JHS	CHECKED: JHS	REGISTERED SURVEYOR OHIO	