


25/91

Plot Vol 25 Pg 91 76568

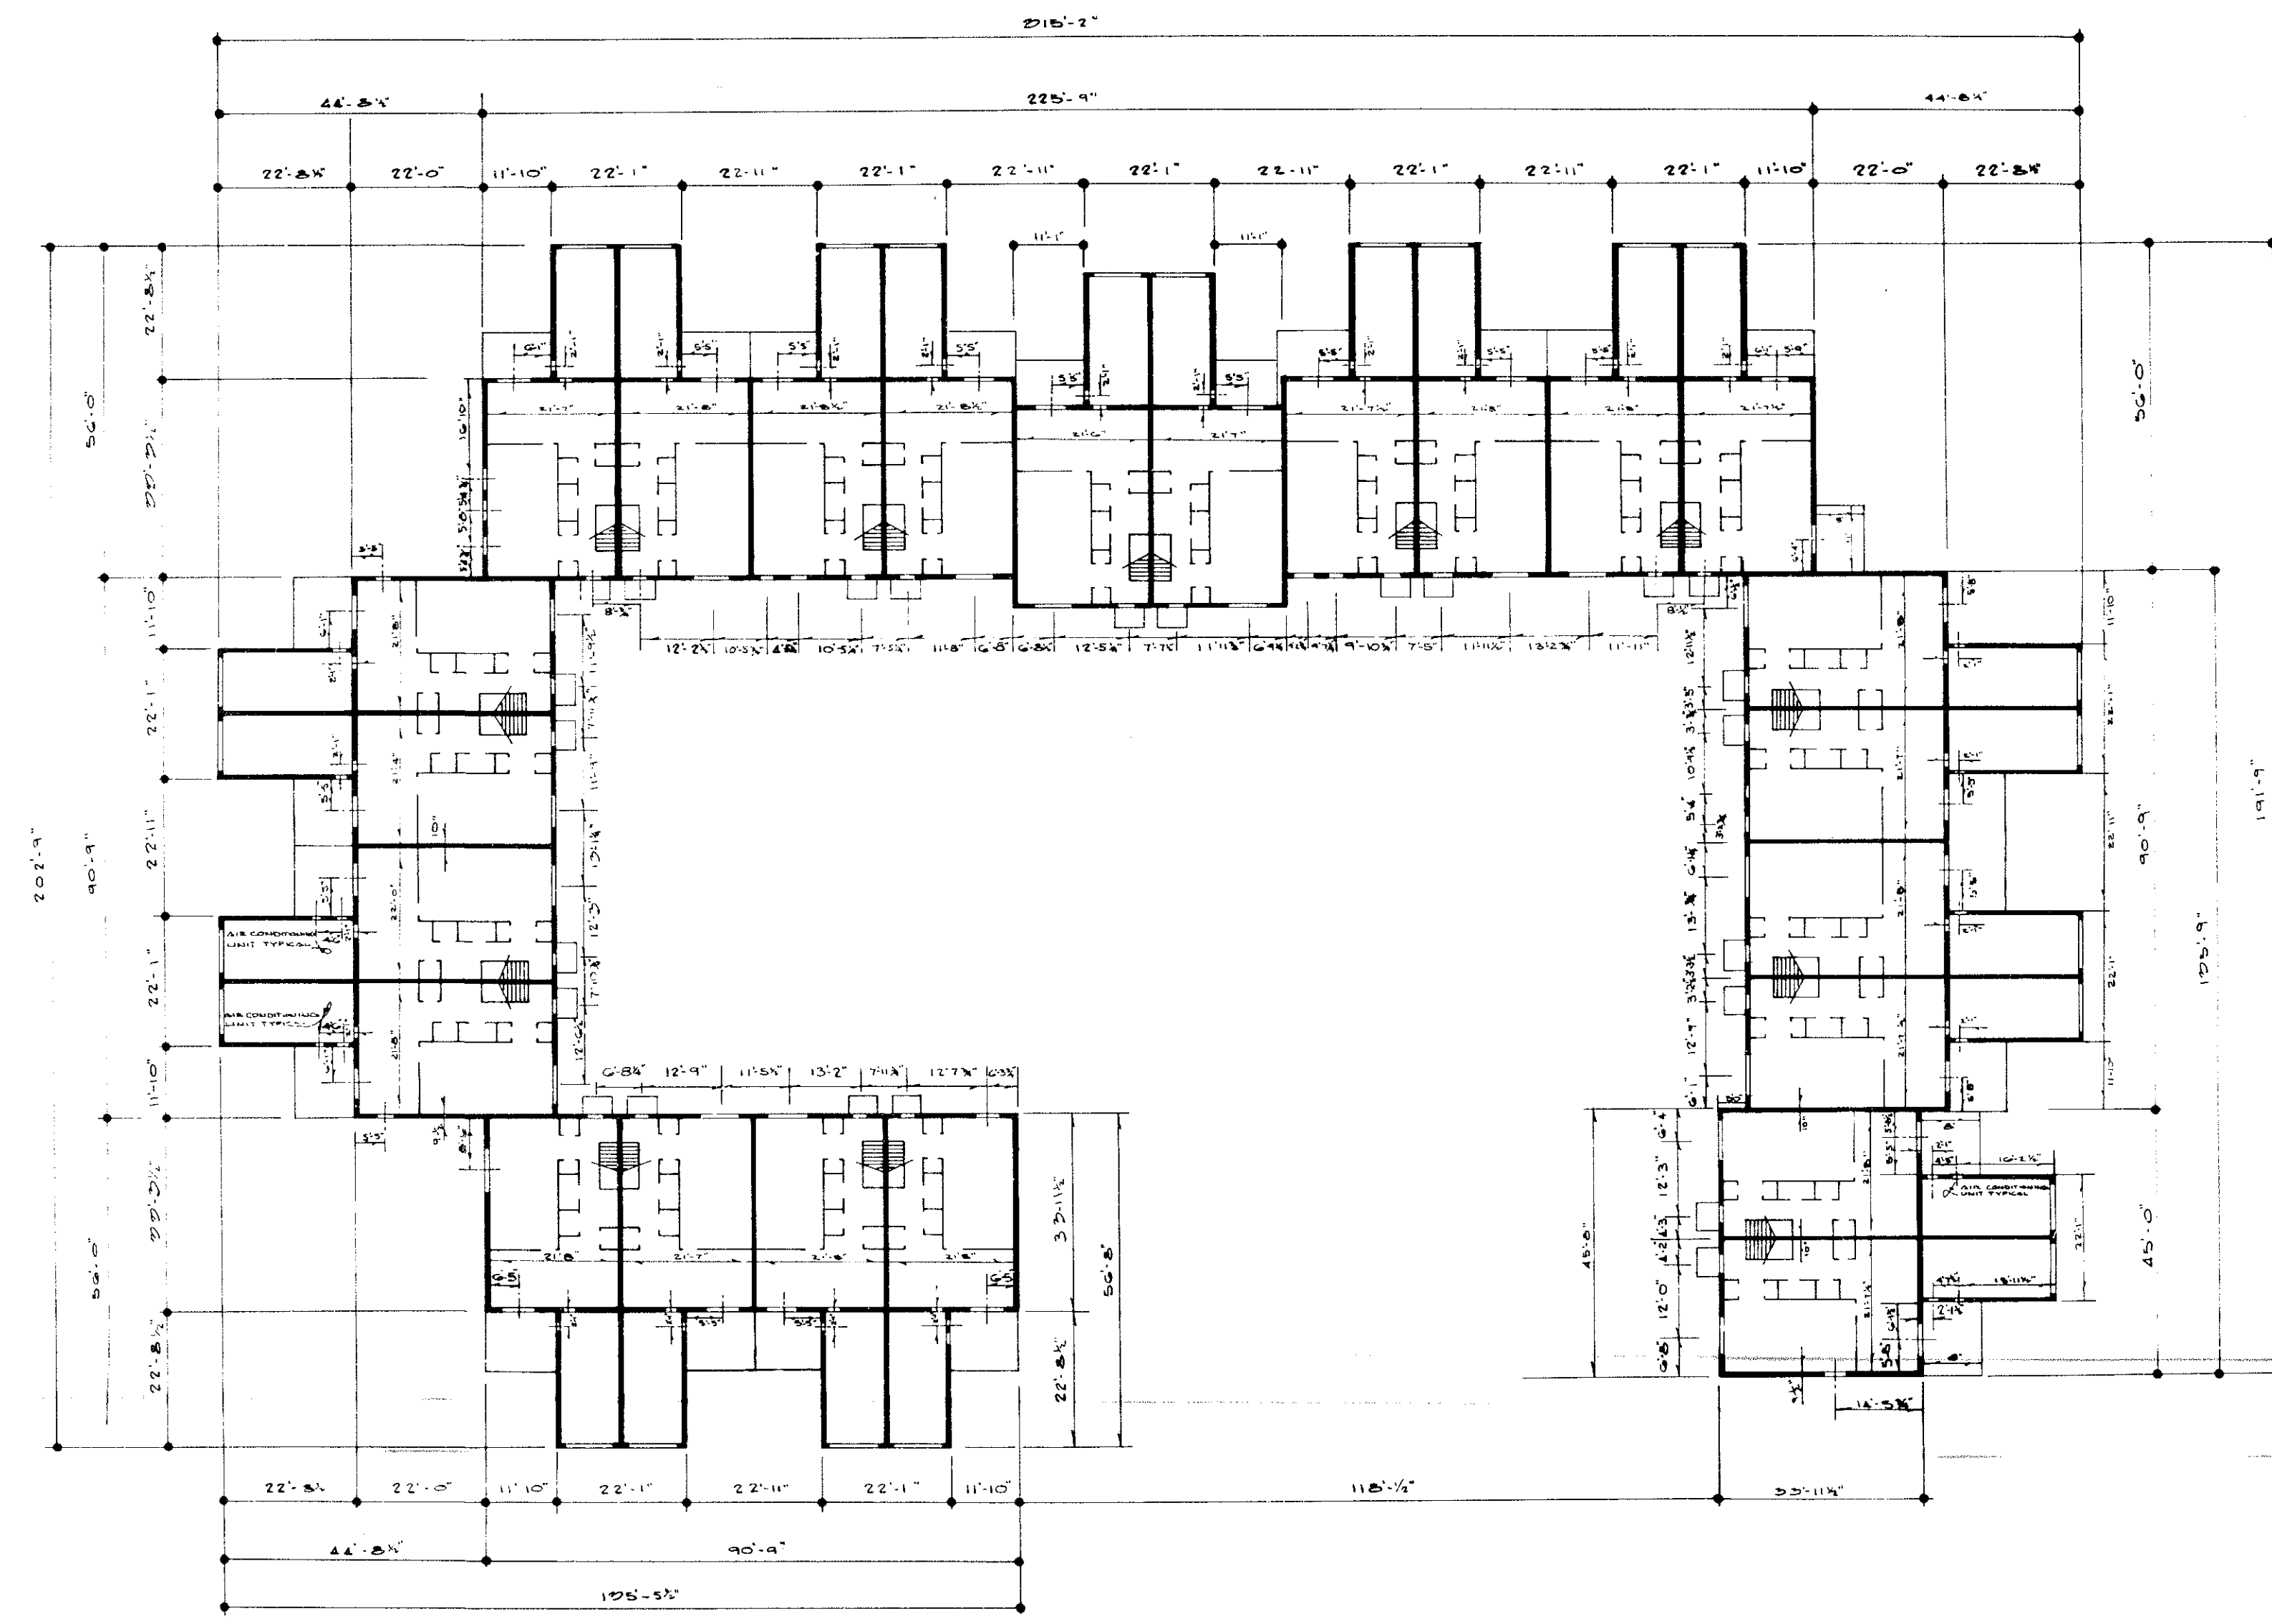

FIRST FLOOR PLAN
 SCALE: 1/16" = 1'-0"
 MACBETH COURT


NOTE: PATIOS ARE LIMITED COMMON AREAS.

STATEMENT OF CERTIFICATION:
 I CERTIFY THAT THE ATTACHED DRAWINGS
 CORRECTLY REPRESENT THE DIMENSIONS
 OF THE BUILDING AS CONSTRUCTED
 AND THAT THERE ARE NO ENCROACHMENTS
 ON ANY ADJUTING PREMISES.

James H. Schmidt
 JAMES H. SCHMIDT
 REGISTERED SURVEYOR


STATEMENT OF CERTIFICATION:
 I CERTIFY THAT THE ATTACHED DRAWINGS
 CORRECTLY REPRESENT THE BUILDING
 AS CONSTRUCTED AND THAT THERE ARE
 NO ENCROACHMENTS ON ANY ADJUTING
 PREMISES.

Andre D. Dushler
 ANDRE D. DUSHLER
 REGISTERED ARCHITECT

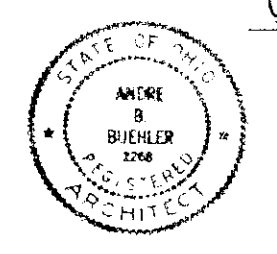

25/91

STRATFORD VILLAGES CONDOMINIUM NO. 3 FOR ANON ESTATE MANAGEMENT CO.		1 ST FLOOR MACBETH CT.	JOB NO. 0491
EXHIBIT "A"			
SCALE: AS SHOWN	DATE: JUNE 1970	PREPARED BY: JAMES H. SCHMIDT REGISTERED SURVEYOR ELYRIA, OHIO	SHEET NO. 3 OF 11

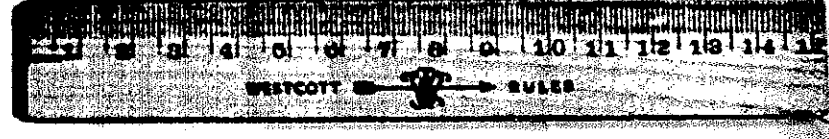

25/91