

25/93

Plot Vol 25/93



765858

STATEMENT OF CERTIFICATION:
I CERTIFY THAT THE ATTACHED DRAWINGS
CORRECTLY REPRESENT THE DIMENSIONS OF THE
BUILDINGS AS CONSTRUCTED AND THAT THERE
ARE NO ENCROACHMENTS ON ADJACENT
PREMISES.

James H. Schmidt
JAMES H. SCHMIDT
REGISTERED SURVEYOR

STATEMENT OF CERTIFICATION:
I CERTIFY THAT THE ATTACHED DRAWINGS
CORRECTLY REPRESENT THE BUILDINGS AS
CONSTRUCTED AND THAT THERE ARE NO
ENCROACHMENTS ON ADJACENT PREMISES.

Andrea D. Dushler
ANDREA D. DUSHLER
REGISTERED ARCHITECT

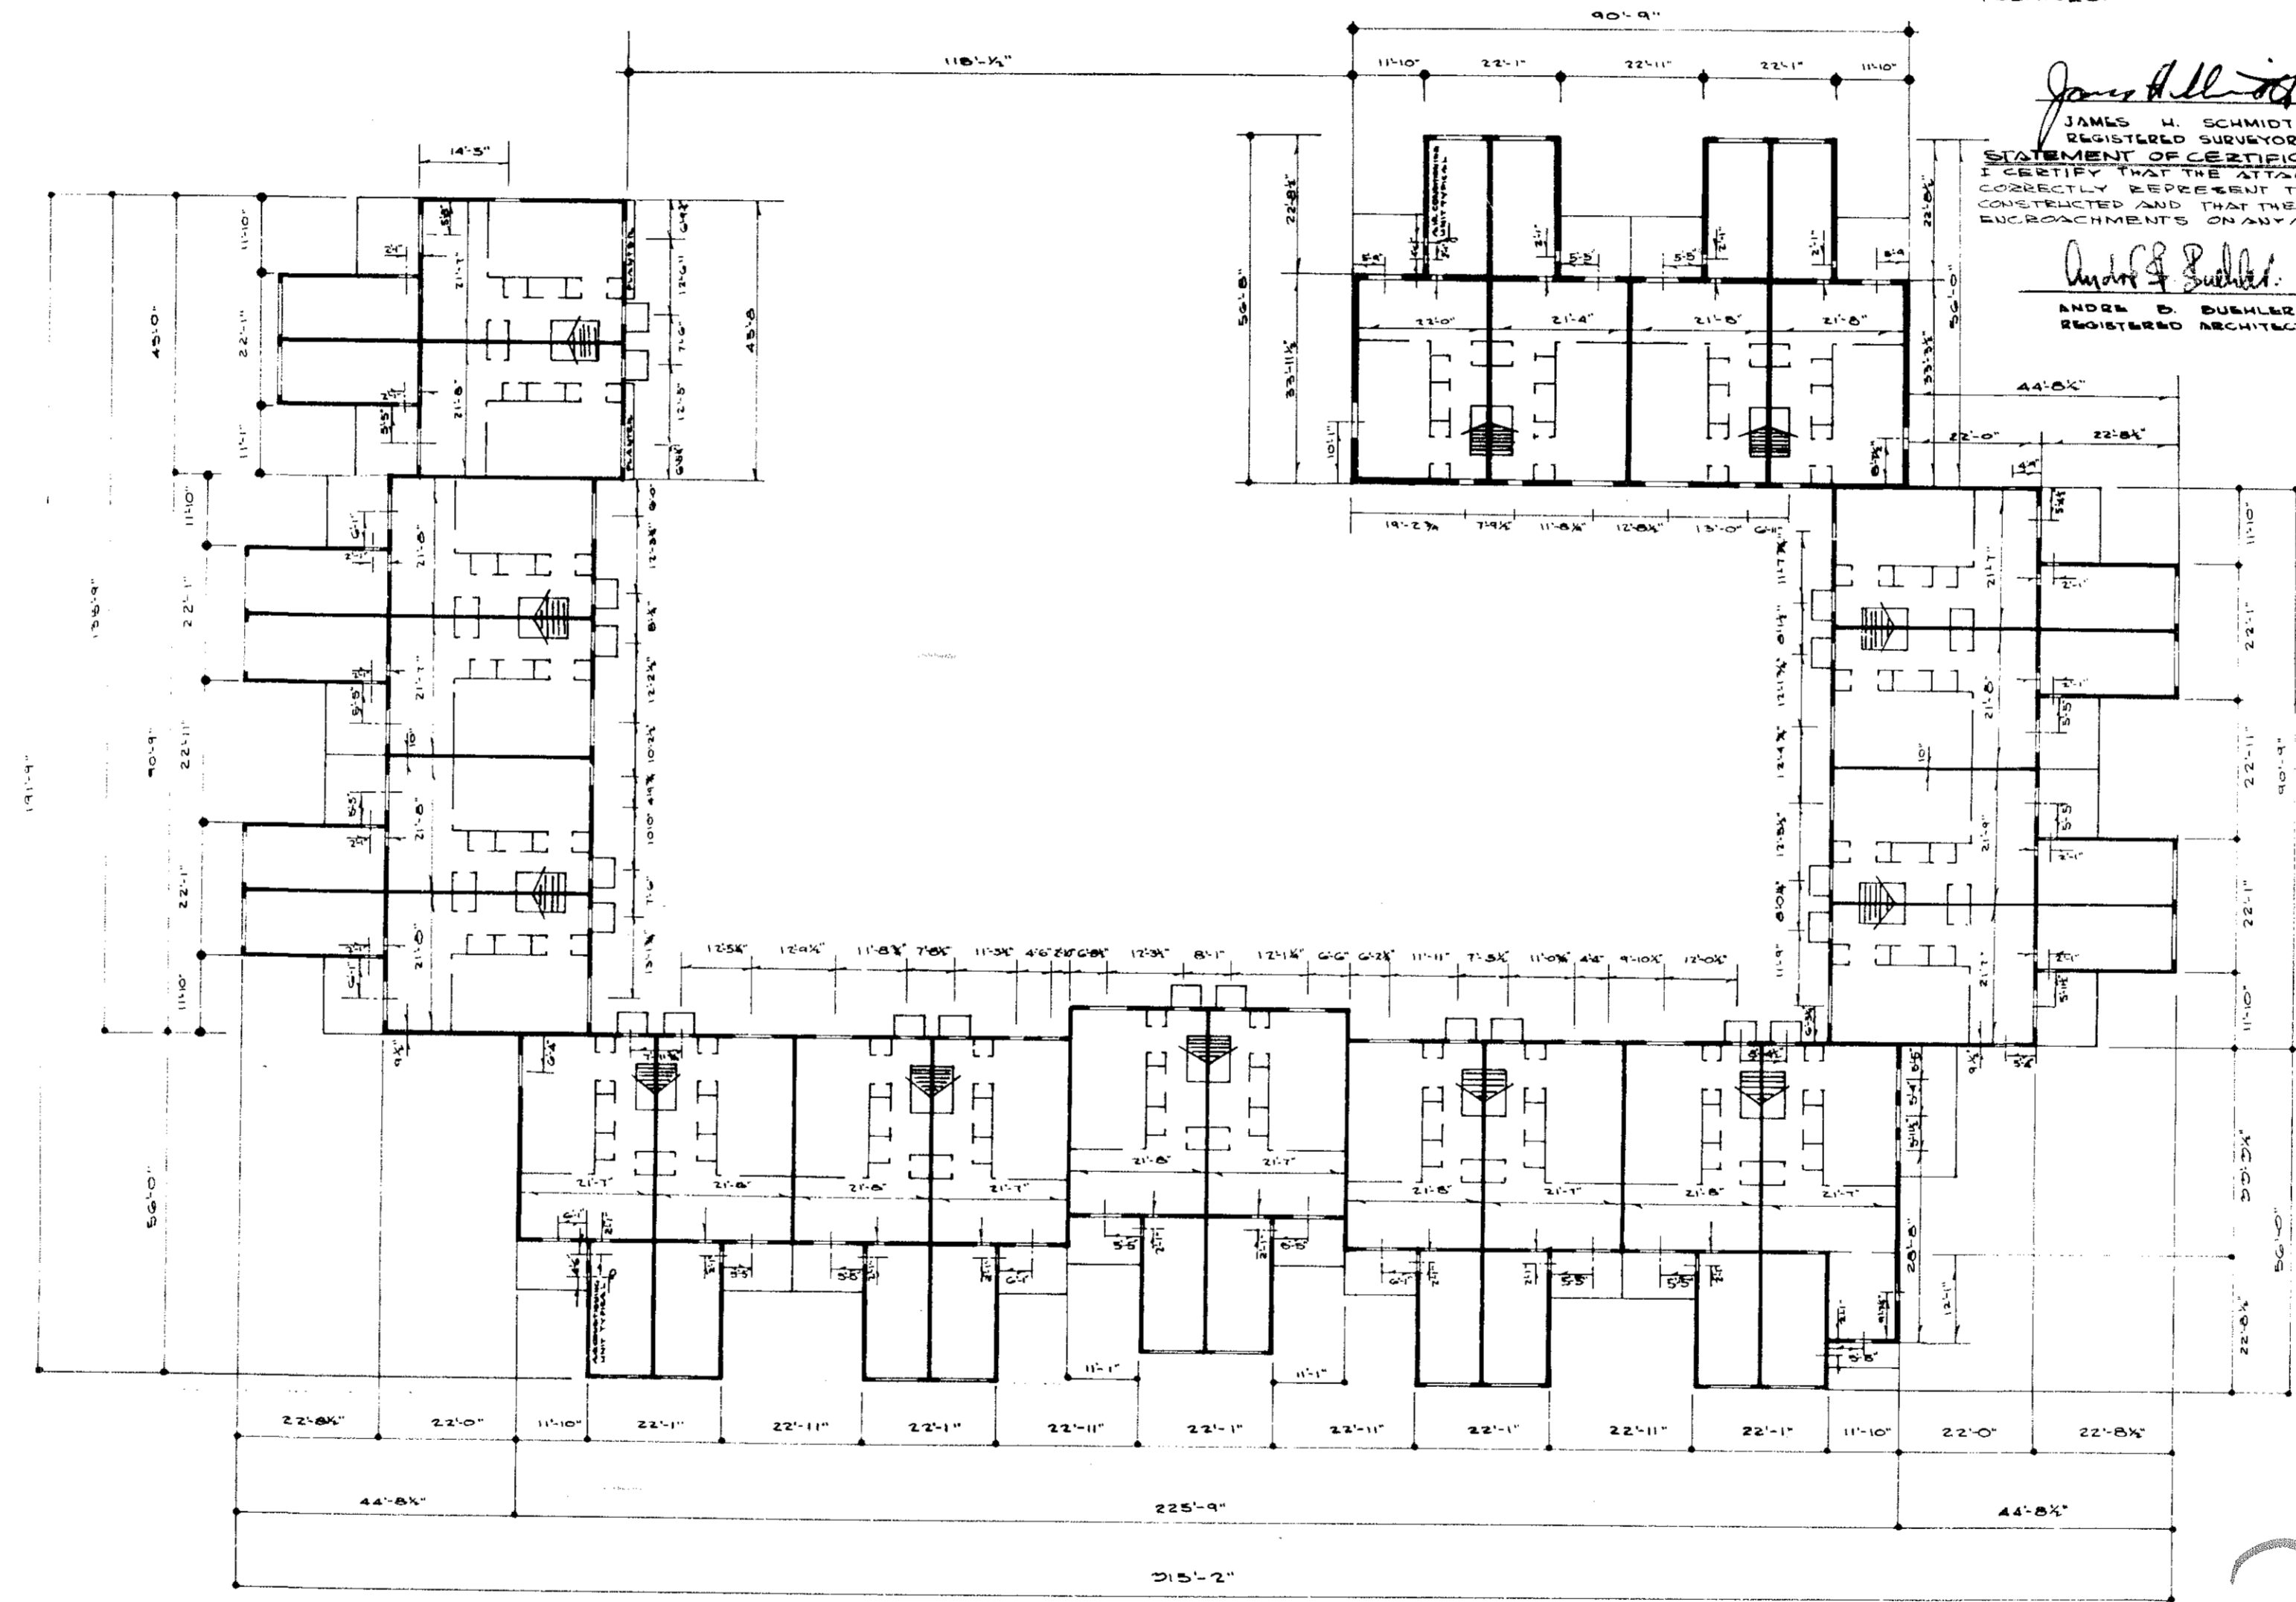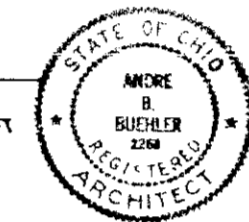

FIRST FLOOR PLAN HAMLET COURT

SCALE 1/8"=1'-0"

NOTE: PATIOS ARE LIMITED COMMON AREAS

STRAFORD VILLAGE CONDOMINIUM NO. 1 PUE ANDON REALTY INVESTMENT CO		JOB NO. 0771
EXHIBIT "A"		
SCALE: AS SHOWN	DATE: JUNE 1970	PREPARED BY JAMES H. SCHMIDT REGISTERED SURVEYOR SUCIA
		SHEET NO. 7 OF 31

25/93

25/93