


25/94

Plot Vol 25/94 765768

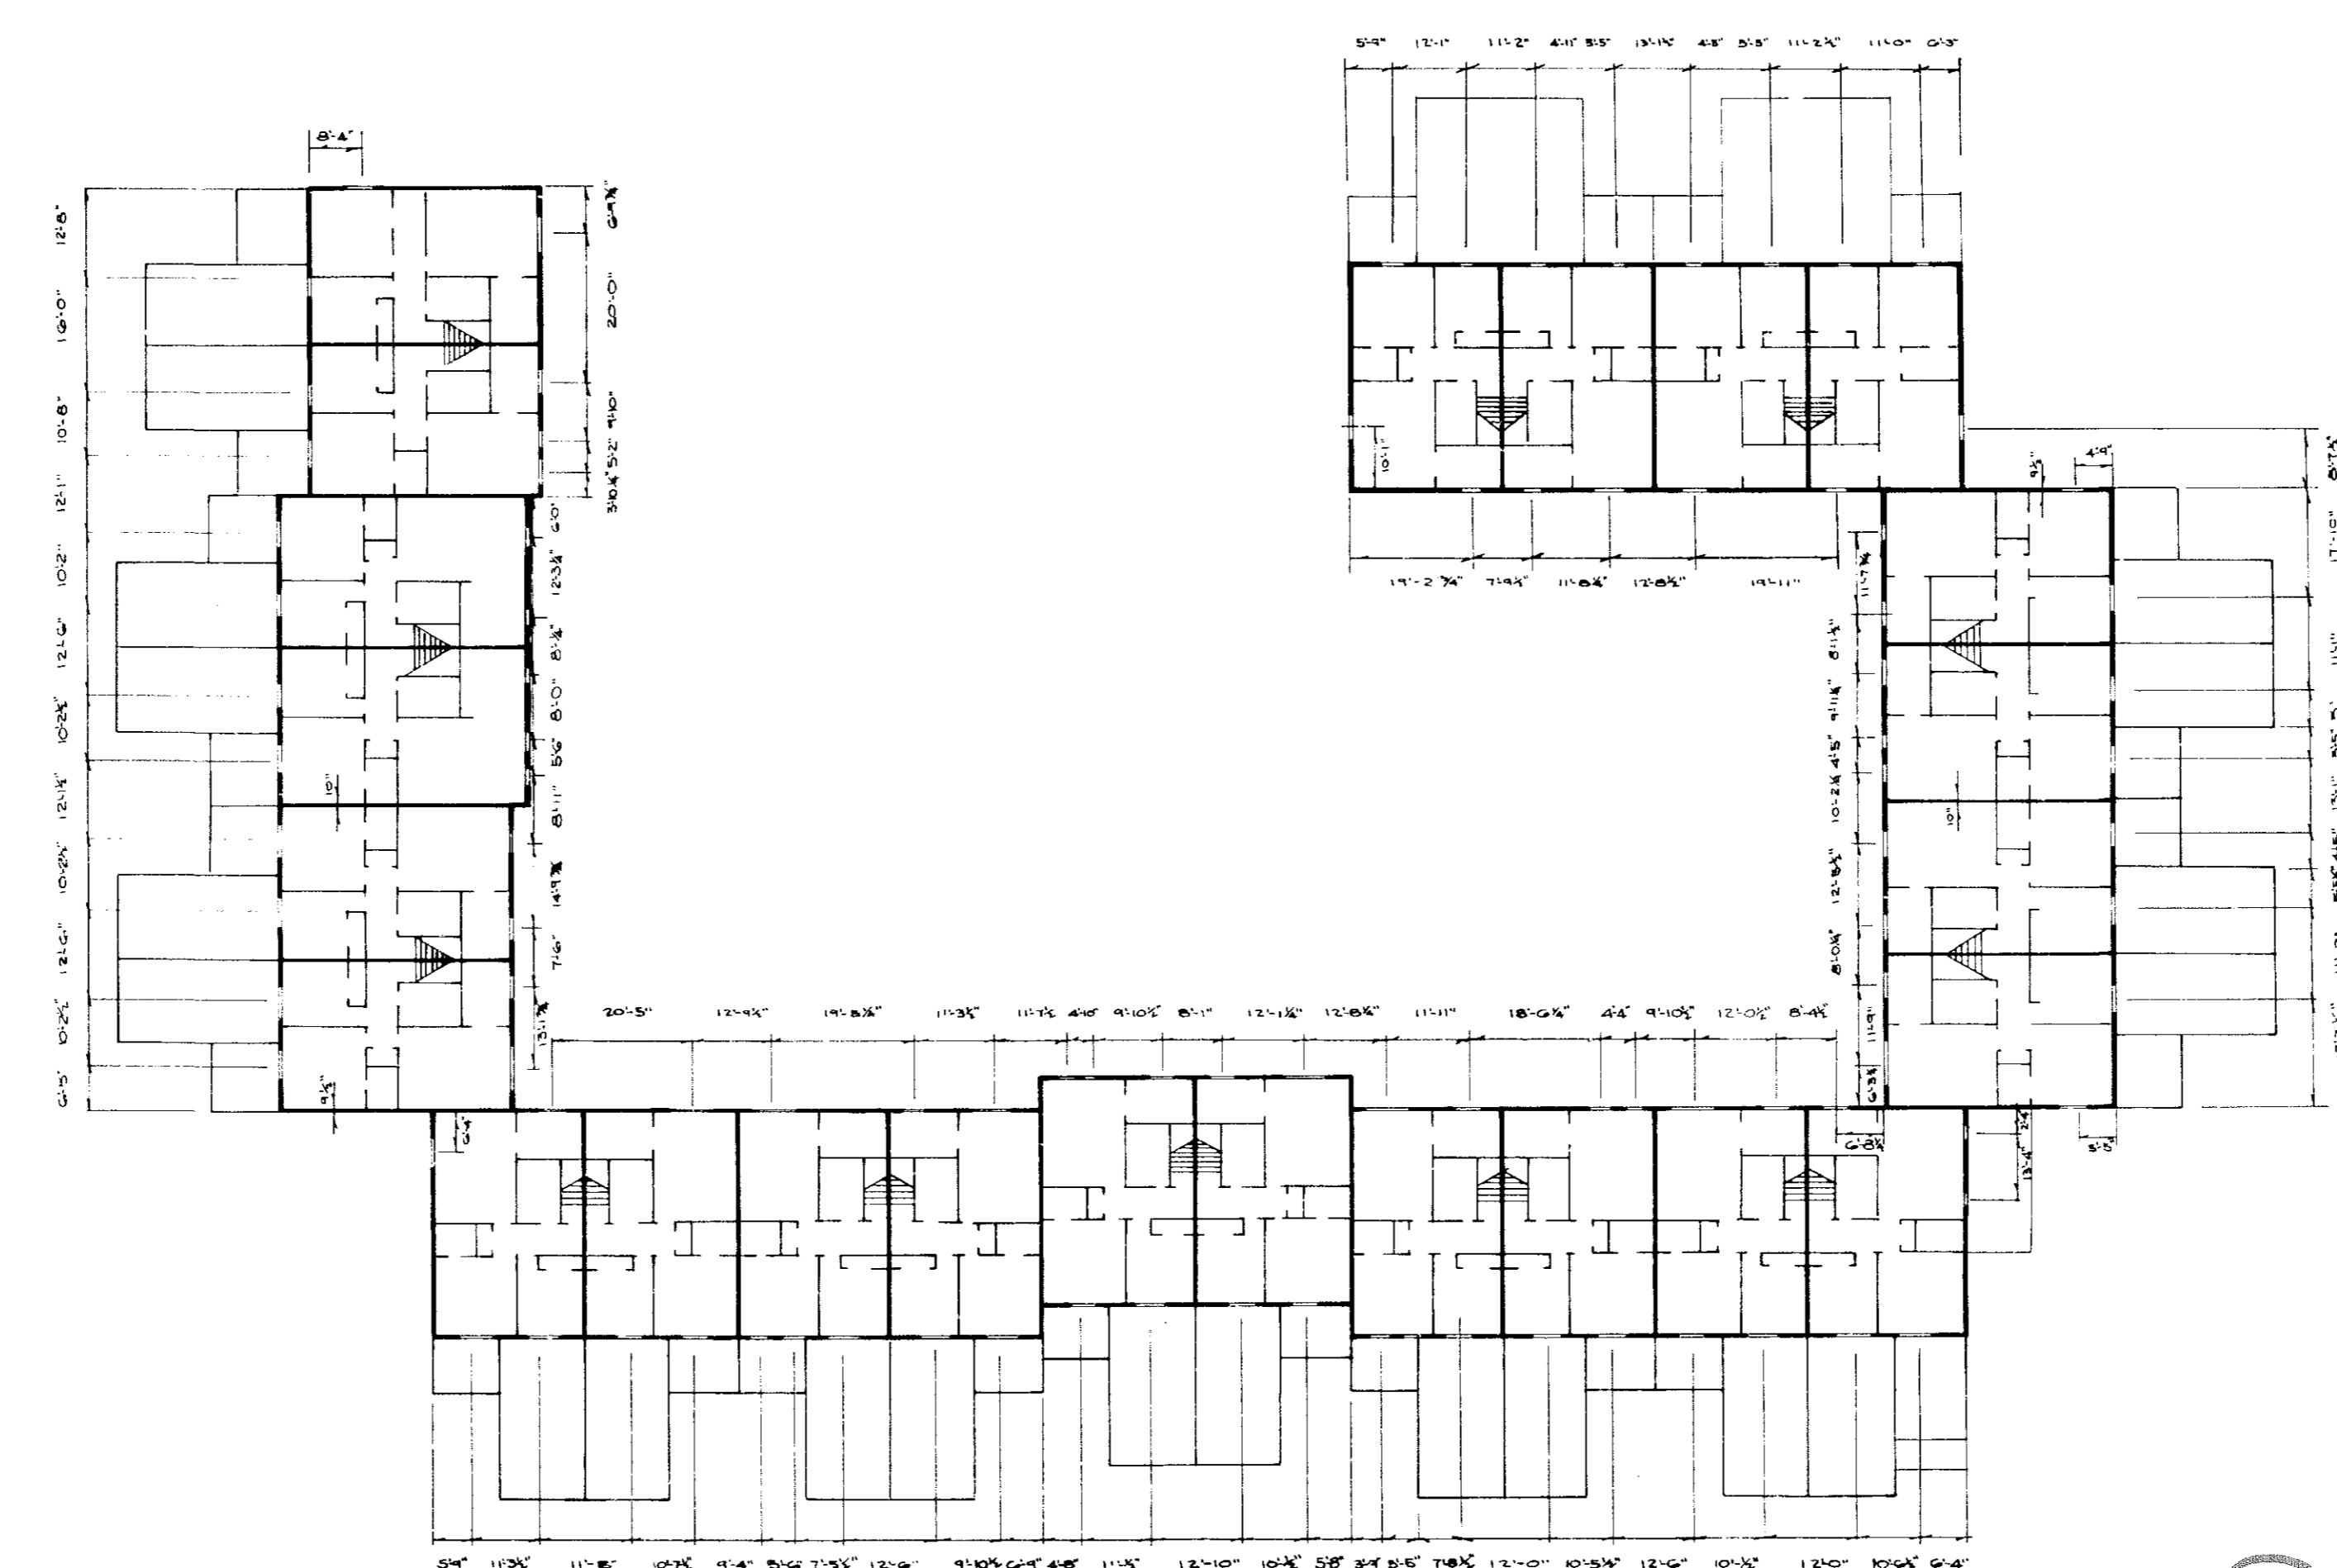


SECOND FLOOR PLAN  
SCALE 1/8"=1'-0"

HAMLET COURT

NOTE: PATIOS ARE LIMITED COMMON AREA.


STATEMENT OF CERTIFICATION:  
I CERTIFY THAT THE ATTACHED DRAWINGS  
CORRECTLY REPRESENT THE DIMENSIONS  
OF THE BUILDING AS CONSTRUCTED  
AND THAT THERE ARE NO ENCROACHMENTS  
ON ANY ADJACENT PREMISES.

*James H. Schmidt*  
JAMES H. SCHMIDT  
REGISTERED SURVEYOR

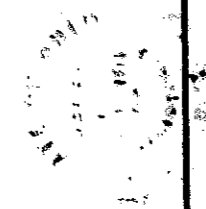

STATEMENT OF CERTIFICATION:  
I CERTIFY THAT THE ATTACHED DRAWINGS  
CORRECTLY REPRESENT THE BUILDING  
AS CONSTRUCTED AND THAT THERE  
ARE NO ENCROACHMENTS ON ANY  
ADJACENT PREMISES.

*Andre B. Buehler*  
ANDRE B. BUEHLER  
REGISTERED ARCHITECT

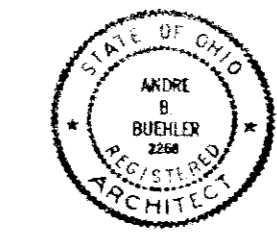

25/94

STEARNS VILLAGE CONDOMINIUM NO. 1 FOR ANDERSON BUILDING COMPANY EXHIBIT "A"		2 <sup>ND</sup> FL HAMLET CT.	JOB NO. 0471
SCALE: AS SHOWN	DATE: JUNE 1970	PREPARED BY: JAMES H. SCHMIDT REGISTERED SURVEYOR ELYRIA, OHIO	SHEET NO. 4 OF 11

25/94