



25/96


Plot 25 of 96 765868

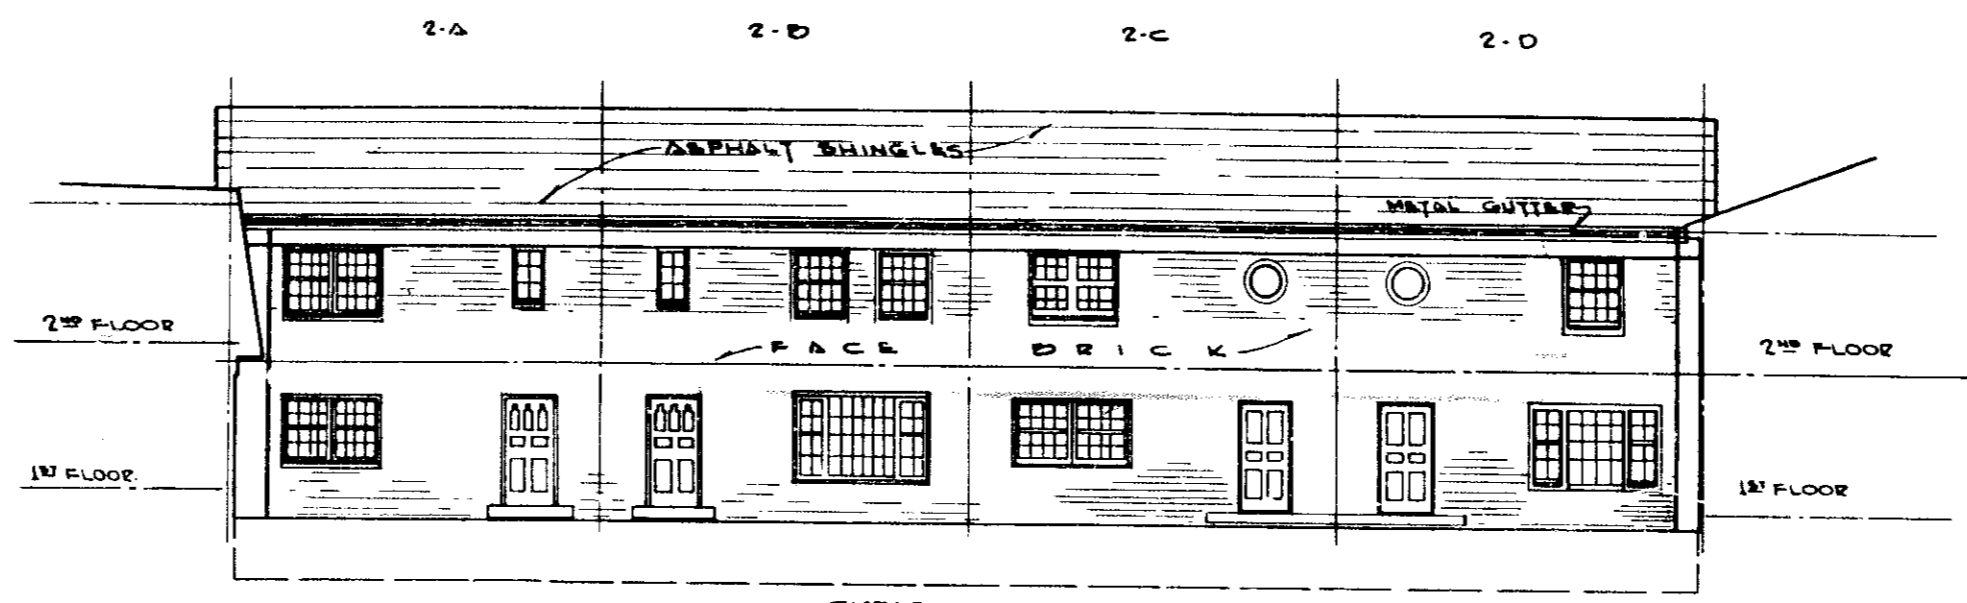


TYPICAL COURT ELEVATION
SCALE 1"=8'

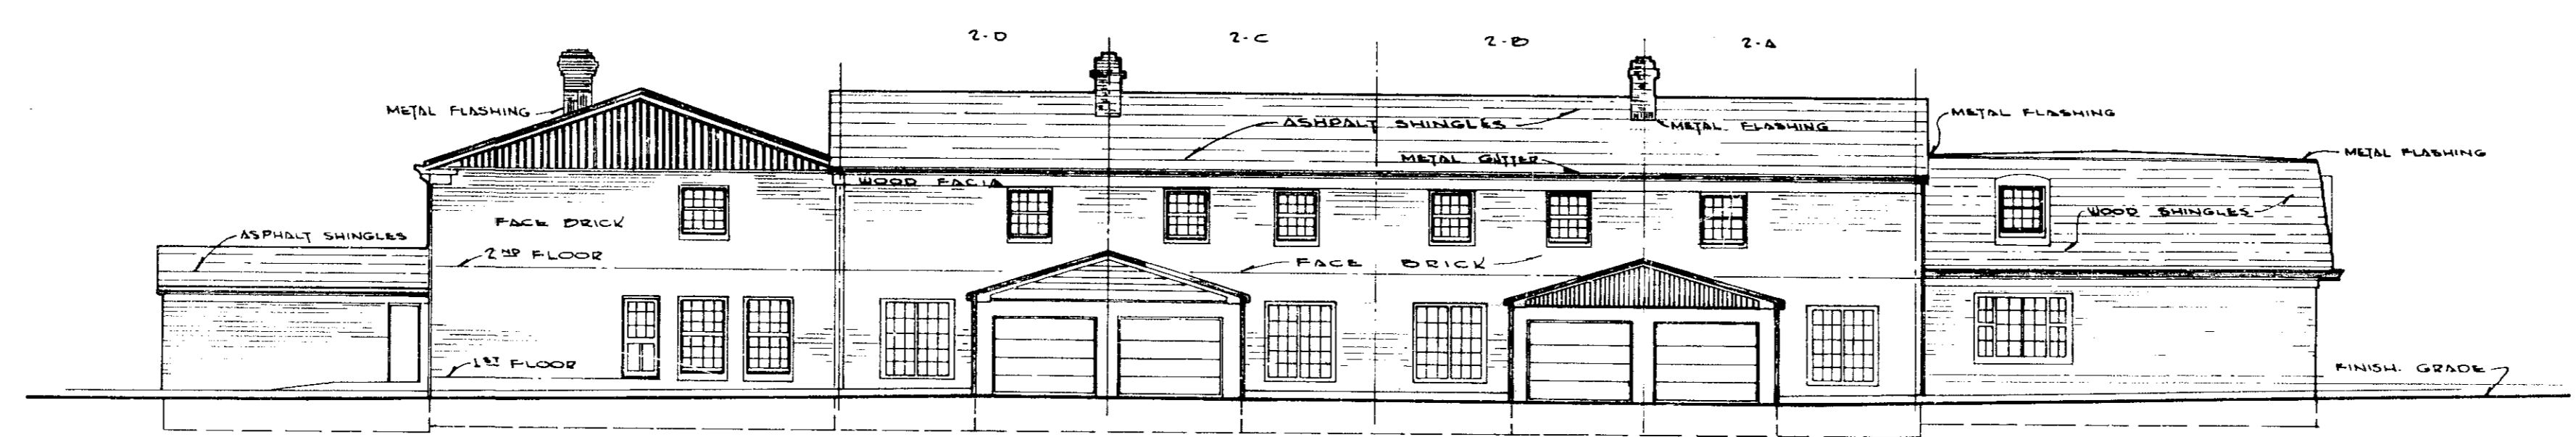

TYPICAL REAR ELEVATION
SCALE 1"=8'

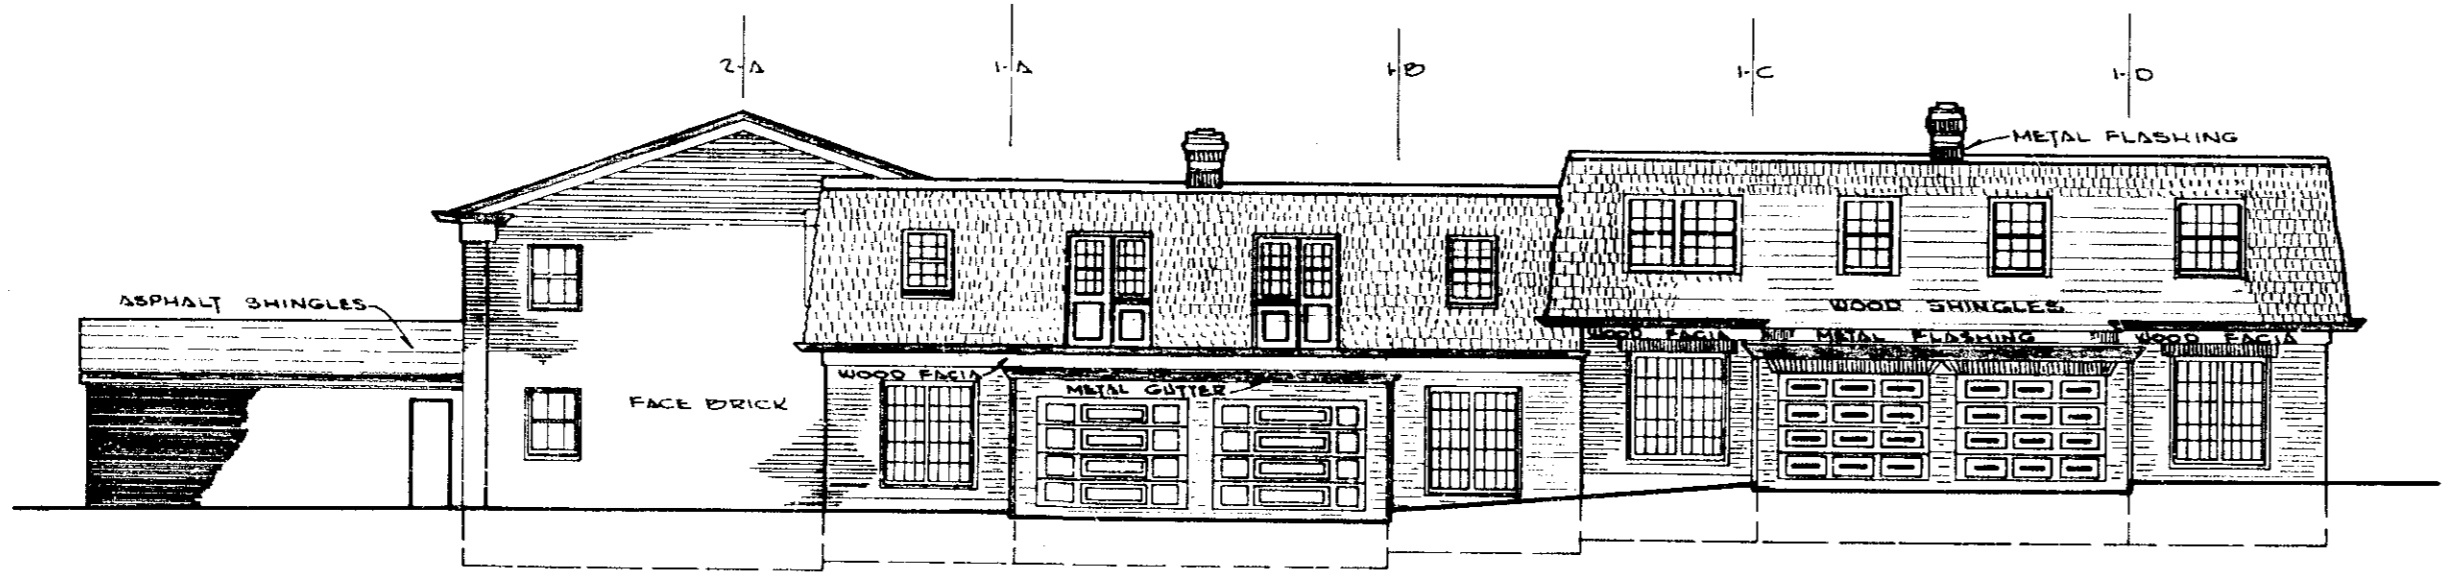

TYPICAL STREET ELEVATION
SCALE 1"=8'

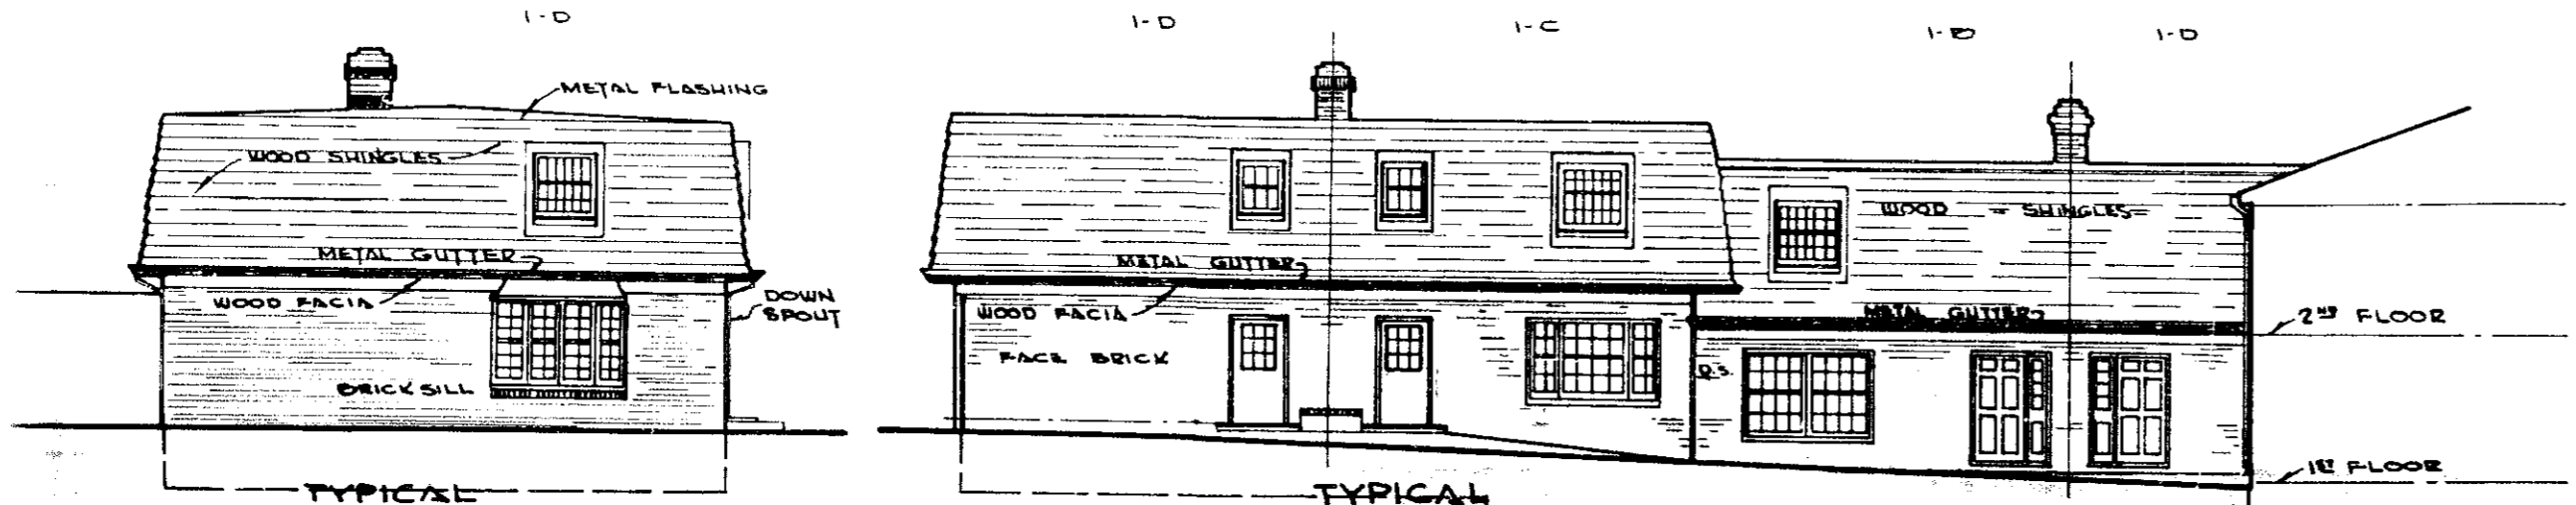

TYPICAL SIDE ELEVATION
SCALE 1"=8'


TYPICAL COURT ELEVATION
SCALE 1"=8'

STATEMENT OF CERTIFICATION:
I CERTIFY THAT THE ATTACHED DRAWINGS CORRECTLY REPRESENT THE DIMENSIONS OF THE BUILDING AS CONSTRUCTED AND THAT THERE ARE NO ENCROACHMENTS ON ANY ADJUTING PREMISES.

James H. Schmidt
JAMES H. SCHMIDT
REGISTERED SURVEYOR

STATEMENT OF CERTIFICATION:
I CERTIFY THAT THE ATTACHED DRAWINGS CORRECTLY REPRESENT THE BUILDING AS CONSTRUCTED AND THAT THERE ARE NO ENCROACHMENTS ON ANY ADJUTING PREMISES.

Andre D. Dugher
ANDRE D. DUGHER
REGISTERED ARCHITECT

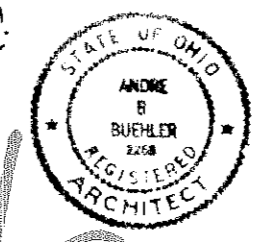

25/96

STAYFORD VILLAGE CONDOMINIUM NO. 1 FOR AVON REALTY INVESTMENT CO. EXHIBIT "A"		ELEVATIONS		JOB NO. 0991
SCALE: AS SHOWN	DATE: JUNE 1970	PREPARED BY: JAMES H. SCHMIDT REGISTERED SURVEYOR ELYRIA OHIO		SHEET NO. 10 OF 11



25/96