




27/26

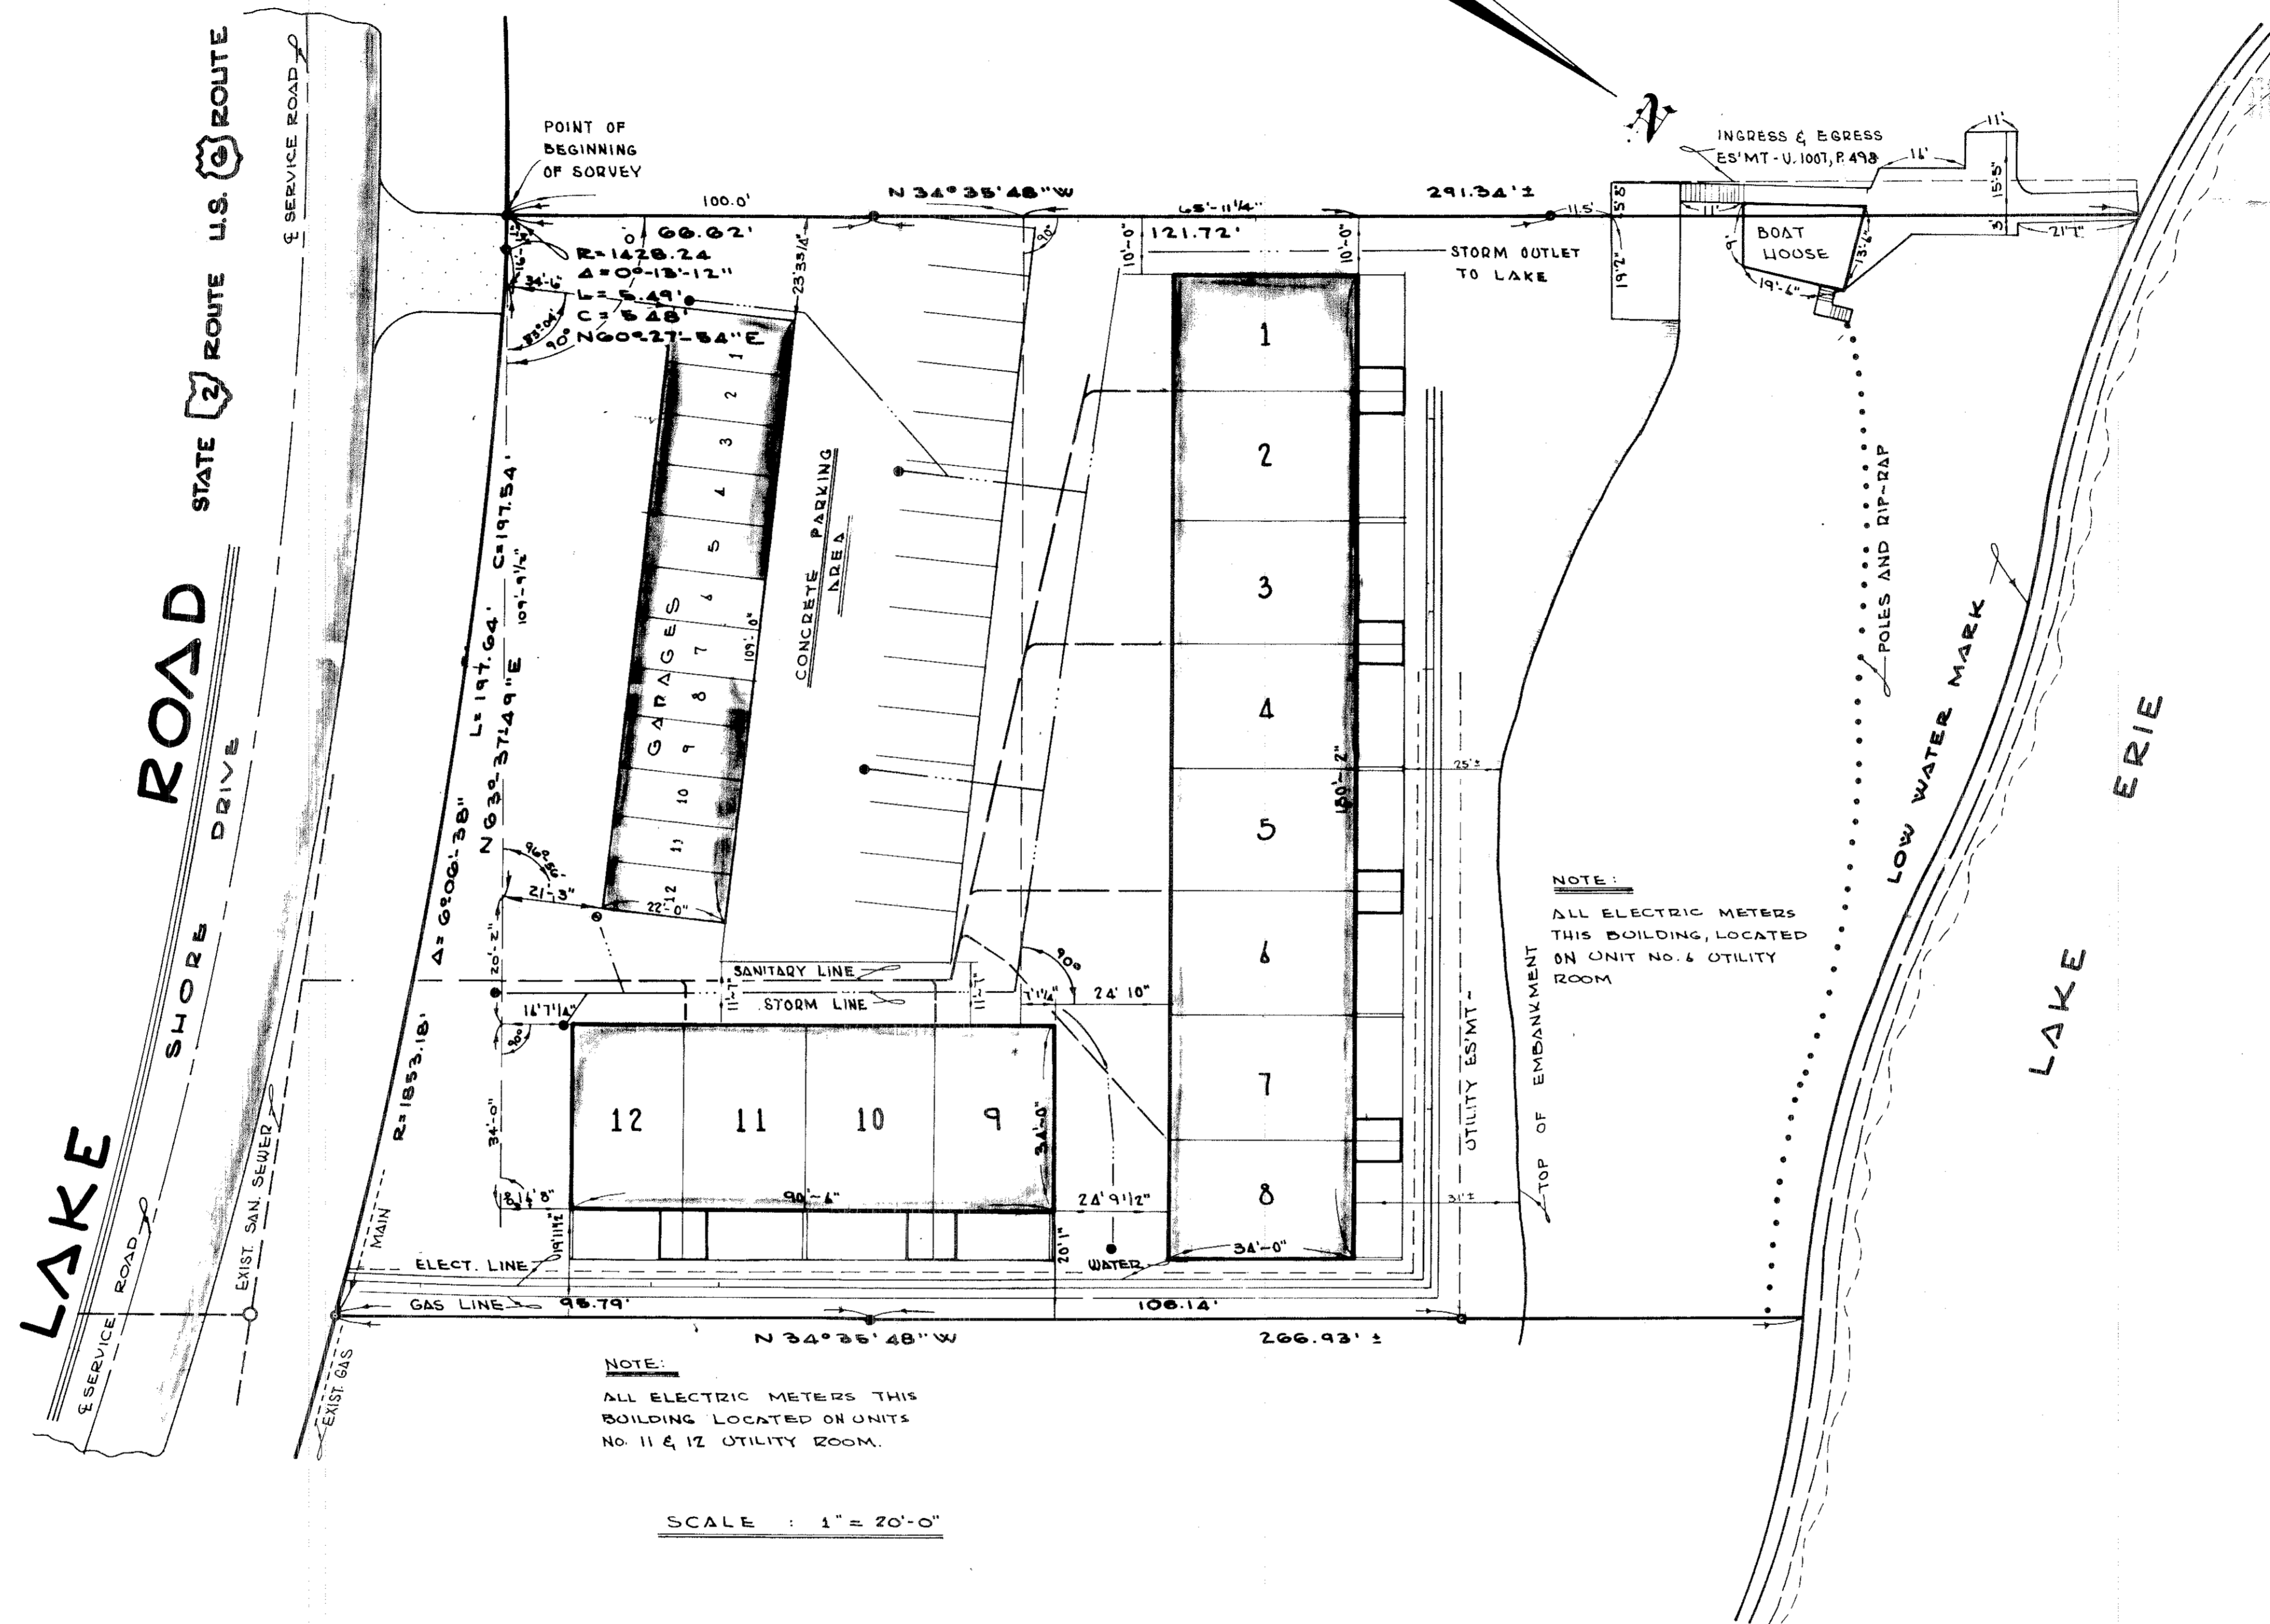

NOTE:  
ALL ELECTRIC METERS THIS BUILDING LOCATED ON UNITS No. 11 & 12 UTILITY ROOM.

NOTE:  
ALL ELECTRIC METERS THIS BUILDING, LOCATED ON UNIT NO. 4 UTILITY ROOM

SCALE : 1" = 20'-0"

# Lakeside "62"

## CONDOMINIUM TOWNHOUSES

LORAIN 02-02-021 OHIO

ORIGINAL BLACK RIVER TOWNSHIP LOT NO. 21

**STATEMENT OF CERTIFICATION**  
I CERTIFY THAT THE ATTACHED DRAWINGS CORRECTLY REPRESENT THE DIMENSIONS OF THE BUILDINGS AS CONSTRUCTED AND THAT THERE ARE NO ENCROACHMENTS ON ANY ADJACENT PREMISES.

*James H. Schmidt*  
JAMES H. SCHMIDT  
REGISTERED SURVEYOR

**STATEMENT OF CERTIFICATION**  
I CERTIFY THAT THE ATTACHED DRAWINGS CORRECTLY REPRESENT THE BUILDINGS AS CONSTRUCTED AND THAT THERE ARE NO ENCROACHMENTS ON ANY ADJACENT PREMISES.

*Andre B. Soule*  
ANDRE B. SOULE  
REGISTERED ARCHITECT

NO TRANSFER NECESSARY  
JOSEPH J. MITOCK  
LORAIN COUNTY AUDITOR  
*Daniel K. Miller*  
DEPUTY  
10/2/92

27/26

"LAKESIDE-62" CONDOMINIUM - PREPARED FOR ERIE SHORES DEVELOPMENT CO.		LOCATION & SURVEY	JOB NO. 70-175
SCALE: AS SHOWN	DATE: NOV. 1970	PREPARED BY JAMES H. SCHMIDT	SHEET NO. 2
DRAWN: J.B.R. - 1/4	CHK'D.	REGISTERED SURVEYOR ELYRIA, OHIO	OF

27/27

STATEMENT OF CERTIFICATION

I CERTIFY THAT THE ATTACHED DRAWINGS CORRECTLY REPRESENT THE BUILDINGS AS CONSTRUCTED AND THAT THERE ARE NO ENCROACHMENTS ON ANY ADJACENT PREMISES.

*Andre B. Boehler*  
 ANDRE B. BOEHLER  
 REGISTERED ARCHITECT

STATEMENT OF CERTIFICATION


I CERTIFY THAT THE ATTACHED DRAWINGS CORRECTLY REPRESENT THE DIMENSIONS OF THE BUILDINGS AS CONSTRUCTED - AND THAT THERE ARE NO ENCROACHMENTS ON ANY ADJACENT PREMISES.

*James H. Schmidt*  
 JAMES H. SCHMIDT  
 REGISTERED SURVEYOR

**NO TRANSFER NECESSARY**

JOSEPH J. MITOCK  
 LORAIN COUNTY AUDITOR

*Samuel C. Smith*  
 DEPUTY  
 10/2/12

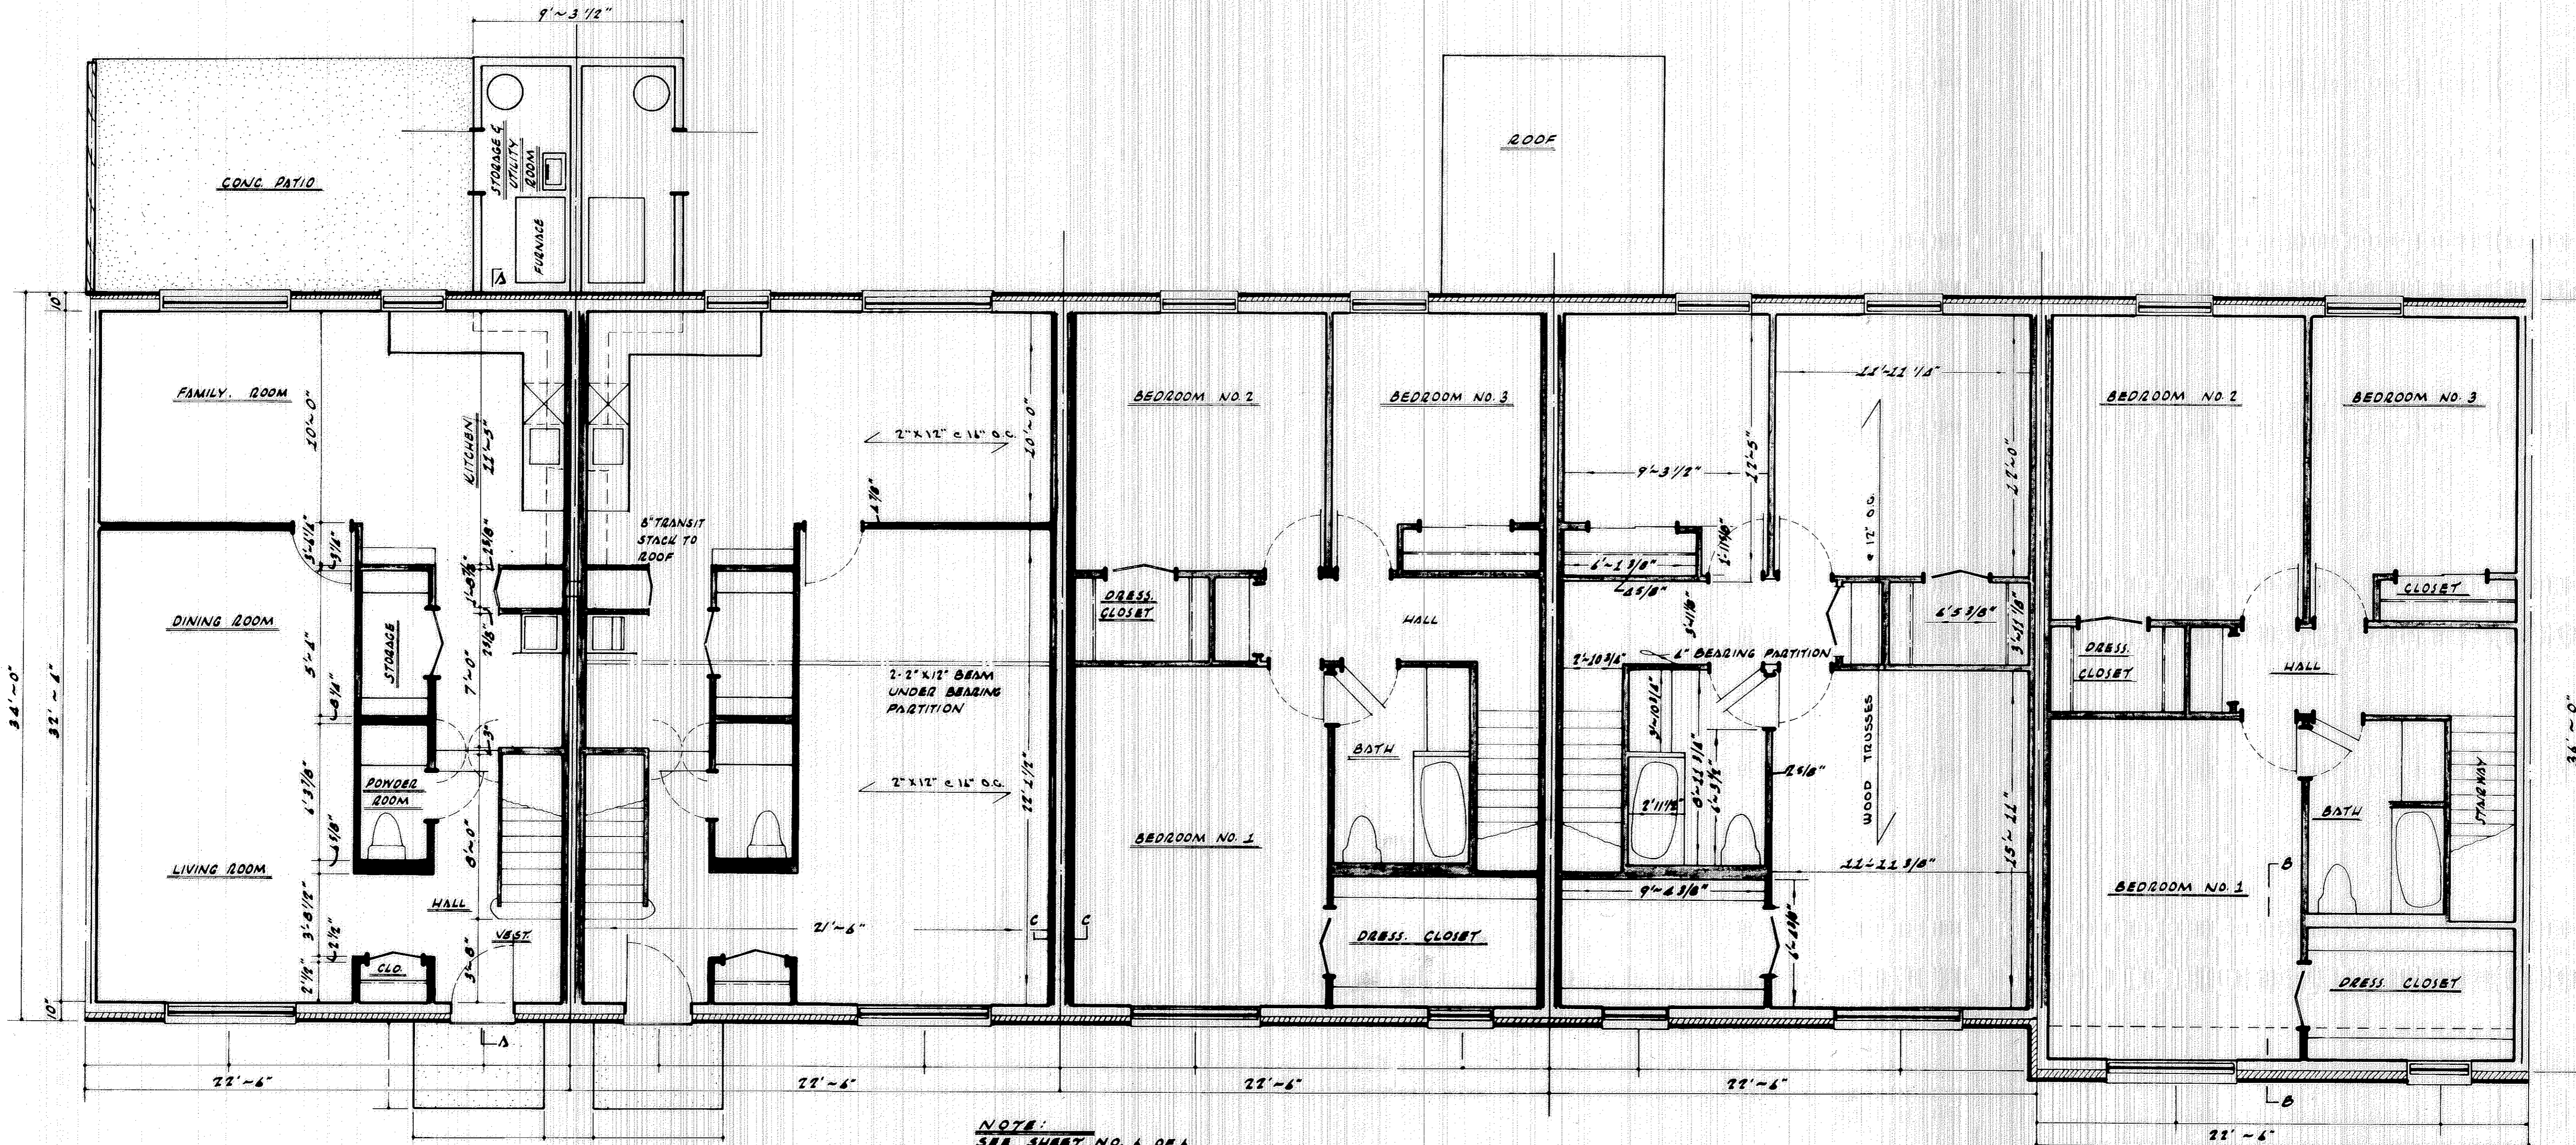

FIRST FLOOR PLAN

ALL UNITS  
 SCALE: 3/8" = 1'-0"

SECOND FLOOR PLAN

ALL UNITS EXCEPT NO'S 445  
 SCALE: 3/8" = 1'-0"

SECOND FLOOR SPECIAL PLAN


UNIT NO'S 445  
 SCALE: 3/8" = 1'-0"

NOTE:  
 SEE SHEET NO. 6 OF 6  
 FOR WINDOW & DOOR  
 MEASUREMENTS.

02-02-021


27/27

LANESIDE 62" CONDOMINIUM - PREPARED FOR EBIE SHORES DEVELOPMENT CO.		FLOOR PLAN	JOB NO. 70-175
SCALE: AS SHOWN	DATE: NOV. 1970	PREPARED BY <b>JAMES H. SCHMIDT</b> REGISTERED SURVEYOR	SHEET NO. 3 OF 6
DRAWN: L. Quinn	CH'NG.	BY: R. J. D. OHIO	

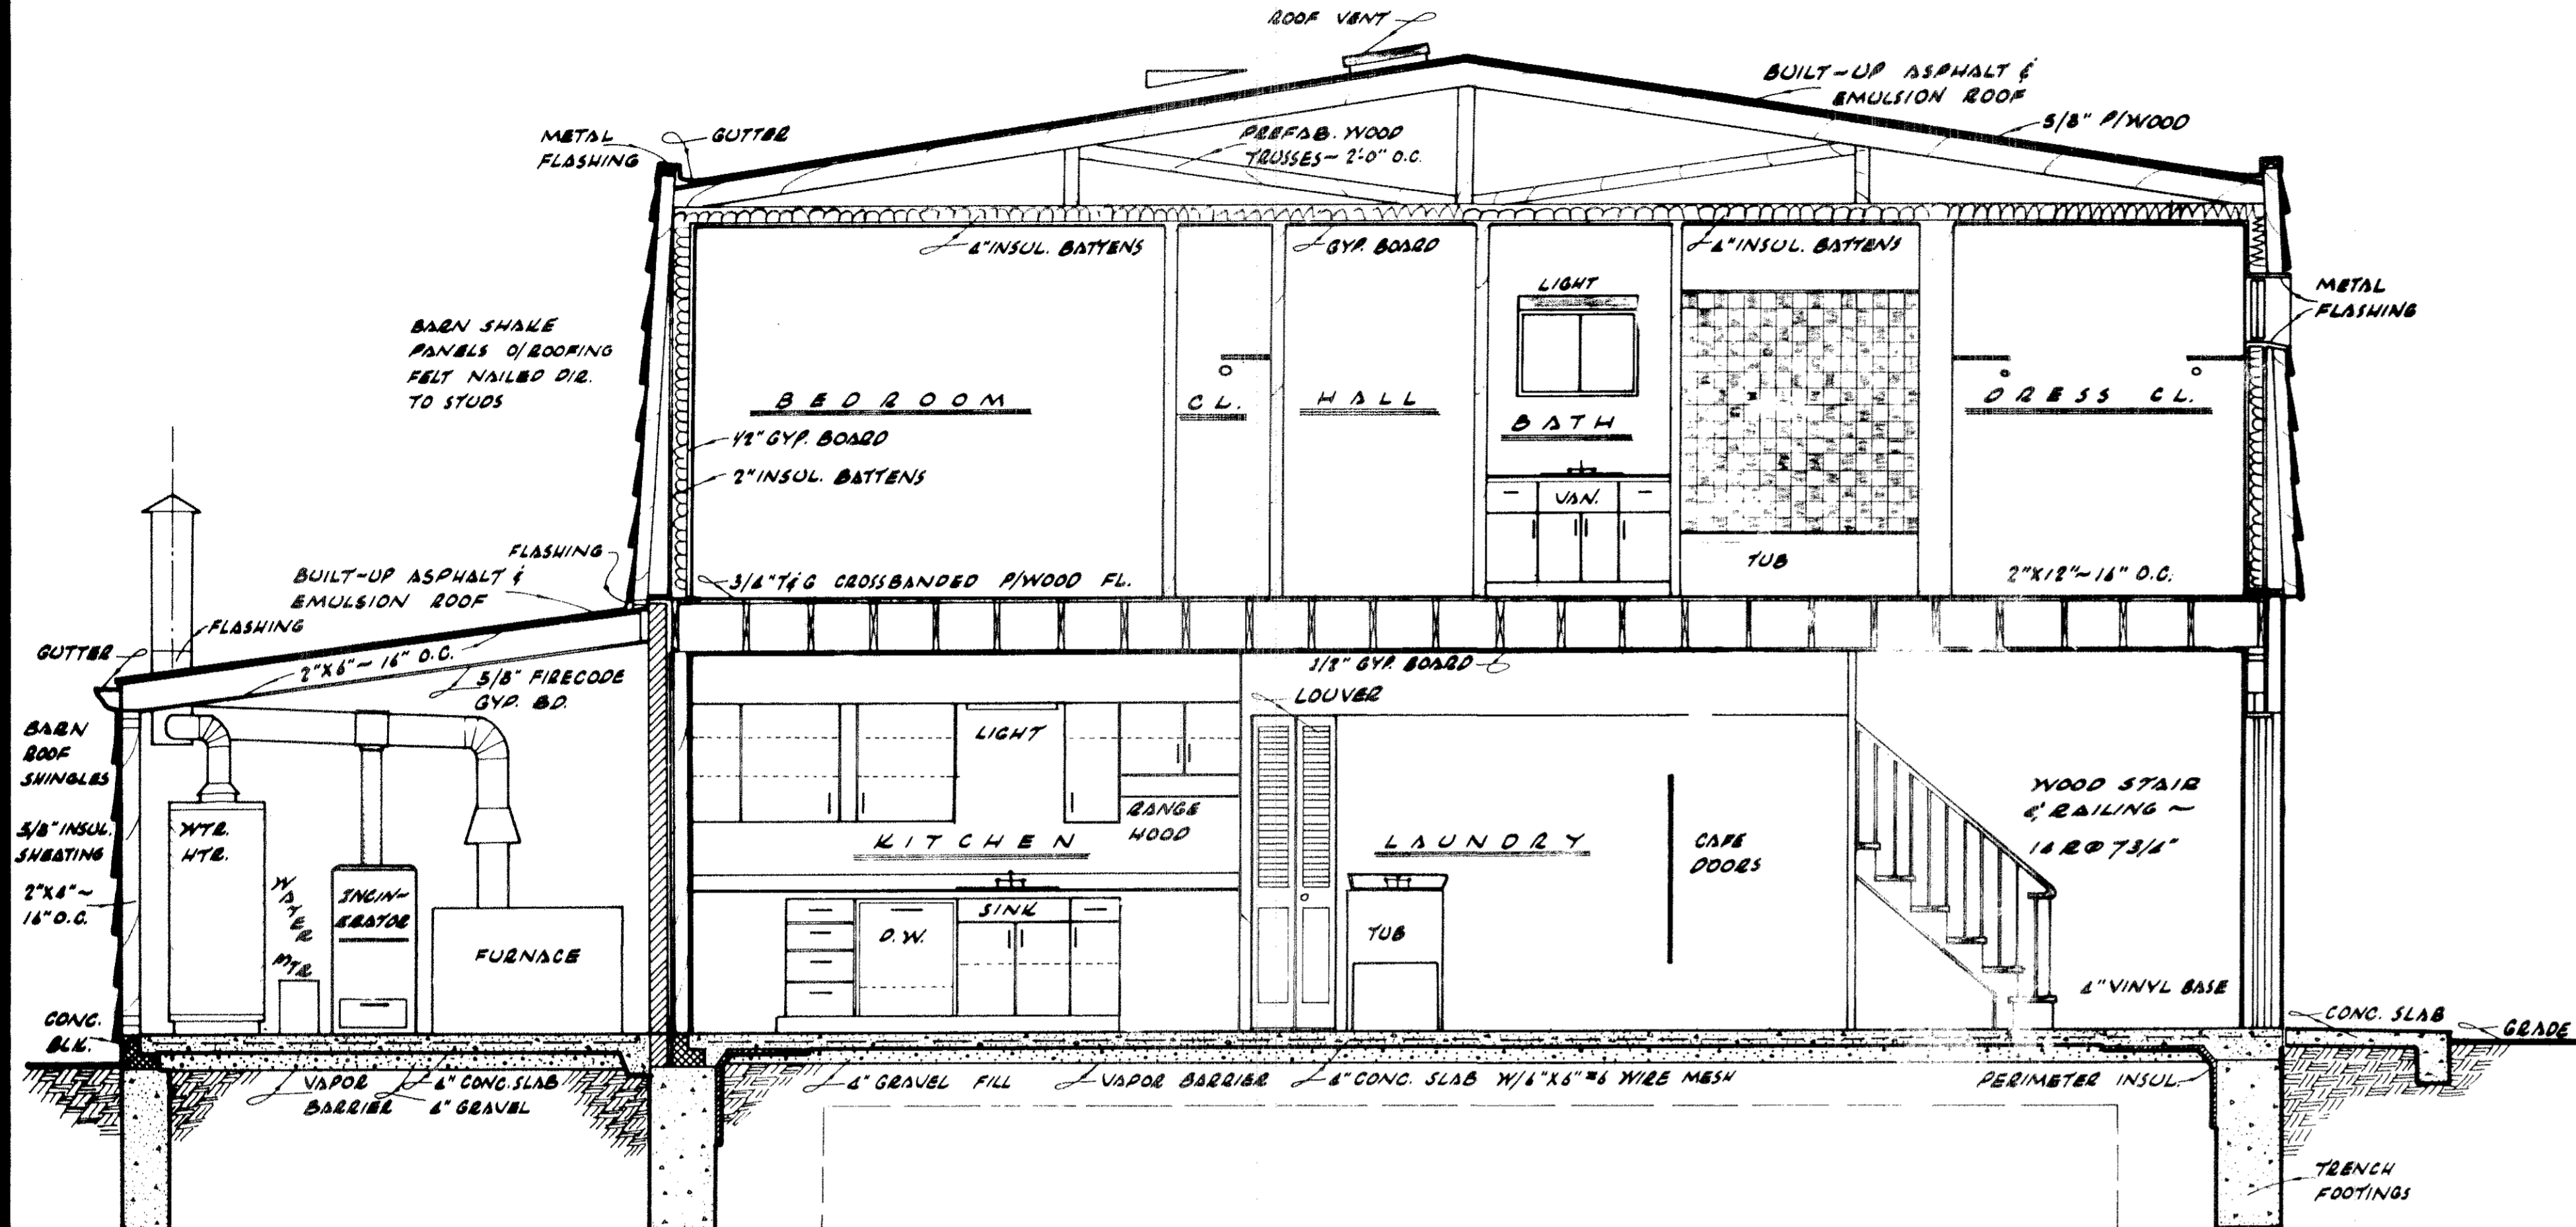


**LONGITUDINAL SECTION "A-A"**

SCALE: 3/8" = 1'-0"

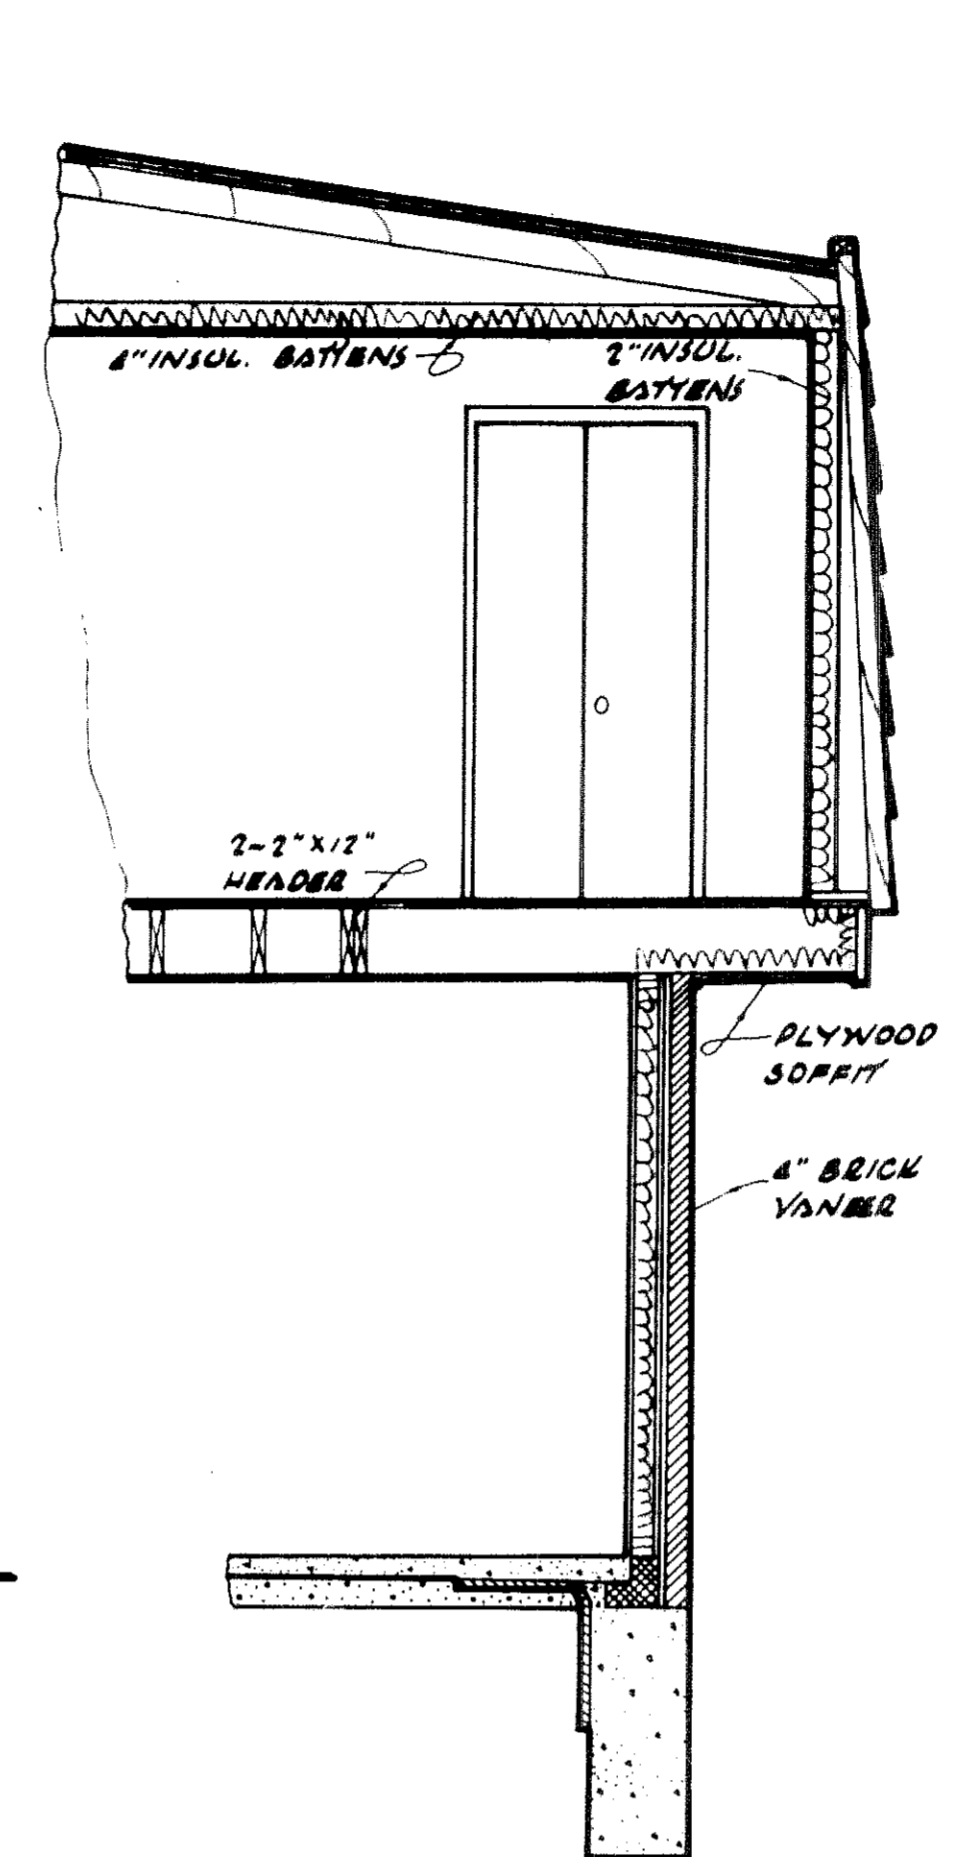

**SECTION "B-B"**

UNIT NO'S 445  
SCALE: 3/8" = 1'-0"

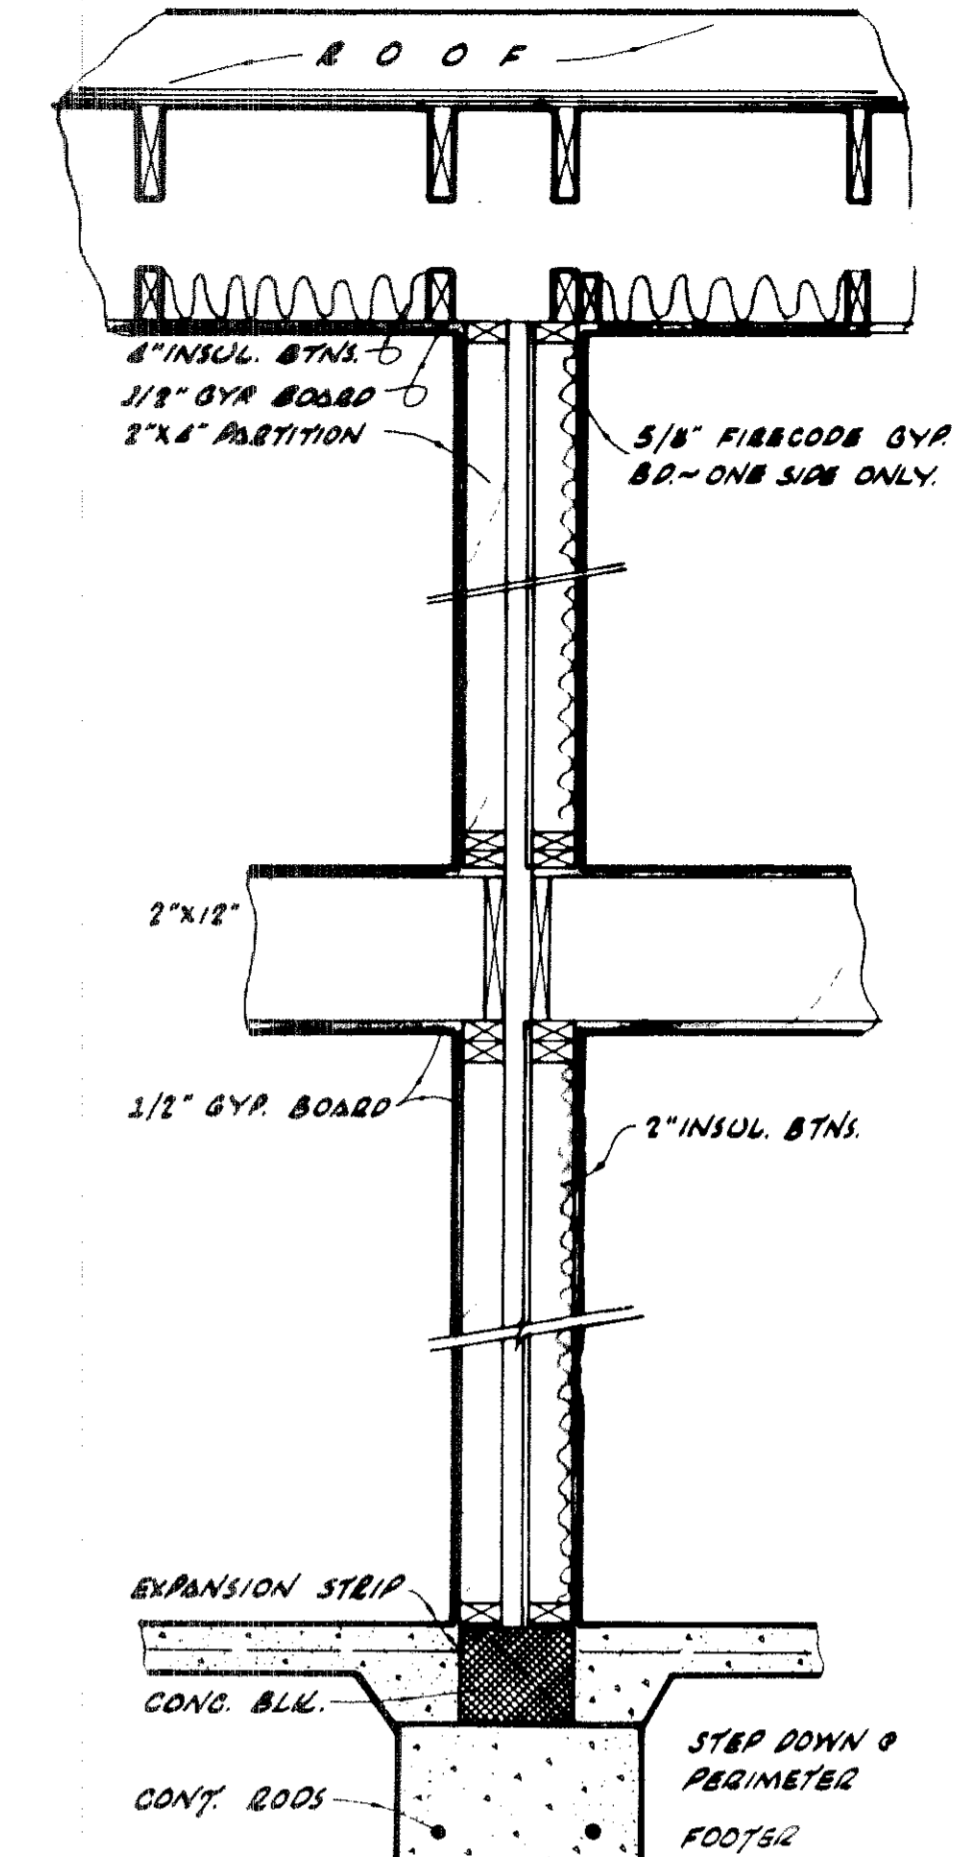


**SECTION "C-C"**

SCALE: 3/4" = 1'-0"


**STATEMENT OF CERTIFICATION**  
I CERTIFY THAT THE ATTACHED DRAWINGS CORRECTLY REPRESENT THE DIMENSIONS OF THE BUILDING AS CONSTRUCTED AND THAT THERE ARE NO ENCROACHMENTS ON ANY ADJUTING PREMISES.

*James H. Schmidt*  
**JAMES H. SCHMIDT**  
REGISTERED SURVEYOR

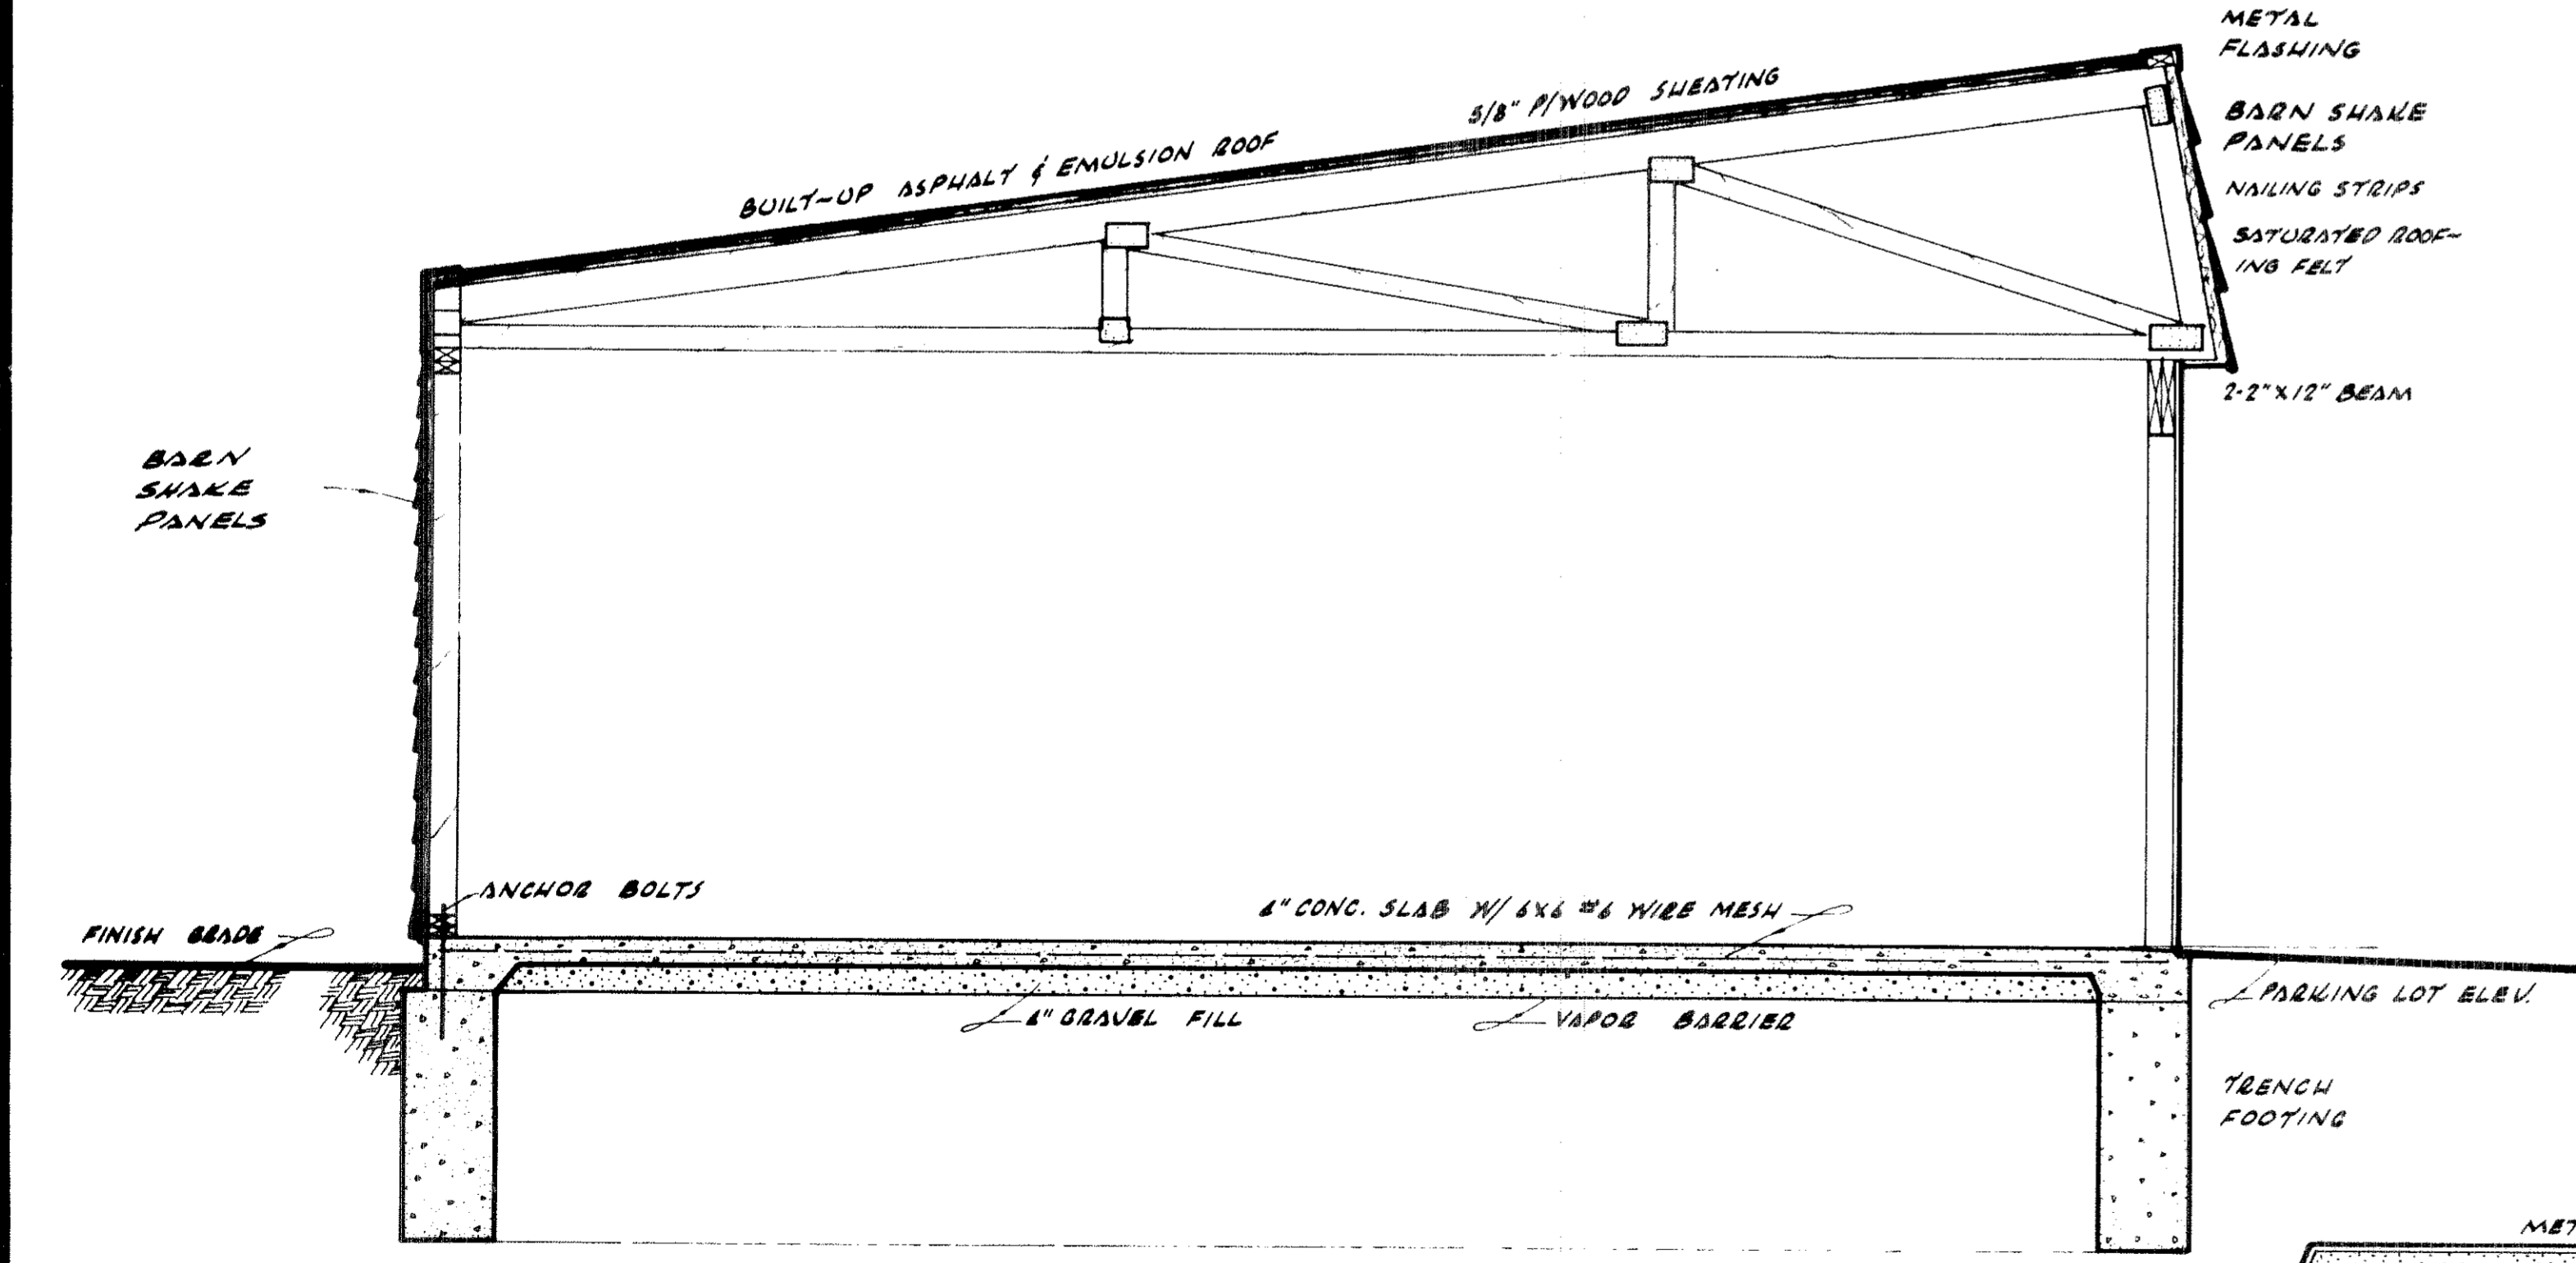


**CROSS-SECTION OF GARAGE**

SCALE: 3/2" = 1'-0"

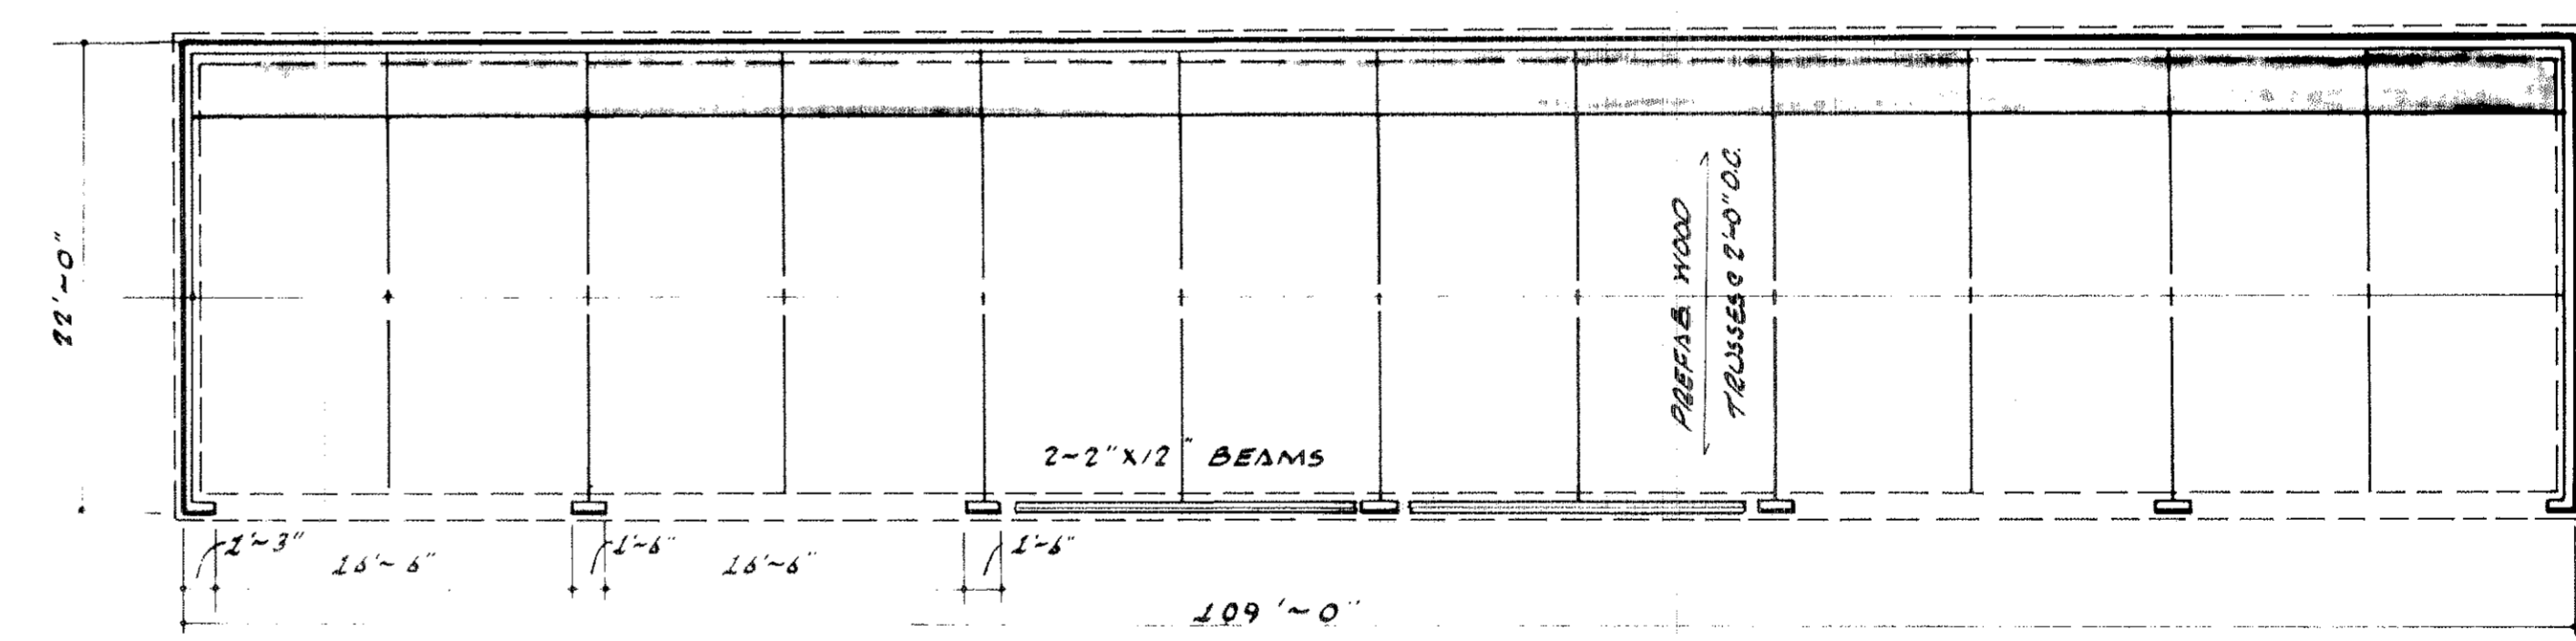


**FLOOR PLAN OF GARAGE**

SCALE: 1/8" = 1'-0"

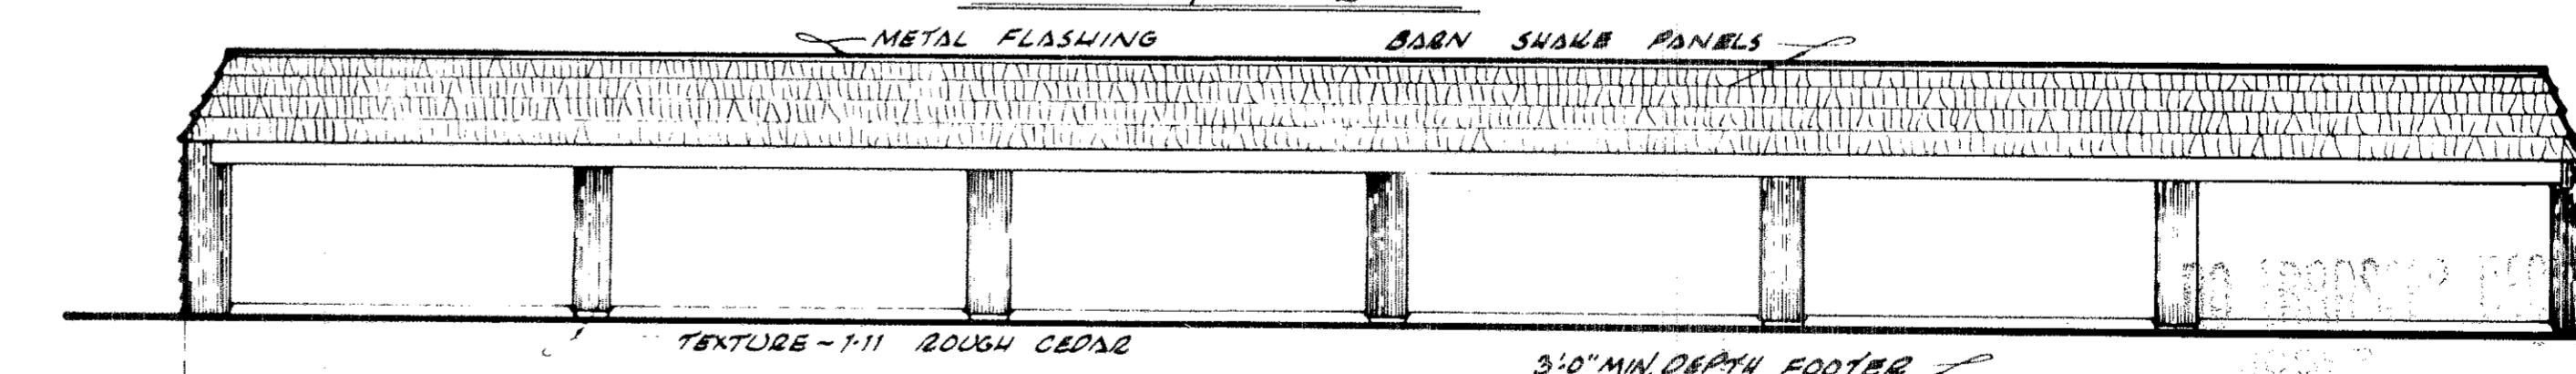

**NORTH ELEVATION ~ GARAGE**

SCALE: 1/8" = 1'-0"

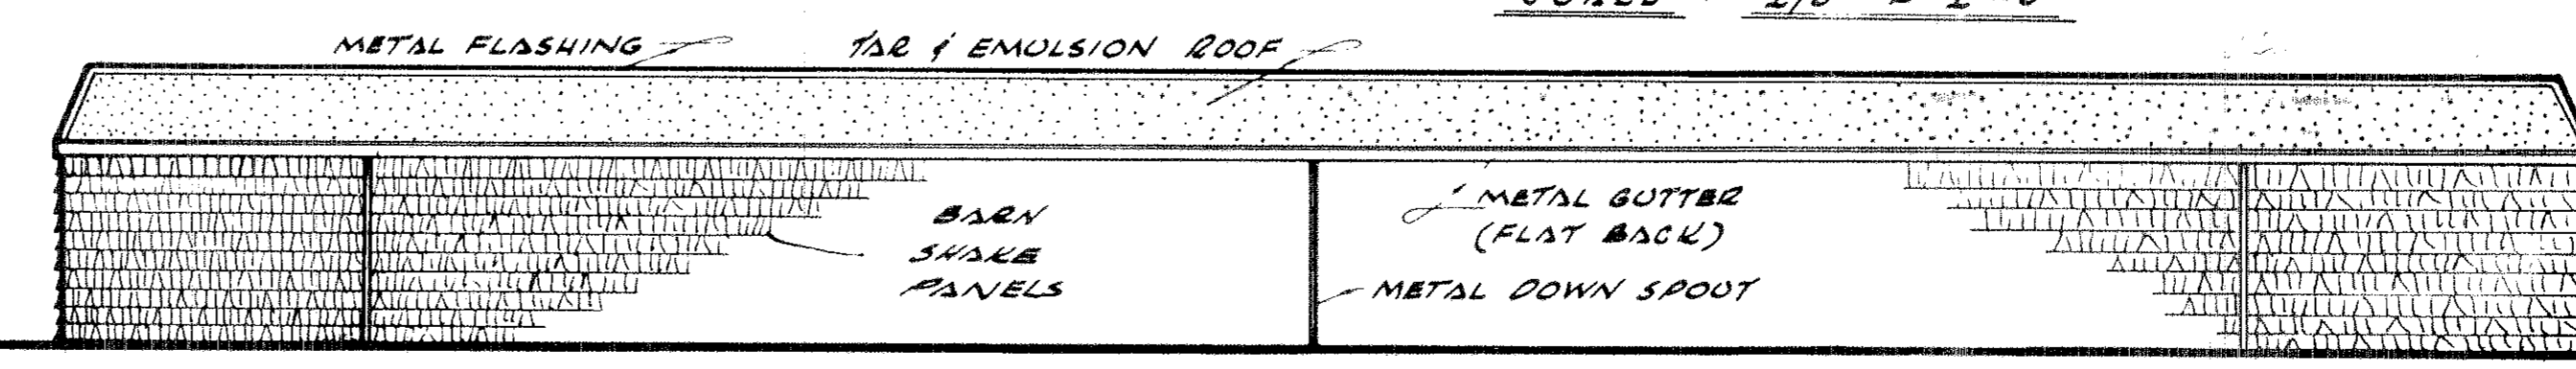

**SOUTH ELEVATION ~ GARAGE**

SCALE: 1/8" = 1'-0"


**STATEMENT OF CERTIFICATION**  
I CERTIFY THAT THE ATTACHED DRAWINGS CORRECTLY REPRESENT THE BUILDINGS AS CONSTRUCTED AND THAT THERE ARE NO ENCROACHMENTS ON ANY ADJUTING PREMISES.

*Andre B. Buehler*  
**ANDRE B. BUEHLER**  
REGISTERED ARCHITECT

**NO TRANSFER NECESSARY**  
JOSEPH J. MITOCK  
LORAIN COUNTY AUDITOR  
DEPUTY

"LAVESIDE 62" CONDOMINIUM - PREPARED FOR ERIE SHORES DEVELOPMENT CO.		SECTION VIEWS AND BUILDING ELEVATIONS	JOB NO. 70-175
SCALE: AS SHOWN	DATE: NOV. 1970	PREPARED BY <b>JAMES H. SCHMIDT</b>	SHEET NO. 4 OF 6
DRAWN L. J. ...	CHECKED L. J. ...	REGISTERED SURVEYOR OHIO	

02-02-021

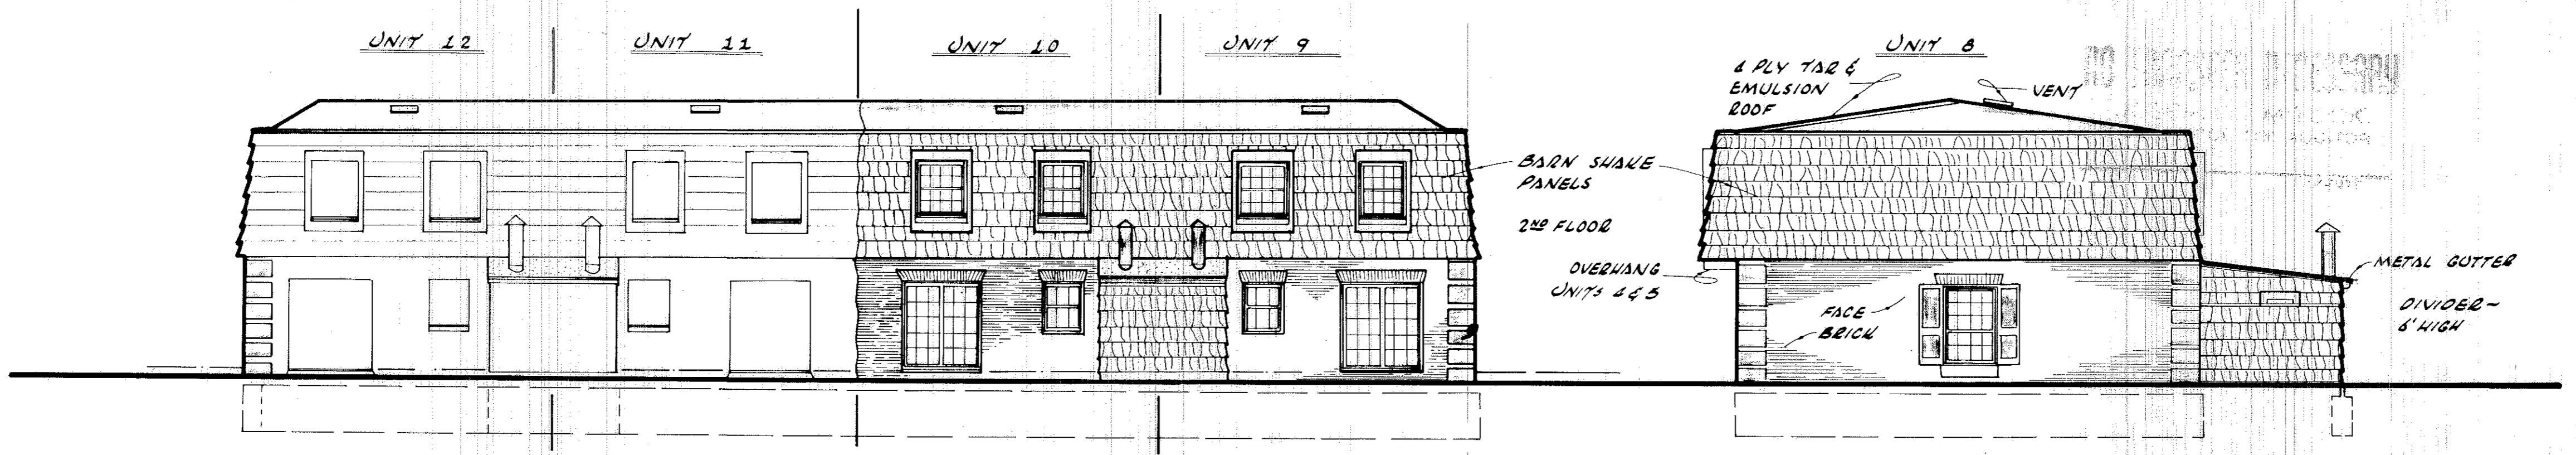


ELEVATION NO. 1


ELEVATION NO. 5




ELEVATION NO. 2

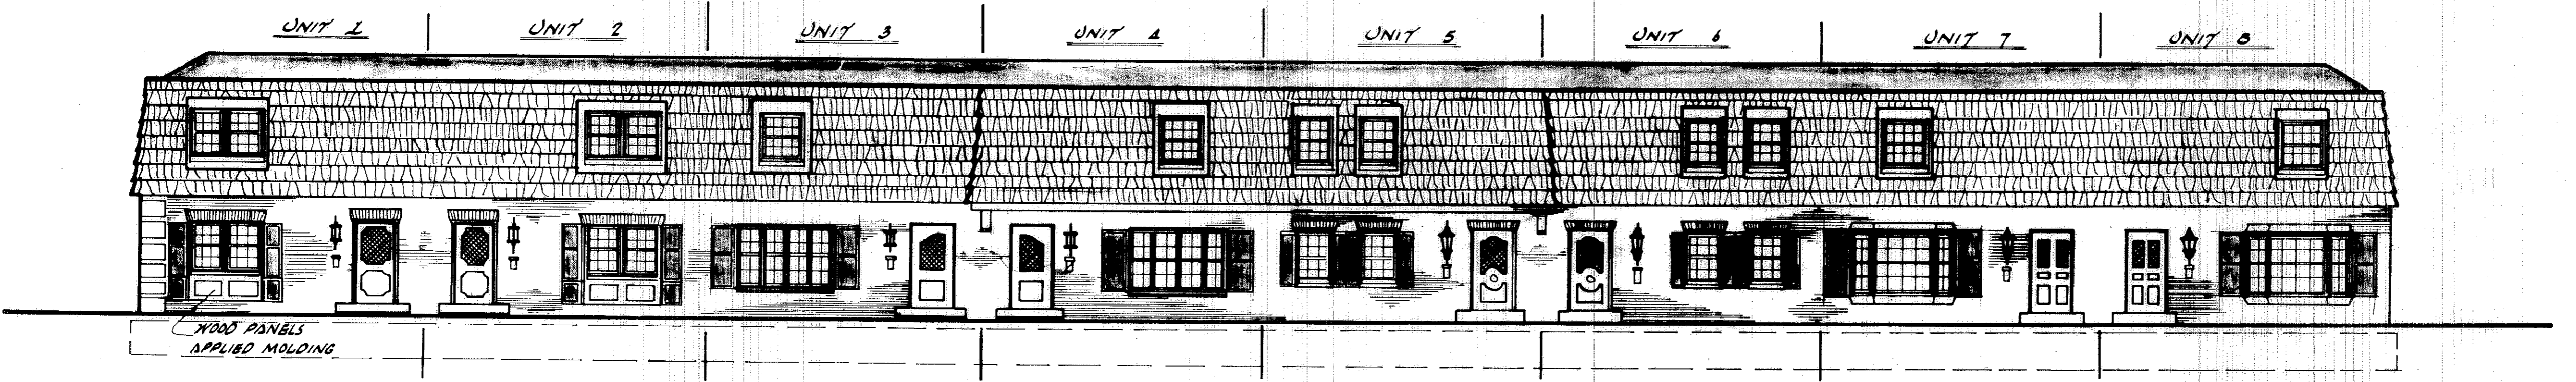

ELEVATION NO. 3

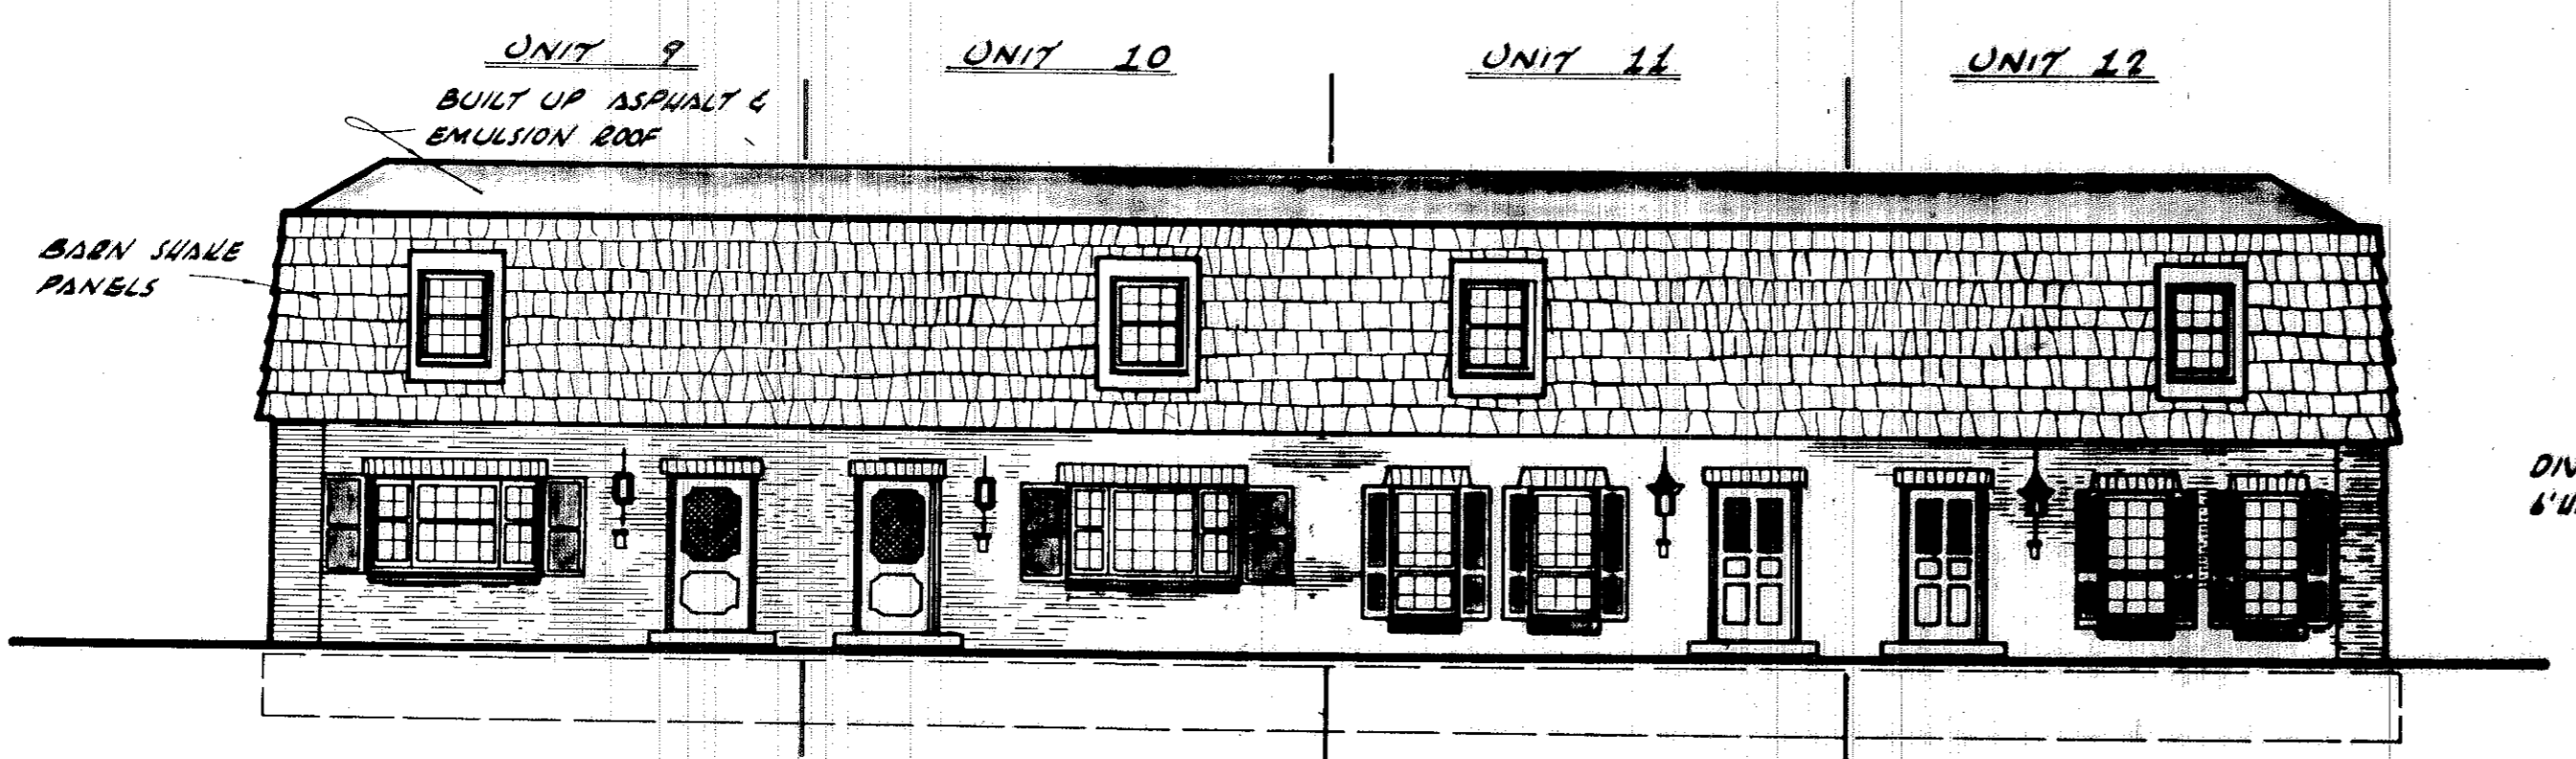

ELEVATION NO. 4

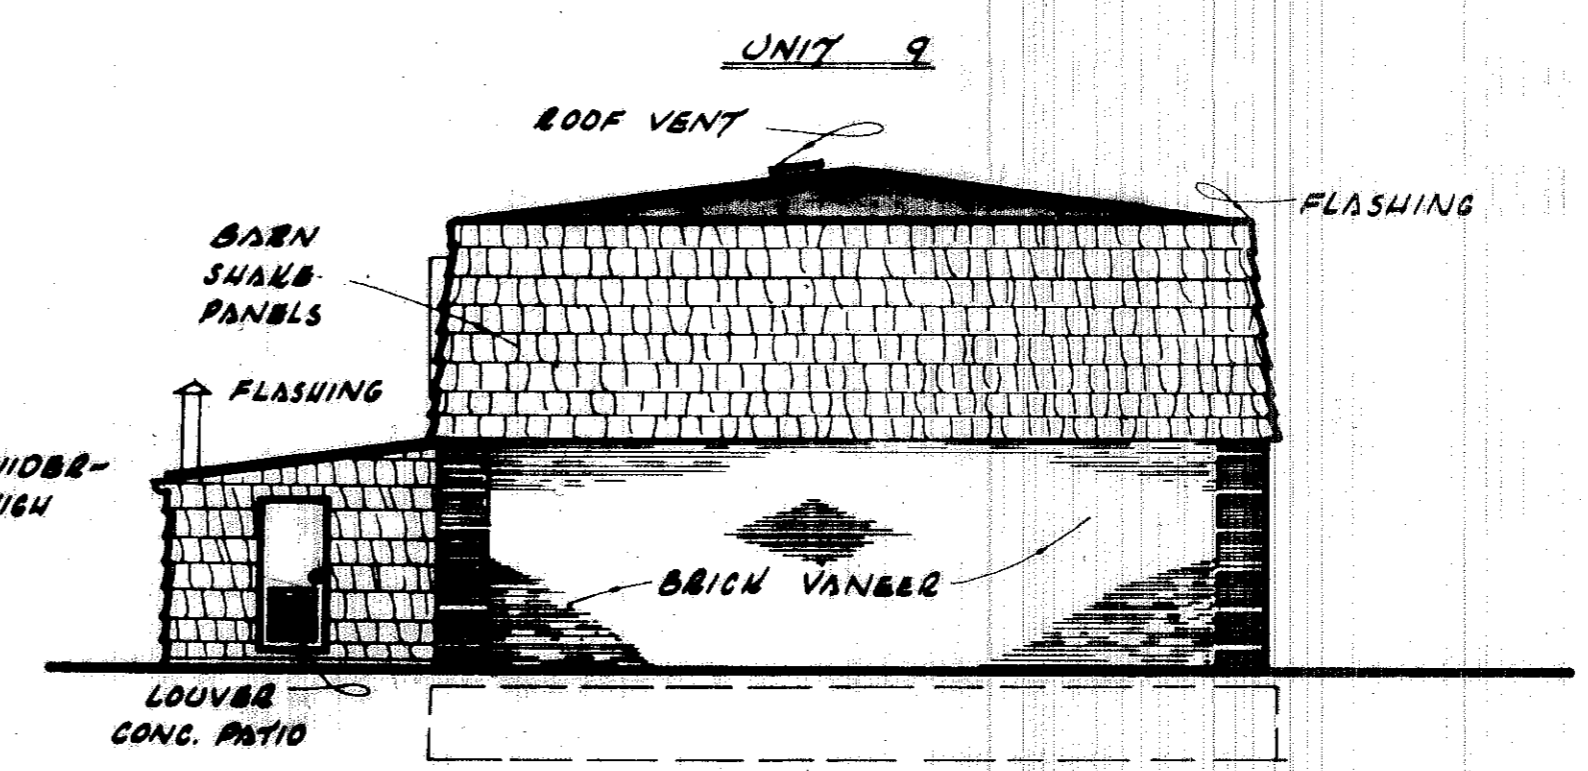

ELEVATION NO. 6

NOTICE OF CERTIFICATION

I HEREBY CERTIFY THAT THE ATTACHED DRAWINGS CORRECTLY REPRESENT THE DIMENSIONS OF THE BUILDINGS AS CONSTRUCTED - AND THAT THERE ARE NO ENCROACHMENTS ON ANY ADJACENT PREMISES.

*James H. Schmidt*  
 JAMES H. SCHMIDT  
 REGISTERED SURVEYOR

NOTICE OF CERTIFICATION

I HEREBY CERTIFY THAT THE ATTACHED DRAWINGS CORRECTLY REPRESENT THE BUILDINGS AS CONSTRUCTED - AND THAT THERE ARE NO ENCROACHMENTS ON ANY ADJACENT PREMISES.

*Andree B. Schuler*  
 ANDREE B. SCHULER  
 REGISTERED ARCHITECT

NO TRANSFER NECESSARY  
 JOSEPH J. MITOCK  
 LORAIN COUNTY AUDITOR  
*Daniel C. Hall*  
 DEPUTY  
 10/2/72

"LAKESIDE - 62" CONDOMINIUM - PREPARED FOR ERIC SHORES DEVELOPMENT CO		BUILDING ELEVATIONS		JOB NO. 70-178
SCALE: 1/8" = 1'-0"	DATE: NOV. 1970	PREPARED BY JAMES H. SCHMIDT		SHEET NO. 5
DRAWN: L. G. J.	CHECKED:	REGISTERED SURVEYOR ELYRIA, OHIO		OF 6

**NOTICE OF CERTIFICATION**

I HEREBY CERTIFY THAT THE ATTACHED DRAWINGS CORRECTLY REPRESENT THE DIMENSIONS OF THE BUILDINGS AS CONSTRUCTED - AND THAT THERE ARE NO ENCROACHMENTS ON ANY ADJACENT PREMISES.

*James H. Schmidt*  
**JAMES H. SCHMIDT**  
 REGISTERED SURVEYOR

**NOTICE OF CERTIFICATION**

I HEREBY CERTIFY THAT THE ATTACHED DRAWINGS CORRECTLY REPRESENT THE BUILDINGS AS CONSTRUCTED AND THAT THERE ARE NO ENCROACHMENTS ON ANY ADJACENT PREMISES.

**NO TRANSFER NECESSARY**  
**JOSEPH J. MITOCK**  
 LORAIN COUNTY AUDITOR  
*David C. Knecht*  
 DEPUTY

*Andros B. Boehler*  
**ANDROS B. BOEHLER**  
 REGISTERED ARCHITECT

**SCHEDULE "K"**


UNIT NO.	DIMENSION
1	4'-7 3/4"
2	4'-7 1/4"
3	4'-8 1/4"
4	4'-8 1/4"
5	4'-7 3/8"
6	4'-7 3/8"
7	4'-7 3/8"
8	4'-7 3/8"
9	4'-7 1/2"
10	4'-7 1/4"
11	4'-7 3/8"
12	4'-7 3/8"

**SCHEDULE "J"**

UNIT NO.	DIMENSION
1	2'-7"
2	2'-11 3/4"
3	2'-8 1/2"
4	3'-0 1/2"
5	2'-11 3/4"
6	2'-9"
7	2'-10 1/8"
8	2'-10 1/4"
9	2'-10 1/8"
10	2'-10 7/8"
11	2'-10 7/8"
12	2'-10 1/4"

**SCHEDULE "I"**

UNIT NO.	DIMENSION
1	6'-0 1/4"
2	6'-3"
3	6'-3"
4	6'-2 1/4"
5	6'-2 1/4"
6	6'-3 1/4"
7	6'-3 1/4"
8	6'-0"
9	6'-0"
10	6'-3 1/2"
11	6'-3 1/2"
12	6'-0"

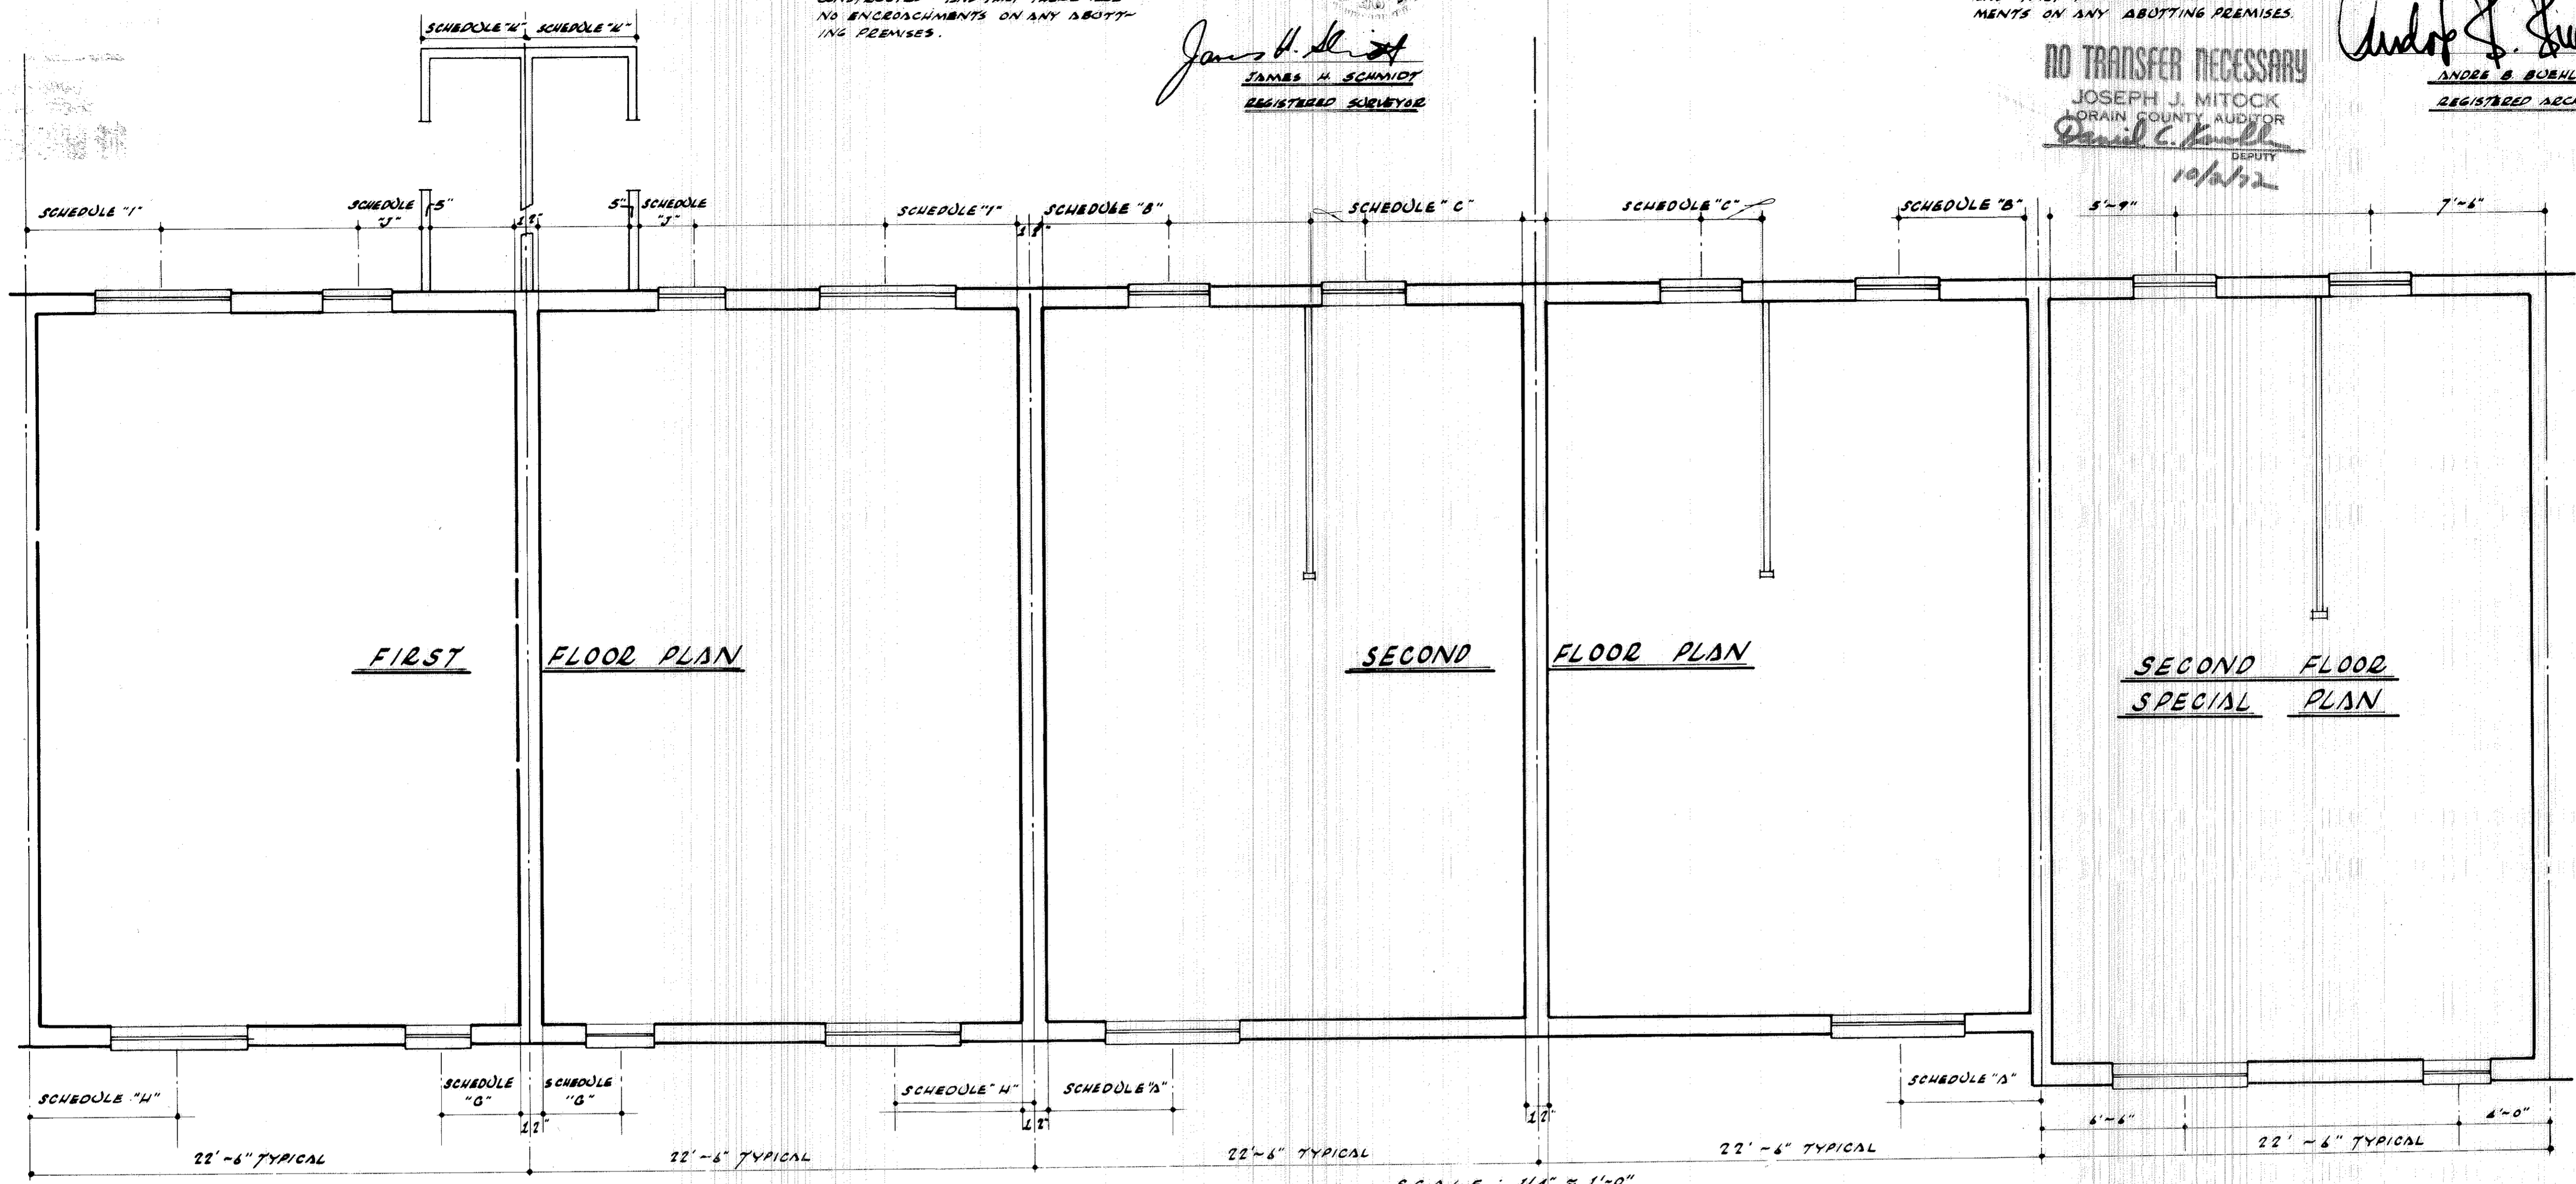

SCALE: 1/4" = 1'-0"

**SCHEDULE "A"**

UNIT NO.	DIMENSION
1	6'-0 1/8"
2	6'-2 1/4"
3	6'-0 7/8"
4	5'-5 1/8"
5	SEE DETAIL BELOW
6	SEE DETAIL BELOW
7	6'-0"
8	5'-11 3/4"
9	6'-0"
10	6'-3 1/2"
11	5'-6 5/8"
12	6'-5 1/2"

**SCHEDULE "B"**

UNIT NO.	DIMENSION
1	5'-8 3/4"
2	5'-9 1/2"
3	5'-9"
4	5'-8 1/2"
5	5'-7 3/4"
6	5'-9 1/2"
7	5'-8 7/8"
8	5'-9"
9	5'-9"
10	5'-9 1/2"
11	5'-8 1/2"
12	5'-8 5/8"

**SCHEDULE "C"**

UNIT NO.	DIMENSION
1	2'-4"
2	2'-4 3/4"
3	2'-4"
4	2'-3 1/4"
5	2'-2 3/4"
6	2'-4 7/8"
7	2'-4 1/4"
8	2'-3 1/2"
9	2'-3 1/2"
10	2'-4 3/8"
11	2'-4 1/8"
12	2'-3 7/8"

**SCHEDULE "D"**

UNIT NO.	FIN FLOOR EL.
1	+28.88
2	+28.90
3	+28.90
4	+28.88
5	+28.88
6	+28.88
7	+28.89
8	+28.88
9	+28.87
10	+28.84
11	+28.87
12	+28.84

**SCHEDULE "E"**

UNIT NO.	PATIO EL.
1	+28.48
2	+28.47
3	+28.52
4	+28.48
5	+28.48
6	+28.48
7	+28.50
8	+28.48
9	+28.47
10	+28.44
11	+28.49
12	+28.45

**SCHEDULE "F"**



UNIT NO.	CEILING HEIGHT 1ST FLOOR	2ND FLOOR
1	8'-0"	8'-0"
2	8'-0"	8'-0"
3	8'-0"	8'-0"
4	8'-0"	8'-0"
5	8'-0"	8'-0"
6	8'-0"	8'-0"
7	8'-0"	8'-0"
8	8'-0"	8'-0"
9	8'-0"	8'-0"
10	8'-0"	8'-0"
11	8'-0"	8'-0"
12	8'-0"	8'-0"

**SCHEDULE "G"**

UNIT NO.	DIMENSION
1	3'-5 7/8"
2	3'-6 3/4"
3	3'-6 1/8"
4	3'-6 1/8"
5	3'-7 1/2"
6	3'-4 3/8"
7	3'-5 3/8"
8	3'-6 3/8"
9	3'-6"
10	3'-5 5/8"
11	3'-6"
12	3'-6 3/8"

**SCHEDULE "H"**

UNIT NO.	DIMENSION
1	6'-2 1/2"
2	6'-5 1/4"
3	6'-5 1/4"
4	SEE INSET DETAIL
5	SEE INSET DETAIL
6	SEE INSET DETAIL
7	SEE INSET DETAIL
8	6'-3 1/2"
9	6'-2 1/4"
10	SEE INSET DETAIL
11	SEE INSET DETAIL
12	6'-7 1/4"

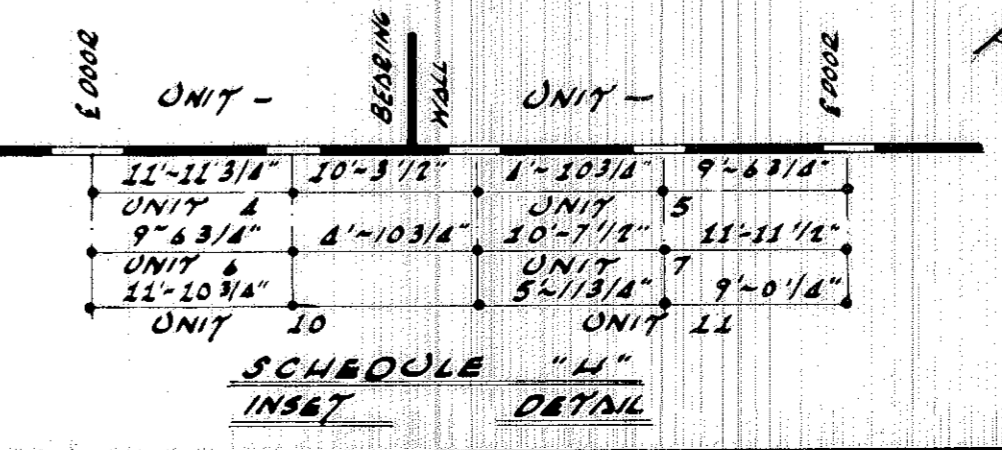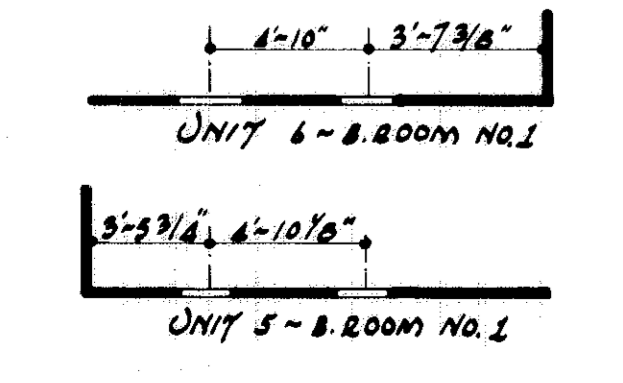

RECEIVED FOR RECORD AT 8:00 AM OCT-31-92  
 RECORDED IN LORAIN COUNTY RECORDS  
 LORAIN COUNTY RECORDER  
 LEOVA B. MITCHELL  
 25  
 26  
 27  
 28  
 29  
 30  
 See Deed Vol Page 103 68 27/30

02-02-021

**"LAKESIDE 62"**  
 CONDOMINIUM - PREPARED FOR  
 ERIC SHORES DEVELOPMENT CO.

SCALE: AS SHOWN DATE: NOV 1970  
 DRAWN: CH'LD REGISTERED SURVEYOR L. Quinn OHIO

PREPARED BY: **JAMES H. SCHMIDT**  
 REGISTERED SURVEYOR

DIMENSION SCHEDULE JOB NO. 70-175 SHEET NO. 6 OF 6