


PROPOSED SMUGGLERS COVE CONDOMINIUM COMPLEX NO. 3 PARCELS C & D

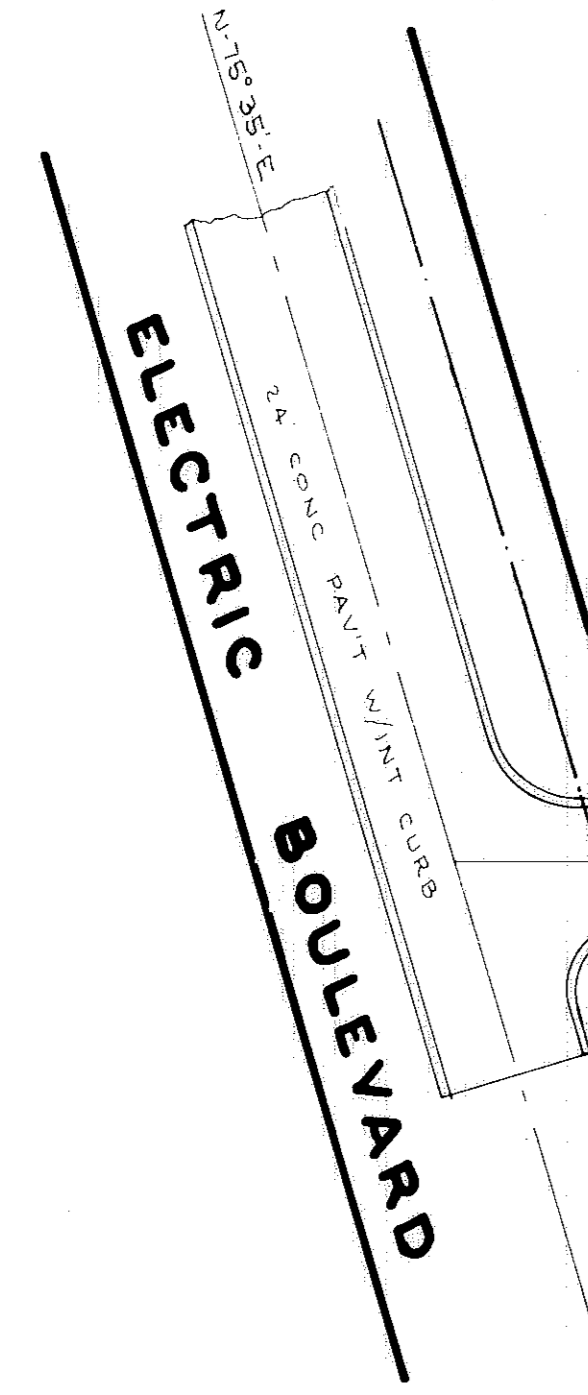

UTILITY EASEMENT AND INGRESS & EGRESS EASEMENT

NON-CONDOMINIUM ROADWAY

PROPOSED SMUGGLERS COVE CONDOMINIUM COMPLEX NO. 4 PARCELS A & B

NON-CONDOMINIUM RECREATION AREA

SMUGGLERS COVE CONDOMINIUM COMPLEX NO. 1 P.VOL. 26 PG'S 75 THRU 82 PARCELS E & F

SMUGGLERS COVE CONDOMINIUM COMPLEX NO. 2

33803 ELECTRIC BOULEVARD

SCALE: 1" = 30' SEPTEMBER, 1972

2.558 ACRES

PREPARED FOR SMUGGLERS COVE SALES CORPORATION AVON LAKE, OHIO

PREPARED BY JAMES H. SCHMIDT REGISTERED SURVEYOR 4846 ELYRIA, OHIO

EXHIBIT "A" PARCELS G & H

TRANSFERRED IN COMPLIANCE WITH SEC. 218.02 OHIO REV. CODE NOV 8 1972 *Julian A. Pajin* AUDITOR


RECEIVED FOR RECORD AT 11:07 A.M. NOV - 8 1972

RECORDED IN LORAIN COUNTY RECORDS Plate No. 27 Page 41 thru 48 Incl. LOTA B. MITCHELL Lorain County Recorder

See Deed Vol 1063/38-24 Page 147



TYPICAL FRONT ELEVATION

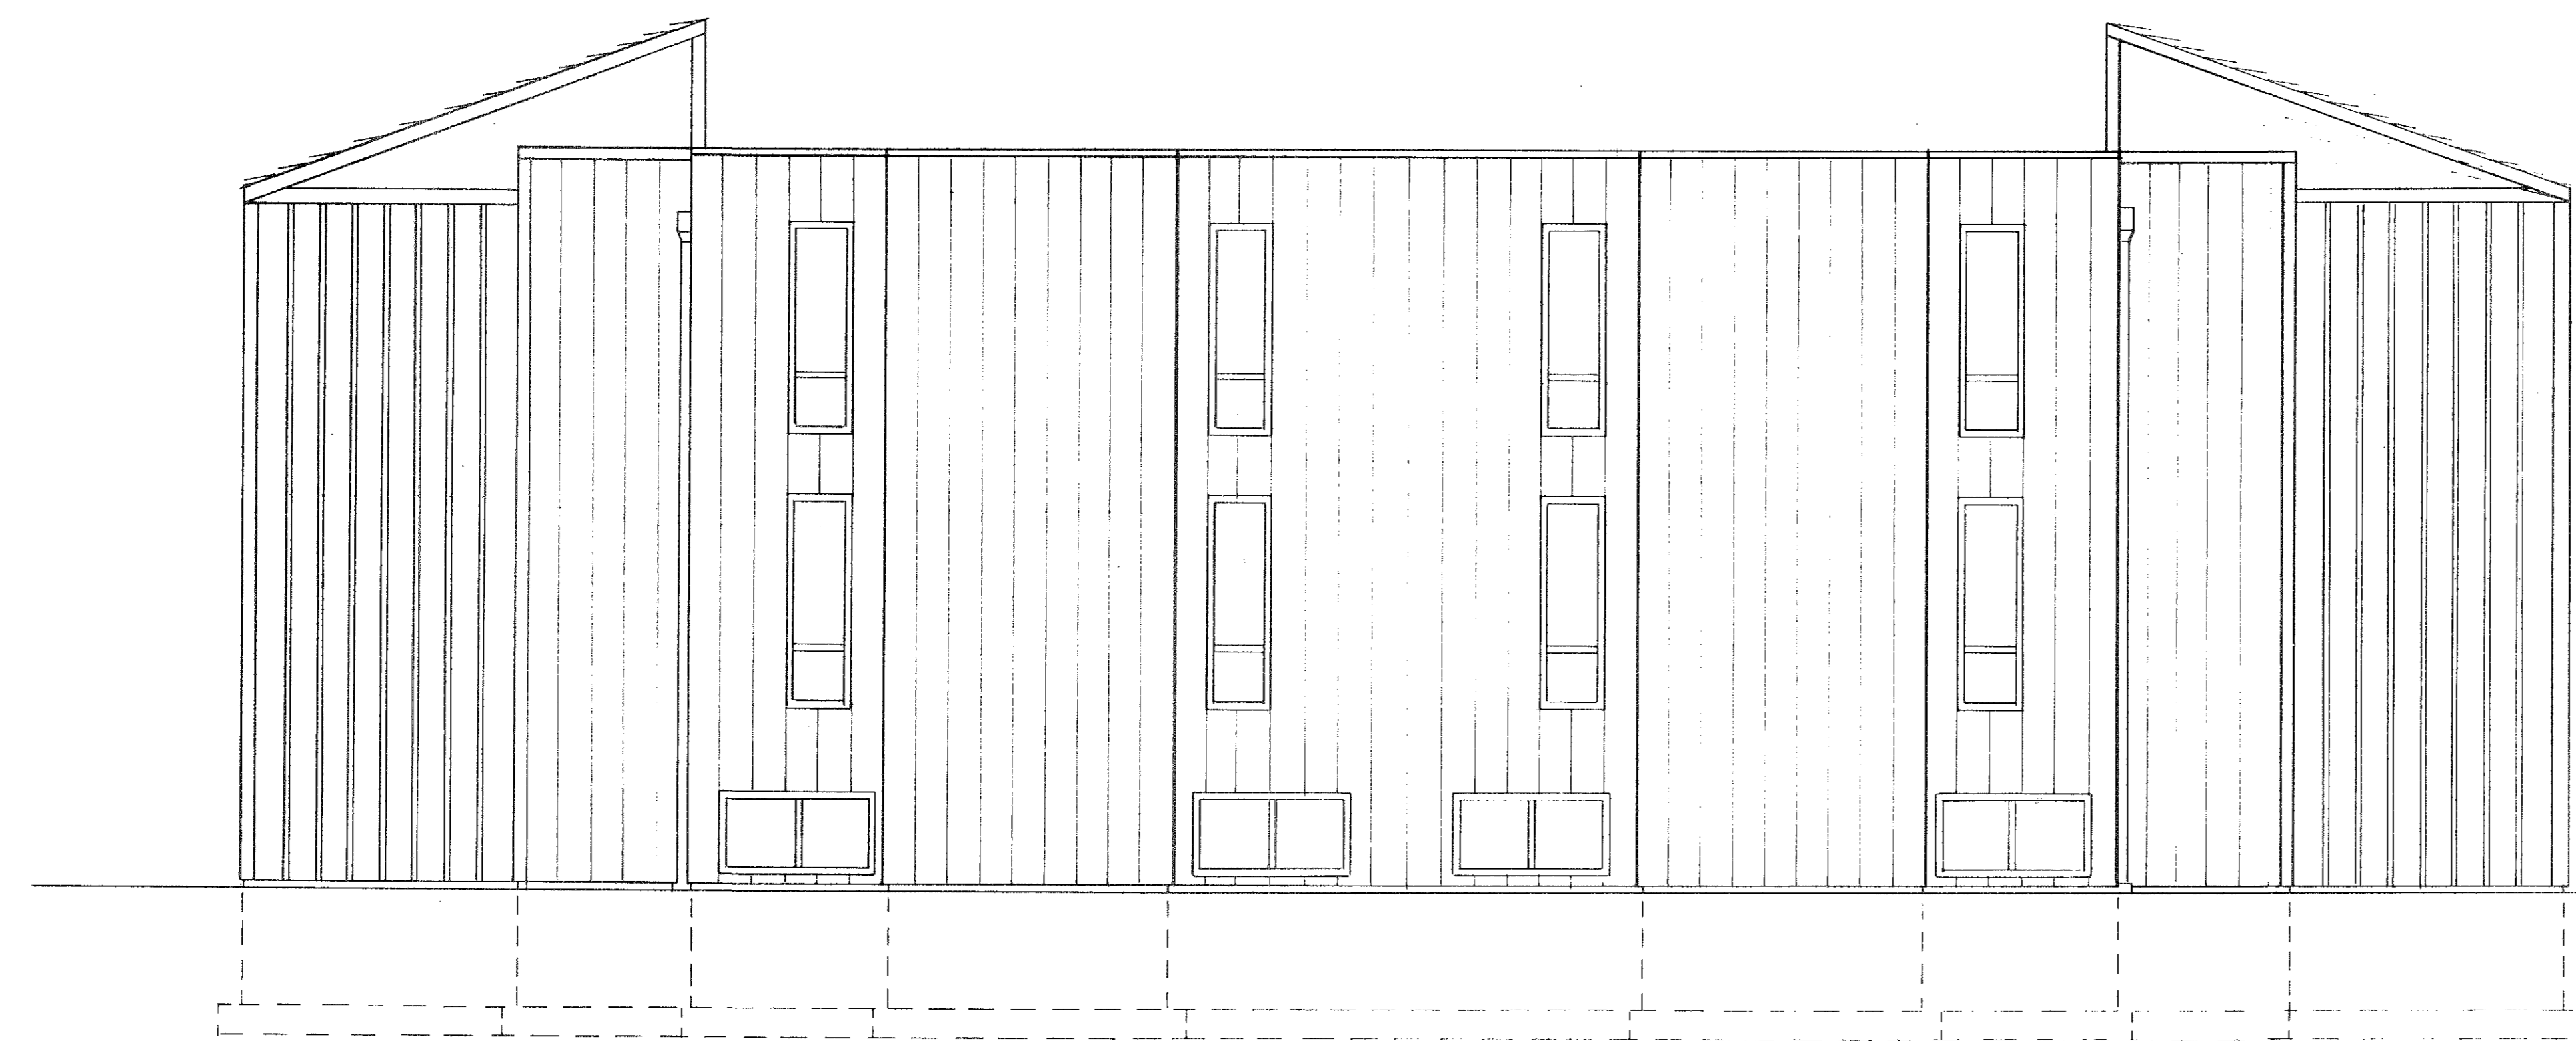

TYPICAL SIDE ELEVATION


STATEMENT OF CERTIFICATION
I CERTIFY THAT THE ATTACHED DRAWINGS CORRECTLY REPRESENT THE DIMENSIONS OF THE BUILDINGS AS CONSTRUCTED AND THAT THERE ARE NO ENCROACHMENTS ON ANY ABUTTING PREMISES.

James H. Schmidt
JAMES H. SCHMIDT
REGISTERED SURVEYOR

STATEMENT OF CERTIFICATION
I CERTIFY THAT THE ATTACHED DRAWINGS CORRECTLY REPRESENT THE DIMENSIONS OF THE BUILDINGS AS CONSTRUCTED.

W. Trout
W. TROUT
REGISTERED ARCHITECT

TRANSFERRED
IN COMPLIANCE WITH REG. 210-021
OHIO REV. CODE
NOV 8 1972
JULIAN A. PIJN
ADD 170R

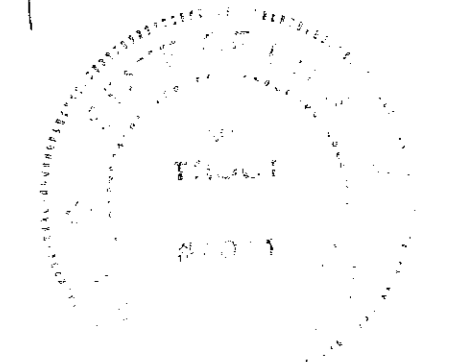

BUILDINGS G-NORTH & H-SOUTH
TYPICAL FRONT & SIDE ELEVATIONS
SMUGGLERS COVE
CONDOMINIUM COMPLEX NO. 2


SCALE: 1/4" = 1'-0" SEPTEMBER, 1972

PREPARED FOR SMUGGLERS COVE SALES CORPORATION AVON LAKE, OHIO
PREPARED BY JAMES H. SCHMIDT REGISTERED SURVEYOR ELYRIA, OHIO

STATEMENT OF CERTIFICATION

I CERTIFY THAT THE ATTACHED DRAWINGS CORRECTLY REPRESENT THE DIMENSIONS OF THE BUILDINGS AS CONSTRUCTED AND THAT THERE ARE NO ENCROACHMENTS ON ANY ADJUTING PREMISES.

James H. Schmidt
 JAMES H. SCHMIDT
 REGISTERED SURVEYOR

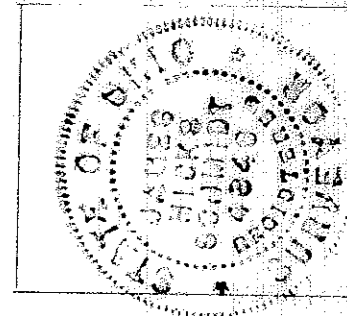

STATEMENT OF CERTIFICATION

I CERTIFY THAT THE ATTACHED DRAWINGS CORRECTLY REPRESENT THE DIMENSIONS OF THE BUILDINGS AS CONSTRUCTED.

W. J. ...
 REGISTERED ARCHITECT

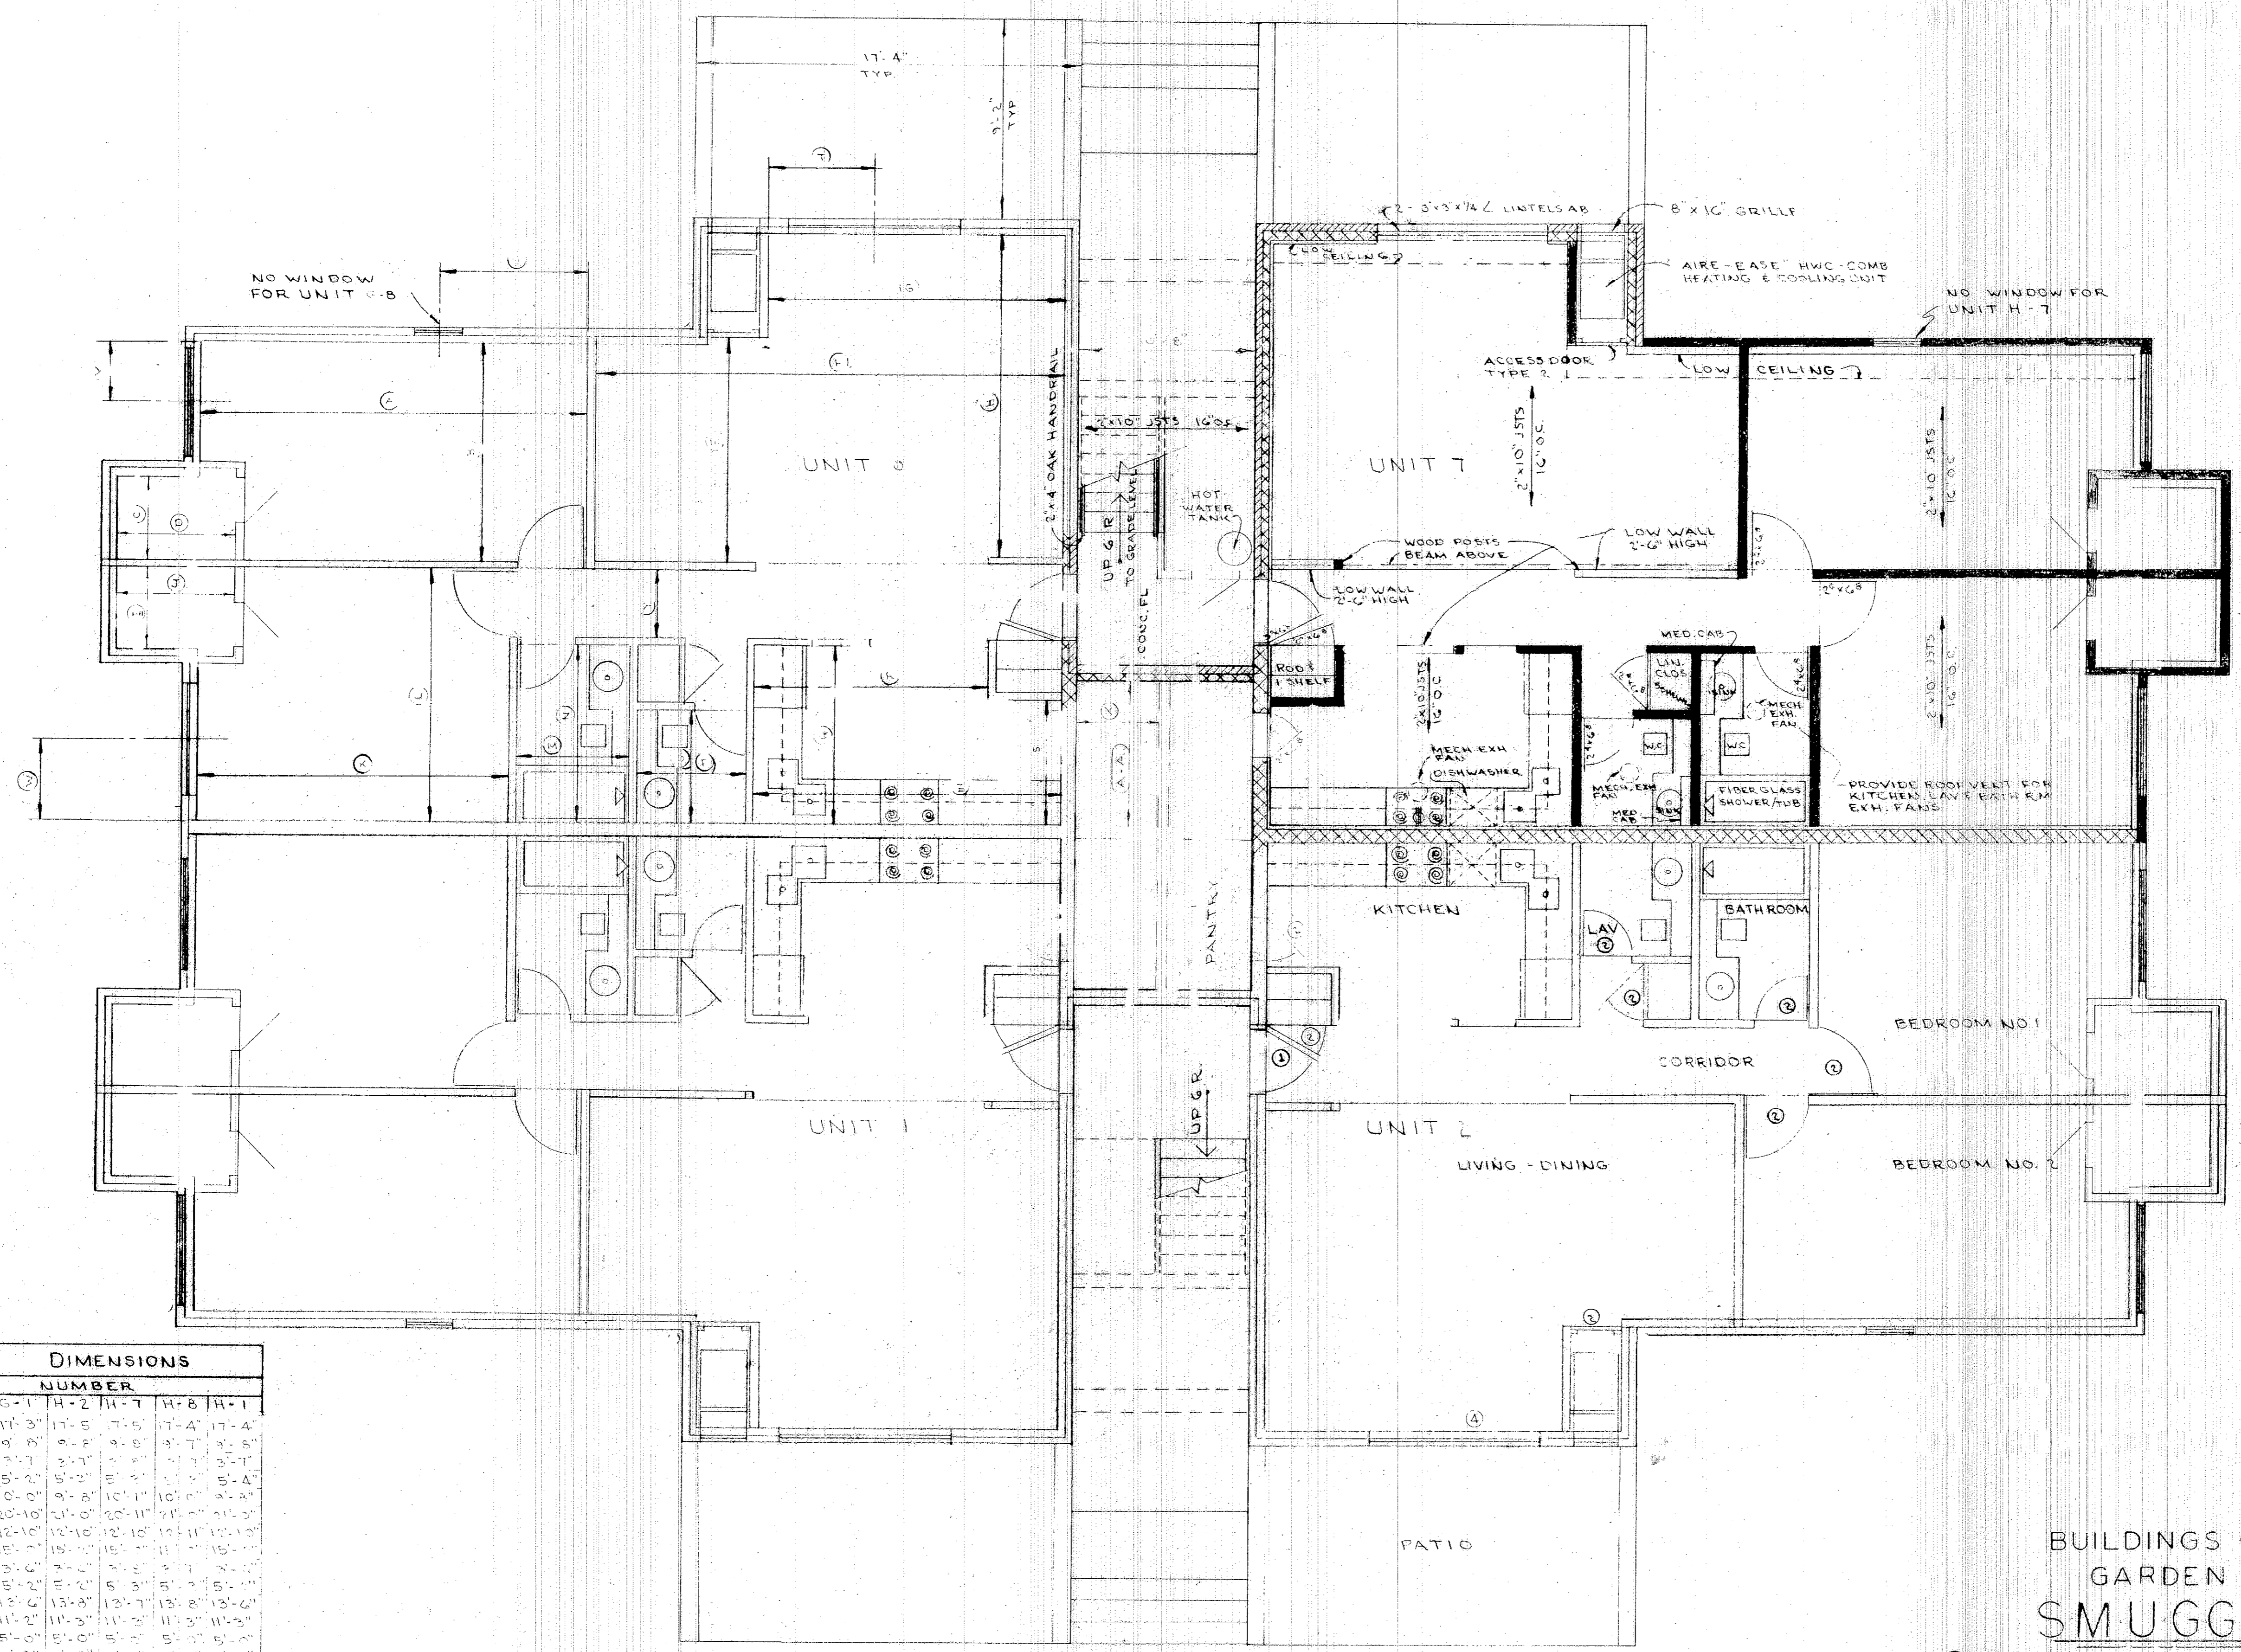
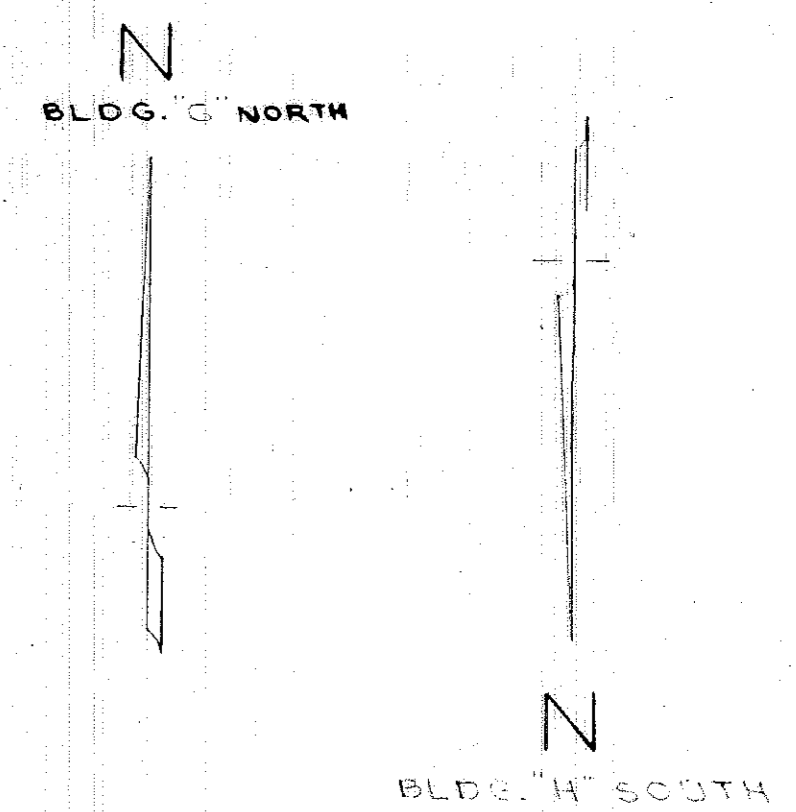
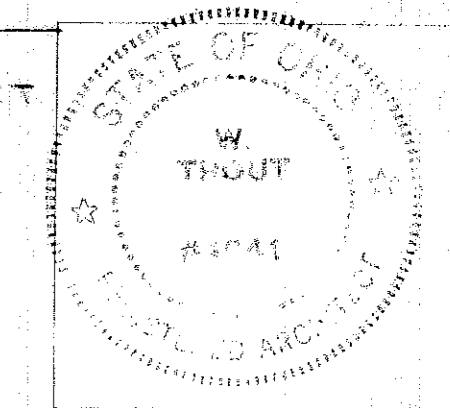


TABLE OF DIMENSIONS

DIMENSION	UNIT NUMBER							
	G-2	G-7	G-8	H-1	H-2	H-7	H-8	H-1
A	11'-2"	11'-2 1/2"	11'-3"	11'-3"	11'-5"	11'-5"	11'-4"	11'-4"
B	9'-7"	9'-7"	9'-7"	9'-8"	9'-8"	9'-8"	9'-7"	9'-8"
C	21'-1"	21'-1"	21'-1"	21'-1"	21'-1"	21'-1"	21'-1"	21'-1"
D	5'-2"	5'-2"	5'-2"	5'-2"	5'-2"	5'-2"	5'-2"	5'-2"
E	9'-11"	10'-0"	10'-0"	10'-0"	9'-8"	10'-1"	10'-0"	9'-8"
F	20'-11"	20'-10"	21'-0"	20'-10"	21'-0"	20'-11"	21'-0"	21'-0"
G	12'-10"	12'-10"	12'-10"	12'-10"	12'-10"	12'-10"	12'-10"	12'-10"
H	15'-0"	15'-0"	15'-0"	15'-0"	15'-0"	15'-0"	15'-0"	15'-0"
I	3'-7"	3'-6"	3'-6"	3'-6"	3'-6"	3'-6"	3'-7"	3'-6"
J	5'-4"	5'-3"	5'-3"	5'-2"	5'-2"	5'-3"	5'-3"	5'-1"
K	13'-7"	13'-6"	13'-7"	13'-6"	13'-8"	13'-7"	13'-8"	13'-6"
L	11'-3"	11'-2"	11'-2"	11'-2"	11'-3"	11'-3"	11'-3"	11'-2"
M	4'-11"	5'-0"	4'-11"	5'-0"	5'-0"	5'-0"	5'-0"	5'-0"
N	7'-8"	7'-8"	7'-7"	7'-7"	7'-9"	7'-9"	7'-9"	7'-9"
O	5'-4"	5'-1"	5'-1"	5'-1"	5'-2"	5'-4"	5'-2"	5'-2"
P	4'-10"	4'-10"	4'-11"	5'-0"	5'-0"	5'-1"	5'-0"	5'-0"
Q	7'-5"	7'-5"	7'-5"	7'-5 1/2"	7'-6"	7'-6"	7'-6"	7'-4 1/2"
R	9'-11"	9'-11"	9'-10"	9'-10"	9'-10"	9'-9"	9'-9"	9'-10"
S	4'-7"	4'-7"	4'-7"	4'-7"	4'-11"	4'-10"	4'-11"	4'-11"
T	4'-4"	4'-3"	4'-3"	4'-2"	4'-2"	4'-2"	4'-2"	4'-2"
U	7'-0"	7'-0"	-	7'-0"	7'-0"	-	7'-0"	7'-0"
V	2'-4"	2'-4"	2'-5"	2'-4"	2'-9"	2'-9"	2'-10"	2'-10"
W	3'-6"	3'-7"	3'-6"	3'-6"	3'-8"	3'-8"	3'-8"	3'-6"
X	5'-1"	5'-2"	5'-2"	5'-4"	5'-4"	5'-2"	5'-2"	5'-2"
Y	3'-2"	3'-1"	3'-1"	3'-1"	3'-2"	3'-2"	3'-2"	3'-2"
Z	13'-7"	13'-7"	13'-5"	13'-5"	13'-8"	13'-8"	13'-8"	13'-8"
AA	6'-5"	6'-4"	6'-4"	6'-4"	6'-8"	6'-7"	6'-8"	6'-9"

BUILDINGS G-NORTH & H-SOUTH
 GARDEN FLOOR PLAN
 SMUGGLERS COVE
 CONDOMINIUM COMPLEX NO. 2

SCALE: 1/4"=1'-0" SEPTEMBER, 1972

PREPARED FOR SMUGGLERS COVE SALES CORPORATION AVON LAKE, OHIO
 PREPARED BY JAMES H. SCHMIDT REGISTERED SURVEYOR ELYRIA, OHIO

TRANSFERRED
 IN COMPLIANCE WITH SEC. 313.08
 OHIO REV. CODE
 NOV 8 1972 FEE: WDE
Julia P. Pij...
 AUDITOR

BLDG. G-NORTH

BLDG. H-SOUTH


TABLE OF DIMENSIONS

DIMENSION	UNIT NUMBER				
	G-4	G-7	G-10	G-11	G-12
A	15'-0"	15'-0"	15'-0"	15'-0"	15'-0"
B	20'-11"	20'-11"	20'-11"	20'-11"	20'-11"
C	12'-10"	12'-10"	12'-10"	12'-10"	12'-10"
D	10'-0"	10'-0"	10'-0"	10'-0"	10'-0"
E	17'-7"	17'-7"	17'-7"	17'-7"	17'-7"
F	9'-11"	9'-11"	9'-11"	9'-11"	9'-11"
G	4'-5"	4'-5"	4'-5"	4'-5"	4'-5"
H	5'-8"	5'-8"	5'-8"	5'-8"	5'-8"
I	3'-11"	3'-11"	3'-11"	3'-11"	3'-11"
J	5'-7"	5'-7"	5'-7"	5'-7"	5'-7"
K	2'-10"	2'-10"	2'-10"	2'-10"	2'-10"
L	14'-2"	13'-11"	13'-11"	13'-11"	13'-11"
M	5'-2"	5'-2"	5'-2"	5'-2"	5'-2"
N	11'-2"	11'-2"	11'-2"	11'-2"	11'-2"
O	4'-11"	4'-11"	4'-11"	4'-11"	4'-11"
P	7'-8"	7'-8"	7'-8"	7'-8"	7'-8"
Q	4'-10"	4'-10"	4'-10"	4'-10"	4'-10"
R	5'-2"	5'-2"	5'-2"	5'-2"	5'-2"
S	10'-0"	10'-0"	10'-0"	10'-0"	10'-0"
T	7'-5"	7'-5"	7'-5"	7'-5"	7'-5"
U	3'-2"	3'-2"	3'-2"	3'-2"	3'-2"
V	7'-0"	7'-0"	7'-0"	7'-0"	7'-0"
W	4'-0"	4'-0"	4'-0"	4'-0"	4'-0"
X	6'-5"	6'-7"	6'-6"	6'-6"	6'-7"
Y	5'-1"	5'-1"	5'-4"	5'-4"	5'-2"

1ST FLOOR 2ND FLOOR


TABLE OF DIMENSIONS

DIMENSION	UNIT NUMBER				
	H-4	H-5	H-10	H-11	H-12
A	15'-0"	14'-10"	15'-0"	15'-0"	15'-2"
B	20'-10"	20'-11"	20'-11"	20'-11"	20'-10"
C	12'-10"	12'-11"	12'-10"	12'-10"	12'-10"
D	10'-1"	10'-0"	10'-0"	10'-0"	10'-2"
E	17'-8"	17'-7"	17'-7"	17'-7"	17'-7"
F	10'-1"	9'-11"	10'-1"	10'-1"	10'-0"
G	4'-5"	4'-5"	4'-5"	4'-5"	4'-5"
H	5'-11"	5'-8"	5'-8"	5'-8"	5'-8"
I	5'-1"	5'-2"	5'-1"	5'-1"	5'-1"
J	3'-10"	3'-10"	3'-9"	3'-9"	3'-10"
K	14'-0"	14'-2"	13'-11"	14'-0"	13'-11"
L	5'-7"	5'-8"	5'-8"	5'-8"	5'-8"
M	11'-3"	11'-4"	11'-3"	11'-4"	11'-4"
N	5'-0"	5'-0"	5'-0"	5'-0"	5'-0"
O	7'-9"	7'-8"	7'-8"	7'-9"	7'-9"
P	2'-11"	2'-11"	2'-11"	2'-11"	2'-11"
Q	2'-11"	2'-11"	2'-11"	2'-11"	2'-11"
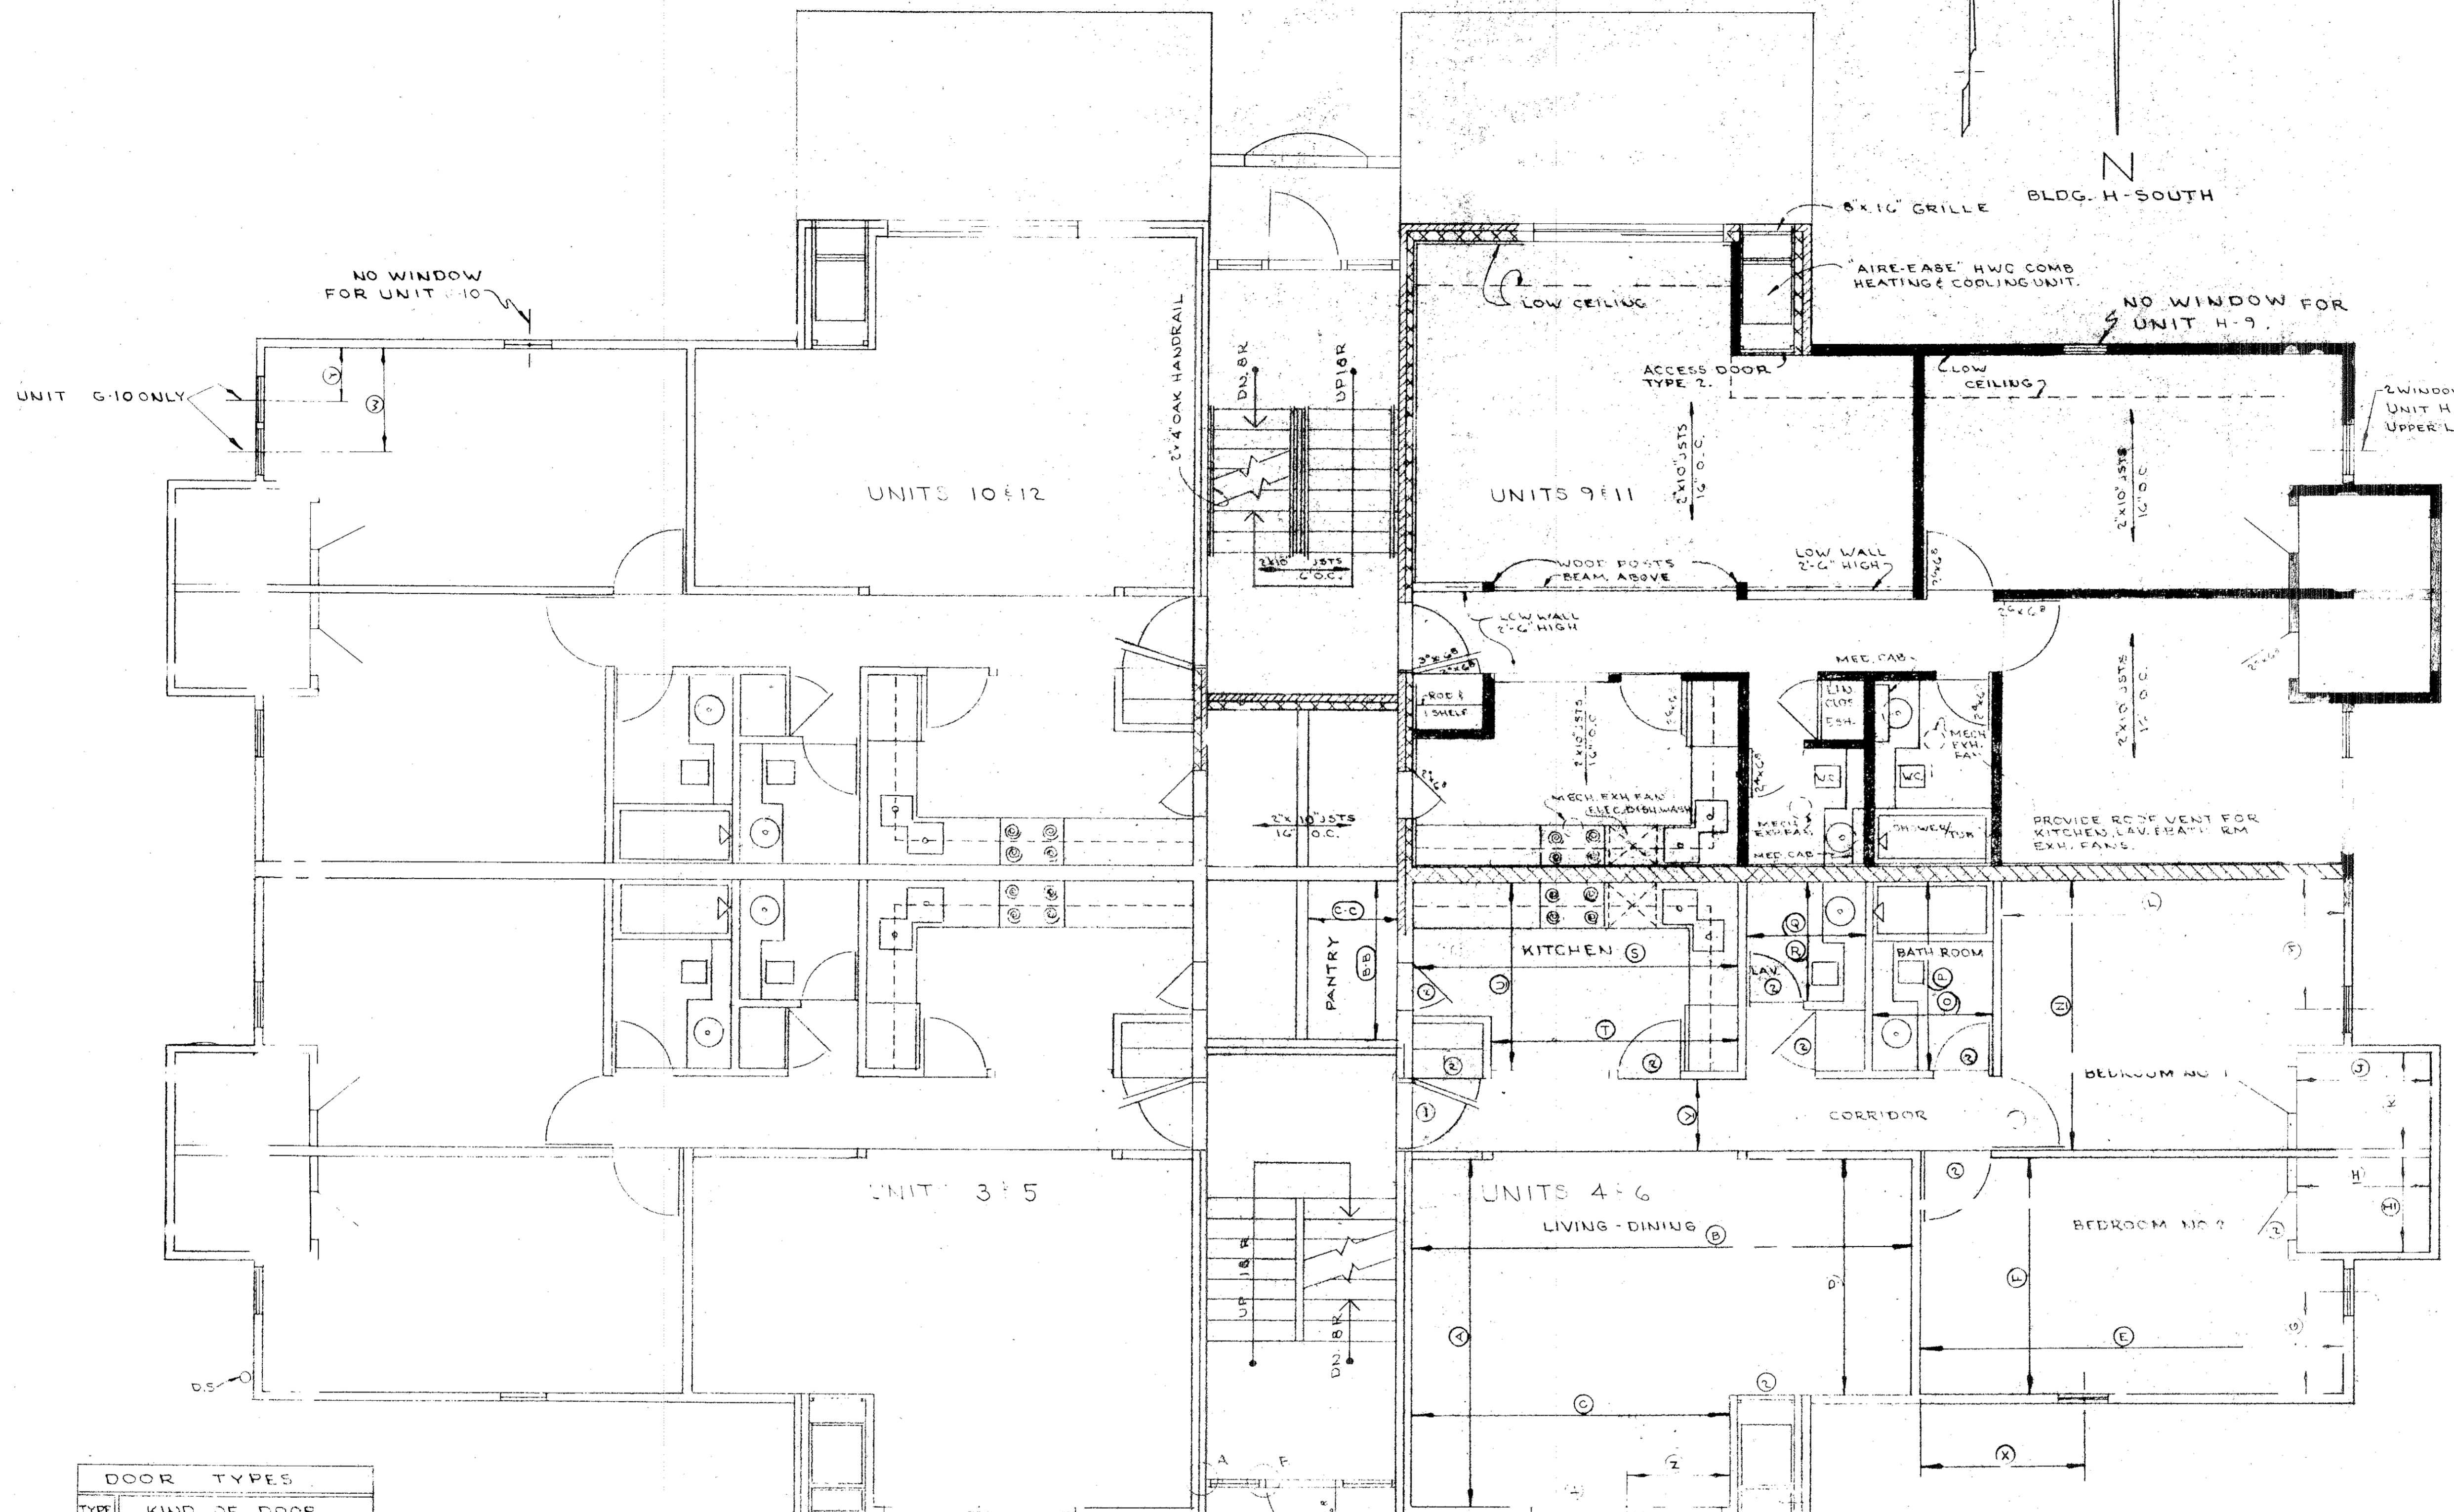

DOOR TYPES


TYPE	KIND OF DOOR
1	METAL FIREPROOF
2	PRE-HUNG HOLLOW WOOD
3	SLIDING HOLLOW WOOD
4	PLATE GLASS SLIDING
5	ACCORDIAN-PLASTIC CLOTH
6	CRACKED WOOD

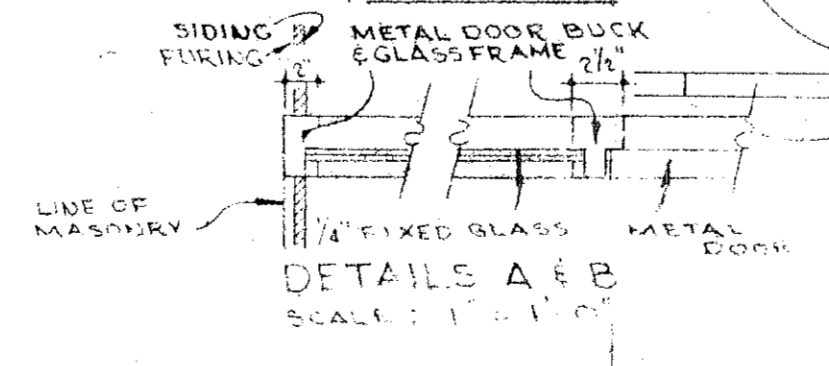

STATEMENT OF CERTIFICATION

I CERTIFY THAT THE ATTACHED DRAWINGS CORRECTLY REPRESENT THE DIMENSIONS OF THE BUILDINGS AS CONSTRUCTED AND THAT THERE ARE NO ENCROACHMENTS ON ANY ADJUTING PREMISES.

James H. Schmidt
 JAMES H. SCHMIDT
 REGISTERED SURVEYOR

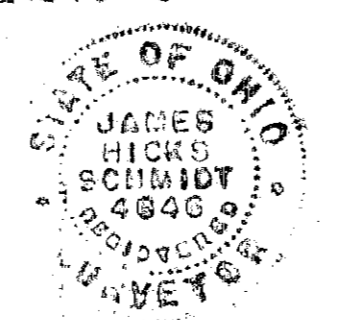


I CERTIFY THAT THE ATTACHED DRAWINGS CORRECTLY REPRESENT THE DIMENSIONS OF THE BUILDINGS AS CONSTRUCTED AND THAT THERE ARE NO ENCROACHMENTS ON ANY ADJUTING PREMISES.


BUILDINGS G-NORTH & H-SOUTH
 FIRST AND SECOND FLOOR PLAN
 SMUGGLERS COVE
 CONDOMINIUM COMPLEX, NO. 2

SCALE: 1/4" = 1'-0"
 PREPARED FOR: SMUGGLERS COVE SALES CORPORATION, AVON LAKE, OHIO
 PREPARED BY: JAMES H. SCHMIDT, REGISTERED SURVEYOR, ELYRIA, OHIO

TRANSFERRED
 IN ACCORDANCE WITH SEC. 3733.02
 OHIO REV. CODE
 NOV 8 1972
Julian A. Pijp
 AUDITOR

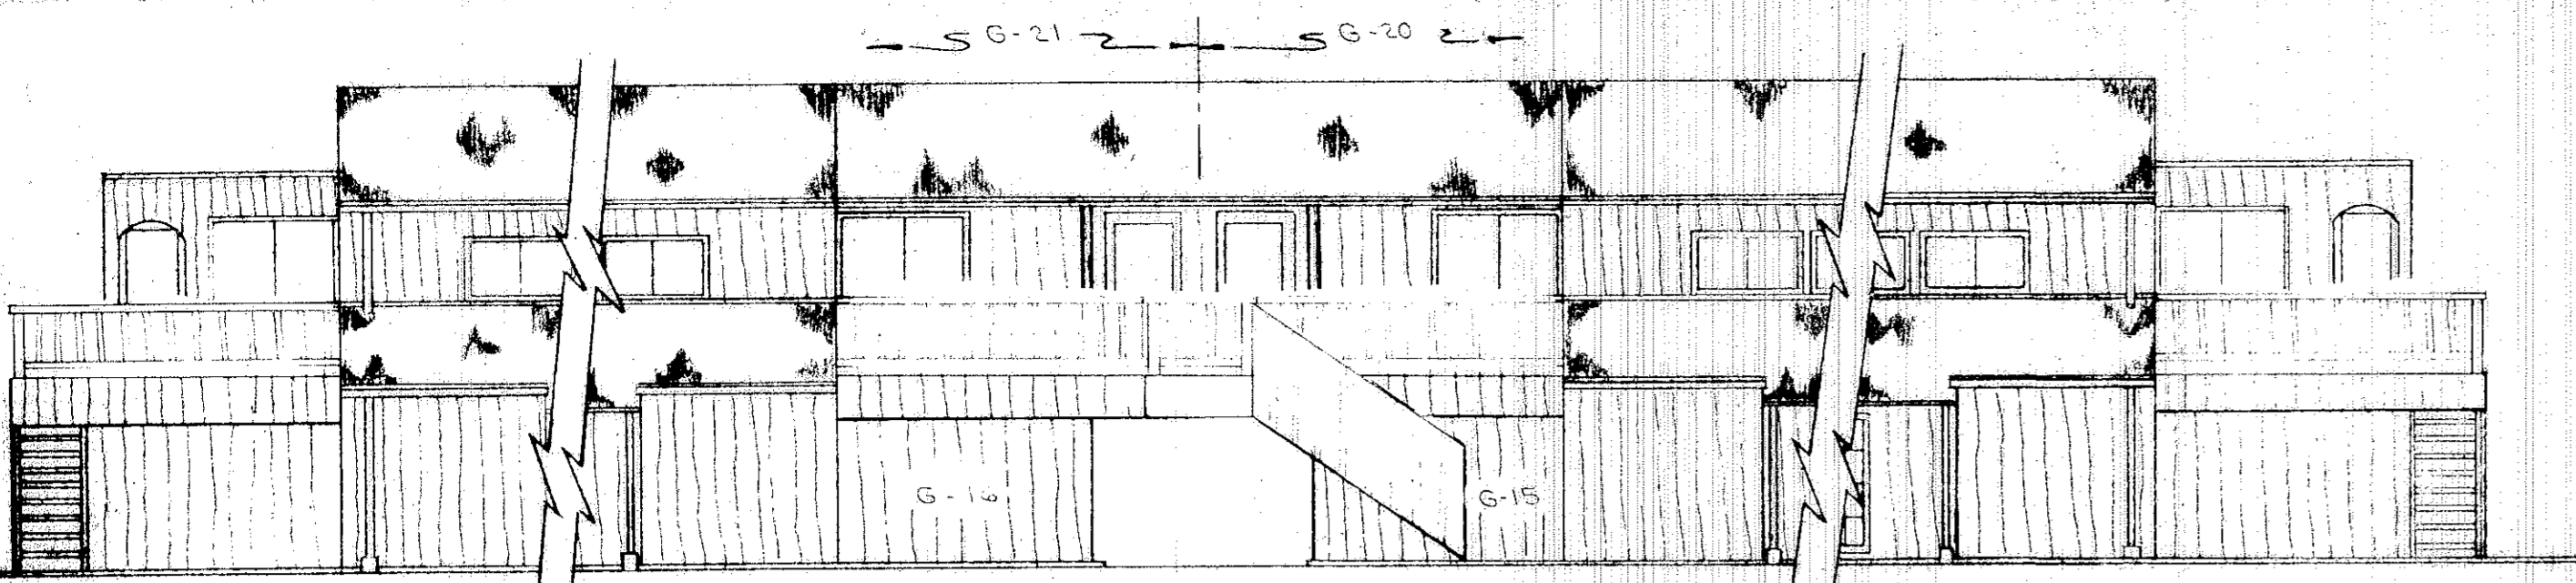



COURTYARD SIDE BLDG. "G" SOUTH
(1/8" = 1'-0")

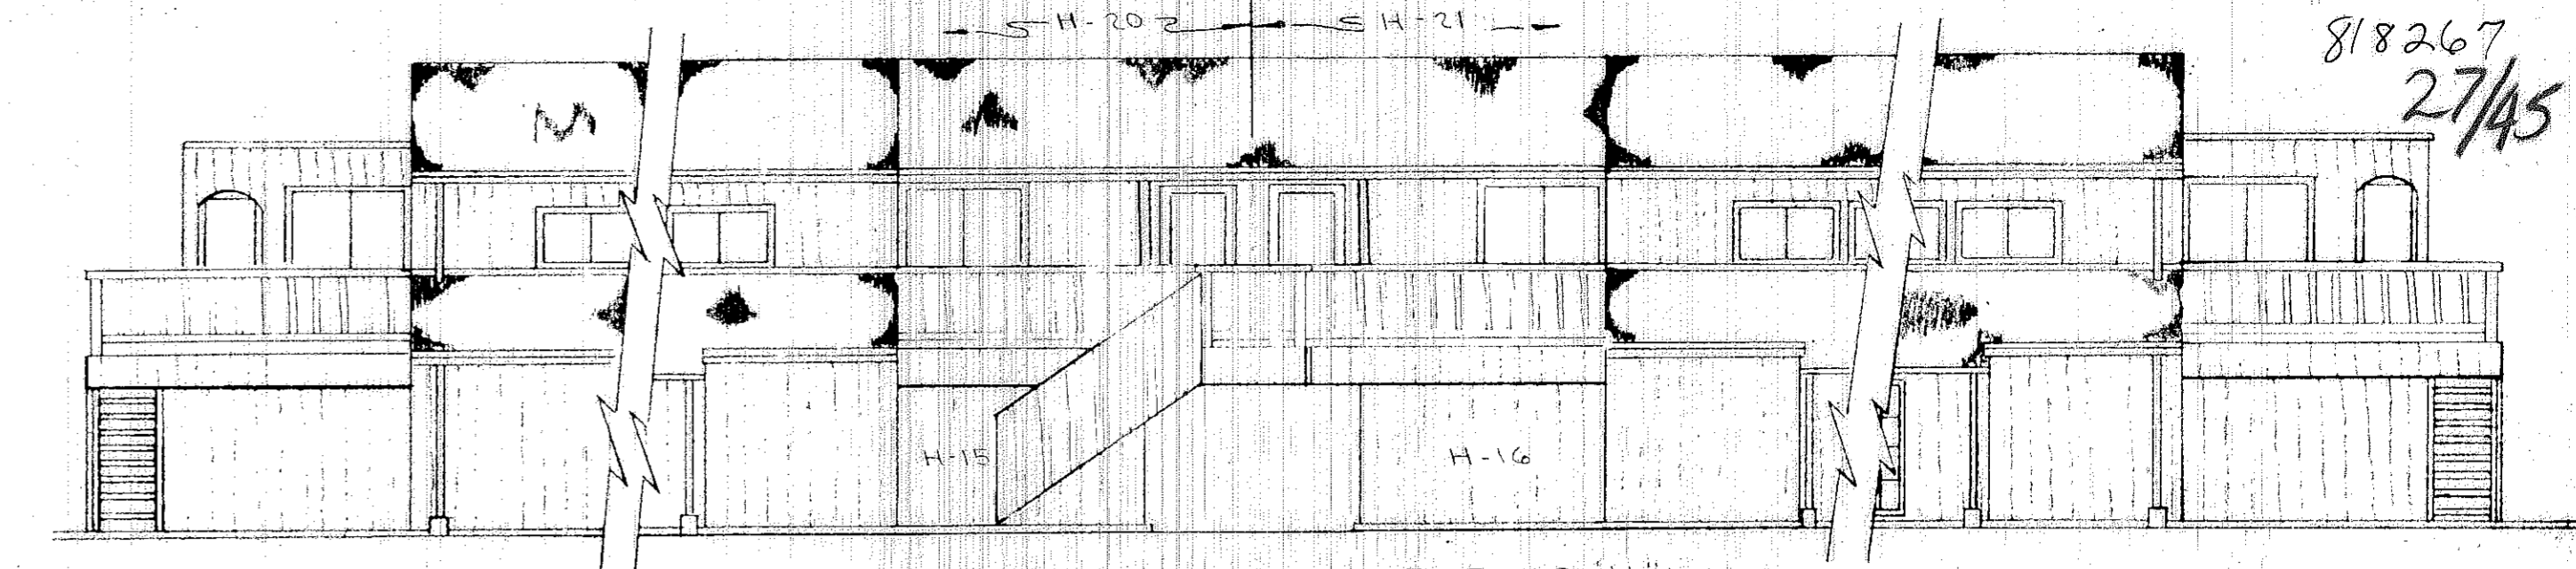

COURTYARD SIDE BLDG. "H" NORTH
(1/8" = 1'-0")

STATEMENT OF CERTIFICATION
I CERTIFY THAT THE ATTACHED DRAWINGS CORRECTLY REPRESENT THE DIMENSIONS OF THE BUILDINGS AS CONSTRUCTED AND THAT THERE ARE NO ENCROACHMENTS ON ANY ADJUTING PREMISES.



James H. Schmidt
JAMES H. SCHMIDT
REGISTERED SURVEYOR

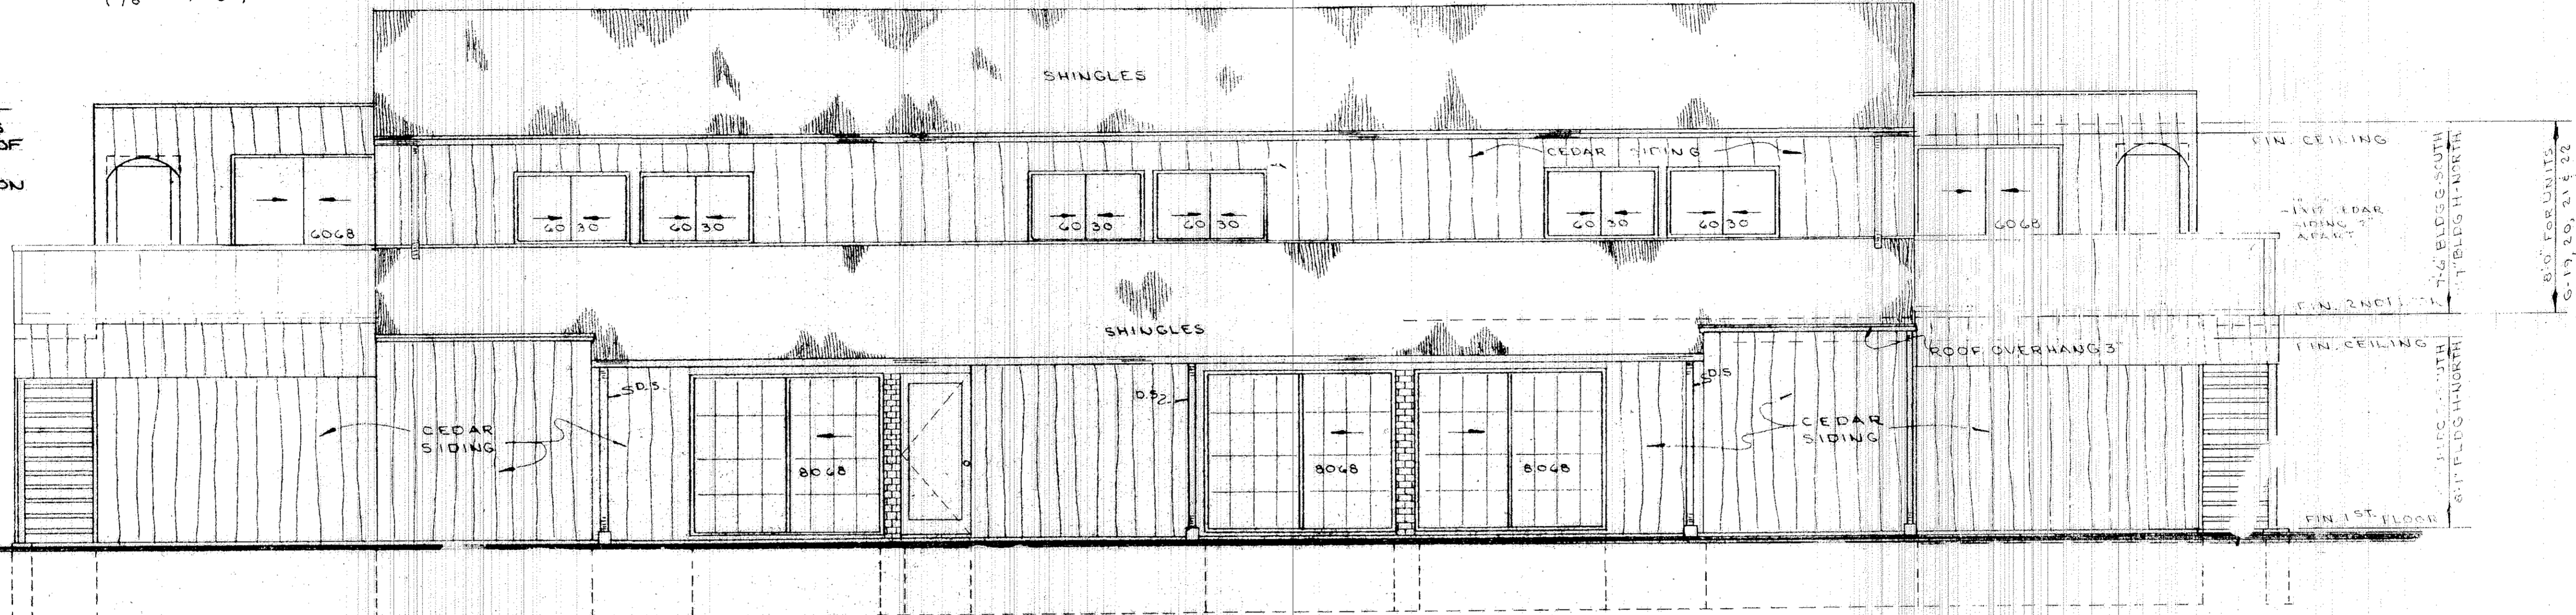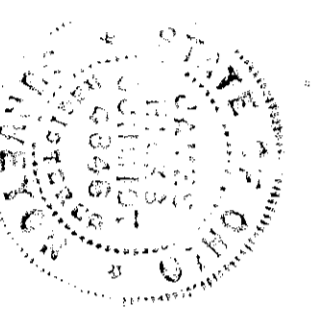


COURTYARD SIDE ELEVATION

STATEMENT OF CERTIFICATION
I CERTIFY THAT THE ATTACHED DRAWINGS CORRECTLY REPRESENT THE DIMENSIONS OF THE BUILDINGS AS CONSTRUCTED.

W. Trout
W. TROUT
REGISTERED ARCHITECT

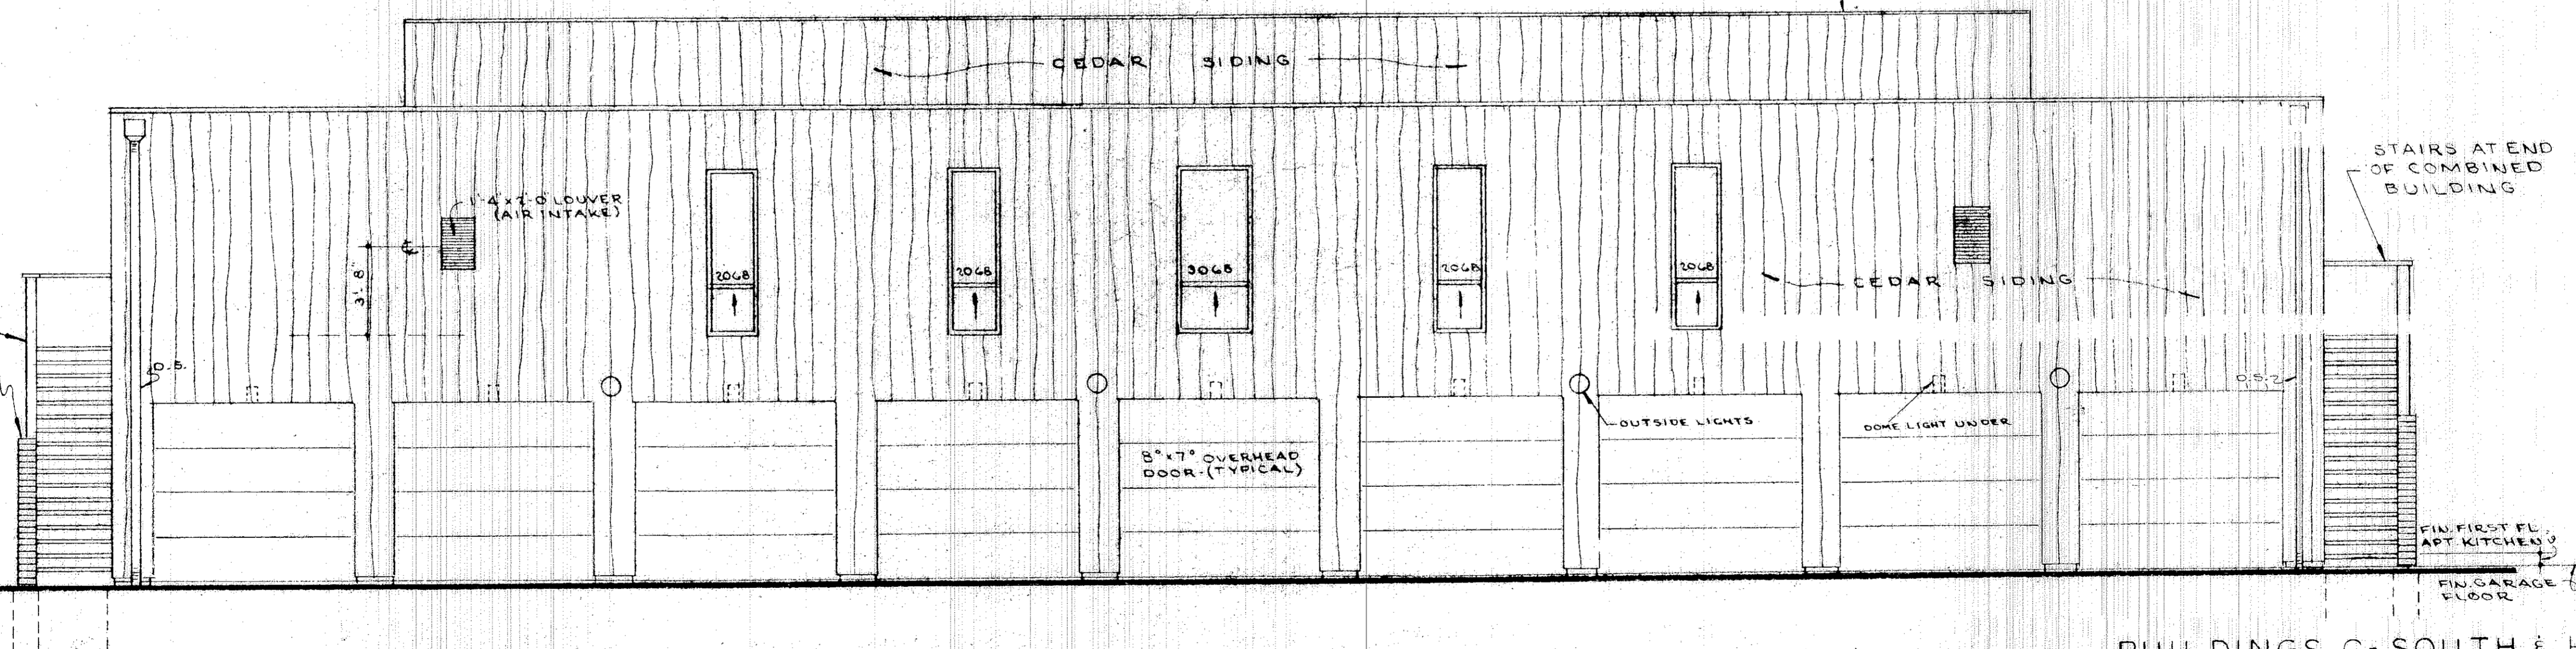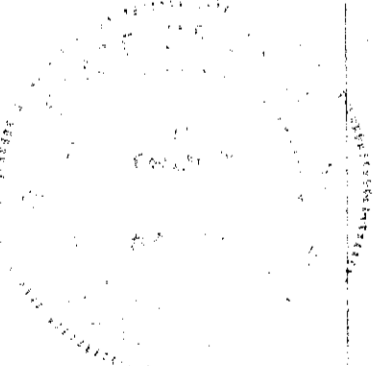

GARAGE SIDE ELEVATION

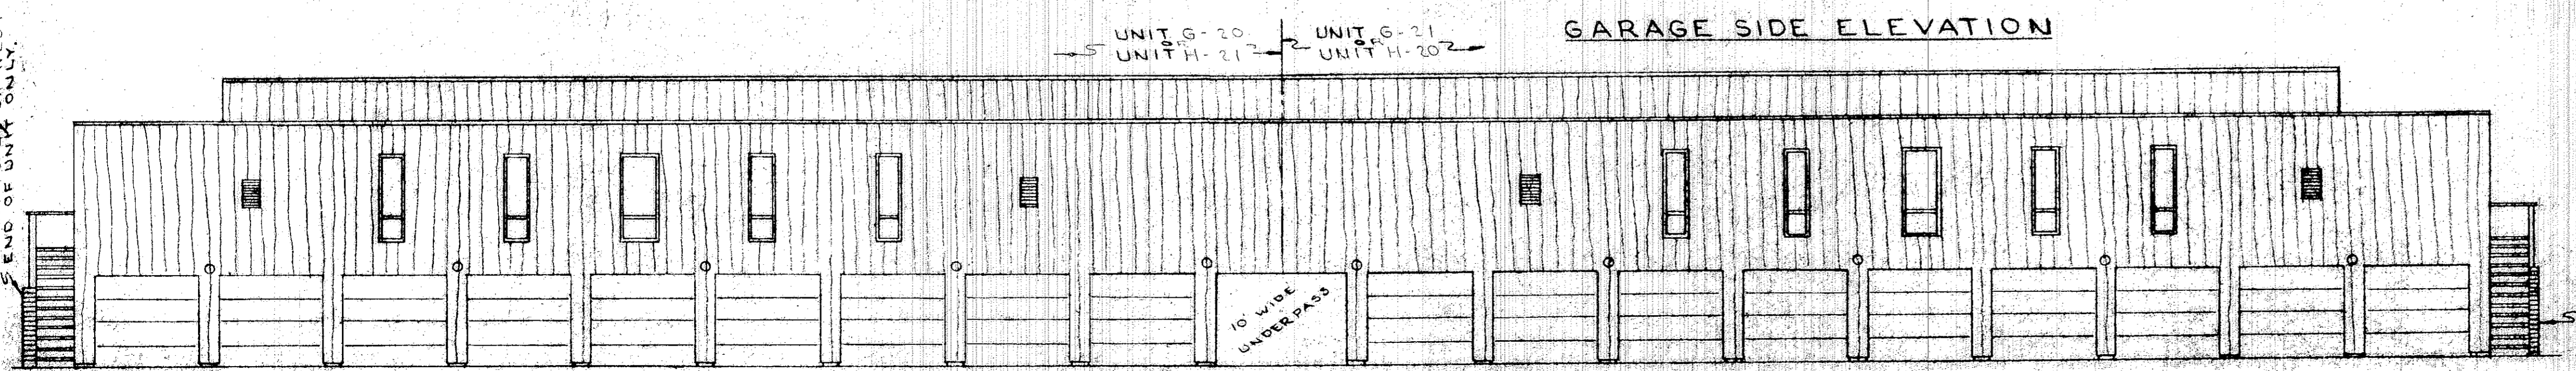

TYPICAL GARAGE SIDE ELEVATION (1/8" = 1'-0")

NOTE: PITCH ROOF 1/8" PER FOOT BY SHIMMING ROOF SHEATHING

TRANSFERRED
NOV 8 1972
Julian P. Pini
AUDITOR

BUILDINGS G-SOUTH & H-NORTH
GARAGE & COURTYARD SIDE ELEVATIONS
SMUGGLERS COVE
CONDOMINIUM COMPLEX NO. 2



SCALE: 1/4" = 1'-0" SEPTEMBER, 1972
PREPARED FOR SMUGGLERS COVE SALES CORPORATION AVON LAKE, OHIO
PREPARED BY JAMES H. SCHMIDT REGISTERED SURVEYOR ELYRIA, OHIO

STATEMENT OF CERTIFICATION
I CERTIFY THAT THE ATTACHED DRAWINGS
CORRECTLY REPRESENT THE DIMENSIONS
OF THE BUILDINGS AS CONSTRUCTED AND
THAT THERE ARE NO ENCROACHMENTS ON
ANY ABUTTING PREMISES.

James H. Schmidt
JAMES H. SCHMIDT
REGISTERED SURVEYOR

STATEMENT OF CERTIFICATION
I CERTIFY THAT THE ATTACHED DRAWINGS
CORRECTLY REPRESENT THE DIMENSIONS
OF THE BUILDINGS AS CONSTRUCTED.

W. Trout
W. TROUT
REGISTERED ARCHITECT

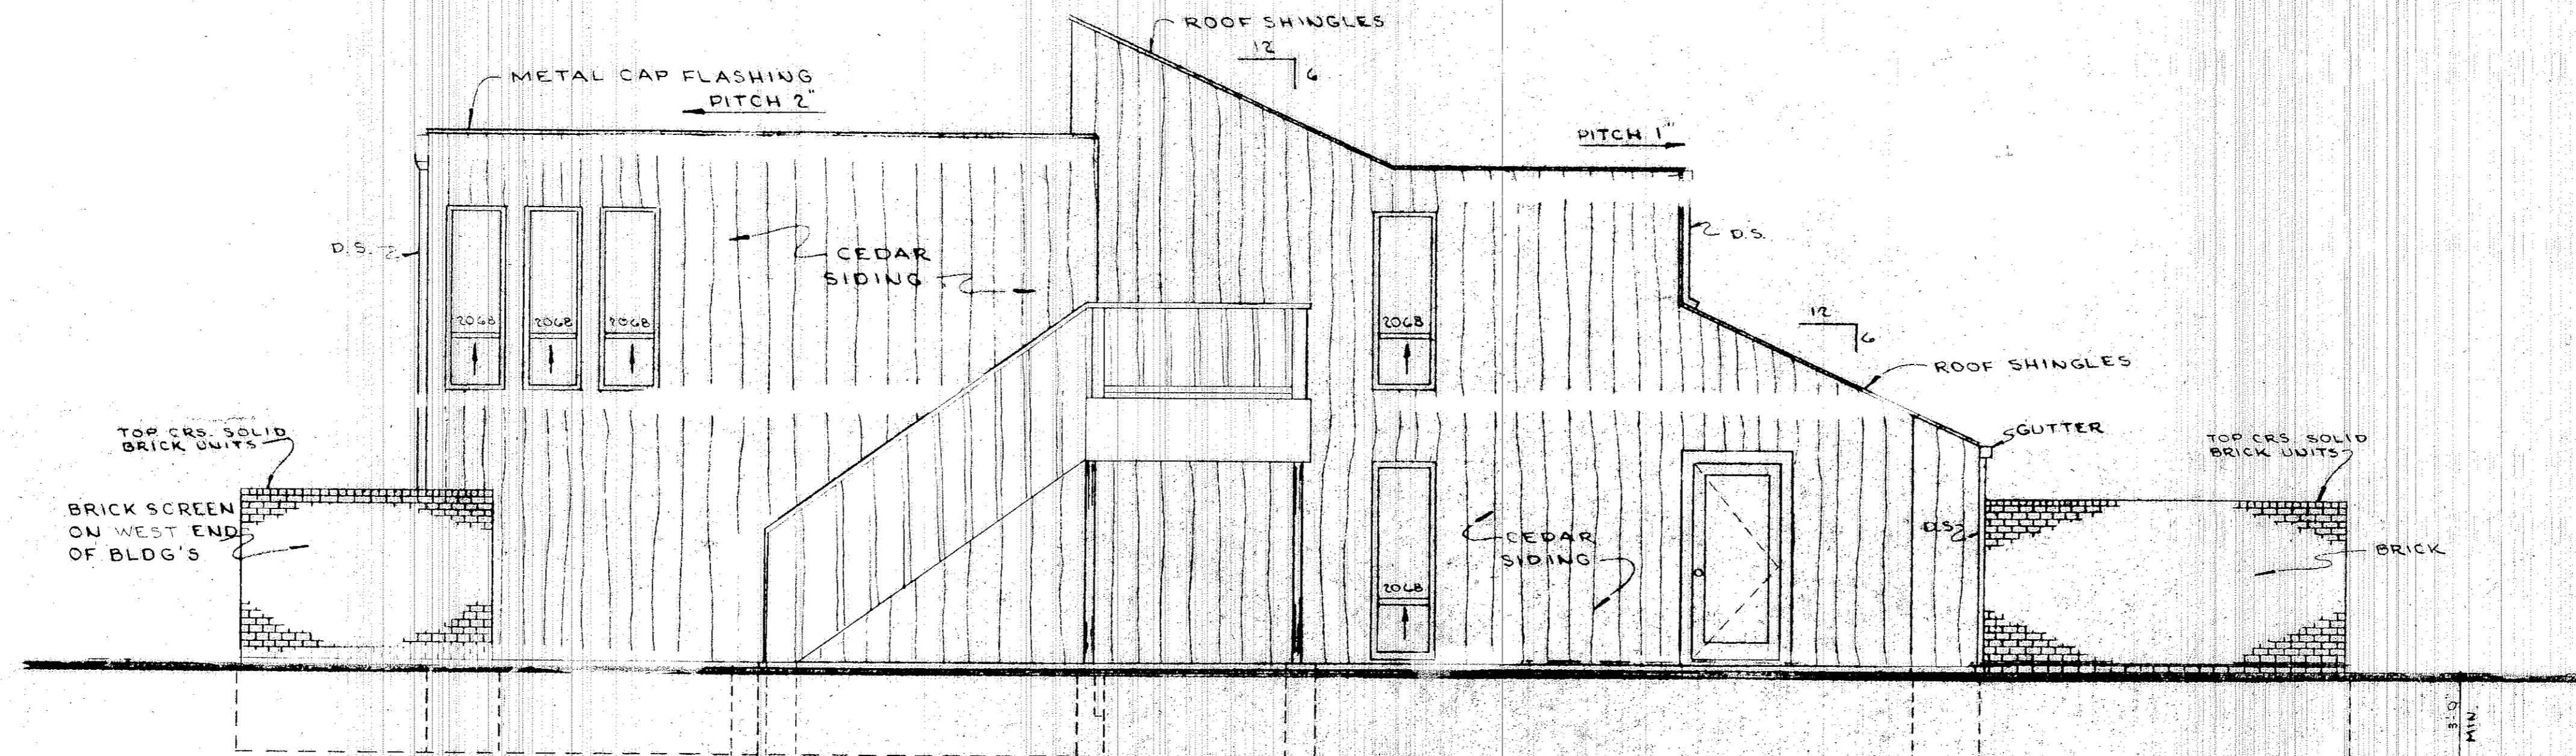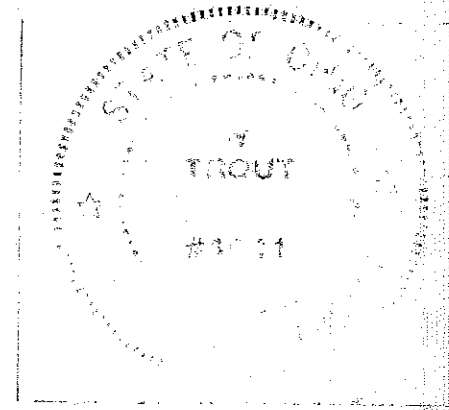

TYPICAL END ELEVATION

BUILDINGS G-SOUTH & H-NORTH
TYPICAL END ELEVATION
SMUGGLERS COVE
CONDOMINIUM COMPLEX NO. 2

SCALE: 1/4" = 1'-0" SEPTEMBER, 1972
PREPARED FOR SMUGGLERS COVE SALES CORPORATION AVON LAKE, OHIO
PREPARED BY JAMES H. SCHMIDT REGISTERED SURVEYOR ELYRIA, OHIO




TRANSFERRED
IN COMPLIANCE WITH SEC. 319.02
OHIO REV. CODE
NOV 8 1972
Julia A. P... ROR
AUDITOR

TABLE OF DIMENSIONS

DIMENSIONS	UNIT	NUMBER	G-13	G-14	G-15	G-16	G-17	G-18
A			28'-4"	28'-4"	28'-4"	28'-4"	28'-4"	28'-4"
B			20'-6"	20'-6"	20'-6"	20'-7"	20'-6"	20'-6"
C			11'-7"	11'-7"	11'-7"	11'-7"	11'-7"	11'-7"
D			14'-7"	14'-3"	14'-7"	14'-7"	14'-3"	14'-6"
E			4'-4"	3'-11"	4'-6"	4'-6"	3'-11"	4'-6"
F			3'-6"	2'-9"	3'-6"	3'-7"	2'-9"	3'-7"
G			20'-1"	0	0	20'-1"	20'-1"	20'-1"
H			0	8'-1"	8'-0"	0	0	0
I			11'-4"	11'-3"	11'-4"	11'-3"	11'-3"	11'-3"
J			5'-5"	5'-4"	5'-5"	5'-5"	5'-4"	5'-5"
K			3'-0"	3'-0"	3'-0"	2'-11"	3'-0"	2'-11"
L			4'-0"	4'-0"	4'-1"	4'-0"	4'-0"	4'-1"
M			1'-8"	1'-6"	1'-7"	1'-6"	1'-6"	1'-5"
N			3'-4"	3'-7"	3'-4"	3'-7"	3'-7"	3'-9"
O			13'-1"	13'-1"	13'-2"	13'-2"	13'-1"	13'-2"
P			5'-4"	5'-2"	5'-4"	5'-4"	5'-4"	5'-3"
Q			4'-0"	5'-11"	4'-0"	6'-0"	4'-0"	4'-0"
R			2'-9"	2'-9"	2'-9"	2'-10"	2'-10"	2'-9"
S			2'-8"	2'-8"	2'-8"	2'-8"	2'-8"	2'-7"
T			4'-10"	4'-10"	4'-10"	4'-10"	4'-10"	4'-9"
U			1'-6"	1'-6"	1'-6"	1'-6"	1'-6"	1'-6"
V			3'-0"	3'-1"	3'-0"	3'-1"	3'-1"	3'-1"
W			8'-10"	8'-10"	8'-10"	9'-0"	8'-10"	8'-10"
X			2'-8"	2'-10"	2'-8"	2'-8"	2'-9"	2'-9"
Y			17'-6"	0	16'-11"	17'-11"	0	17'-0"
Z			4'-3"	4'-3"	4'-0"	4'-3"	4'-3"	4'-2"
A-A			0	8'-3"	8'-4"	0	0	0

TABLE OF DIMENSIONS

DIMENSIONS	UNIT	NUMBER	H-14	H-15	H-16	H-17	H-18
A			28'-4"	28'-4"	28'-4"	28'-4"	28'-4"
B			20'-6"	20'-6"	20'-6"	20'-7"	20'-6"
C			11'-7"	11'-7"	11'-7"	11'-7"	11'-7"
D			14'-7"	14'-3"	14'-7"	14'-7"	14'-3"
E			4'-4"	3'-11"	4'-6"	4'-6"	3'-11"
F			3'-6"	2'-9"	3'-6"	3'-7"	2'-9"
G			20'-1"	0	0	20'-1"	20'-1"
H			0	8'-1"	8'-0"	0	0
I			11'-4"	11'-3"	11'-4"	11'-3"	11'-3"
J			5'-5"	5'-4"	5'-5"	5'-5"	5'-4"
K			3'-0"	3'-0"	3'-0"	2'-11"	3'-0"
L			4'-0"	4'-0"	4'-1"	4'-0"	4'-0"
M			1'-8"	1'-6"	1'-7"	1'-6"	1'-5"
N			3'-4"	3'-7"	3'-4"	3'-7"	3'-7"
O			13'-1"	13'-1"	13'-2"	13'-2"	13'-1"
P			5'-4"	5'-2"	5'-4"	5'-4"	5'-3"
Q			4'-0"	5'-11"	4'-0"	6'-0"	4'-0"
R			2'-9"	2'-9"	2'-9"	2'-10"	2'-10"
S			2'-8"	2'-8"	2'-8"	2'-8"	2'-7"
T			4'-10"	4'-10"	4'-10"	4'-10"	4'-9"
U			1'-6"	1'-6"	1'-6"	1'-6"	1'-6"
V			3'-0"	3'-1"	3'-0"	3'-1"	3'-1"
W			8'-10"	8'-10"	8'-10"	9'-0"	8'-10"
X			2'-8"	2'-10"	2'-8"	2'-8"	2'-9"
Y			17'-6"	0	16'-11"	17'-11"	0
Z			4'-3"	4'-3"	4'-0"	4'-3"	4'-2"
A-A			0	8'-3"	8'-4"	0	0

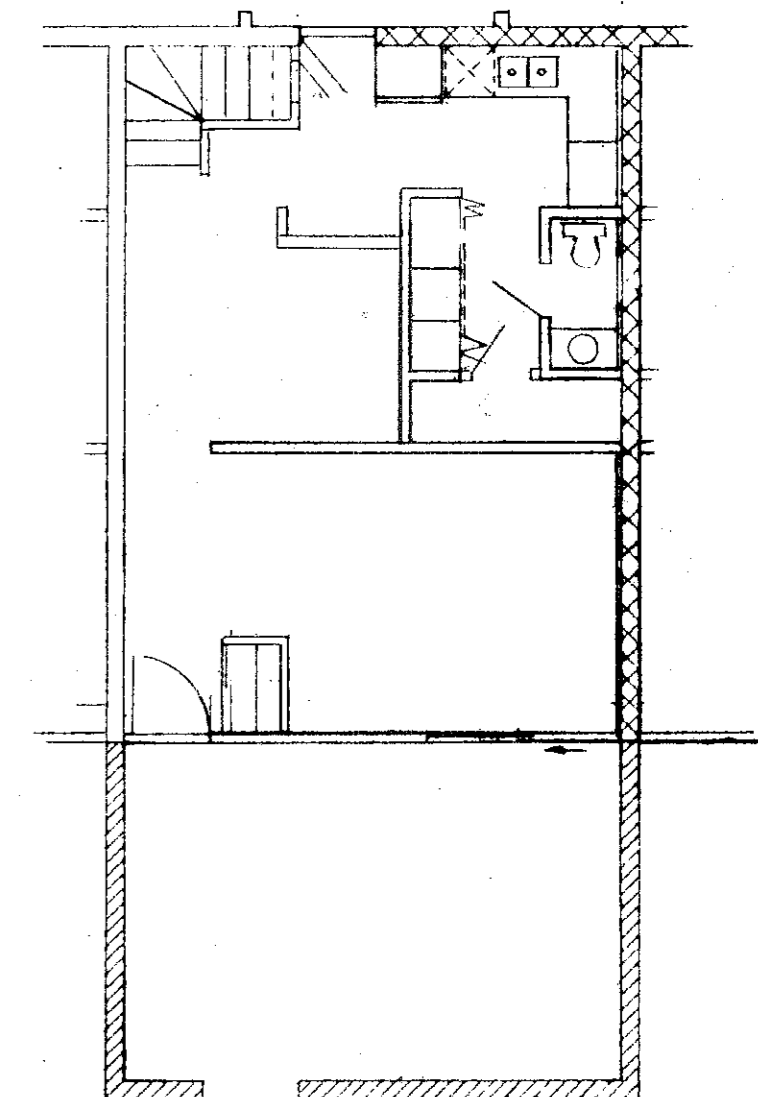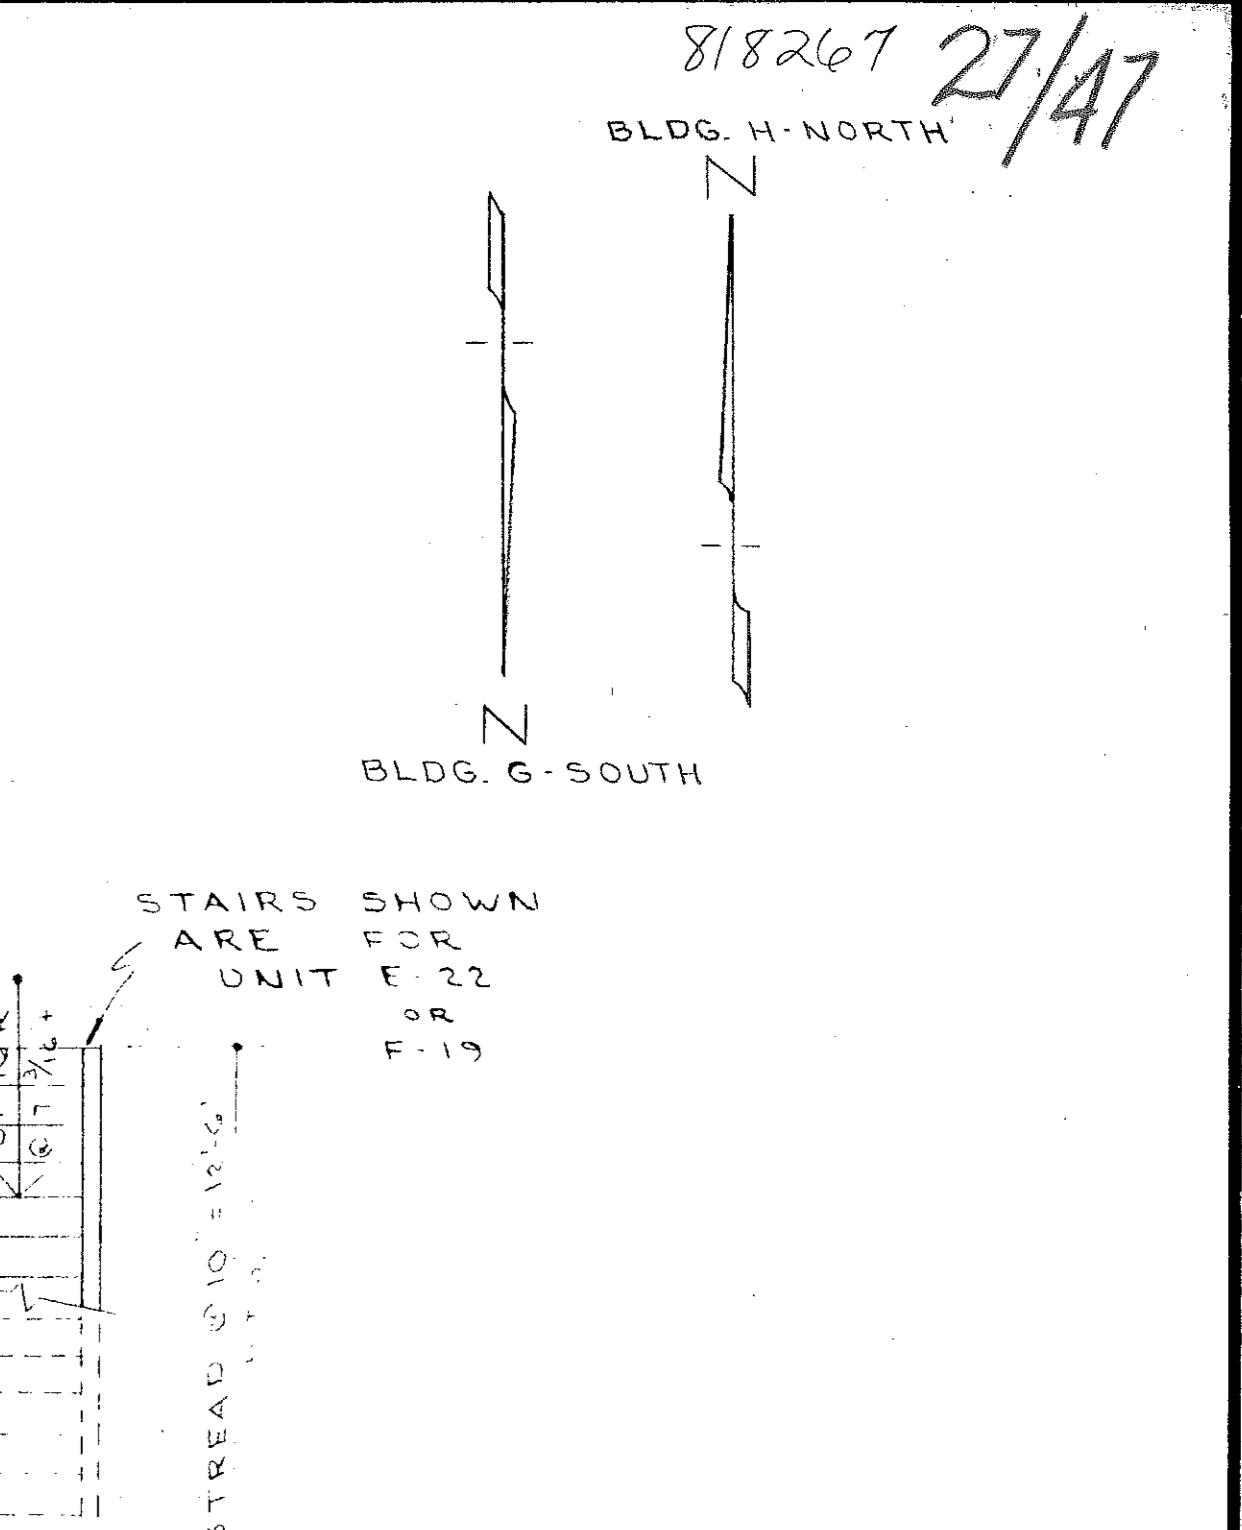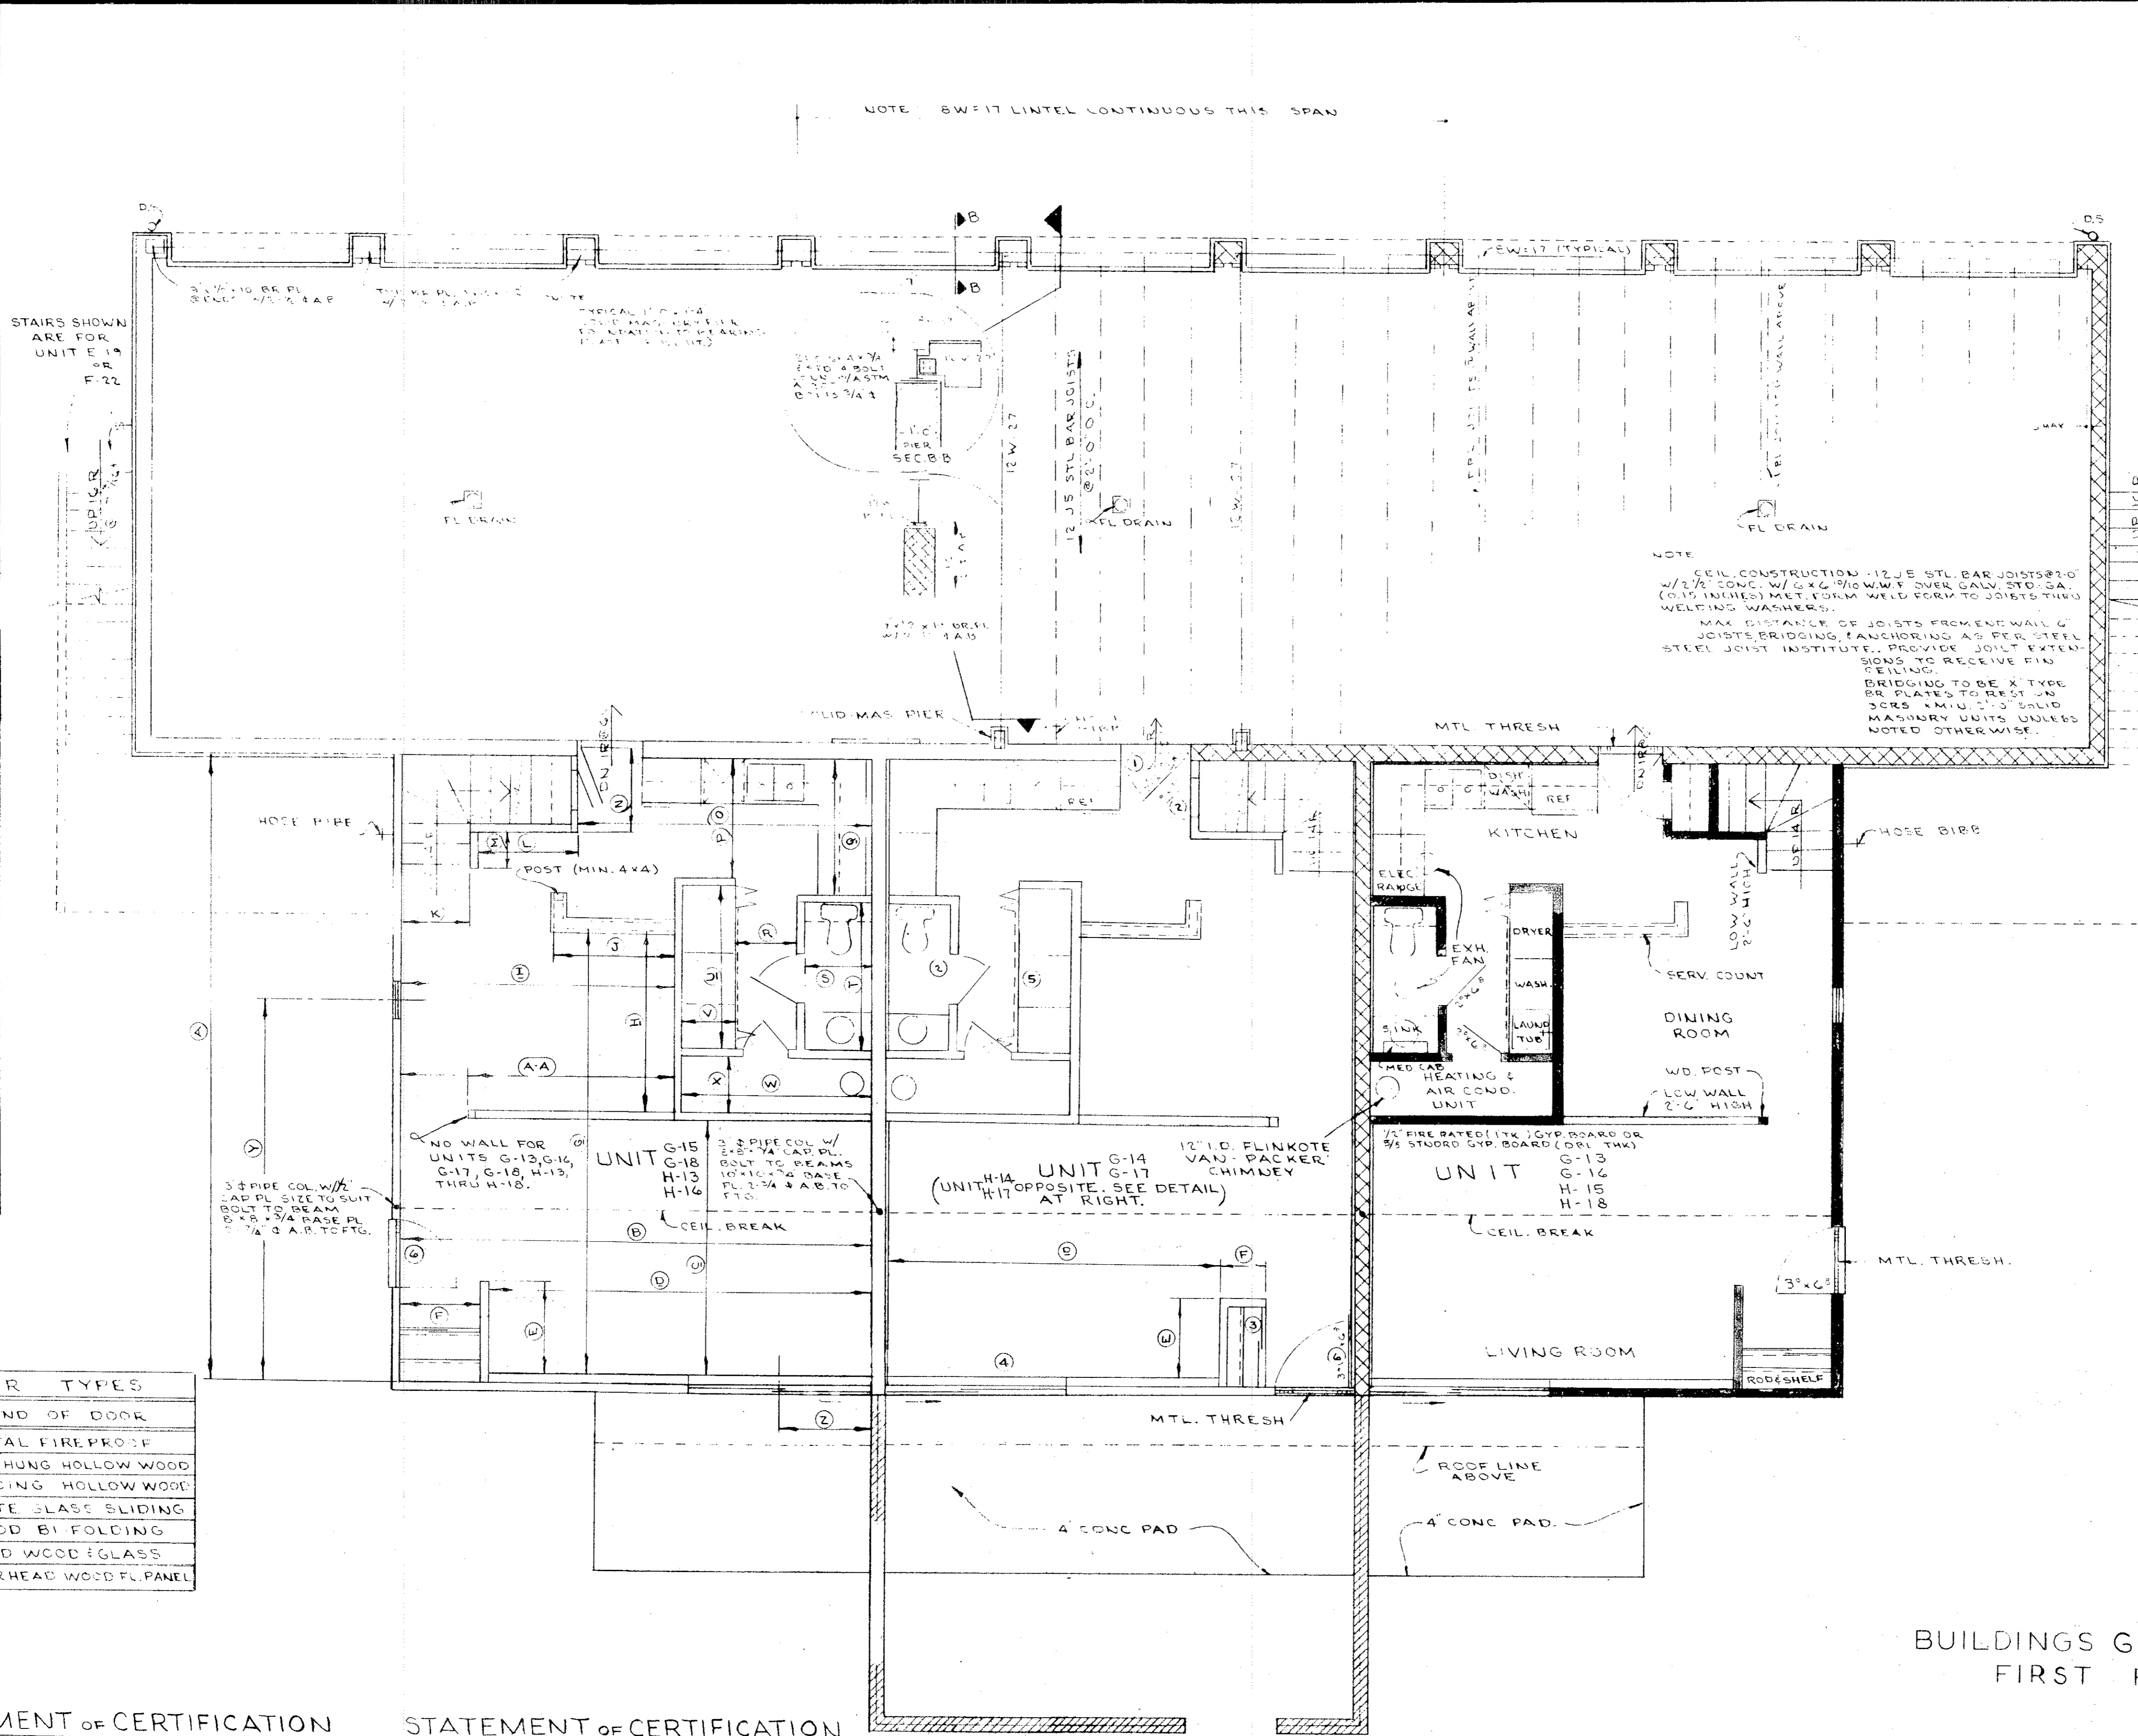


DOOR TYPES

TYPE	KIND OF DOOR
1	METAL FIREPROOF
2	PRE-HUNG HOLLOW WOOD
3	SLICING HOLLOW WOOD
4	FLATE GLASS SLIDING
5	WOOD BI-FOLDING
6	SOLID WOOD GLASS
7	OVERHEAD WOOD FL. PANEL


STATEMENT OF CERTIFICATION
I CERTIFY THAT THE ATTACHED DRAWINGS CORRECTLY REPRESENT THE DIMENSIONS OF THE BUILDINGS AS CONSTRUCTED AND THAT THERE ARE NO ENCROACHMENTS ON ANY ADJUTING PREMISES.

James H. Schmidt
JAMES H. SCHMIDT
REGISTERED SURVEYOR

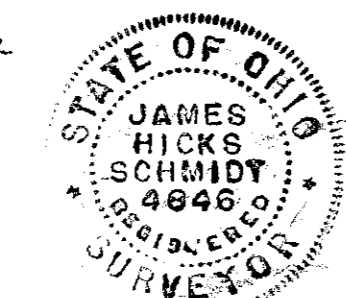

STATEMENT OF CERTIFICATION
I CERTIFY THAT THE ATTACHED DRAWINGS CORRECTLY REPRESENT THE DIMENSIONS OF THE BUILDINGS AS CONSTRUCTED.

W. Trout
W. TROUT
REGISTERED ARCHITECT

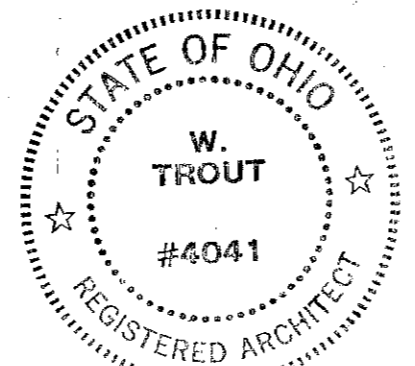

BUILDINGS G-SOUTH & H-NORTH
FIRST FLOOR PLAN

SMUGGLERS COVE
CONDOMINIUM COMPLEX NO. 2


SCALE: 1/4" = 1'-0"
SEPTEMBER, 1972
PREPARED BY
SMUGGLERS COVE SALES CORPORATION
AVON LAKE, OHIO
PREPARED BY
JAMES H. SCHMIDT
REGISTERED SURVEYOR
ELYRIA, OHIO

TRANSFERRED
IN COMPLIANCE WITH SEC. 319.02
OHIO REV. CODES
NOV 8 1972
Julian A. Papi
ADDITOR

818267
27/48


DOOR TYPES	
TYPE	KIND OF DOOR
1	METAL FIREPROOF
2	PRE-HUNG HOLLOW WOOD
3	SLIDING HOLLOW WOOD
4	PLATE GLASS SLIDING
5	WOOD BIFOLDING
6	SOLID WOOD & GLASS

TABLE OF DIMENSIONS						
DIM.	UNIT NUMBER					
	G-13	G-14	G-15	G-16	G-17	G-18
A	16'-1"	16'-0"	16'-3"	16'-2"	16'-3"	16'-2"
B	10'-1"	10'-1"	10'-3"	10'-2"	10'-2"	10'-2"
C	10'-1"	10'-1"	10'-3"	10'-0"	10'-1"	10'-0"
D	14'-2"	14'-2"	14'-2"	14'-3"	14'-2"	14'-4"
E	2'-0"	2'-0"	2'-0"	2'-0"	2'-0"	2'-0"
F	6'-8"	6'-7"	6'-7"	6'-4"	6'-7"	6'-7"
G	2'-0"	2'-0"	2'-0"	2'-0"	2'-0"	2'-0"
H	7'-0"	7'-0"	7'-1"	7'-1"	6'-11"	7'-0"
I	3'-0"	2'-11"	2'-10"	3'-0"	3'-0"	2'-11"
J	4'-11"	4'-11"	4'-11"	5'-0"	4'-11"	4'-11"
K	7'-7"	7'-2"	7'-6"	7'-1"	7'-3"	7'-7"
L	3'-0"	3'-0"	3'-0"	3'-0"	3'-0"	3'-0"
M	3'-0"	2'-11"	3'-0"	3'-0"	3'-0"	3'-0"
N	10'-2"	10'-3"	10'-5"	10'-5"	10'-4"	10'-4"
OP	5'-0"	5'-0"	4'-11"	4'-11"	4'-11"	4'-11"
P	9'-10"	9'-10"	9'-10"	9'-10"	9'-10"	9'-10"
Q	17'-3"	17'-3"	17'-2"	17'-2"	17'-2"	17'-2"
R	2'-3"	2'-3"	2'-3"	2'-3"	2'-3"	2'-3"
S	4'-10"	4'-10"	4'-10"	4'-10"	4'-10"	4'-10"

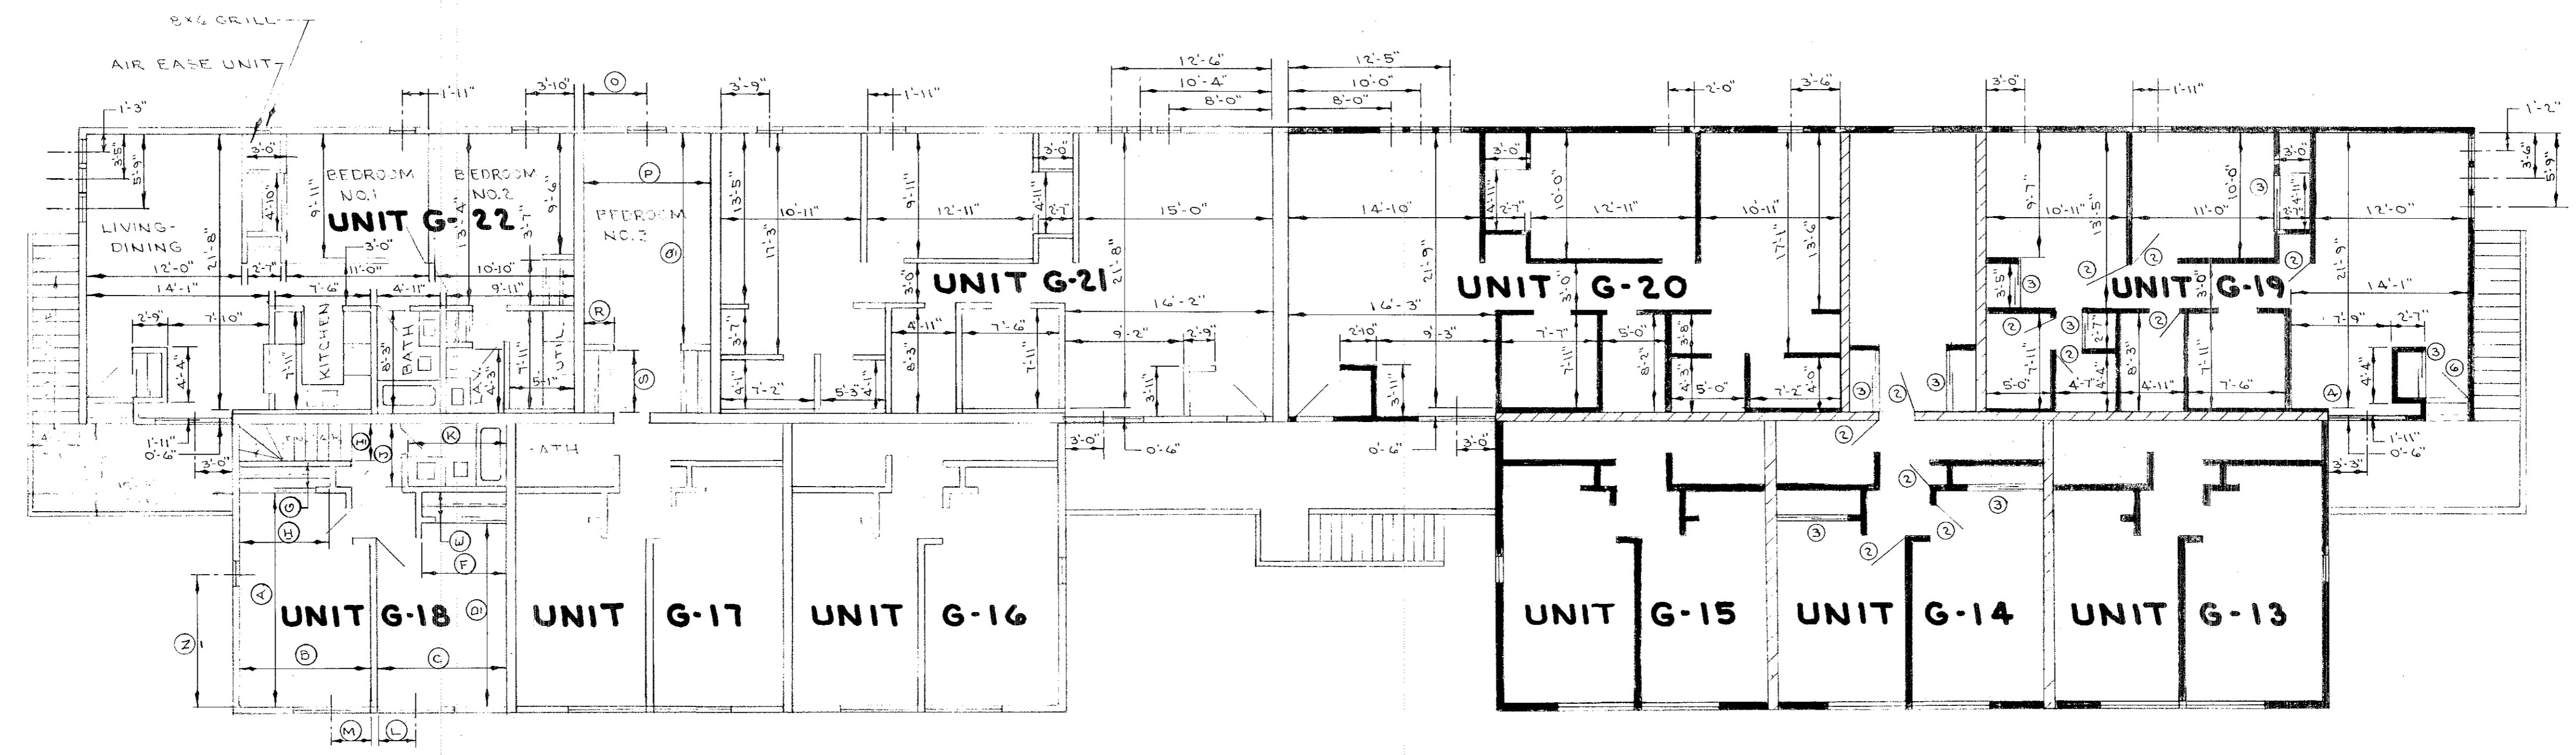

BUILDING G-SOUTH

TABLE OF DIMENSIONS						
DIM.	UNIT NUMBER					
	H-13	H-14	H-15	H-16	H-17	H-18
A	16'-3"	16'-2"	16'-1"	16'-1"	16'-2"	16'-2"
B	10'-2"	10'-2"	10'-1"	10'-1"	10'-1"	10'-1"
C	10'-2"	10'-2"	10'-1"	10'-1"	10'-1"	10'-1"
D	14'-2"	14'-2"	14'-2"	14'-2"	14'-2"	14'-2"
E	2'-0"	2'-0"	2'-0"	2'-0"	2'-0"	2'-0"
F	6'-8"	6'-7"	6'-7"	6'-4"	6'-7"	6'-7"
G	2'-0"	2'-0"	2'-0"	2'-0"	2'-0"	2'-0"
H	7'-3"	7'-3"	7'-3"	7'-3"	7'-3"	7'-3"
I	3'-0"	2'-11"	2'-10"	3'-0"	3'-0"	2'-11"
J	4'-11"	4'-11"	4'-11"	5'-0"	4'-11"	4'-11"
K	7'-7"	7'-2"	7'-6"	7'-1"	7'-3"	7'-7"
L	3'-0"	3'-0"	3'-0"	3'-0"	3'-0"	3'-0"
M	3'-0"	2'-11"	3'-0"	3'-0"	3'-0"	3'-0"
N	10'-4"	10'-3"	10'-5"	10'-5"	10'-4"	10'-4"
OP	5'-0"	5'-0"	4'-11"	4'-11"	4'-11"	4'-11"
P	9'-10"	9'-10"	9'-10"	9'-10"	9'-10"	9'-10"
Q	17'-3"	17'-3"	17'-2"	17'-2"	17'-2"	17'-2"
R	2'-3"	2'-3"	2'-3"	2'-3"	2'-3"	2'-3"
S	4'-10"	4'-10"	4'-10"	4'-10"	4'-10"	4'-10"

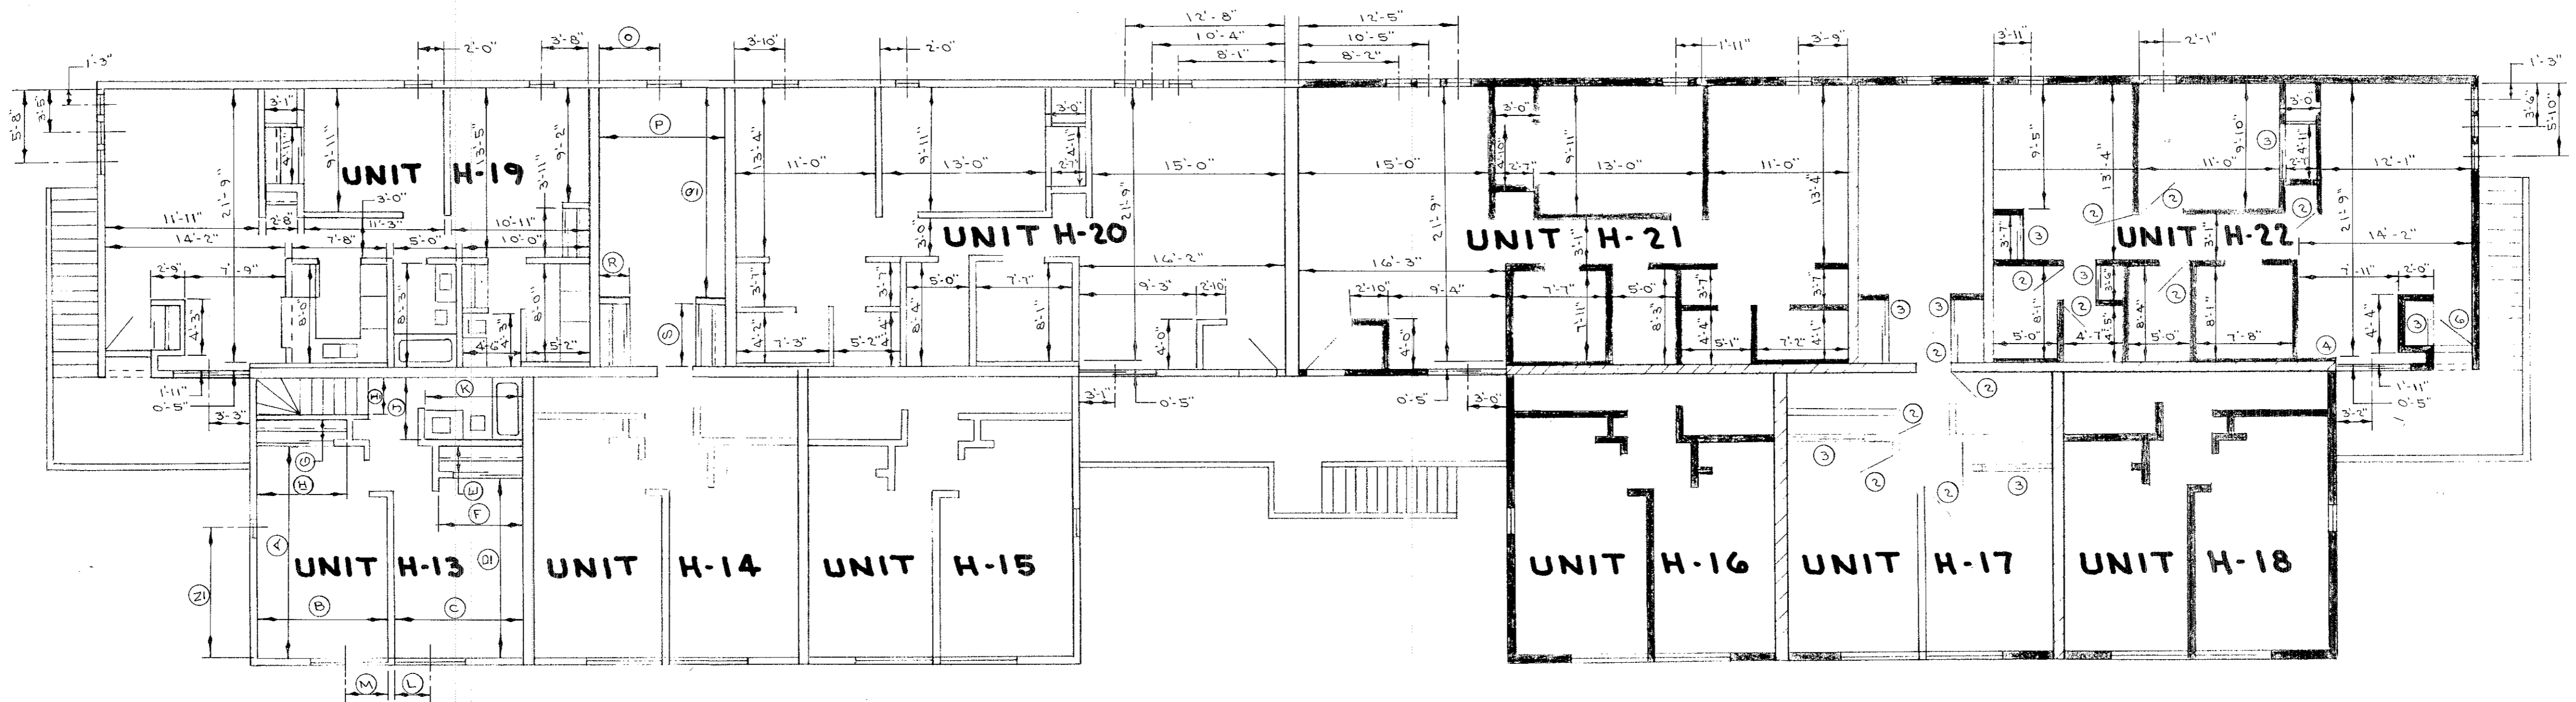


BUILDING H-NORTH

STATEMENT of CERTIFICATION
I CERTIFY THAT THE ATTACHED DRAWINGS CORRECTLY REPRESENT THE DIMENSIONS OF THE BUILDINGS AS CONSTRUCTED, AND THAT THERE ARE NO ENCROACHMENTS ON ANY ADJACENT PREMISES.
James H. Schmidt
JAMES H. SCHMIDT
REGISTERED SURVEYOR



STATEMENT of CERTIFICATION
I CERTIFY THAT THE ATTACHED DRAWINGS CORRECTLY REPRESENT THE DIMENSIONS OF THE BUILDINGS AS CONSTRUCTED.
W. Trout
W. TROUT
REGISTERED ARCHITECT

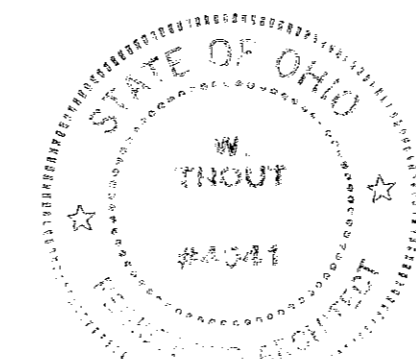

BUILDINGS G-SOUTH & H-NORTH
SECOND FLOOR PLAN
SMUGGLERS COVE
CONDOMINIUM COMPLEX NO. 2

SCALE: 1/8" = 1'-0"
SEPTEMBER, 1972
PREPARED FOR:
SMUGGLERS COVE SALES CORPORATION
AVONLAKE, OHIO
PREPARED BY:
JAMES H. SCHMIDT
REGISTERED SURVEYOR
LYRIA, OHIO

TRANSFERRED
IN COMPLIANCE WITH O.C. 3702
OHIO REV. CODE
NOV 8 1972 FEE: NONE
Julia Phyllis
ADDITOR