


834511

834511

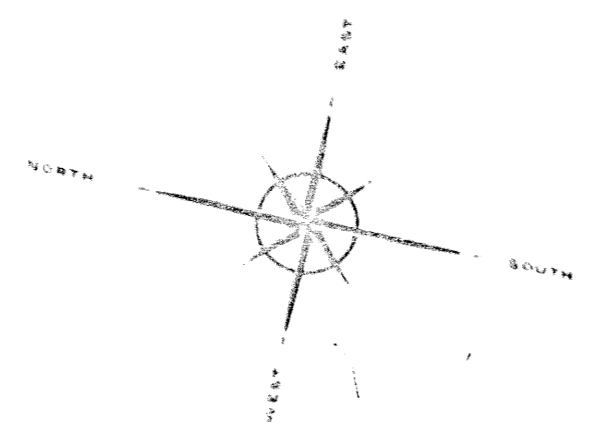

STATEMENT OF CERTIFICATION  
 I HEREBY CERTIFY THAT THE ATTACHED DRAWINGS CORRECTLY REPRESENT THE DIMENSIONS OF THE BUILDINGS AS CONSTRUCTED AND THAT THERE ARE NO ENCROACHMENTS ON ANY ADJUTING PREMISES.

*James H. Schmidt*  
 JAMES H. SCHMIDT  
 REG. SURVEYOR  
 NO. 4006

DENNIS E. & JEAN THOMAS  
 DV 514 P 103

PARCEL NO.	ADDRESS	UNIT	DOLLAR VALUE	% OF TOTAL VALUE
1	R-151	D	17,300	4.01
2	R-151	D	13,800	3.07
3	R-151	D	17,800	4.01
4	R-151	D	17,300	3.90
5	R-151	D	20,100	4.54
6	R-151	D	13,100	2.95
7	R-151	D	13,100	2.95
8	R-151	D	22,850	5.13
9	R-151	D	12,675	2.85
10	R-151	D	20,100	4.54
11	R-151	D	20,100	4.54
TOTAL			424,455	100.00

RECEIVED  
 JUNE 10 1973  
 SURVEYOR'S OFFICE  
 COLUMBUS, OHIO

PARCEL NO.	AREA
1	0.18
2	0.31
3	0.44
4	0.37
5	0.30
6	0.33
7	0.37
8	0.16
9	0.31
10	0.43
11	0.55
12	0.71
13	0.71
TOTAL	4.407
UNSHADED	1.517

BUILDING	ELEV.	ELE.
1	106.10	115.46
2	116.55	115.71
3	110.30	113.74

**EVERGREEN MEADOWS CONDOMINIUM NO. 1**  
 ELYRIA, OHIO

LOCATION: PART OF ORIG. ELYRIA TWP. LOT 3, WEST OF THE BLACK RIVER, CITY OF ELYRIA, CO. OF OHIO

Prepared for: \_\_\_\_\_  
 Drawn by: D. SCHMIDT  
 Checked by: \_\_\_\_\_  
 Date: JUNE, 1973

**SCHMIDT and Associates**  
 Elyria, Ohio  
 Huron, Ohio  
 SURVEYORS and CONSULTANTS in LAND PLANNING


SHEET NO. 109 NO. 4753

*COPY*


For Ordinance see Rel. Vol. 95 # 834837 Pg. 338  
 For Correction see Ord. Vol. 1084 # 836834 Pg. 224

*SEE 28/58*

*28 41*

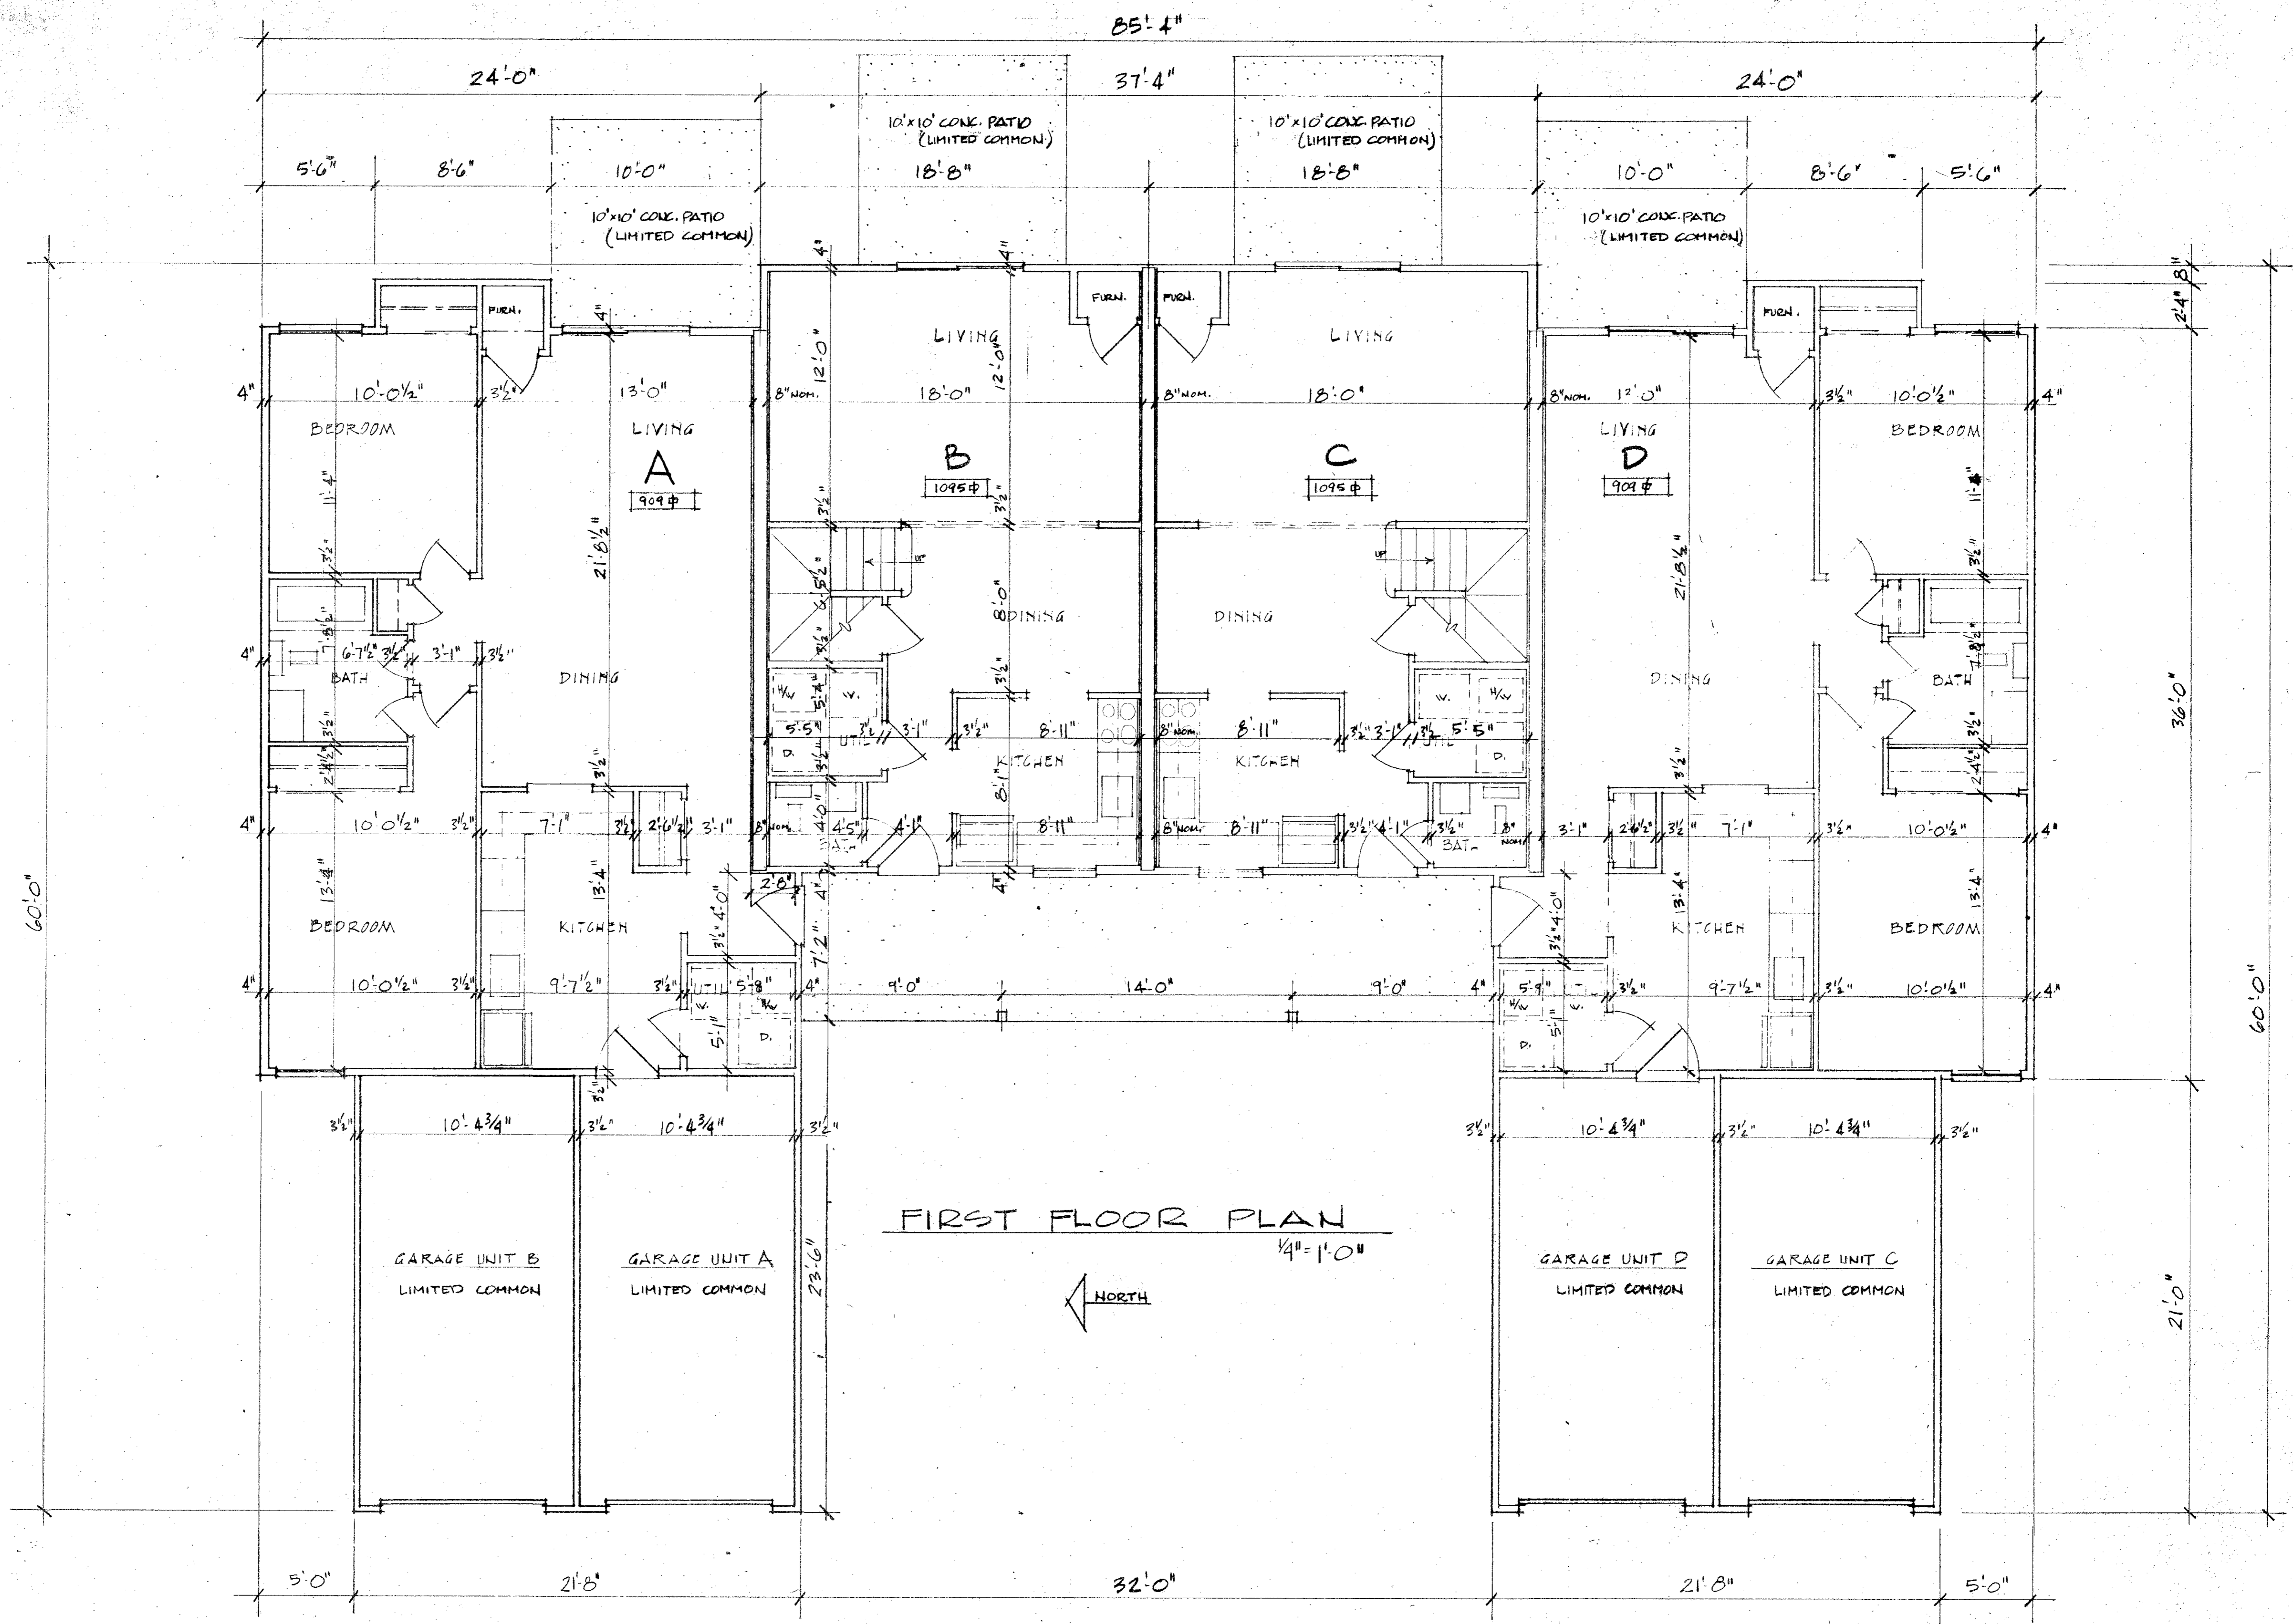


FIRST FLOOR PLAN

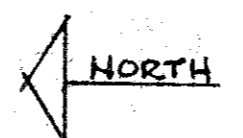

STATEMENT OF CERTIFICATION  
 I CERTIFY THAT THE ATTACHED DRAWINGS CORRECTLY REPRESENT THE BUILDINGS AS CONSTRUCTED AND THAT THERE ARE NO ENCROACHMENTS ON ANY ADJUTING PREMISES.


*Richard Gly*  
 RICHARD GLY  
 REGISTERED ARCHITECT

BLDG 6 - UNITS A, B, C, D  
 3751 W RIDGE RD

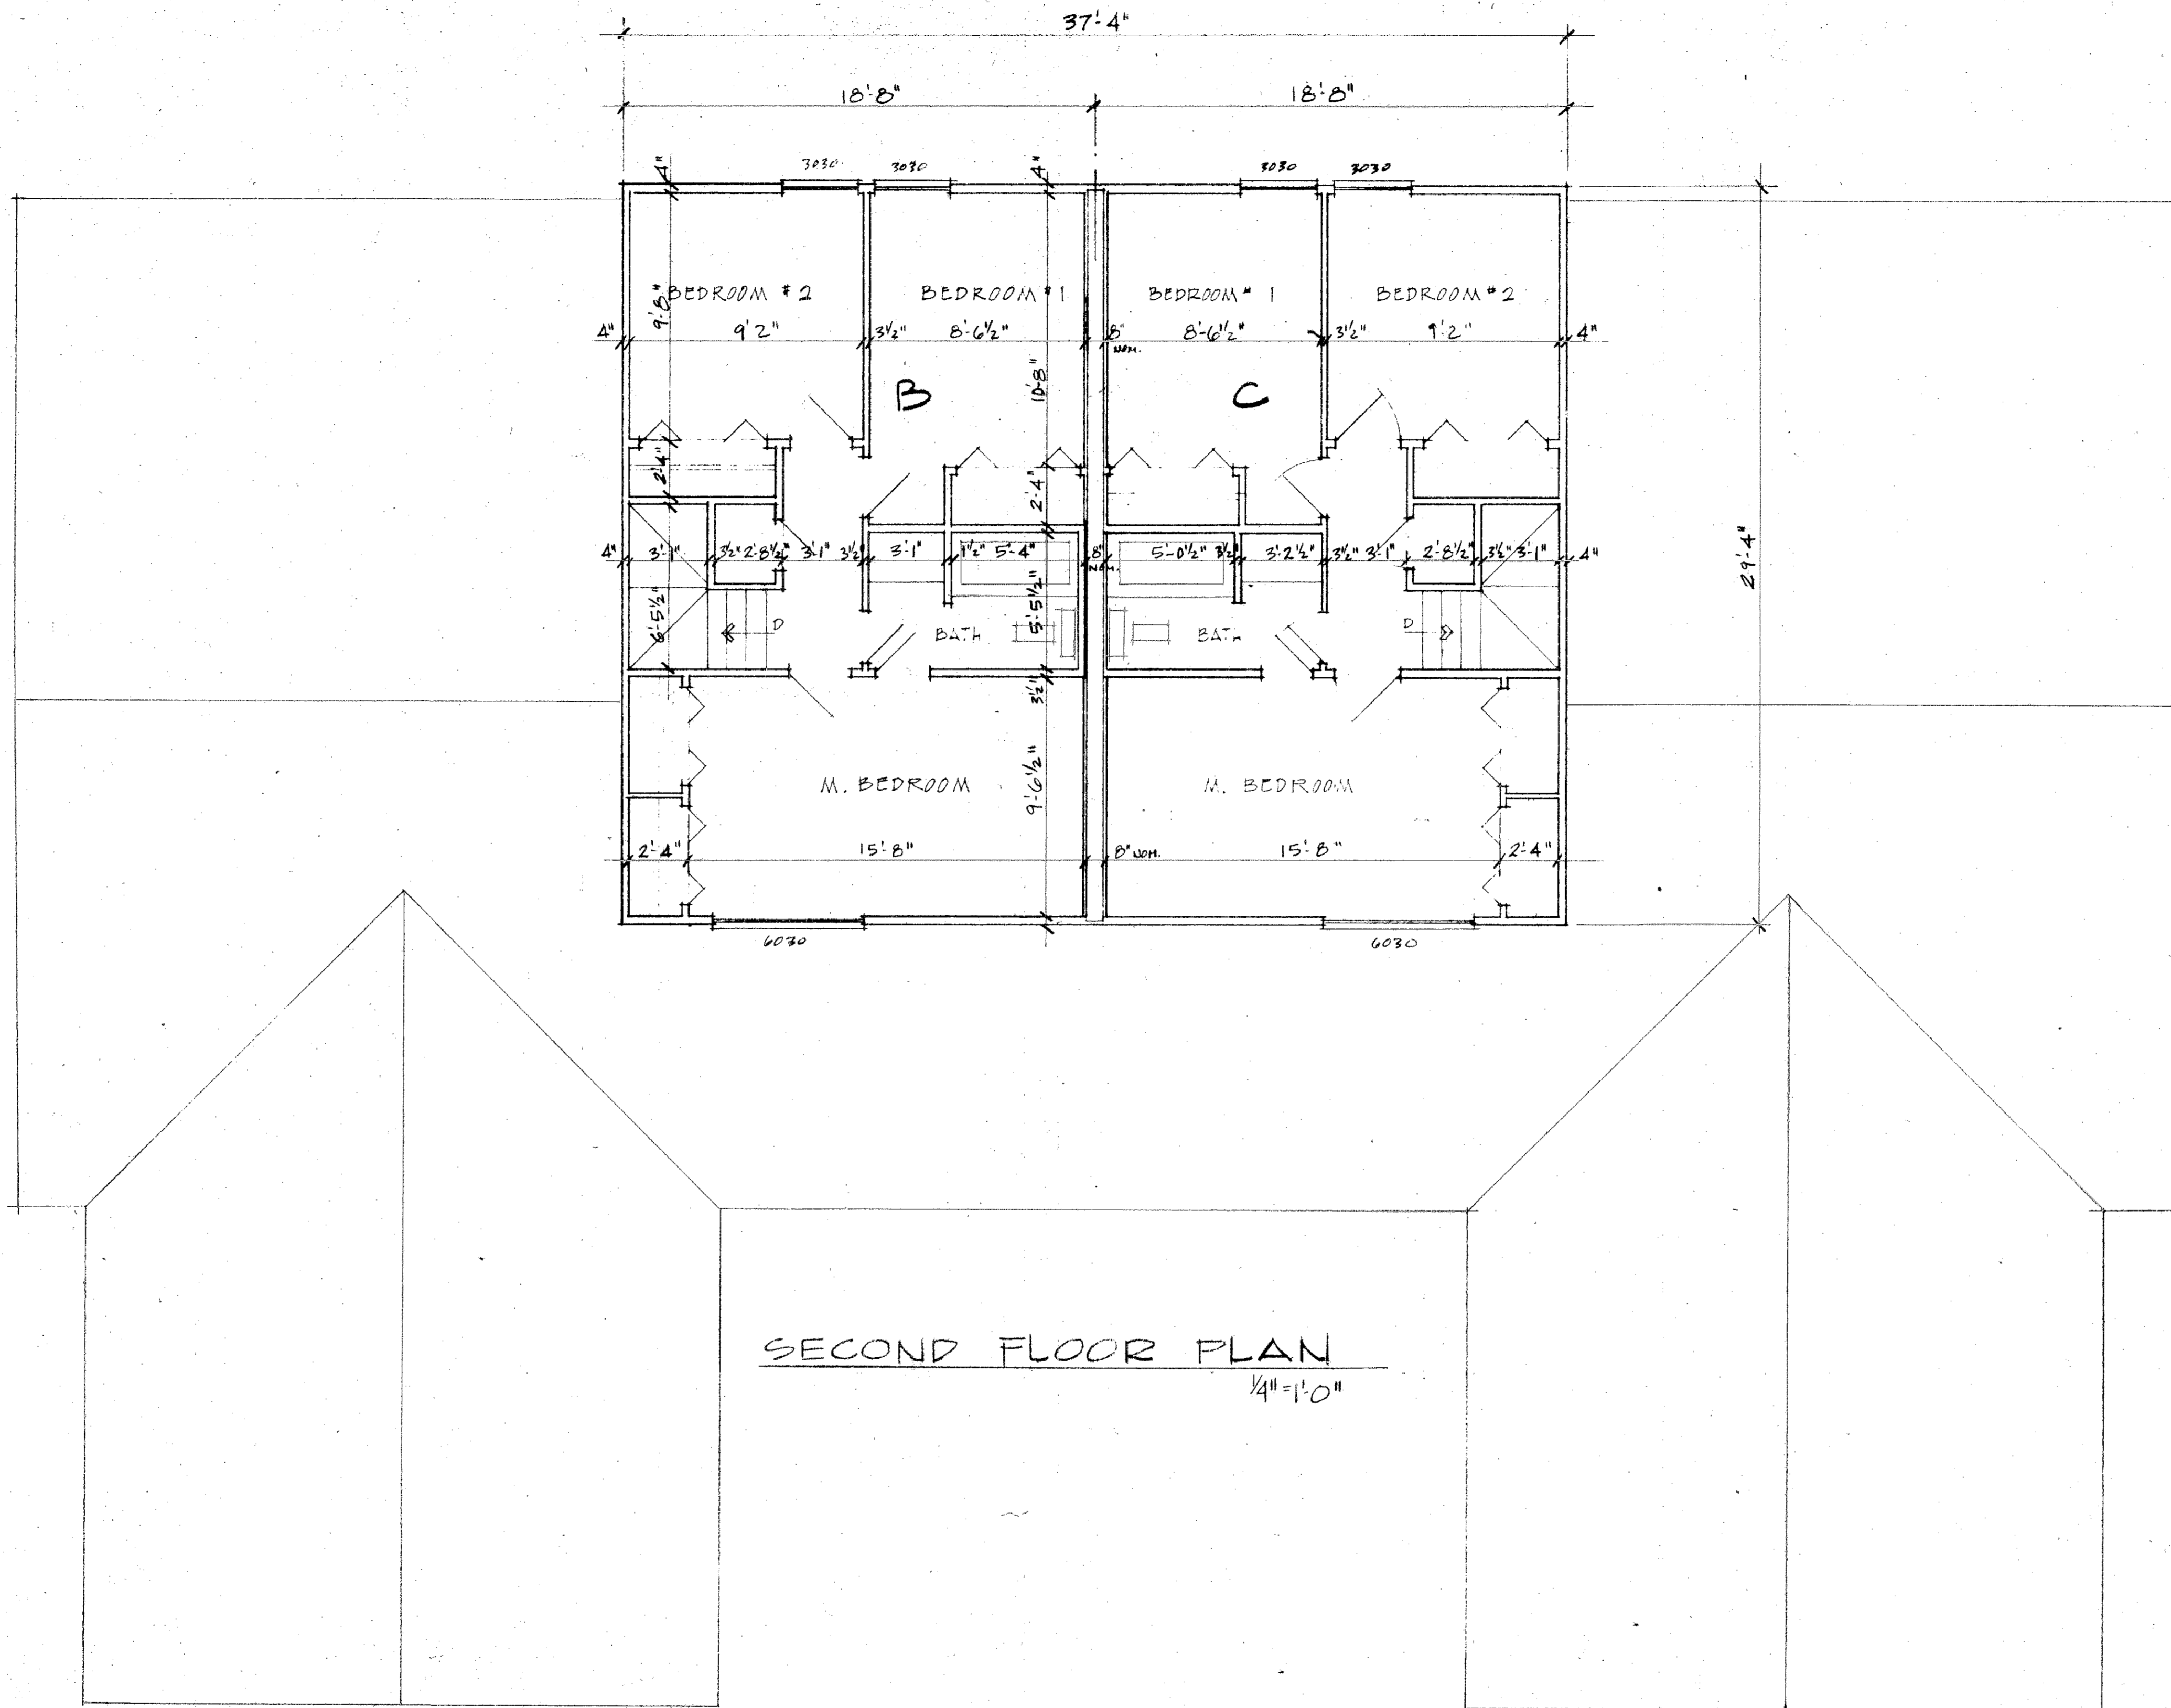


SECOND FLOOR PLAN  
 1/4" = 1'-0"


BLDG G - UNITS A,B,C,D  
 8751 W RIDGE RD.

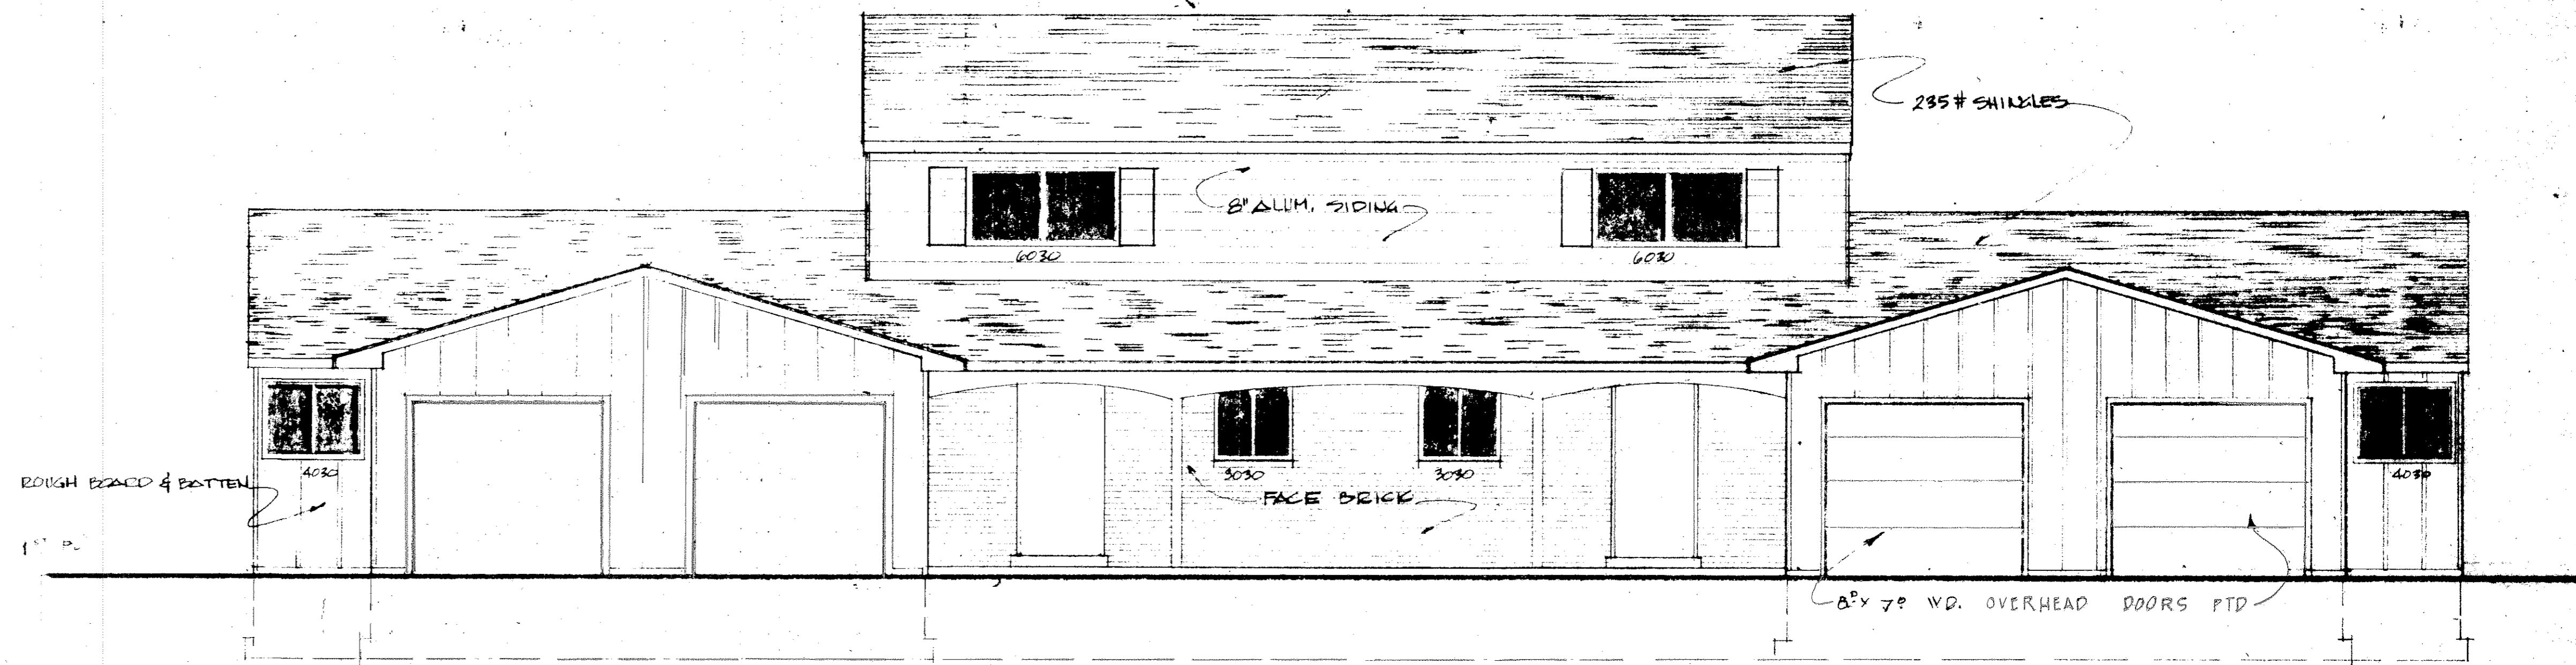

FRONT ELEVATION  
SCALE 1/4" = 1'-0"

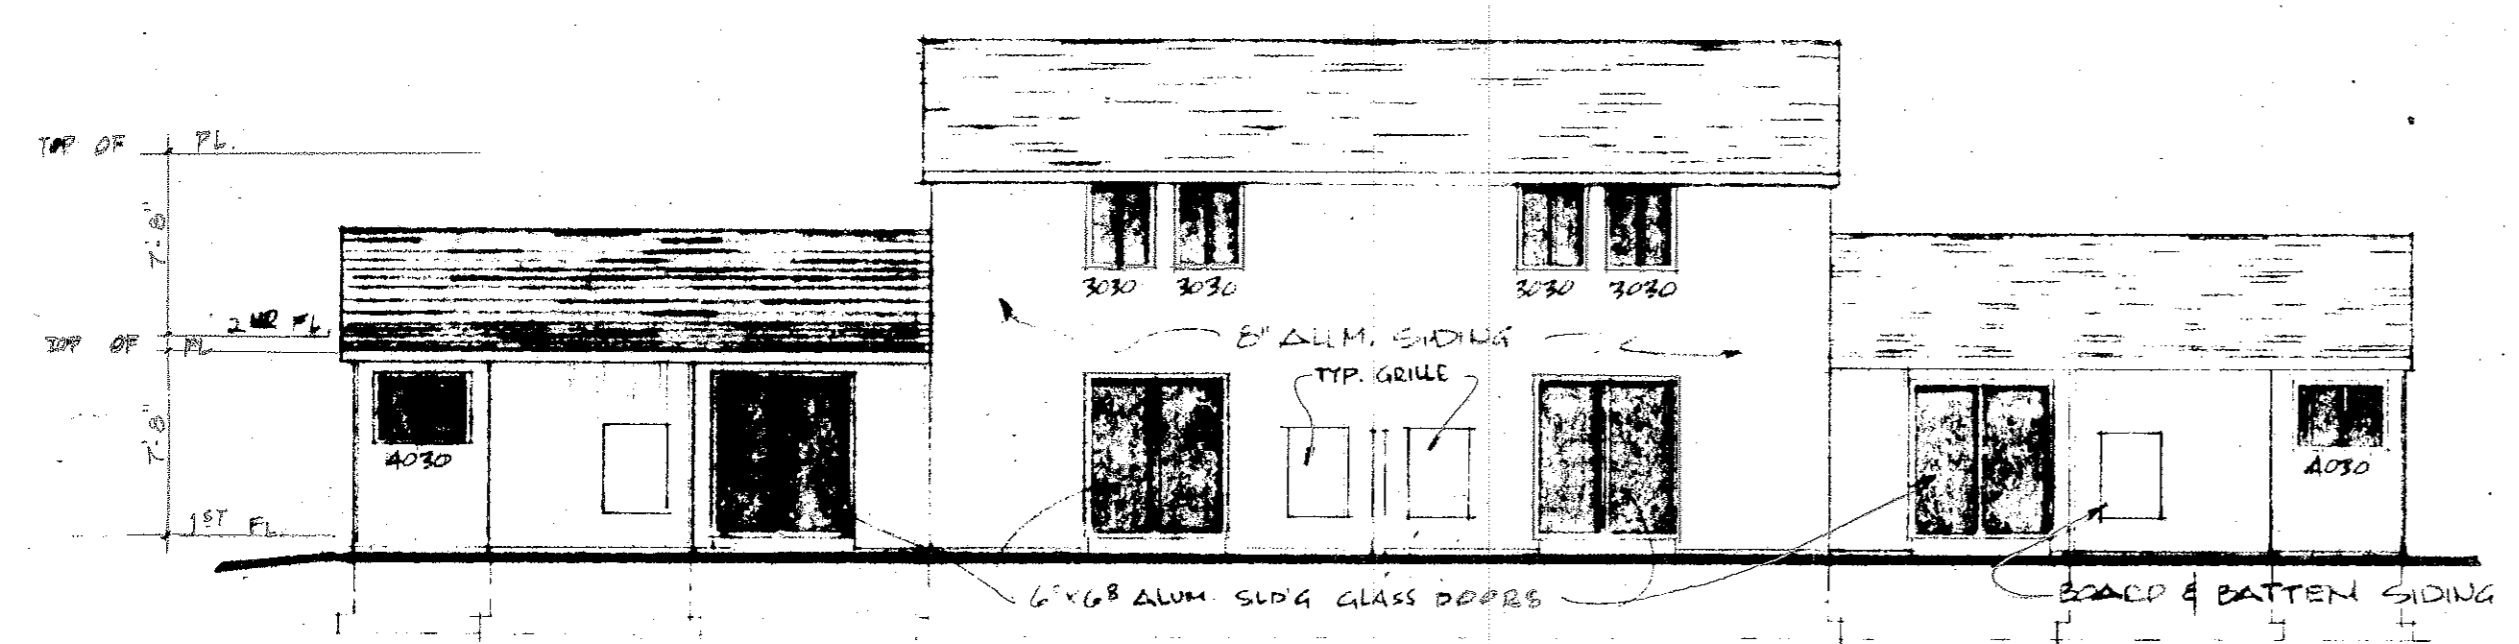


REAR ELEVATION  
SCALE 1/8" = 1'-0"

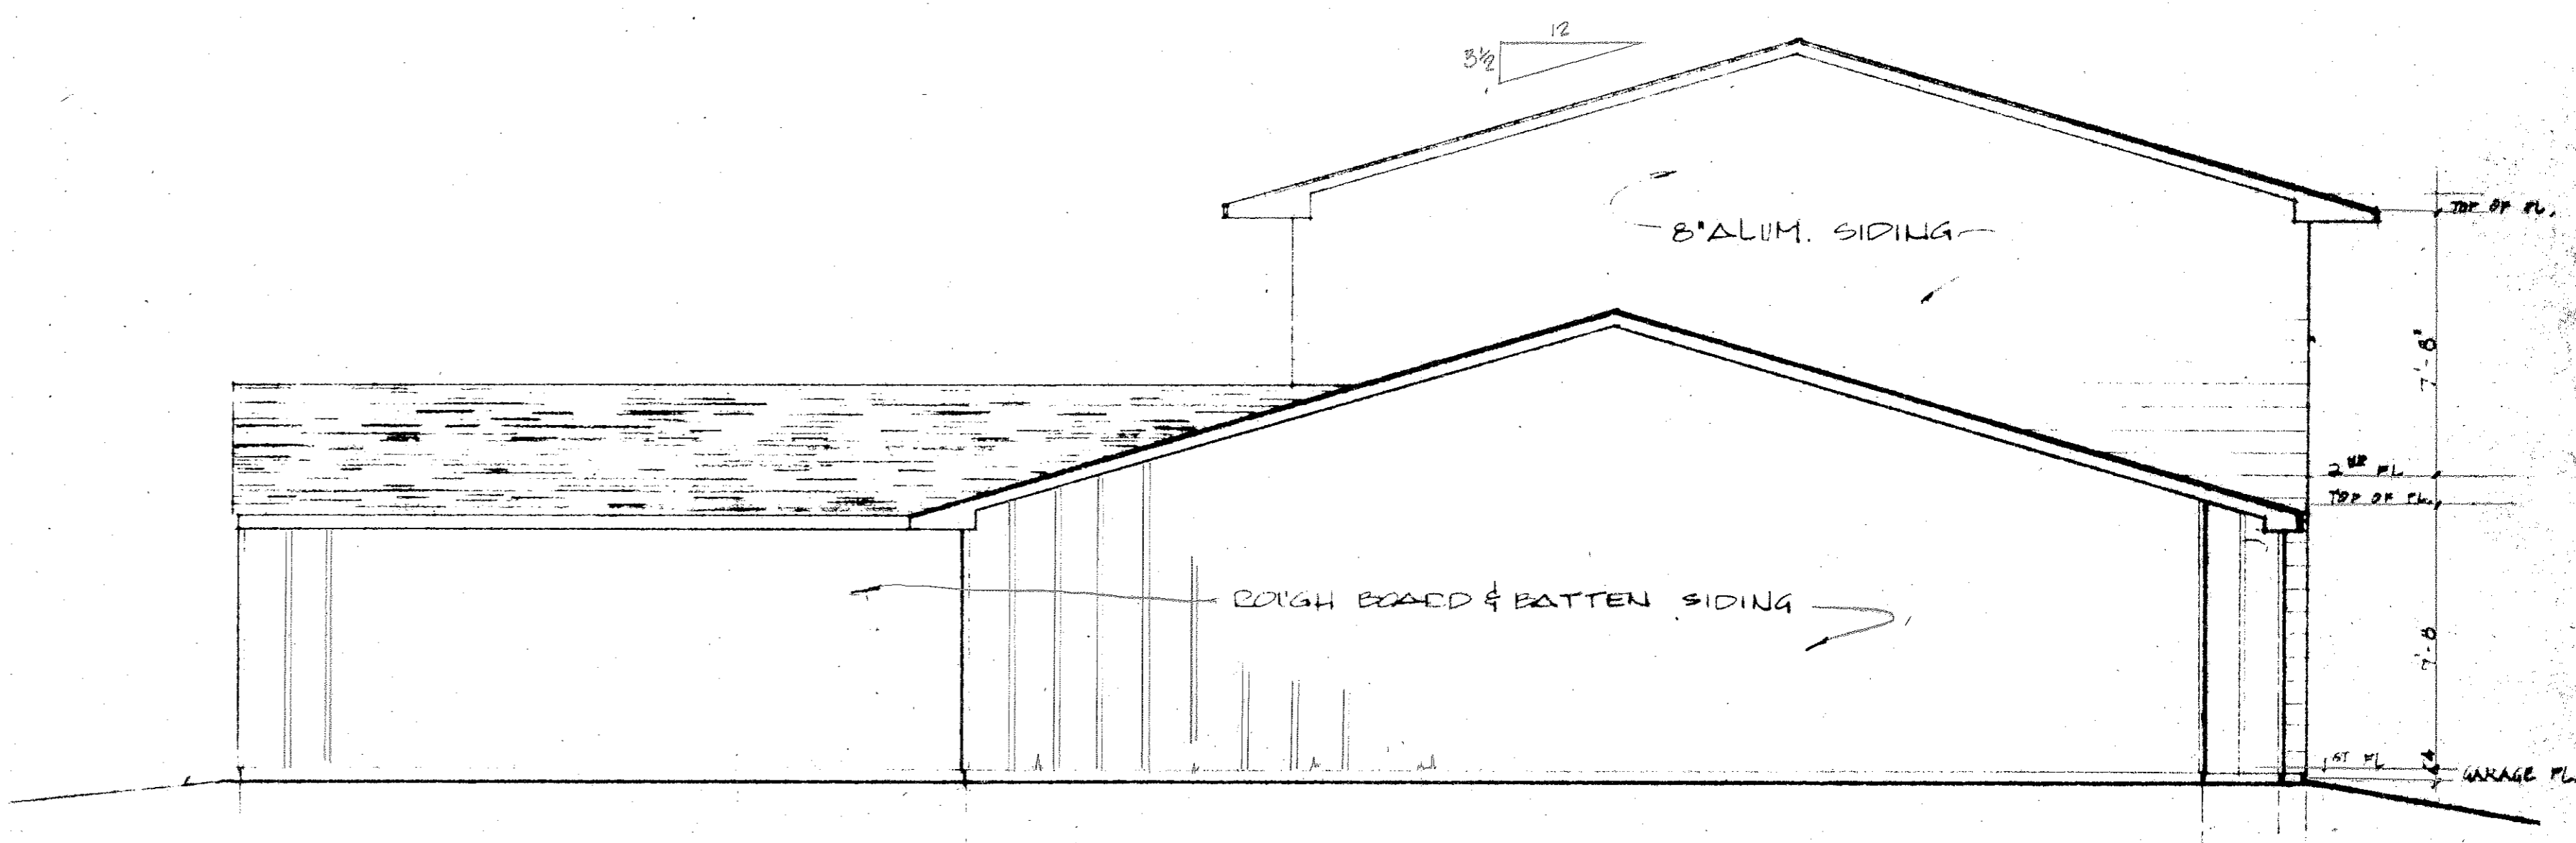


TYPICAL SIDE ELEVATION  
SCALE 1/4" = 1'-0"

BLDG. G - UNITS A,B,C,D  
8751 W. RIDGE RD.

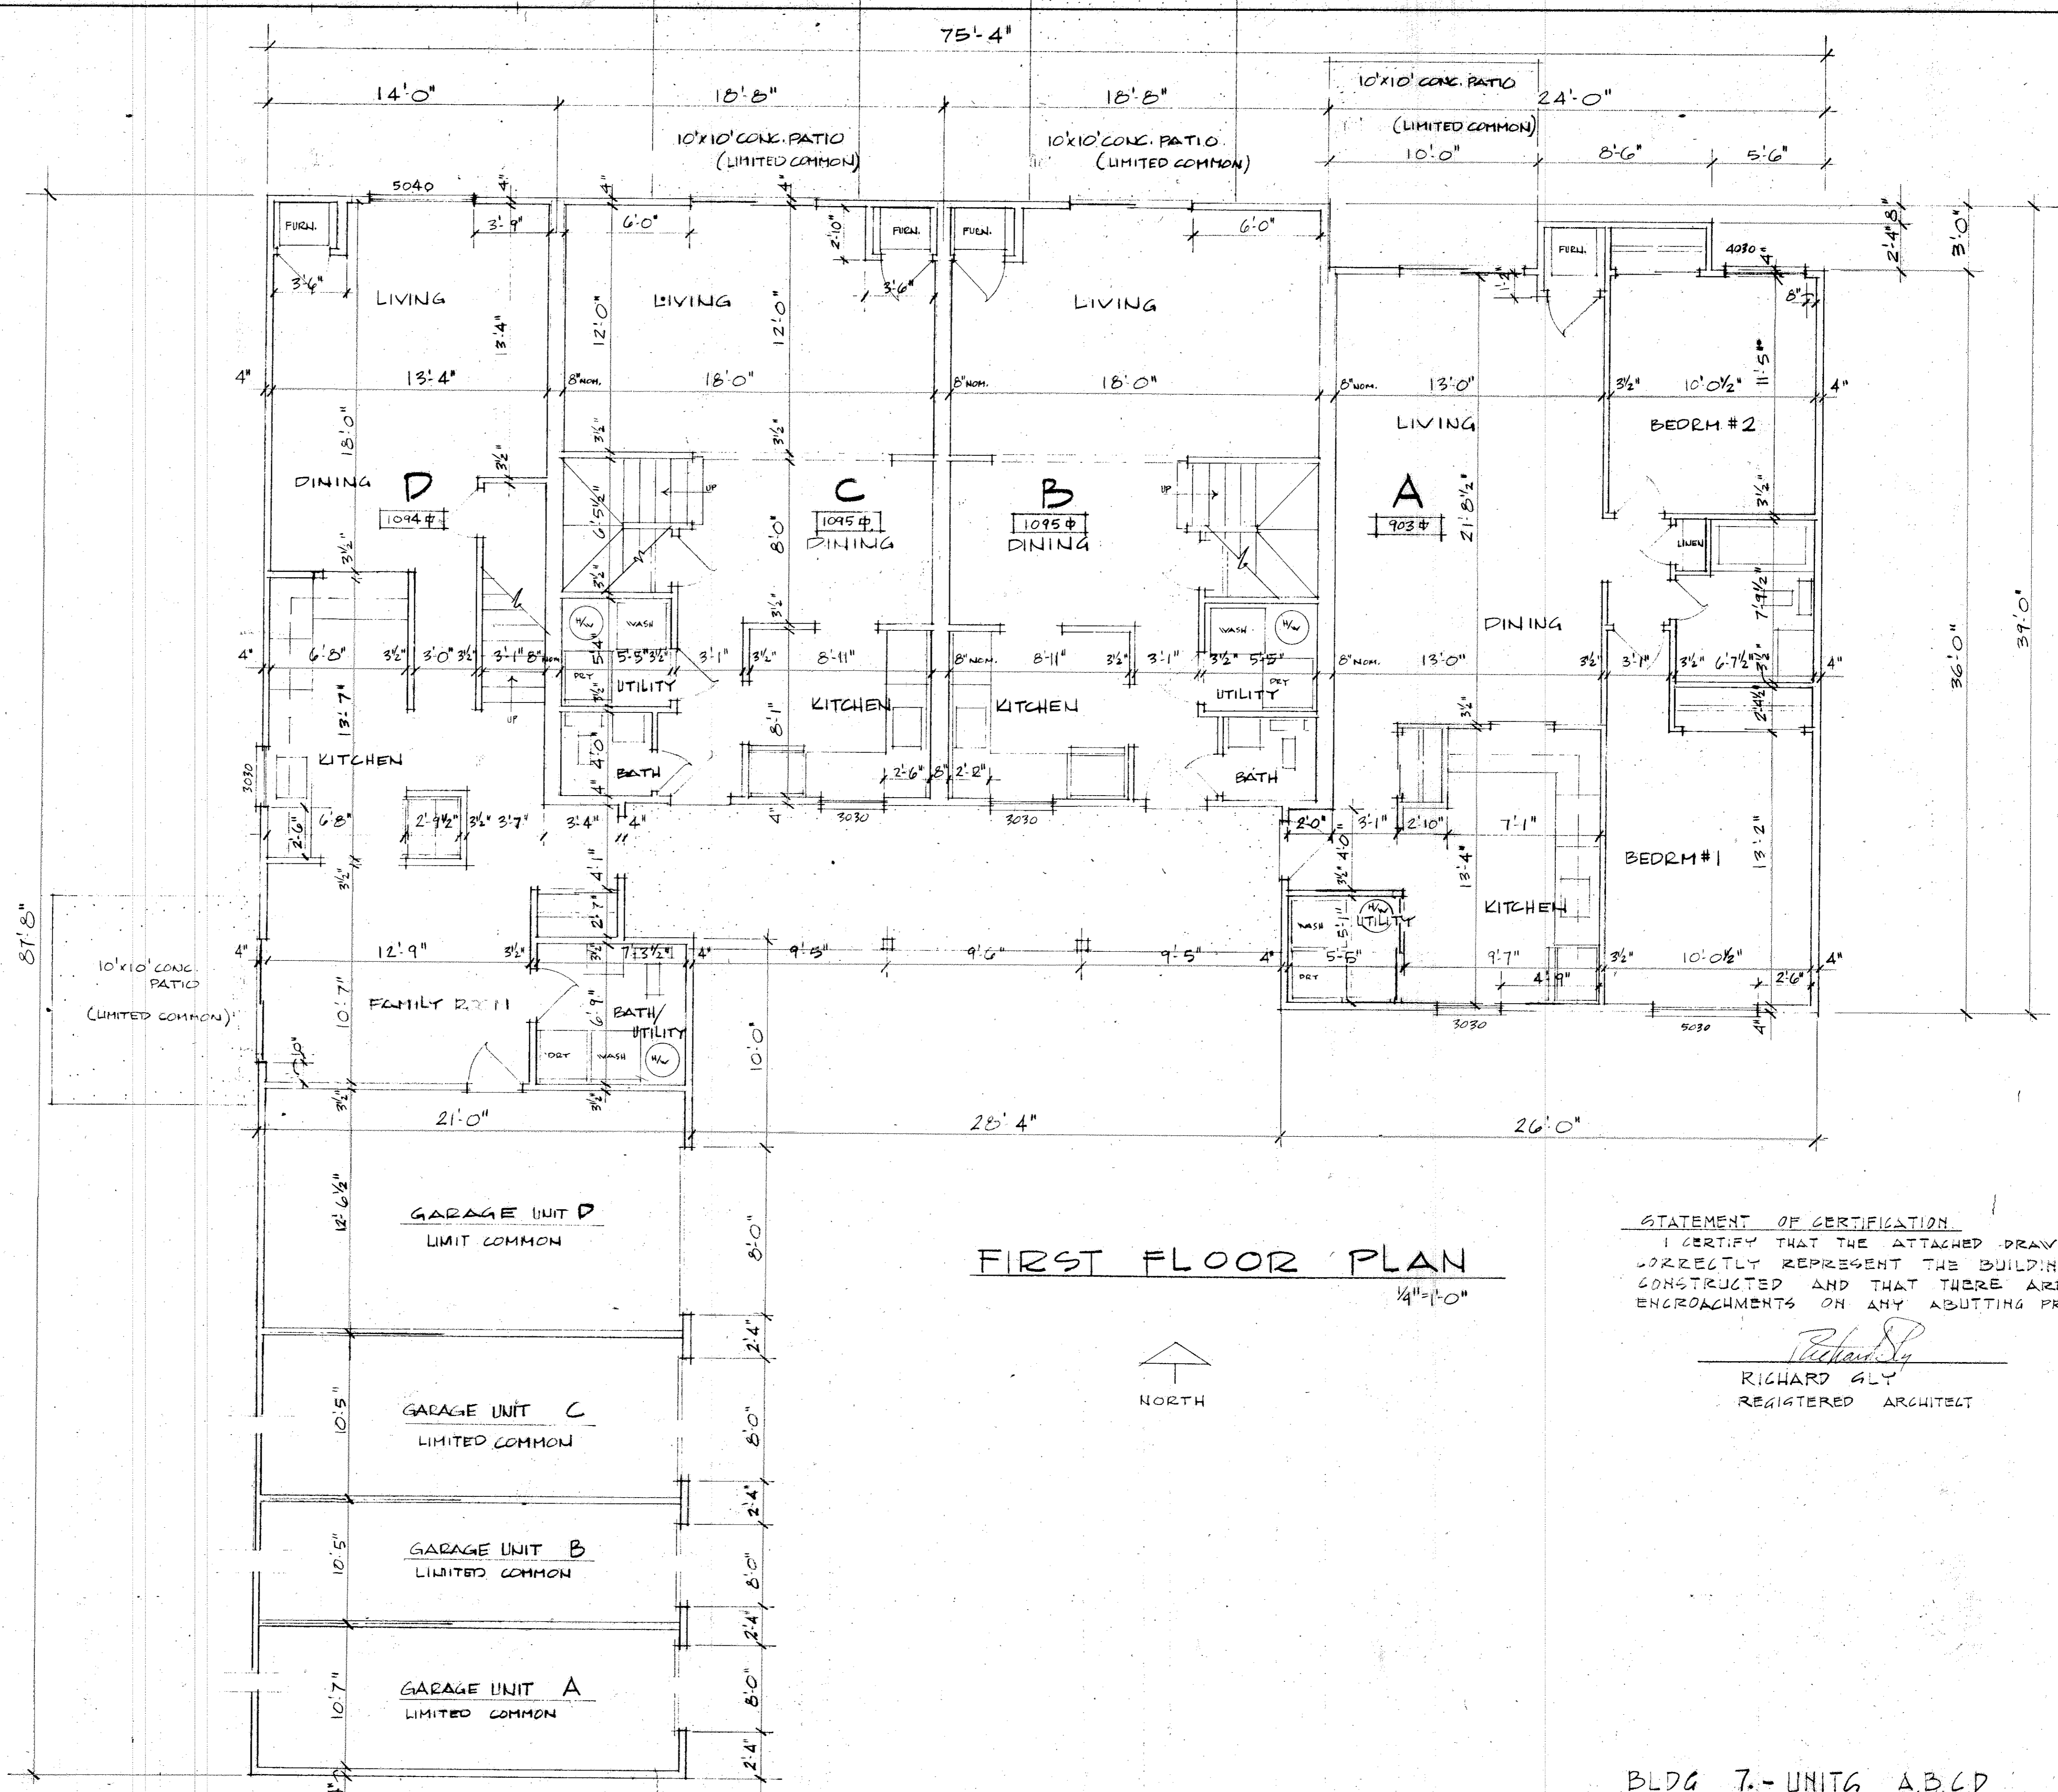


FIRST FLOOR PLAN  
1/4" = 1'-0"

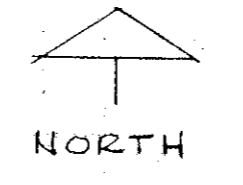


STATEMENT OF CERTIFICATION  
I CERTIFY THAT THE ATTACHED DRAWINGS  
CORRECTLY REPRESENT THE BUILDINGS AS  
CONSTRUCTED AND THAT THERE ARE NO  
ENCROACHMENTS ON ANY ADJUTING PREMISES.

*Richard G. Ly*  
RICHARD G. LY  
REGISTERED ARCHITECT


BLDG 7.- UNITG A,B,C,D  
8749 W RIDGE RD

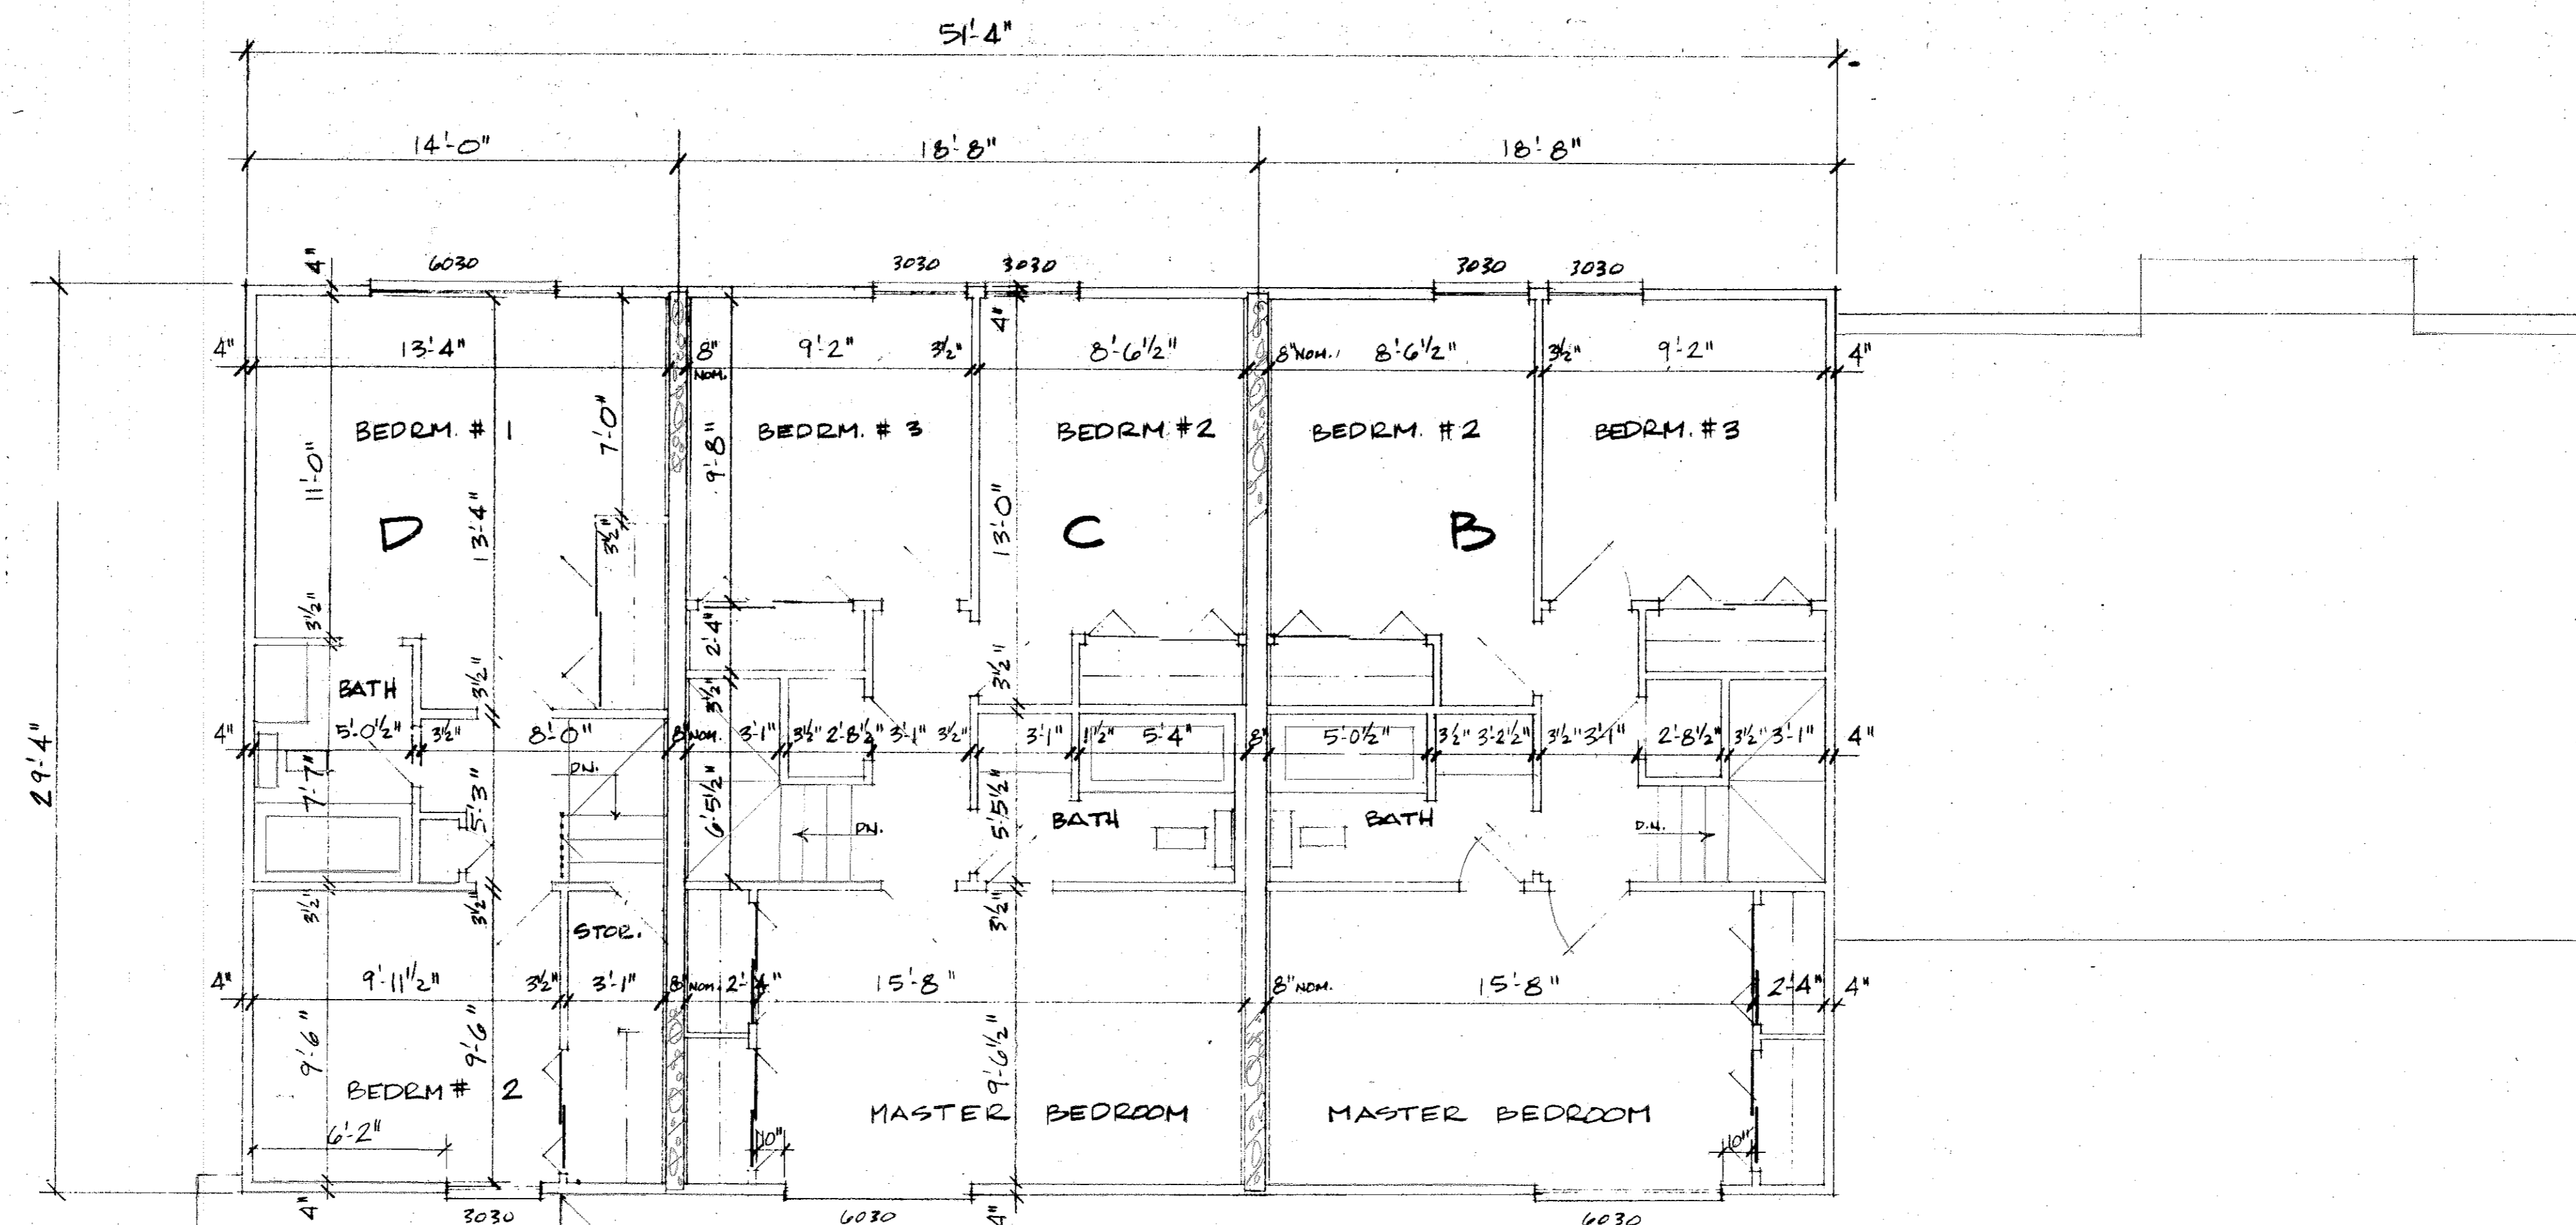


SECOND FLOOR PLAN  
1/4" = 1'-0"

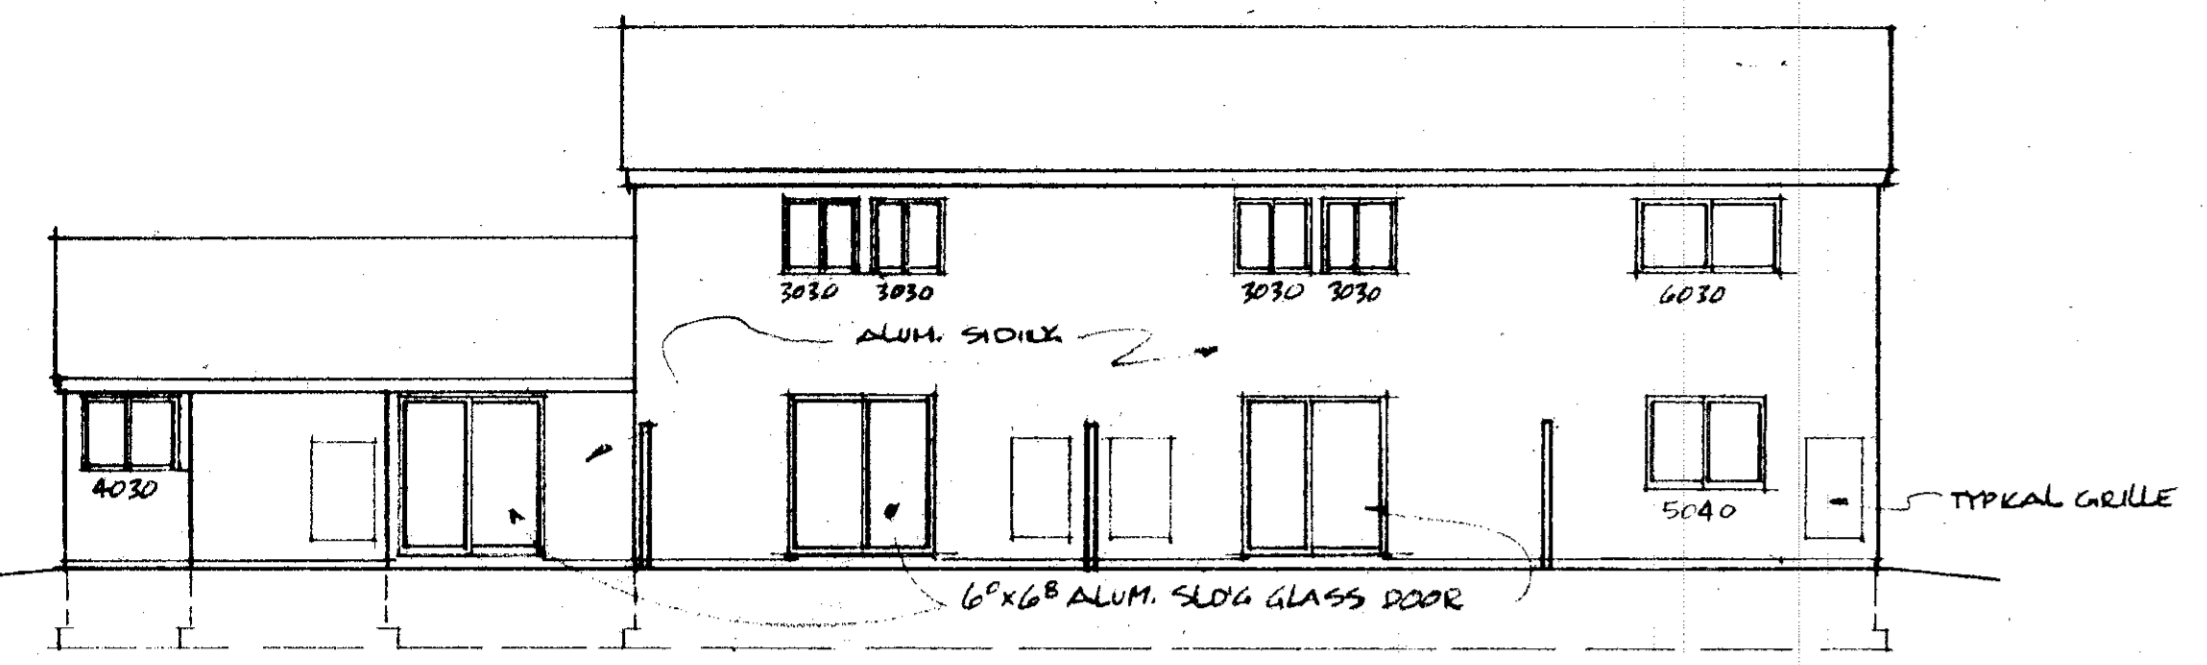


REAR ELEVATION  
1/8"=1'-0"

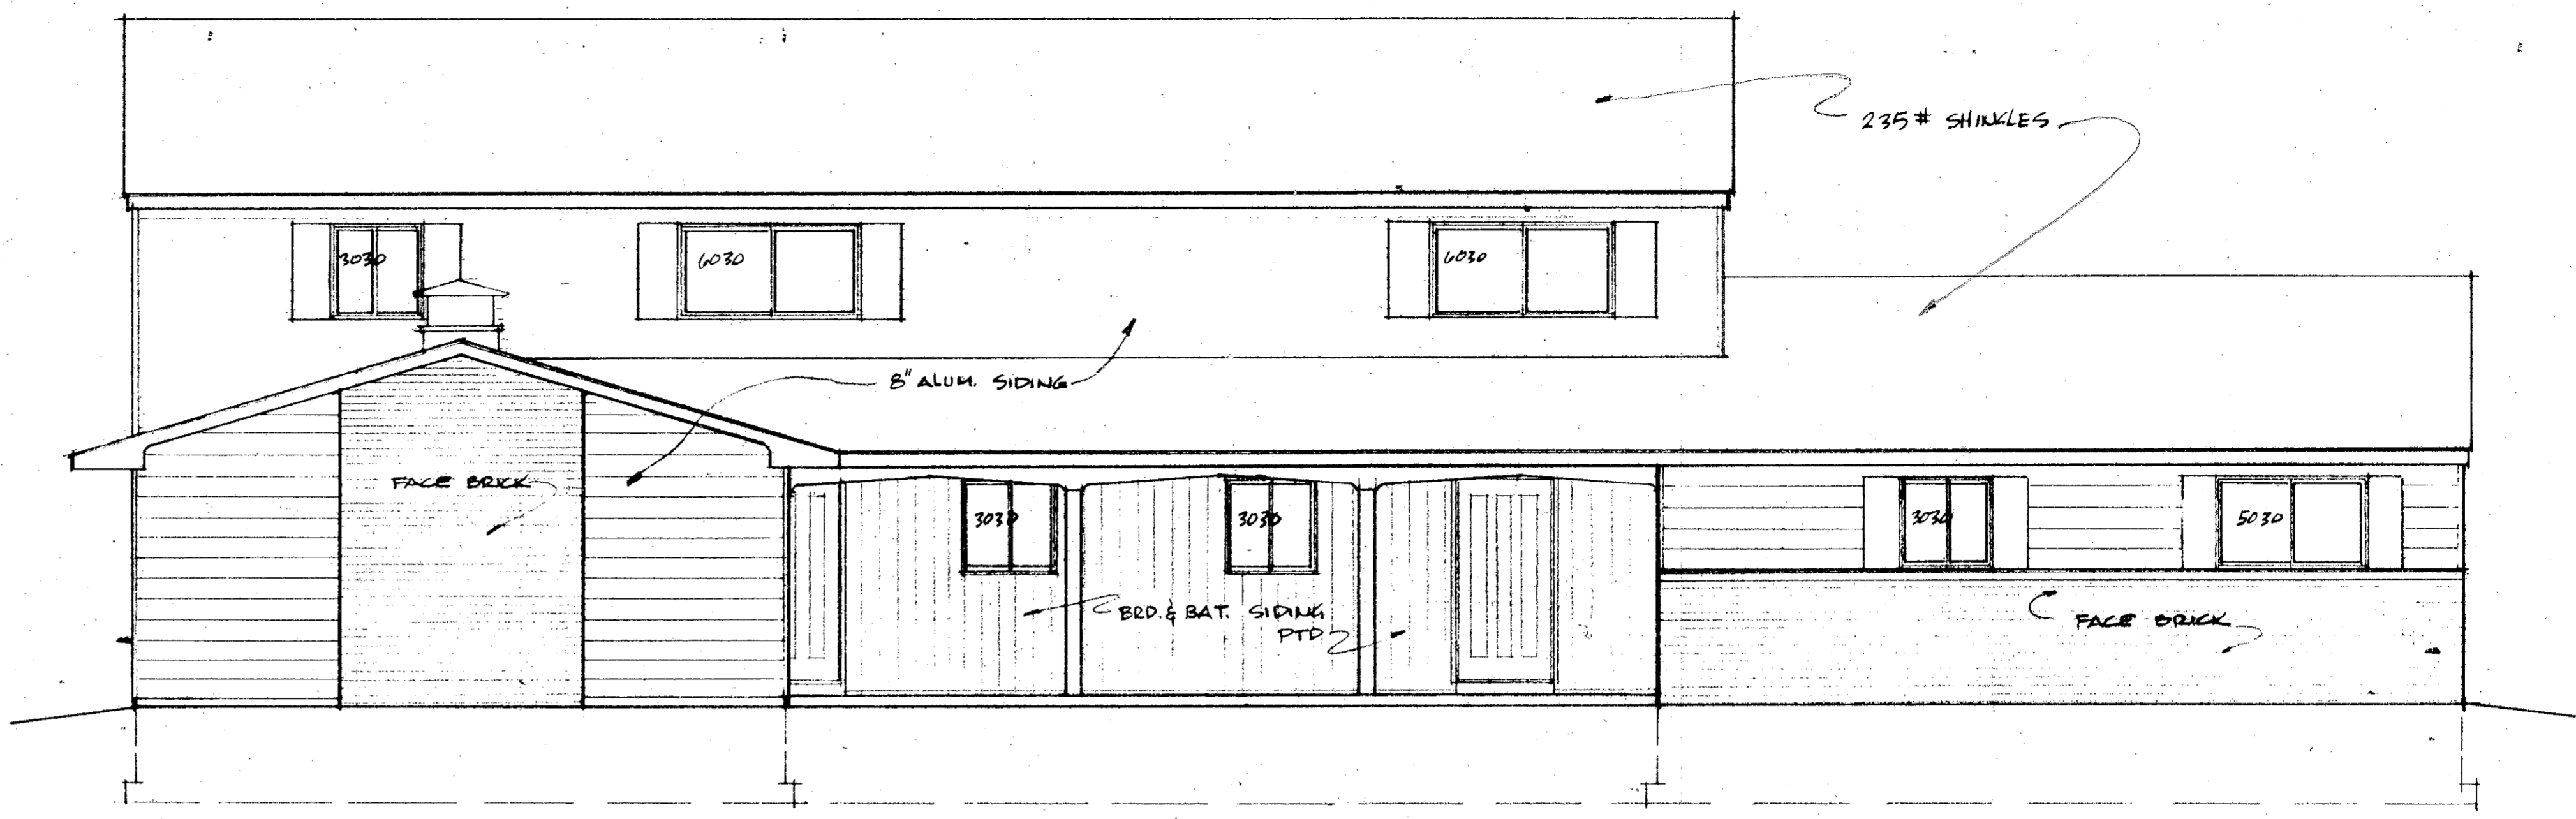

FRONT ELEVATION  
1/4"=1'-0"

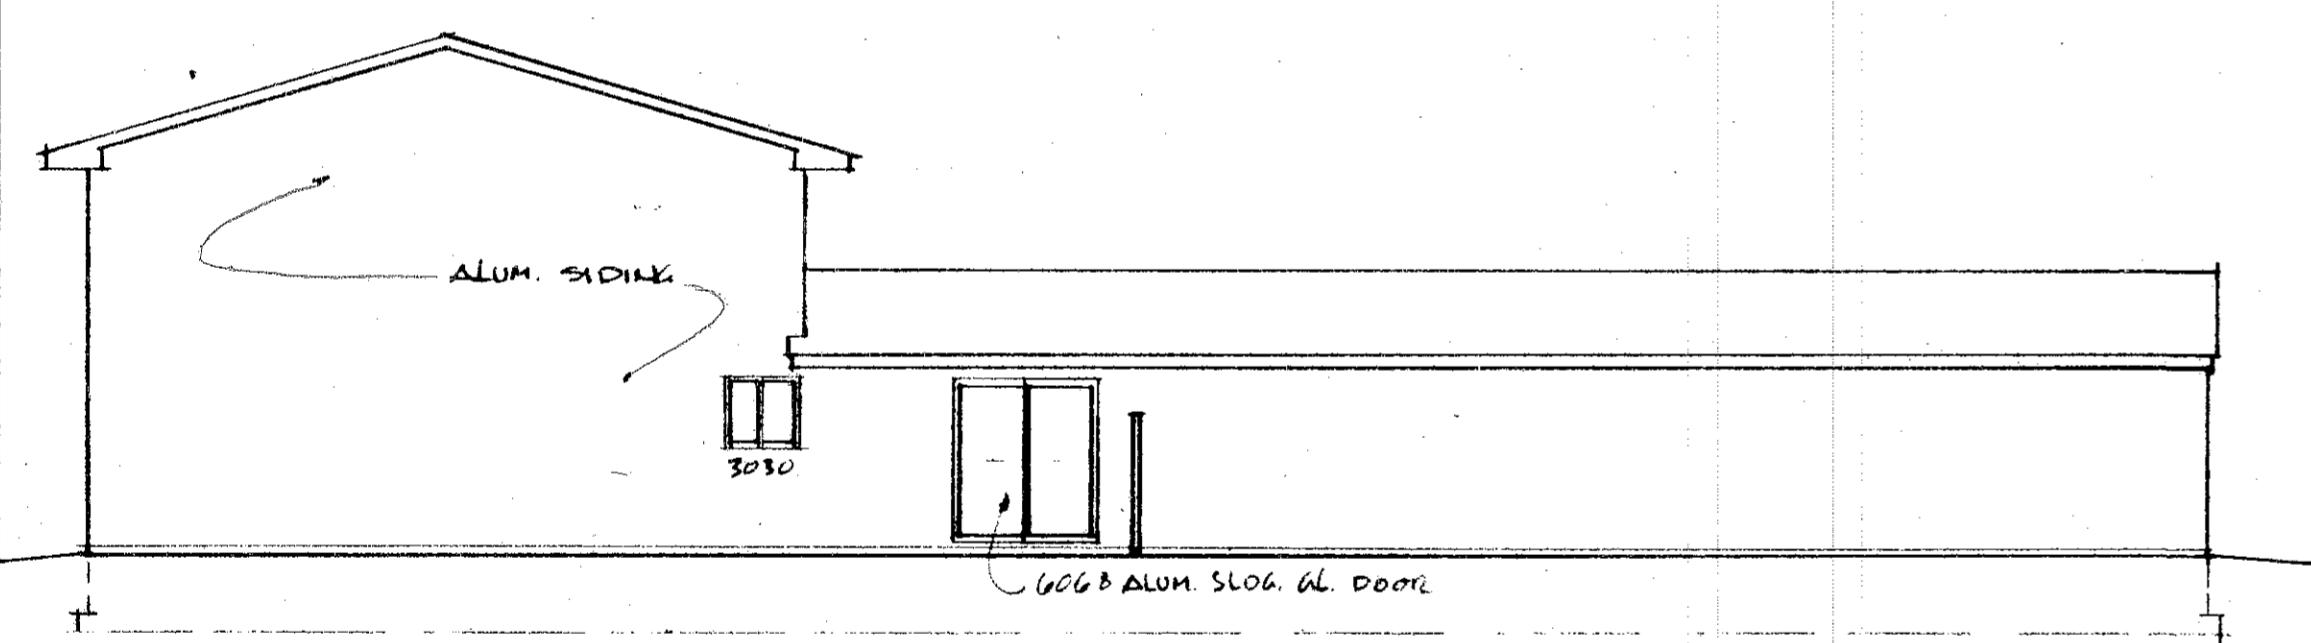


LEFT SIDE ELEVATION  
1/8"=1'-0"

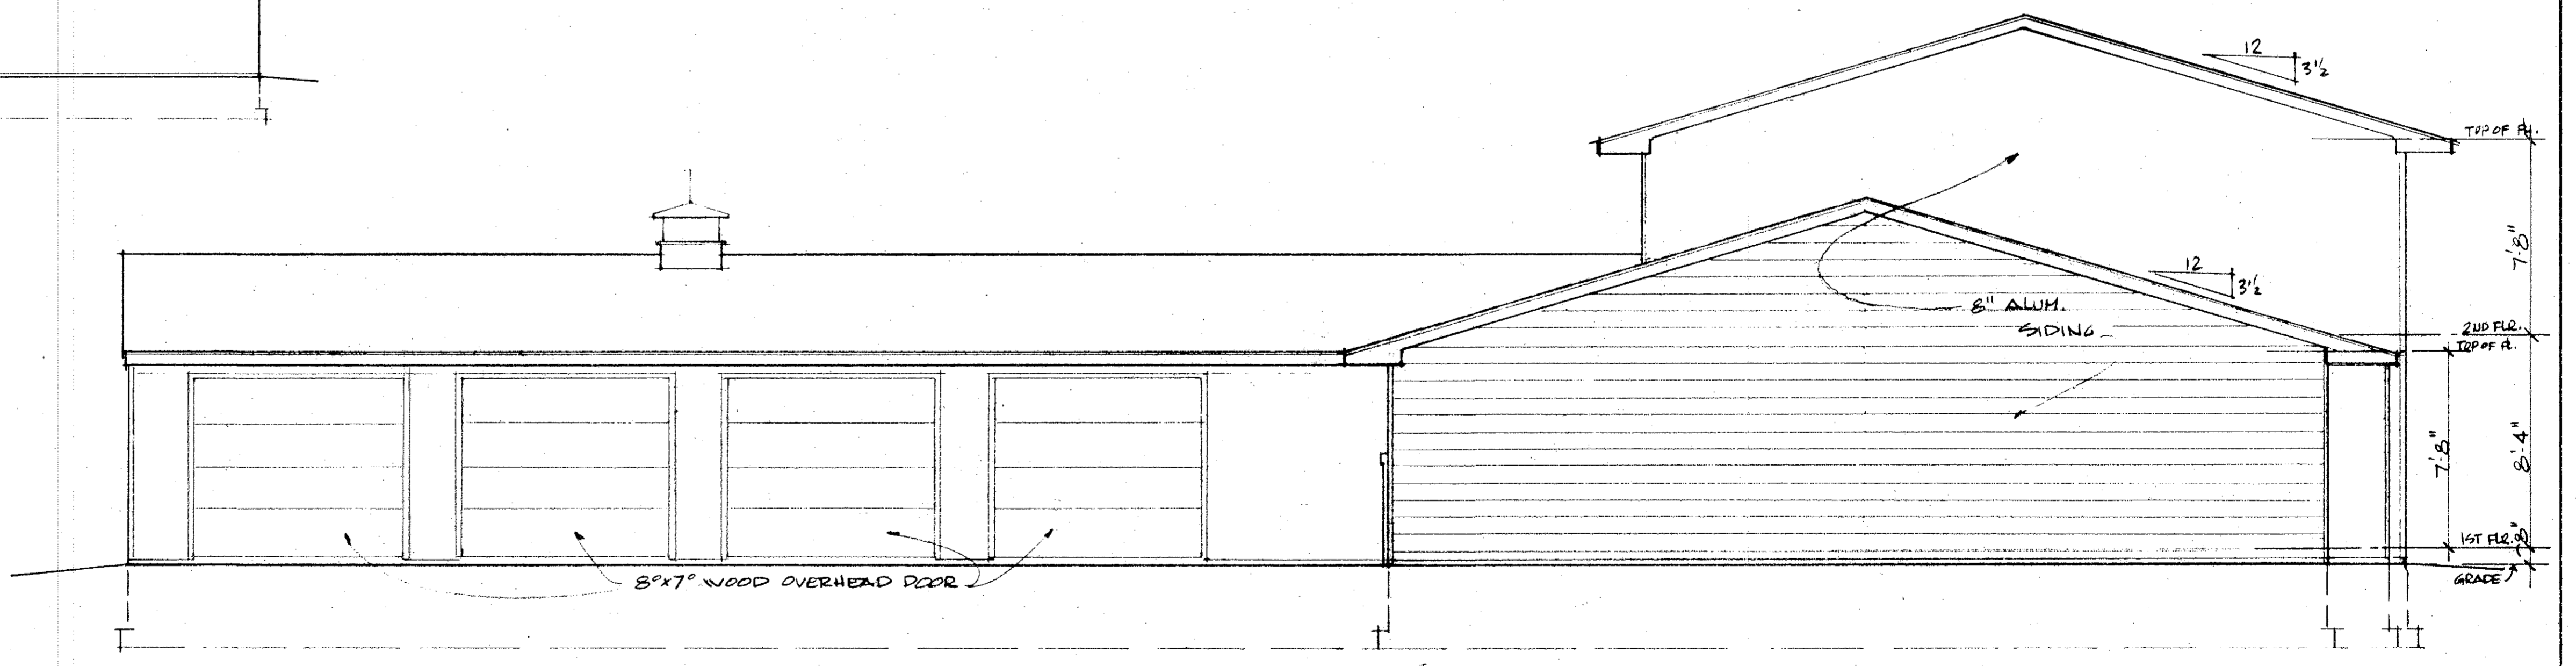

RIGHT SIDE ELEVATION  
1/4"=1'-0"

BLDG 7 - UNITS A,B,C,D,  
8749 W RIDGE RD,

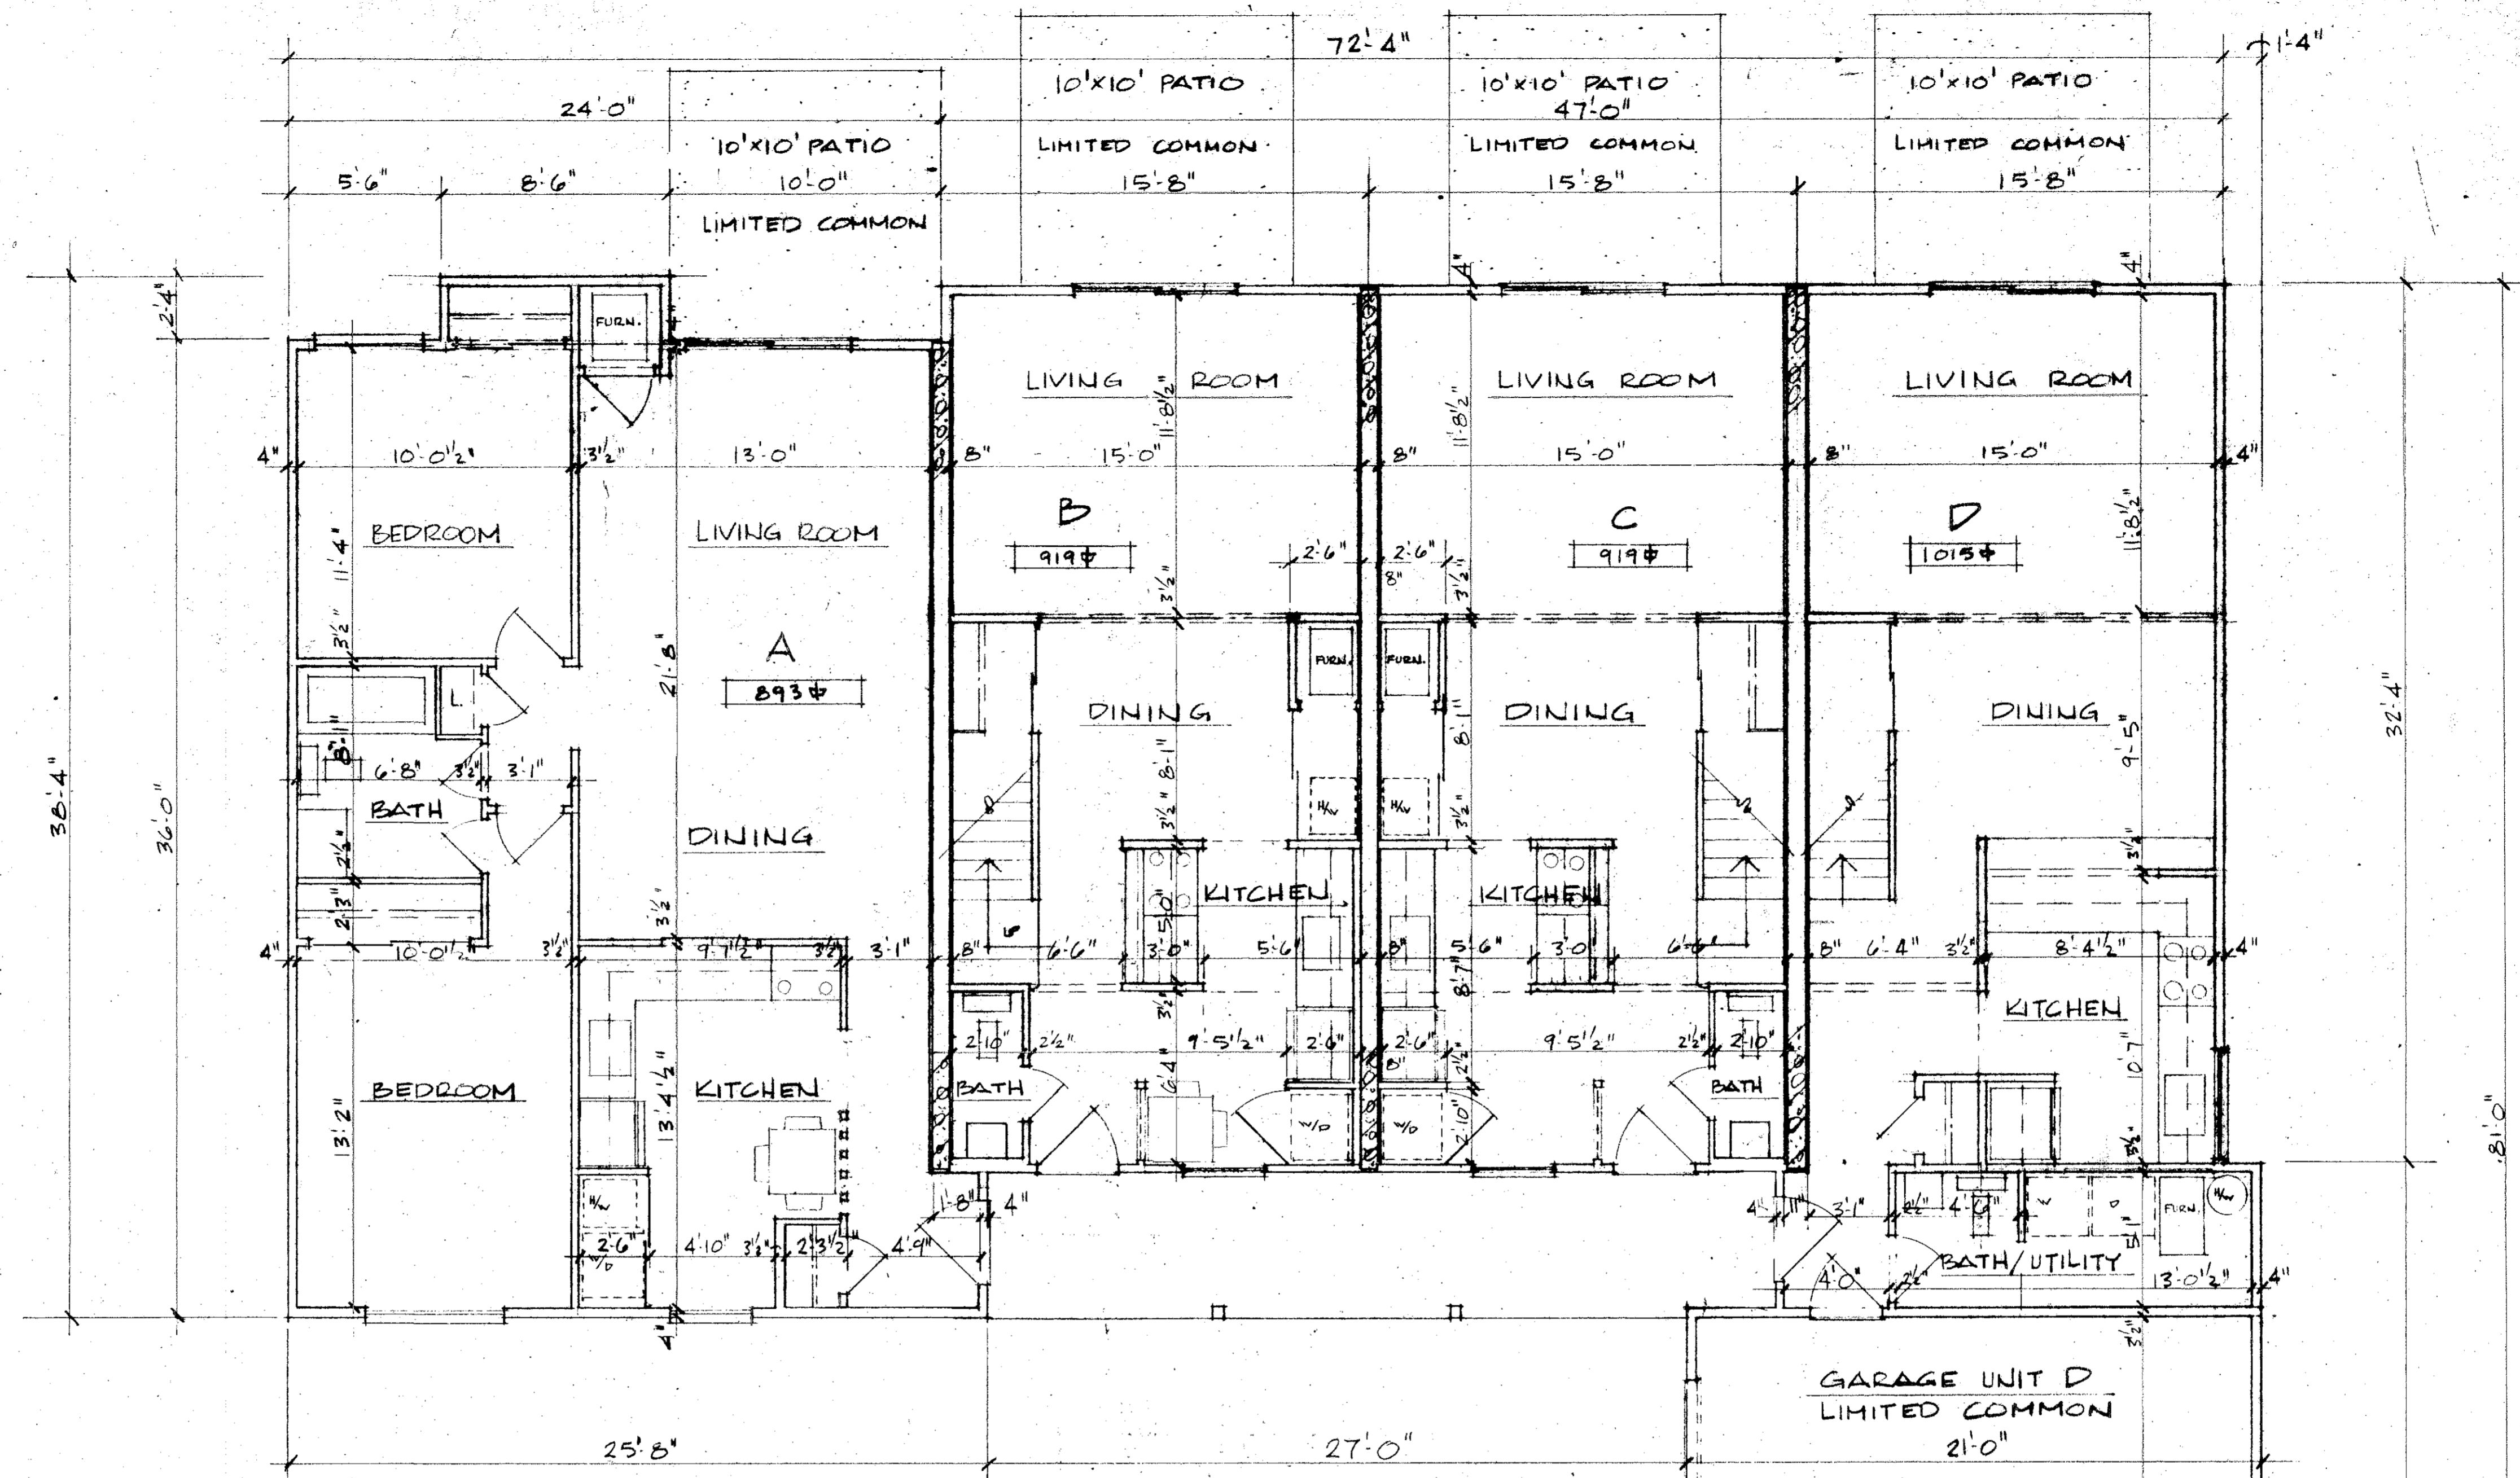


FIRST FLOOR PLAN

SCALE 1/4"=1'-0"




STATEMENT OF CERTIFICATION  
 I CERTIFY THAT THE ATTACHED DRAWINGS  
 CORRECTLY REPRESENT THE BUILDINGS AS  
 CONSTRUCTED AND THAT THERE ARE NO  
 ENCROACHMENTS ON ANY ADJUTING PREMISES.

RICHARD SLY  
 REGISTERED ARCHITECT

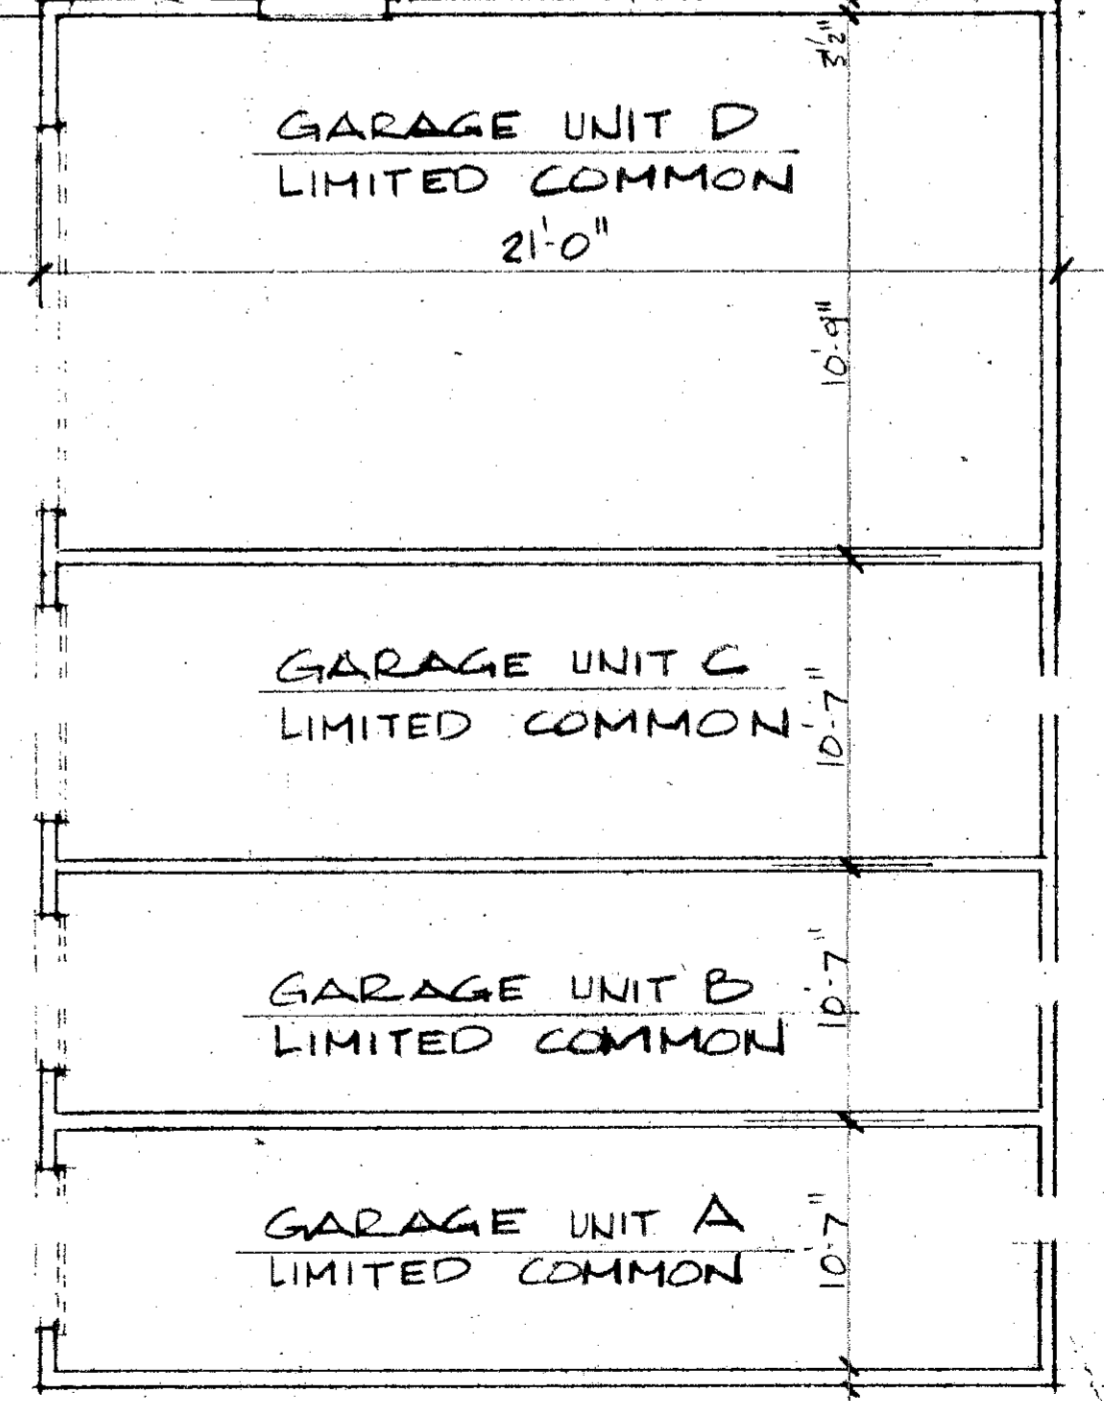


BLDG. 9 - UNITS A,B,C,D  
 8745 W. RIDGE RD.



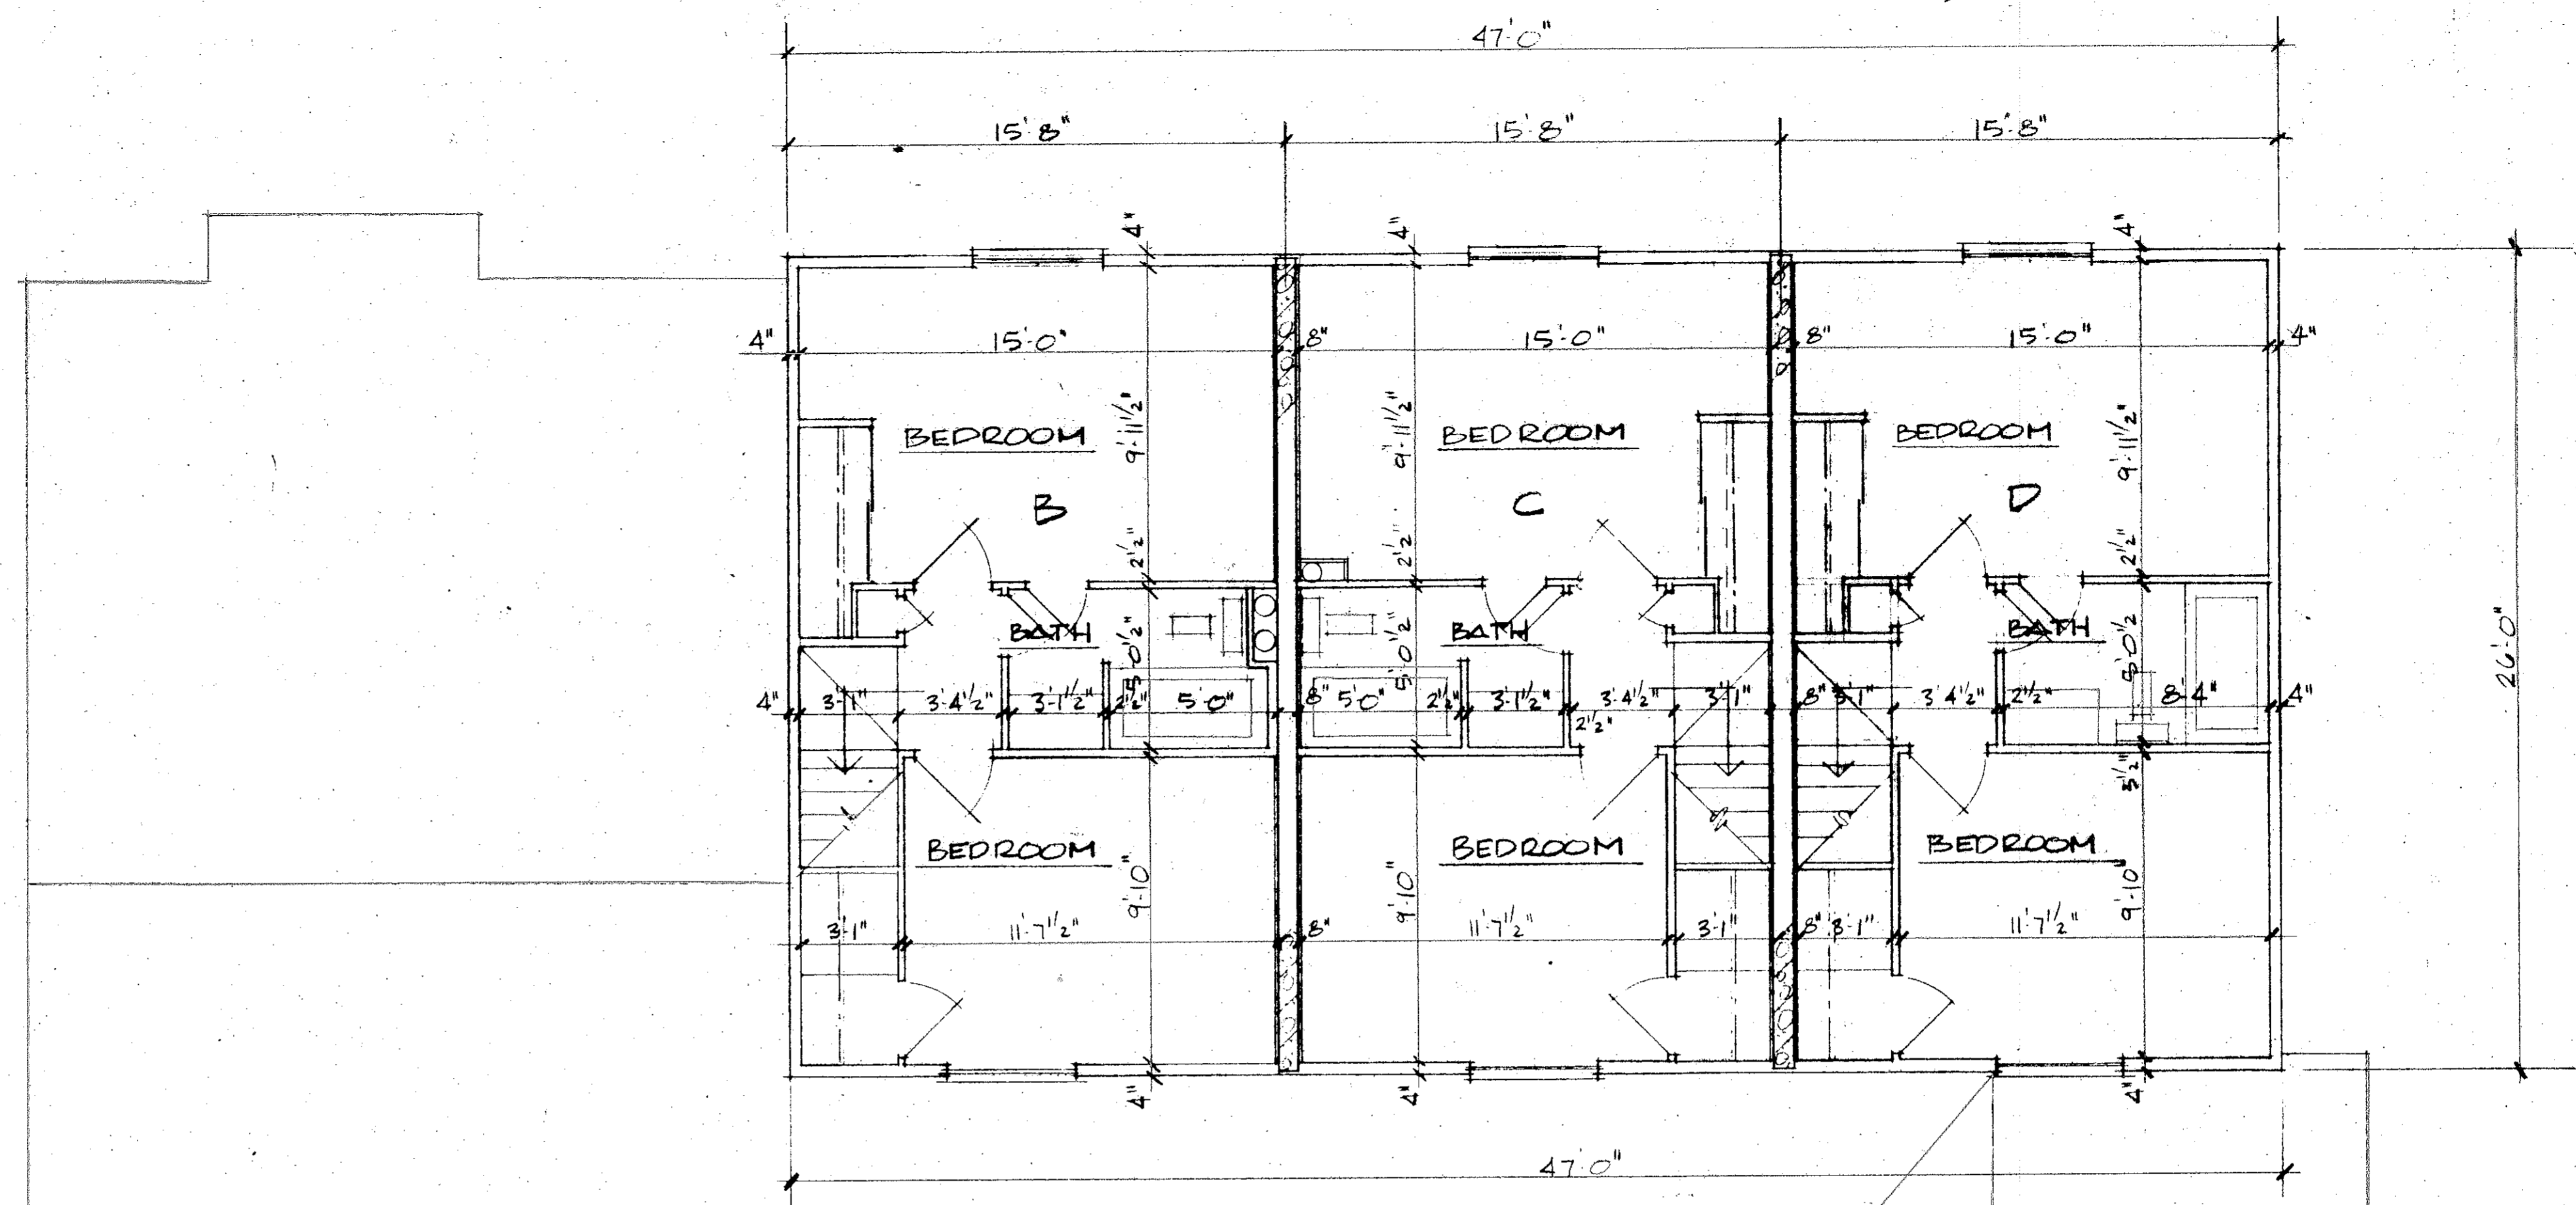


SECOND FLOOR PLAN  
SCALE 1/4" = 1'-0"


JUN 28 1973  
 6-8-73  
 BLDG. 9 - UNITS: A, B, C, D  
 8745 W. RIDGE RD.  
 28/49  
 109

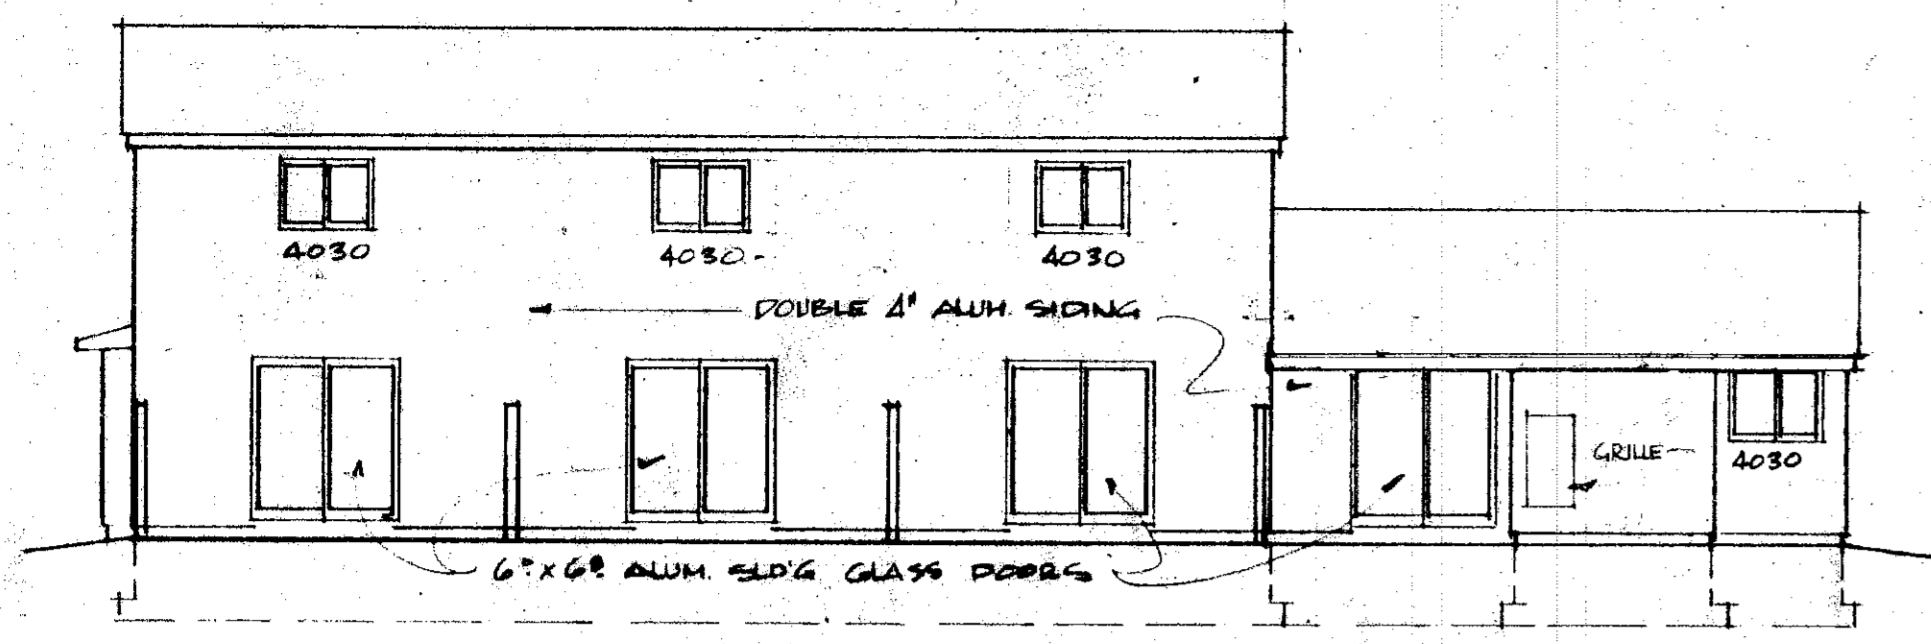


REAR ELEVATION  
SCALE 1/8" = 1'-0"

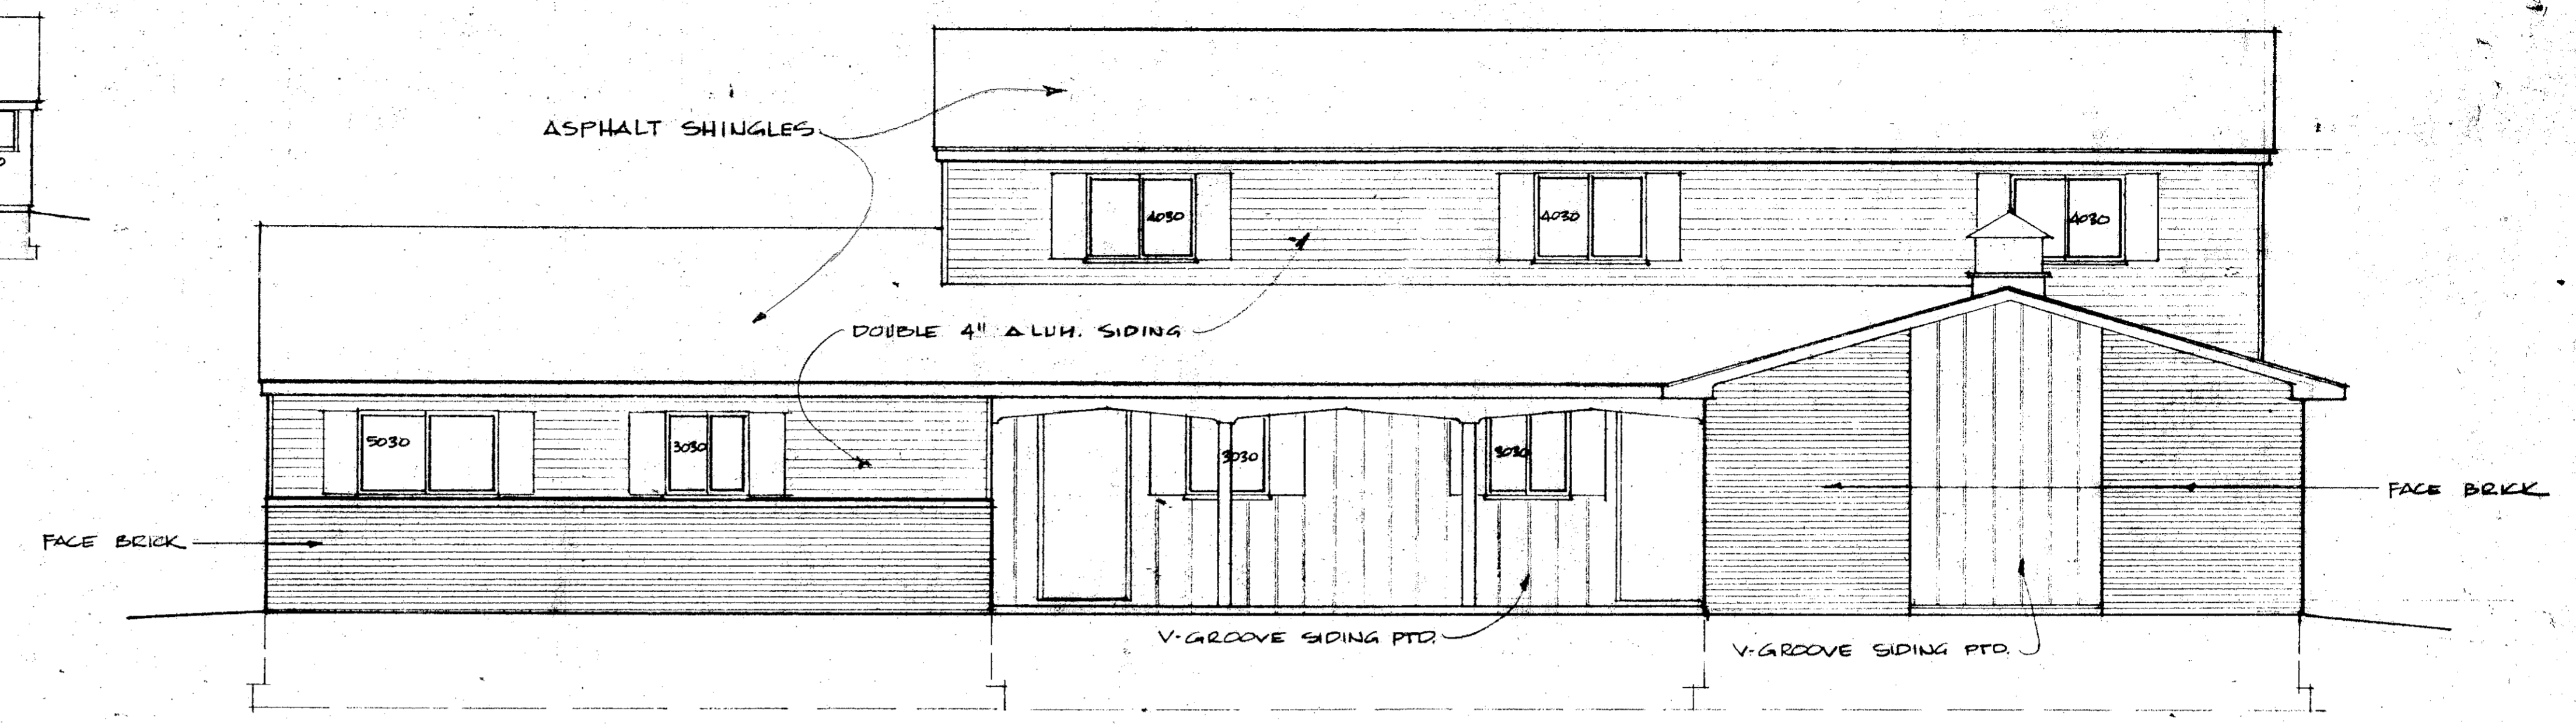

FRONT ELEVATION  
SCALE 1/4" = 1'-0"

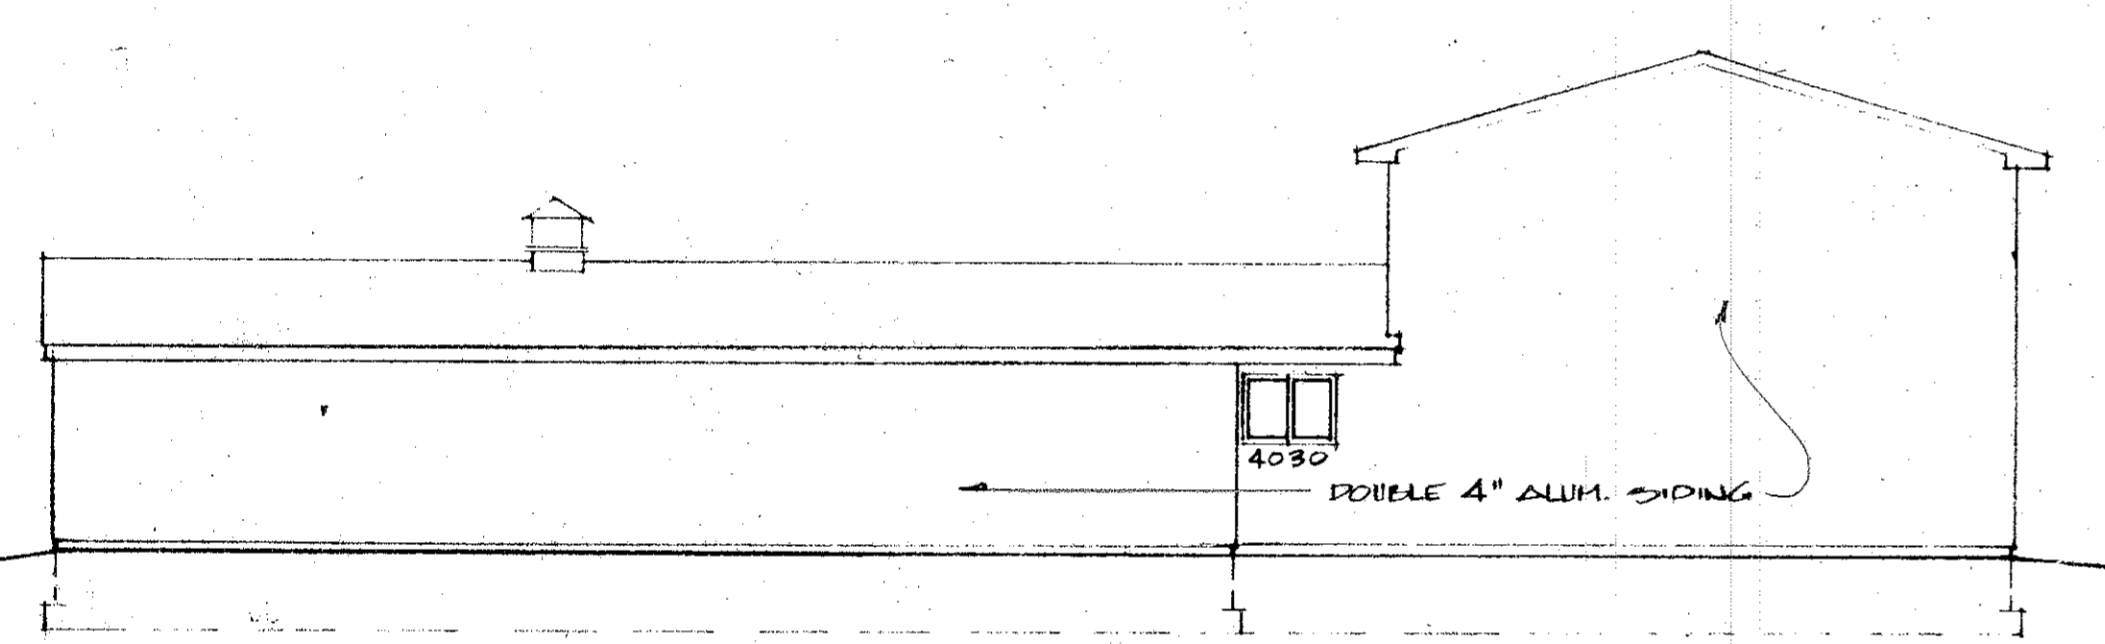

RIGHT SIDE ELEVATION  
SCALE 1/8" = 1'-0"

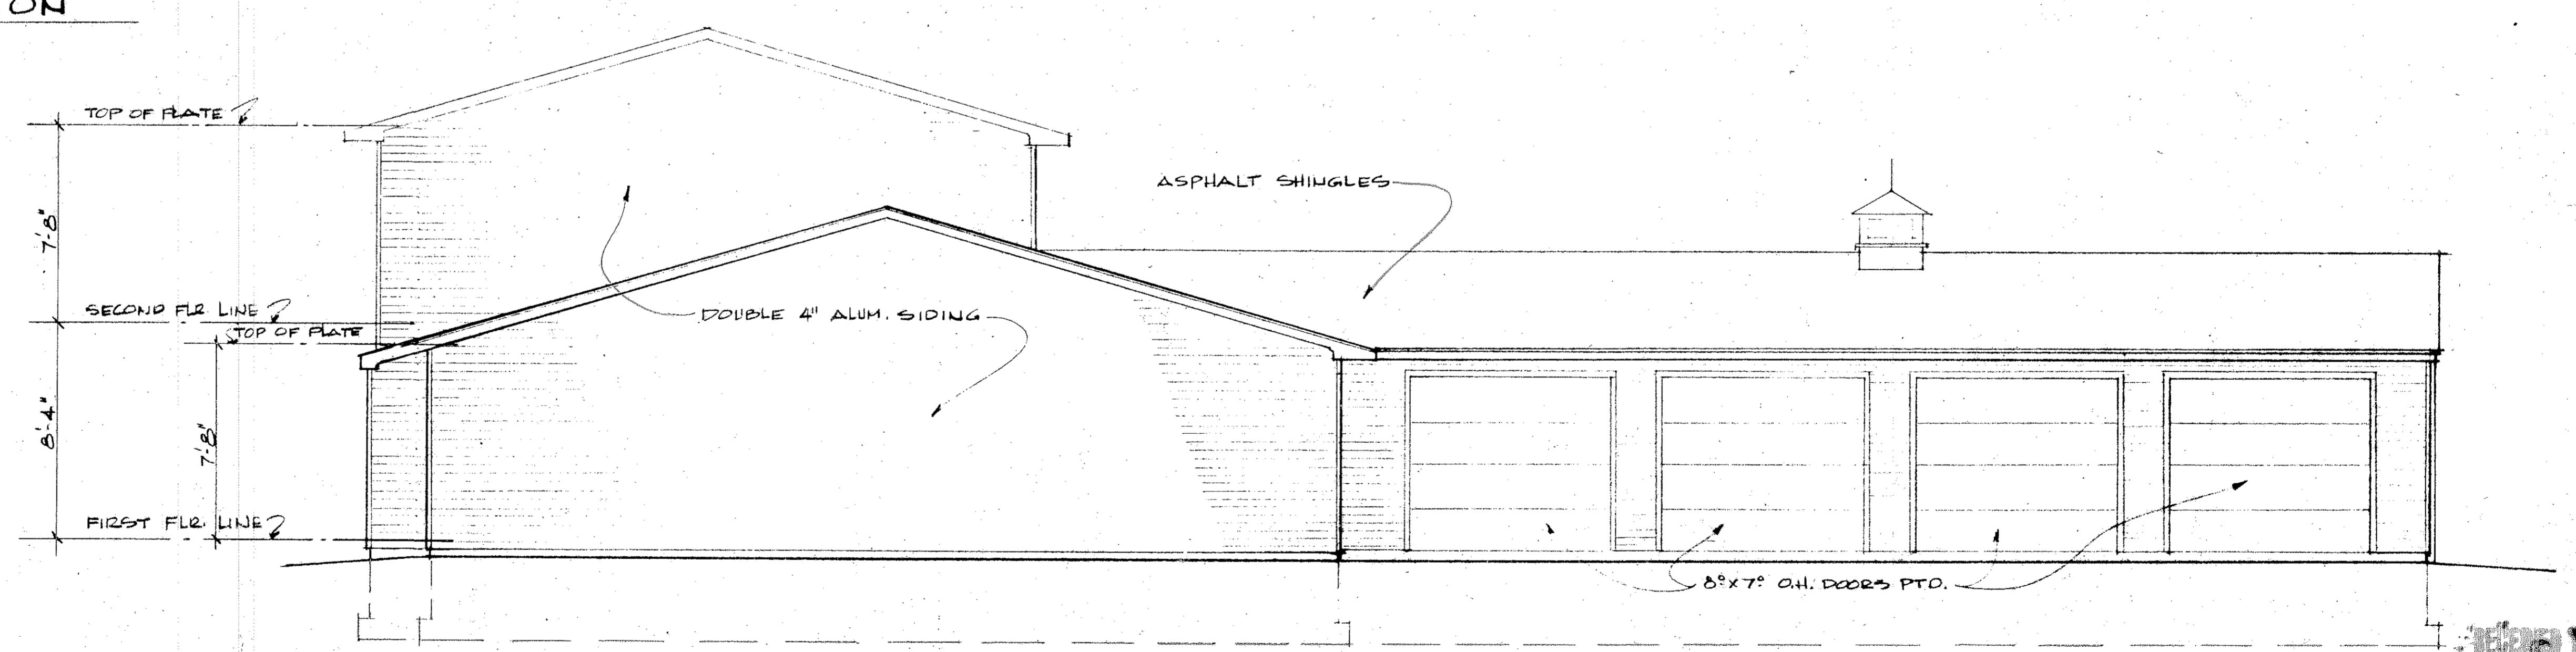

LEFT SIDE ELEVATION  
SCALE 1/4" = 1'-0"

RECORDED FOR RECORD  
 JUN 29 1973  
 RECORDED IN LORAIN  
 COUNTY RECORDS  
 6-8-73

BLDG. 9 - UNITG A,B,C,D 28/50  
 8745 W. RIDGE RD.  
 6-8-73