


29/13

EXHIBIT "A"
DRAWINGS FOR PINE FOREST CONDOMINIUM
OF
MILLS CREEK SUBDIVISION, SECTION "D"
VOLUME 25 OF MAPS, PAGES 37 THRU 42
SCALE 1" = 20'-0" OCTOBER 1973

MILLS CREEK CONDOMINIUM
OF MILLS CREEK
SUBDIVISION, SECTION "D"
VOL. 25 OF MAPS
PAGES 37 THRU 42

PART OF MILLS CREEK
SUBDIVISION, SECTION "D"
VOL. 25 OF MAPS
PAGES 37 THRU 42

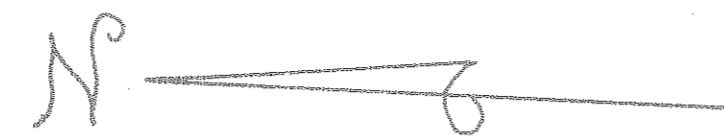



9 E MILLS CREEK LANE 60'

Q & MILLS ROAD

Q & PEARL TREE LANE 60'

Q & WHITE PINE WAY
20' CONC. PAVING

WE, PRESTON R. SPENCER, REGISTERED SURVEYOR
OHIO 6047 AND EDWARD A. SCHMITT REGISTERED
ARCHITECT OHIO 4404 HEREBY CERTIFY THAT
THE WITH-IN DRAWINGS FOR PINE FOREST
CONDOMINIUM AMENDMENT
(CONSISTING OF PAGES 1/4 THRU 1/4)
ACCURATELY SHOW THE BUILDINGS AS CONSTRUCTED.

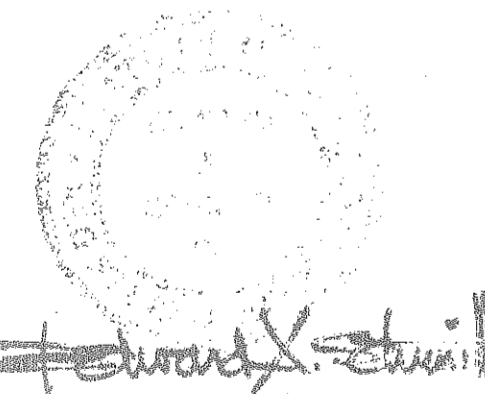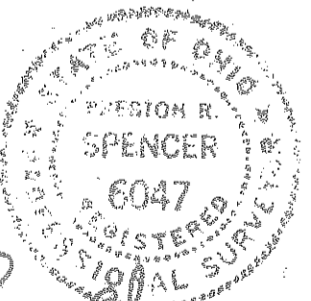

#7517
APPROVED
LORAIN CO.
MAP DEPT.
DATE _____
PAGE _____
BY _____
VOIDS AFTER _____


FOR FILE
9/25/73

PART OF MILLS CREEK
SUBDIVISION, SECTION "D"
VOL. 25 OF MAPS
PAGES 37 THRU 42

Recorded for Record NOV 15, 1973
at _____ in _____ RECORD,
VOL. 25
PAGE 37-42
Lorain County Recorder

Lawyers Title

LEGEND
C.A. - COMMON AREAS & FACILITIES
L.C.A. - LIMITED COMMON AREAS & FACILITIES
L.C.A. BOUNDARY LINE
PROPERTY LINE
UTILITIES BASEMENT LINE
FINISH FLOOR ELEVATION

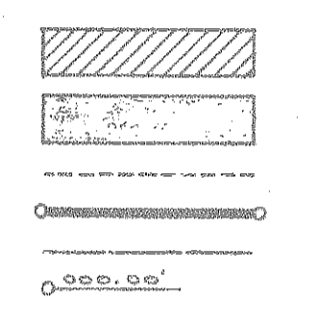

PART OF MILLS CREEK
SUBDIVISION, SECTION "D"
VOL. 25 OF MAPS
PAGES 37 THRU 42

29/13

EXHIBIT "A"
DRAWINGS FOR PINE FOREST CONDOMINIUM
OF
MILLS CREEK SUBDIVISION, SECTION "D"
VOLUME 25 OF MAPS, PAGES 37 THRU 42
SCALE 1" = 20' 0" OCTOBER 1973




PART OF MILLS CREEK SUBDIVISION
SECTION "D"
VOLUME 25, PAGES 37 THRU 42

PART OF MILLS CREEK
SUBDIVISION, SECTION "D"
VOL. 25 OF MAPS, PAGES 37 THRU 42

MILLS CREEK LANE 60'

MILLS CREEK ROAD

FERN TREE LANE 60'

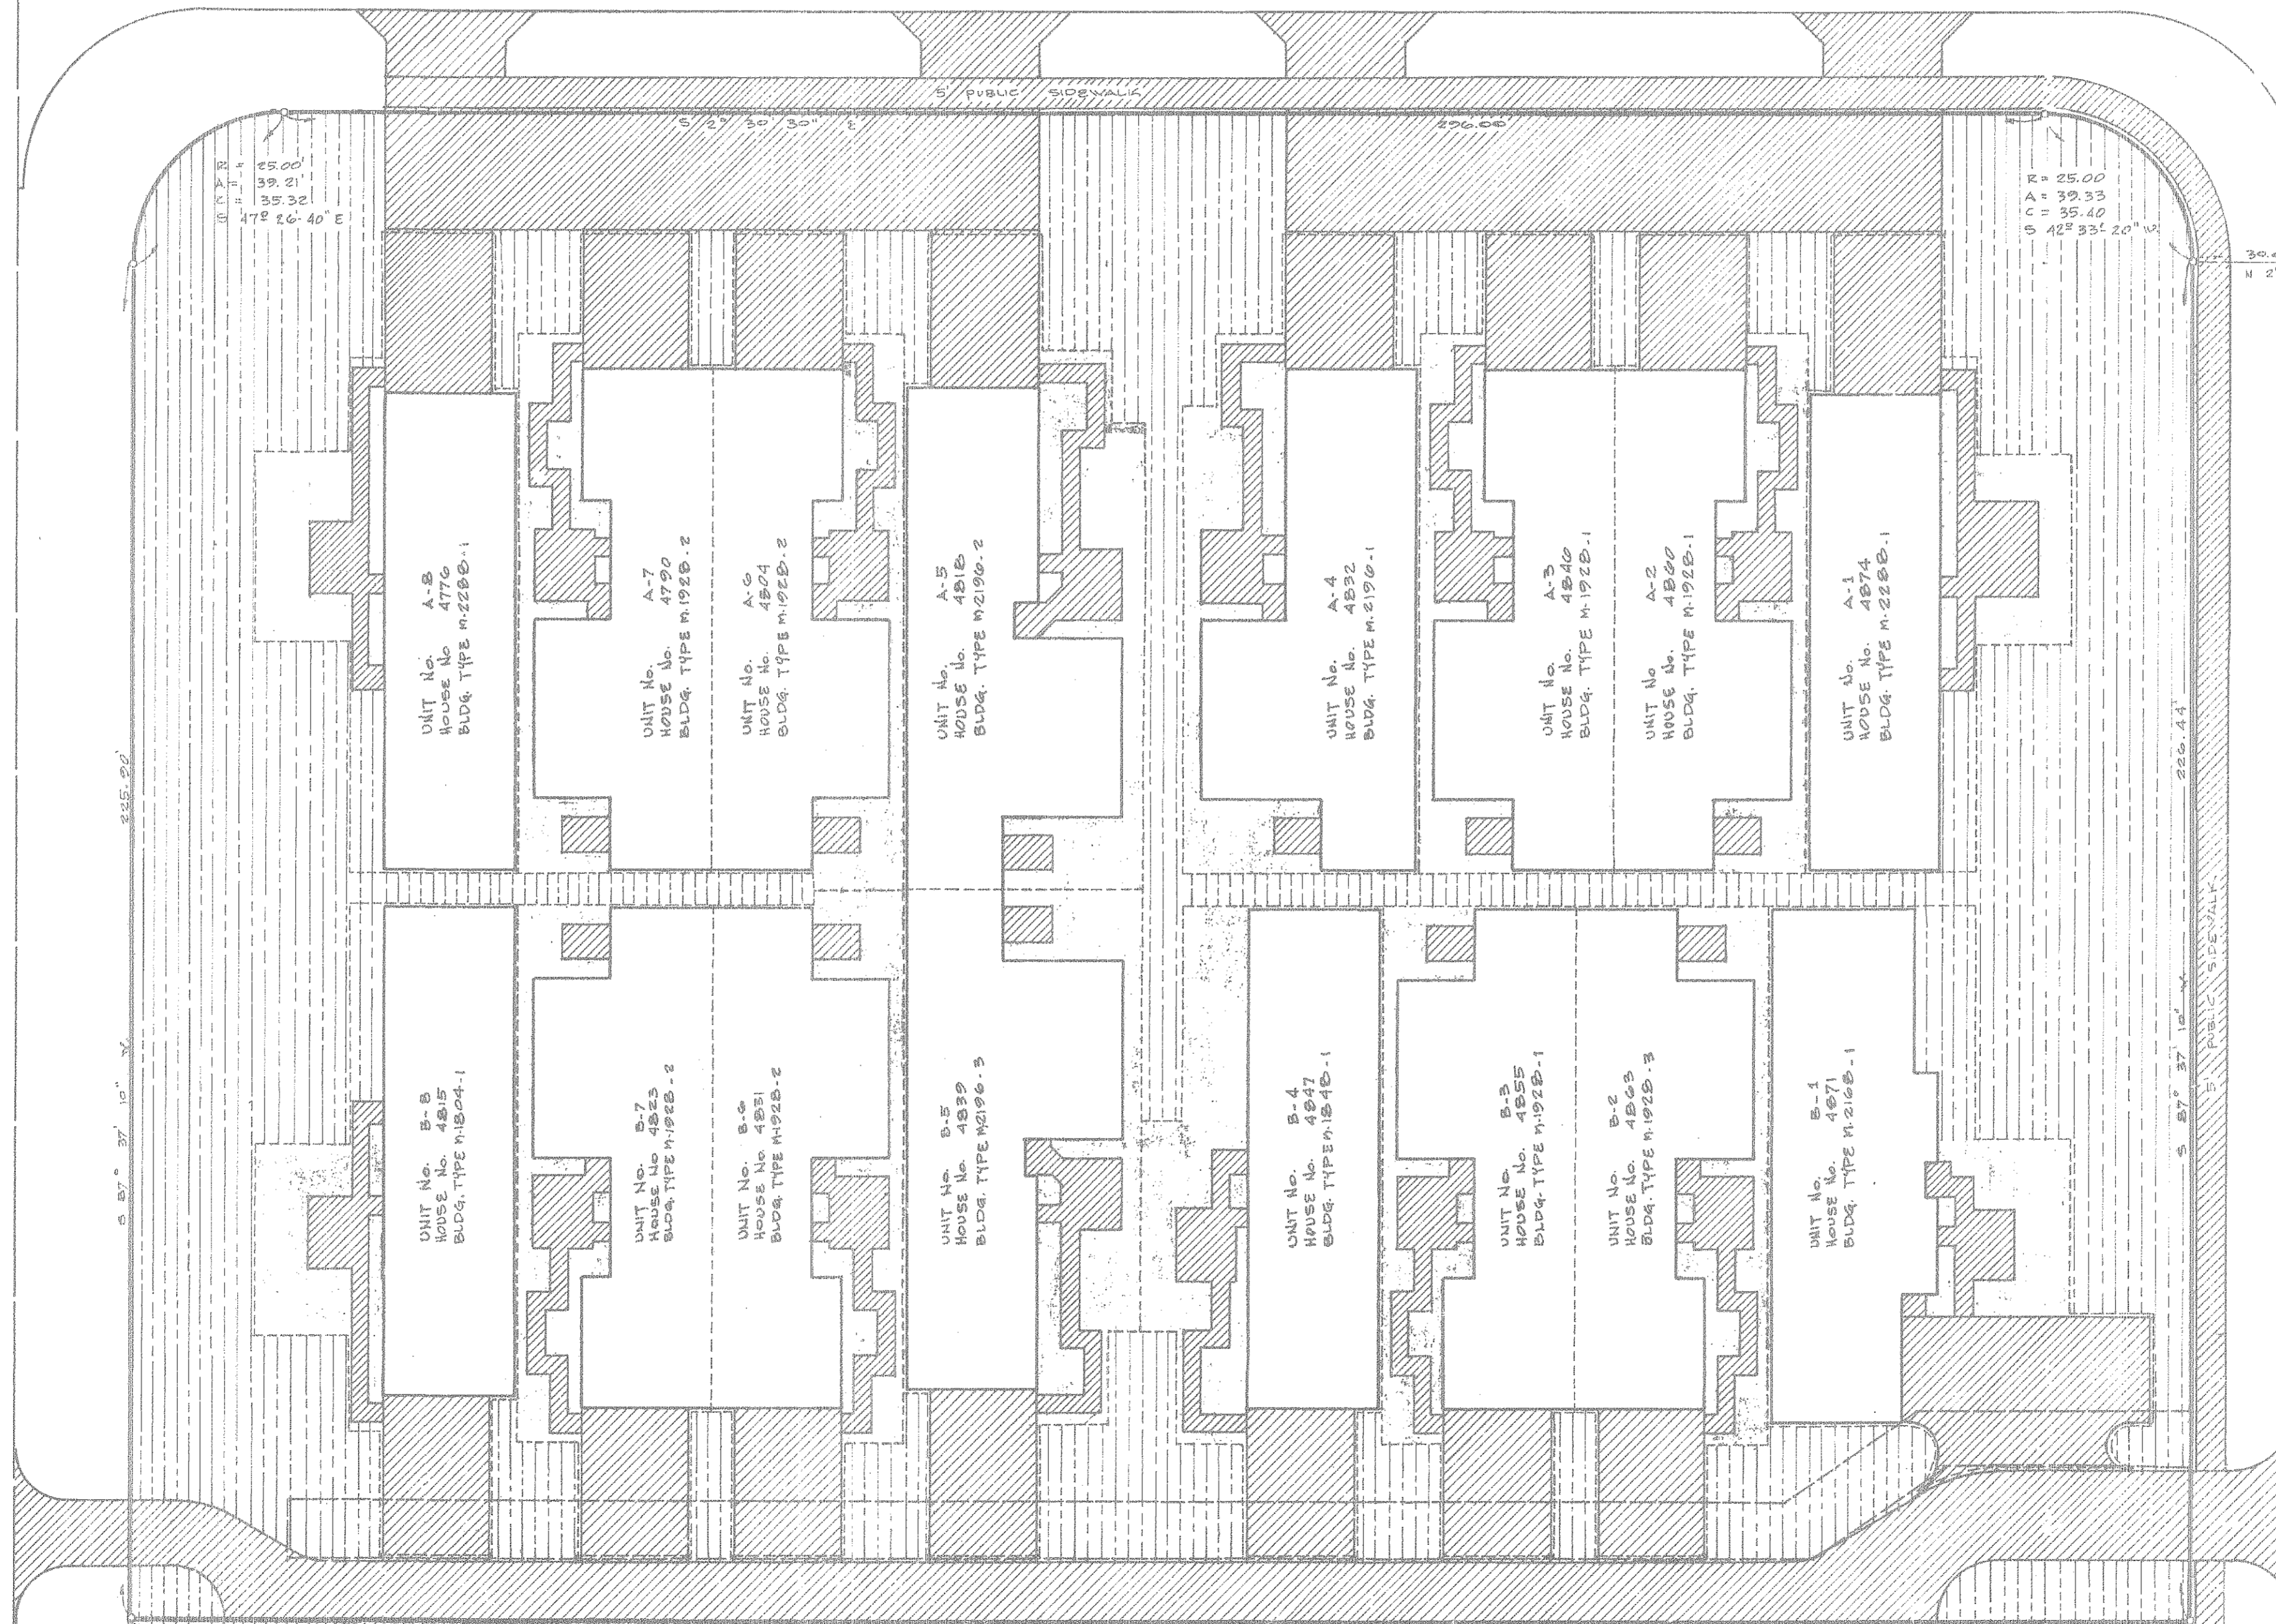

PART OF MILLS CREEK
SUBDIVISION, SECTION "D"
VOLUME 25 OF MAPS
PAGES 37 THRU 42

LEGEND


- L.C.A. BOUNDARY
- PROPERTY LINE
- UTILITY EASEMENT
- CONCRETE WALKS, DRIVES & ACCESS ROADS
- INFORMAL PLANTING AREAS
- PATIO COURT YARD AREAS

PART OF MILLS CREEK SUBDIVISION
SECTION "D"
VOL. 25 OF MAPS, PAGES 37 THRU 42

11/1/73

EXHIBIT "A"
PINE FOREST CONDOMINIUM
TYPICAL WALL SECTIONS

SCALE 3/4" = 1'-0" OCTOBER 1973

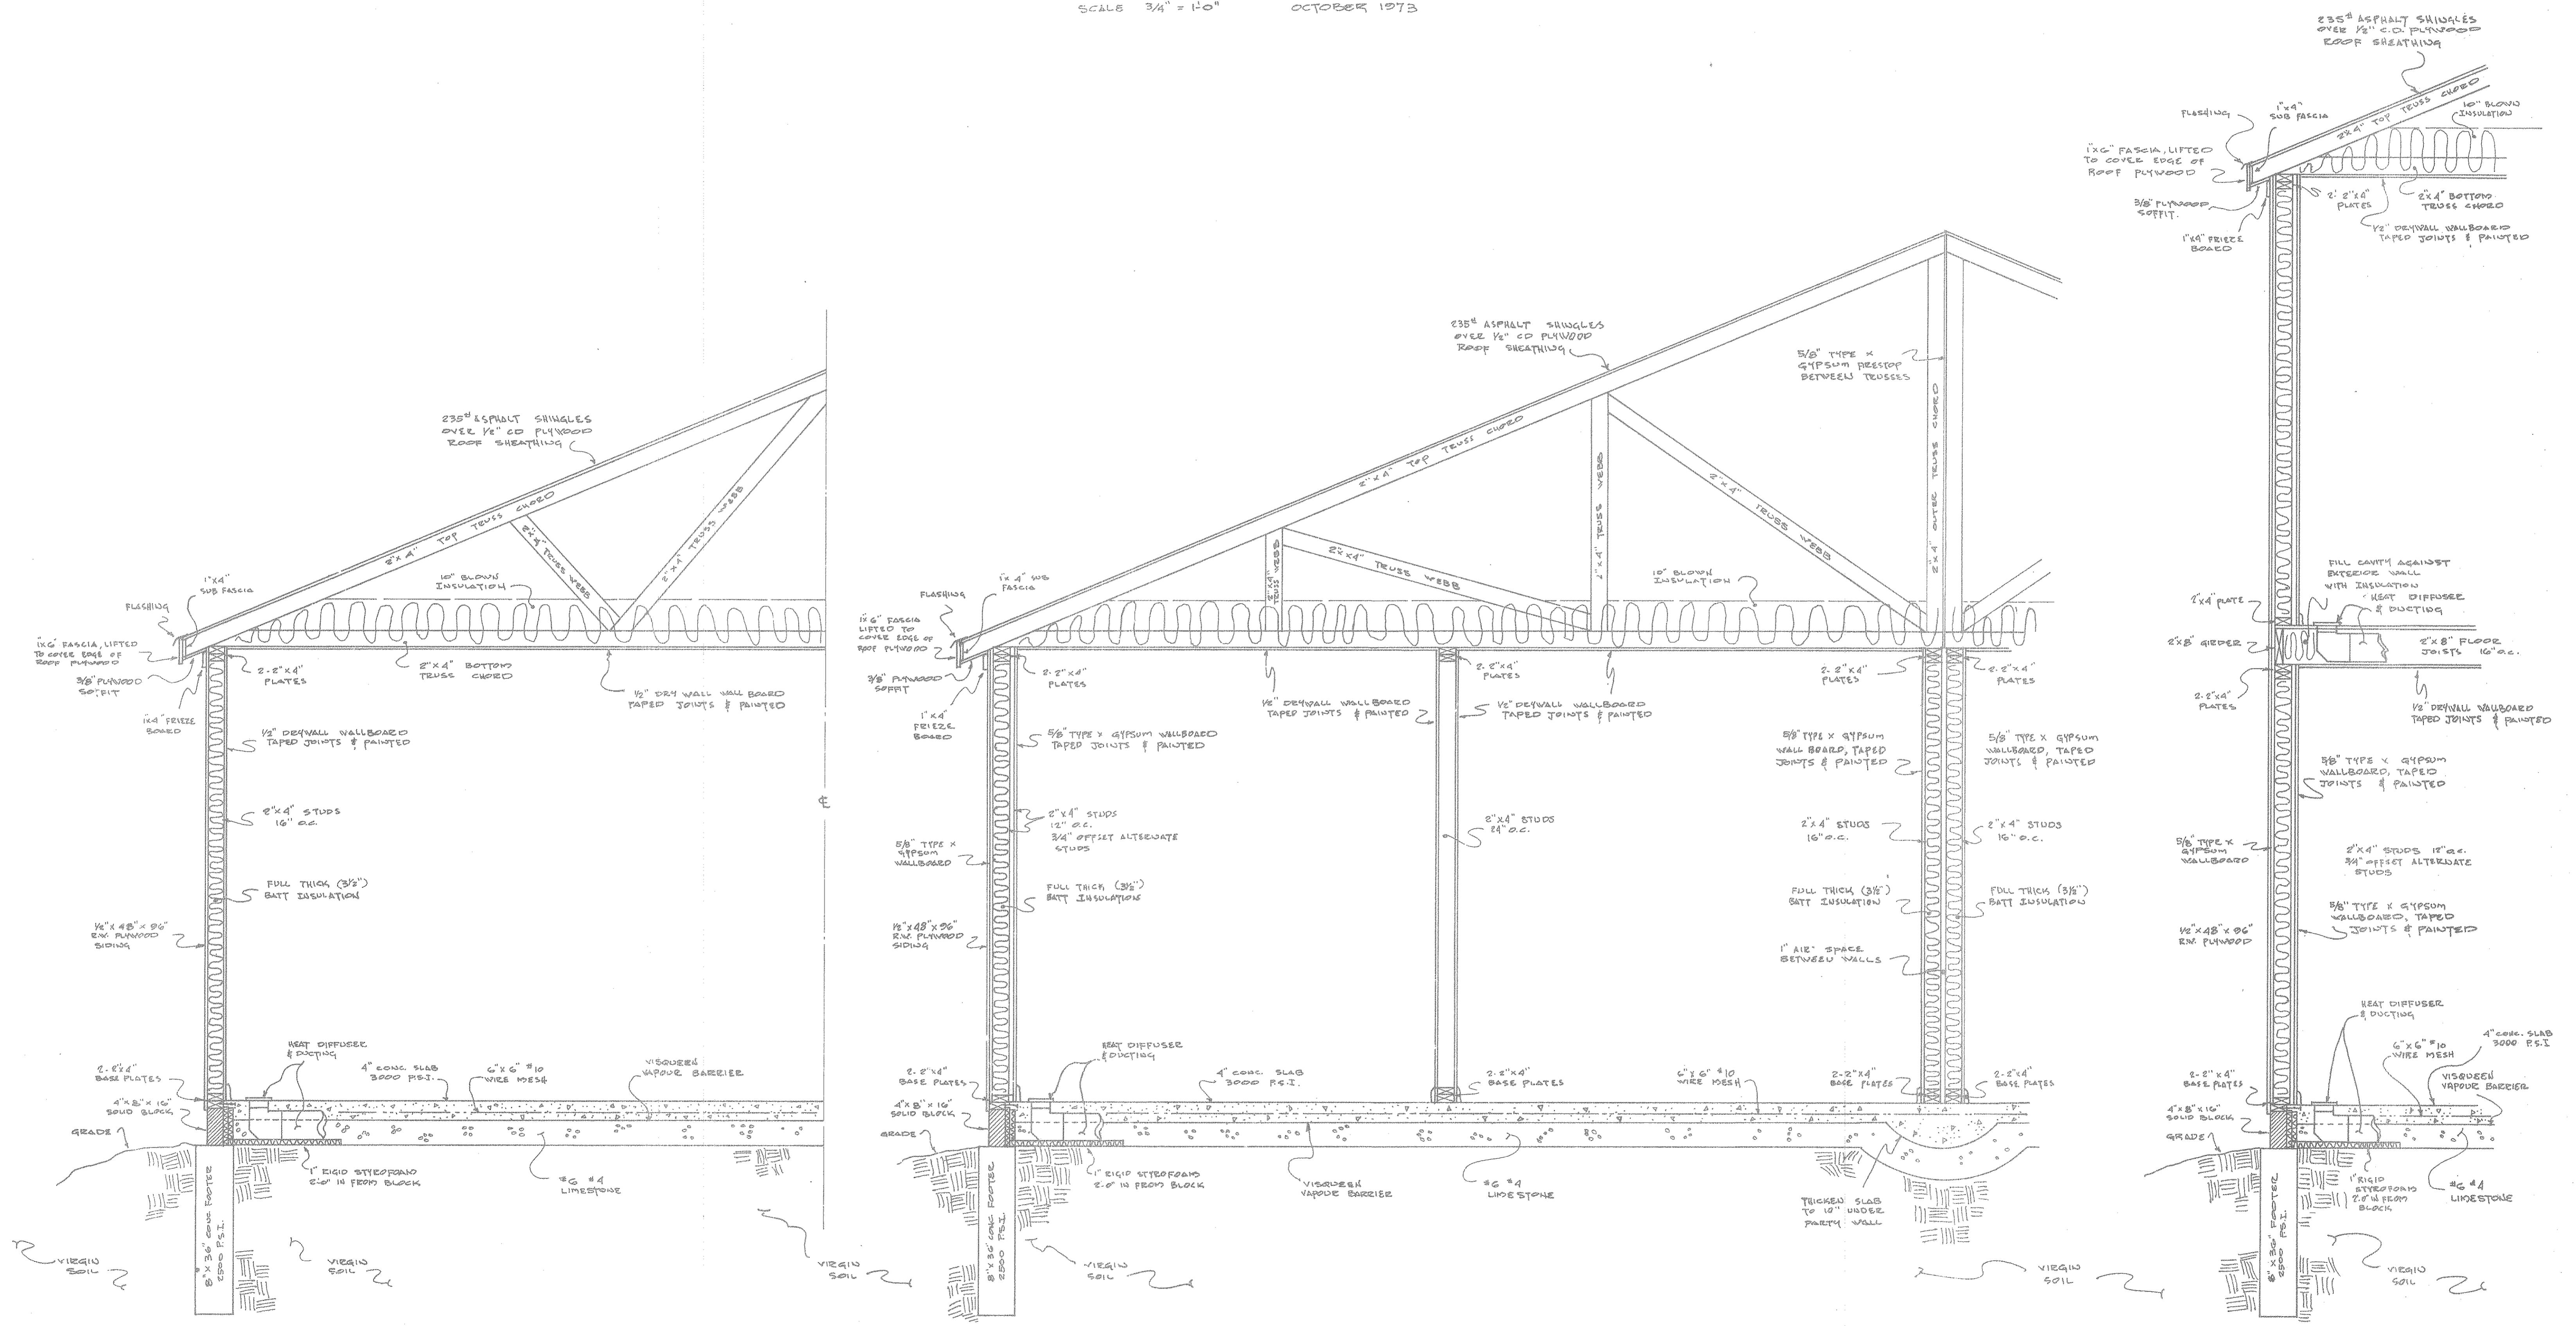

TYPICAL EXTERIOR WALL SECTION

SOUND & FIRE EXTERIOR WALL SECTION

INTERIOR PARTITION WALL SECTION

COMMON PARTY WALL SECTION

2 STORY WALL SECTION


REV

EXHIBIT "A"
PINE FOREST CONDOMINIUM
FLOOR PLANS


SCALE 1/8" = 1'-0" OCTOBER 1973

PLANNED
CITY OF CINCINNATI
NOV 13 1973
CINCINNATI COUNTY AUDITOR


10/13/73
R.L.
M.H.

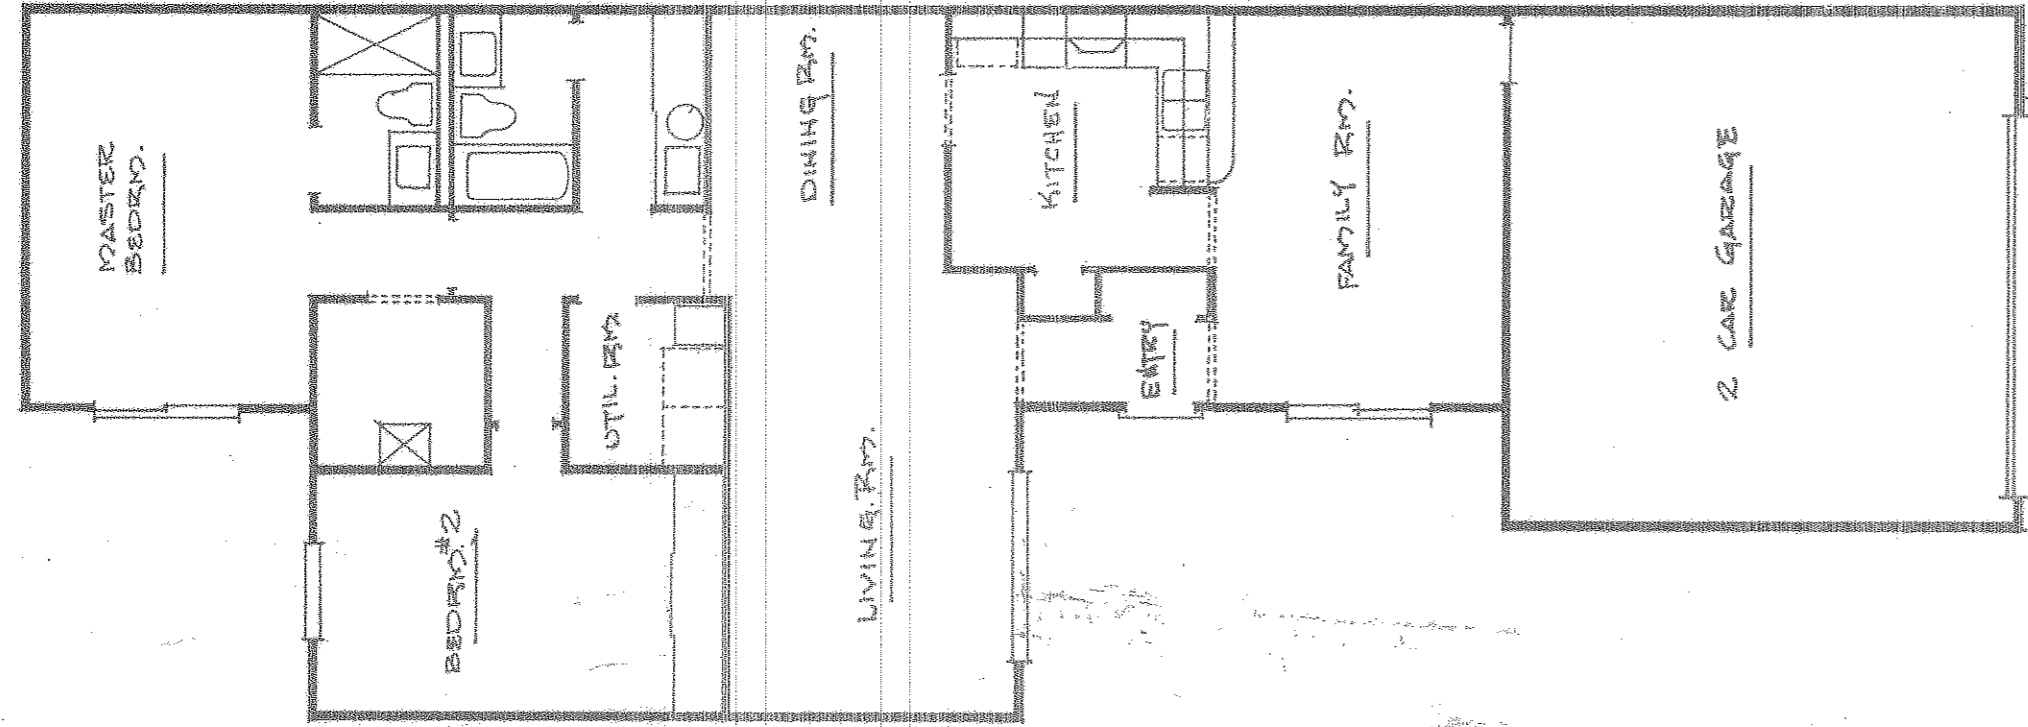


2 BEDROOM FLOOR
PLAN 1925A-1
BLDG. TYPE M-1925-1
USED FOR UNIT NUMBERS
B-2

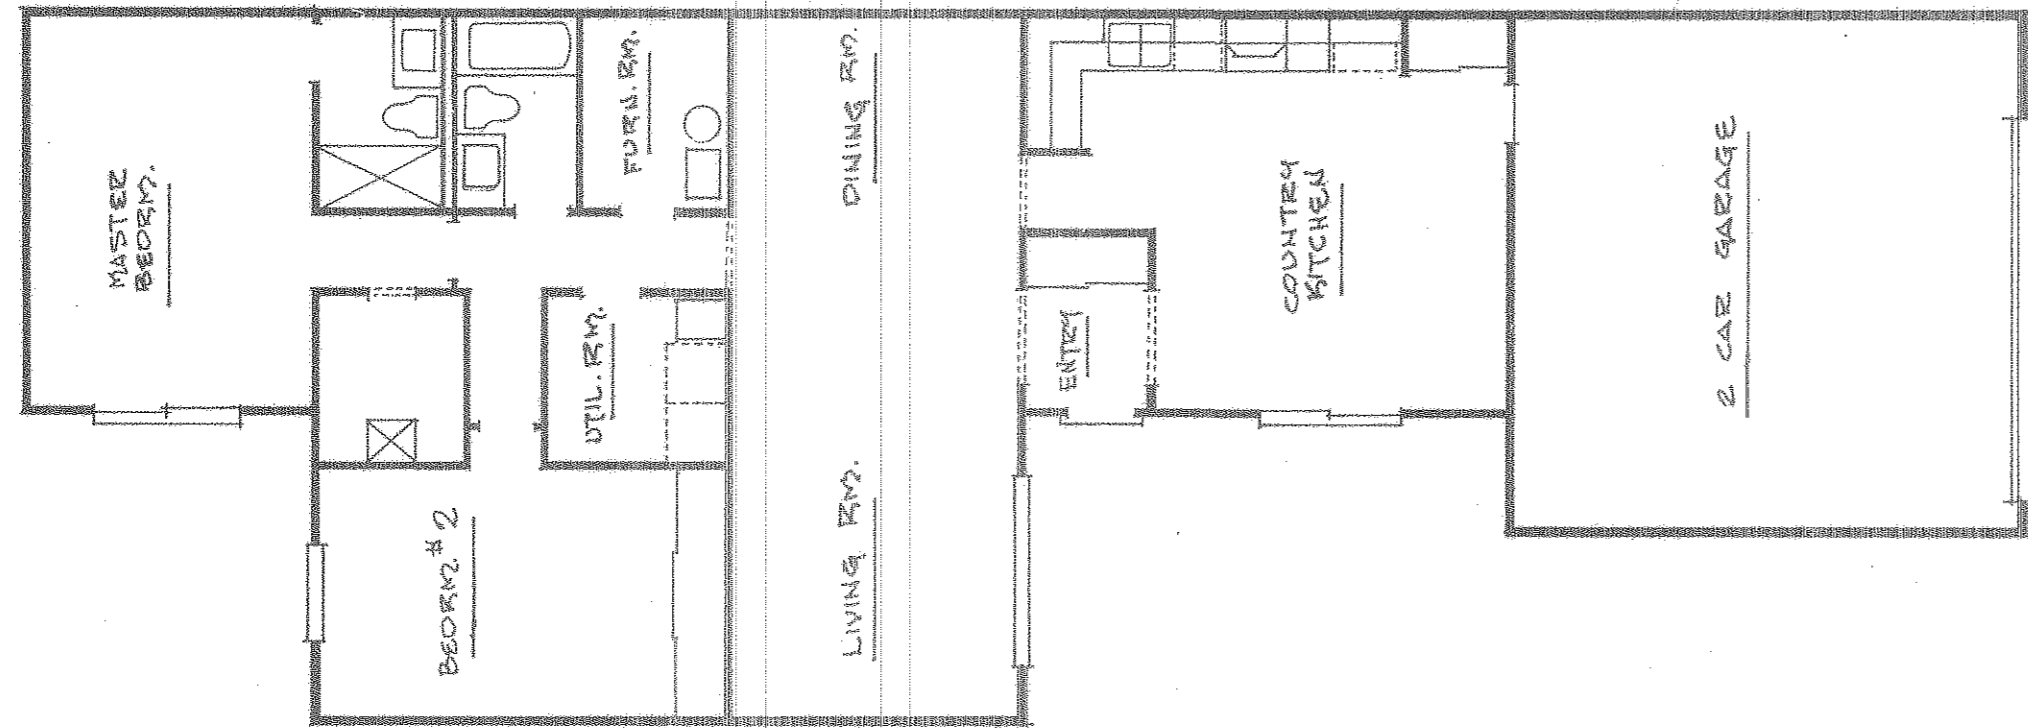


2 BEDROOM FLOOR
PLAN 1925A-2
BLDG. TYPE M-1925-2
USED FOR UNIT NUMBERS
A-2, A-3, B-6 & B-7

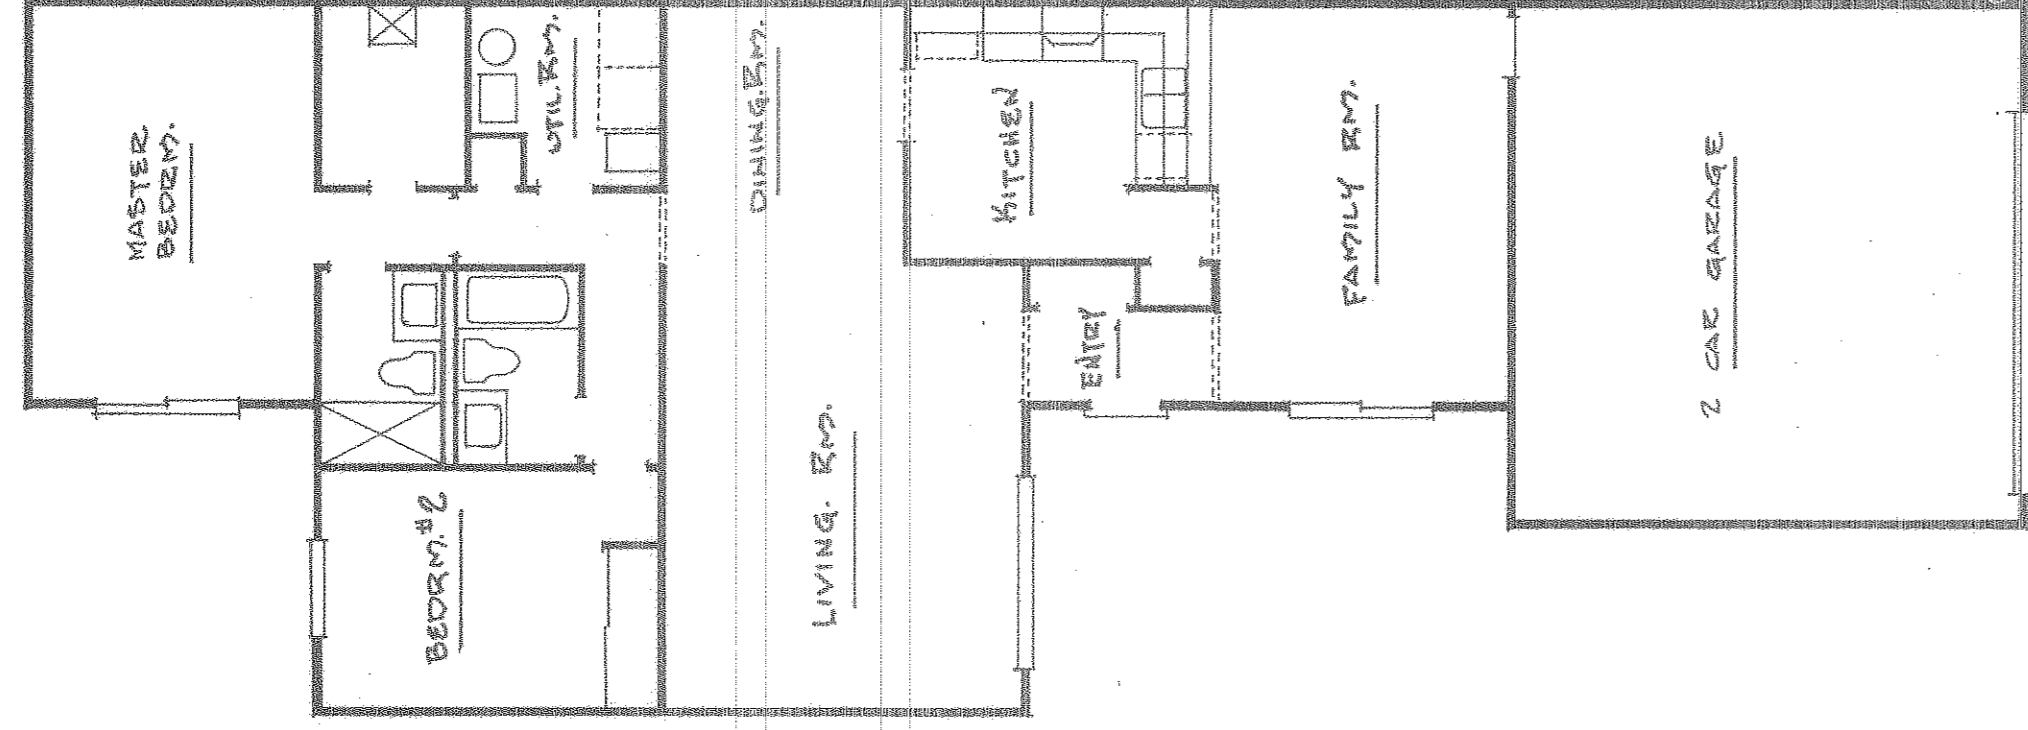


2 BEDROOM FLOOR
PLAN 1925B-1
BLDG. TYPE M-1925-1
USED FOR UNIT NUMBERS
A-1, A-3 & B-3

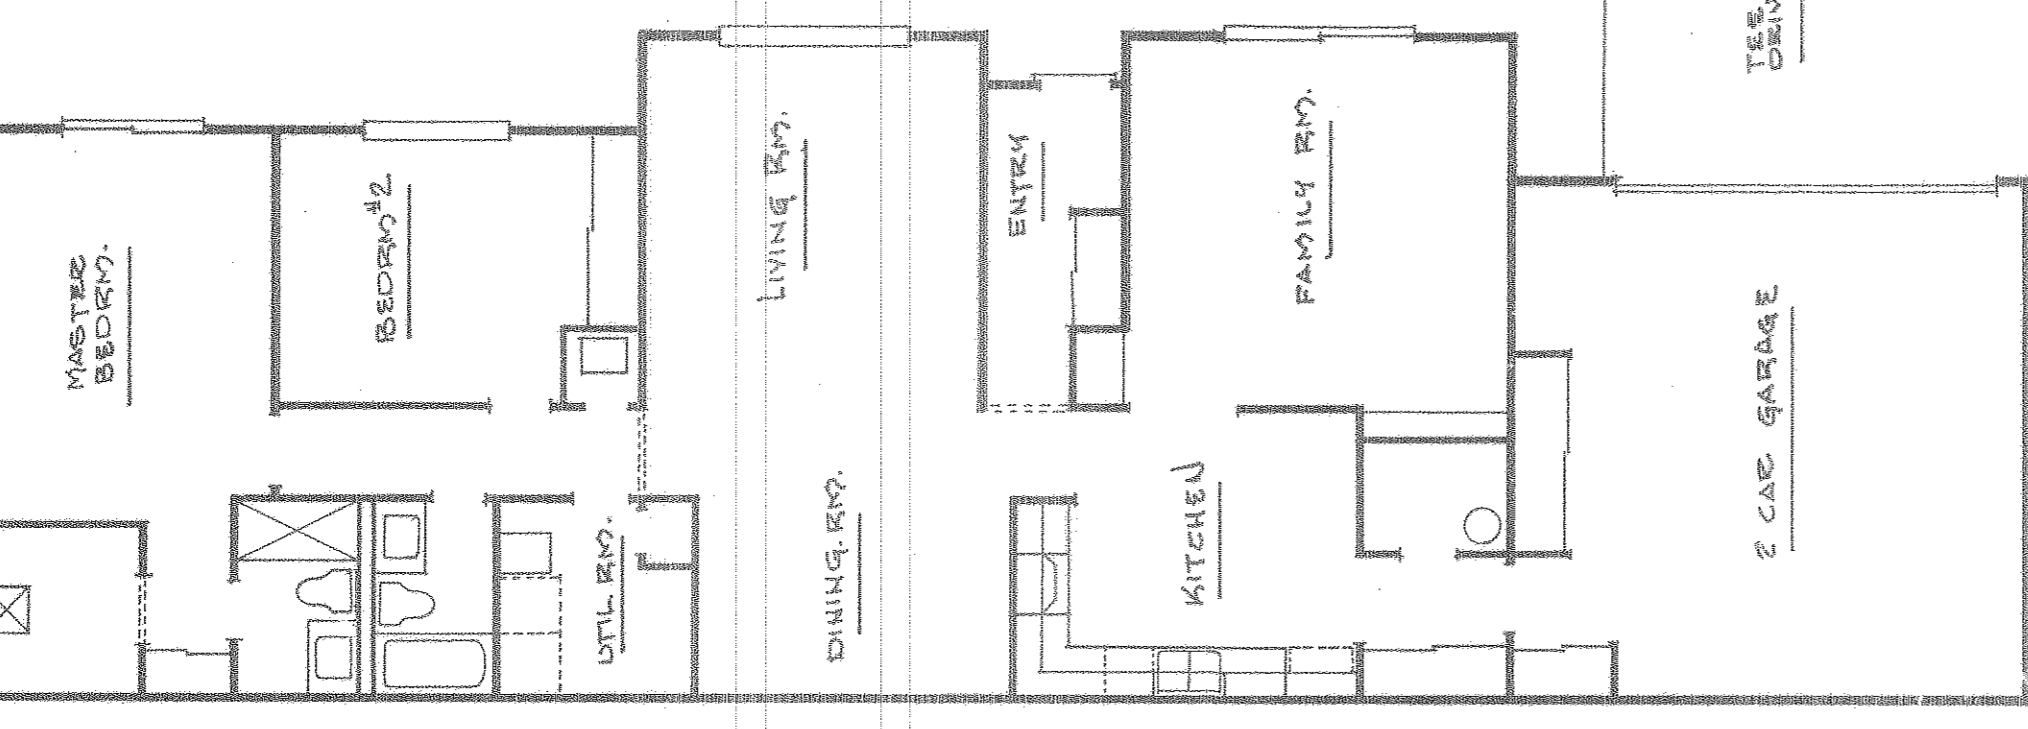


2 BEDROOM FLOOR
PLAN 1925B-2
BLDG. TYPE M-1925-1
USED FOR UNIT NUMBERS
B-1

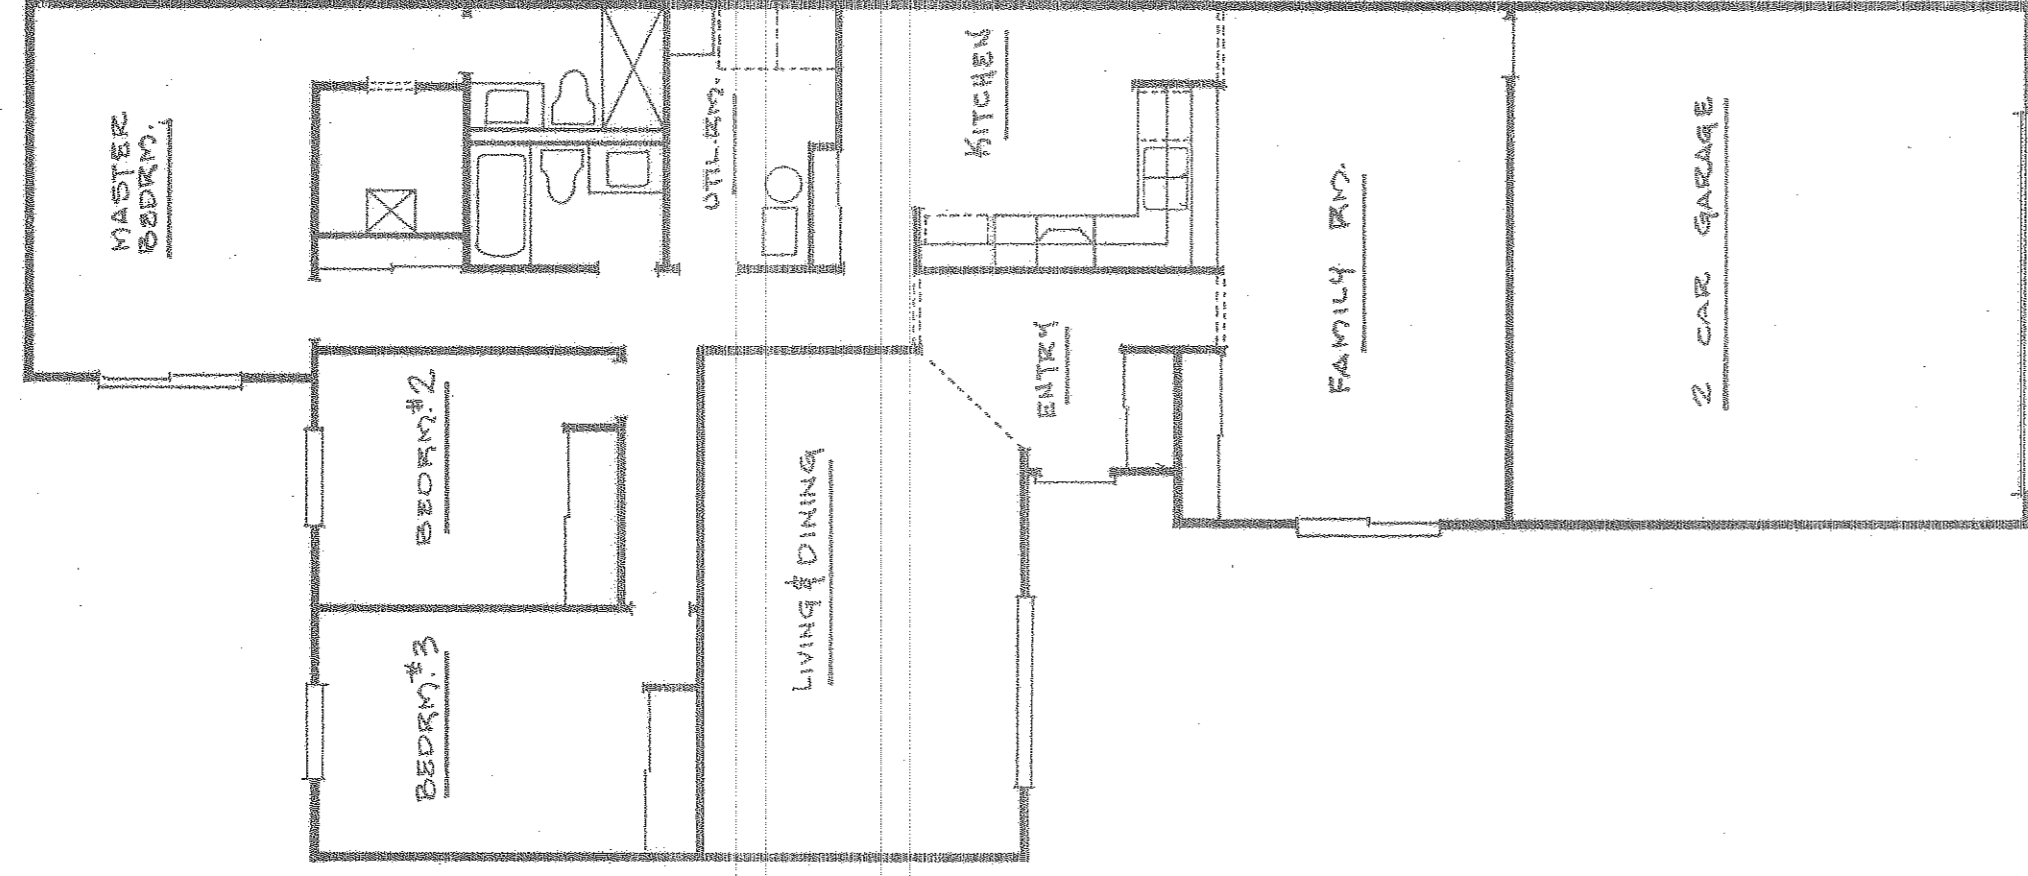


3 BEDROOM FLOOR
PLAN 2196-1
BLDG. TYPE M-2196-3
USED FOR UNIT NUMBERS
B-5

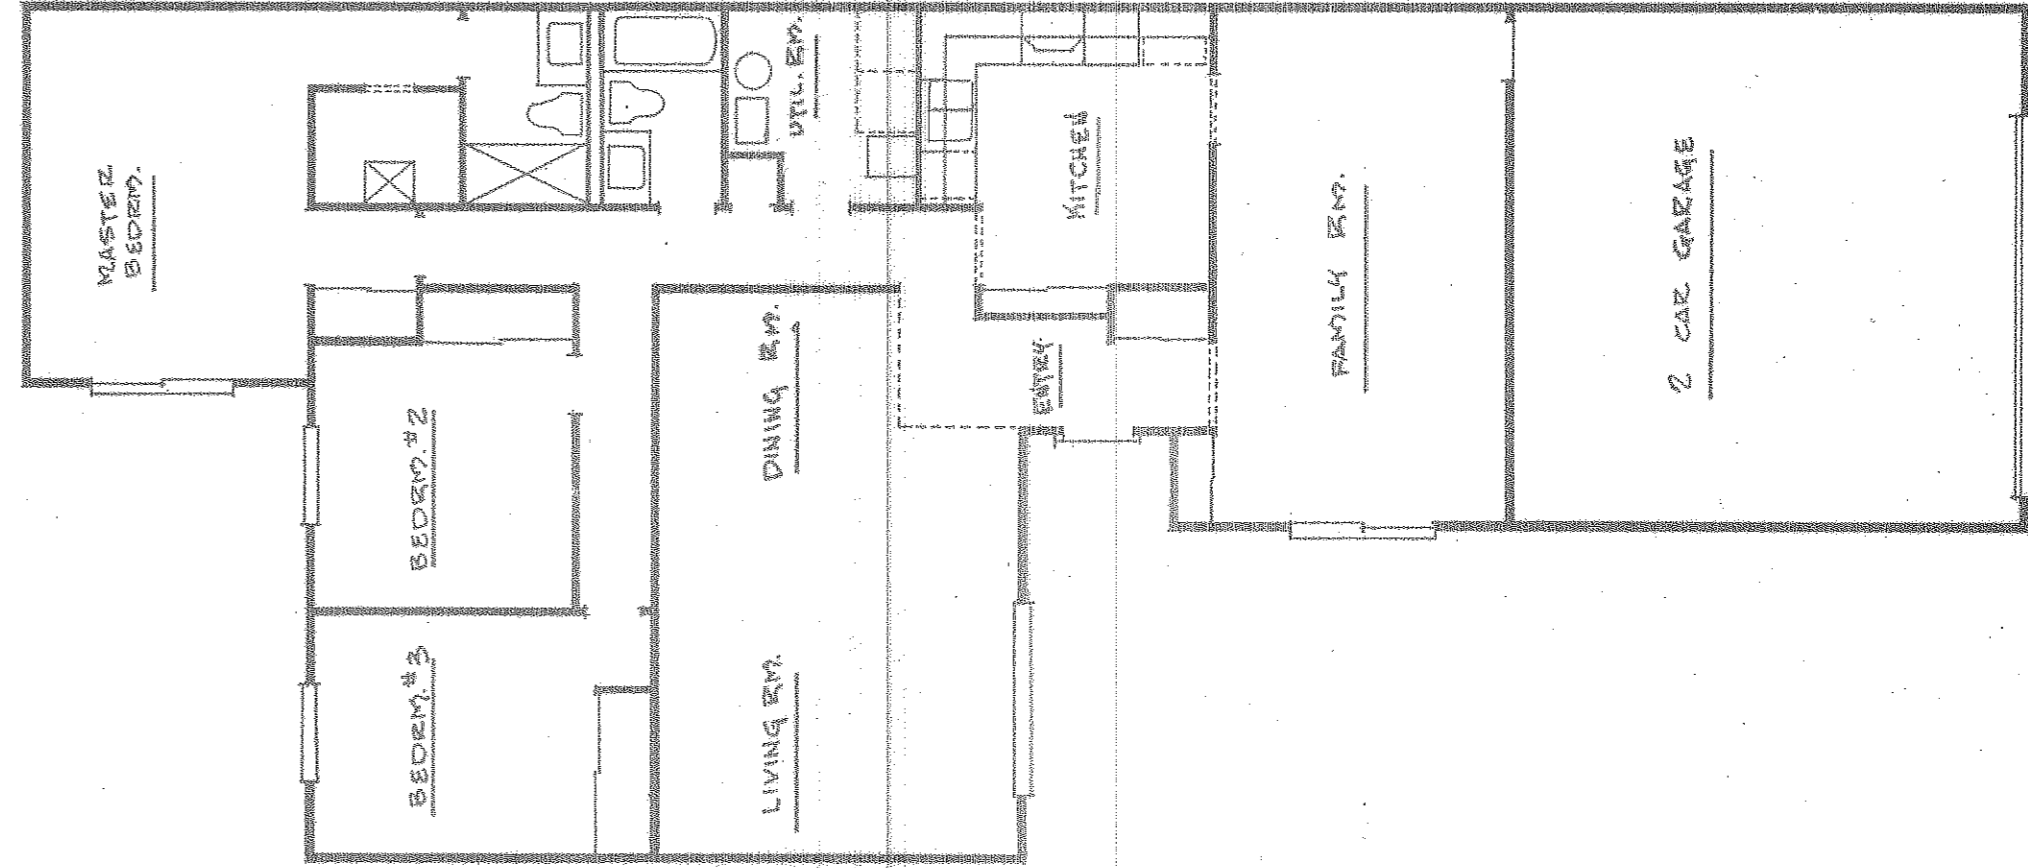


3 BEDROOM FLOOR
PLAN 2196-2
BLDG. TYPE M-2196-2
USED FOR UNIT NUMBERS
A-3

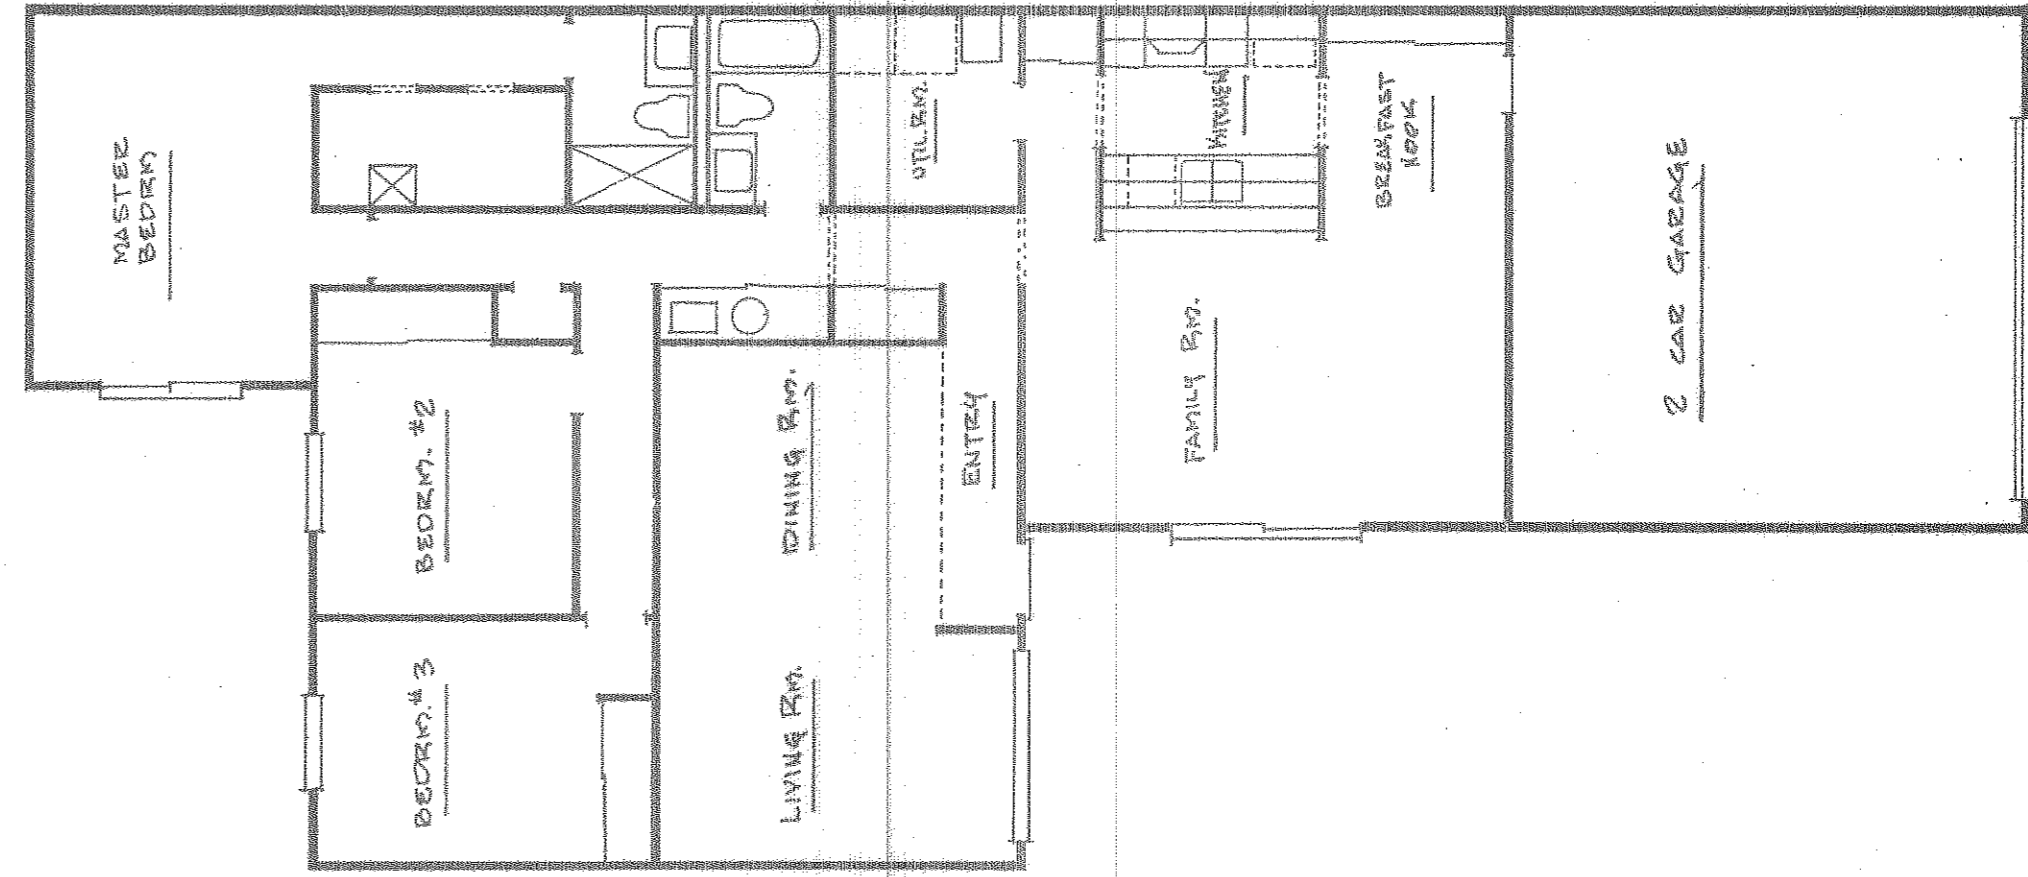


3 BEDROOM FLOOR
PLAN 2196-3
BLDG. TYPE M-2196-1
USED FOR UNIT NUMBERS
A-4

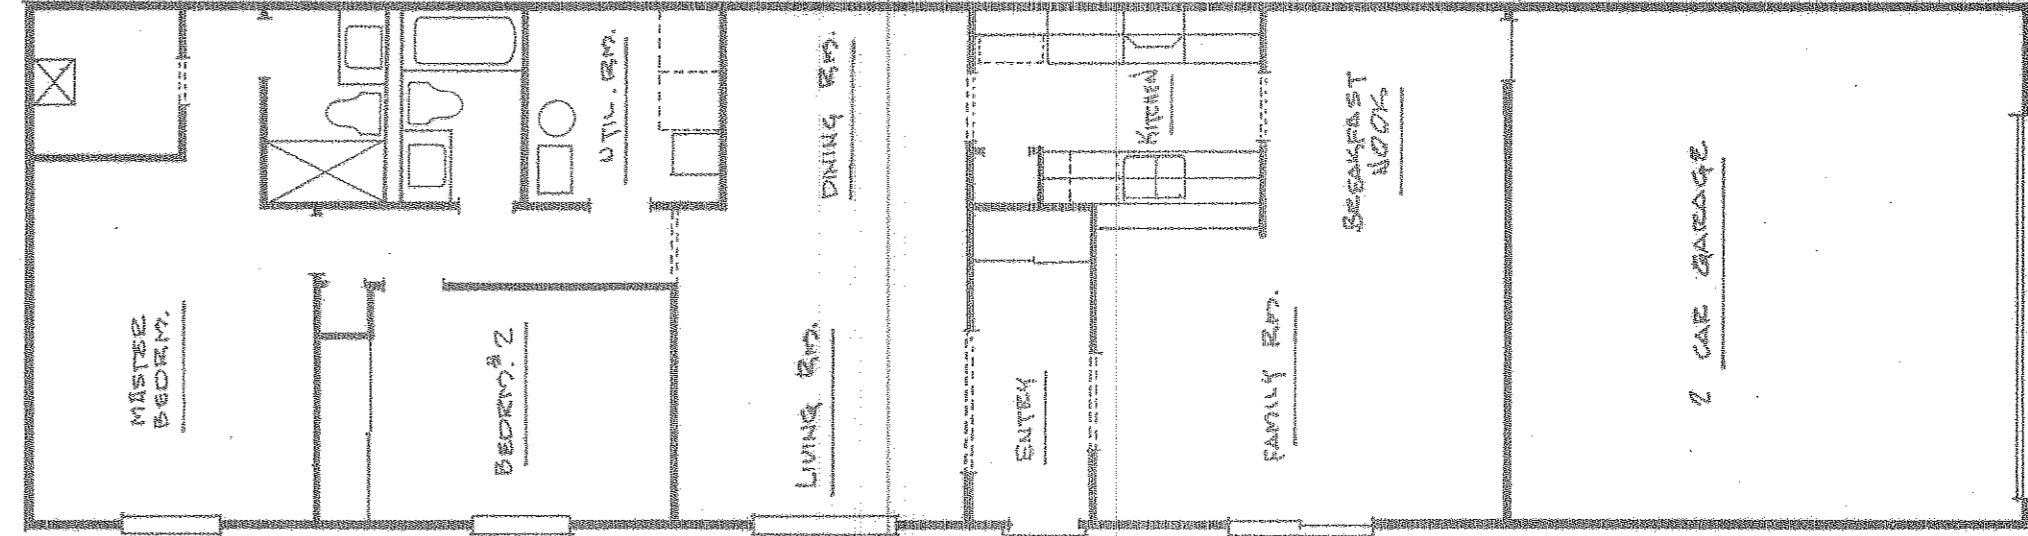


2 BEDROOM FLOOR
PLAN 1804-1
BLDG. TYPE M-1804-1
USED FOR UNIT NUMBERS
B-4

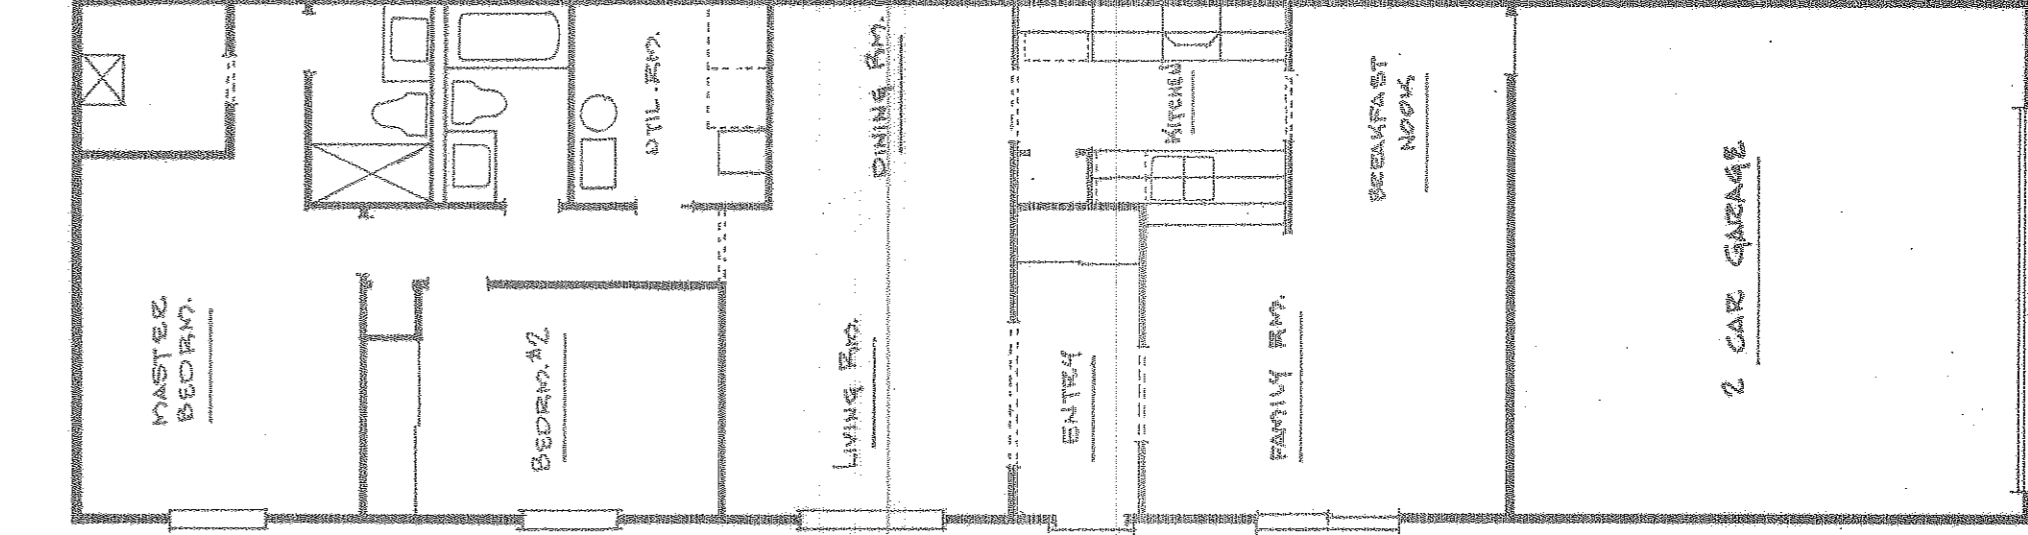

2 BEDROOM FLOOR
PLAN 1804-2
BLDG. TYPE M-1804-1
USED FOR UNIT NUMBERS
B-3

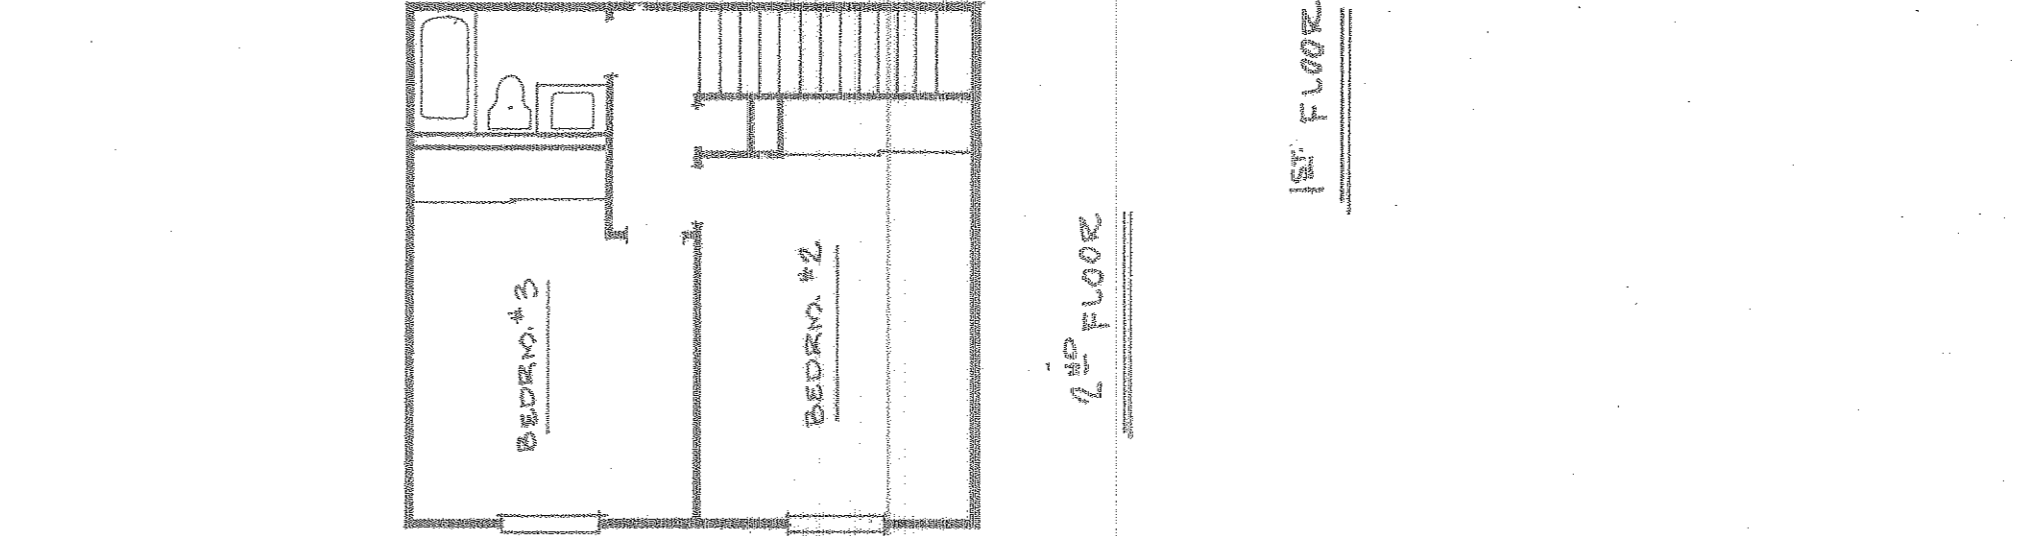

2ND FLOOR
1ST FLOOR

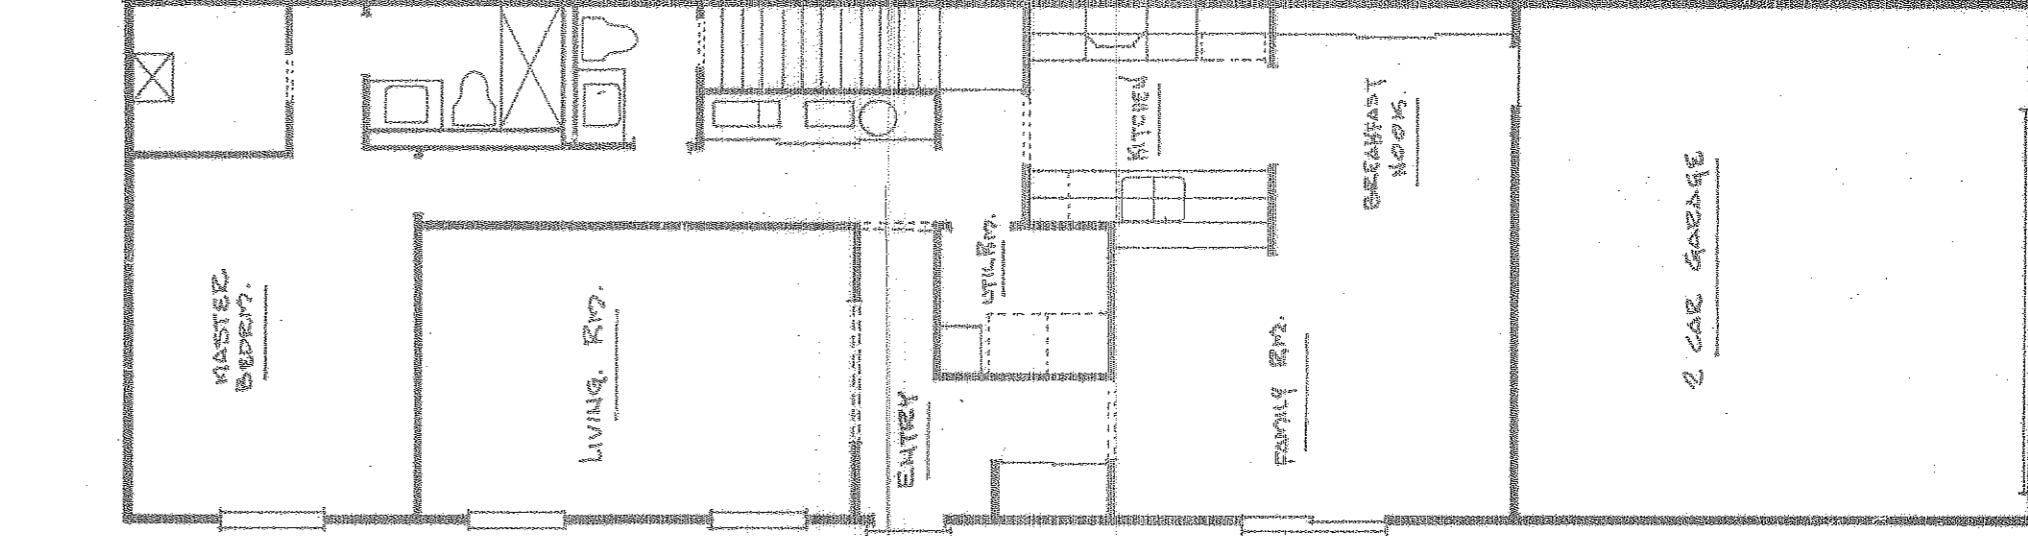

3 BEDROOM FLOOR
PLAN 2196-3
BLDG. TYPE M-2196-1
USED FOR UNIT NUMBERS
A-1 & A-2