


938139 32/4

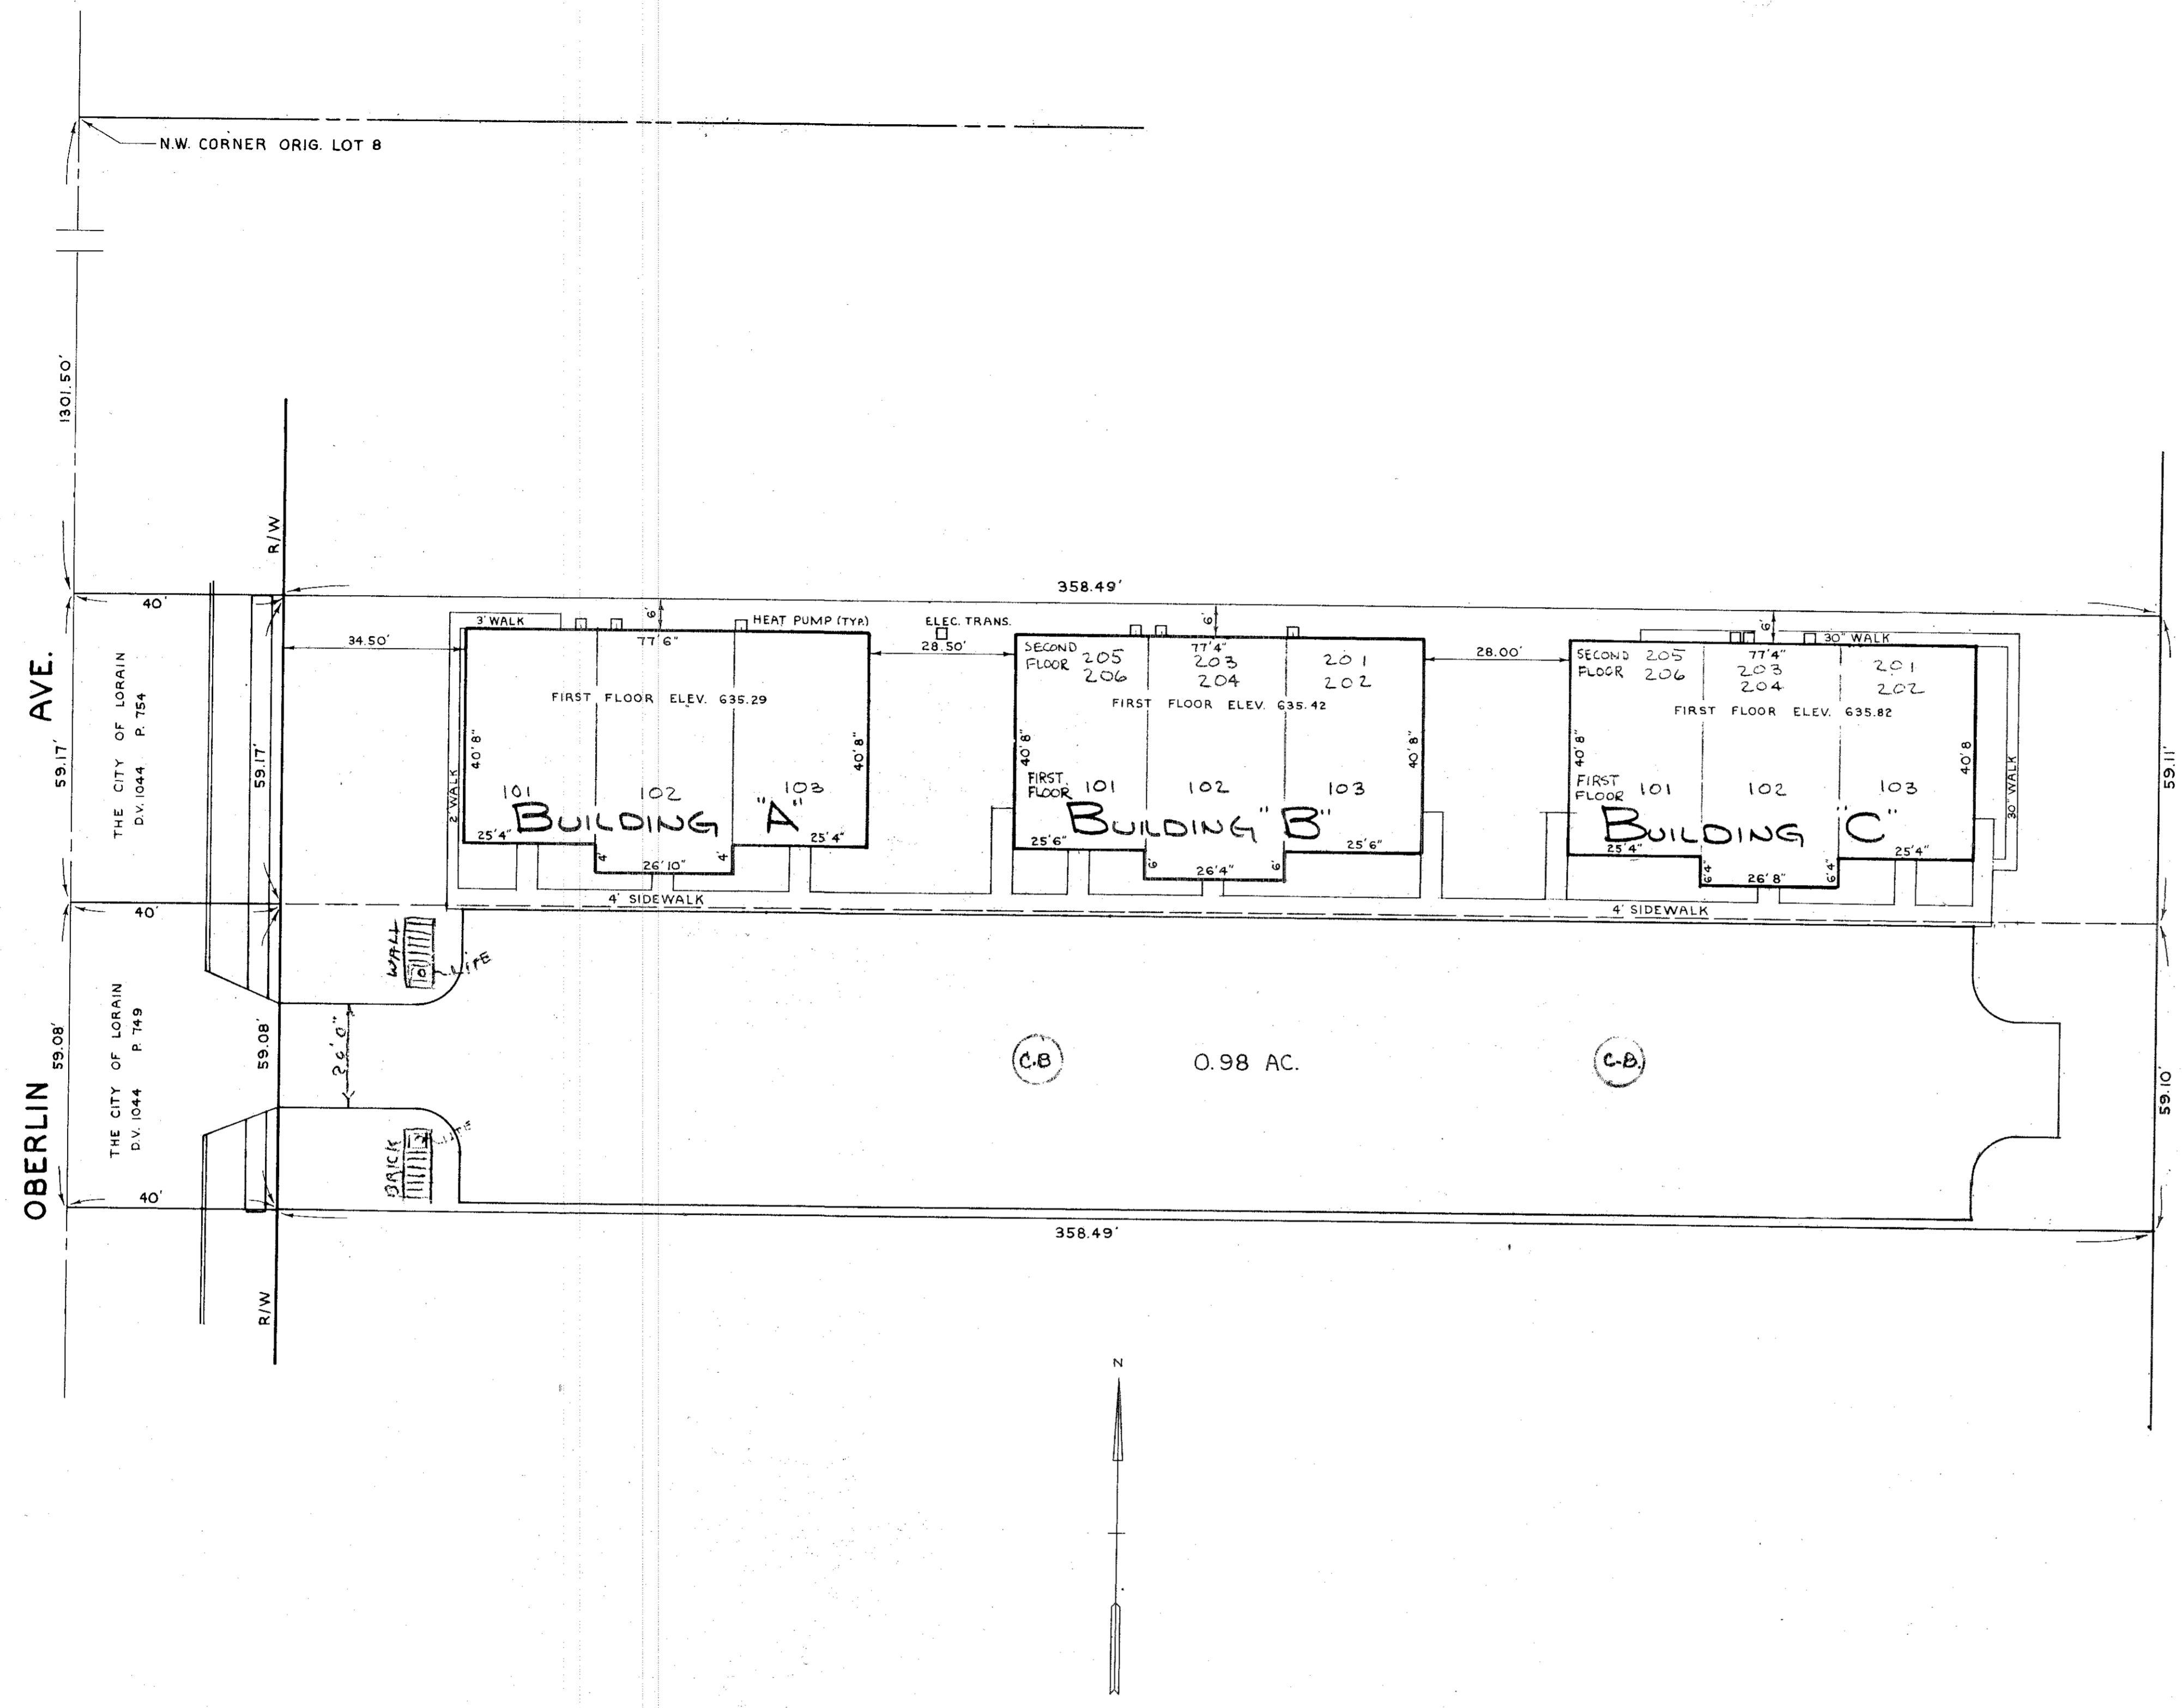

NOTE: SIDEWALK SHOWN ARE ALL 4' WIDE UNLESS OTHERWISE INDICATED.

TRANSFERRED
 IN COMPLIANCE WITH SEC. 309-02
 OHIO REV. CODE

FEB 16 1977

JULIAN A. FLOR
 LORAIN COUNTY AUDITOR

CONCORD STATION
 SITE PLAN

SCALE 1" = 20'

DEC, 1976

PREPARED FOR
 THE KACUR CO.
 LORAIN, OHIO

STATEMENT OF CERTIFICATION
 I CERTIFY THAT THE ATTACHED DRAWINGS CORRECTLY
 REPRESENT THE DIMENSIONS OF THE BUILDING AS CONSTRUCTED
 AND THAT THERE ARE NO ENCROACHMENTS ON ANY ADJUTING
 PREMISES EXCEPT AS SHOWN



Robert E. Henscher
 REGISTERED SURVEYOR

STATEMENT OF CERTIFICATION
 I CERTIFY THAT THE ATTACHED DRAWINGS
 CORRECTLY REPRESENT THE DIMENSIONS OF
 THE BUILDING AS CONSTRUCTED

Robert E. Henscher
 REGISTERED ENGINEER

SHT # 1 OF 12
 #207.36

RECEIVED FOR RECORD
 FEB 16 1977
 RECORDED IN LORAIN COUNTY RECORDS
 PLAT 32 Page 4-15 INC.
 32/4

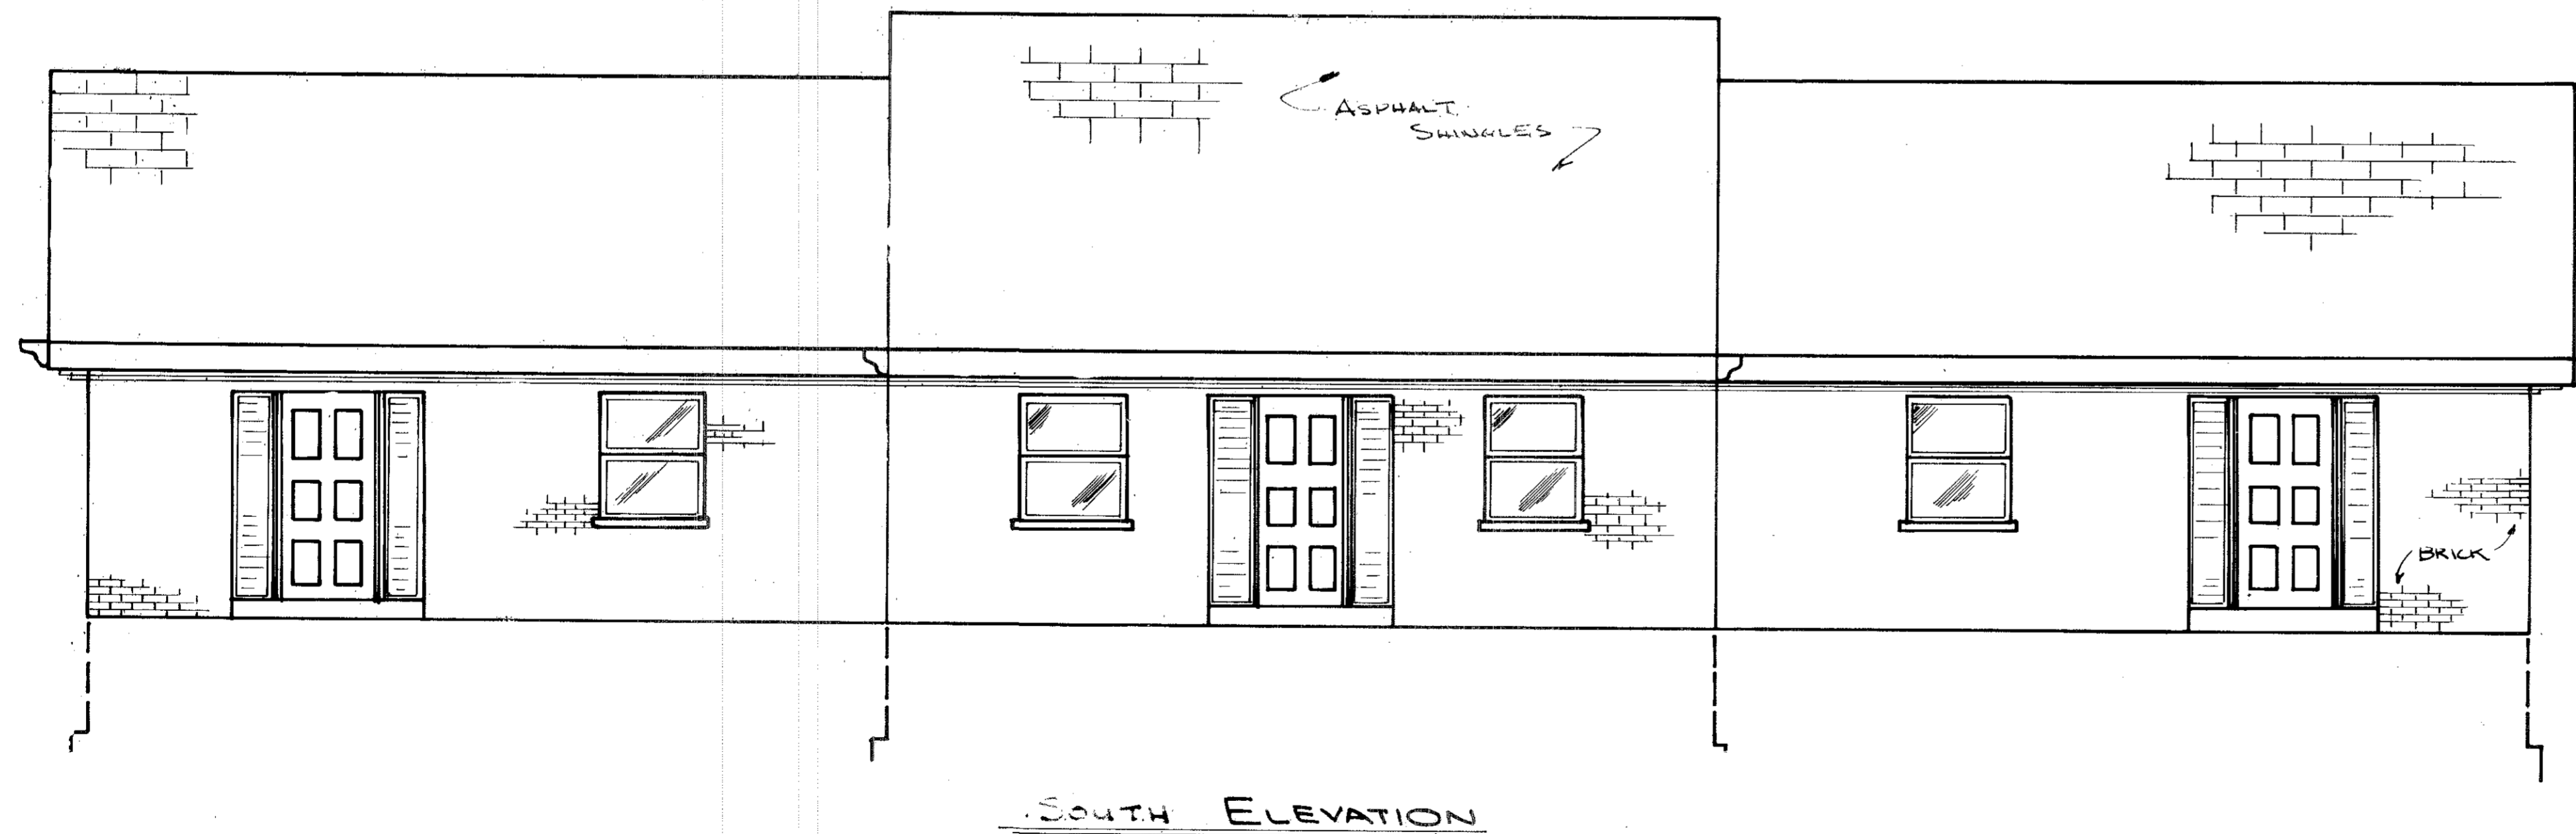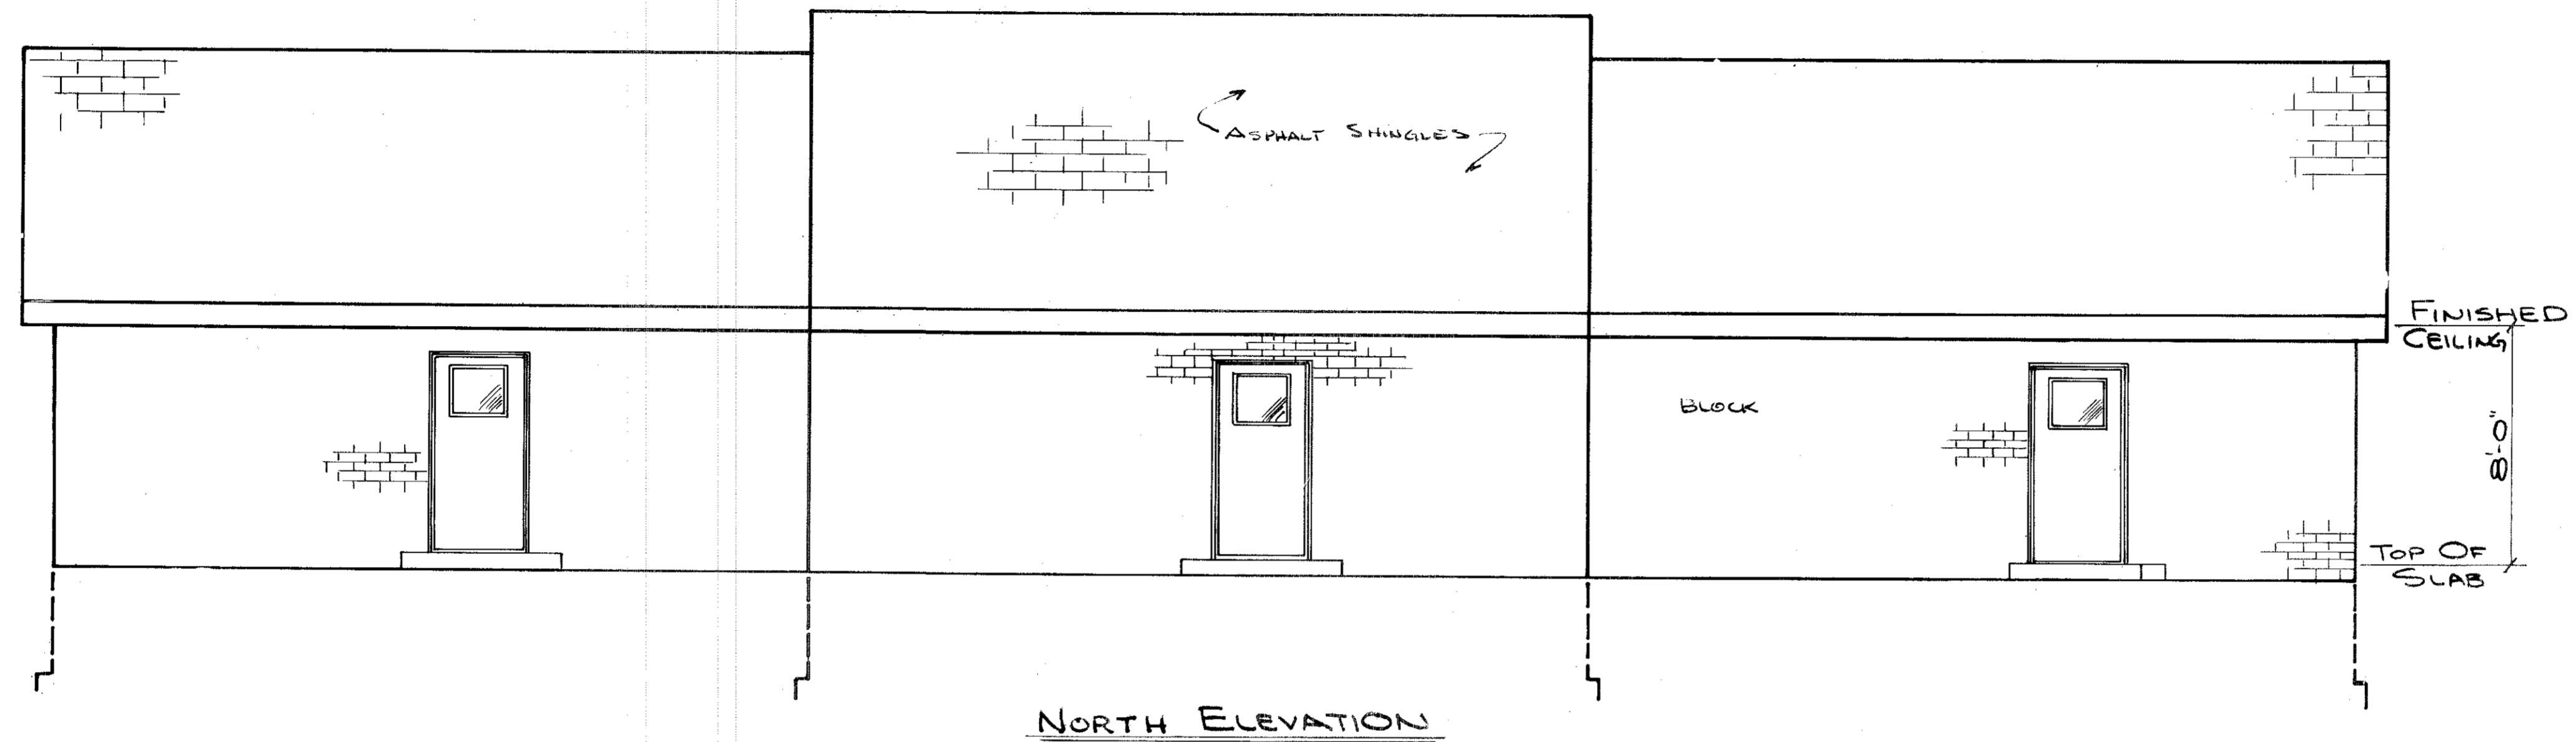

CONCORD STATION
 BUILDING "A"
 ELEVATION VIEWS
 SCALE 1/4"=1'-0" DEC, 1976
 PREPARED FOR
 THE KACUR CO.
 WORAIN, OHIO

SHT # 2 OF 12

STATEMENT OF CERTIFICATION
 I CERTIFY THAT THE ATTACHED DRAWINGS CORRECTLY
 REPRESENT THE DIMENSIONS OF THE BUILDING AS CONSTRUCTED
 AND THAT THERE ARE NO ENCROACHMENTS ON ANY ABUTTING
 PREMISES EXCEPT AS SHOWN

Robert E. Heinicke
 REGISTERED SURVEYOR

STATEMENT OF CERTIFICATION
 I CERTIFY THAT THE ATTACHED DRAWINGS
 CORRECTLY REPRESENT THE DIMENSIONS OF
 THE BUILDING AS CONSTRUCTED



Robert E. Heinicke
 REGISTERED ENGINEER

STATEMENT OF CERTIFICATION
I CERTIFY THAT THE ATTACHED DRAWINGS CORRECTLY REPRESENT THE DIMENSIONS OF THE BUILDING AS CONSTRUCTED AND THAT THERE ARE NO ENCROACHMENTS ON ANY ABUTTING PREMISES EXCEPT AS SHOWN


Robert E. Schneider
REGISTERED SURVEYOR

STATEMENT OF CERTIFICATION
I CERTIFY THAT THE ATTACHED DRAWINGS CORRECTLY REPRESENT THE DIMENSIONS OF THE BUILDING AS CONSTRUCTED

Robert E. Schneider
REGISTERED ENGINEER

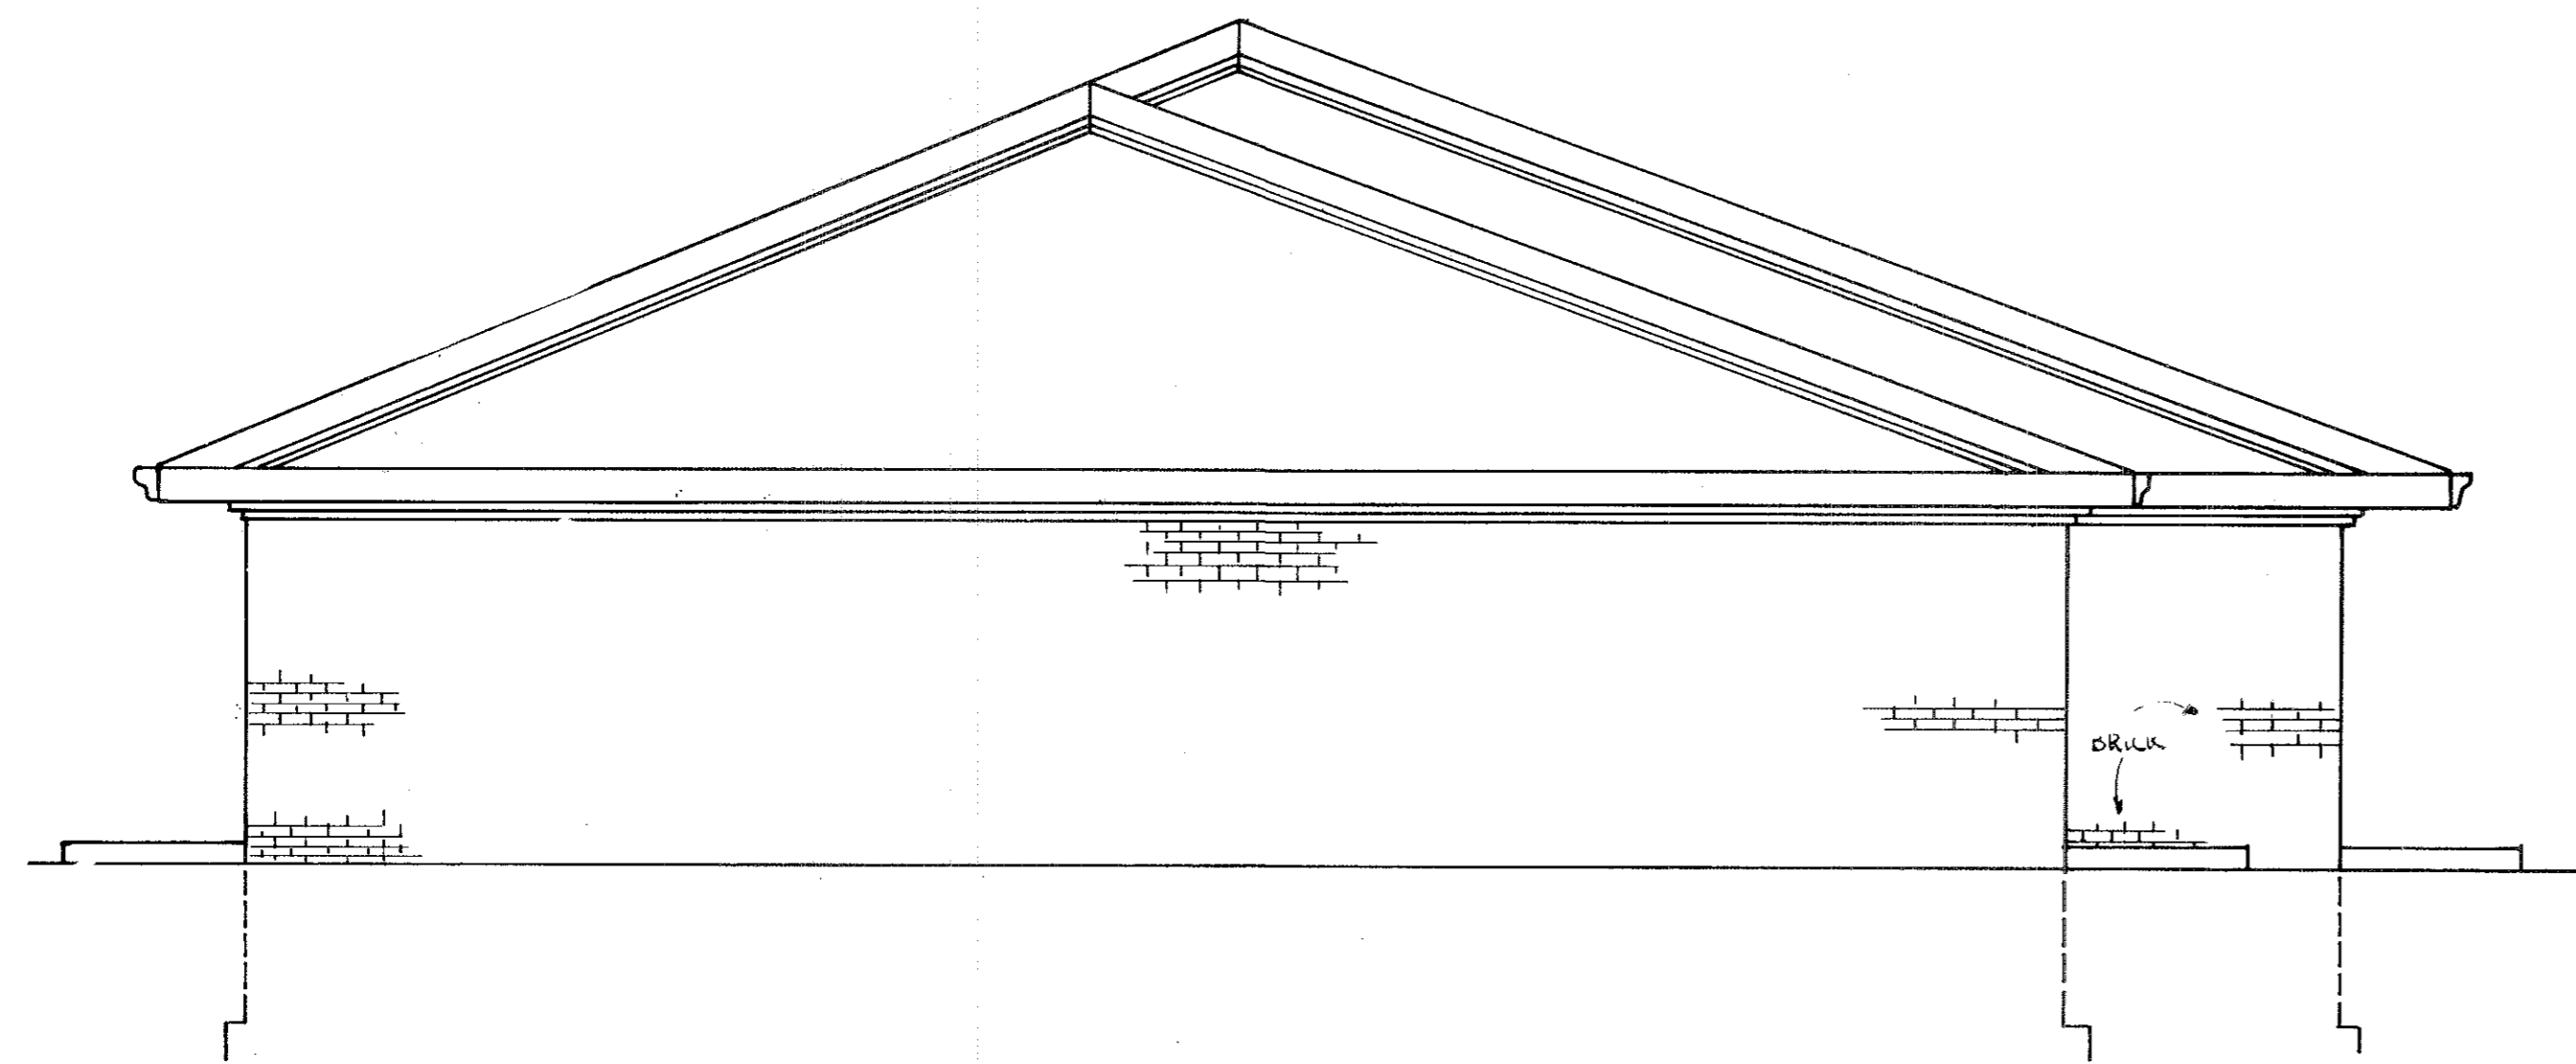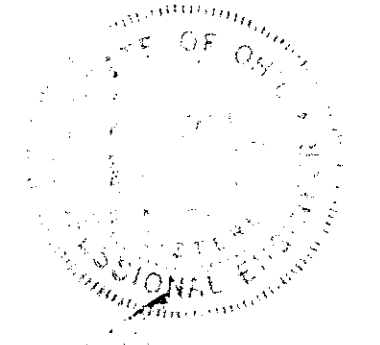


WEST ELEVATION

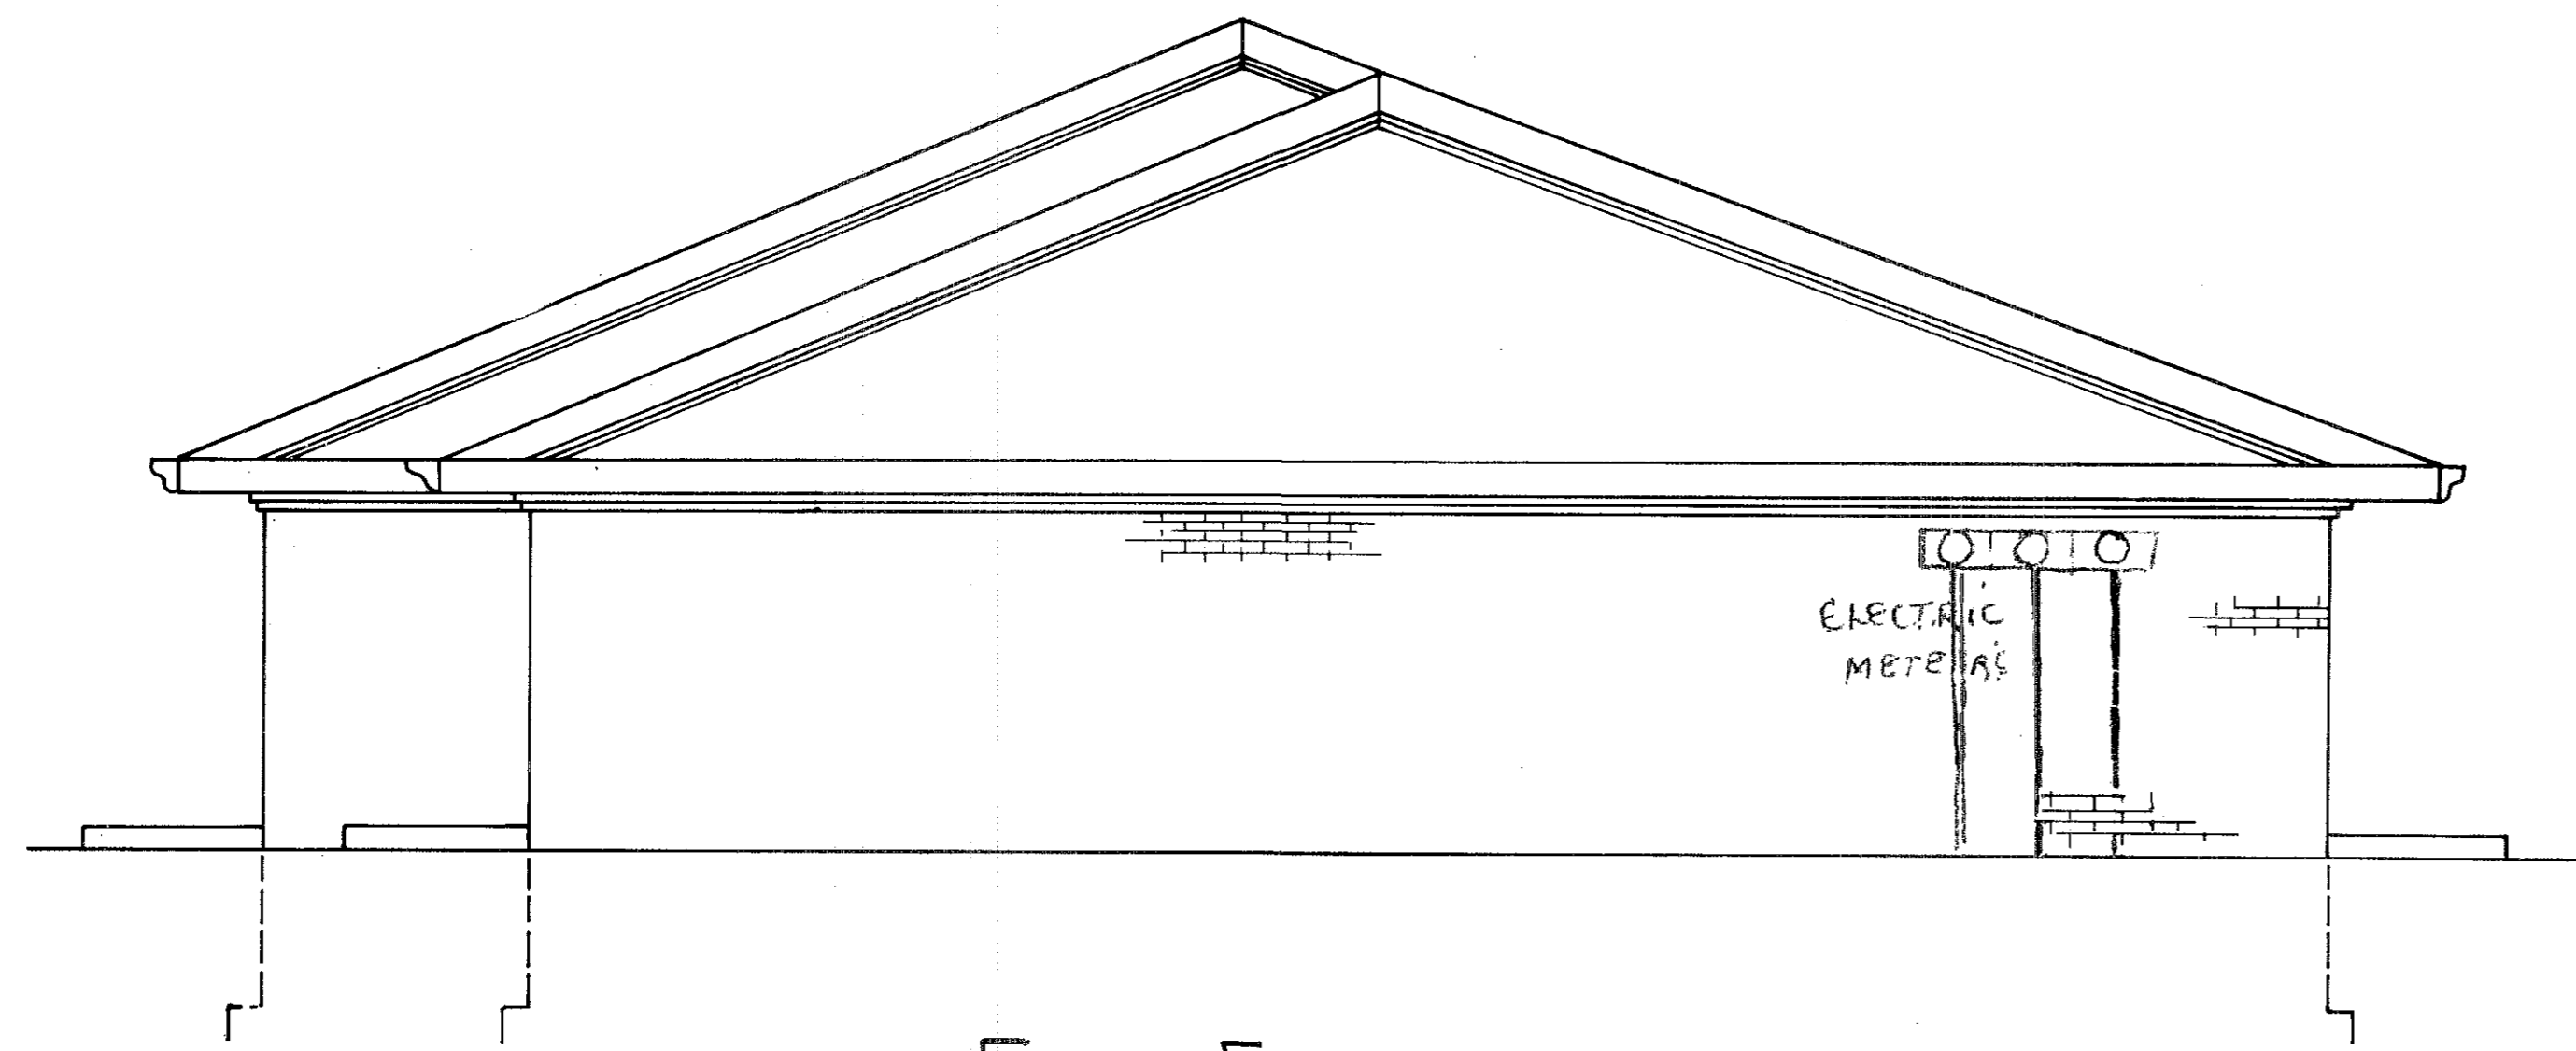

EAST ELEVATION

CONCORD STATION
BUILDING 'A'
ELEVATION VIEWS
SCALE 1/4" = 1'-0" DEC, 1976
PREPARED FOR
THE KACUR CO.
WORAIN, OHIO


SHT # 3 OF 12

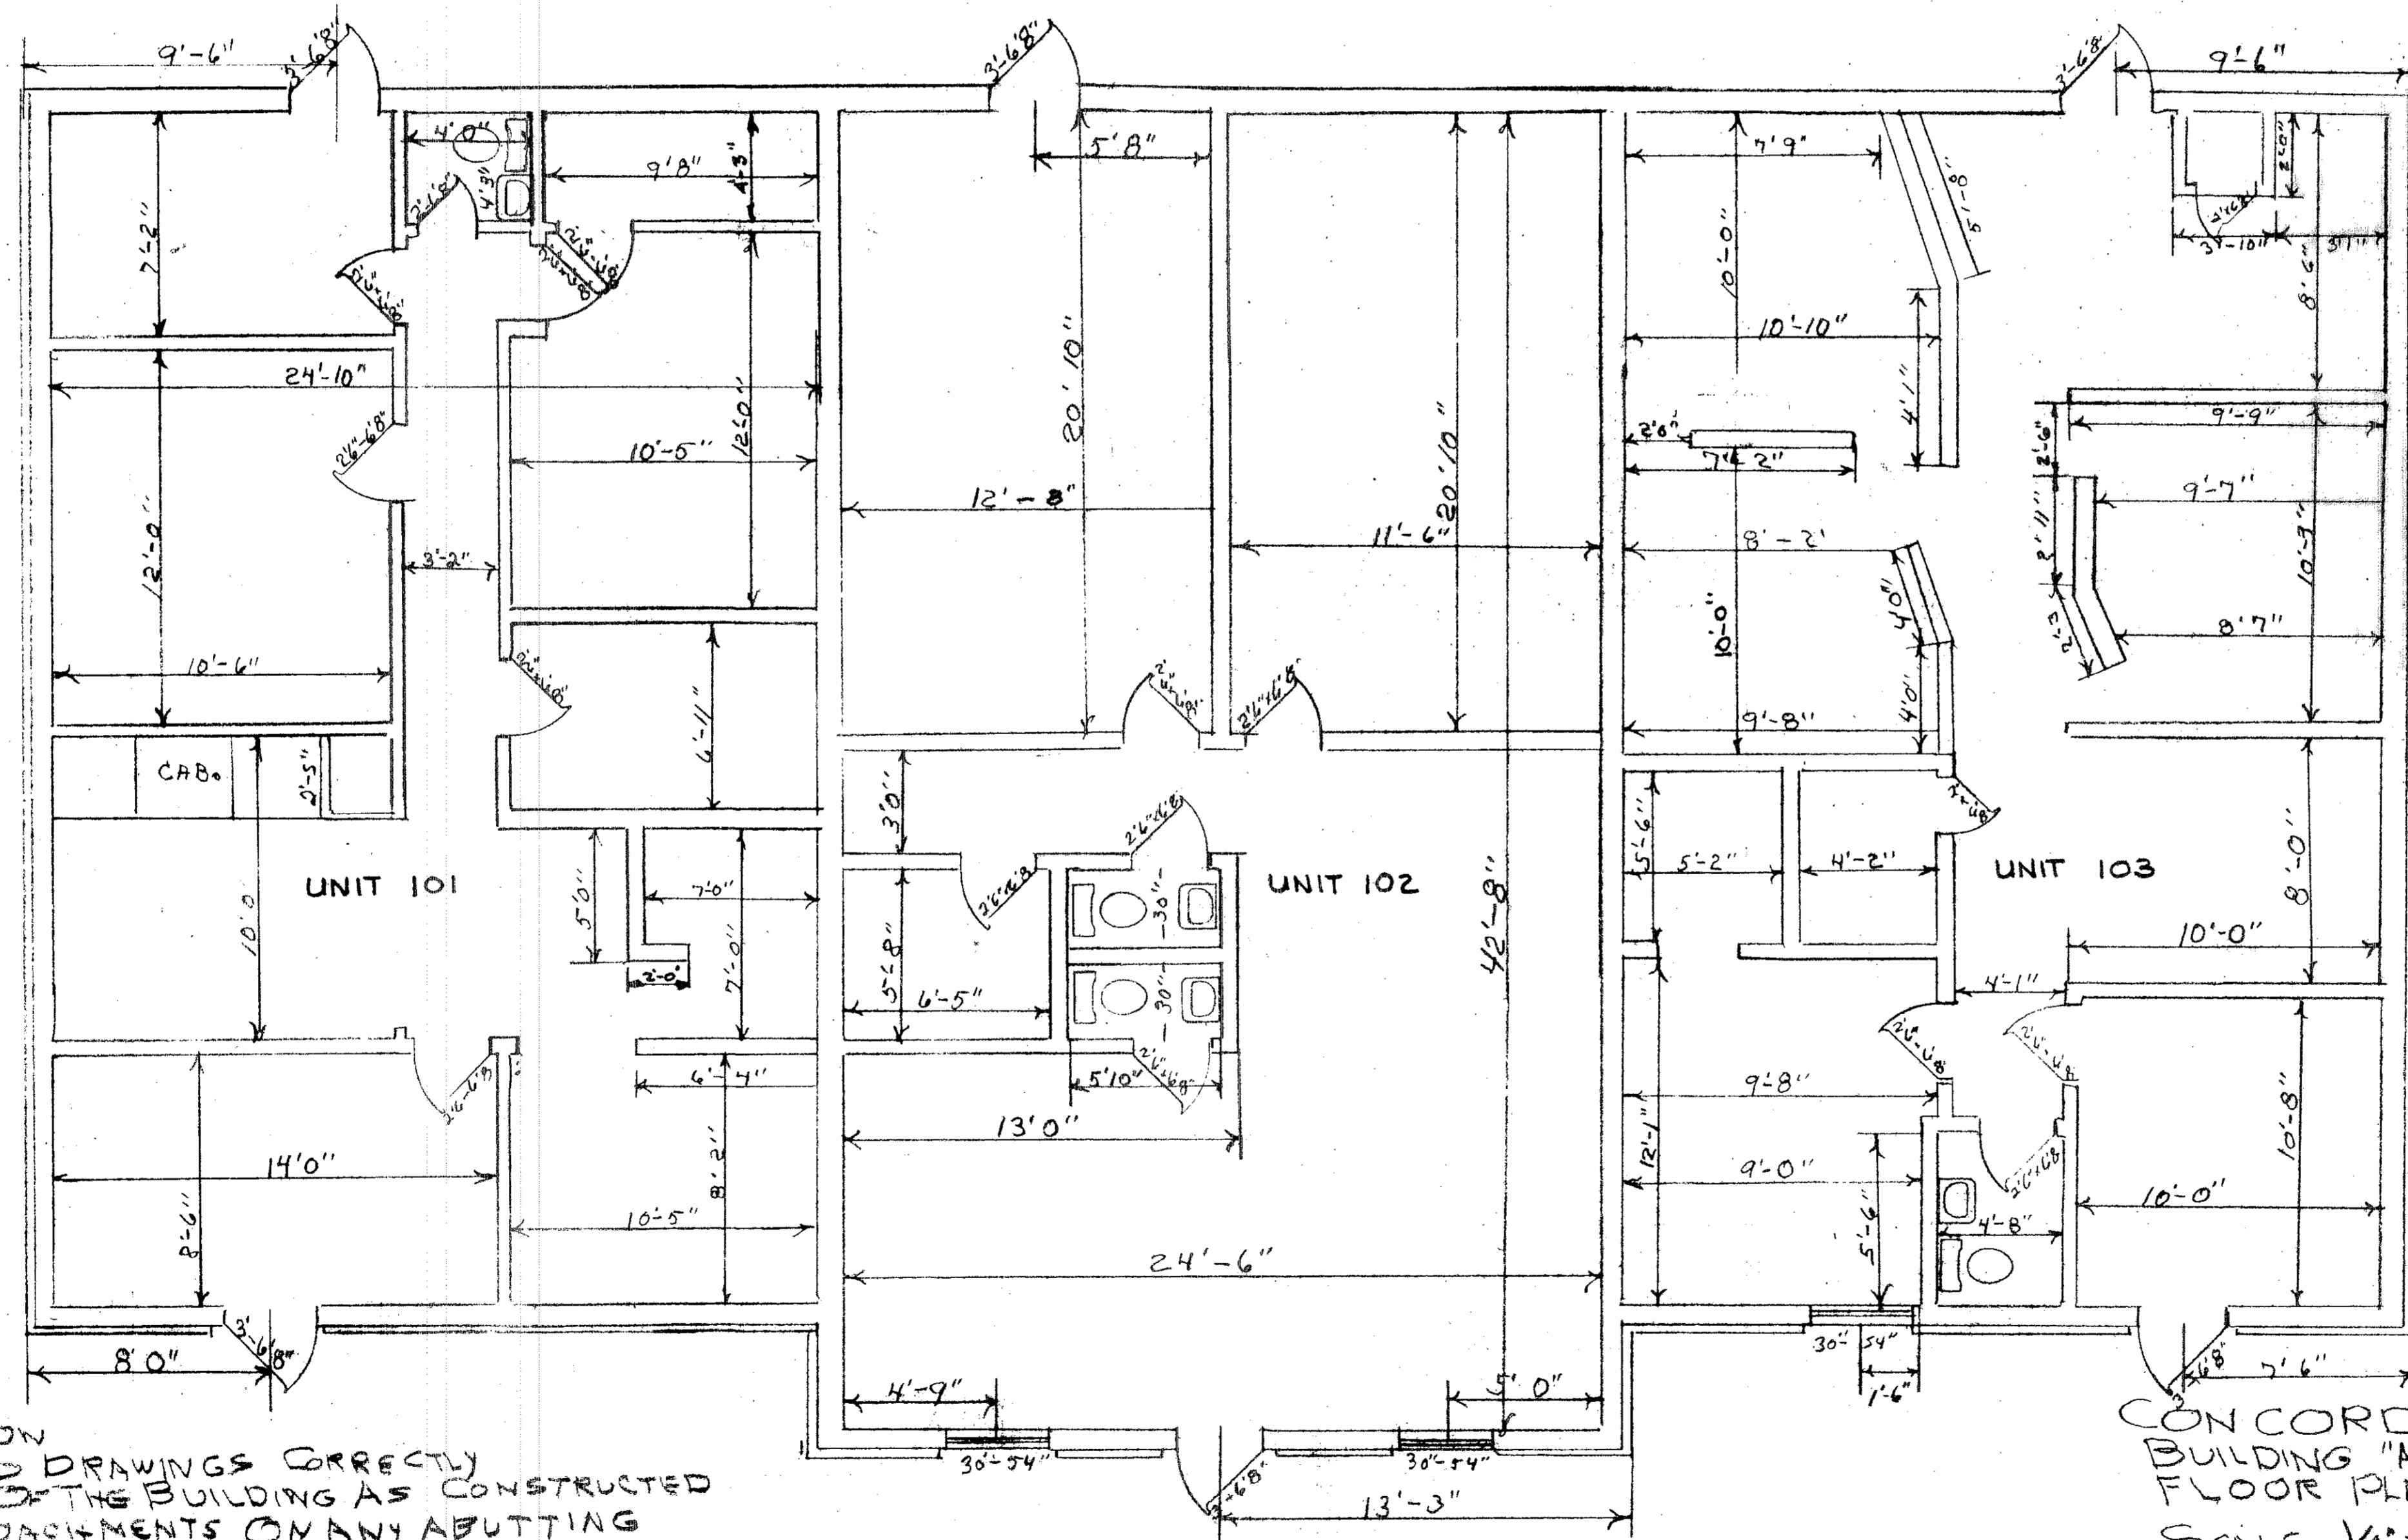

STATEMENT OF CERTIFICATION
 I CERTIFY THAT THE ATTACHED DRAWINGS CORRECTLY
 REPRESENT THE DIMENSIONS OF THE BUILDING AS CONSTRUCTED
 AND THAT THERE ARE NO ENCROACHMENTS ON ANY ADJACENT
 PREMISES EXCEPT AS SHOWN

Robert E. Glusider

REGISTERED SURVEYOR

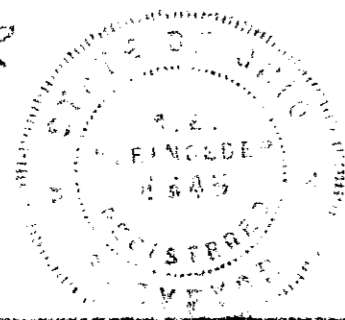

STATEMENT OF CERTIFICATION
 I CERTIFY THAT THE ATTACHED DRAWINGS
 CORRECTLY REPRESENT THE DIMENSIONS OF
 THE BUILDING AS CONSTRUCTED

Robert E. Glusider

REGISTERED ENGINEER



CONCORD STATION
 BUILDING "A"
 FLOOR PLAN
 SCALE 1/4"=1'-0"

DEC, 1976


PREPARED FOR
 THE KACUR CO.
 LORAIN, OHIO

STATEMENT OF CERTIFICATION
I CERTIFY THAT THE ATTACHED DRAWINGS CORRECTLY REPRESENT THE DIMENSIONS OF THE BUILDING AS CONSTRUCTED AND THAT THERE ARE NO ENCROACHMENTS ON ANY ABUTTING PREMISES EXCEPT AS SHOWN


Robert E. Glenside
REGISTERED SURVEYOR

STATEMENT OF CERTIFICATION
I CERTIFY THAT THE ATTACHED DRAWINGS CORRECTLY REPRESENT THE DIMENSIONS OF THE BUILDING AS CONSTRUCTED

Robert E. Glenside
REGISTERED ENGINEER

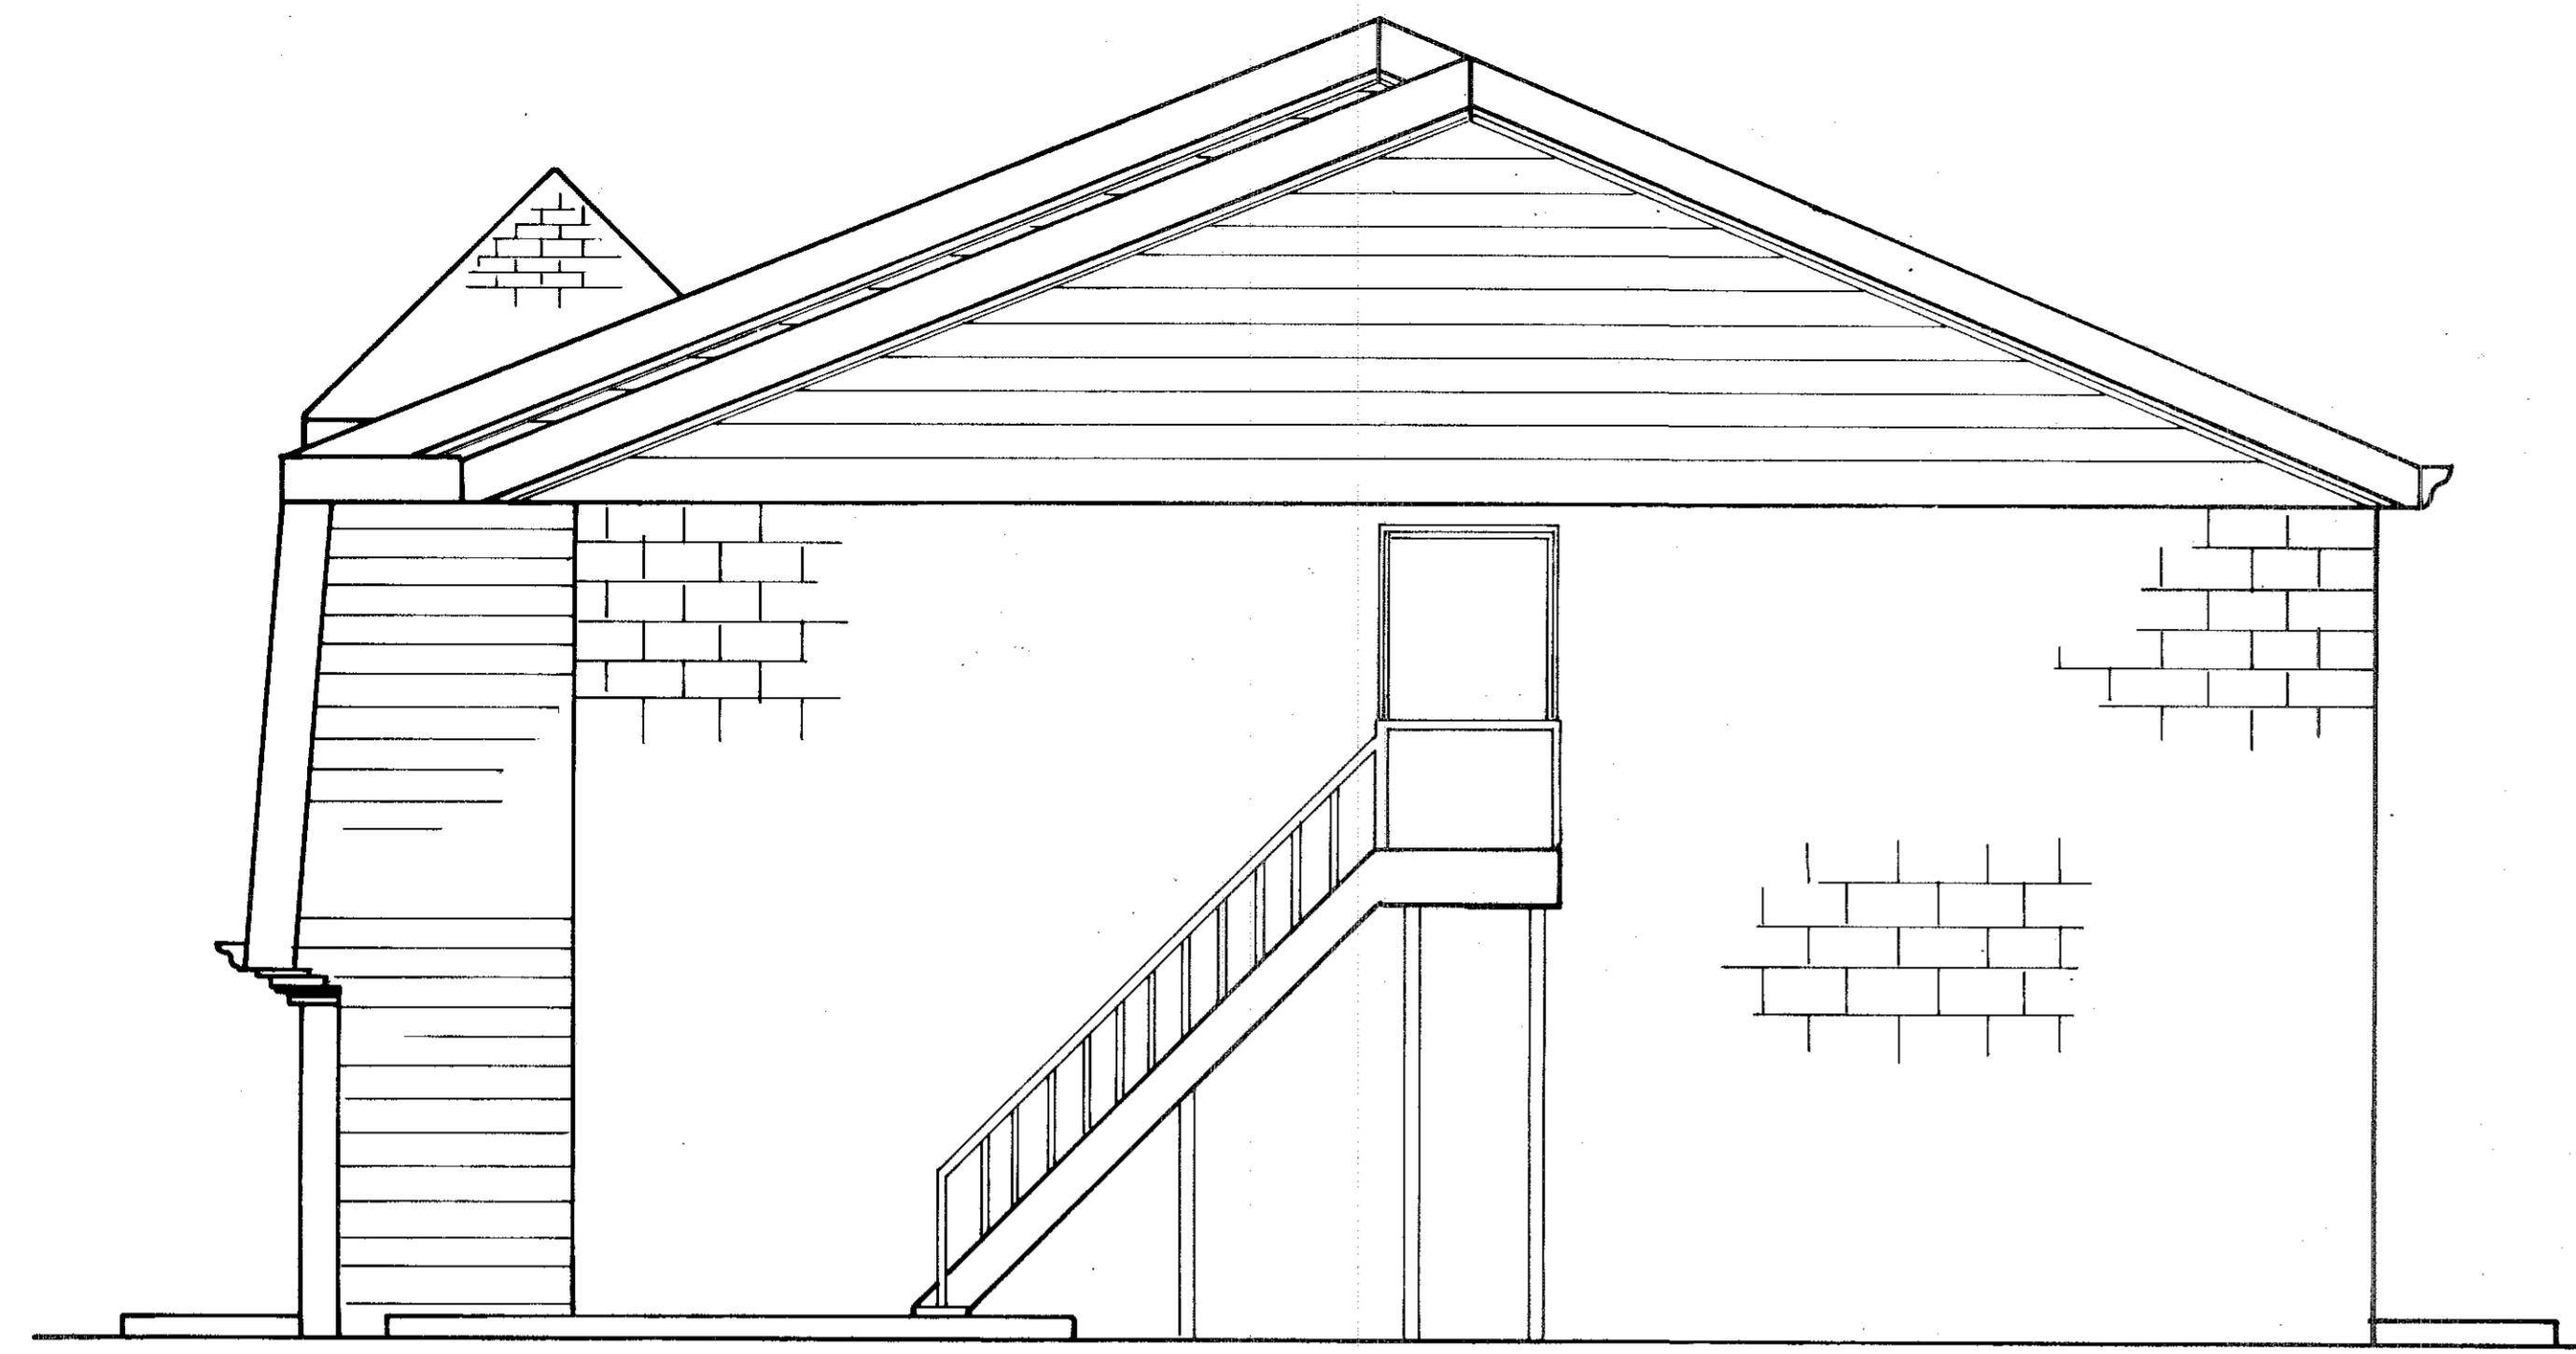

EAST ELEVATION

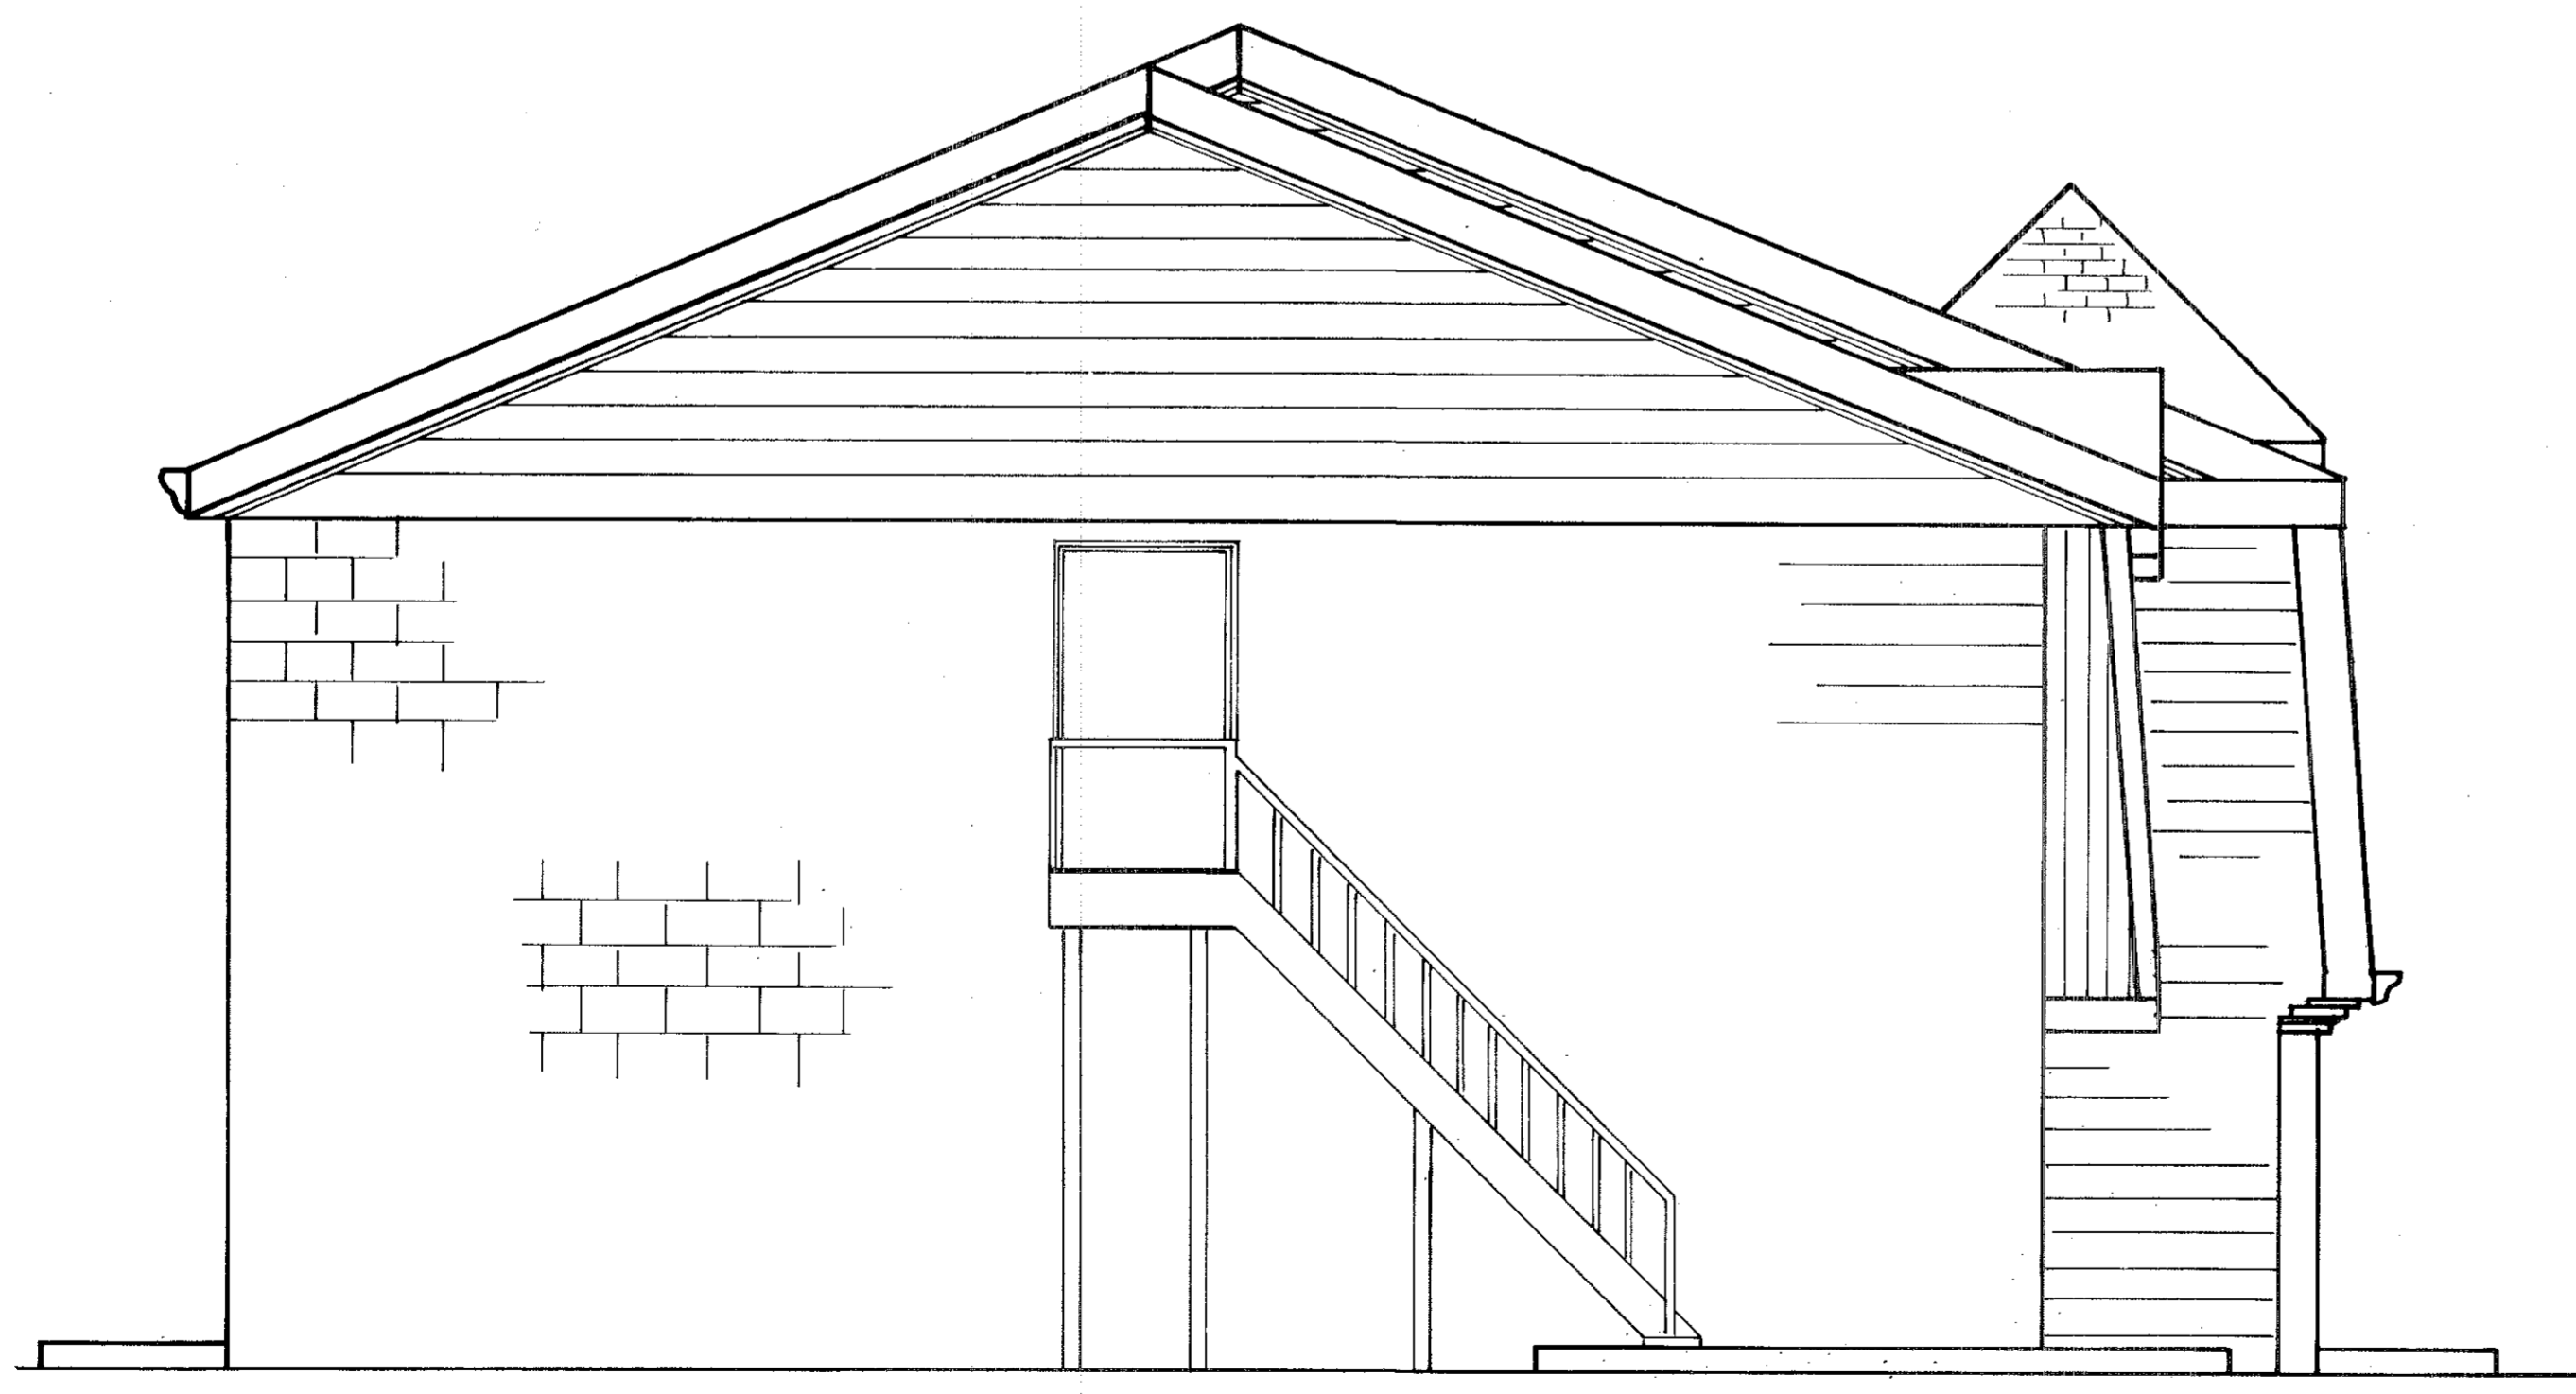

WEST ELEVATION


CONCORD STATION
BUILDING "B"
ELEVATION VIEWS
SCALE 1/4"=1'-0" DEC, 1976
PREPARED FOR
THE KACUR CO.
WORAIN, OHIO

STATEMENT OF CERTIFICATION
I CERTIFY THAT THE ATTACHED DRAWINGS CORRECTLY REPRESENT THE DIMENSIONS OF THE BUILDING AS CONSTRUCTED AND THAT THERE ARE NO ENCREACHMENTS ON ANY ABUTTING PREMISES EXCEPT AS SHOWN

Robert E. Flewisher
REGISTERED SURVEYOR

STATEMENT OF CERTIFICATION
I CERTIFY THAT THE ATTACHED DRAWINGS CORRECTLY REPRESENT THE DIMENSIONS OF THE BUILDING AS CONSTRUCTED

Robert E. Flewisher
REGISTERED ENGINEER

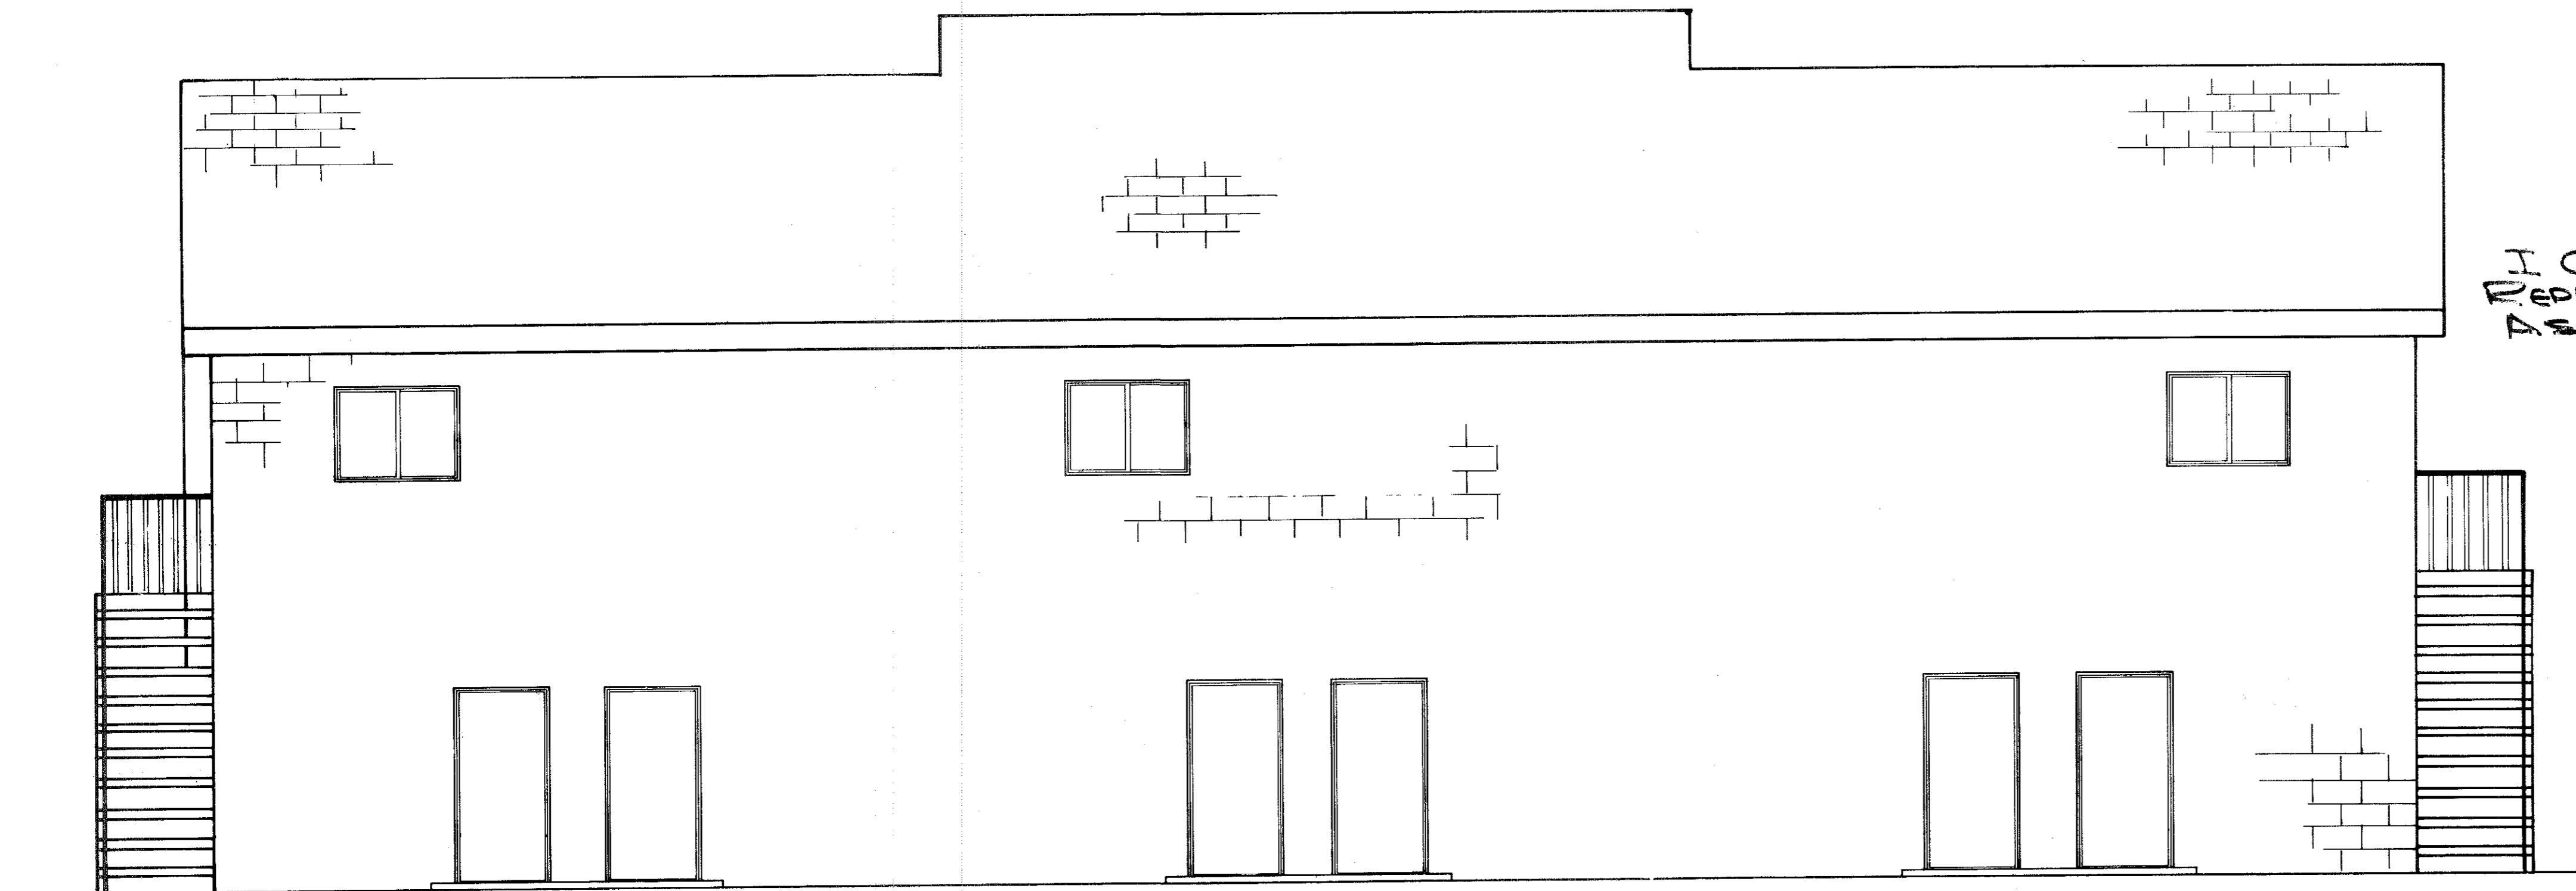


NORTH ELEVATION



SOUTH ELEVATION

CONCORD STATION
BUILDING "B"
ELEVATION VIEWS
SCALE 1/4"=1'-0" DEC, 1976
PREPARED FOR
THE KACUR CO.
WORAIN, OHIO

SHT # 6 OF 12

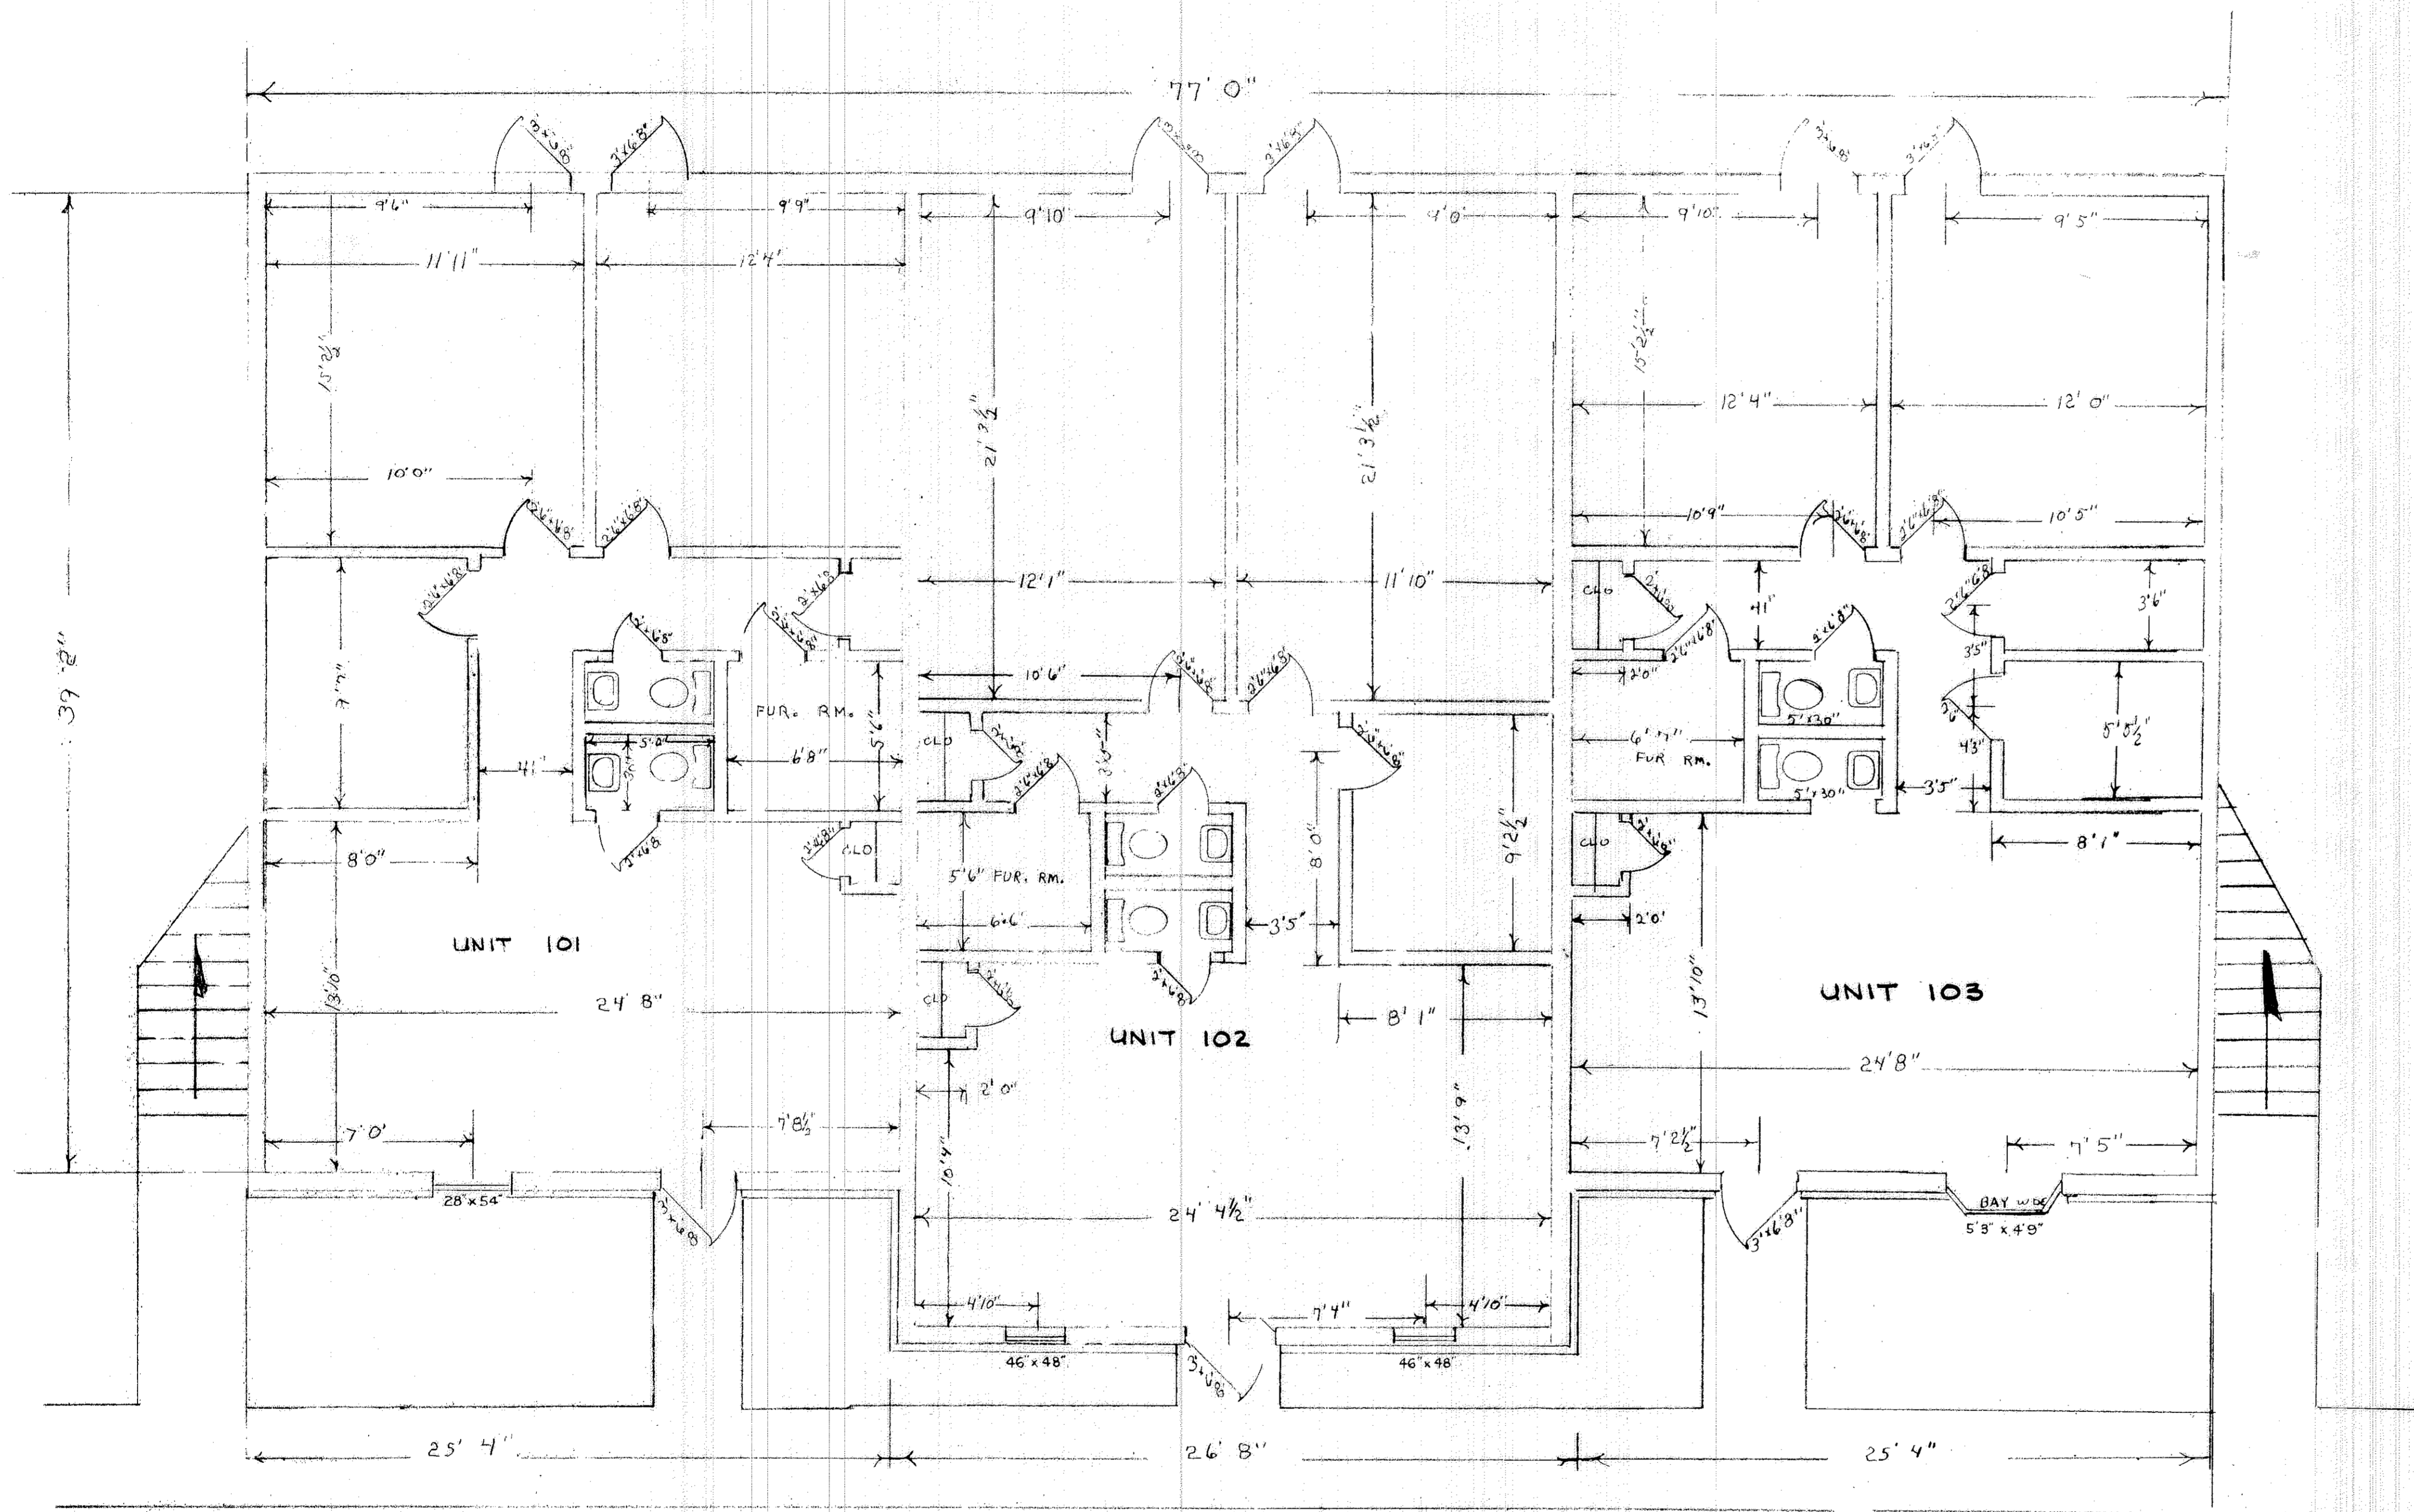

STATEMENT OF CERTIFICATION
 I CERTIFY THAT THE ATTACHED DRAWINGS CORRECTLY
 REPRESENT THE DIMENSIONS OF THE BUILDING AS CONSTRUCTED
 AND THAT THERE ARE NO ENCROACHMENTS ON ANY ADJACENT
 PREMISES EXCEPT AS SHOWN

Robert E. Genside
 REGISTERED SURVEYOR



STATEMENT OF CERTIFICATION
 I CERTIFY THAT THE ATTACHED DRAWINGS
 CORRECTLY REPRESENT THE DIMENSIONS OF
 THE BUILDING AS CONSTRUCTED

Robert E. Genside
 REGISTERED ENGINEER



CONCORD STATION
 BUILDING "B"
 FLOOR PLAN FIRST FLOOR
 SCALE 1/4" = 2'-0" DEC, 1976

PREPARED FOR
 THE KACUR CO.
 LORAIN, OHIO



SHT # 7 OF 12

STATEMENT OF CERTIFICATION
I CERTIFY THAT THE ATTACHED DRAWINGS CORRECTLY
REPRESENT THE DIMENSIONS OF THE BUILDING AS
CONSTRUCTED AND THAT THERE ARE NO ENCROACHMENTS
ON ANY ADJUTING PREMISES EXCEPT AS SHOWN


Robert E. Glenside
REGISTERED SURVEYOR

STATEMENT OF CERTIFICATION
I CERTIFY THAT THE ATTACHED DRAWINGS CORRECTLY
REPRESENT THE DIMENSIONS OF THE BUILDING
AS CONSTRUCTED

Robert E. Glenside
REGISTERED ENGINEER

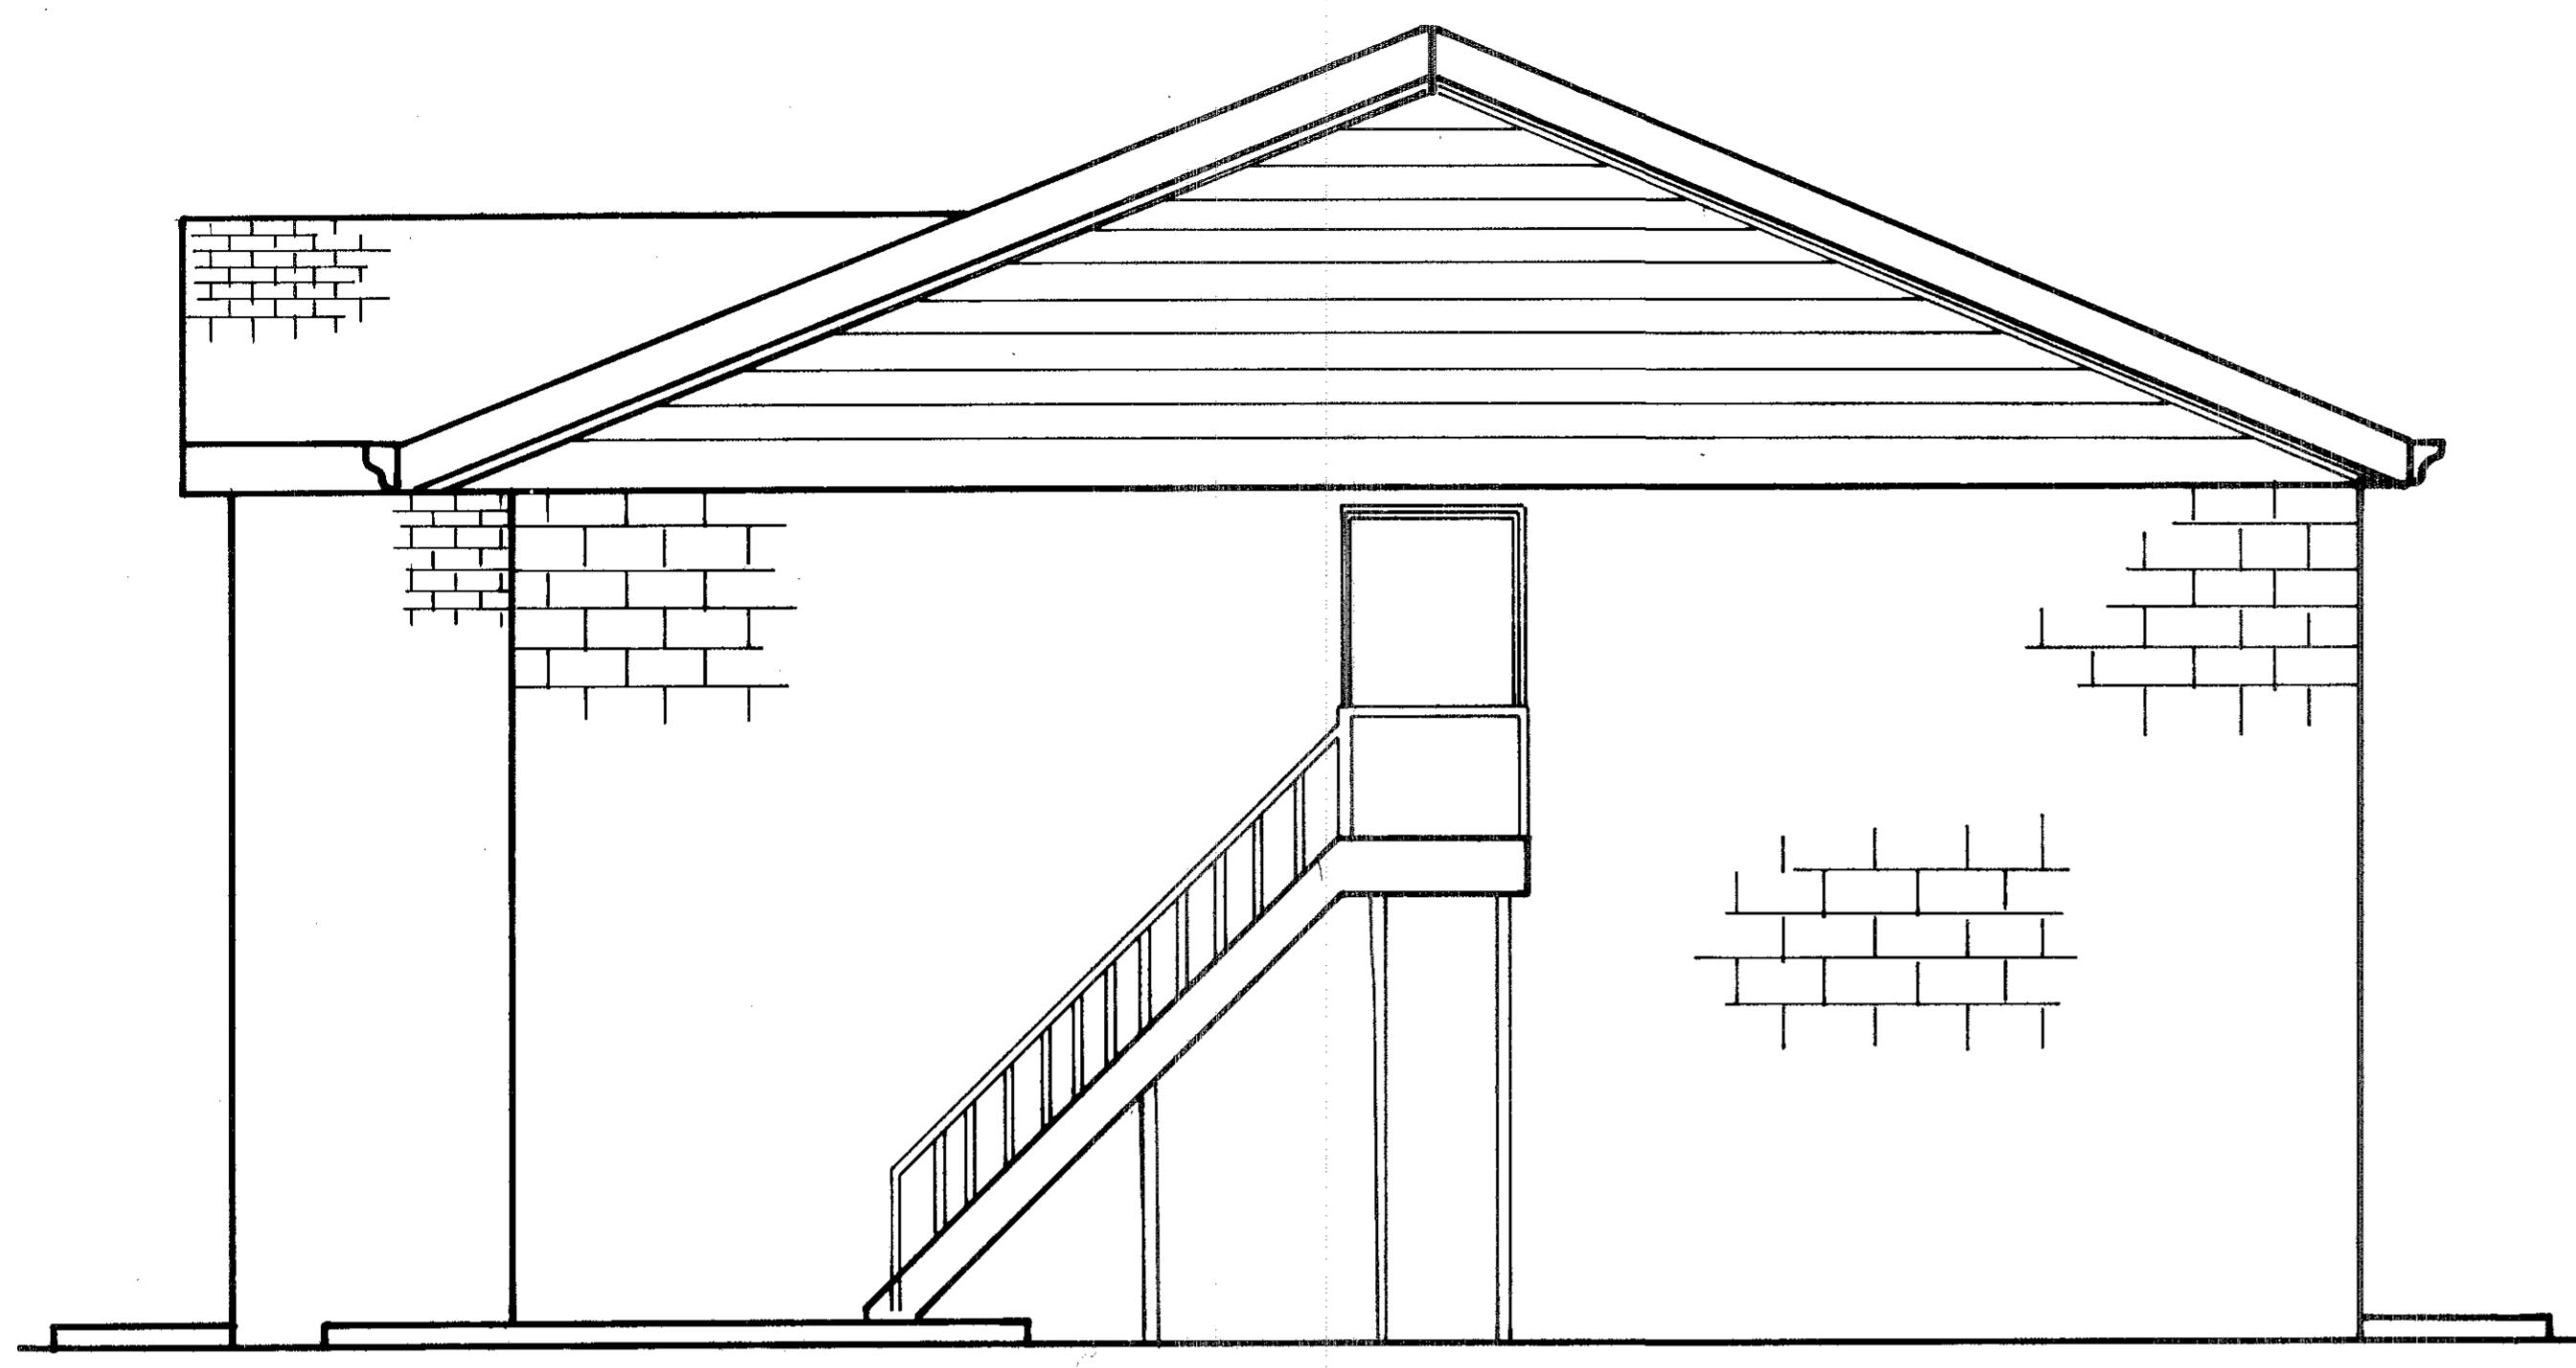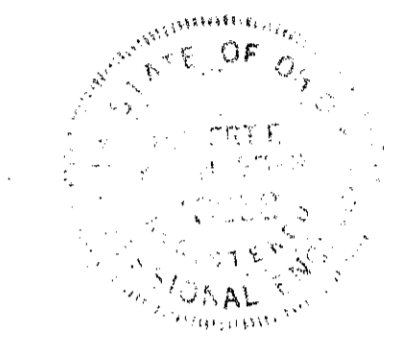

EAST ELEVATION

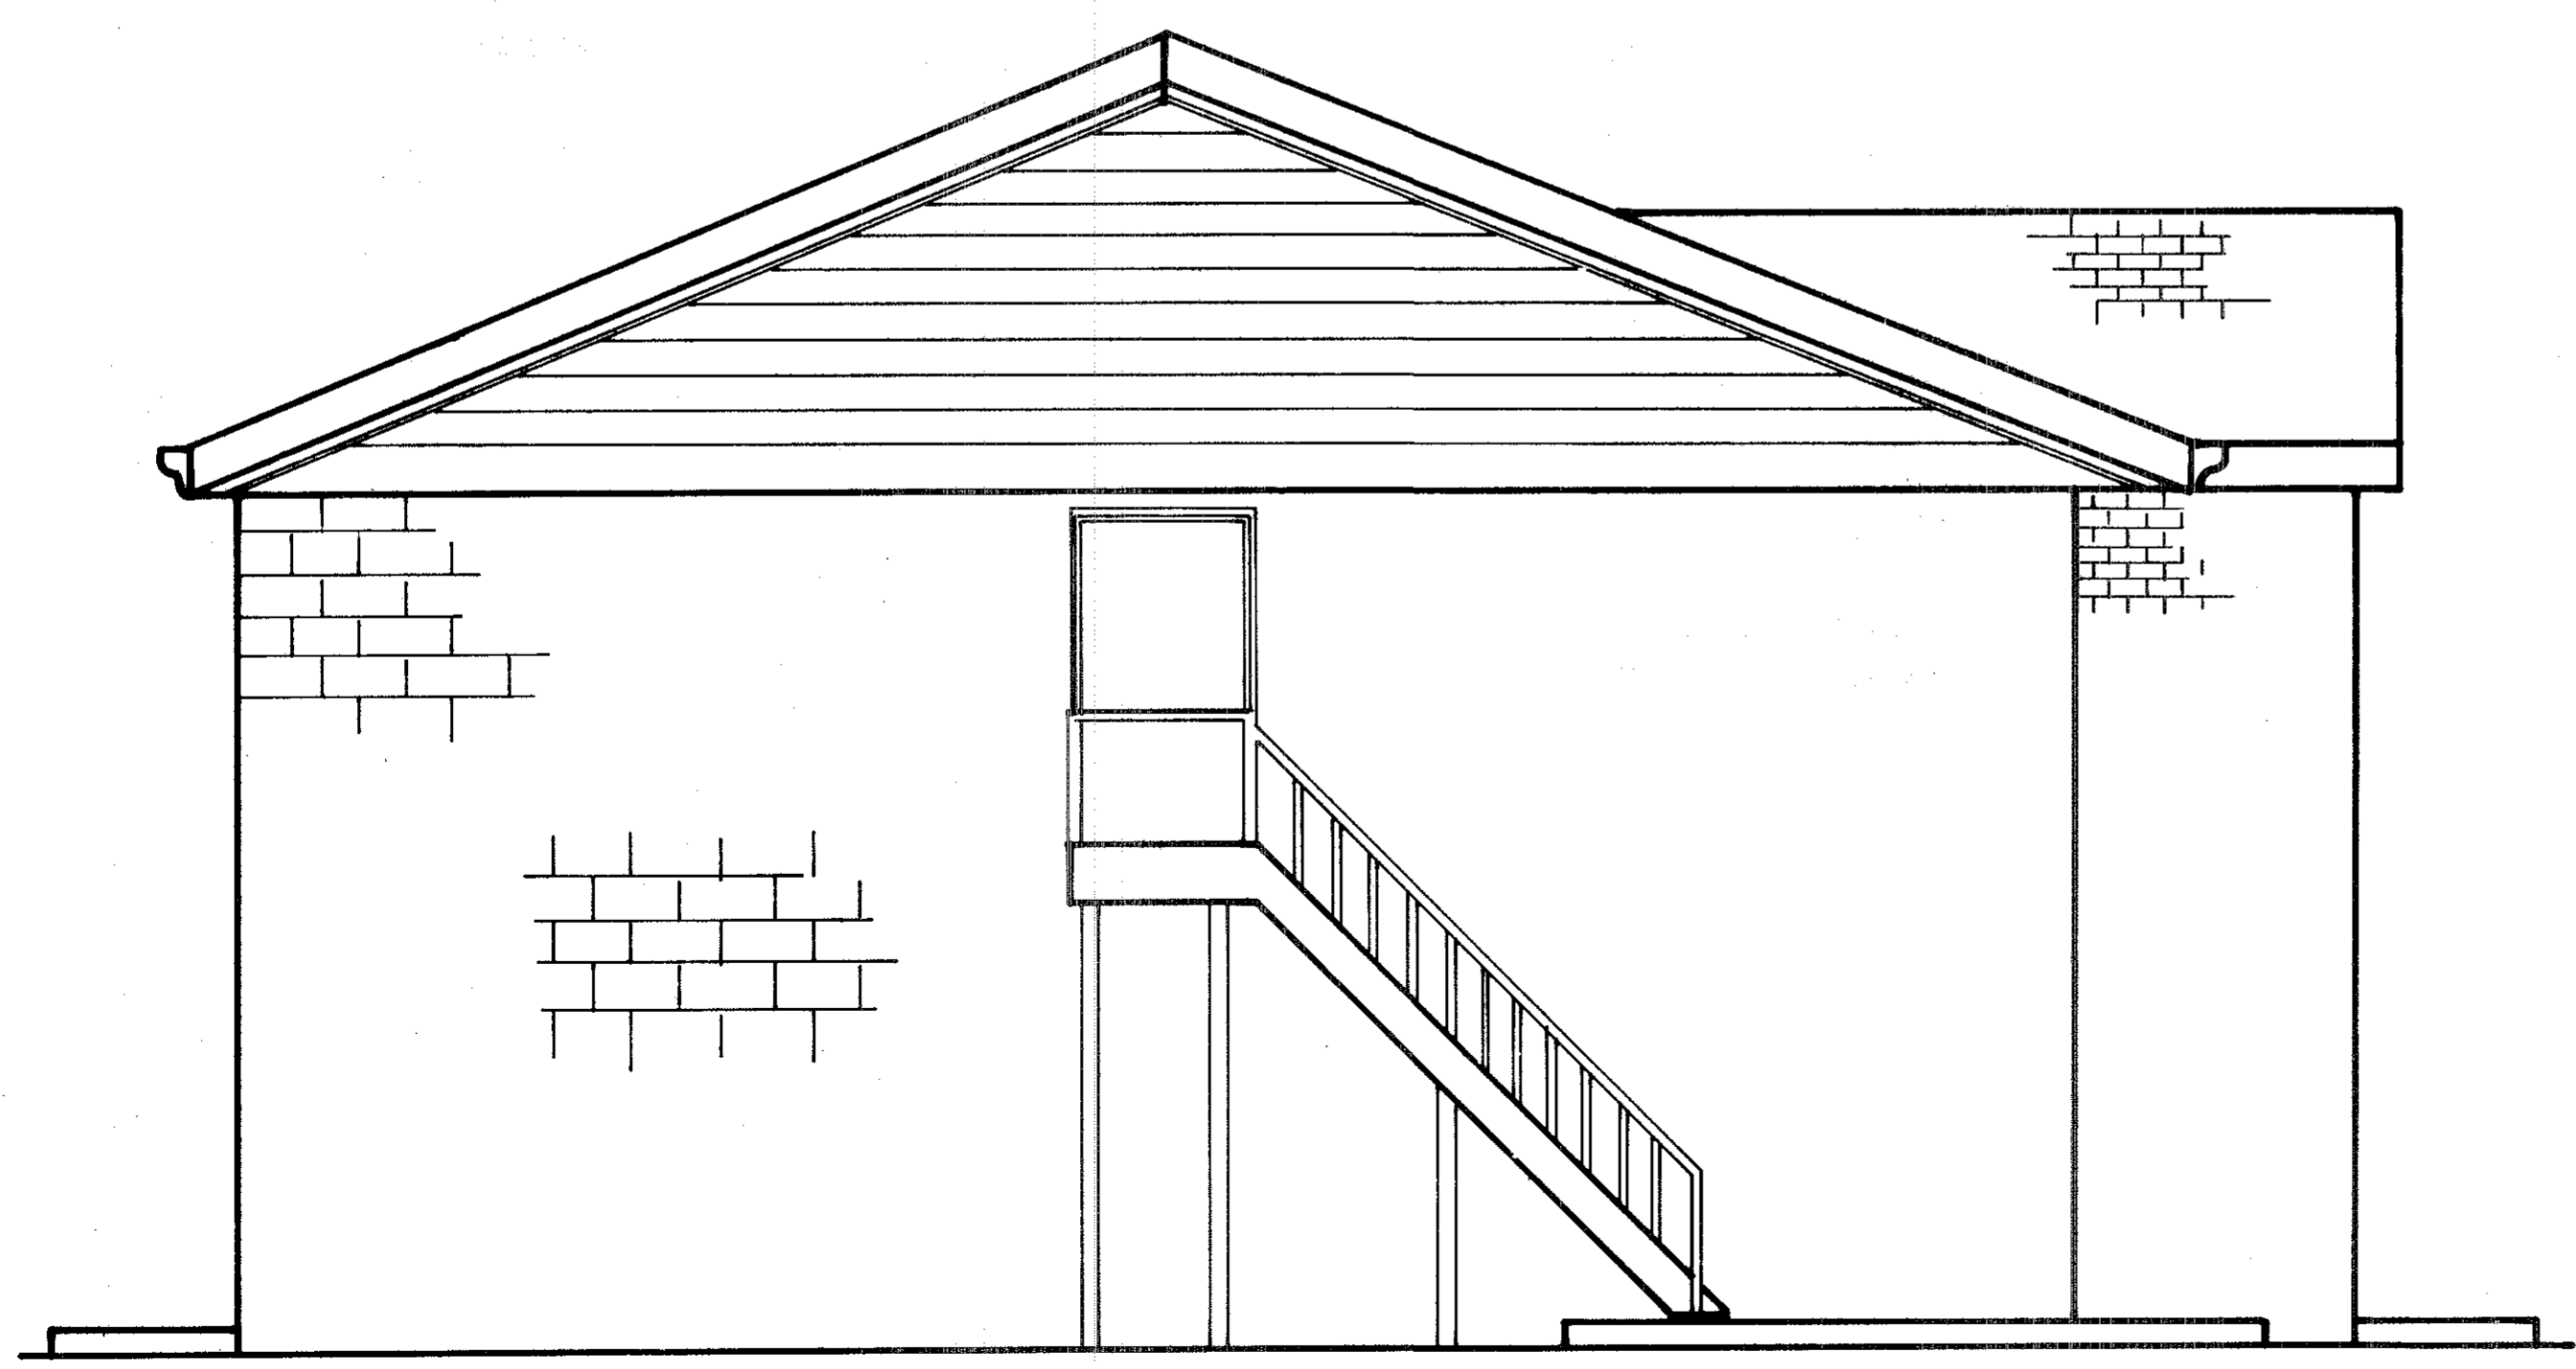


WEST ELEVATION

CONCORD STATION
BUILDING "C"
ELEVATION VIEWS
SCALE 1/4"=1'-0" DEC, 1976

PREPARED FOR
THE KACUR CO.
WORAIN, OHIO

SHT# 9 OF 12

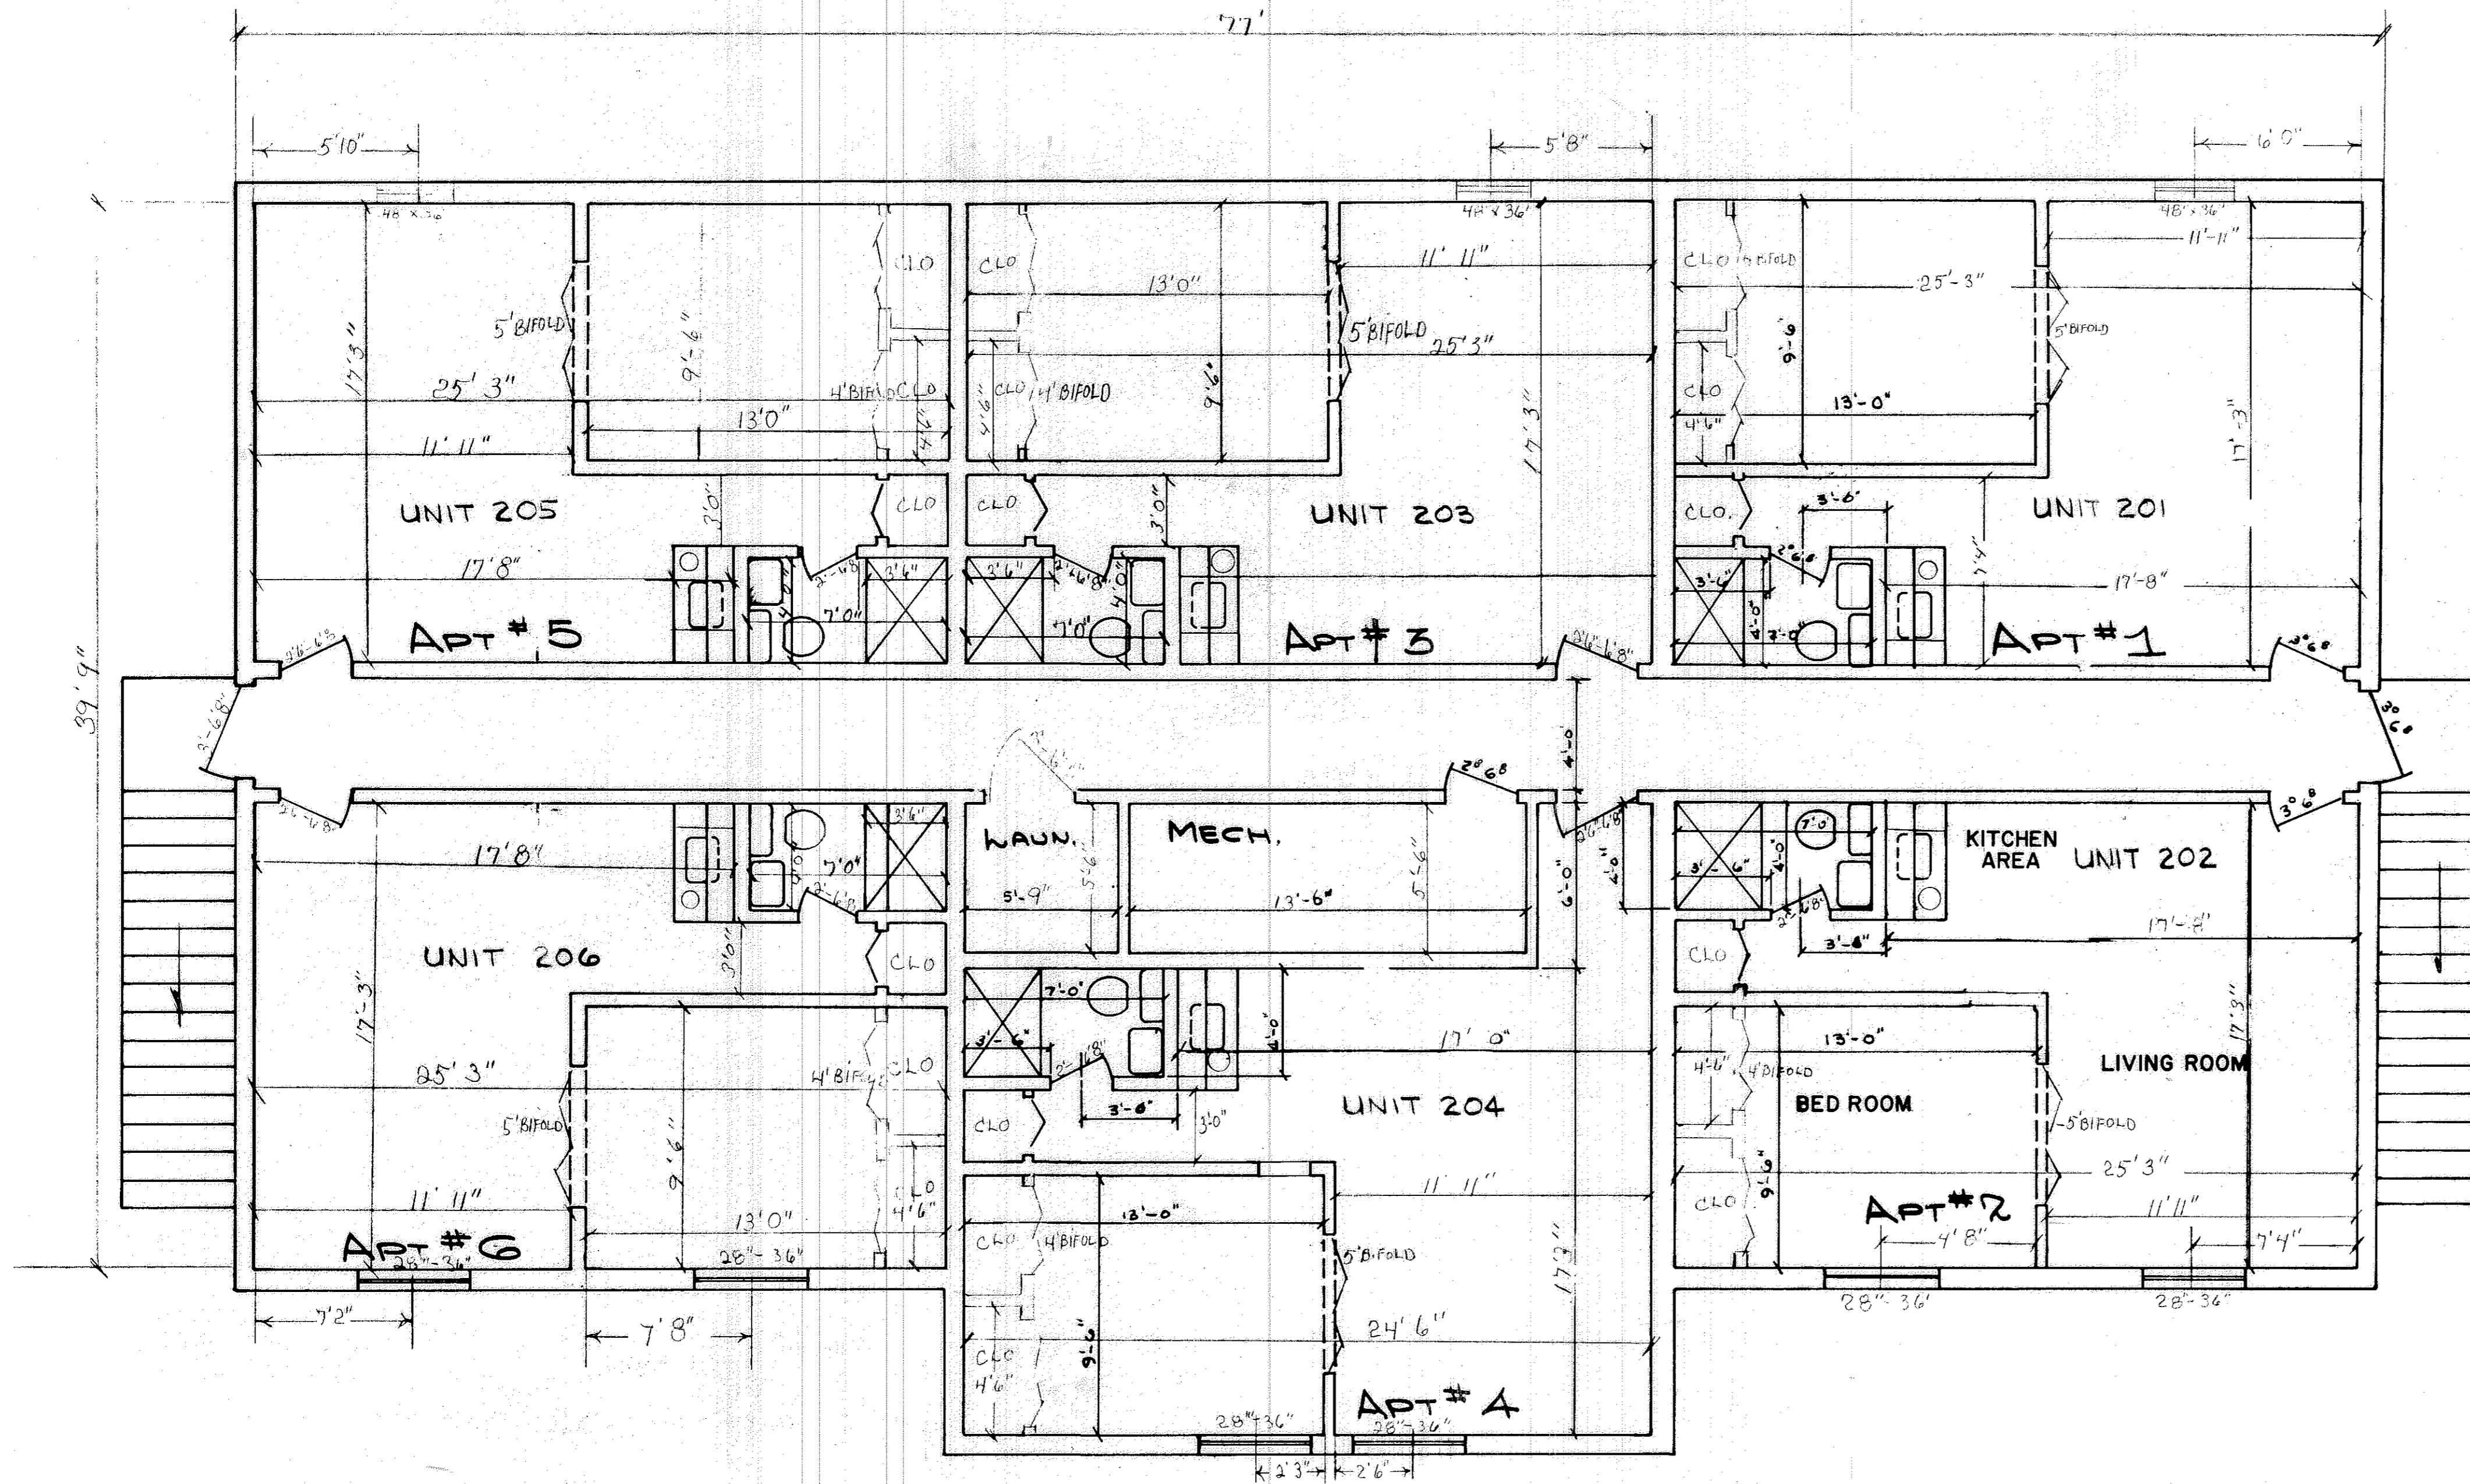


STATEMENT OF CERTIFICATION
 I CERTIFY THAT THE ATTACHED DRAWINGS CORRECTLY
 REPRESENT THE DIMENSIONS OF THE BUILDING AS CONSTRUCTED
 AND THAT THERE ARE NO ENCROACHMENTS ON ANY ADJACENT
 PREMISES EXCEPT AS SHOWN

Robert E. Givens
 REGISTERED SURVEYOR

STATEMENT OF CERTIFICATION
 I CERTIFY THAT THE ATTACHED DRAWINGS
 CORRECTLY REPRESENT THE DIMENSIONS OF
 THE BUILDING AS CONSTRUCTED

Robert E. Givens
 REGISTERED ENGINEER

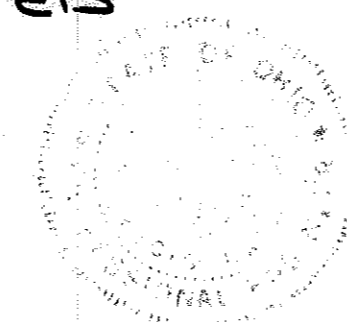

CONCORD STATION
 BUILDING "B"
 FLOOR PLAN SECOND FLOOR
 SCALE 1/4" = 1'-0" DEC, 1976

PREPARED FOR
 THE KACUR CO.
 LORAIN, OHIO


SHT # 8 OF 12

STATEMENT OF CERTIFICATION
I CERTIFY THAT THE ATTACHED DRAWINGS CORRECTLY REPRESENT THE DIMENSIONS OF THE BUILDING AS CONSTRUCTED AND THAT THERE ARE NO ENCROACHMENTS ON ANY ABUTTING PREMISES EXCEPT AS SHOWN


Robert E. Heinicke
REGISTERED SURVEYOR

STATEMENT OF CERTIFICATION
I CERTIFY THAT THE ATTACHED DRAWINGS CORRECTLY REPRESENT THE DIMENSIONS OF THE BUILDING AS CONSTRUCTED

Robert E. Heinicke
REGISTERED ENGINEER

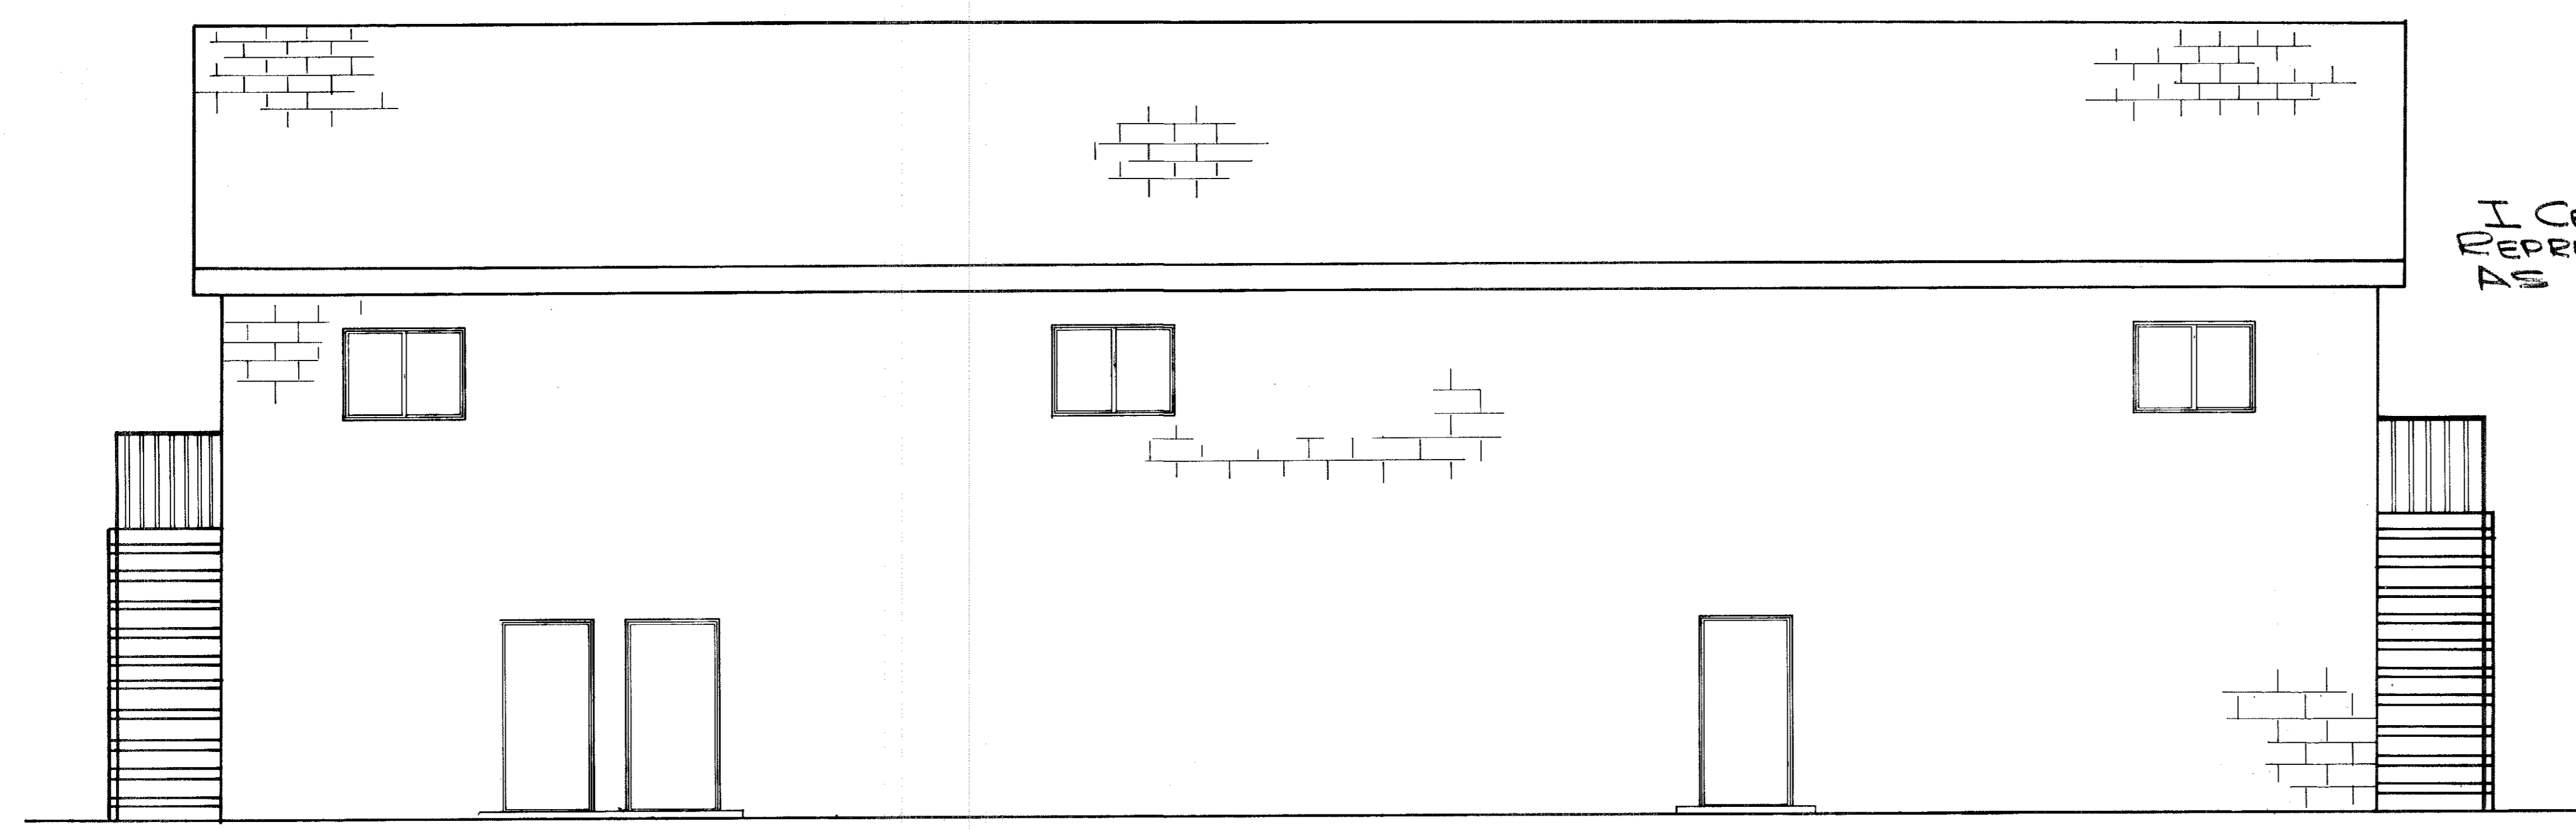

NORTH ELEVATION

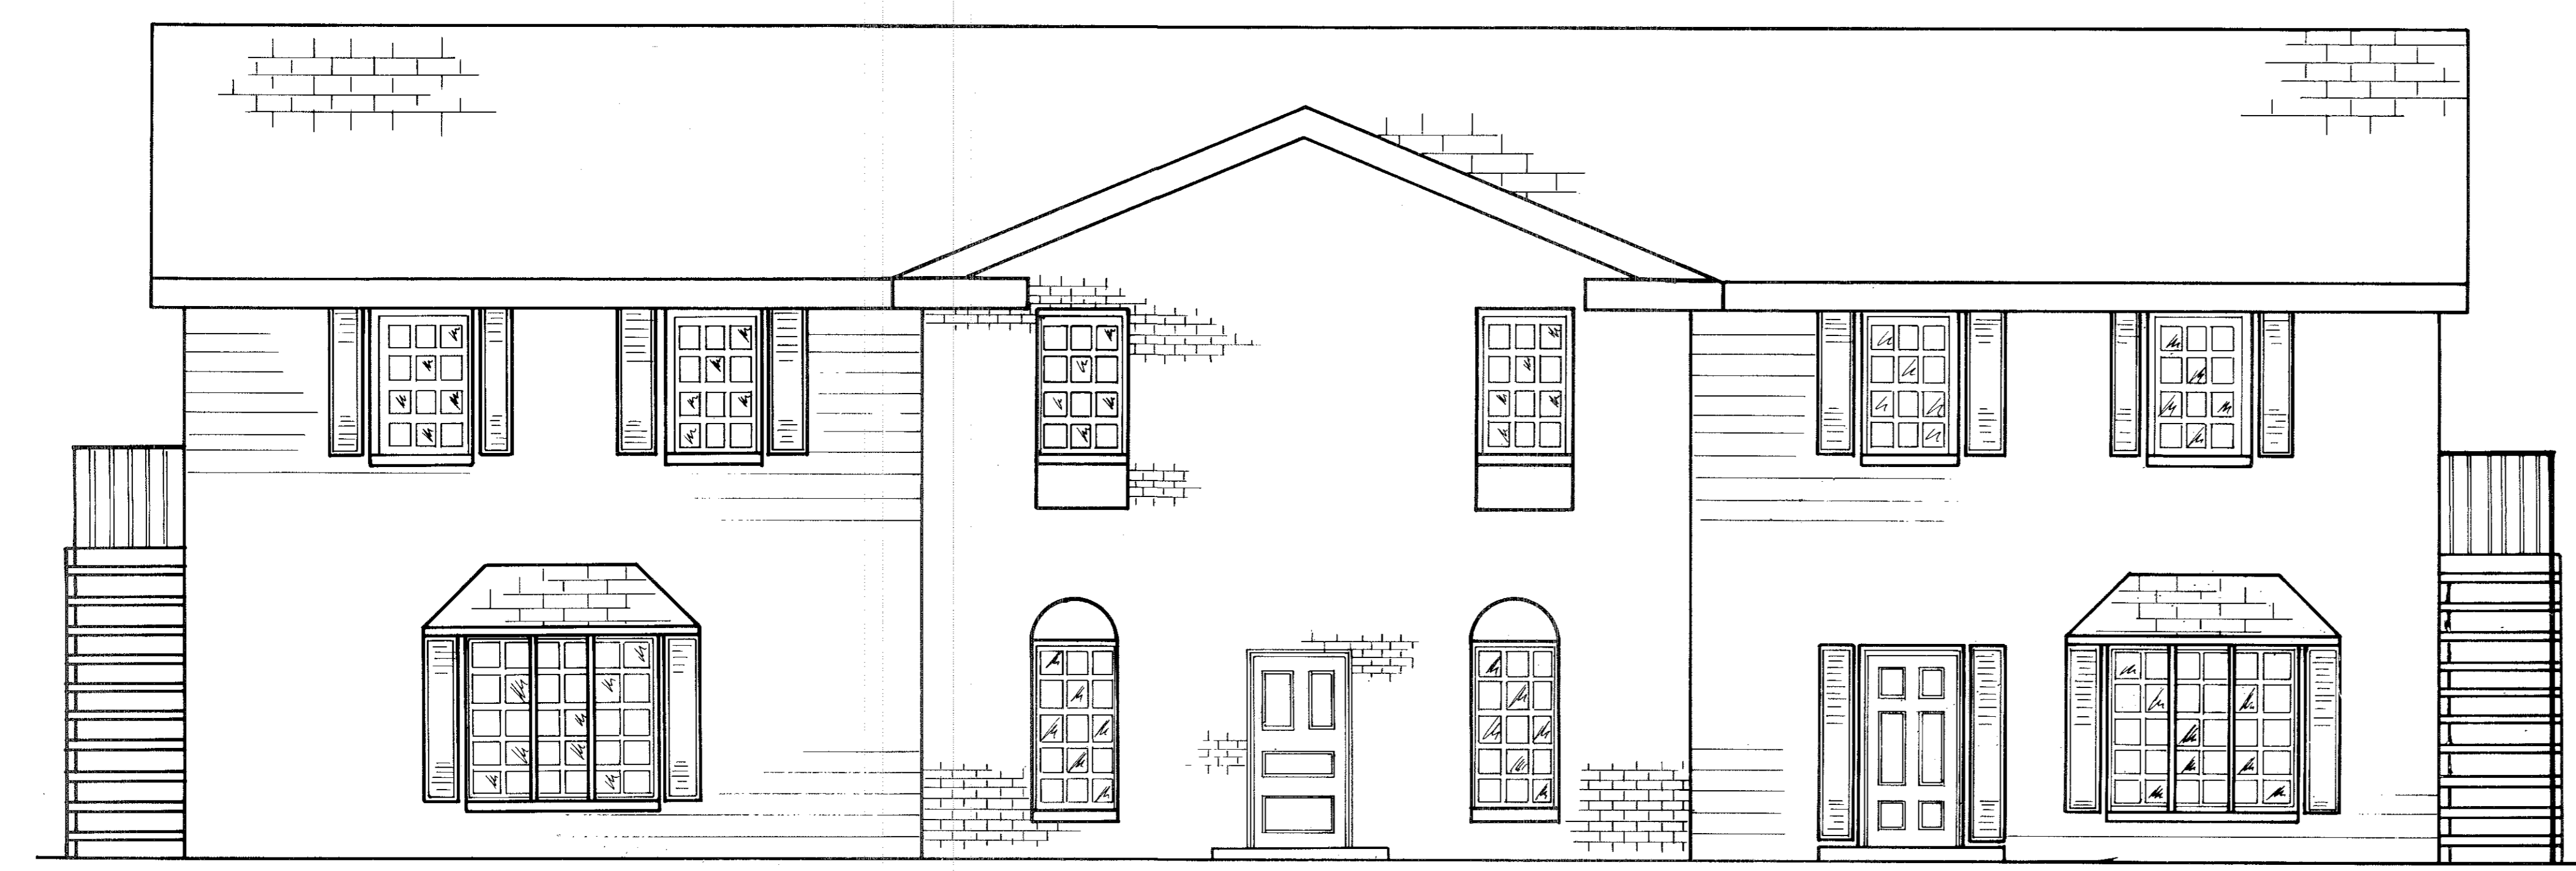

SOUTH ELEVATION

CONCORD STATION
BUILDING "C"
ELEVATION VIEWS
SCALE 1/4"=1'-0" DEC, 1976
PREPARED FOR
THE KACUR CO.
WORAIN, OHIO

SHT #10 OF 12



CONCORD STATION
BUILDING 'C'
FLOOR PLAN FIRST FLOOR
SCALE 1/4" = 1'-0" DEC, 1916
PREPARED FOR
THE KACUR CO.
LORAIN, OHIO


STATEMENT OF CERTIFICATION
I CERTIFY THAT THE ATTACHED DRAWINGS CORRECTLY
REPRESENT THE DIMENSIONS OF THE BUILDING AS CONSTRUCTED
AND THAT THERE ARE NO ENCROACHMENTS ON ANY ABUTTING
PREMISES EXCEPT AS SHOWN

Robert E. Schneider
REGISTERED SURVEYOR

STATEMENT OF CERTIFICATION
I CERTIFY THAT THE ATTACHED DRAWINGS
CORRECTLY REPRESENT THE DIMENSIONS OF
THE BUILDING AS CONSTRUCTED

Robert E. Schneider
REGISTERED ENGINEER

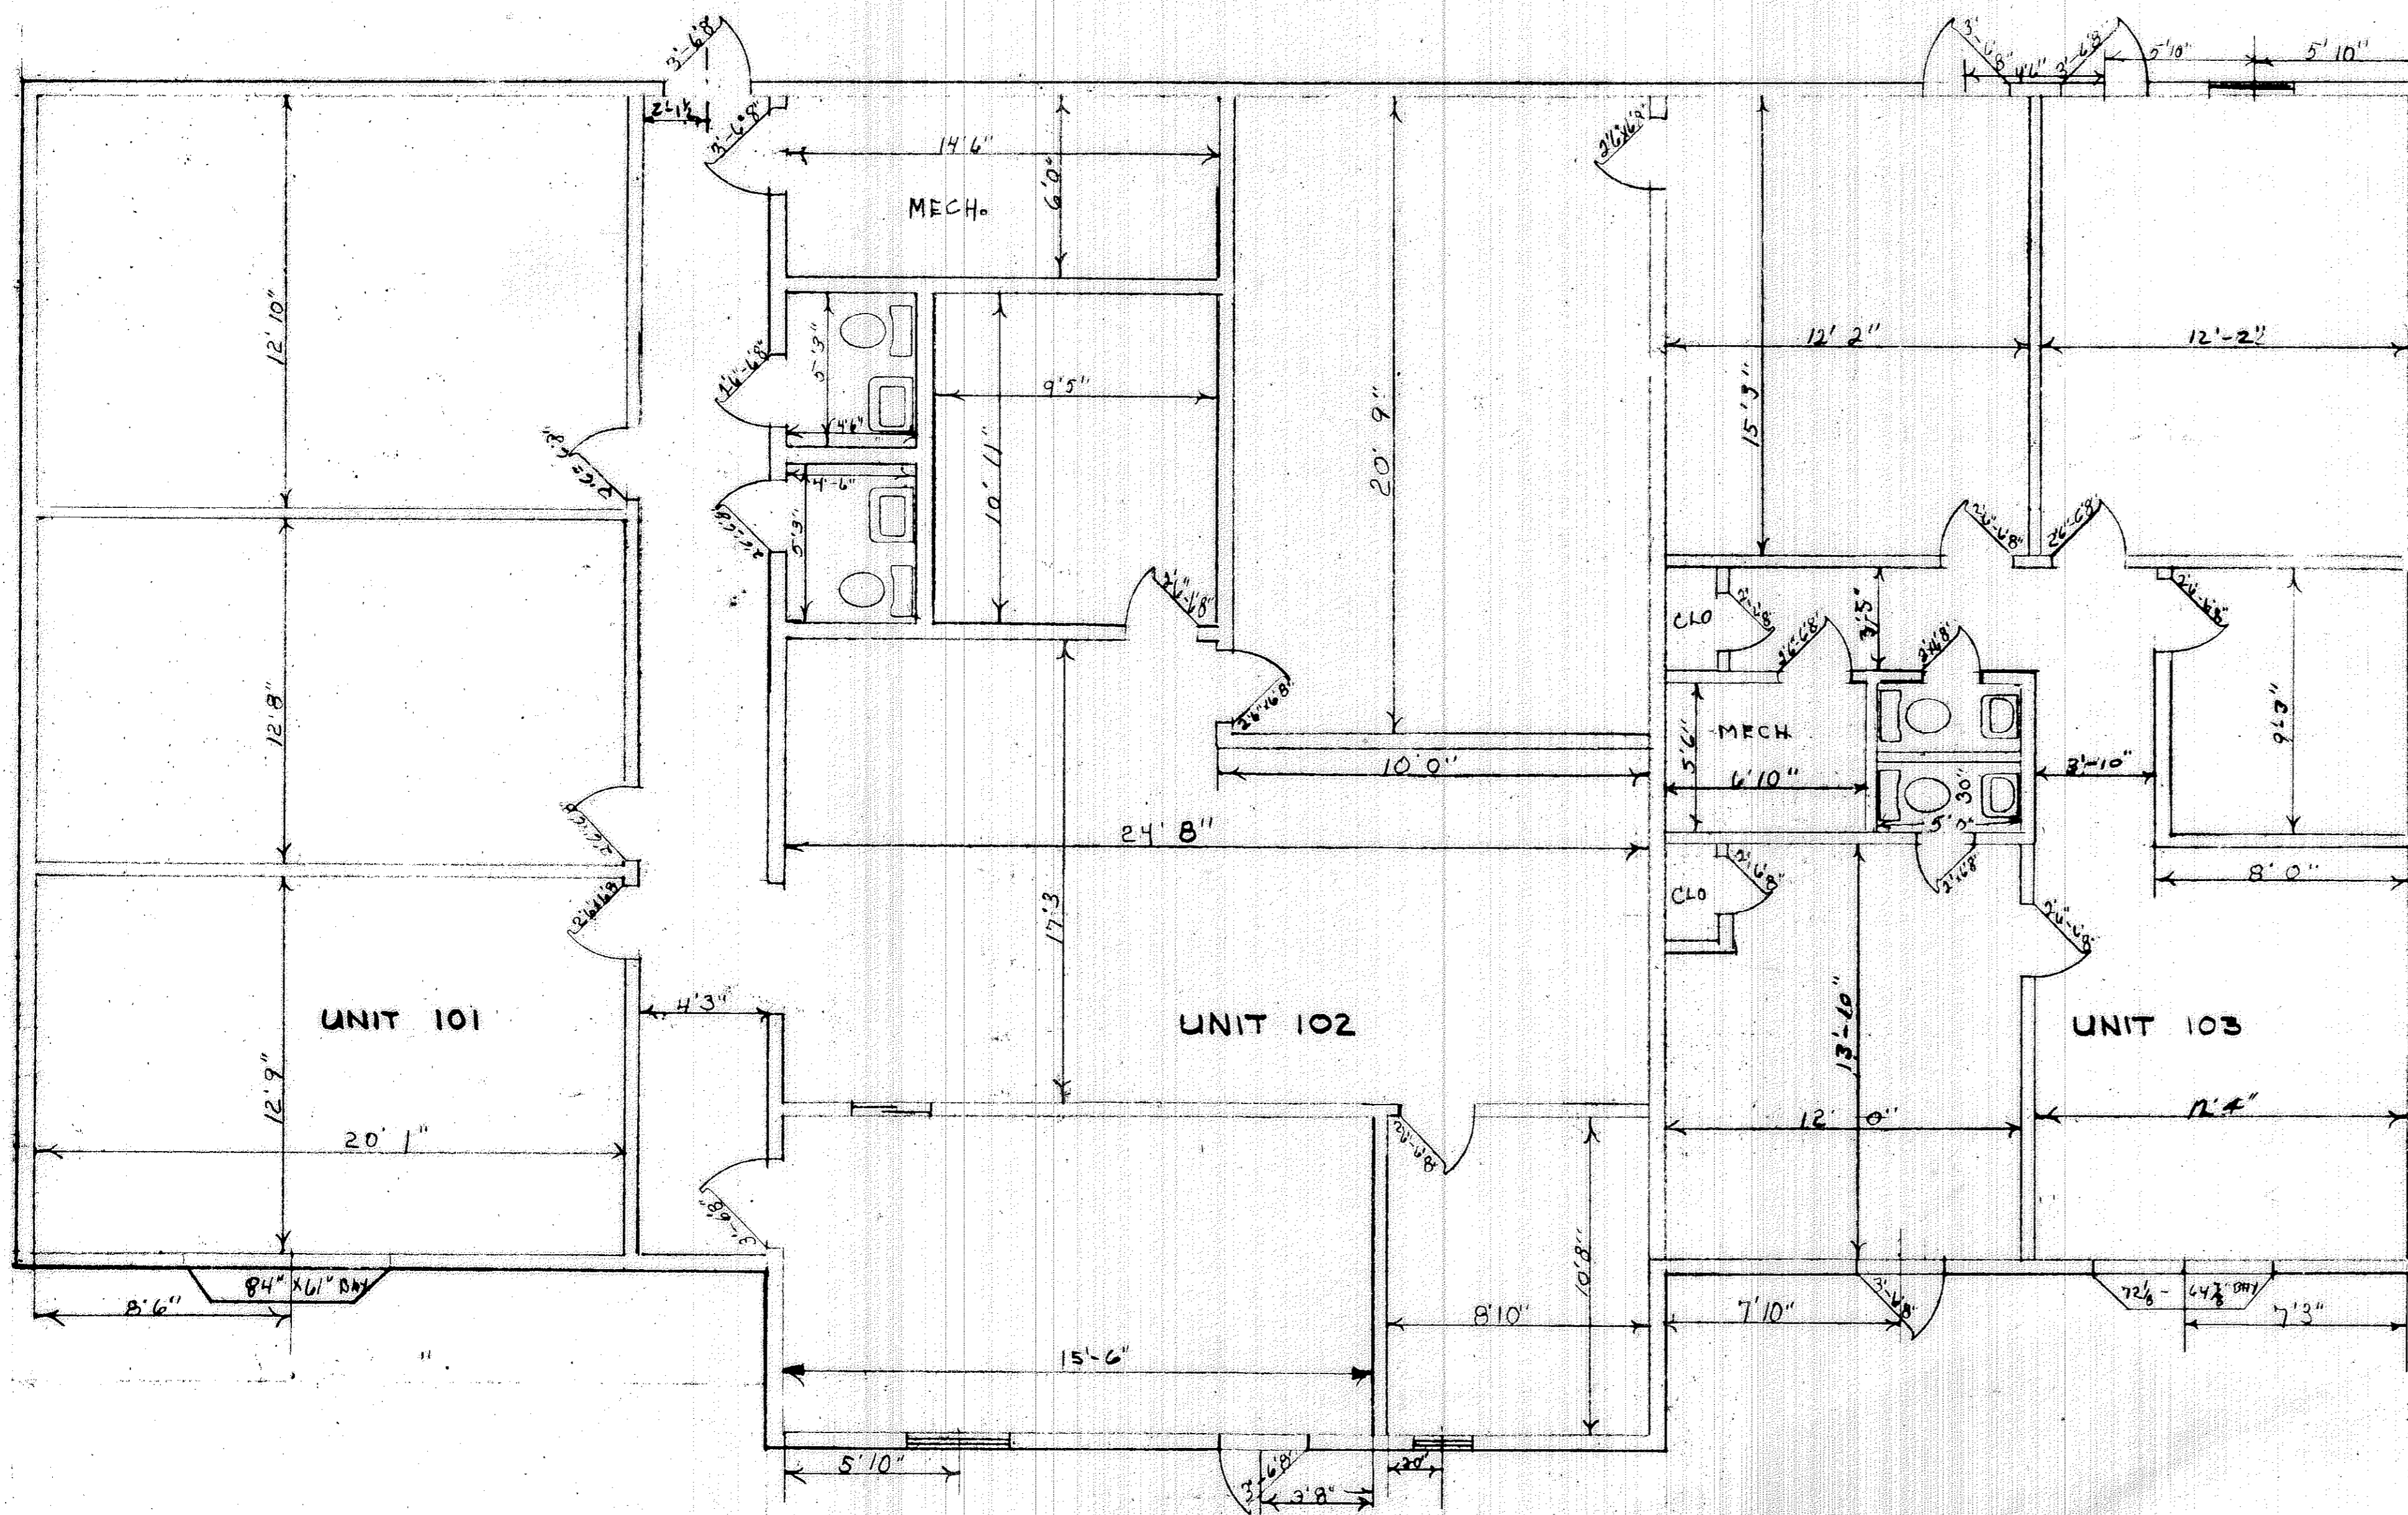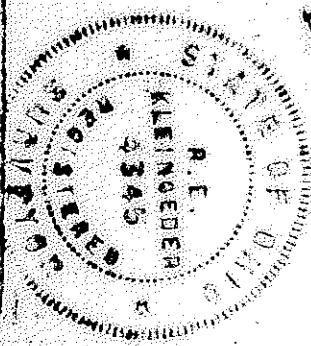


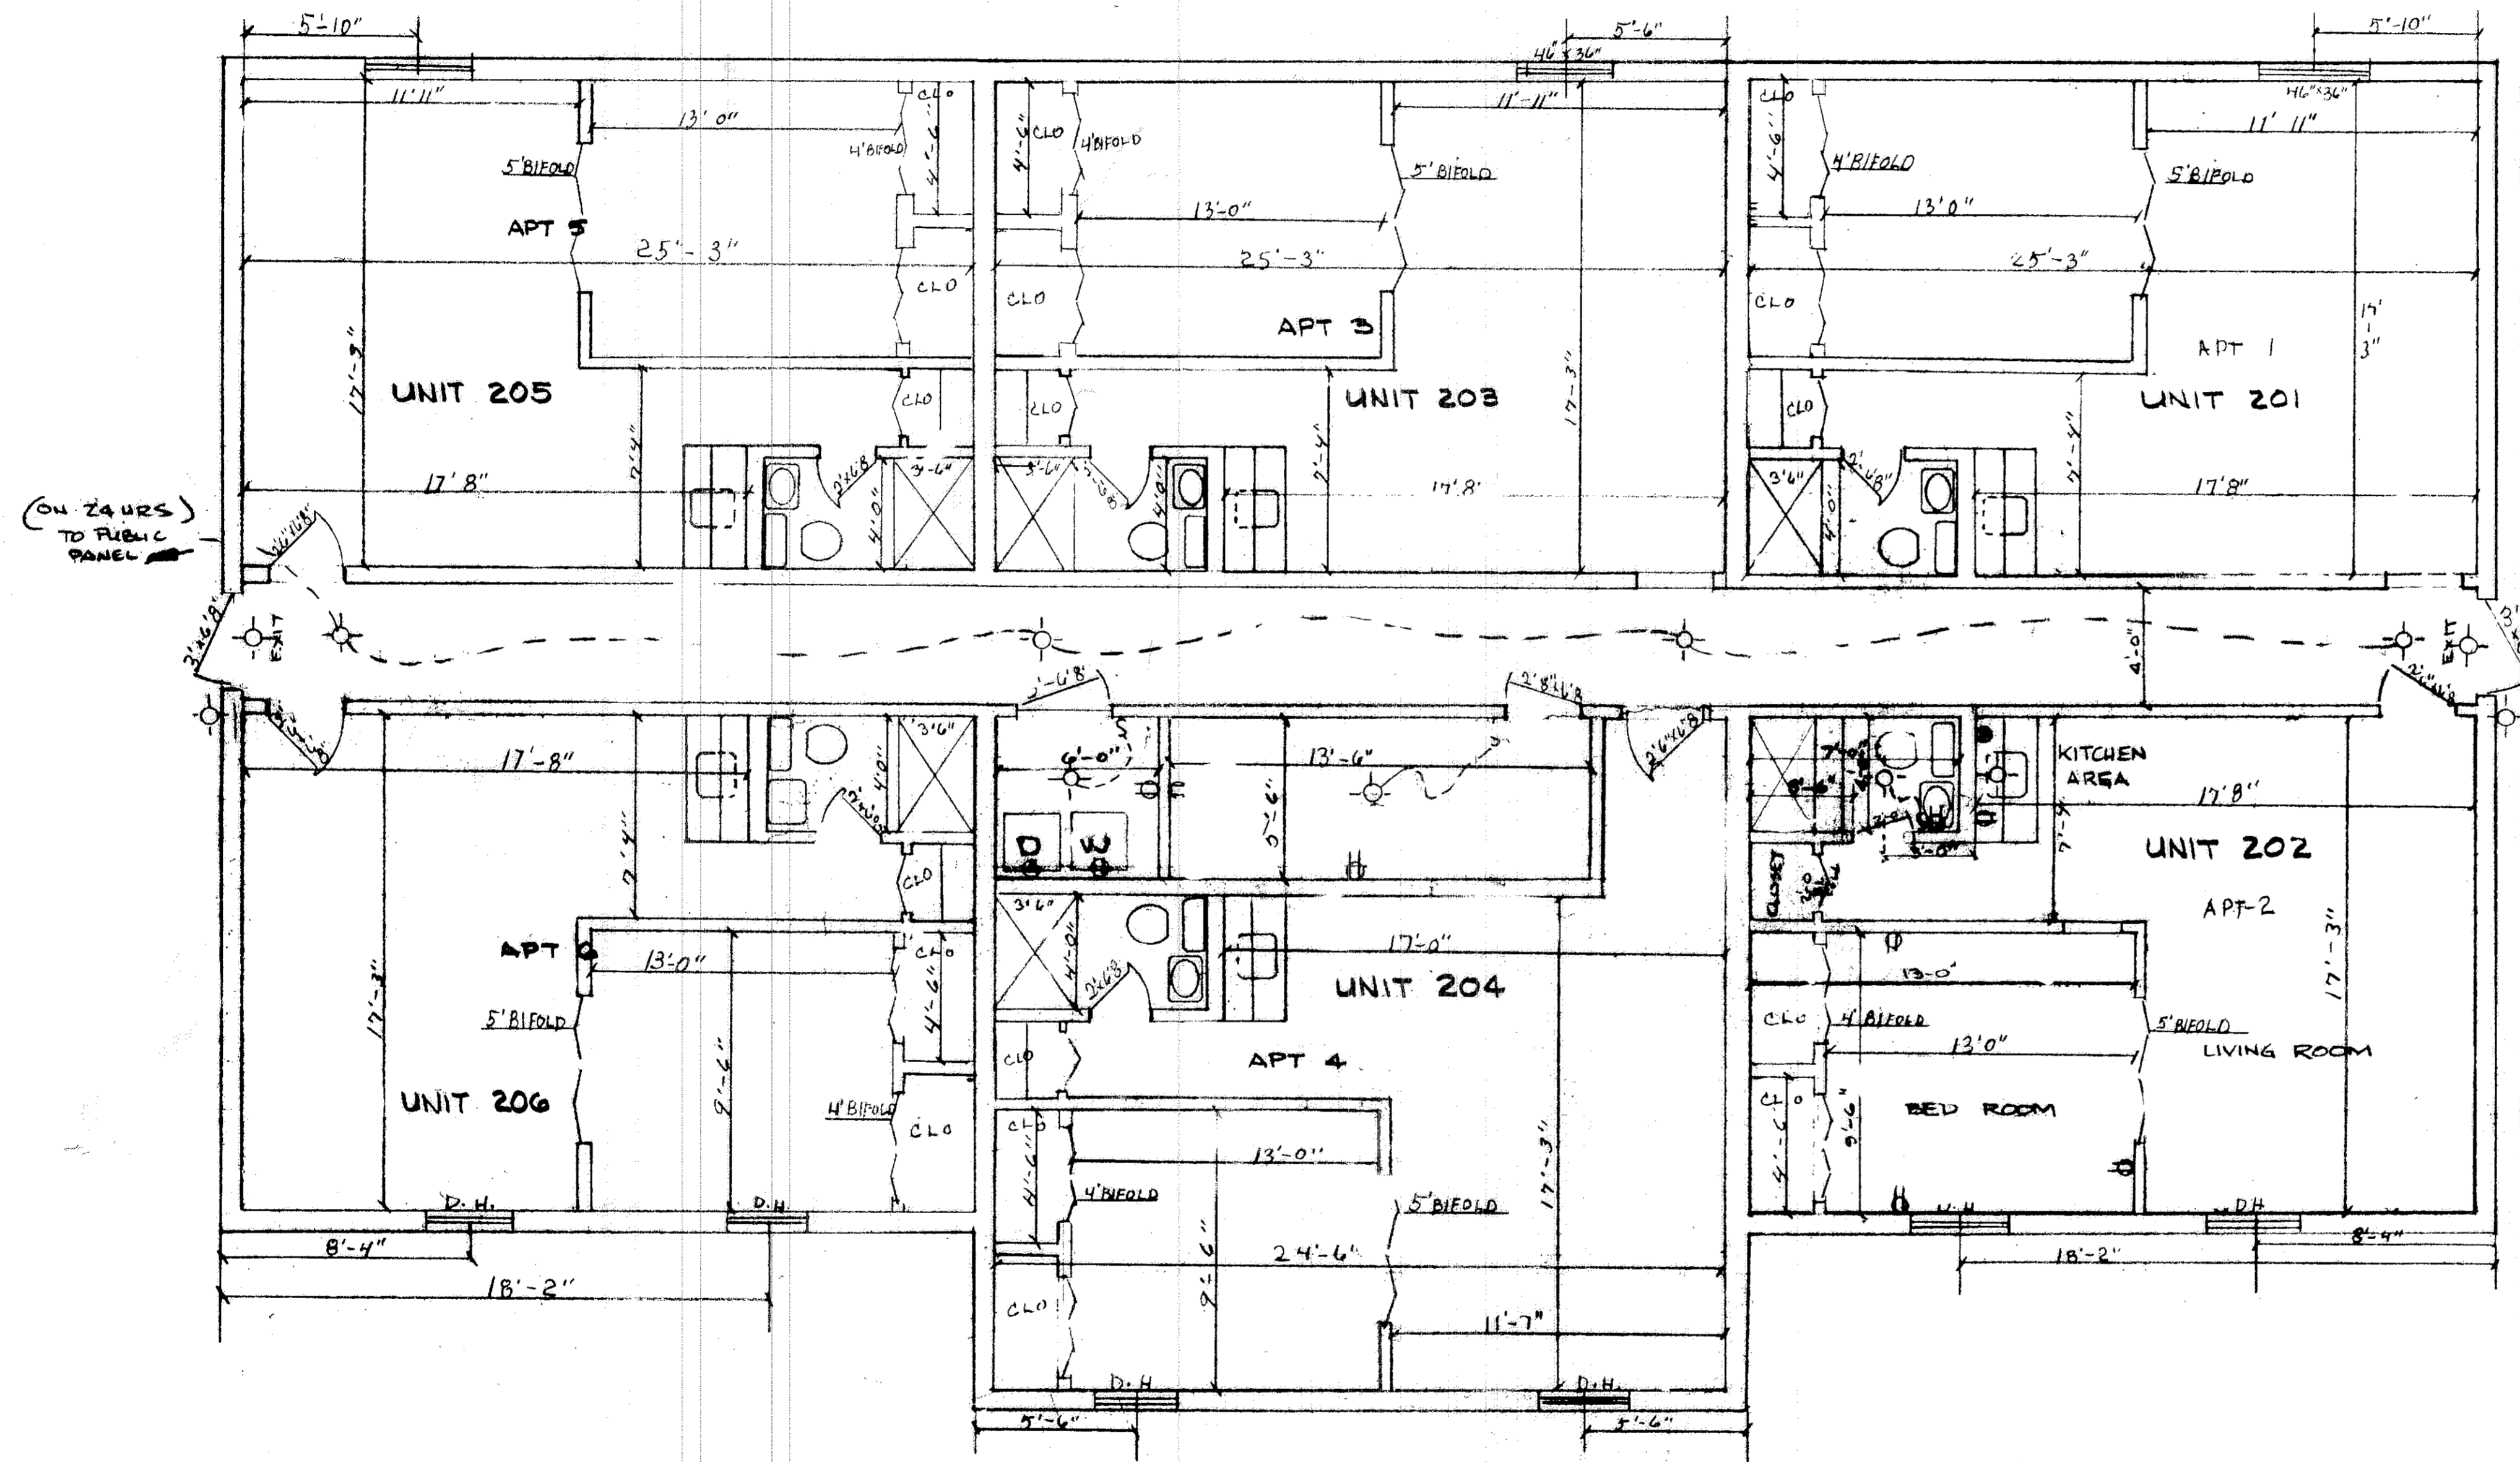

STATEMENT OF CERTIFICATION
 I CERTIFY THAT THE ATTACHED DRAWINGS CORRECTLY
 REPRESENT THE DIMENSIONS OF THE BUILDING AS CONSTRUCTED
 AND THAT THERE ARE NO ENCROACHMENTS ON ANY ABUTTING
 PREMISES EXCEPT AS SHOWN

Robert E. Kleingraber


REGISTERED SURVEYOR

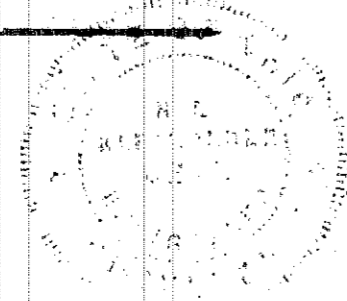

STATEMENT OF CERTIFICATION
 I CERTIFY THAT THE ATTACHED DRAWINGS
 CORRECTLY REPRESENT THE DIMENSIONS OF
 THE BUILDING AS CONSTRUCTED

Robert E. Kleingraber

REGISTERED ENGINEER

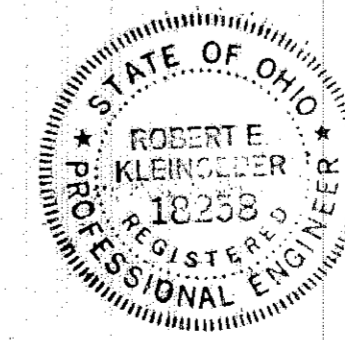

CONCORD STATION
 BUILDING "C"
 FLOOR PLAN SECOND FLOOR
 SCALE 1/4" = 1' DEC. 1971

PREPARED FOR
 THE KACUR CO.
 LORAIN, OHIO

SHEET 12 OF 12

TRANSFERRED
 IN COMPLIANCE WITH SEC. 310-202
 OHIO REV. CODE
 FEB 16 1977
 J. L. A. S. S.
 LORAIN COUNTY