


938948
938948

AVON CENTER ESTATES
SUBDIVISION NO.1
P.V.12 PG.19
208 207 206 205

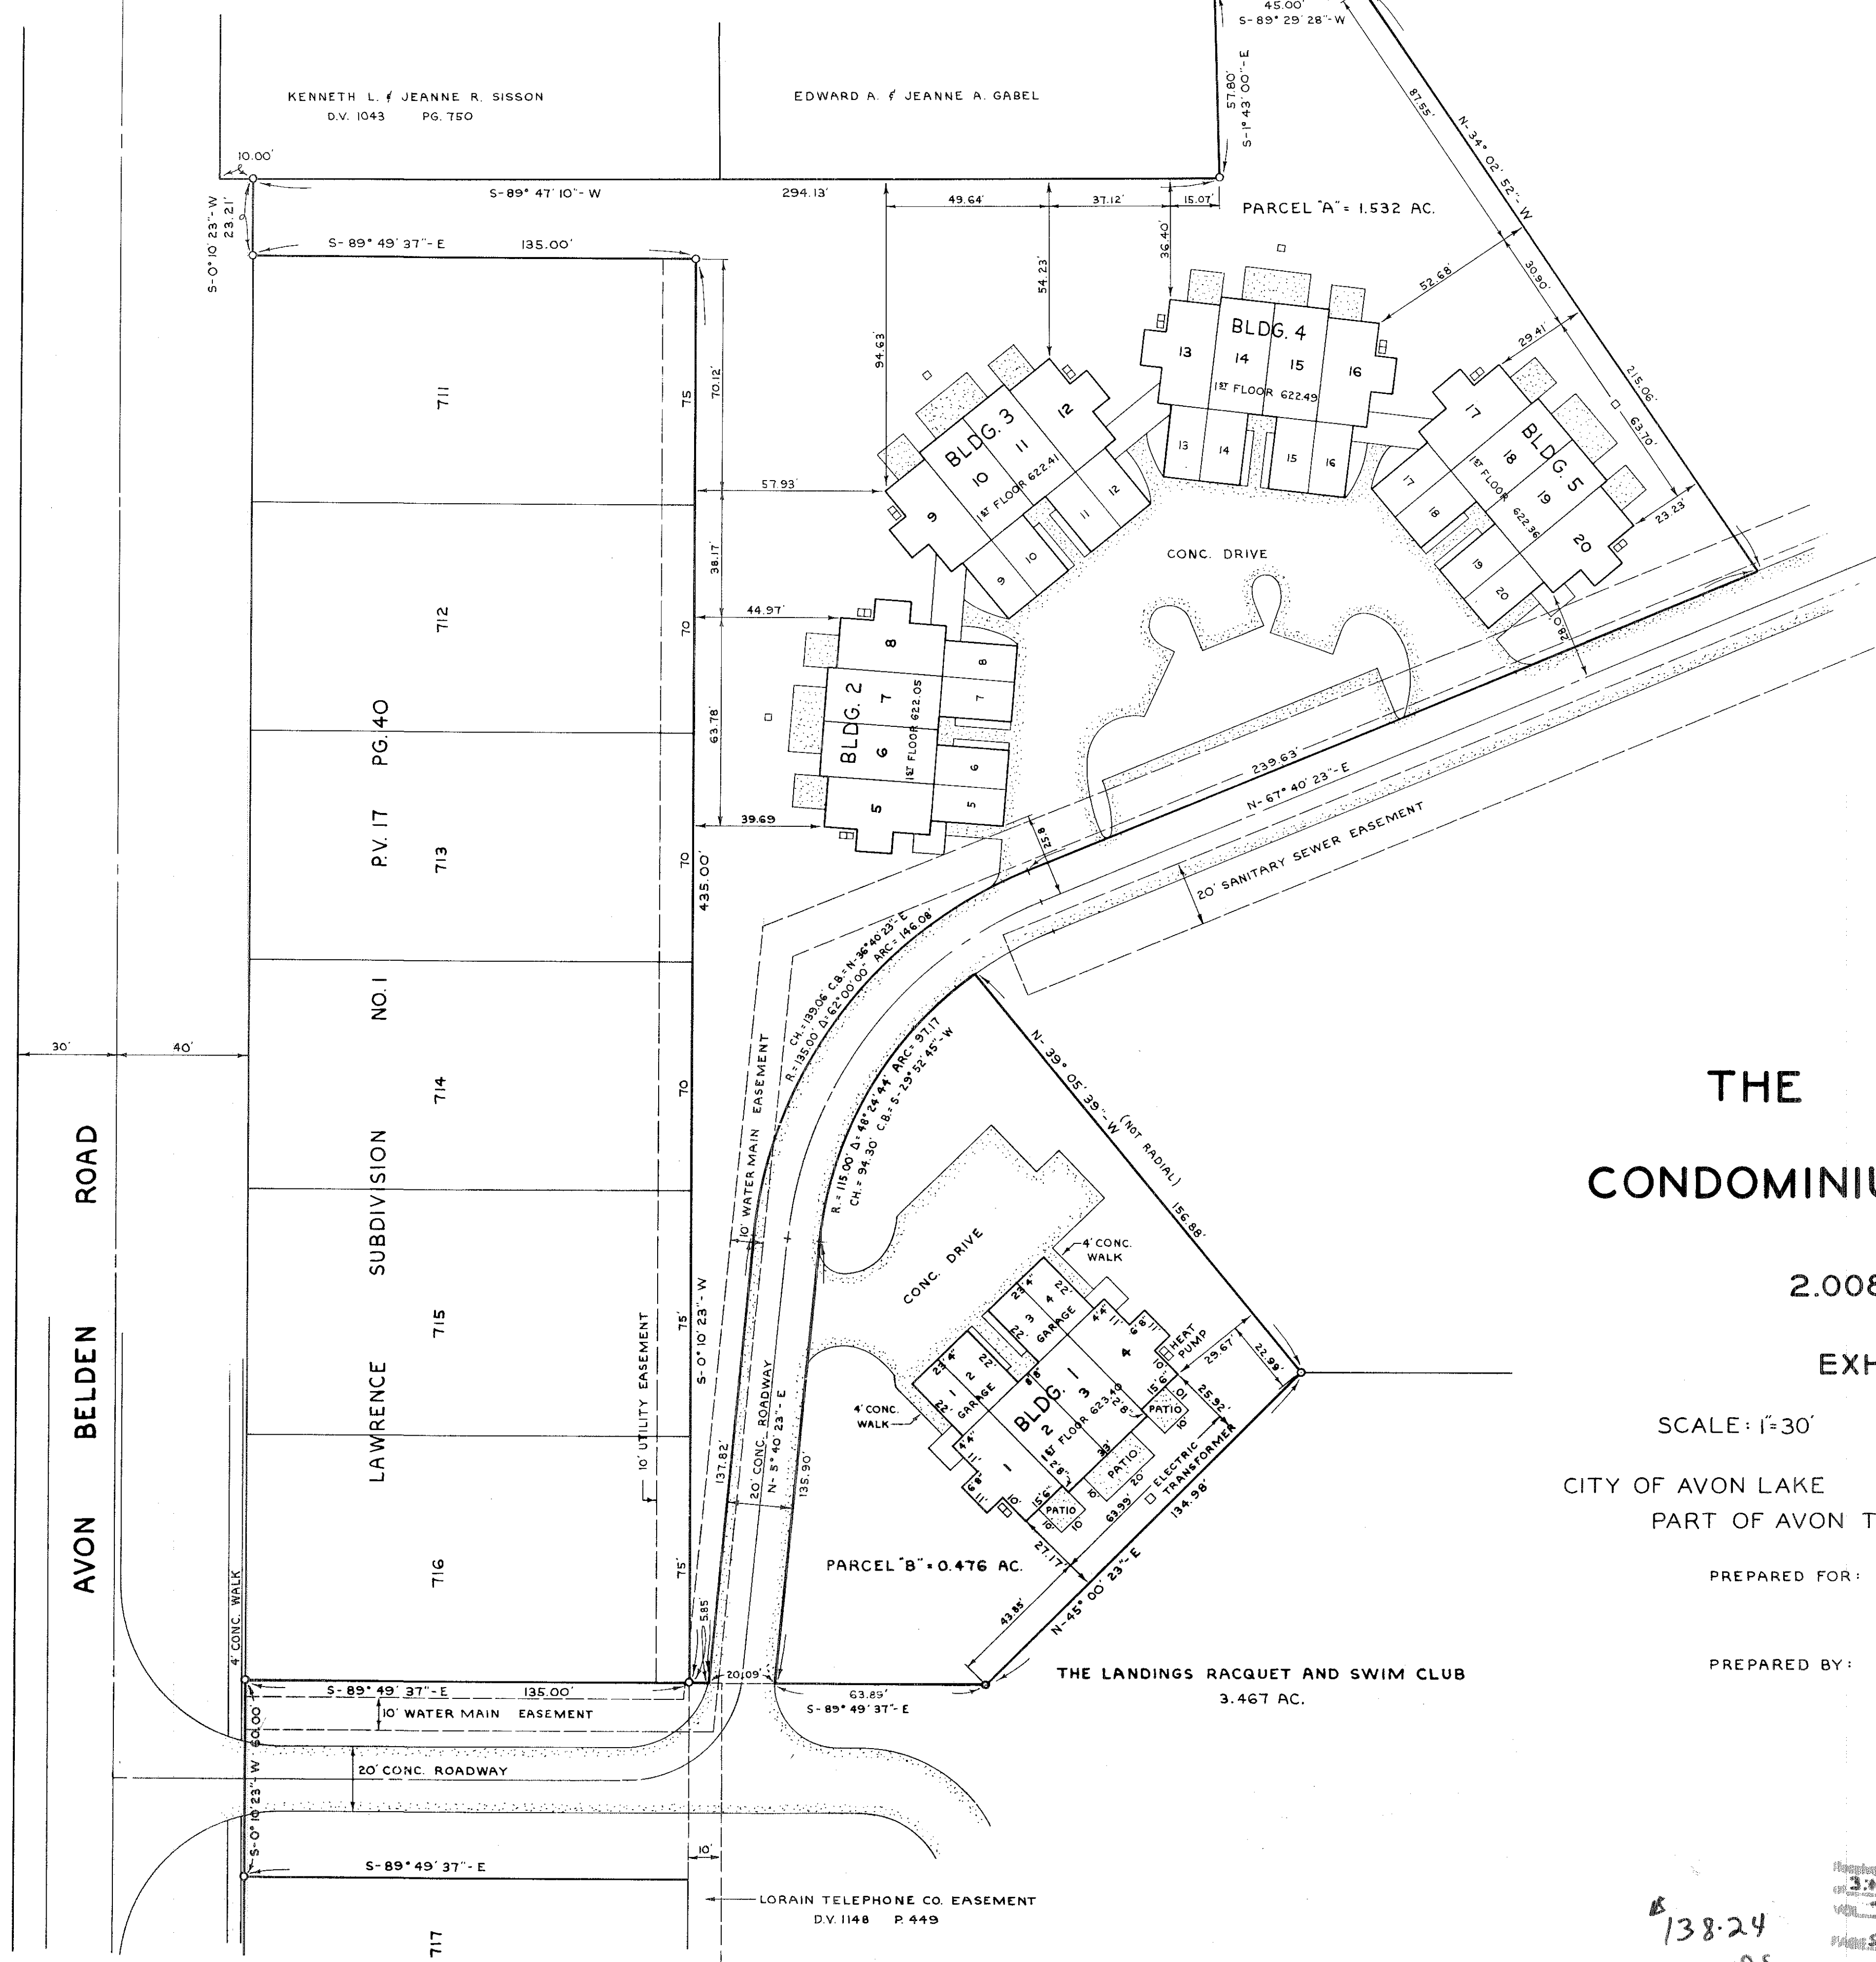

**THE LANDINGS
CONDOMINIUM NO.1**

2.008 ACRES

EXHIBIT "A"

SCALE: 1"=30' JANUARY 1977

CITY OF AVON LAKE COUNTY OF LORAIN
PART OF AVON TOWNSHIP SECTION 18

PREPARED FOR: KOPF CONSTRUCTION
AVON LAKE

PREPARED BY: KLEINOEDER-SCHMIDT & ASSOCIATES
CONSULTING ENGINEERS & SURVEYORS
ELYRIA

STATEMENT OF CERTIFICATION


I CERTIFY THAT THE ATTACHED DRAWINGS
CORRECTLY REPRESENT THE DIMENSIONS OF THE
BUILDINGS AS CONSTRUCTED AND THAT THERE
ARE NO ENCROACHMENTS ON ANY ADJUTING
PREMISES.

James H. Schmidt
JAMES H. SCHMIDT REGISTERED SURVEYOR

138-24
25

EEB 201077
32
32
Dorothy L. Esser
Lorain County Recorder
16 APR 23

Box: Lorain County Jail

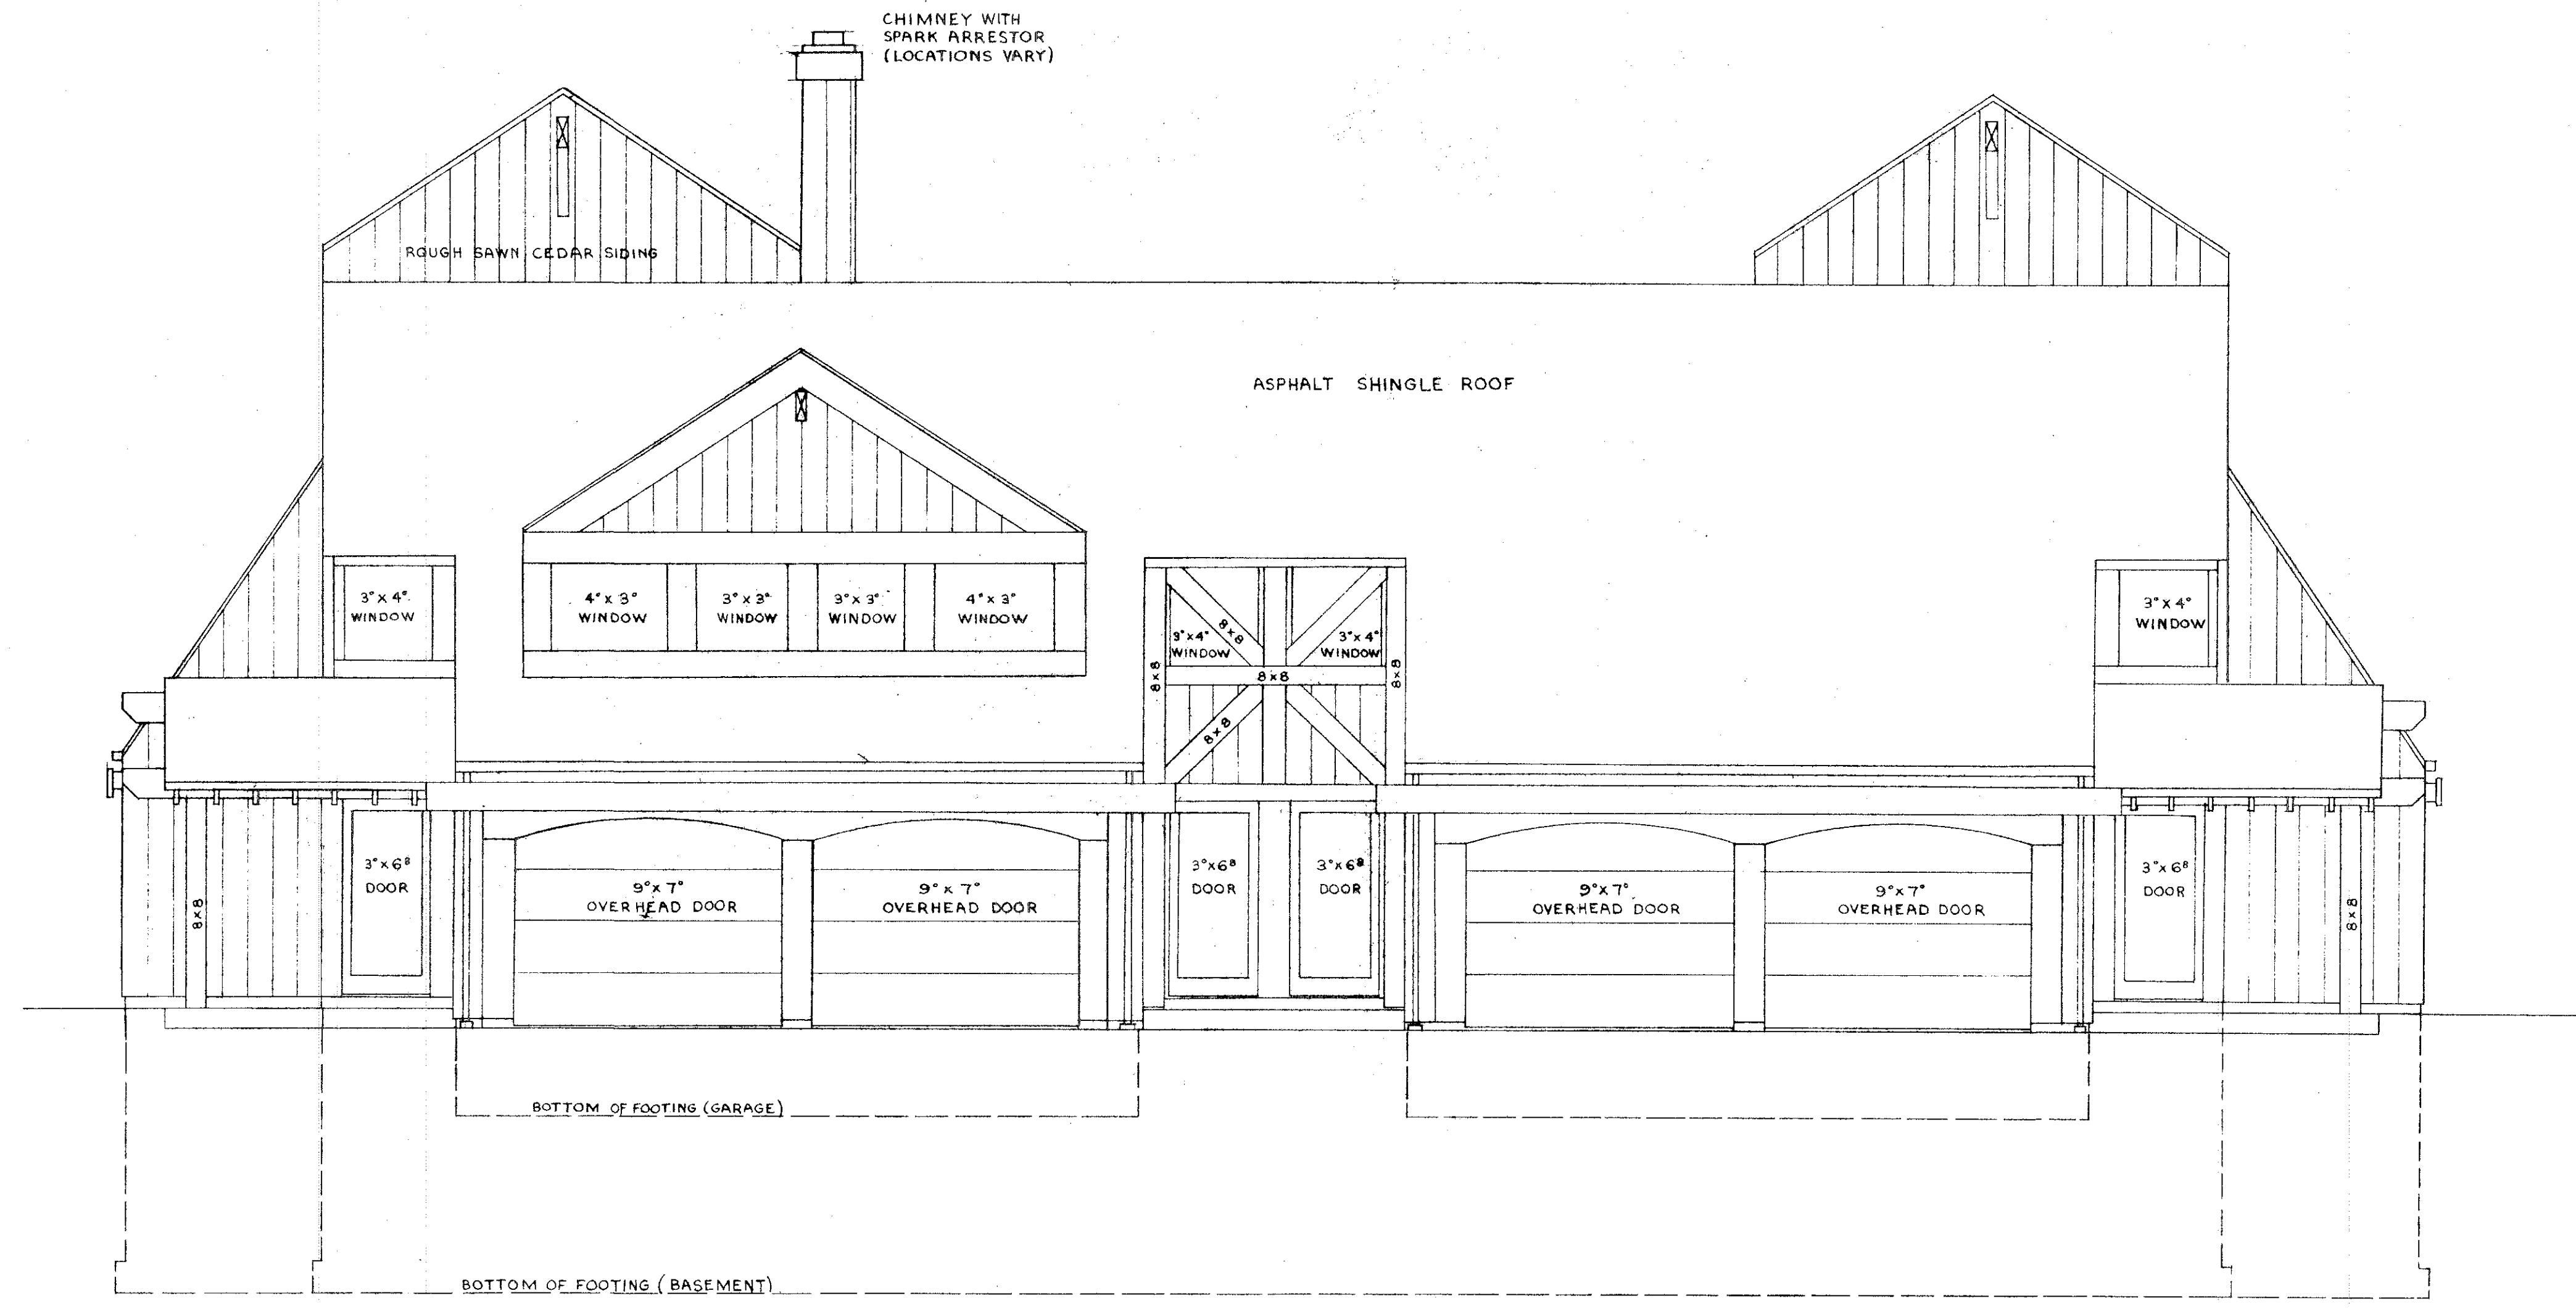


STATEMENT OF CERTIFICATION
 I CERTIFY THAT THE ATTACHED DRAWINGS CORRECTLY REPRESENT THE DIMENSIONS OF THE BUILDINGS AS CONSTRUCTED AND THAT THERE ARE NO ENCROACHMENTS ON ANY ABUTTING PREMISES EXCEPT AS SHOWN.

James H. Schmidt
 JAMES H. SCHMIDT

STATEMENT OF CERTIFICATION
 I CERTIFY THAT THE ATTACHED DRAWINGS CORRECTLY REPRESENT THE DIMENSIONS OF THE BUILDINGS AS CONSTRUCTED.

W. Tabut
 W. TABUT
 REGISTERED ARCHITECT

FRONT ELEVATION
 SCALE: 1" = 4'-0"

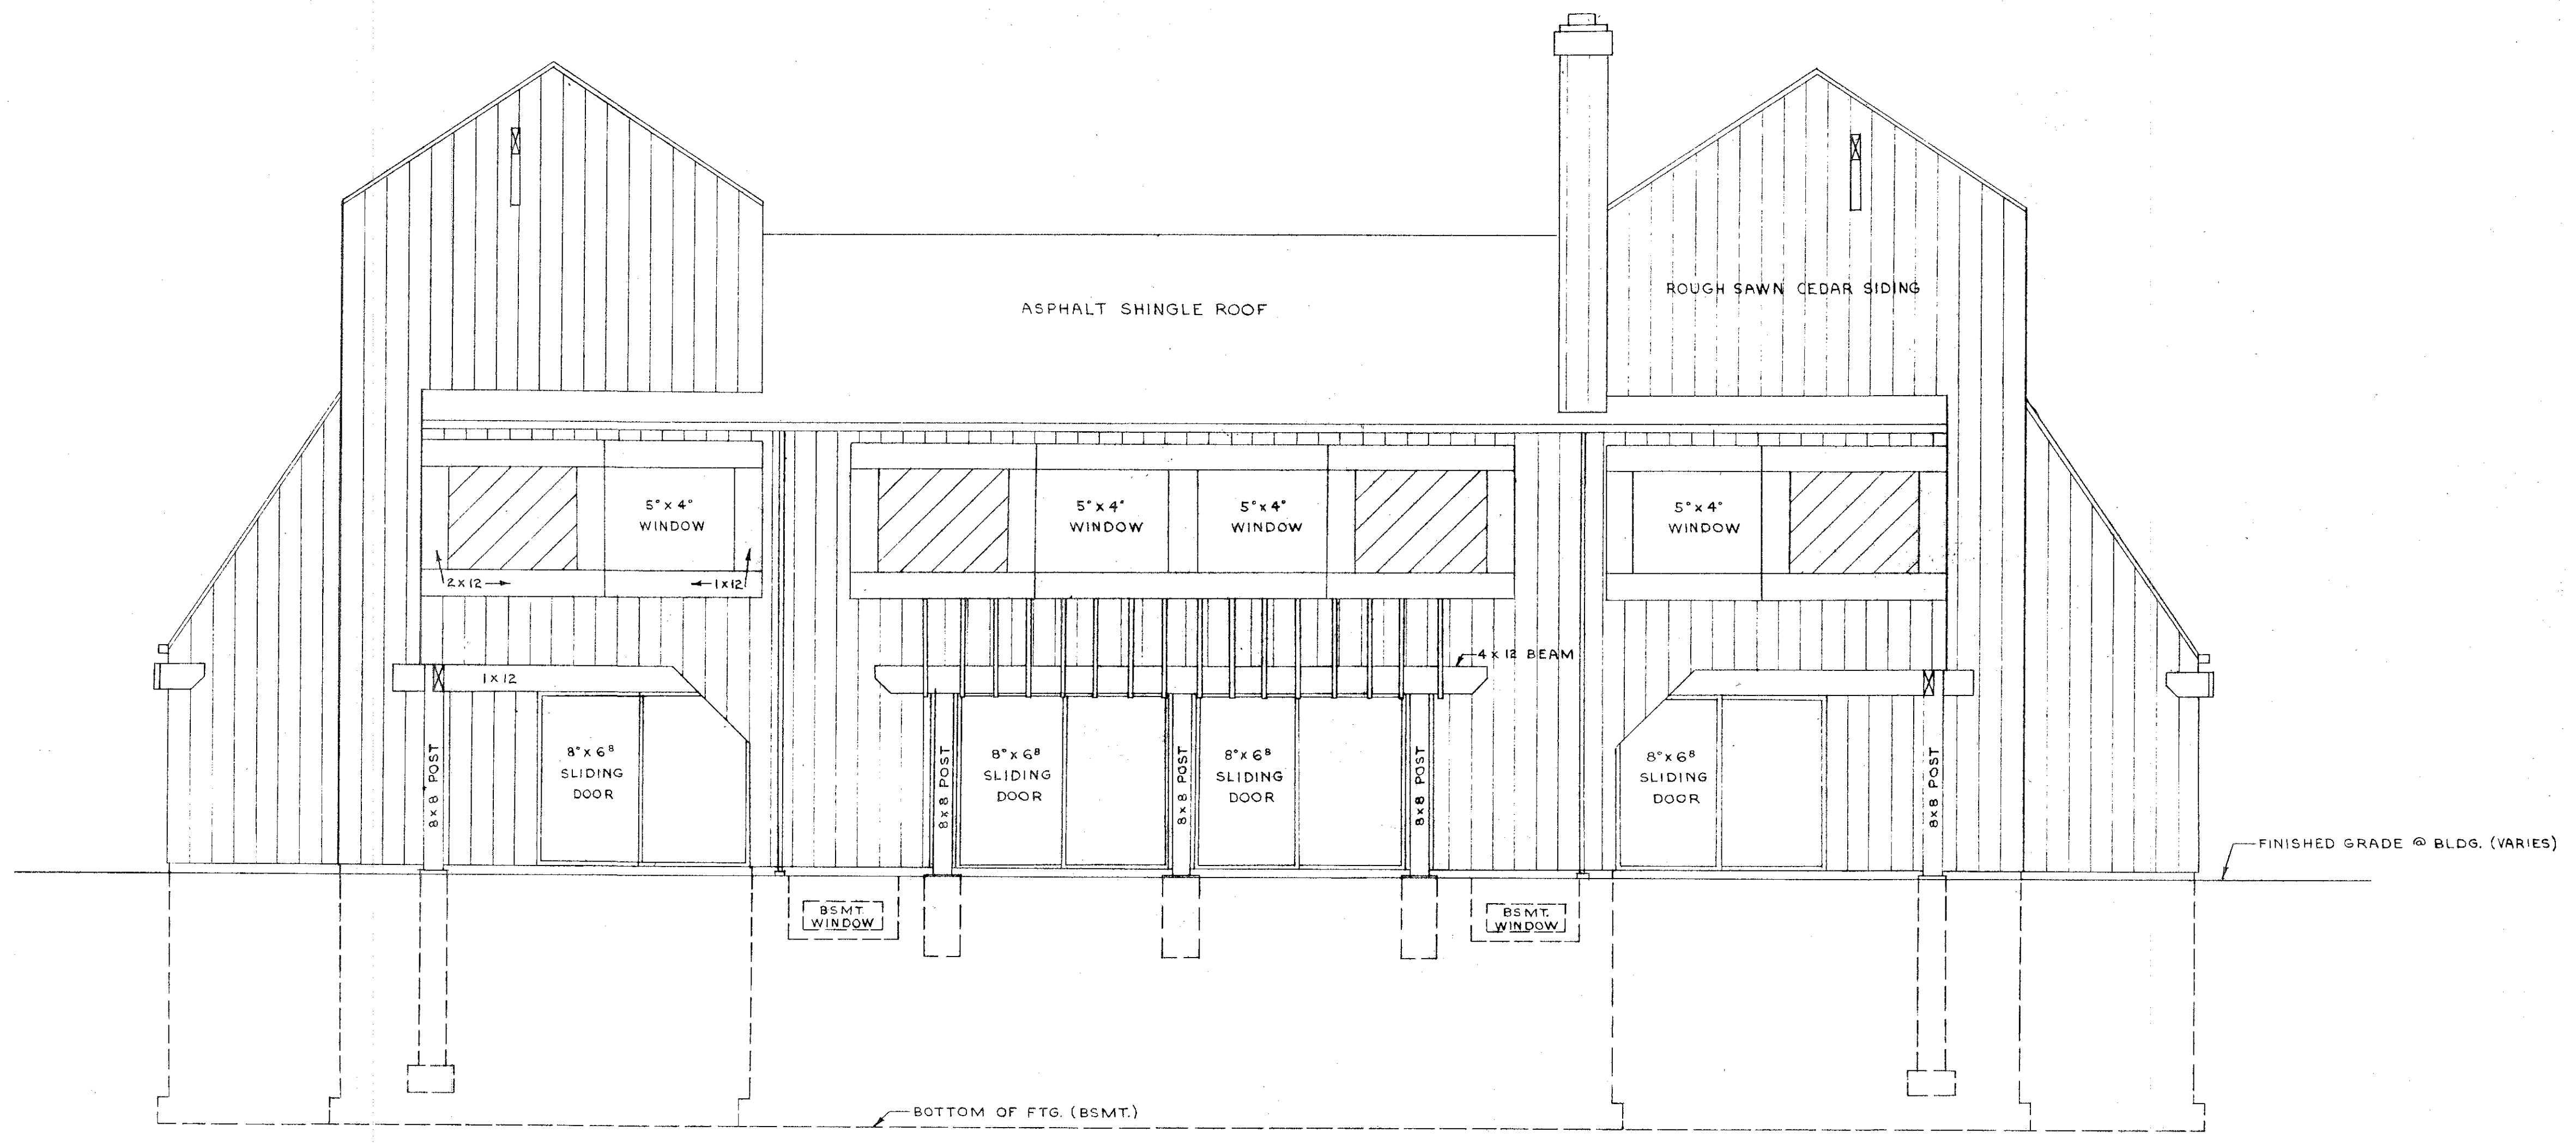


STATEMENT OF CERTIFICATION
 I CERTIFY THAT THE ATTACHED DRAWINGS CORRECTLY REPRESENT THE DIMENSIONS OF THE BUILDINGS AS CONSTRUCTED AND THAT THERE ARE NO ENCROACHMENTS ON ANY ABUTTING PREMISES EXCEPT AS SHOWN.

James H. Schmidt
 JAMES H. SCHMIDT
 REGISTERED SURVEYOR


STATEMENT OF CERTIFICATION
 I CERTIFY THAT THE ATTACHED DRAWINGS CORRECTLY REPRESENT THE DIMENSIONS OF THE BUILDINGS AS CONSTRUCTED.

W. Trout
 W. TROUT
 REGISTERED ARCHITECT

REAR ELEVATION
 SCALE: 1" = 4'0"

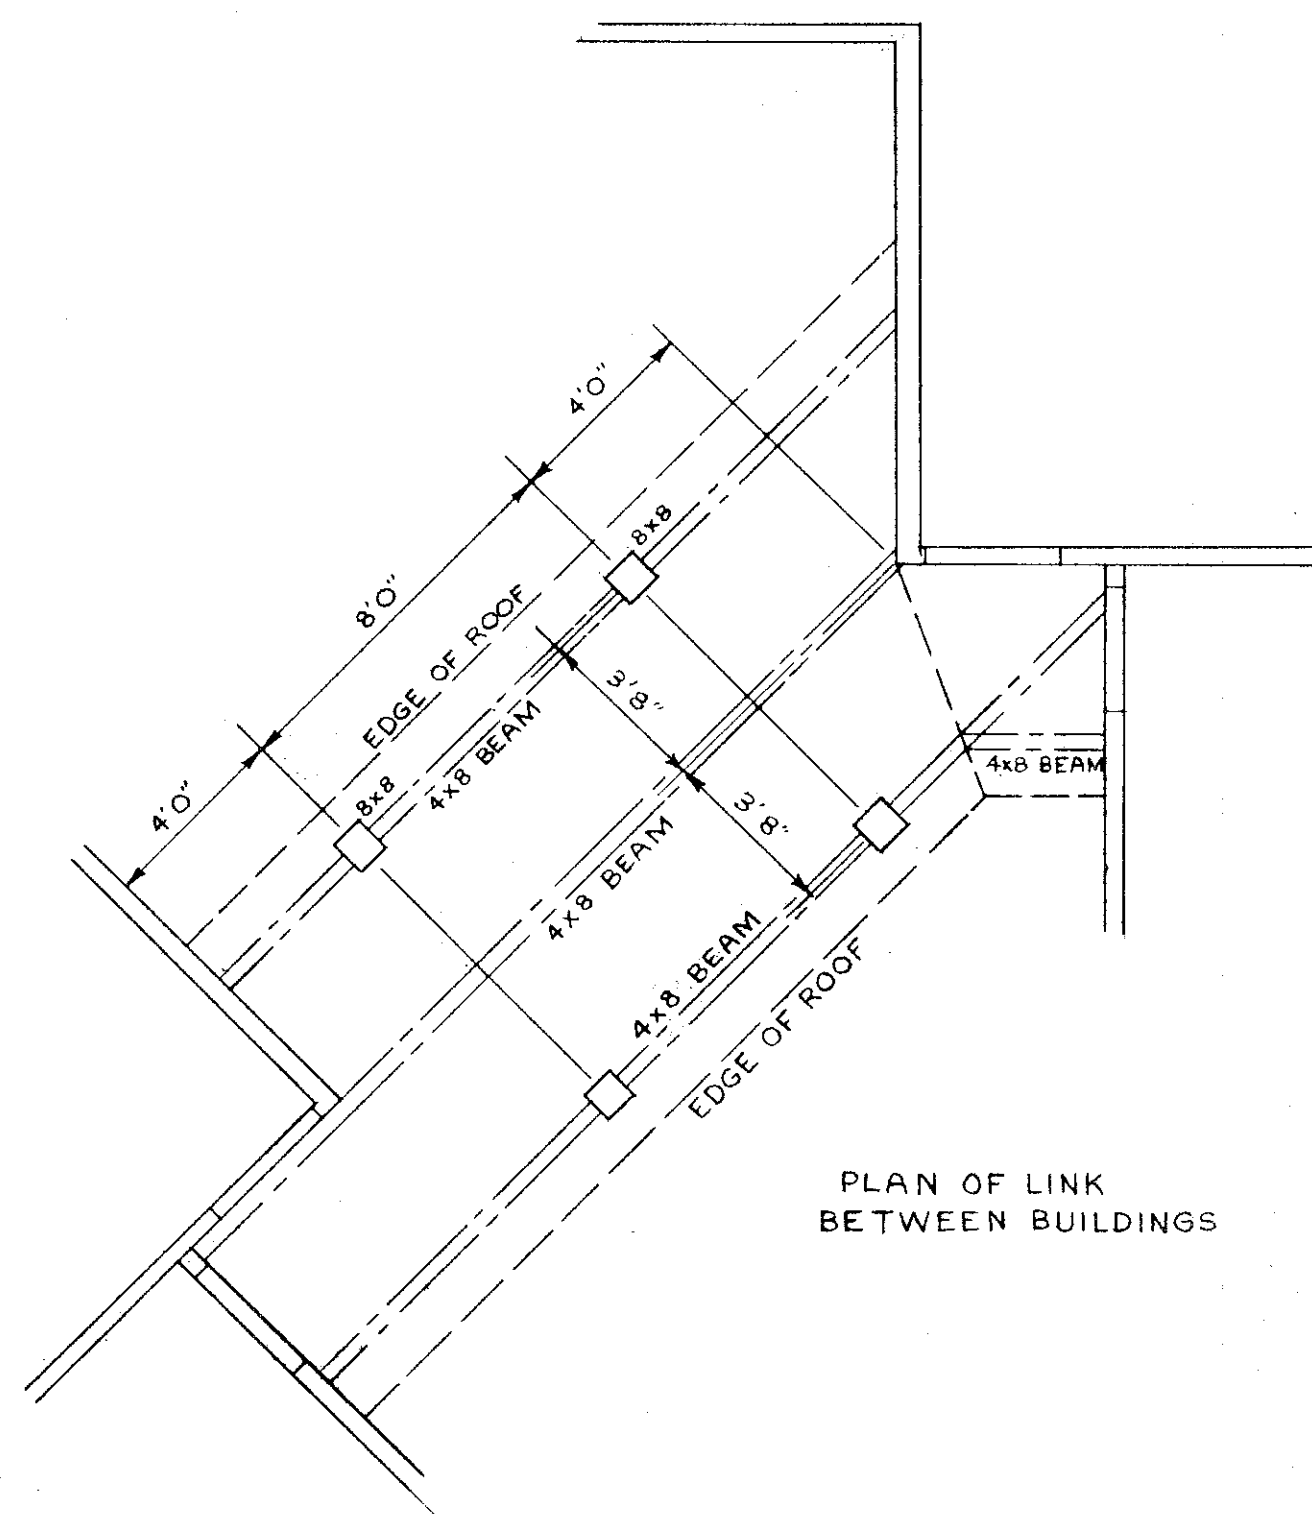

PLAN OF LINK BETWEEN BUILDINGS

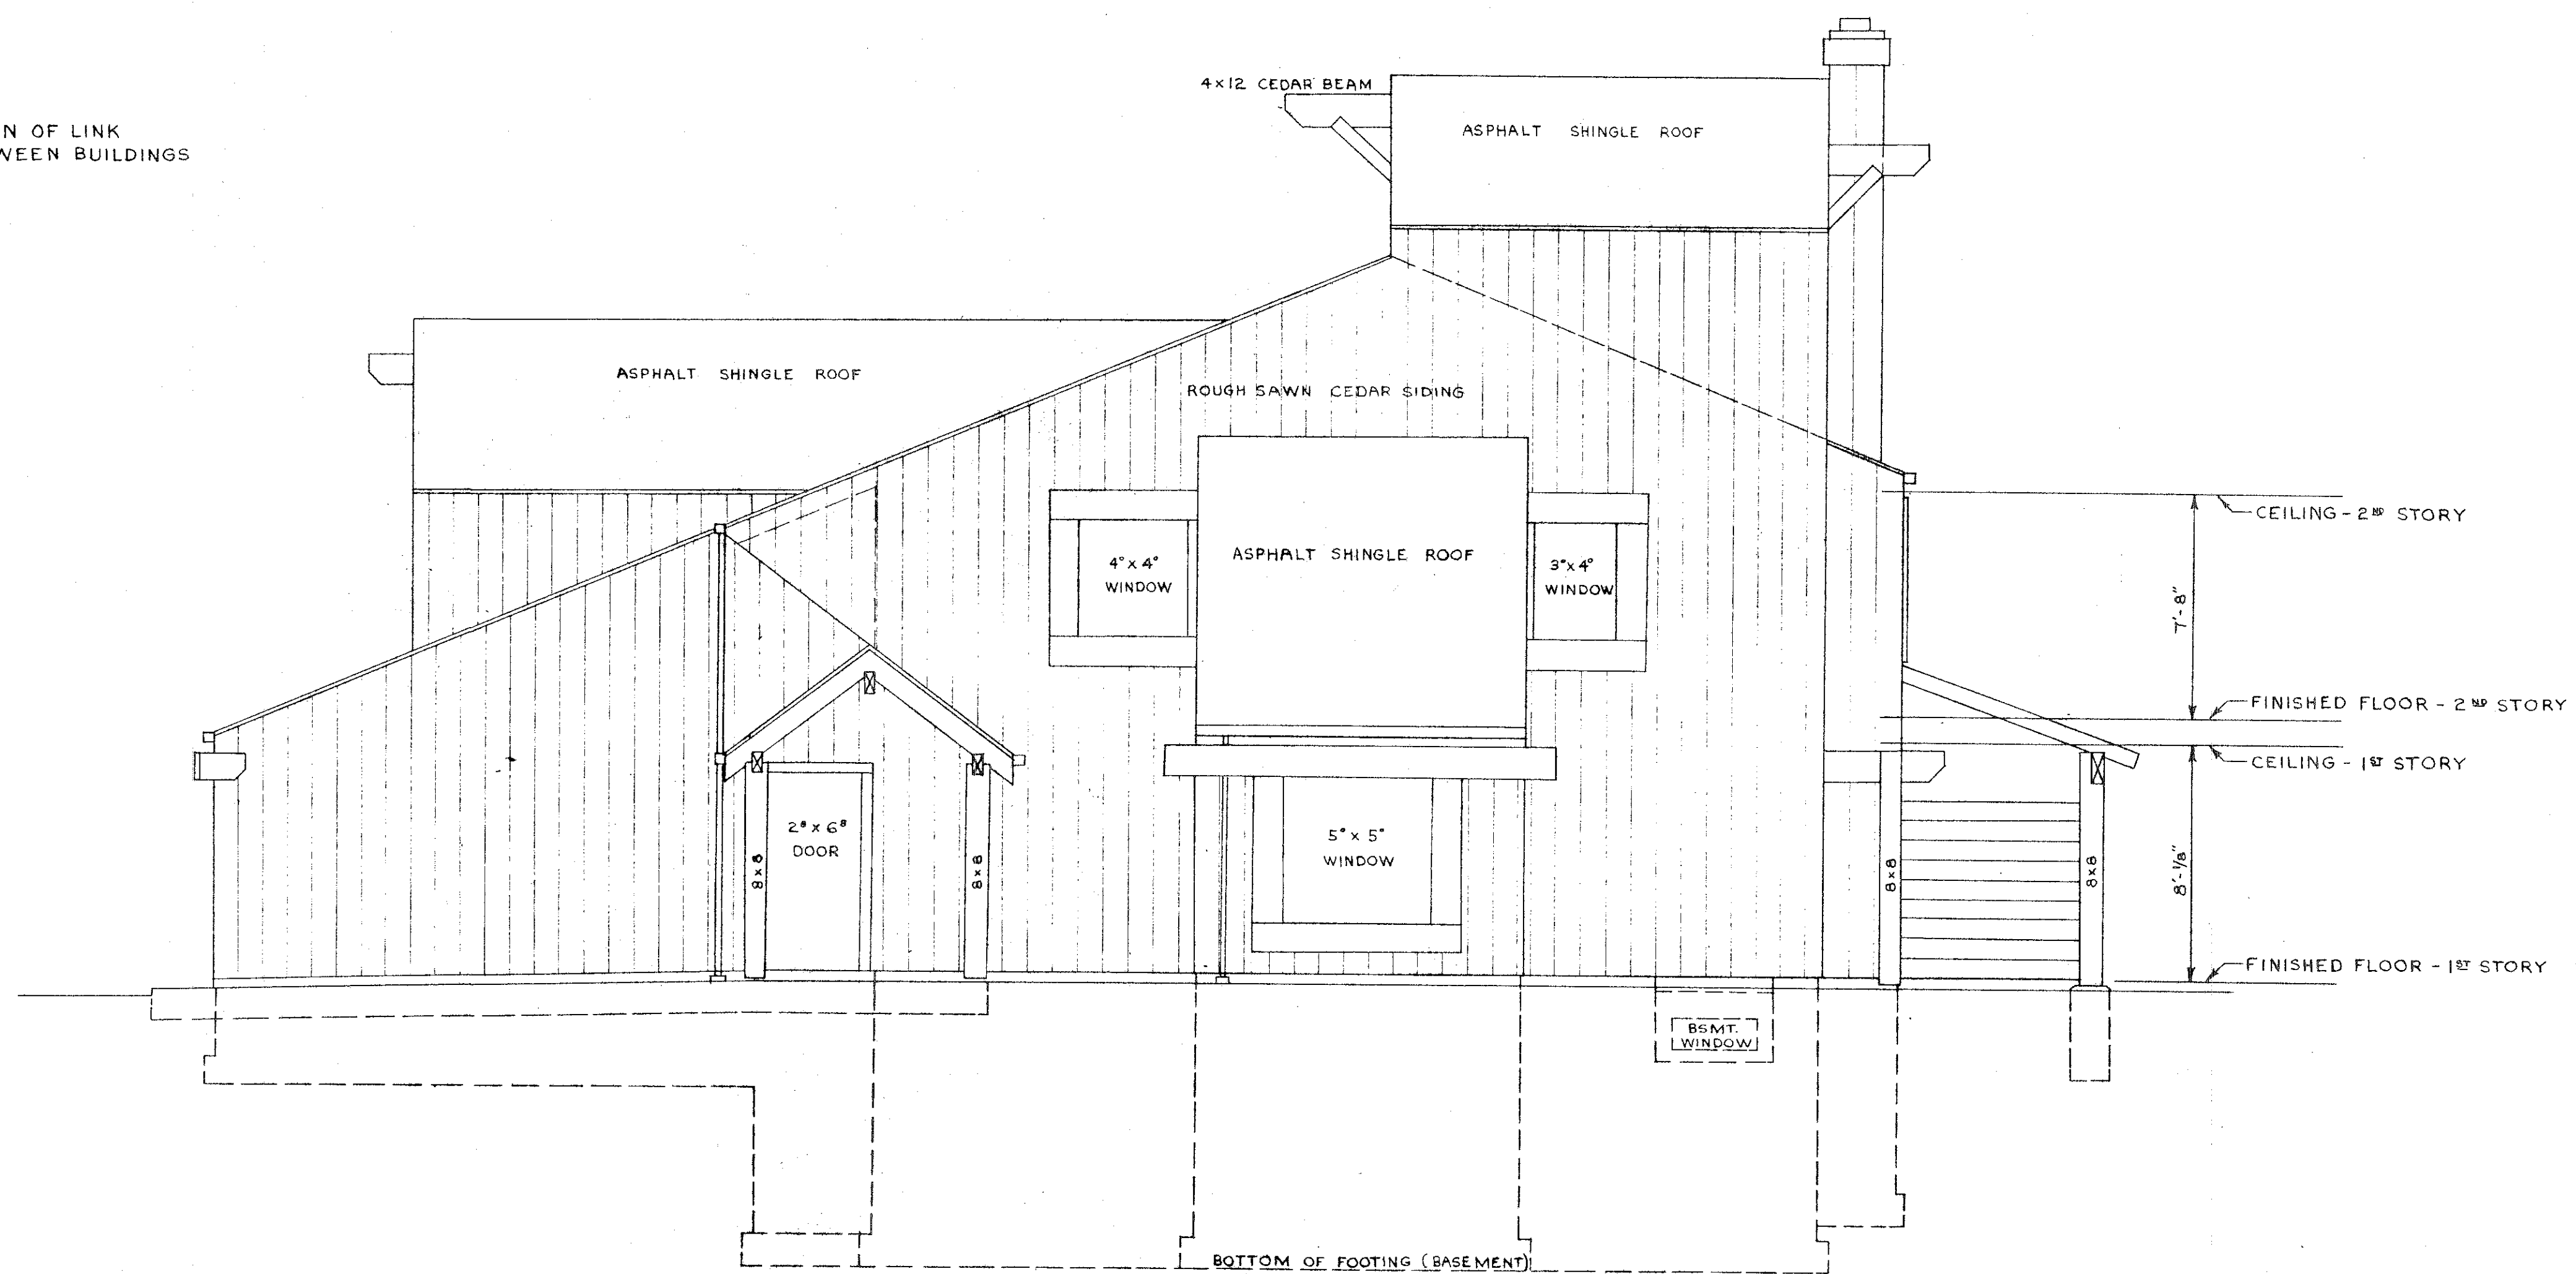


RIGHT SIDE ELEVATION
SCALE: 1" = 4'0"

STATEMENT OF CERTIFICATION
 I CERTIFY THAT THE ATTACHED DRAWINGS CORRECTLY REPRESENT THE DIMENSIONS OF THE BUILDINGS AS CONSTRUCTED AND THAT THERE ARE NO ENCROACHMENTS ON ANY ABUTTING PREMISES EXCEPT AS SHOWN.

James H. Schmidt
 JAMES H. SCHMIDT
 REGISTERED SURVEYOR

STATEMENT OF CERTIFICATION
 I CERTIFY THAT THE ATTACHED DRAWINGS CORRECTLY REPRESENT THE DIMENSIONS OF THE BUILDINGS AS CONSTRUCTED.

W. Trout
 W. TROUT
 REGISTERED ARCHITECT

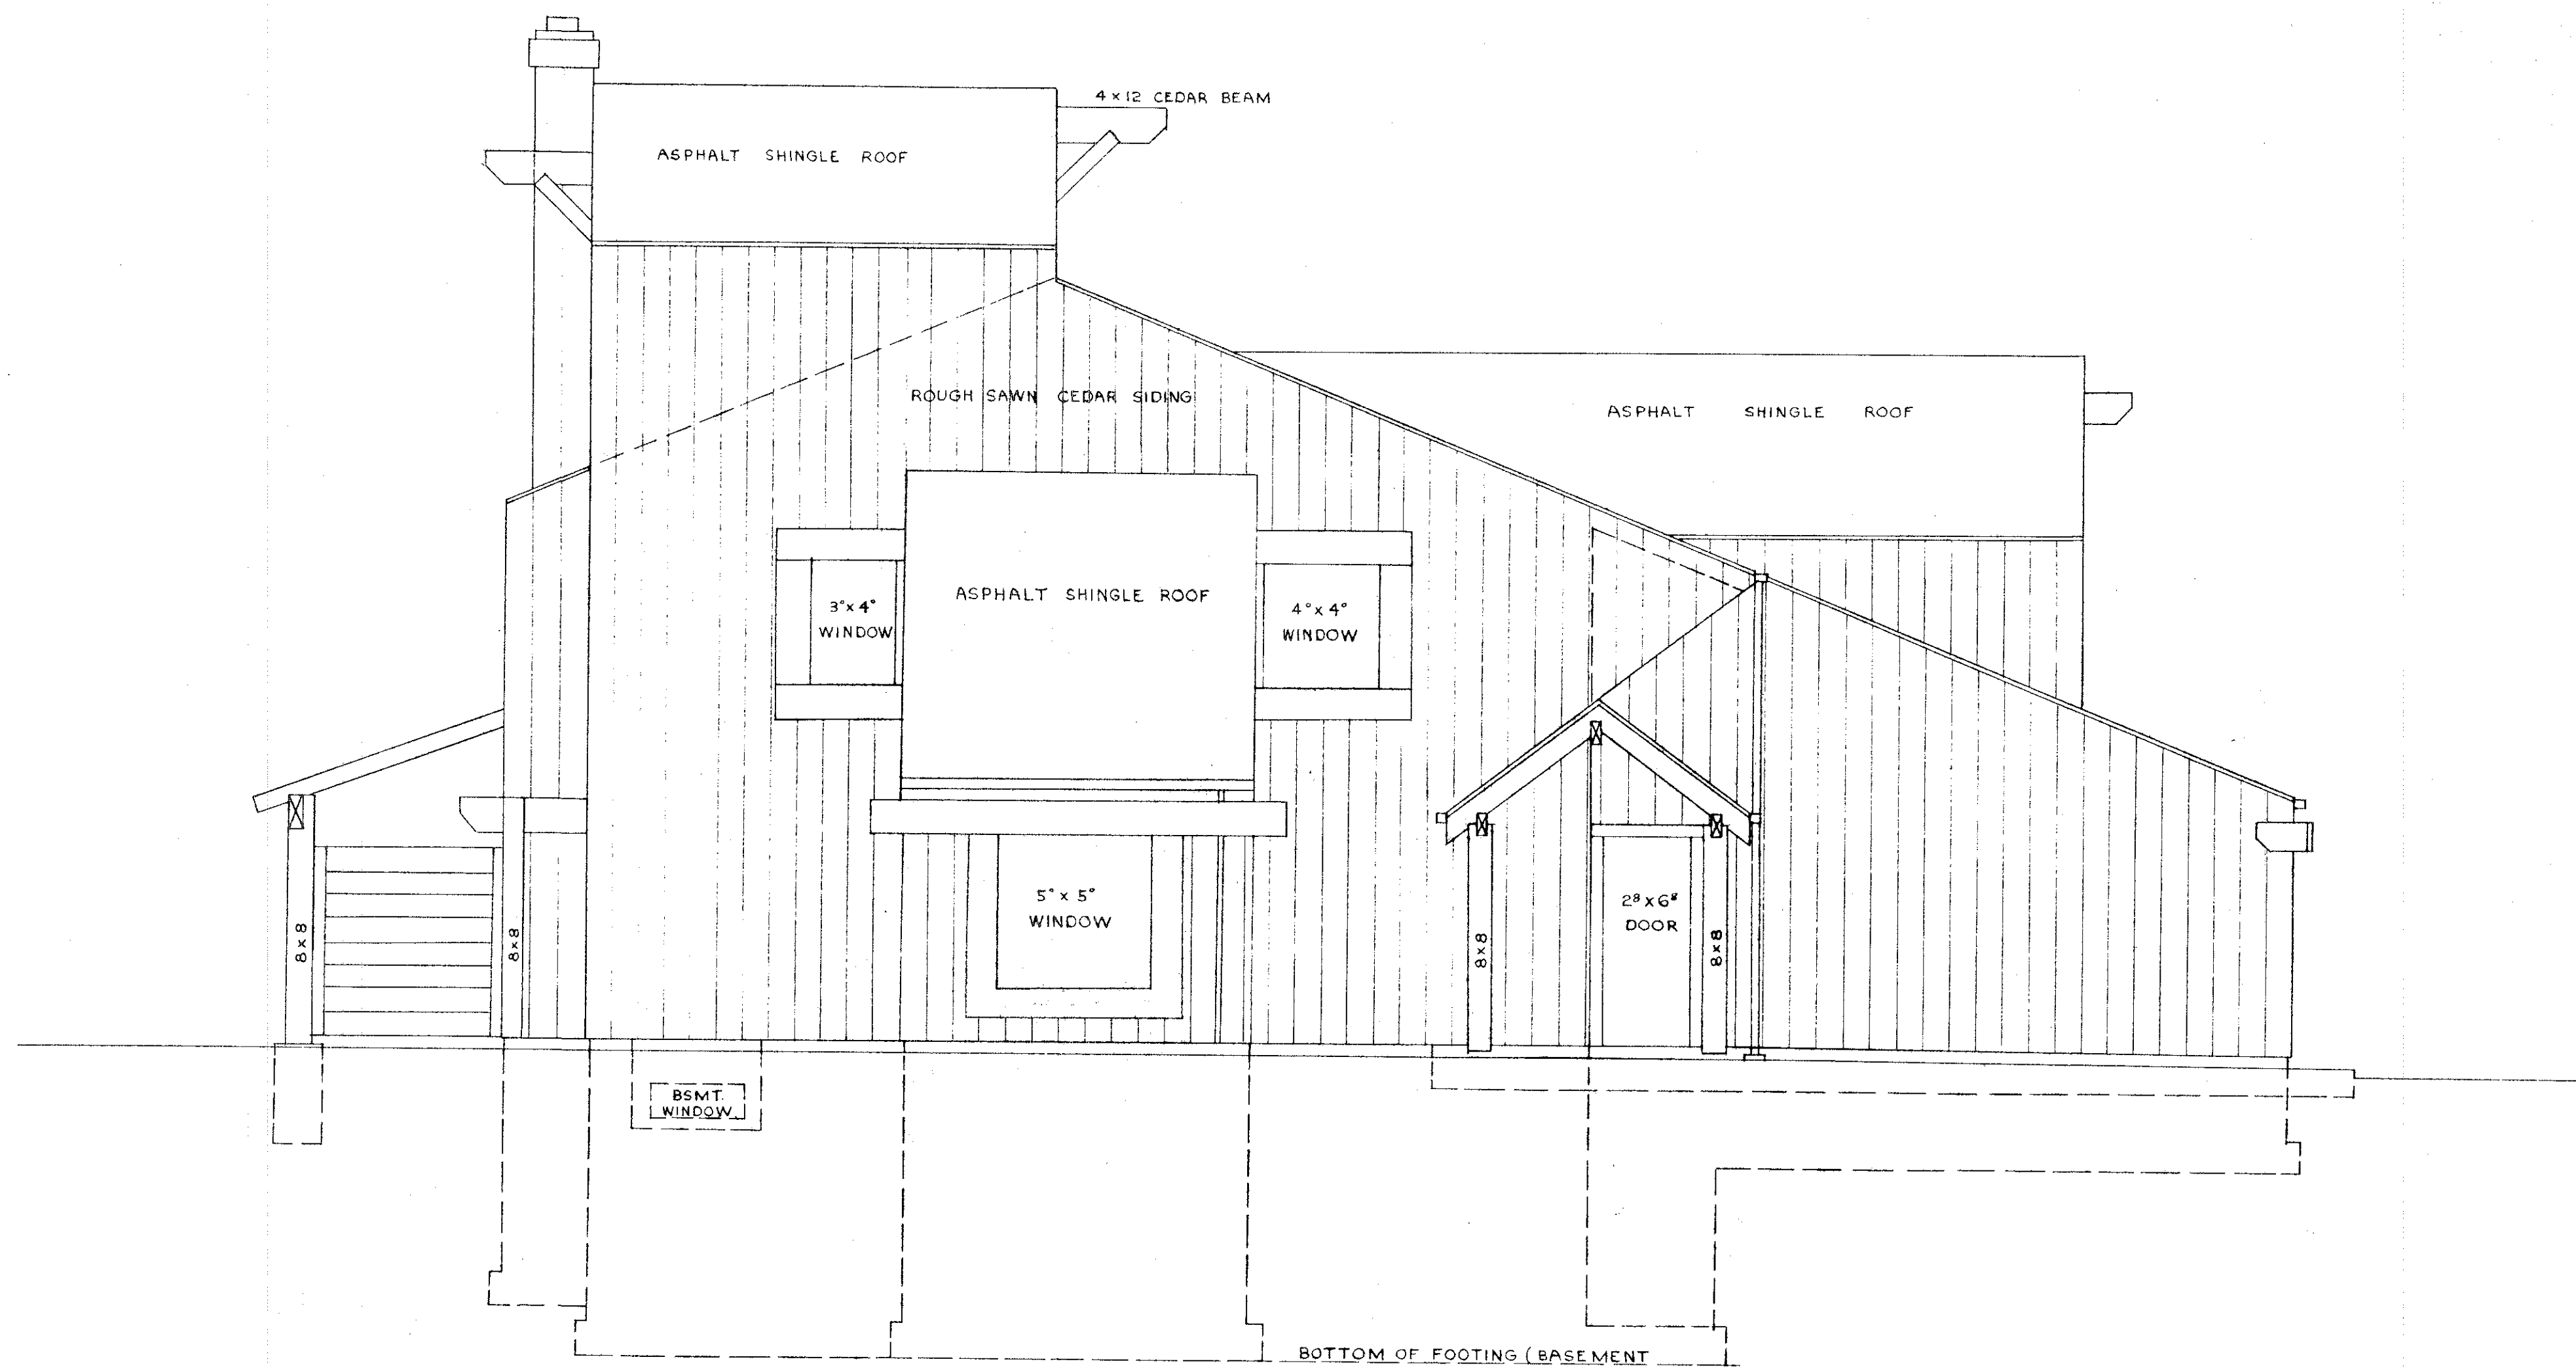


STATEMENT OF CERTIFICATION
 I CERTIFY THAT THE ATTACHED DRAWINGS CORRECTLY REPRESENT THE DIMENSIONS OF THE BUILDINGS AS CONSTRUCTED AND THAT THERE ARE NO ENCROACHMENTS ON ANY ABUTTING PREMISES EXCEPT AS SHOWN.

James H. Schmidt
 JAMES H. SCHMIDT
 REGISTERED SURVEYOR

STATEMENT OF CERTIFICATION
 I CERTIFY THAT THE ATTACHED DRAWINGS CORRECTLY REPRESENT THE DIMENSIONS OF THE BUILDINGS AS CONSTRUCTED.

W. Trout
 W. TROUT
 REGISTERED ARCHITECT

LEFT SIDE ELEVATION
 SCALE: 1" = 4'-0"

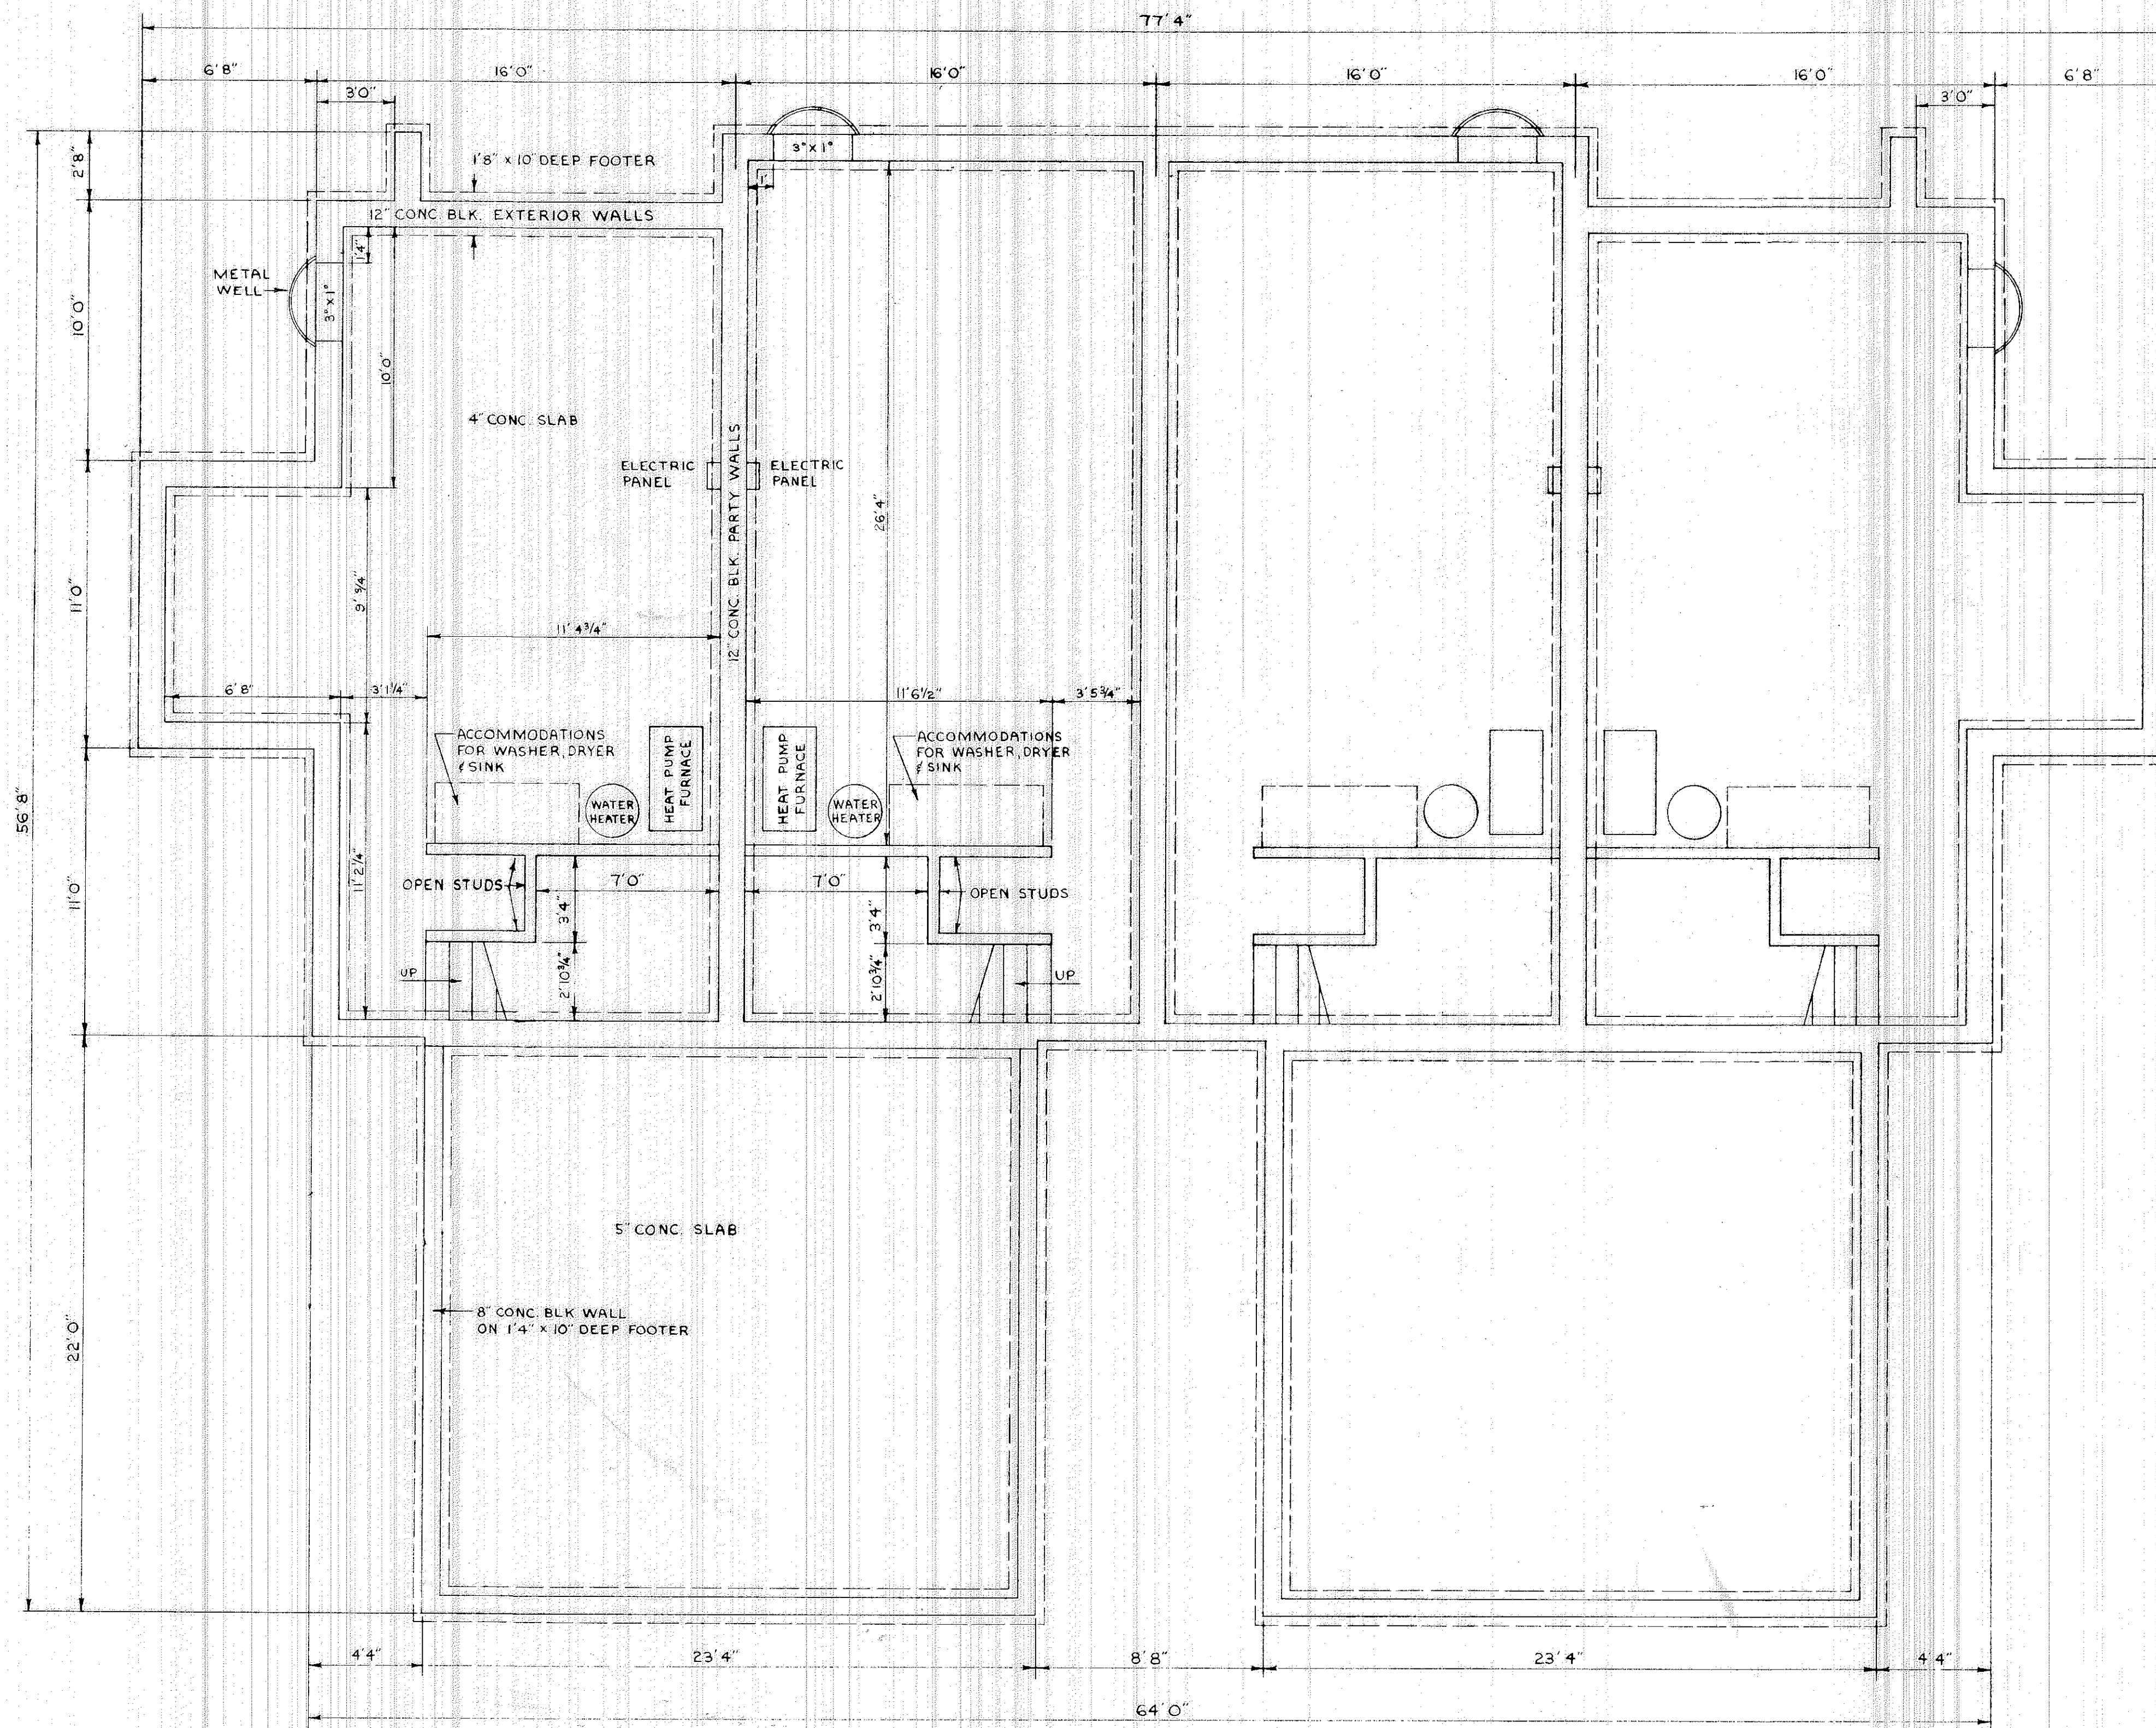


STATEMENT OF CERTIFICATION
 I CERTIFY THAT THE ATTACHED DRAWINGS CORRECTLY REPRESENT THE DIMENSIONS OF THE BUILDINGS AS CONSTRUCTED AND THAT THERE ARE NO ENCRAGEMENTS ON ANY ADJUTING PREMISES EXCEPT AS SHOWN.

James H. Schmidt
 JAMES H. SCHMIDT
 REGISTERED SURVEYOR

STATEMENT OF CERTIFICATION
 I CERTIFY THAT THE ATTACHED DRAWINGS CORRECTLY REPRESENT THE DIMENSIONS OF THE BUILDINGS AS CONSTRUCTED.

W. Trout
 W. TROUT
 REGISTERED ARCHITECT

FOUNDATION & BASEMENT PLAN
 SCALE: 1"=4' 0"

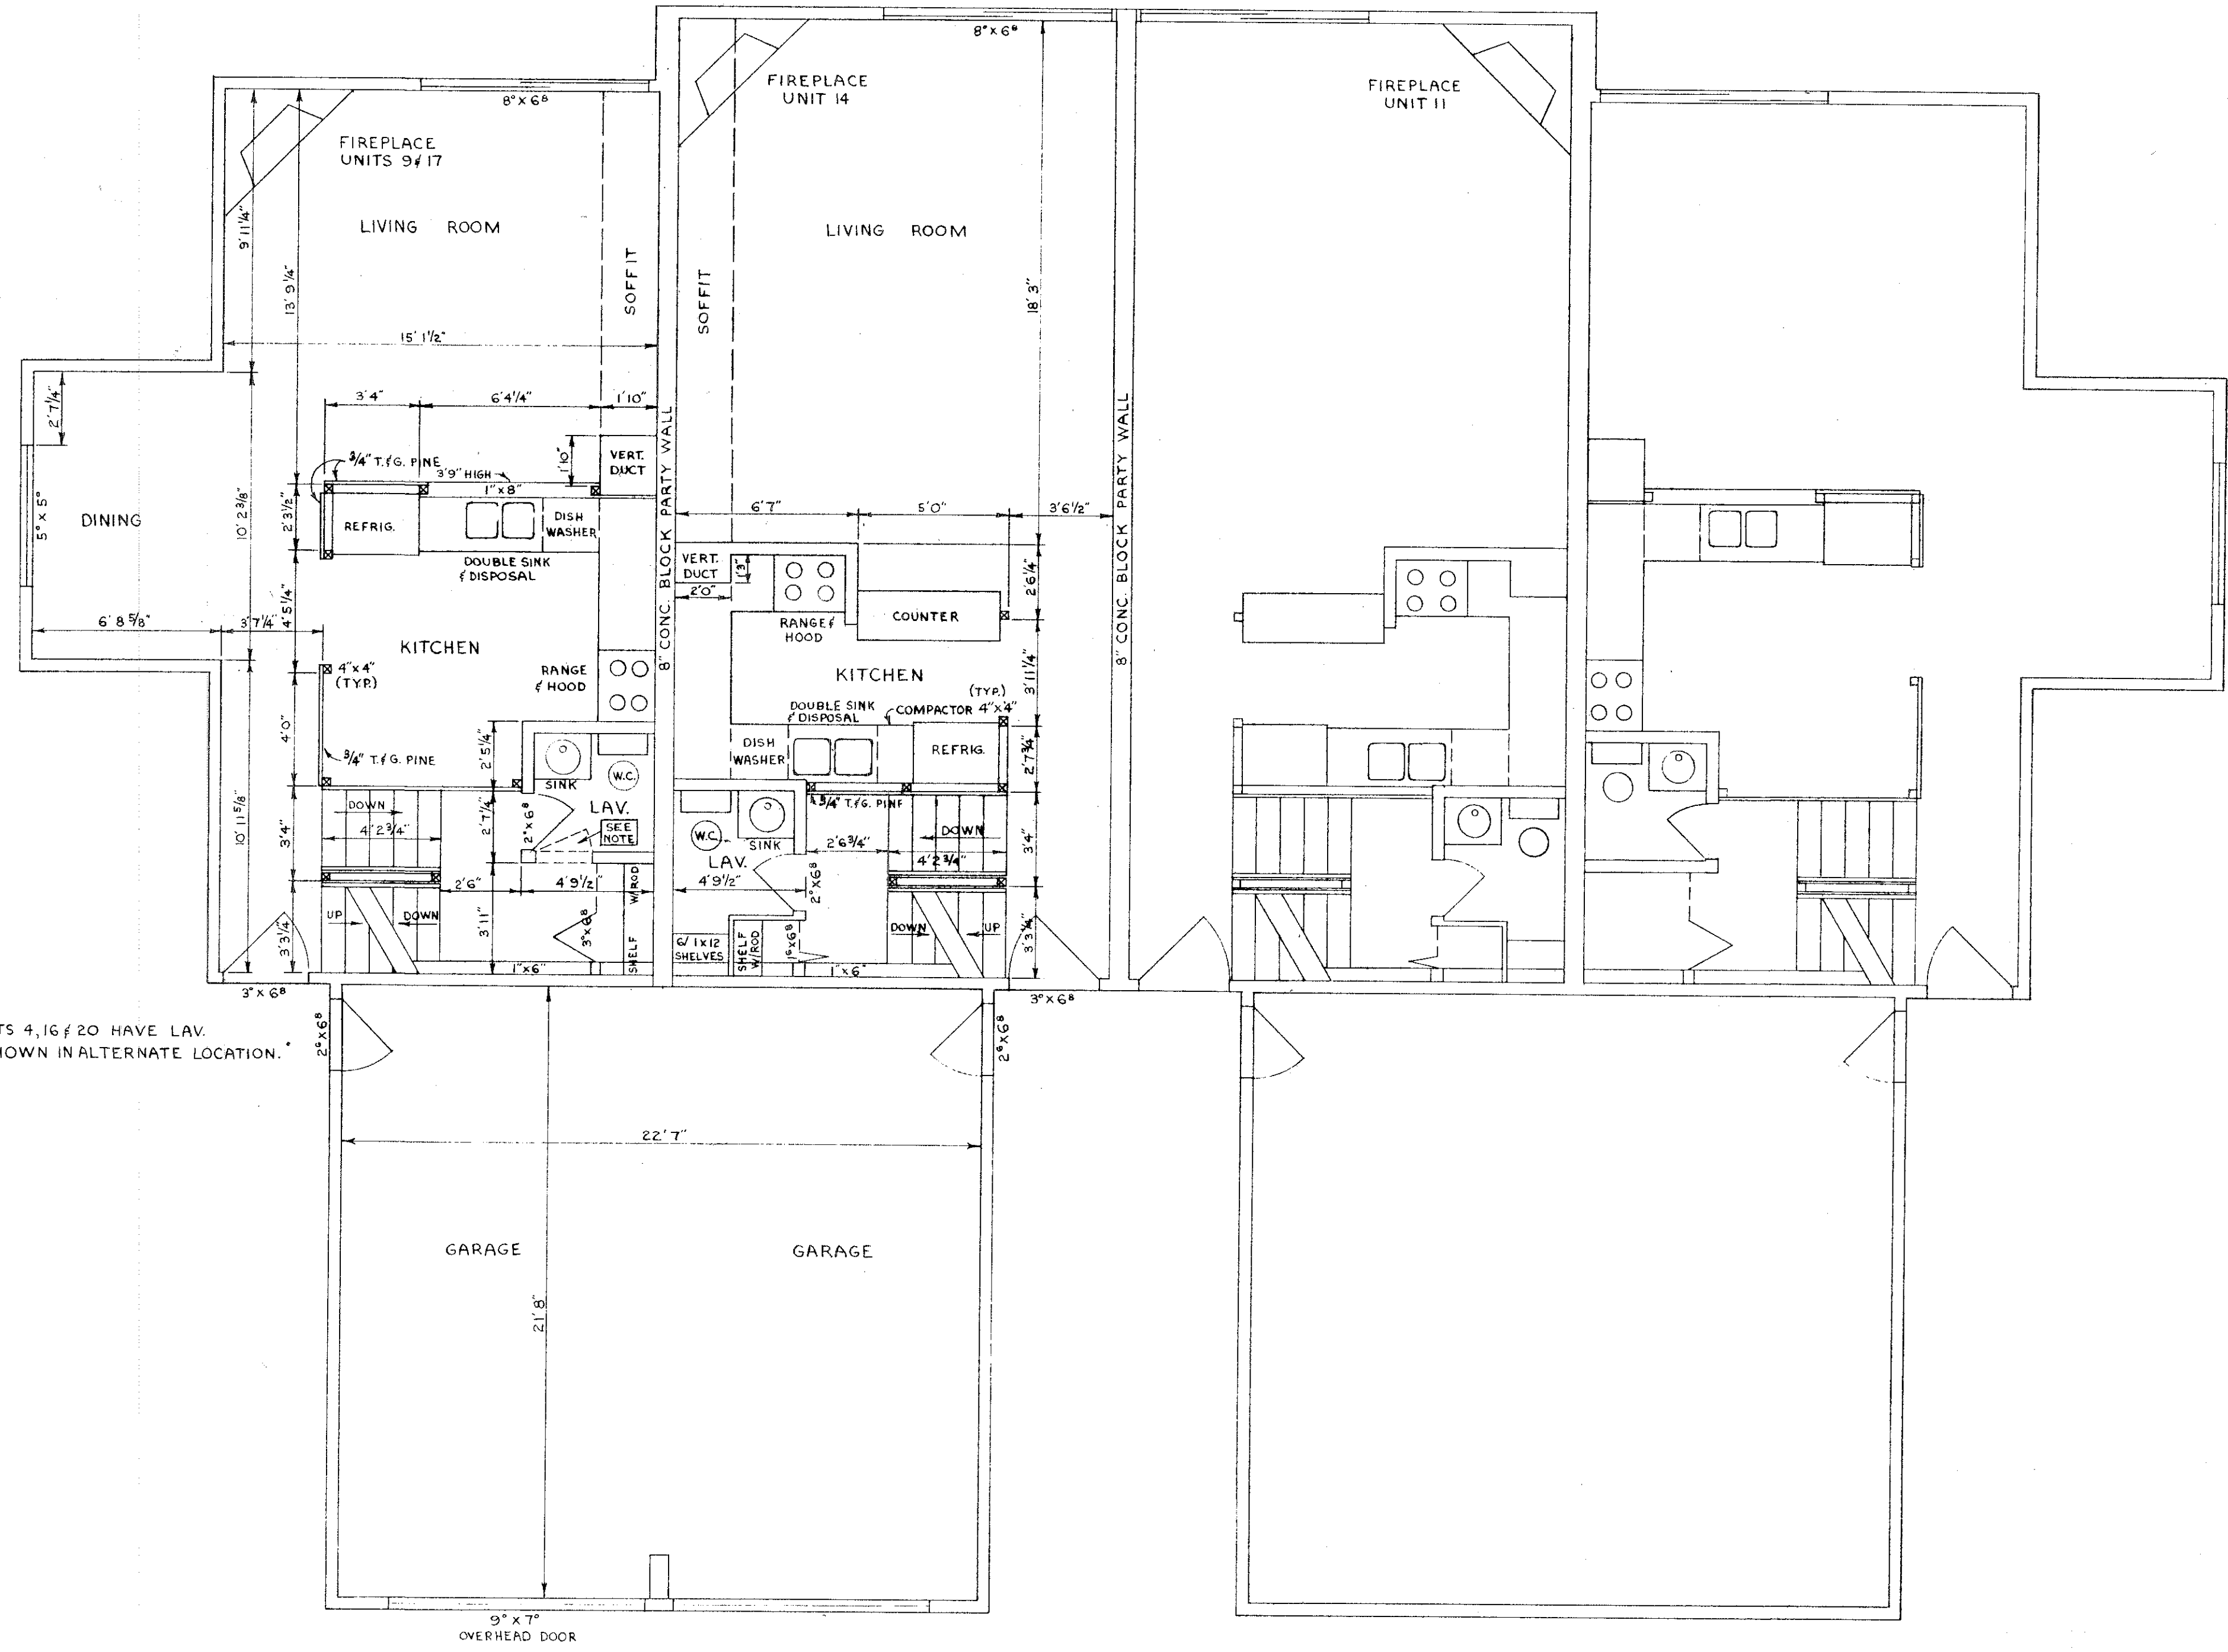

NOTE: UNITS 4, 16 & 20 HAVE LAV. DOOR AS SHOWN IN ALTERNATE LOCATION.


STATEMENT OF CERTIFICATION
 I CERTIFY THAT THE ATTACHED DRAWINGS CORRECTLY REPRESENT THE DIMENSIONS OF THE BUILDINGS AS CONSTRUCTED AND THAT THERE ARE NO ENCROACHMENTS ON ANY ABUTTING PREMISES EXCEPT AS SHOWN.

James H. Schmidt
 JAMES H. SCHMIDT
 REGISTERED SURVEYOR

STATEMENT OF CERTIFICATION
 I CERTIFY THAT THE ATTACHED DRAWING CORRECTLY REPRESENT THE DIMENSIONS OF THE BUILDINGS AS CONSTRUCTED

W. Trout
 W. TROUT
 REGISTERED ARCHITECT

FIRST FLOOR PLAN
 SCALE: 1" = 4' 0"

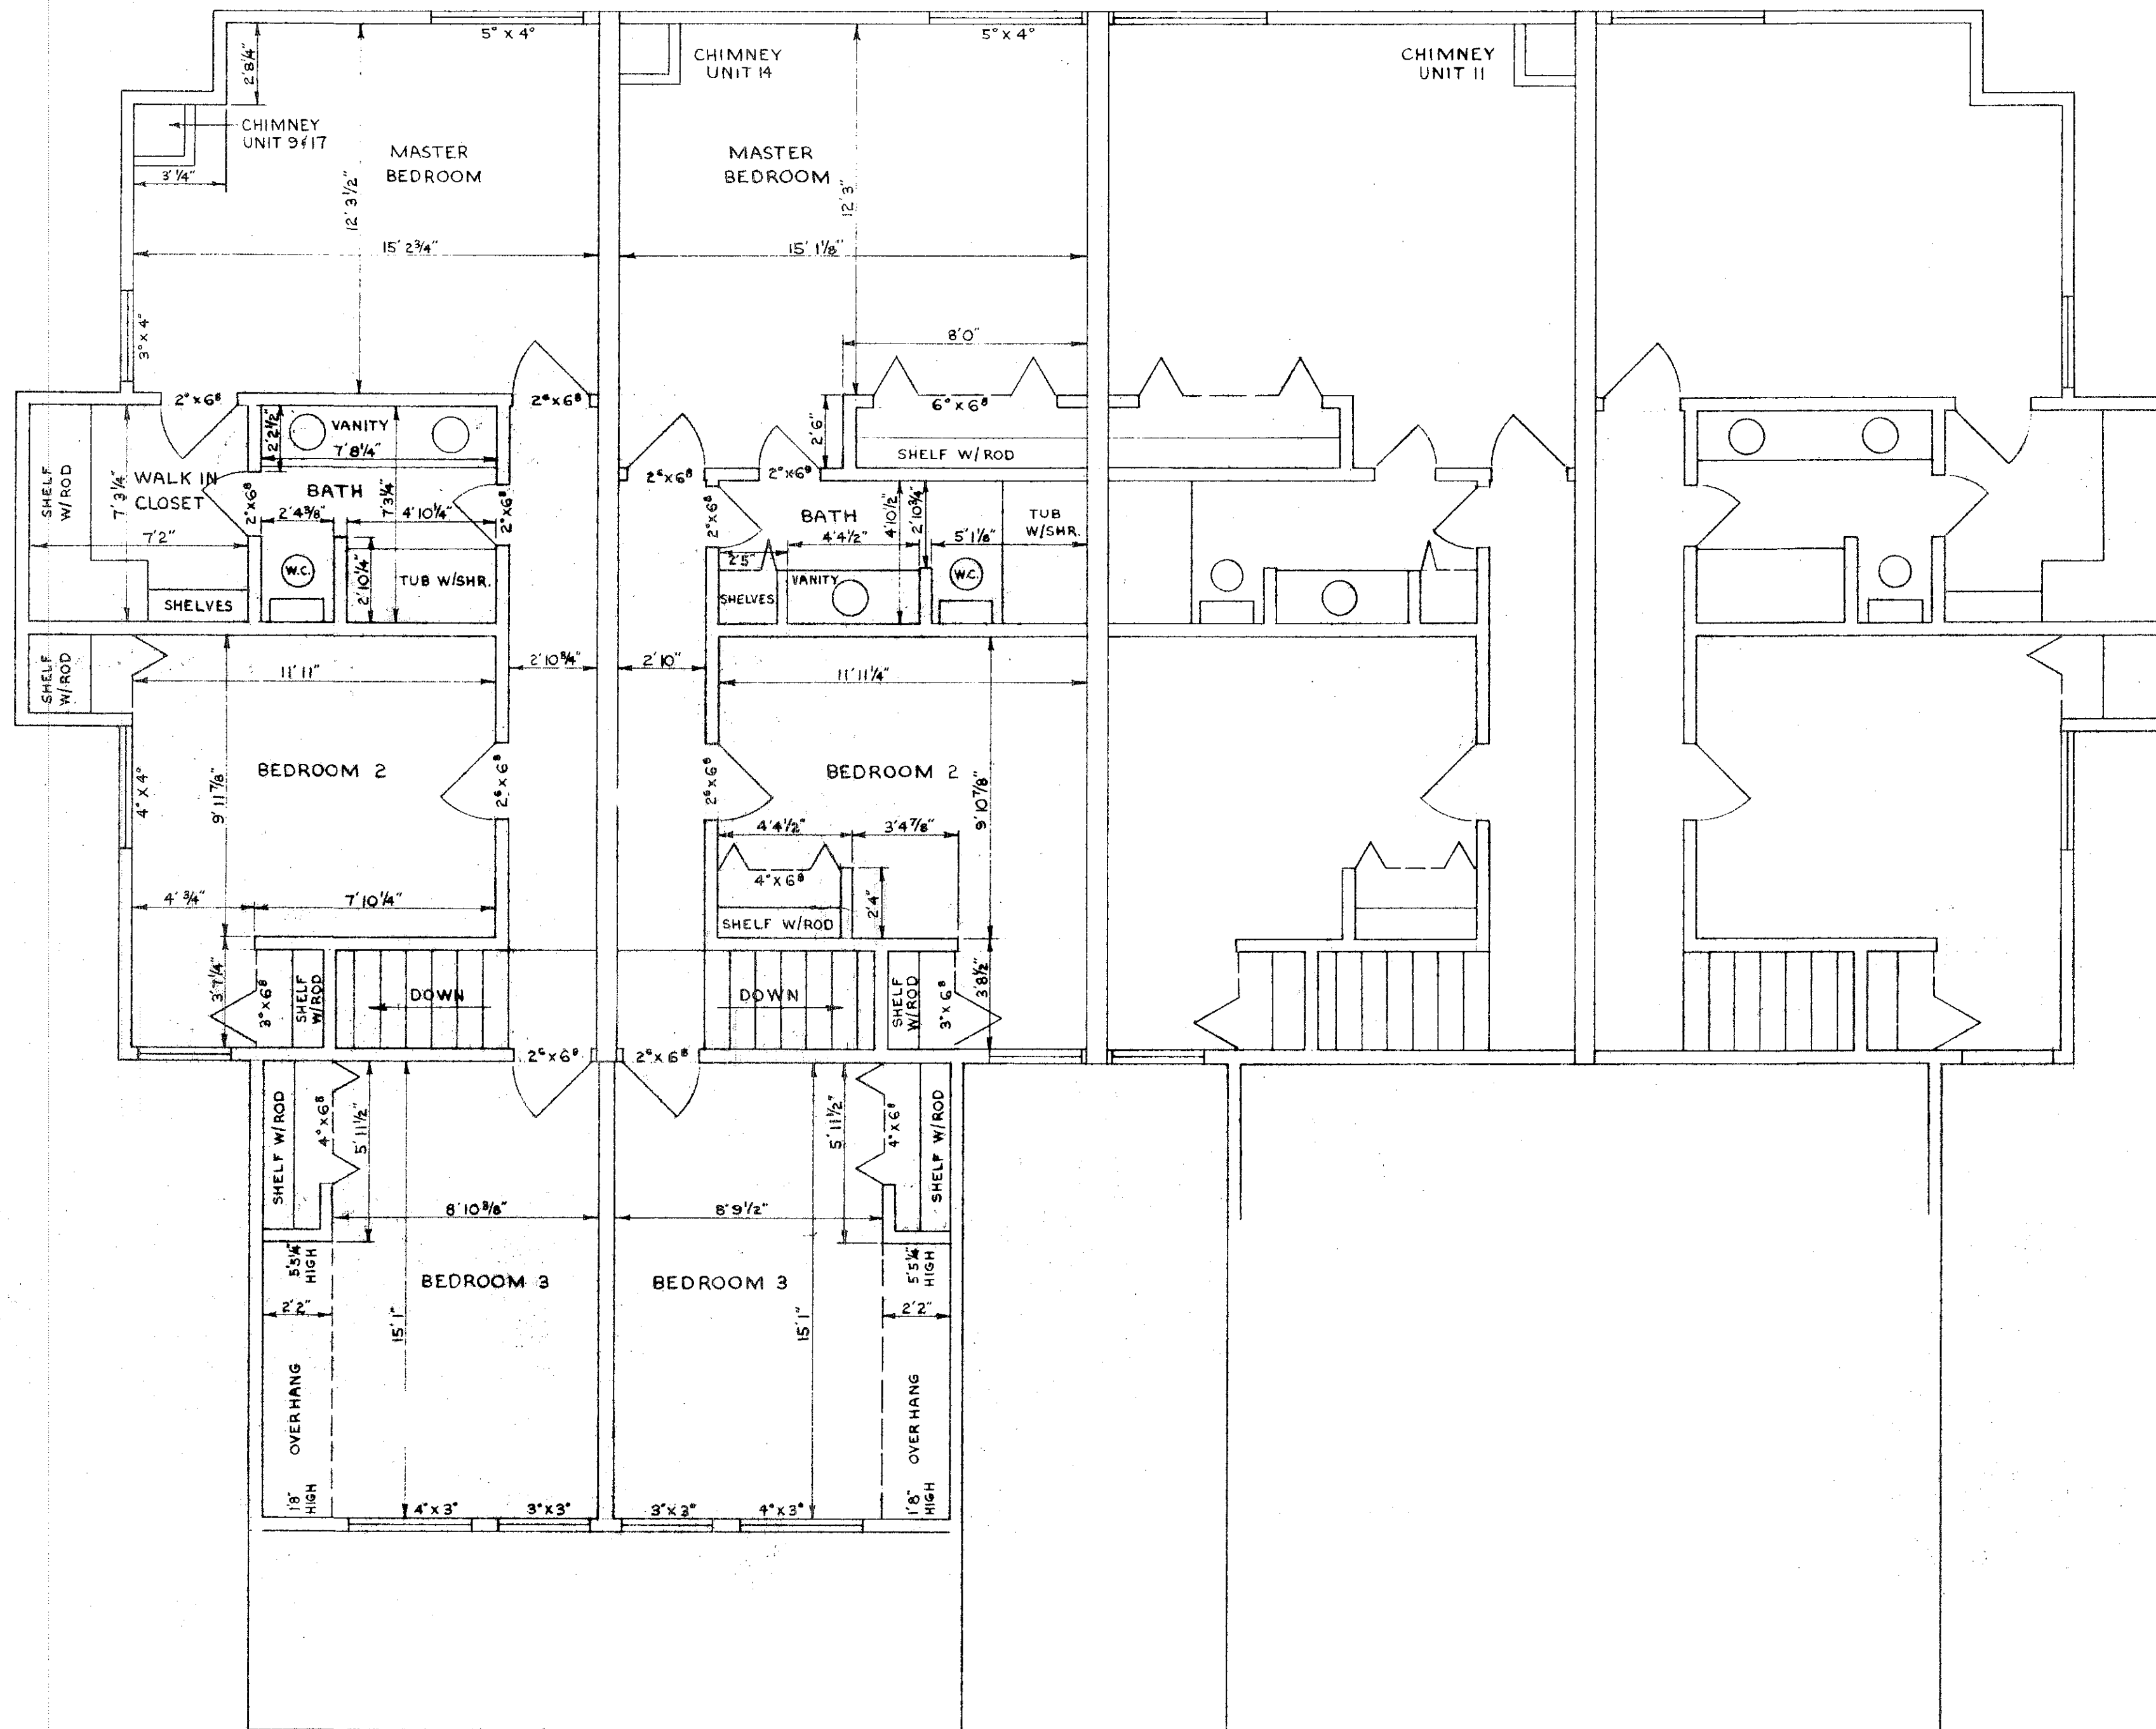

STATEMENT OF CERTIFICATION

I CERTIFY THAT THE ATTACHED DRAWINGS CORRECTLY REPRESENT THE DIMENSIONS OF THE BUILDINGS AS CONSTRUCTED AND THAT THERE ARE NO ENCROACHMENTS ON ANY ABUTTING PREMISES EXCEPT AS SHOWN.

James H. Schmidt
JAMES H. SCHMIDT
REGISTERED SURVEYOR

STATEMENT OF CERTIFICATION

I CERTIFY THAT THE ATTACHED DRAWINGS CORRECTLY REPRESENT THE DIMENSIONS OF THE BUILDINGS AS CONSTRUCTED.

W. Trout
W. TROUT
REGISTERED ARCHITECT

SECOND FLOOR PLAN
SCALE: 1" = 4'0"

UNRECORDED
FEB 20 2017
ALJIAN G. PETER
MURRAY COUNTY SHERIFF