


957661

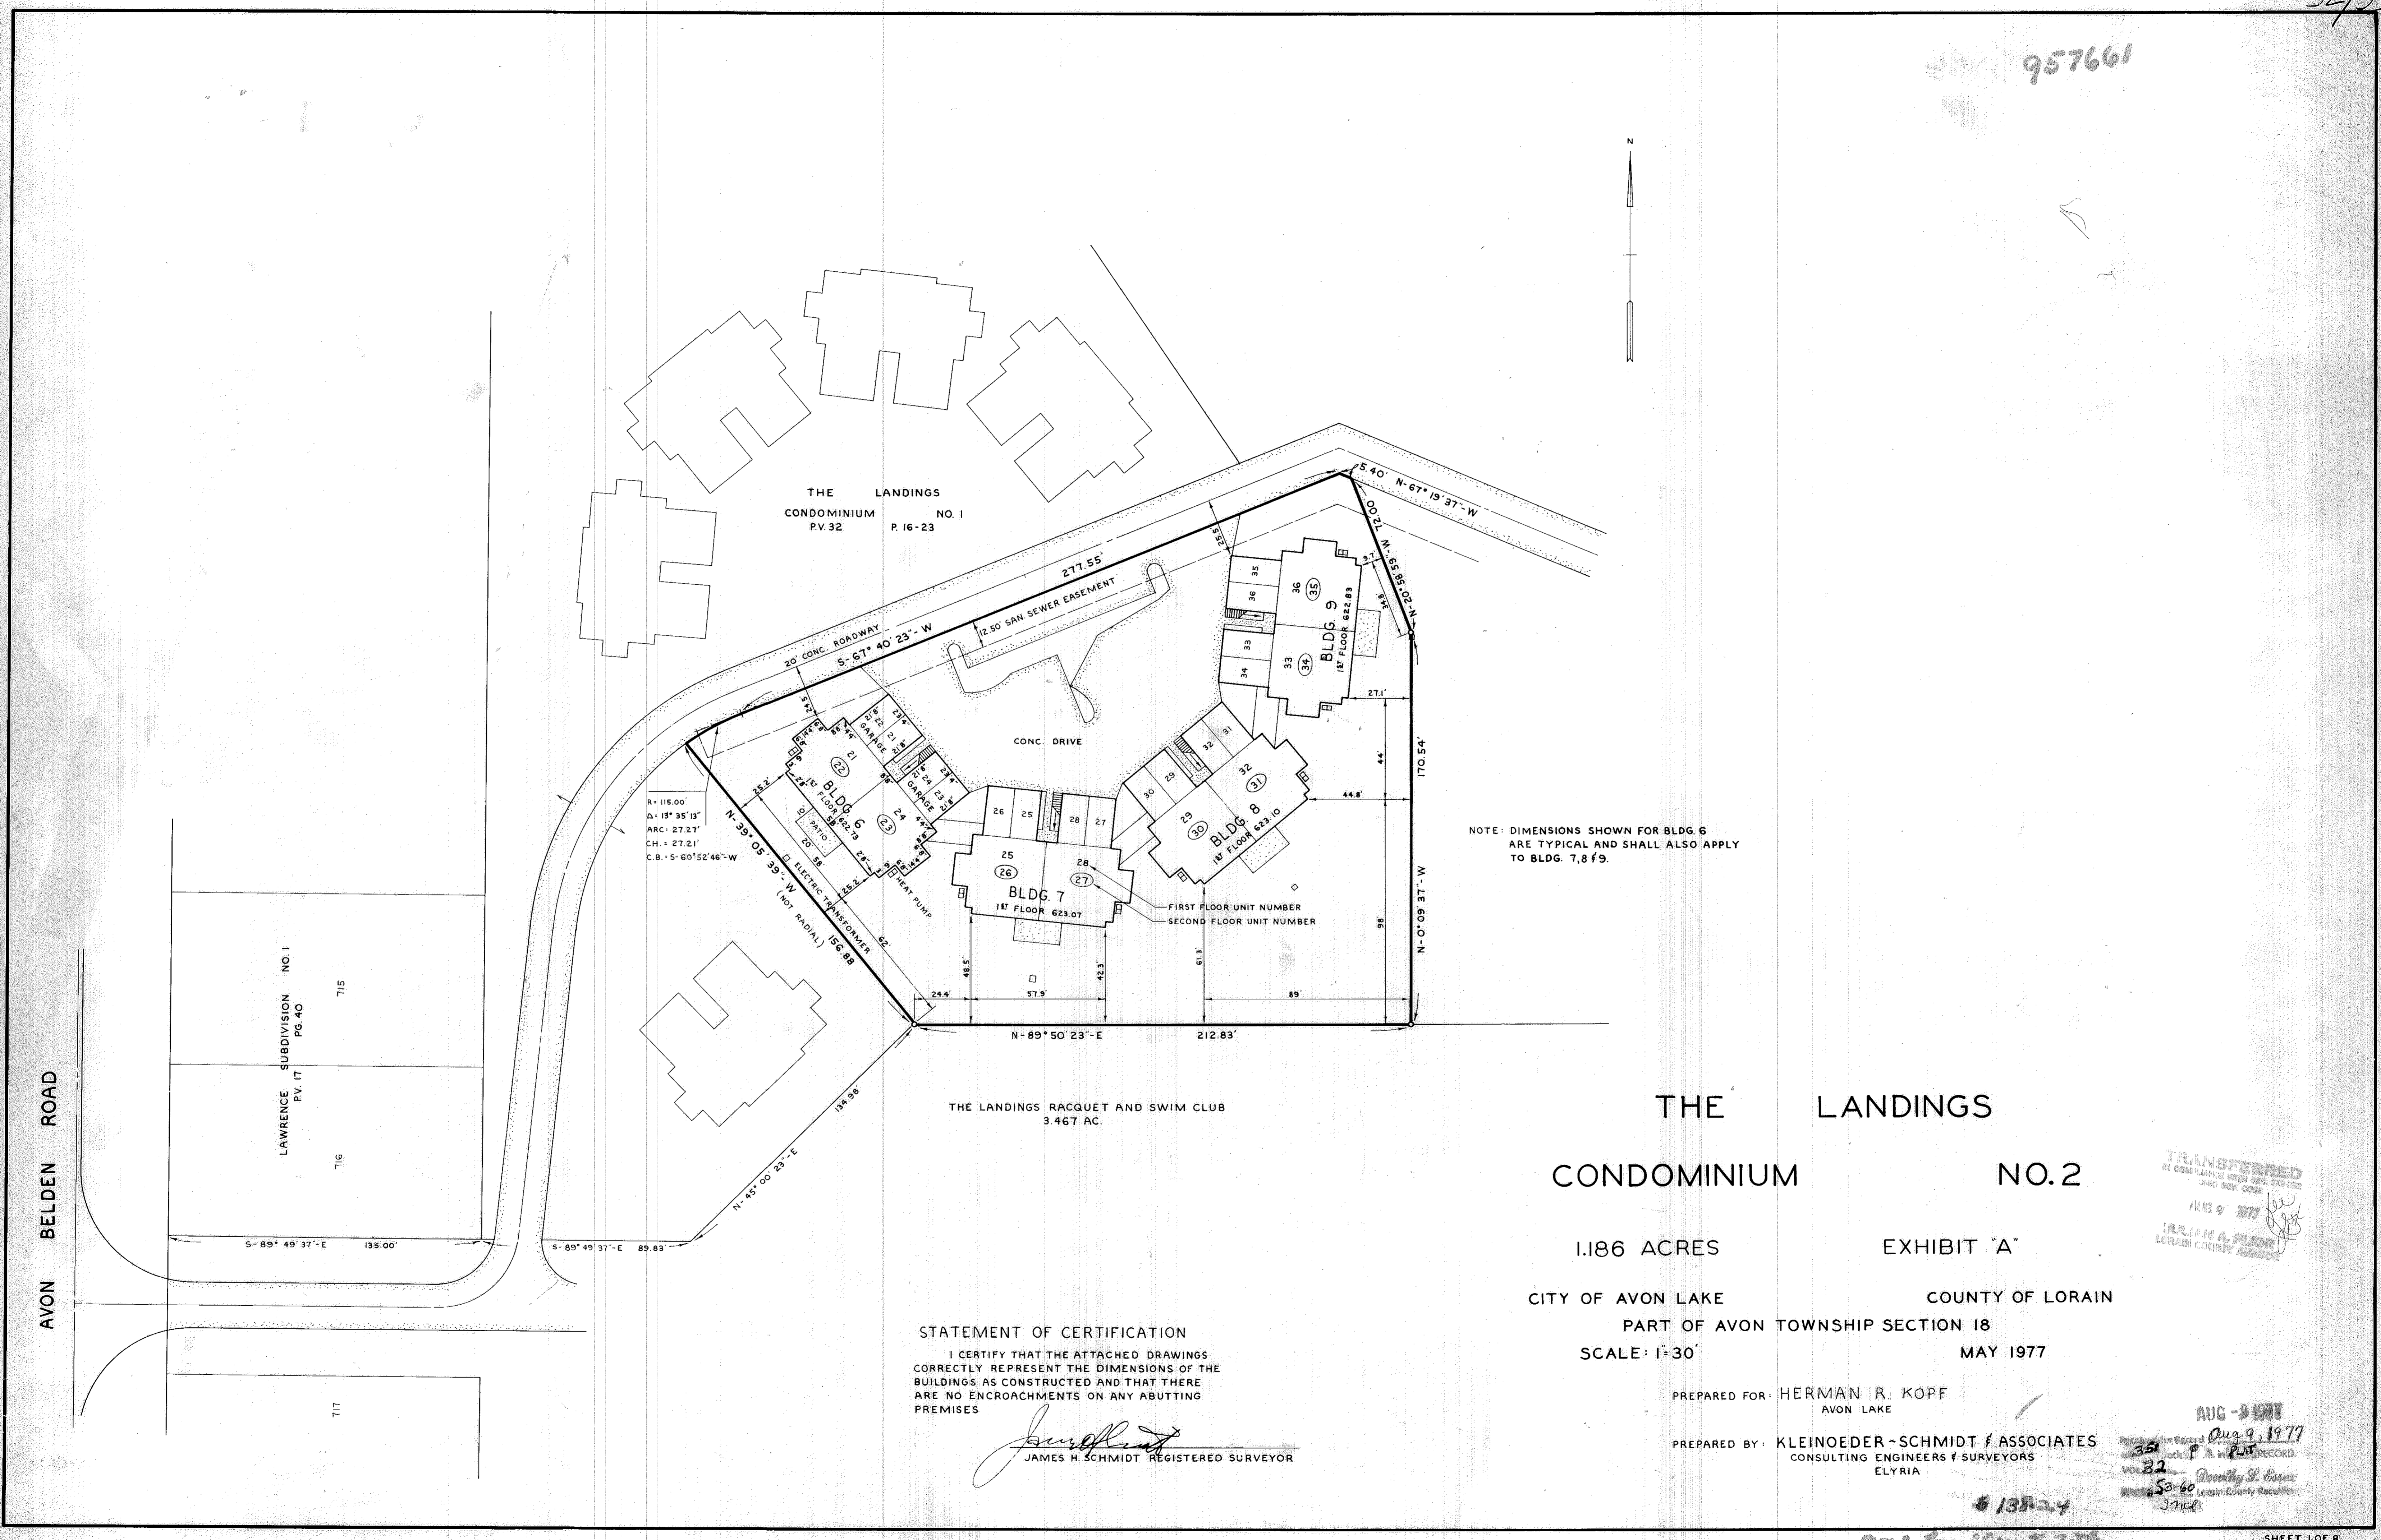

THE LANDINGS
CONDOMINIUM NO. 1
P.V. 32 P. 16-23

NOTE: DIMENSIONS SHOWN FOR BLDG. 6
ARE TYPICAL AND SHALL ALSO APPLY
TO BLDG. 7, 8 & 9.

THE LANDINGS
CONDOMINIUM NO. 2

1.186 ACRES

EXHIBIT "A"

CITY OF AVON LAKE

COUNTY OF LORAIN

PART OF AVON TOWNSHIP SECTION 18

SCALE: 1"=30'

MAY 1977

STATEMENT OF CERTIFICATION

I CERTIFY THAT THE ATTACHED DRAWINGS
CORRECTLY REPRESENT THE DIMENSIONS OF THE
BUILDINGS AS CONSTRUCTED AND THAT THERE
ARE NO ENCROACHMENTS ON ANY ABUTTING
PREMISES

James H. Schmidt
JAMES H. SCHMIDT REGISTERED SURVEYOR


PREPARED FOR: HERMAN R. KOPF
AVON LAKE

PREPARED BY: KLEINOEDER-SCHMIDT & ASSOCIATES
CONSULTING ENGINEERS & SURVEYORS
ELYRIA

TRANSFERRED
AUG 9 1977
JAMES H. SCHMIDT
REGISTERED SURVEYOR

AUG - 9 1977
Aug 9, 1977
RECORDED
32
53-60
Lorain County Recorder

13824

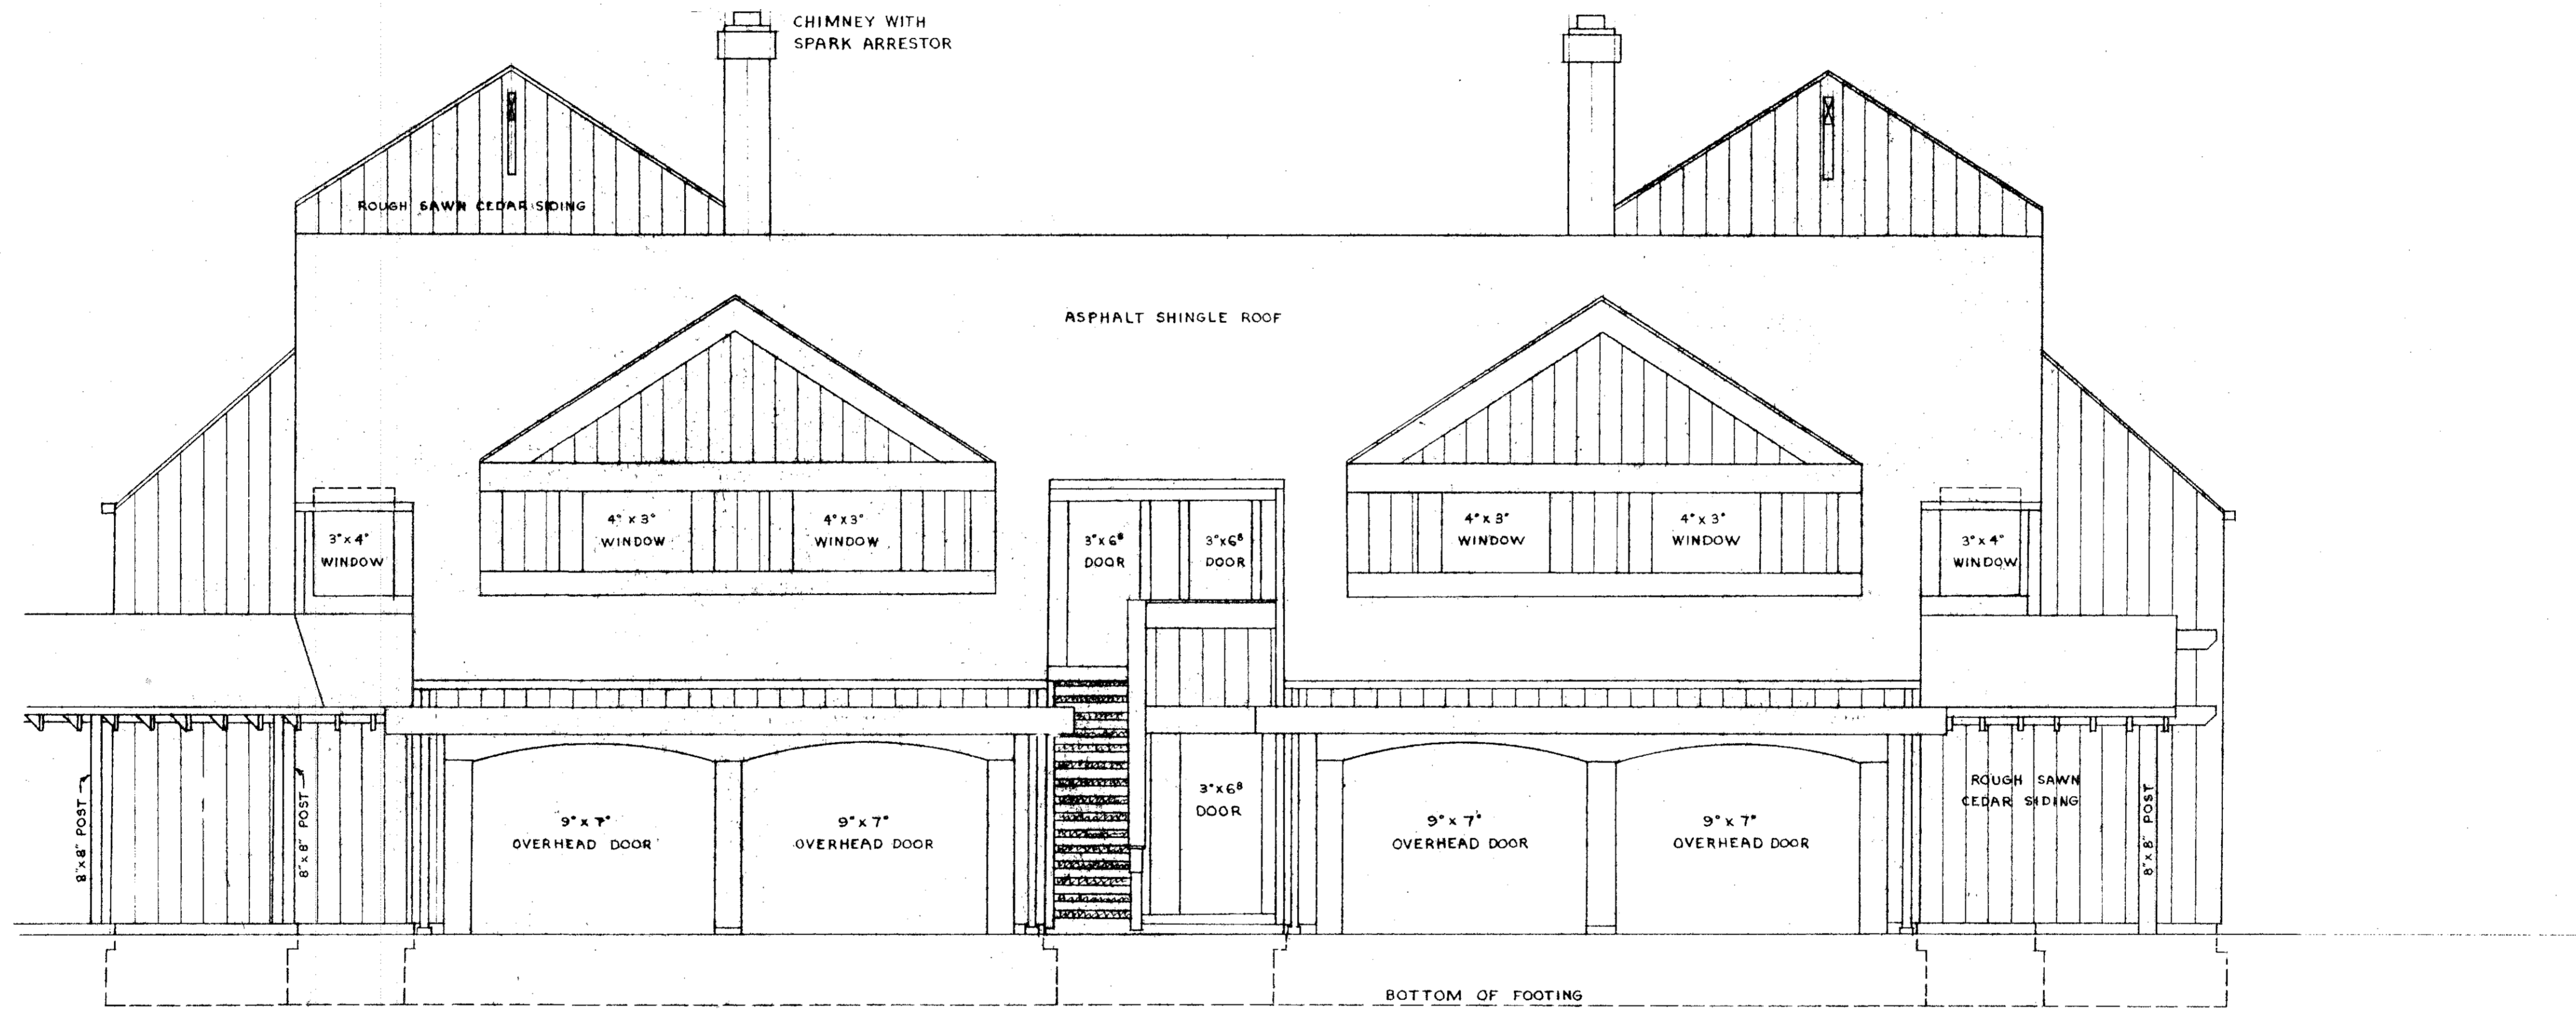

STATEMENT OF CERTIFICATION

I CERTIFY THAT THE ATTACHED DRAWINGS CORRECTLY REPRESENT THE DIMENSIONS OF THE BUILDINGS AS CONSTRUCTED AND THAT THERE ARE NO ENCROACHMENTS ON ANY ABUTTING PREMISES, EXCEPT AS SHOWN

James H. Schmidt
JAMES H. SCHMIDT


STATEMENT OF CERTIFICATION

I CERTIFY THAT THE ATTACHED DRAWINGS CORRECTLY REPRESENT THE DIMENSIONS OF THE BUILDINGS AS CONSTRUCTED.

Robert E. Klejoeder
ROBERT E. KLEJOEDER
REGISTERED ENGINEER

FRONT ELEVATION

SCALE: 1/4" = 1'-0"

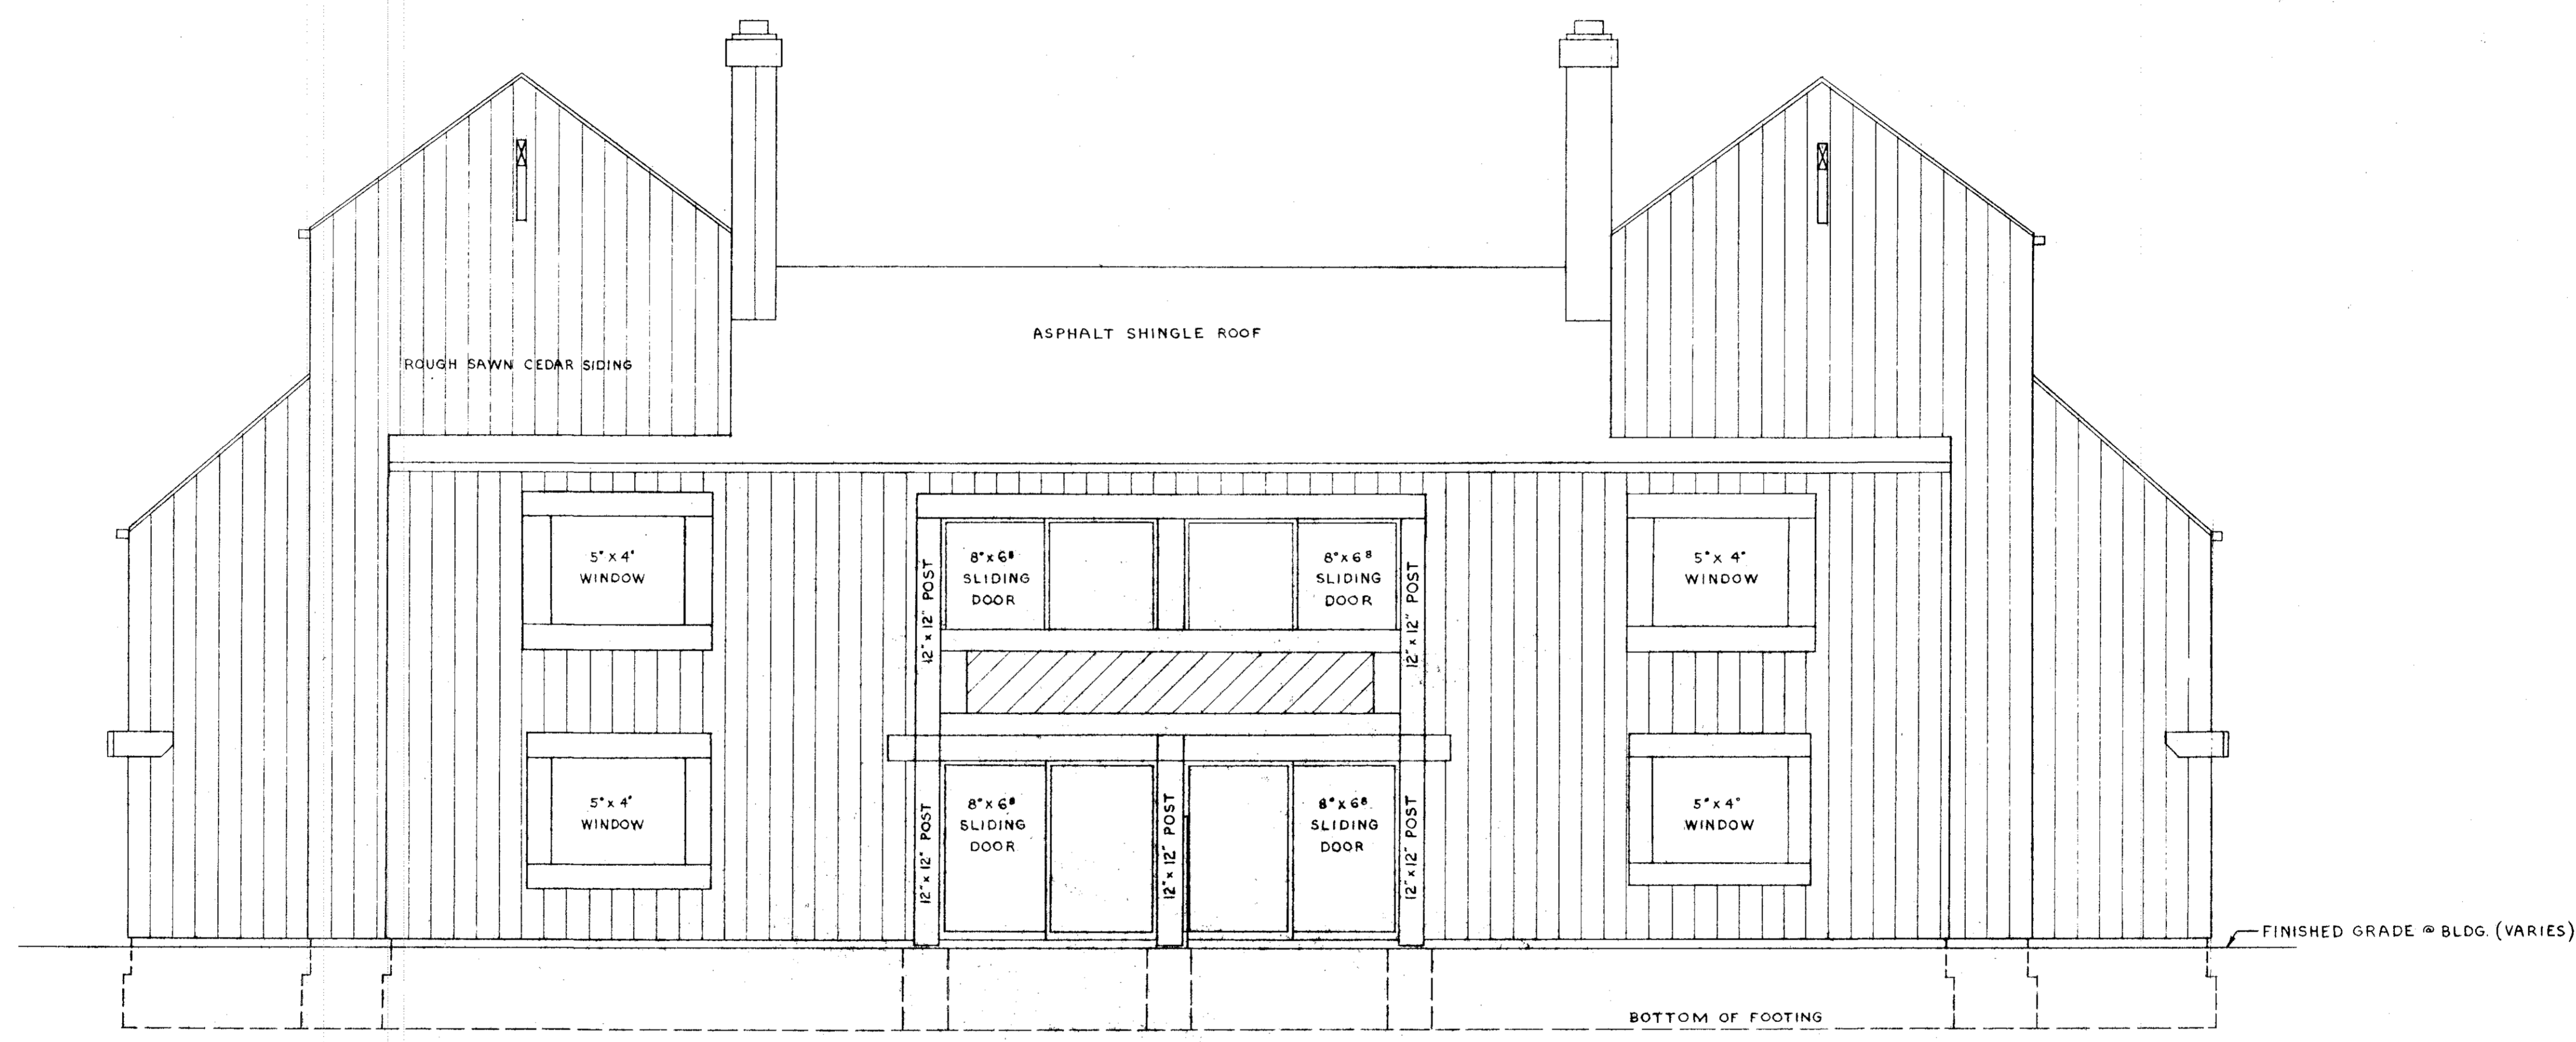


STATEMENT OF CERTIFICATION
 I CERTIFY THAT THE ATTACHED DRAWINGS CORRECTLY REPRESENT THE DIMENSIONS OF THE BUILDINGS AS CONSTRUCTED AND THAT THERE ARE NO ENCROACHMENTS ON ANY ABUTTING PREMISES EXCEPT AS SHOWN.

James H. Schmidt
 JAMES H. SCHMIDT

STATEMENT OF CERTIFICATION
 I CERTIFY THAT THE ATTACHED DRAWINGS CORRECTLY REPRESENT THE DIMENSIONS OF THE BUILDINGS AS CONSTRUCTED.

Robert E. Klineoeder
 ROBERT E. KLINEOEDER
 REGISTERED ENGINEER

REAR ELEVATION
 SCALE: 1/4" = 1'-0"

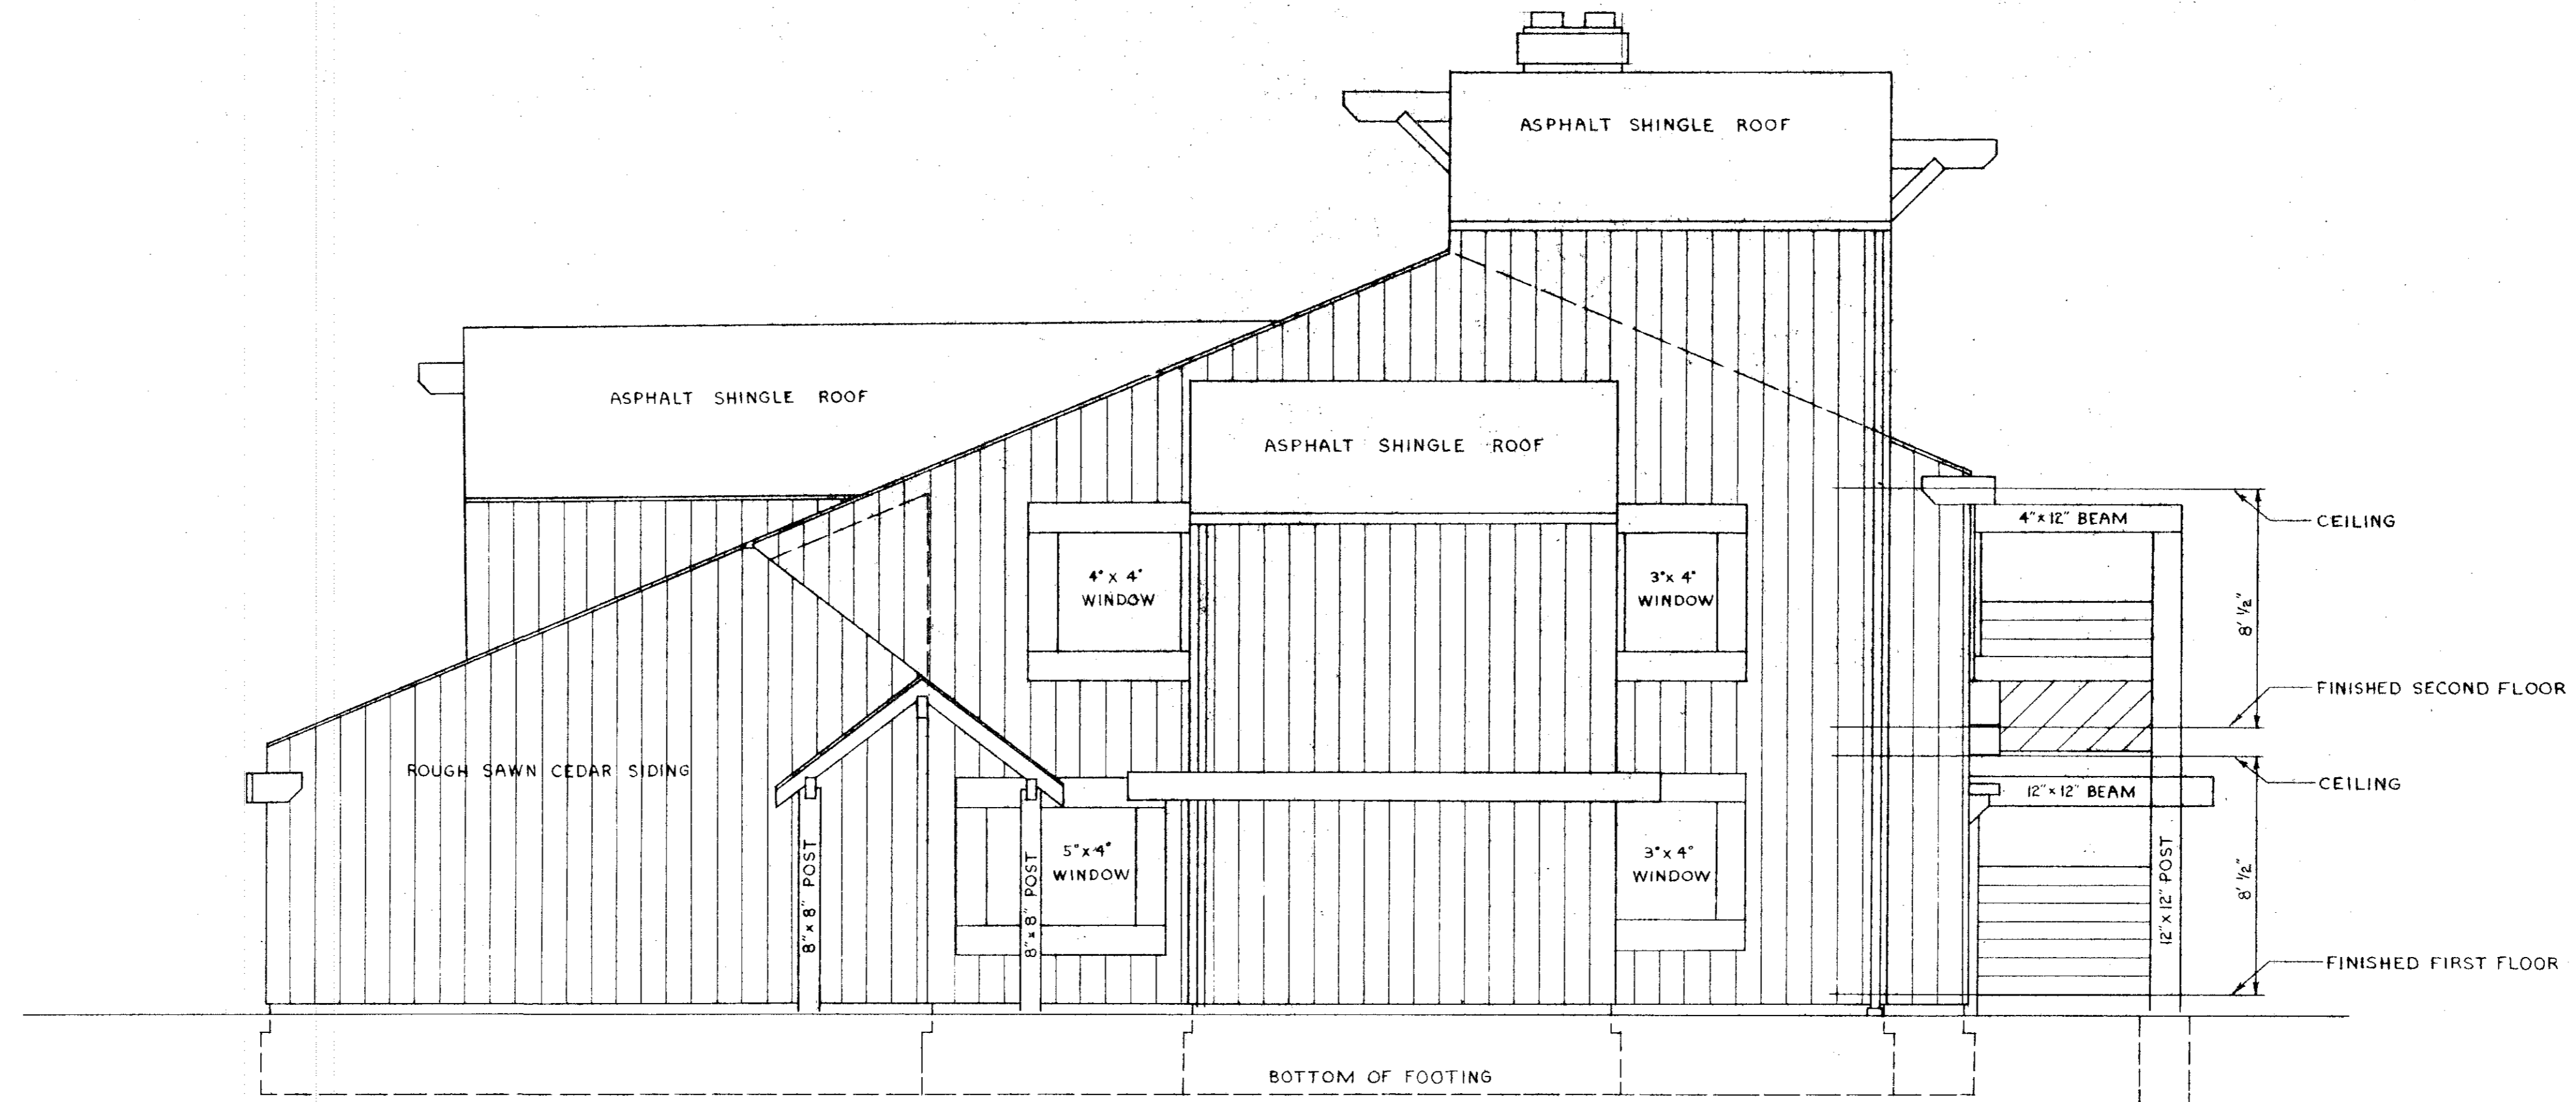


STATEMENT OF CERTIFICATION
 I CERTIFY THAT THE ATTACHED DRAWINGS CORRECTLY REPRESENT THE DIMENSIONS OF THE BUILDINGS AS CONSTRUCTED AND THAT THERE ARE NO ENCROACHMENTS ON ANY ABUTTING PREMISES EXCEPT AS SHOWN.

James H. Schmidt
 JAMES H. SCHMIDT

STATEMENT OF CERTIFICATION
 I CERTIFY THAT THE ATTACHED DRAWINGS CORRECTLY REPRESENT THE DIMENSIONS OF THE BUILDINGS AS CONSTRUCTED.

Robert E. Weinoeder
 ROBERT E. WEINOEDER
 REGISTERED ENGINEER

RIGHT SIDE ELEVATION
 SCALE: 1/4" = 1'-0"

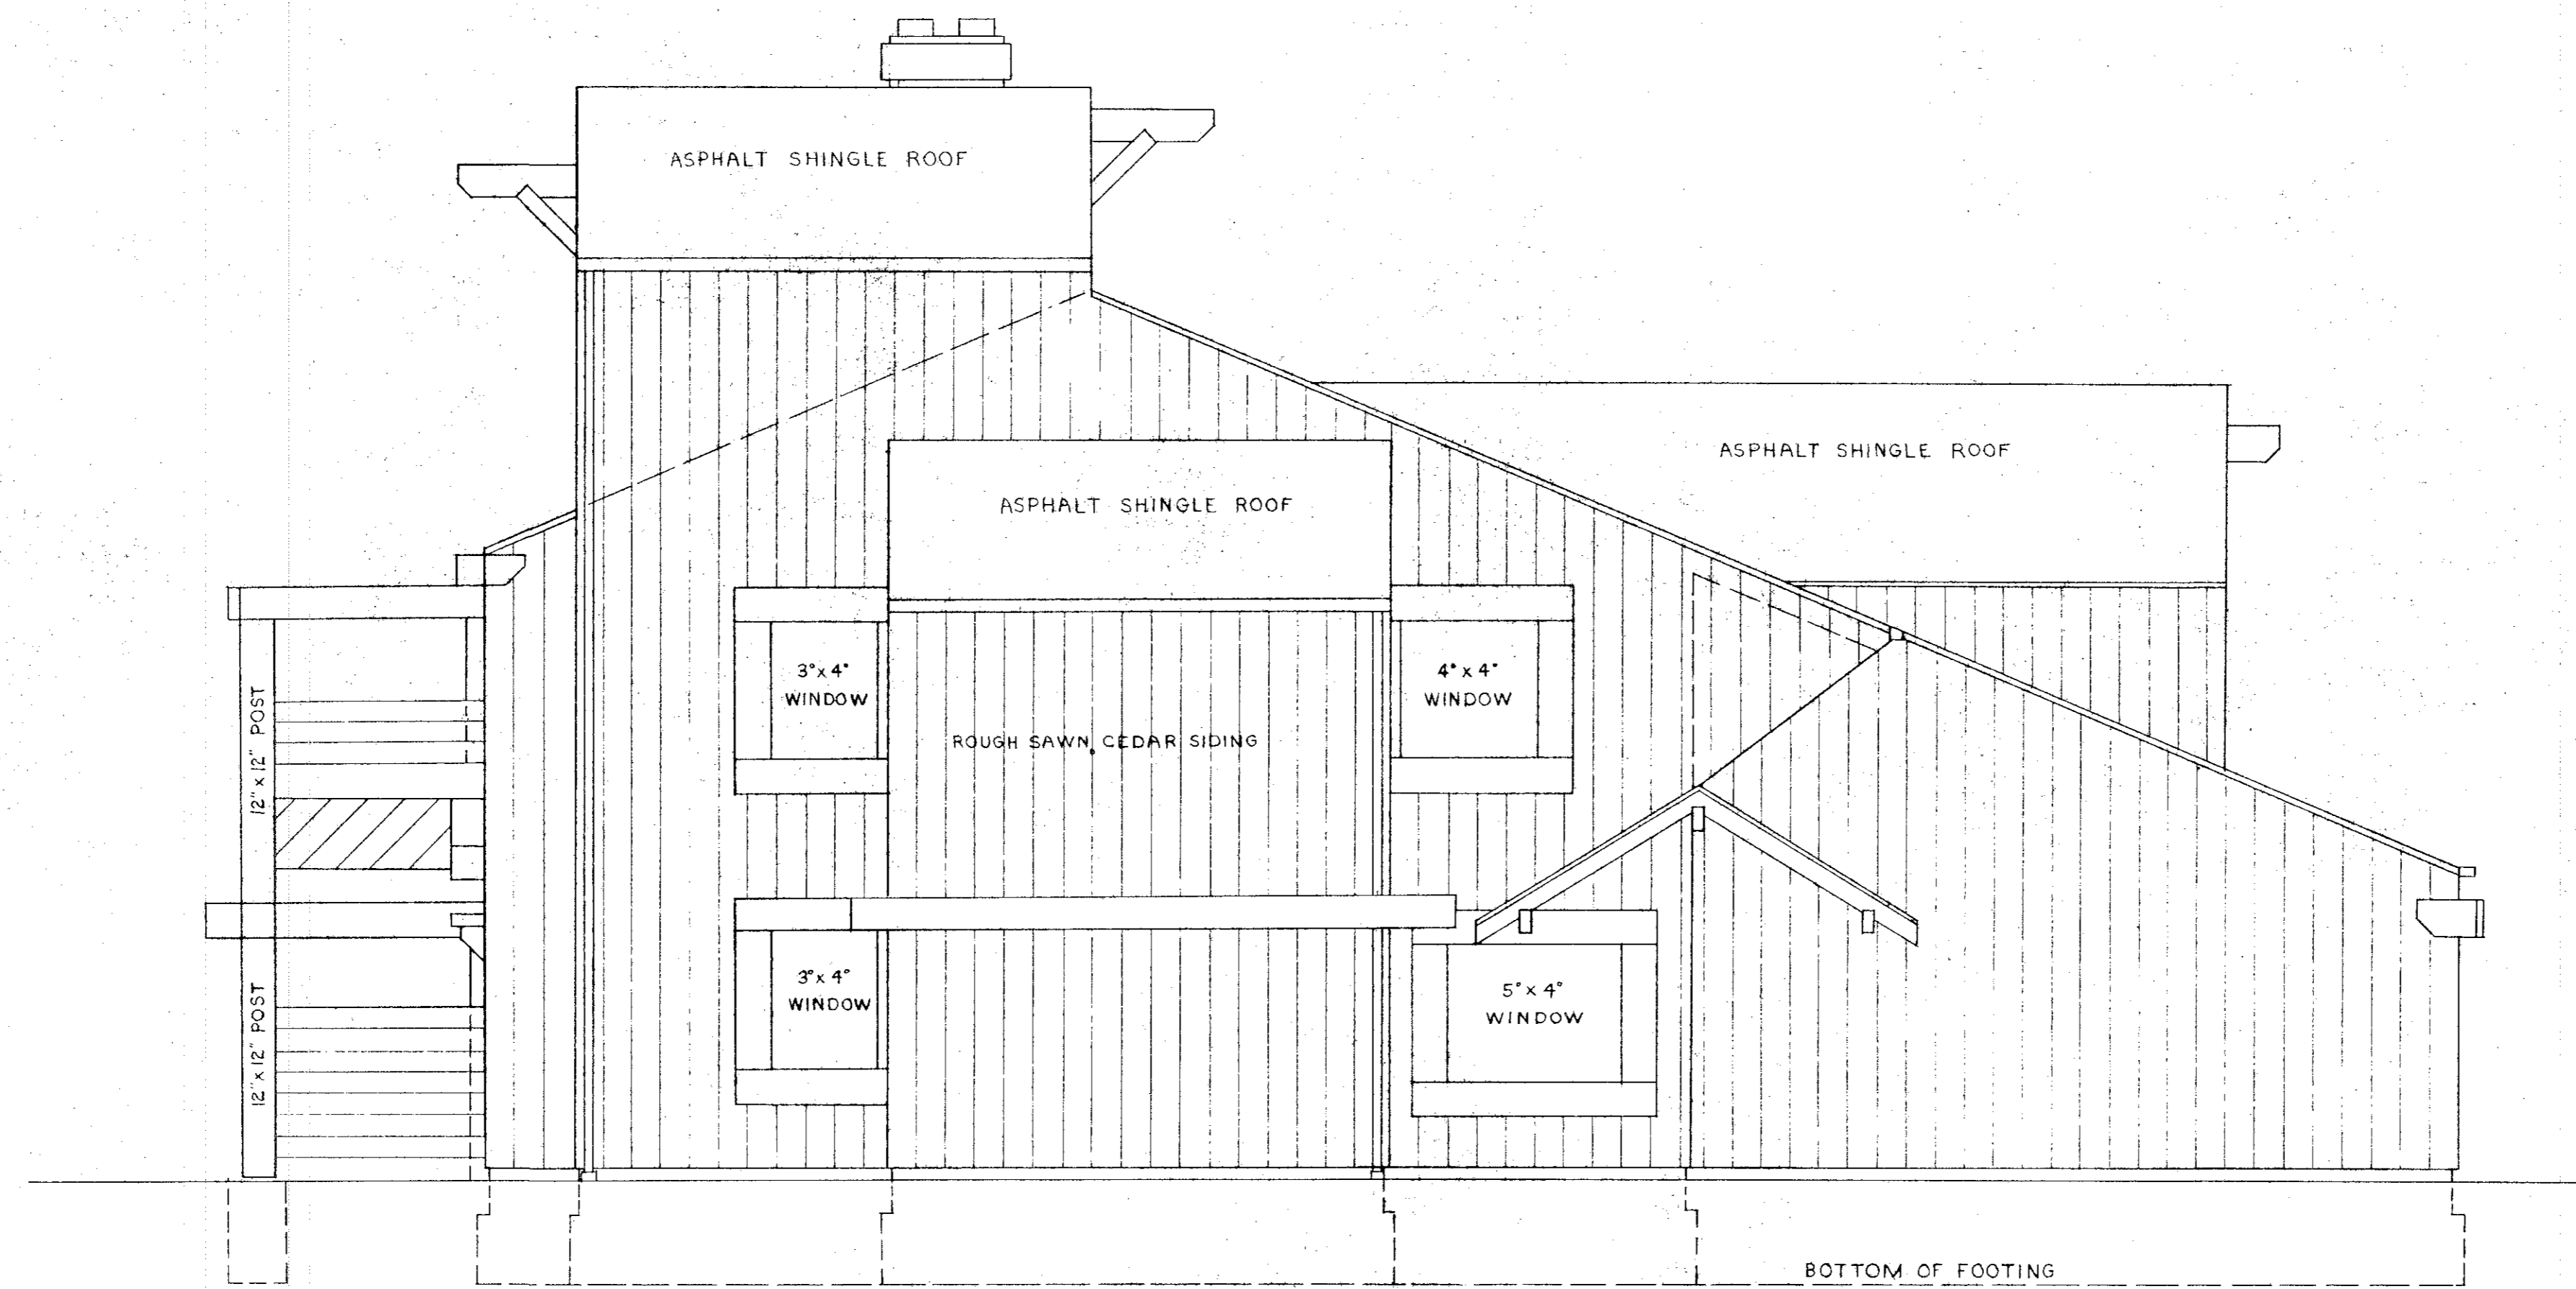

STATEMENT OF CERTIFICATION
 I CERTIFY THAT THE ATTACHED DRAWINGS CORRECTLY REPRESENT THE DIMENSIONS OF THE BUILDINGS AS CONSTRUCTED AND THAT THERE ARE NO ENCROACHMENTS ON ANY ABUTTING PREMISES EXCEPT AS SHOWN.


James H. Schmidt
 JAMES H. SCHMIDT

STATEMENT OF CERTIFICATION
 I CERTIFY THAT THE ATTACHED DRAWINGS CORRECTLY REPRESENT THE DIMENSIONS OF THE BUILDINGS AS CONSTRUCTED.

Robert E. Kloeder
 ROBERT E. KLOEDER
 REGISTERED ENGINEER

LEFT SIDE ELEVATION

SCALE: 1/4" = 1'-0"

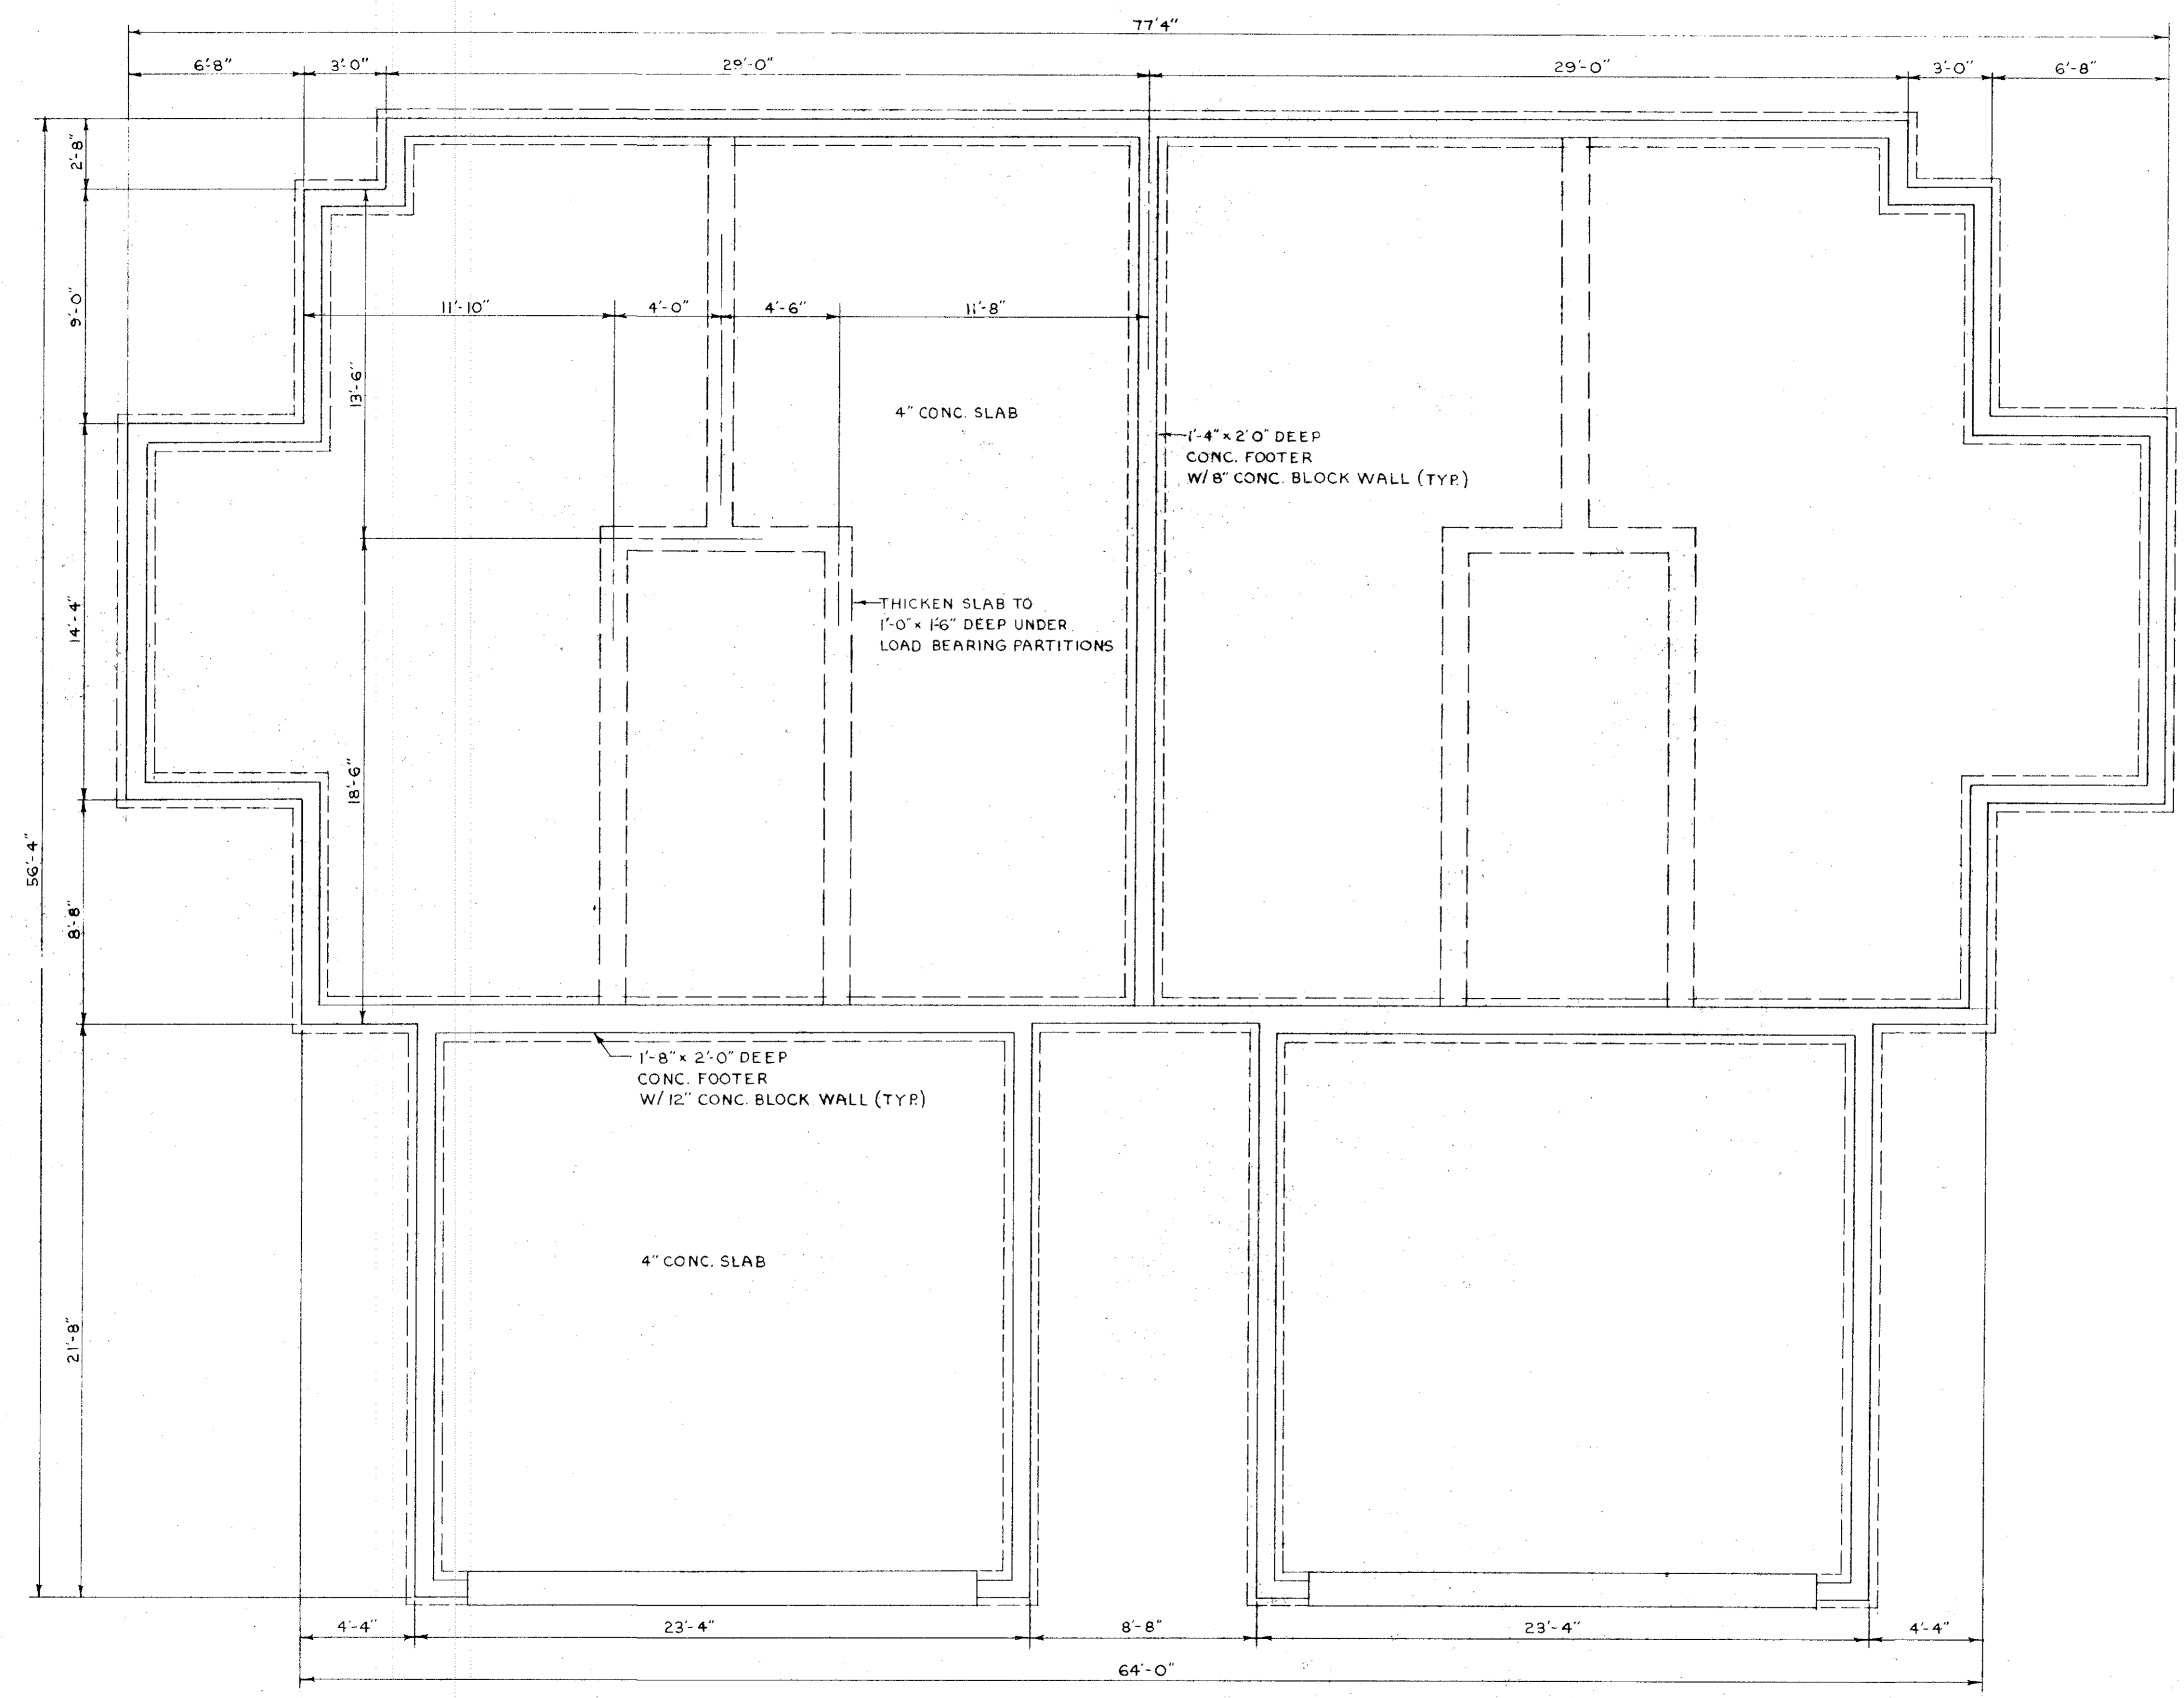


STATEMENT OF CERTIFICATION
 I CERTIFY THAT THE ATTACHED DRAWINGS CORRECTLY REPRESENT THE DIMENSIONS OF THE BUILDINGS AS CONSTRUCTED AND THAT THERE ARE NO ENCROACHMENTS ON ANY ABUTTING PREMISES EXCEPT AS SHOWN.

James H. Schmidt
 JAMES H. SCHMIDT

STATEMENT OF CERTIFICATION
 I CERTIFY THAT THE ATTACHED DRAWINGS CORRECTLY REPRESENT THE DIMENSIONS OF THE BUILDINGS AS CONSTRUCTED.

Robert E. Kleinsoder
 ROBERT E. KLEINSODER
 REGISTERED ENGINEER

FOUNDATION PLAN
 SCALE: 1/4" = 1'-0"

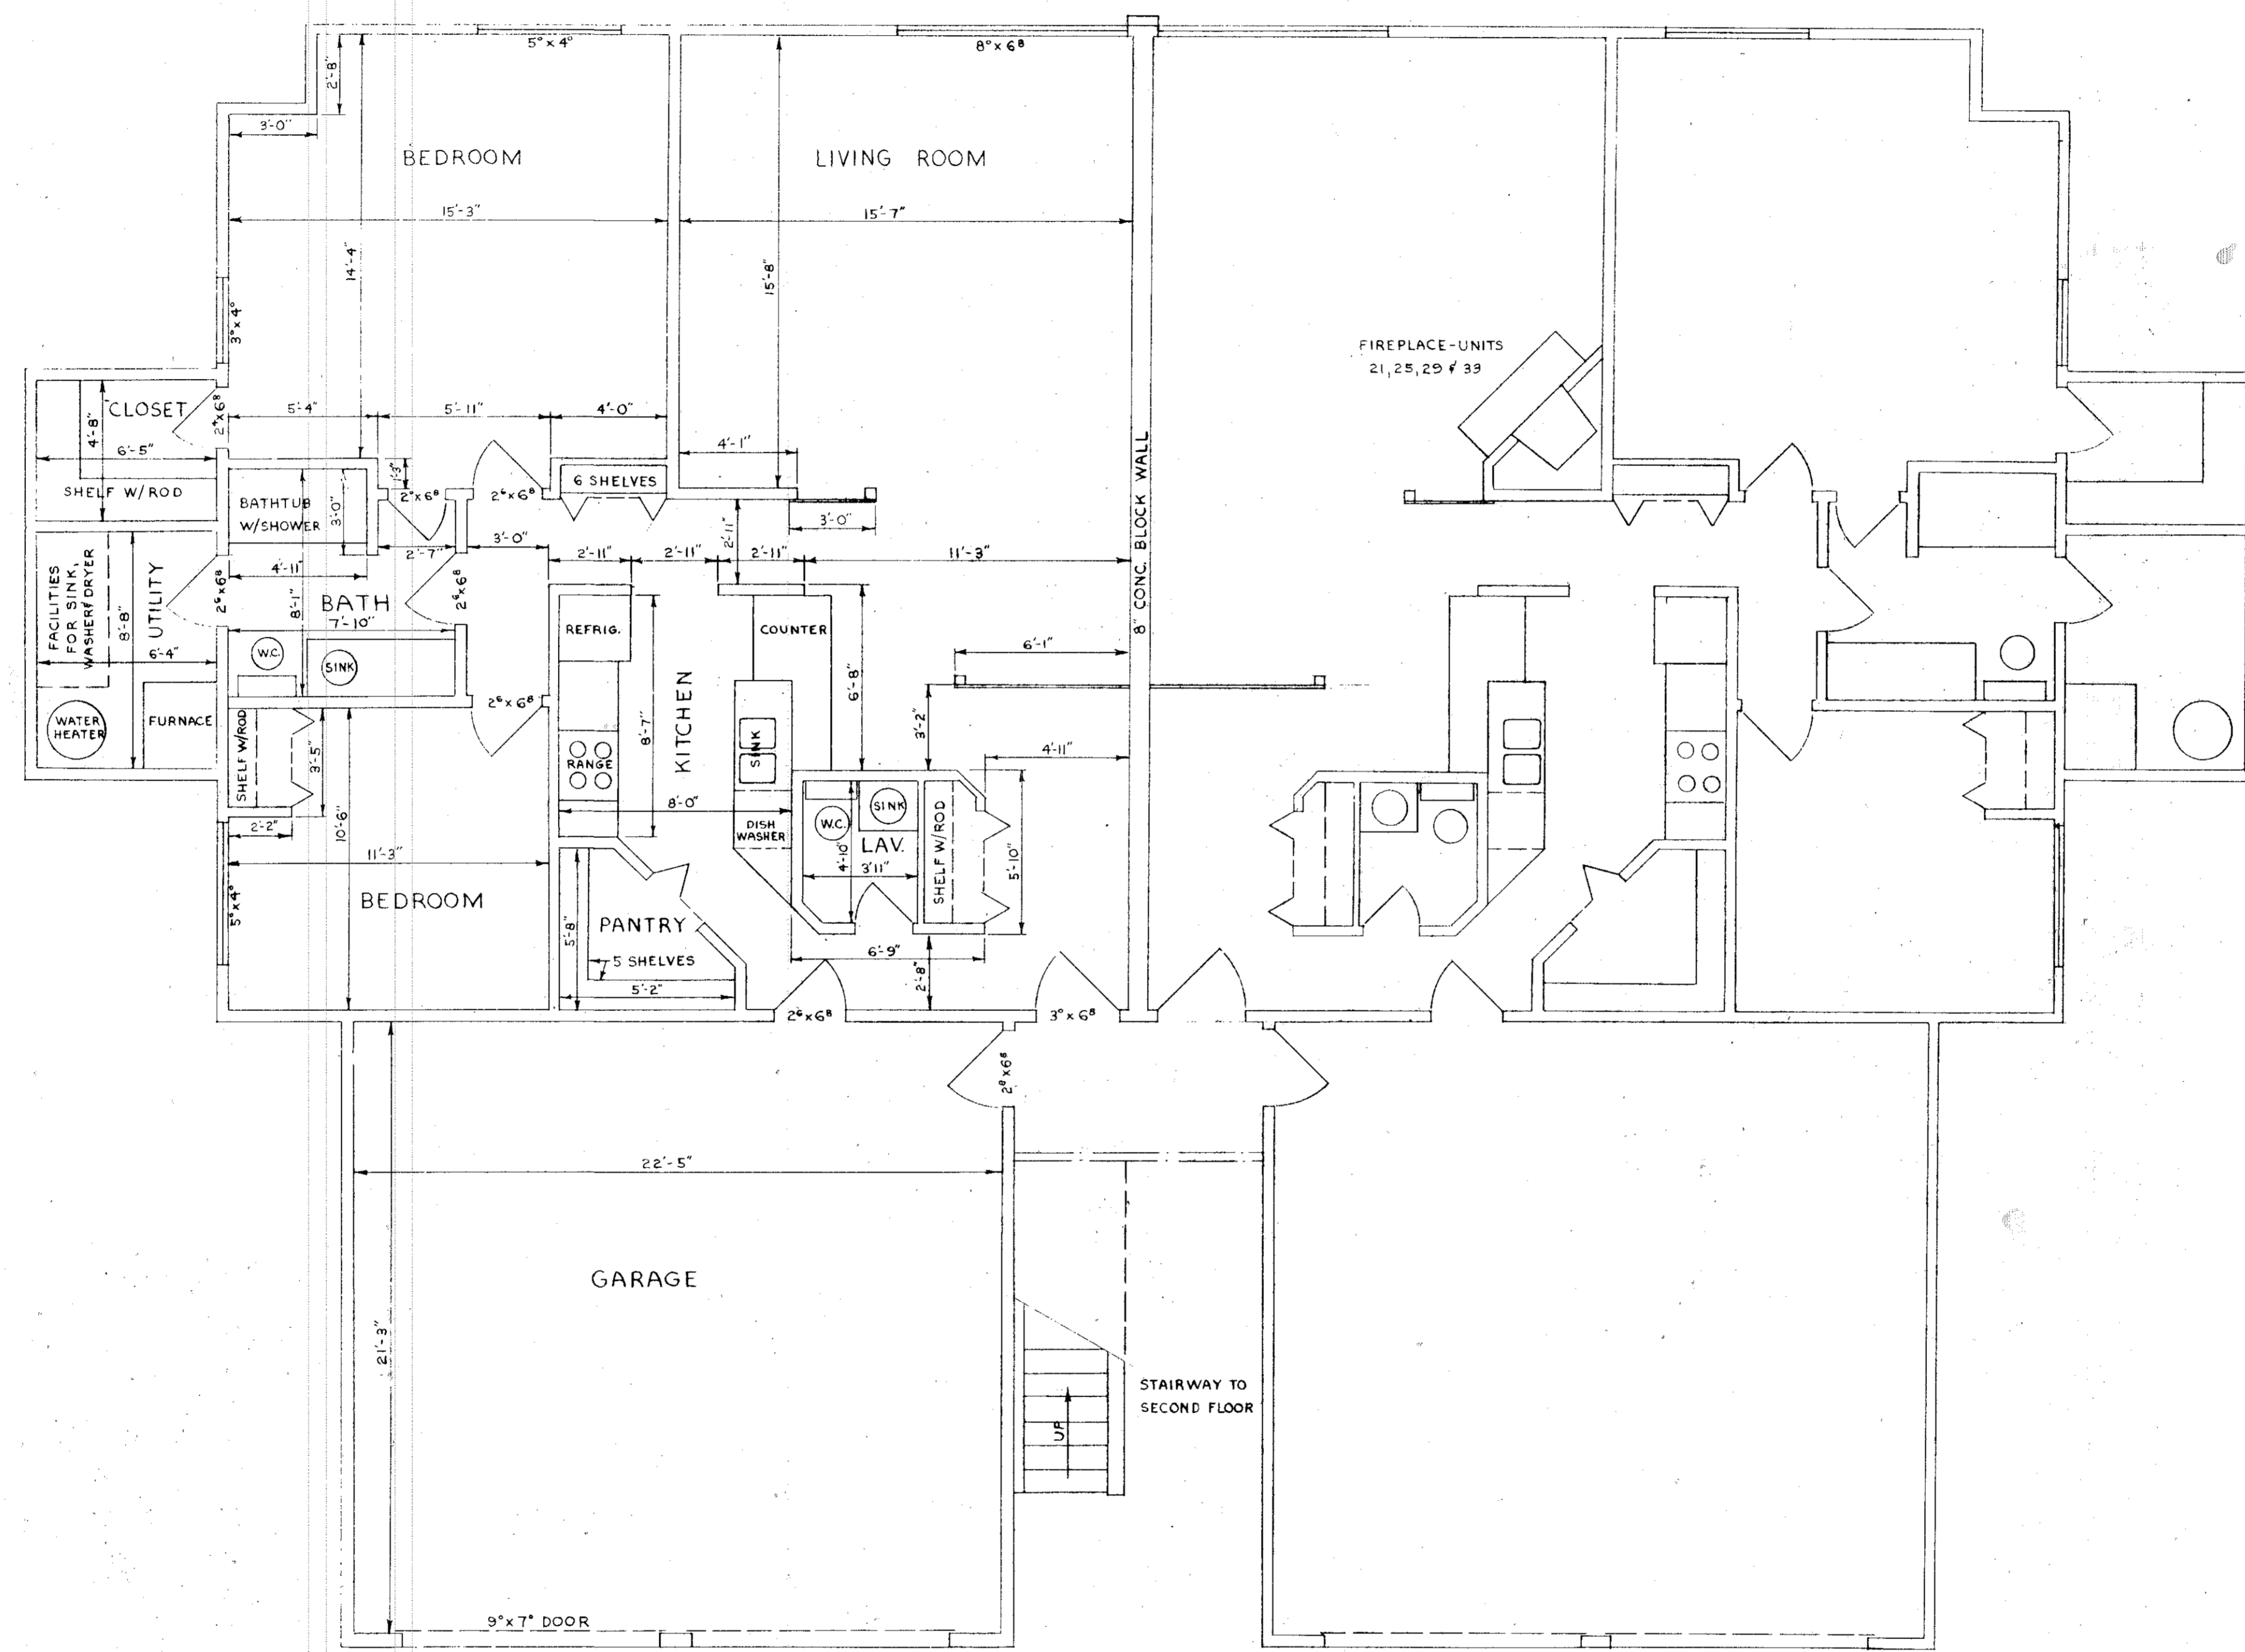


STATEMENT OF CERTIFICATION
 I CERTIFY THAT THE ATTACHED DRAWINGS CORRECTLY REPRESENT THE DIMENSIONS OF THE BUILDINGS AS CONSTRUCTED AND THAT THERE ARE NO ENCROACHMENTS ON ANY ABUTTING PREMISES EXCEPT AS SHOWN.

James H. Schmidt
 JAMES H. SCHMIDT

STATEMENT OF CERTIFICATION
 I CERTIFY THAT THE ATTACHED DRAWINGS CORRECTLY REPRESENT THE DIMENSIONS OF THE BUILDINGS AS CONSTRUCTED.

Robert E. Kluender
 ROBERT E. KLUNEDER
 REGISTERED ENGINEER

FIRST FLOOR PLAN
 SCALE: 1/4" = 1'-0"

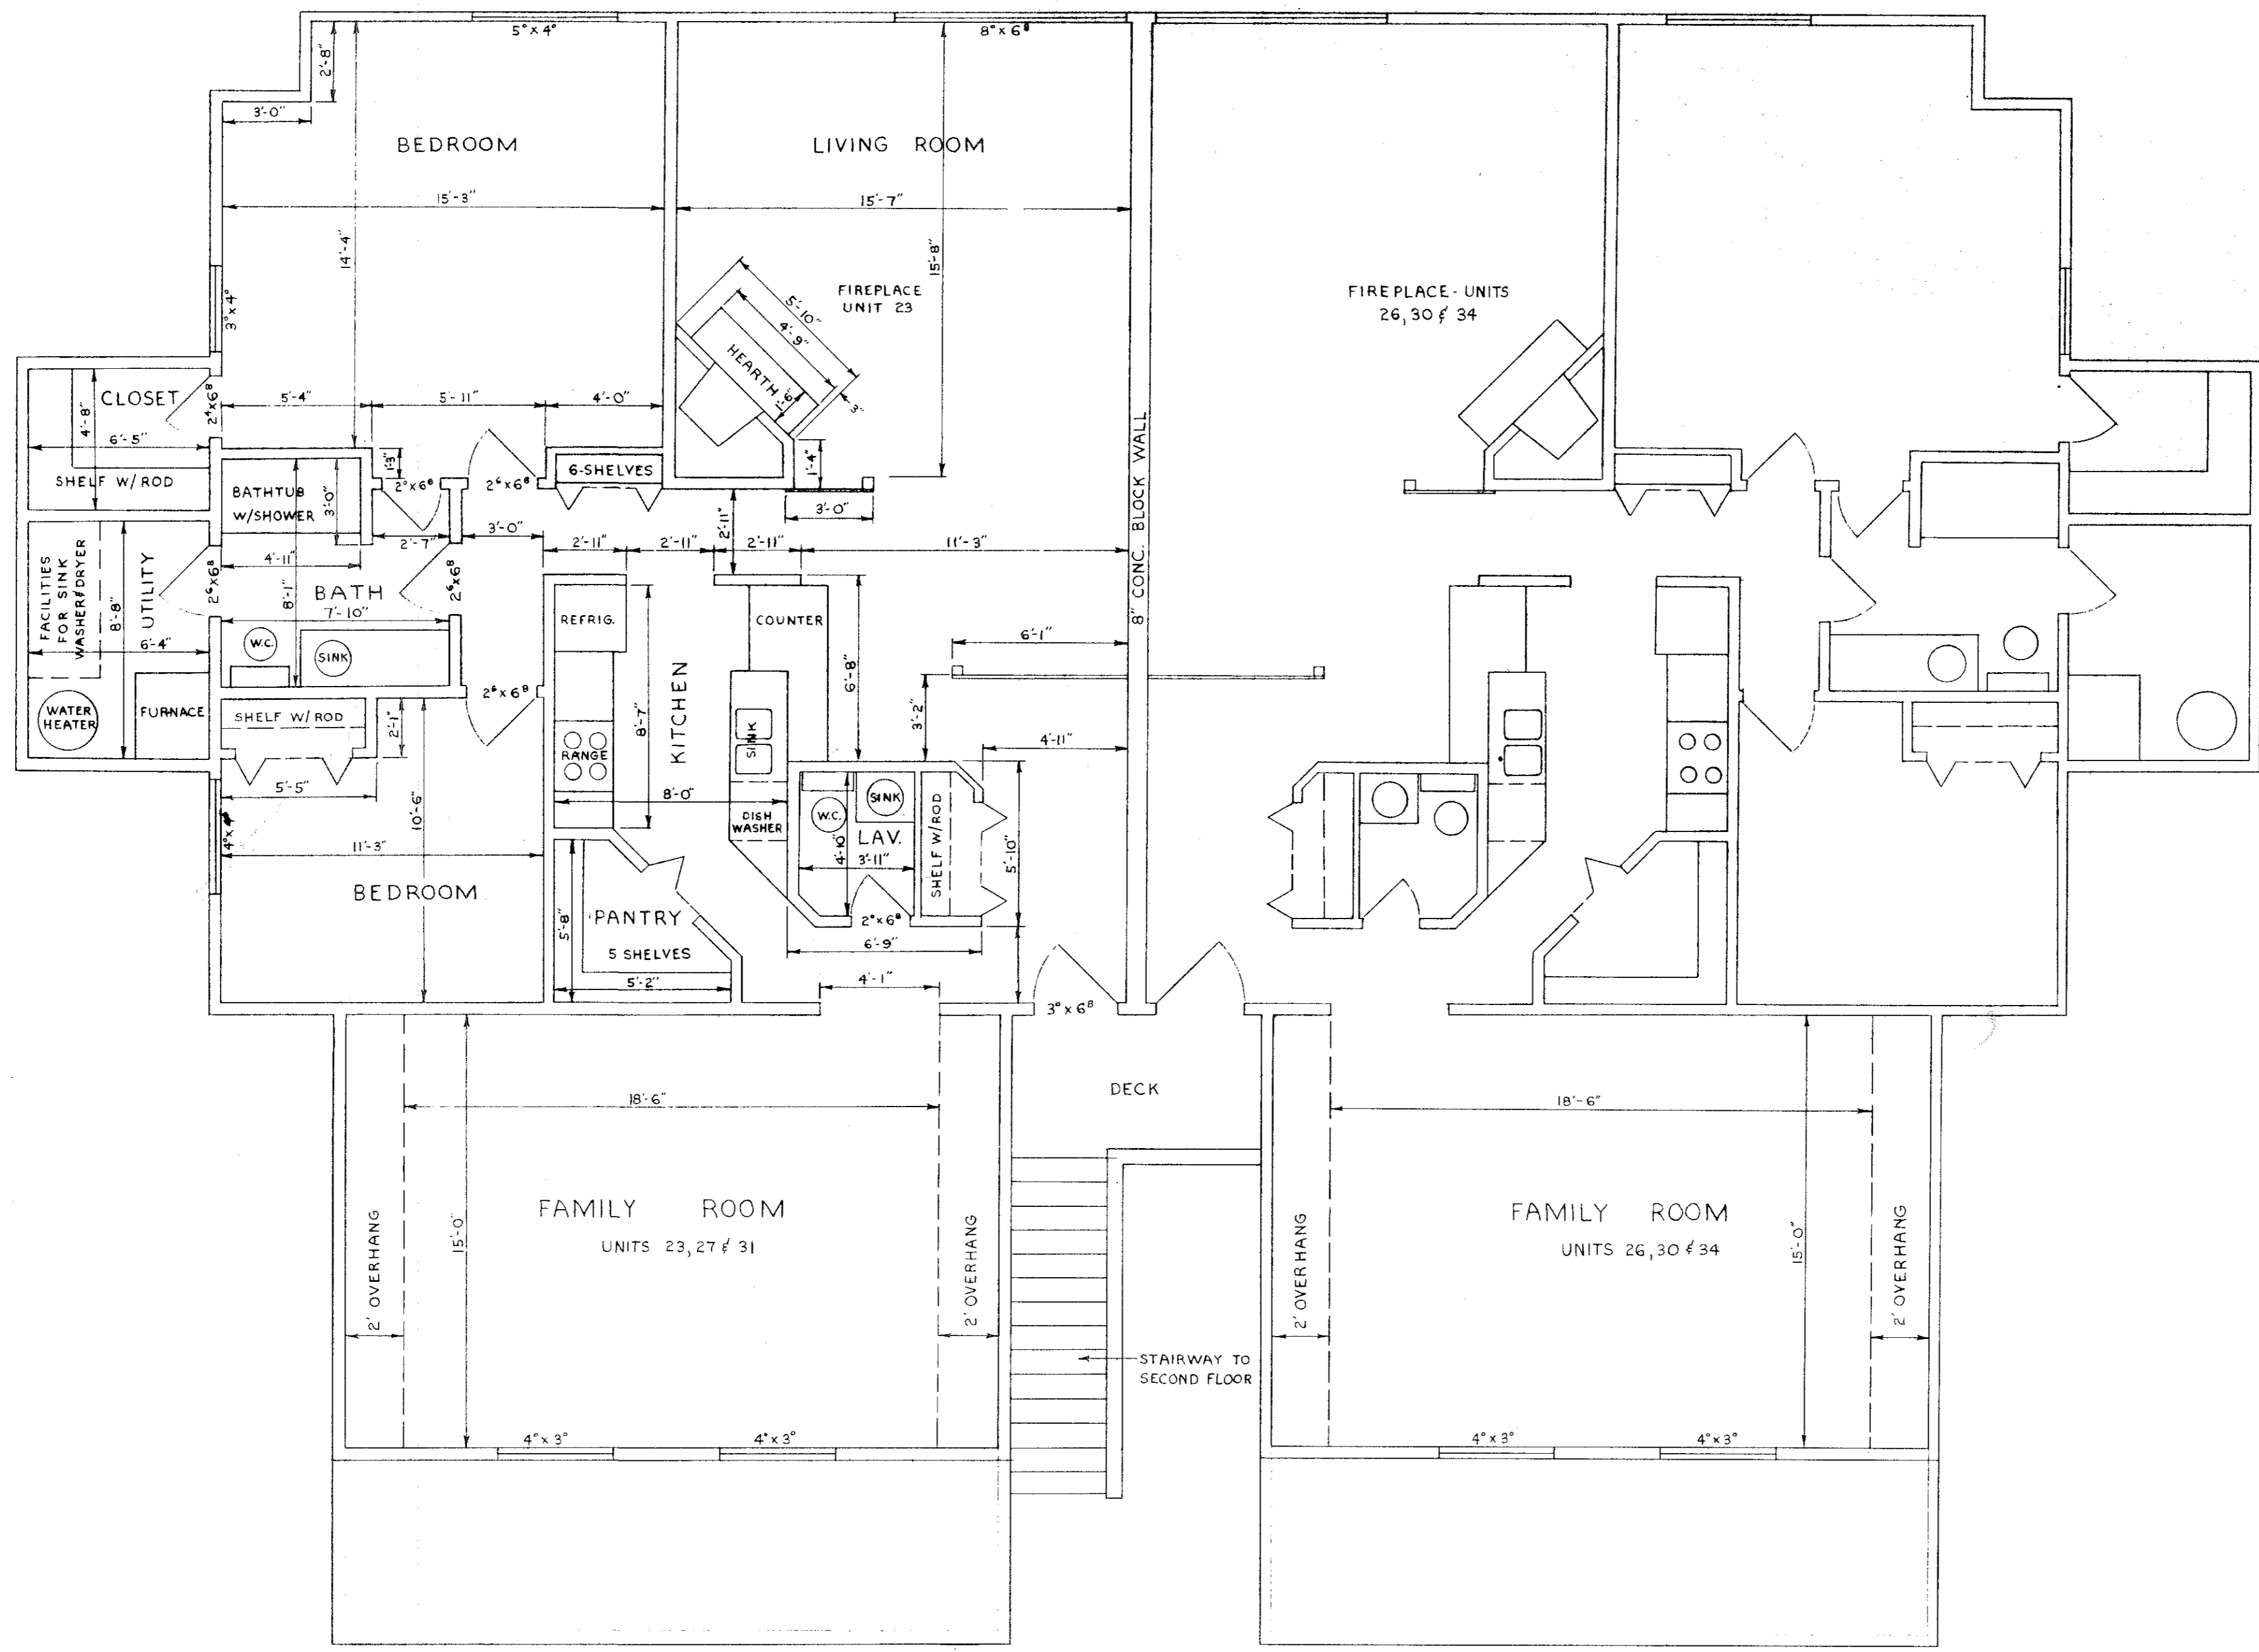

STATEMENT OF CERTIFICATION
I CERTIFY THAT THE ATTACHED DRAWINGS CORRECTLY REPRESENT THE DIMENSIONS OF THE BUILDINGS AS CONSTRUCTED AND THAT THERE ARE NO ENCROACHMENTS ON ANY ABUTTING PREMISES EXCEPT AS SHOWN.

James H. Schmidt
JAMES H. SCHMIDT.

STATEMENT OF CERTIFICATION
I CERTIFY THAT THE ATTACHED DRAWINGS CORRECTLY REPRESENT THE DIMENSIONS OF THE BUILDINGS AS CONSTRUCTED.

Robert E. Kuehner
ROBERT E. KUEHNER
REGISTERED ENGINEER

SECOND FLOOR PLAN
SCALE: 1/4" = 1'-0"