


32/61

957695

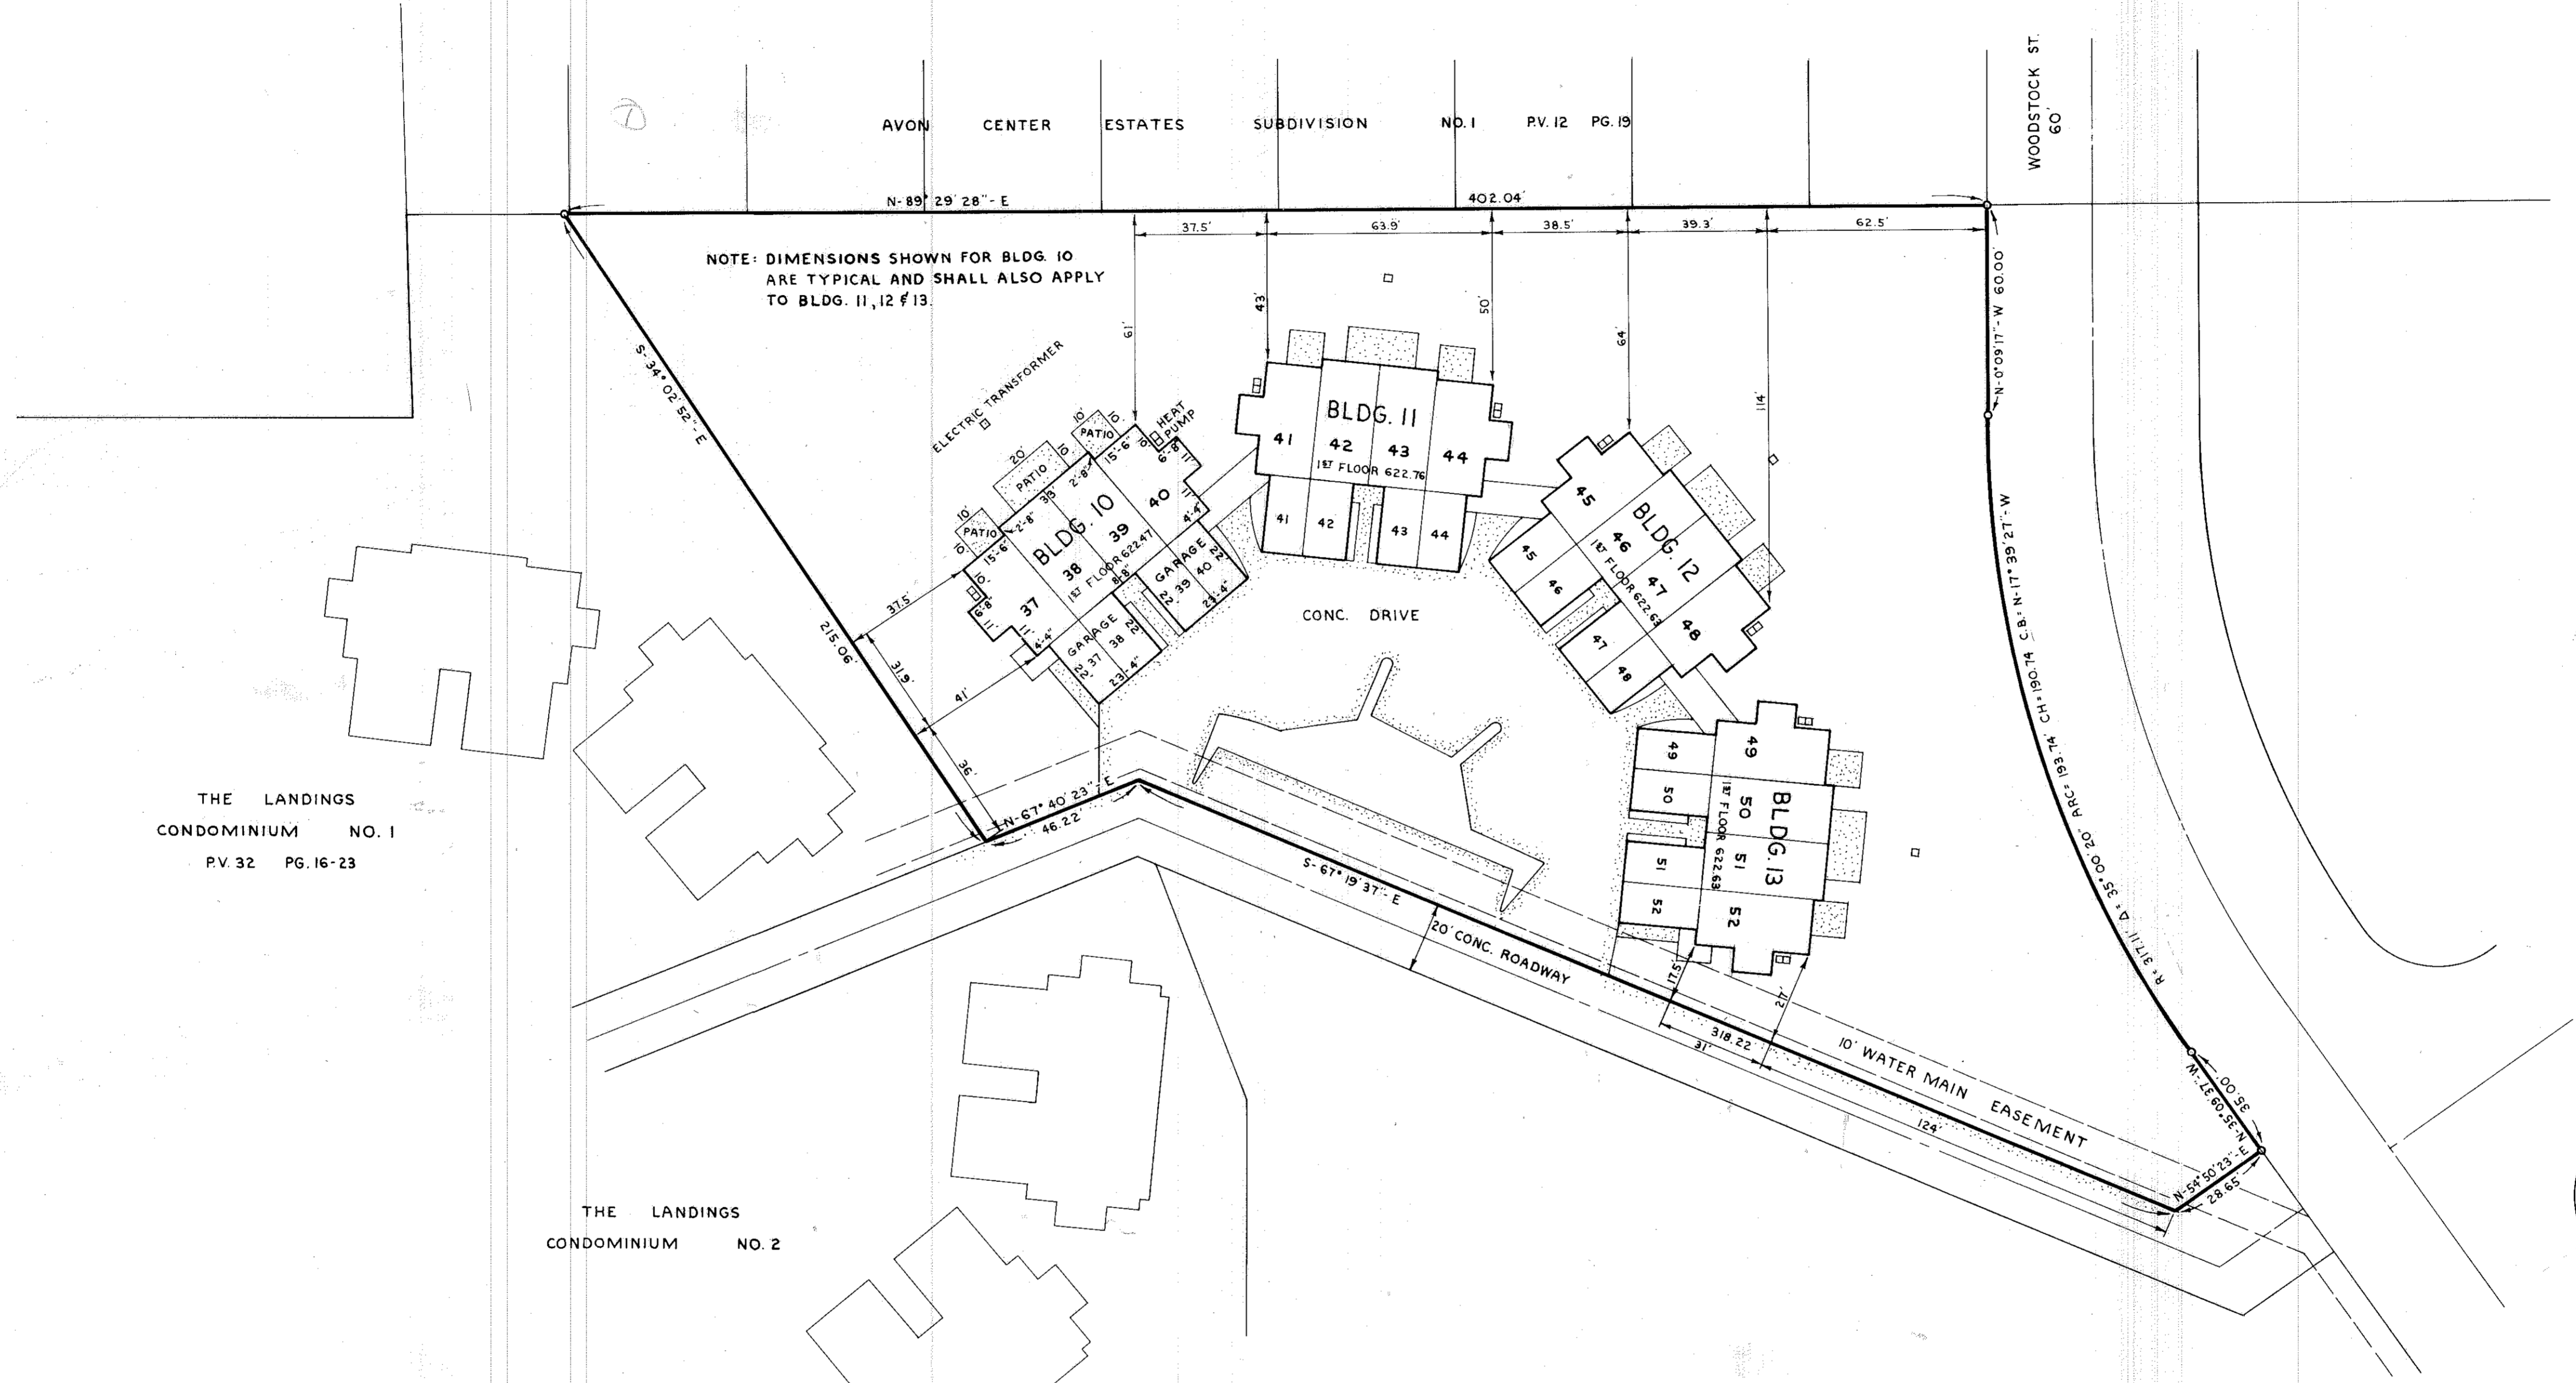

THE LANDINGS
 CONDOMINIUM NO. 1
 PV. 32 PG. 16-23

THE LANDINGS
 CONDOMINIUM NO. 2

THE LANDINGS
 CONDOMINIUM NO. 3

1.718 ACRES EXHIBIT "A"
 CITY OF AVON LAKE COUNTY OF LORAIN
 PART OF AVON TOWNSHIP SECTION 18

STATEMENT OF CERTIFICATION
 I CERTIFY THAT THE ATTACHED DRAWINGS CORRECTLY REPRESENT THE DIMENSIONS OF THE BUILDINGS AS CONSTRUCTED AND THAT THERE ARE NO ENCROACHMENTS ON ANY ABUTTING PREMISES.


James H. Schmidt
 JAMES H. SCHMIDT REGISTERED SURVEYOR

Received for Record
 AUG 10 1977
 10:25 a.m. in Plat RECORD
 Vol. 32
 6-6 Dorothy L. Jones
 Lucas County Recorder

PREPARED FOR: HERMAN R. KOPF
 AVON LAKE
 PREPARED BY: KLEINODER-SCHMIDT & ASSOCIATES
 CONSULTING ENGINEERS & SURVEYORS
 ELYRIA


TRANSFERRED
 IN COMPLIANCE WITH SEC. 319-202
 OHIO REV. CODE
 AUG 10 1977
Juliana Plujor
 JULIANA PLUJOR
 FRANKLIN COUNTY AUDITOR

138.24

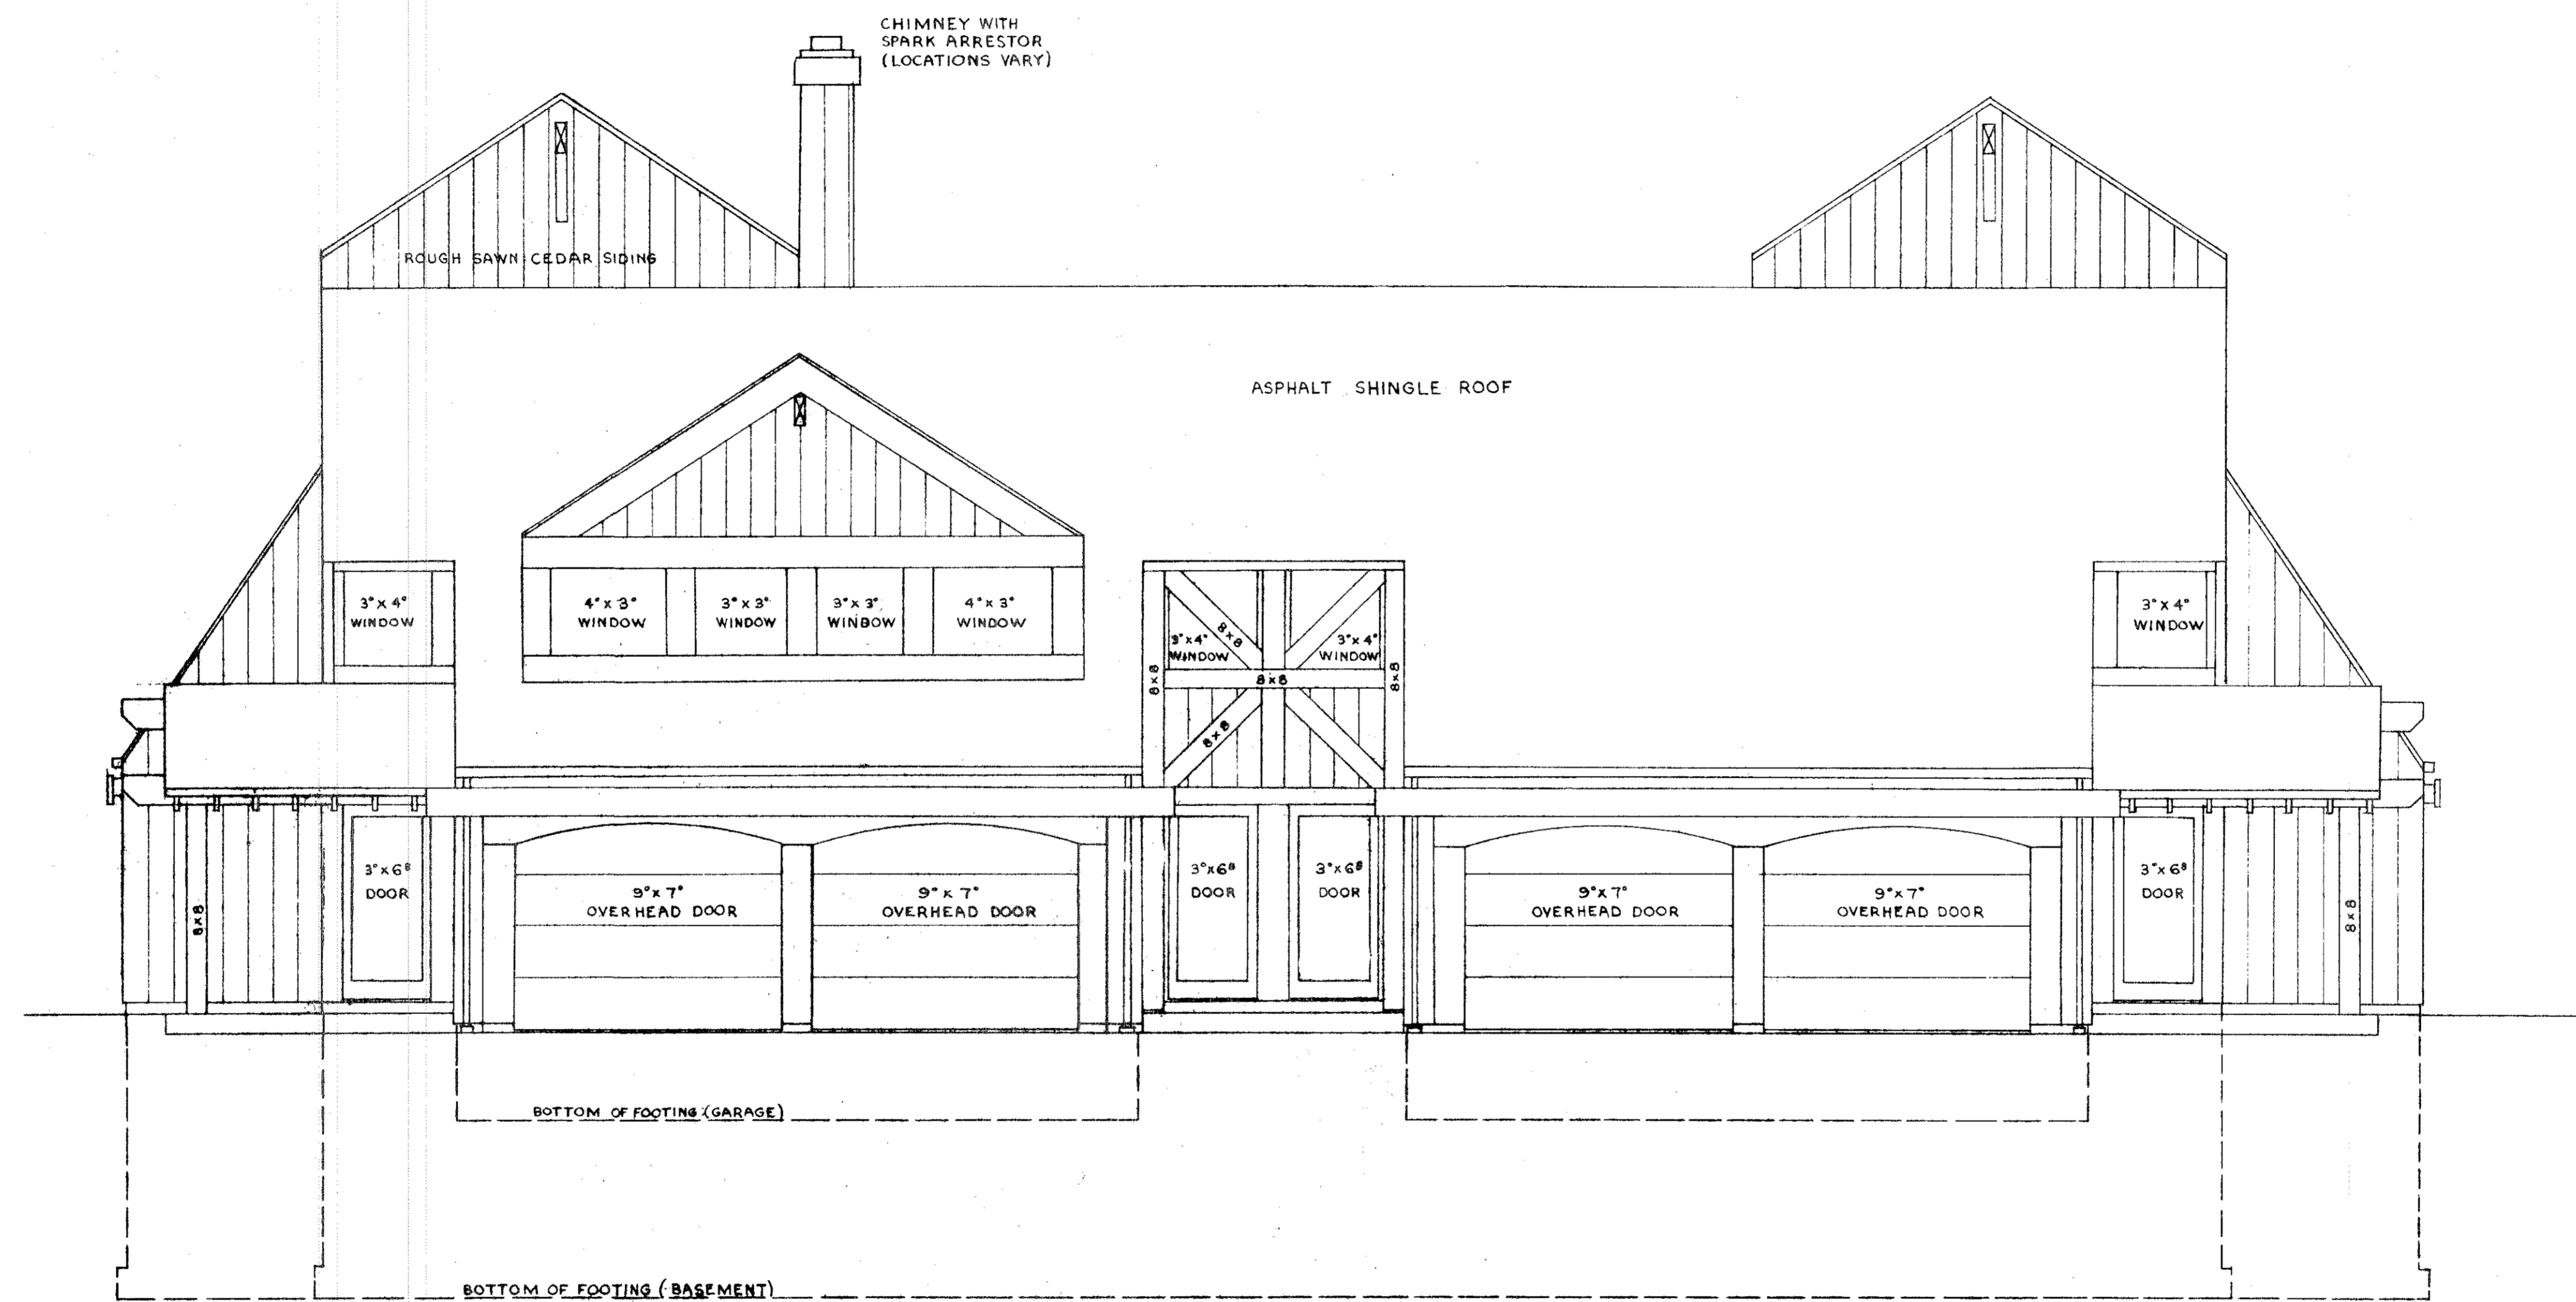

STATEMENT OF CERTIFICATION


I CERTIFY THAT THE ATTACHED DRAWINGS CORRECTLY REPRESENT THE DIMENSIONS OF THE BUILDINGS AS CONSTRUCTED AND THAT THERE ARE NO ENCROACHMENTS ON ANY ABUTTING PREMISES EXCEPT AS SHOWN.

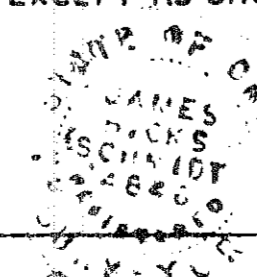


James H. Schmidt
 JAMES H. SCHMIDT
 REGISTERED ENGINEER

STATEMENT OF CERTIFICATION

I CERTIFY THAT THE ATTACHED DRAWINGS CORRECTLY REPRESENT THE DIMENSIONS OF THE BUILDINGS AS CONSTRUCTED.

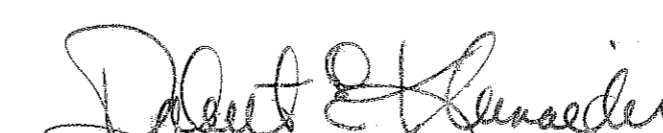
 ROBERT E. KLEINOEDER
 REGISTERED ENGINEER

FRONT ELEVATION
SCALE: 1"=4'-0"

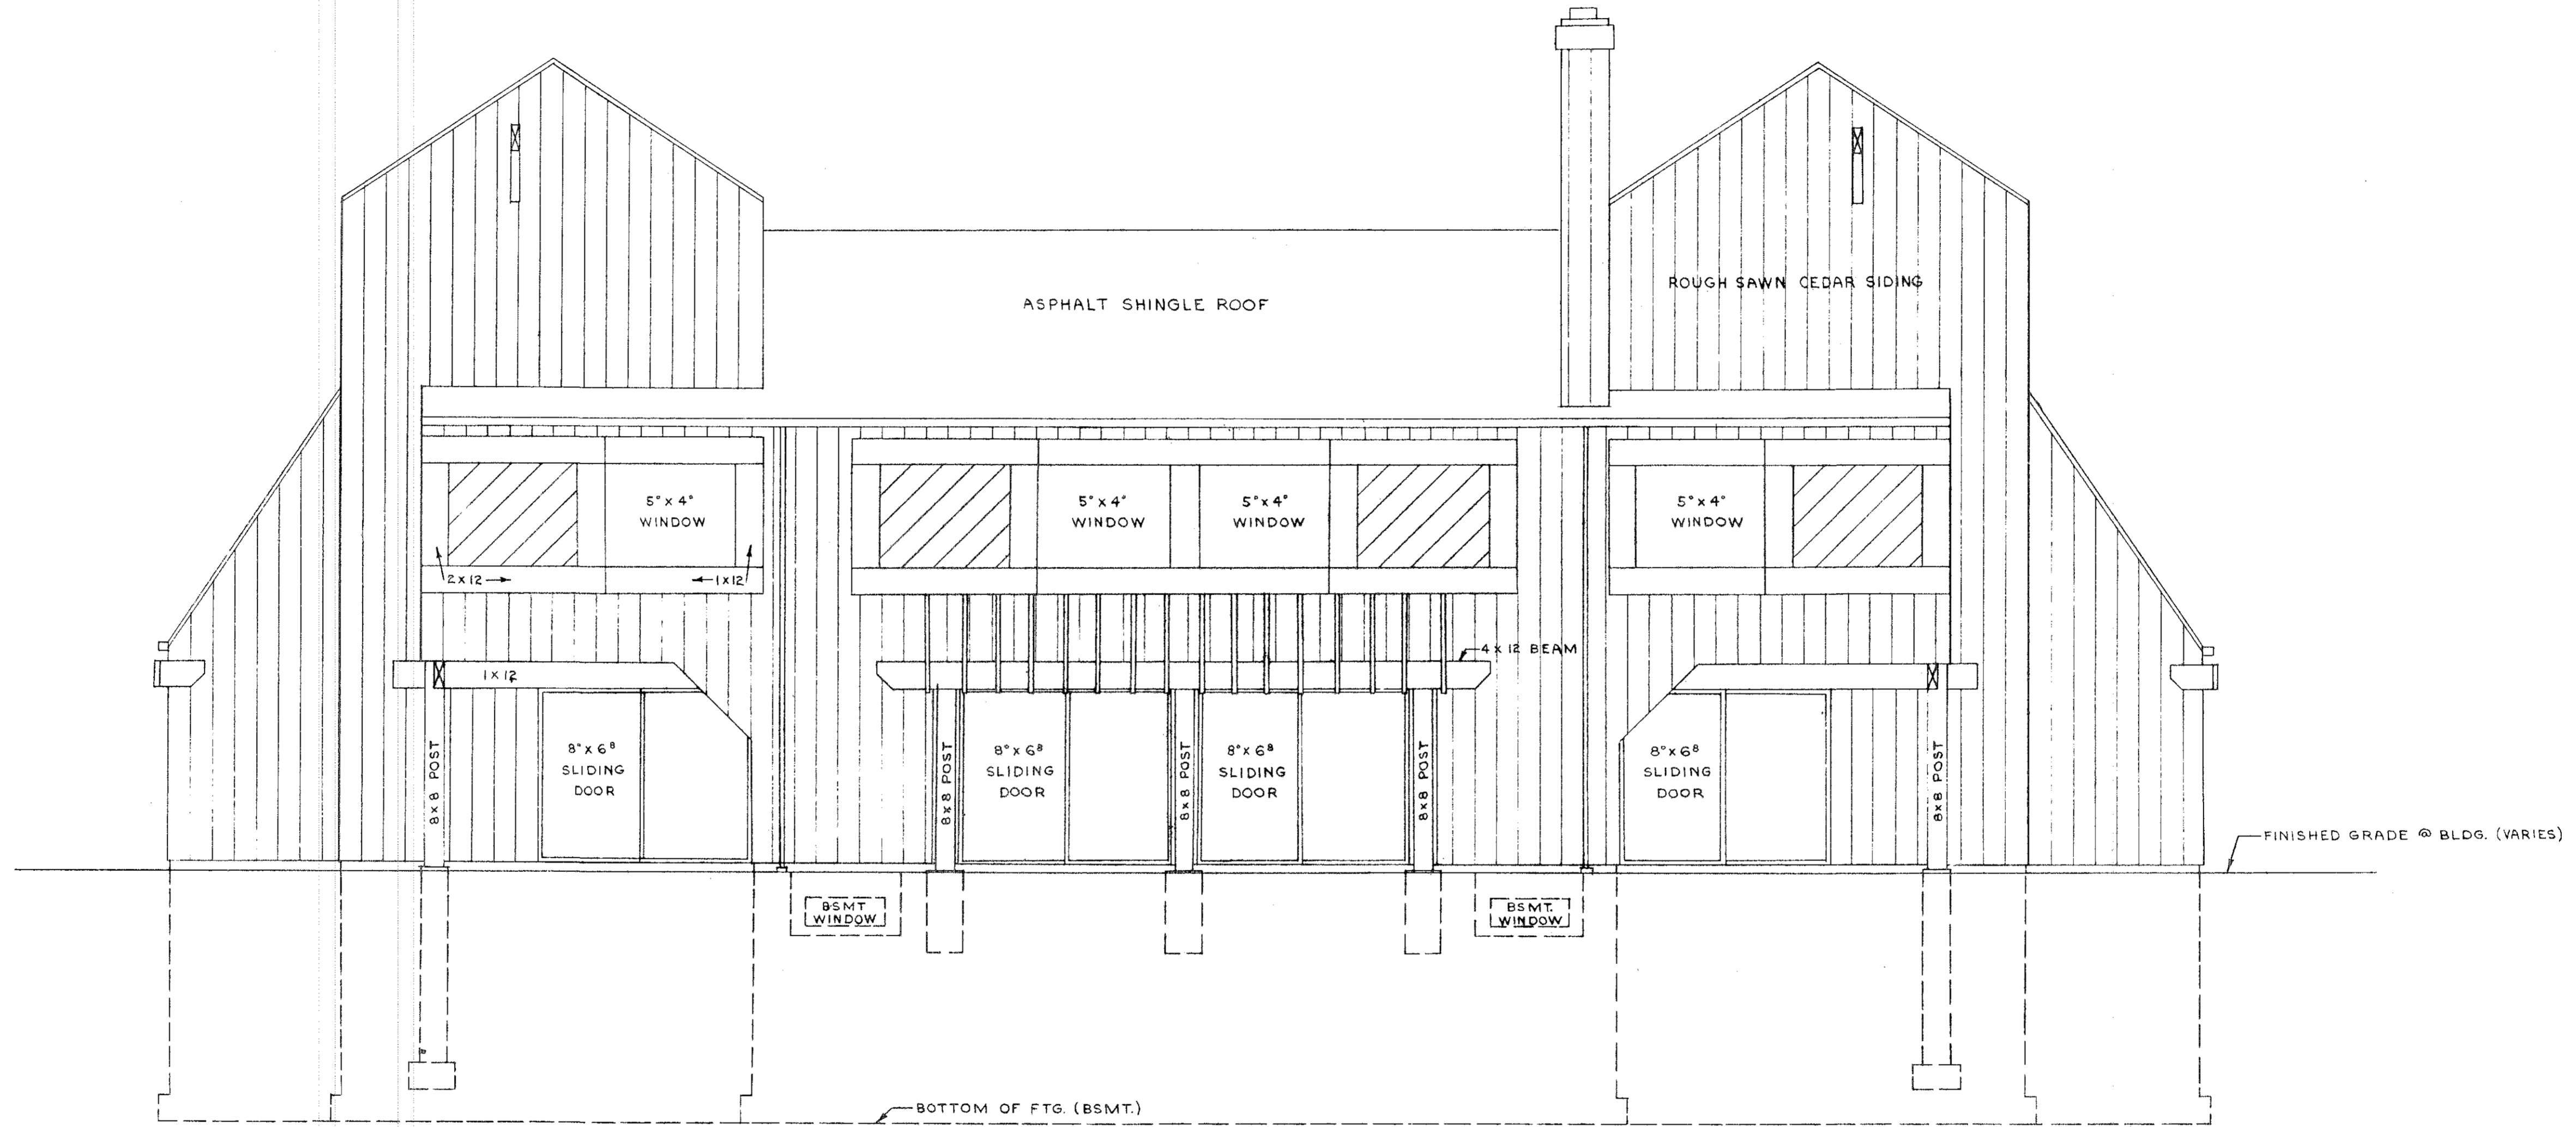


STATEMENT OF CERTIFICATION
 I CERTIFY THAT THE ATTACHED DRAWINGS CORRECTLY REPRESENT THE DIMENSIONS OF THE BUILDINGS AS CONSTRUCTED AND THAT THERE ARE NO ENCROACHMENTS ON ANY ABUTTING PREMISES EXCEPT AS SHOWN.

James H. Schmidt
 JAMES H. SCHMIDT
 REGISTERED SURVEYOR

STATEMENT OF CERTIFICATION
 I CERTIFY THAT THE ATTACHED DRAWINGS CORRECTLY REPRESENT THE DIMENSIONS OF THE BUILDINGS AS CONSTRUCTED.

Robert E. Klejoeder
 ROBERT E. KLEJOEDER
 REGISTERED ENGINEER

REAR ELEVATION
 SCALE: 1" = 4'0"

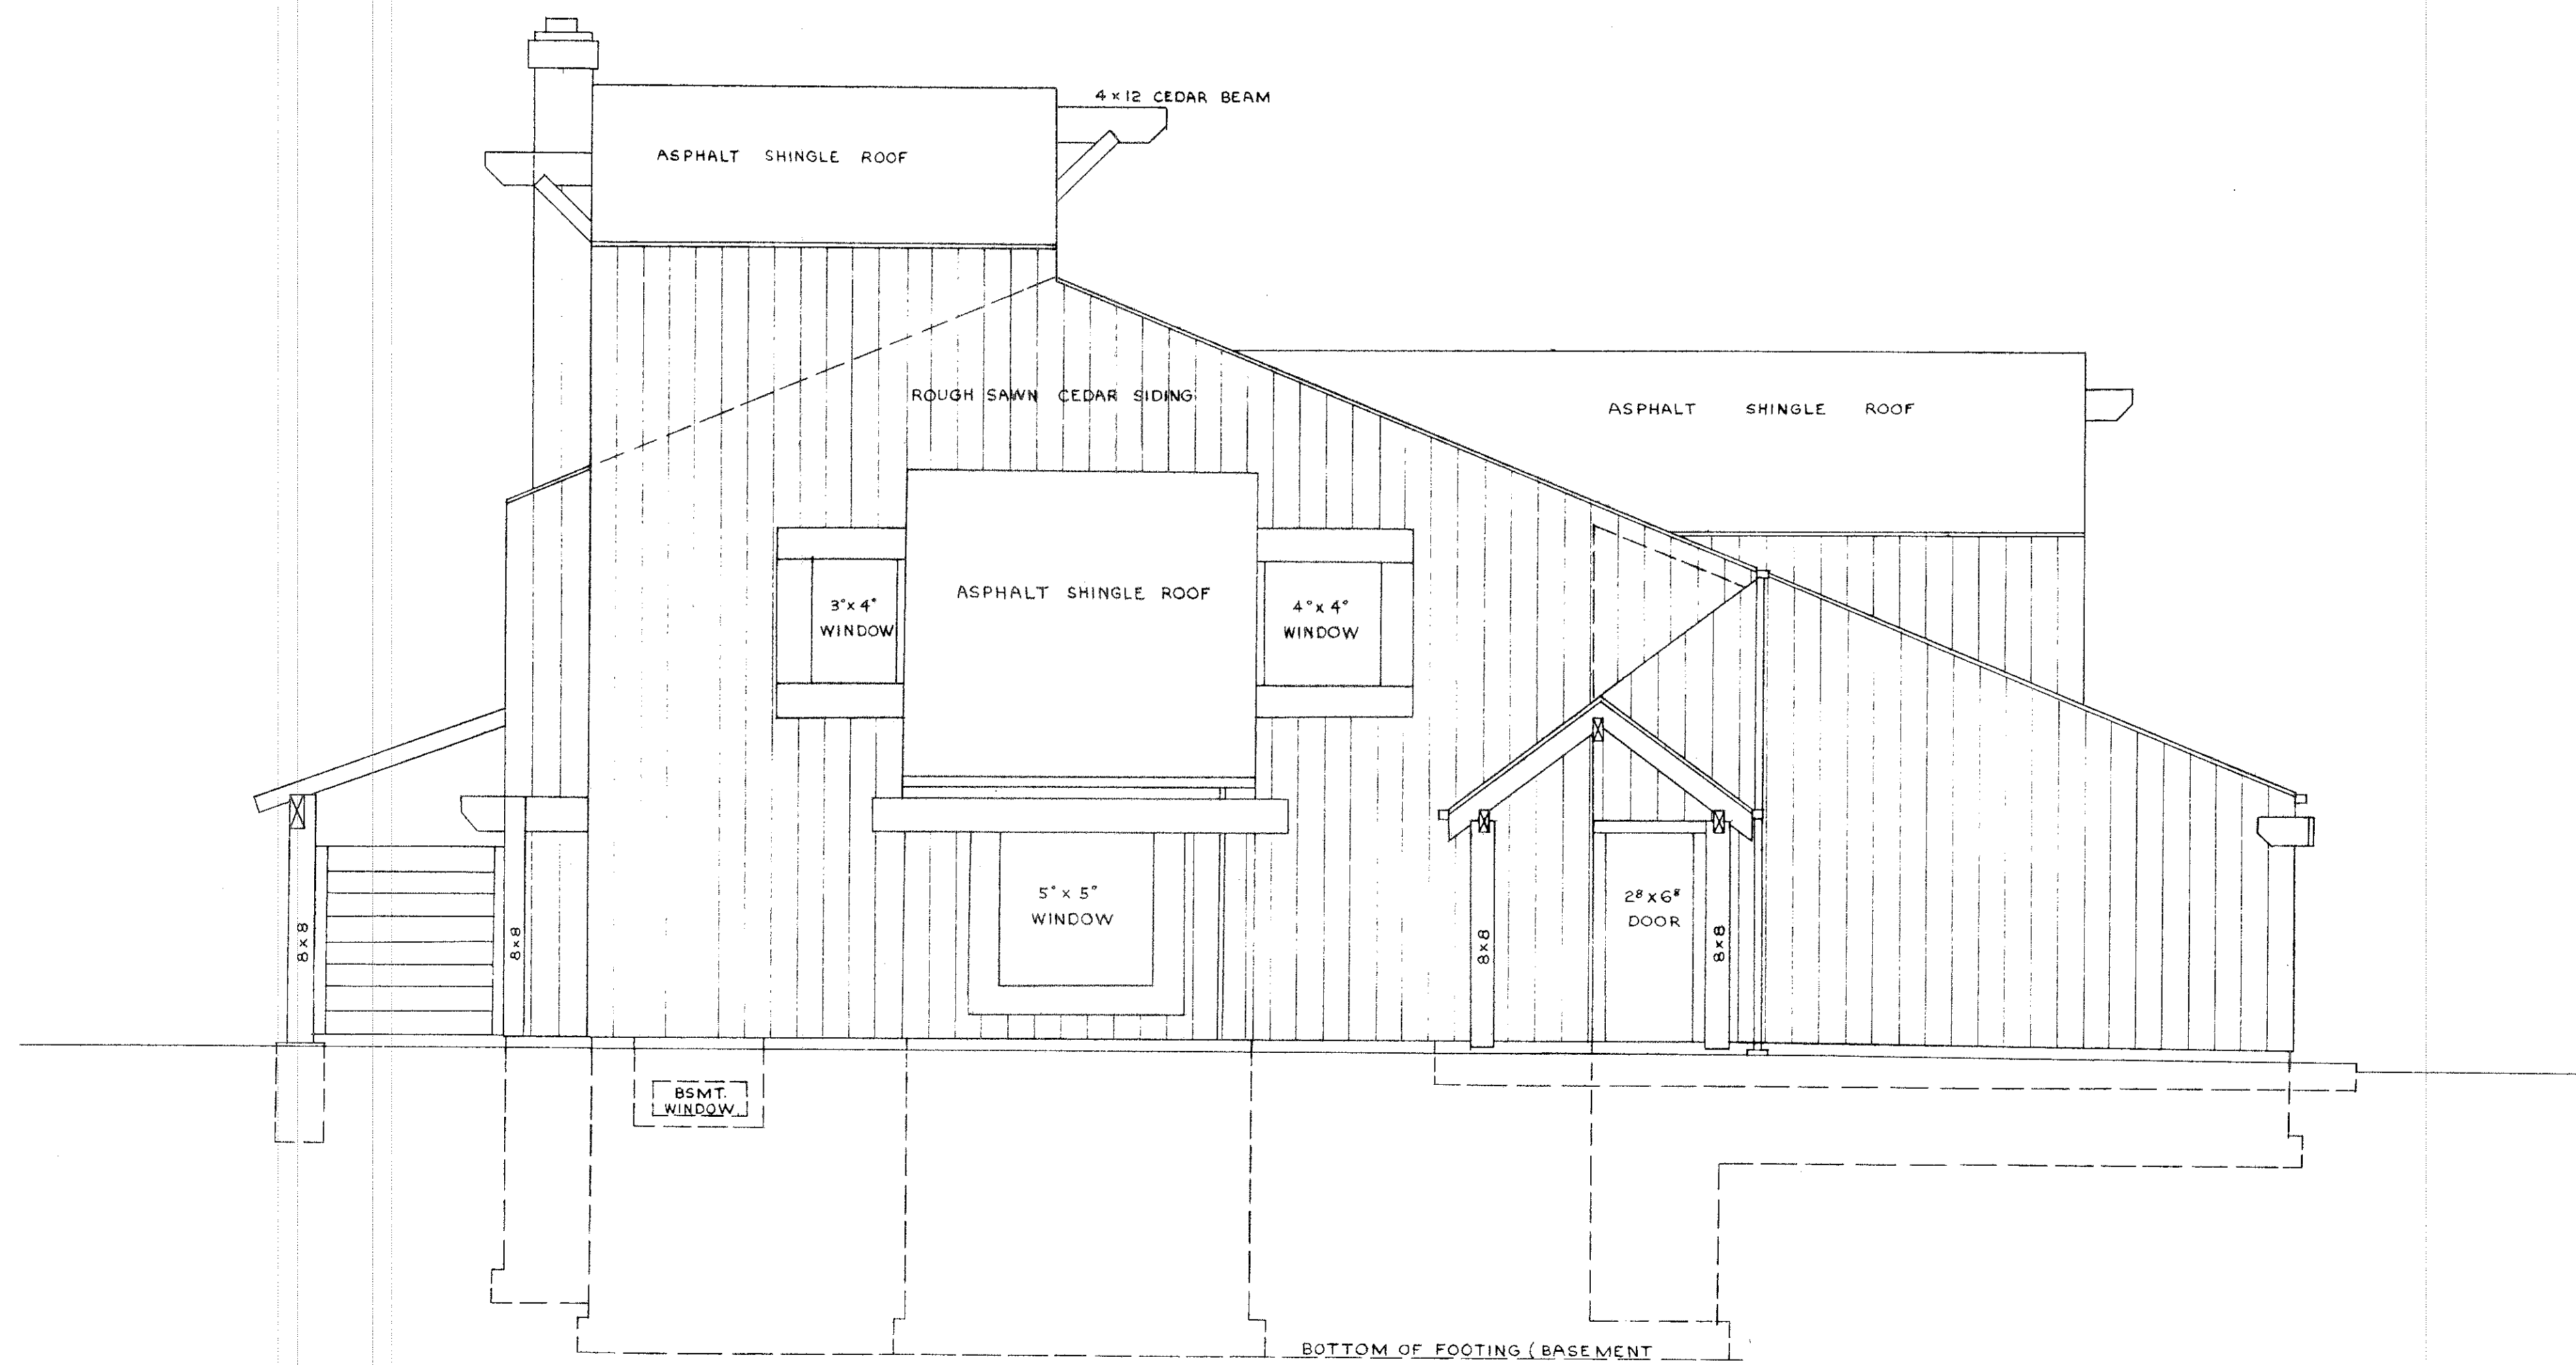


STATEMENT OF CERTIFICATION
I CERTIFY THAT THE ATTACHED DRAWINGS CORRECTLY REPRESENT THE DIMENSIONS OF THE BUILDINGS AS CONSTRUCTED AND THAT THERE ARE NO ENCROACHMENTS ON ANY ABUTTING PREMISES EXCEPT AS SHOWN.

James H. Schmidt
JAMES H. SCHMIDT
REGISTERED SURVEYOR

STATEMENT OF CERTIFICATION
I CERTIFY THAT THE ATTACHED DRAWINGS CORRECTLY REPRESENT THE DIMENSIONS OF THE BUILDINGS AS CONSTRUCTED.

Robert E. Kleinoeder
ROBERT E. KLEINOEDER
REGISTERED ENGINEER

LEFT SIDE ELEVATION
SCALE: 1" = 4'0"

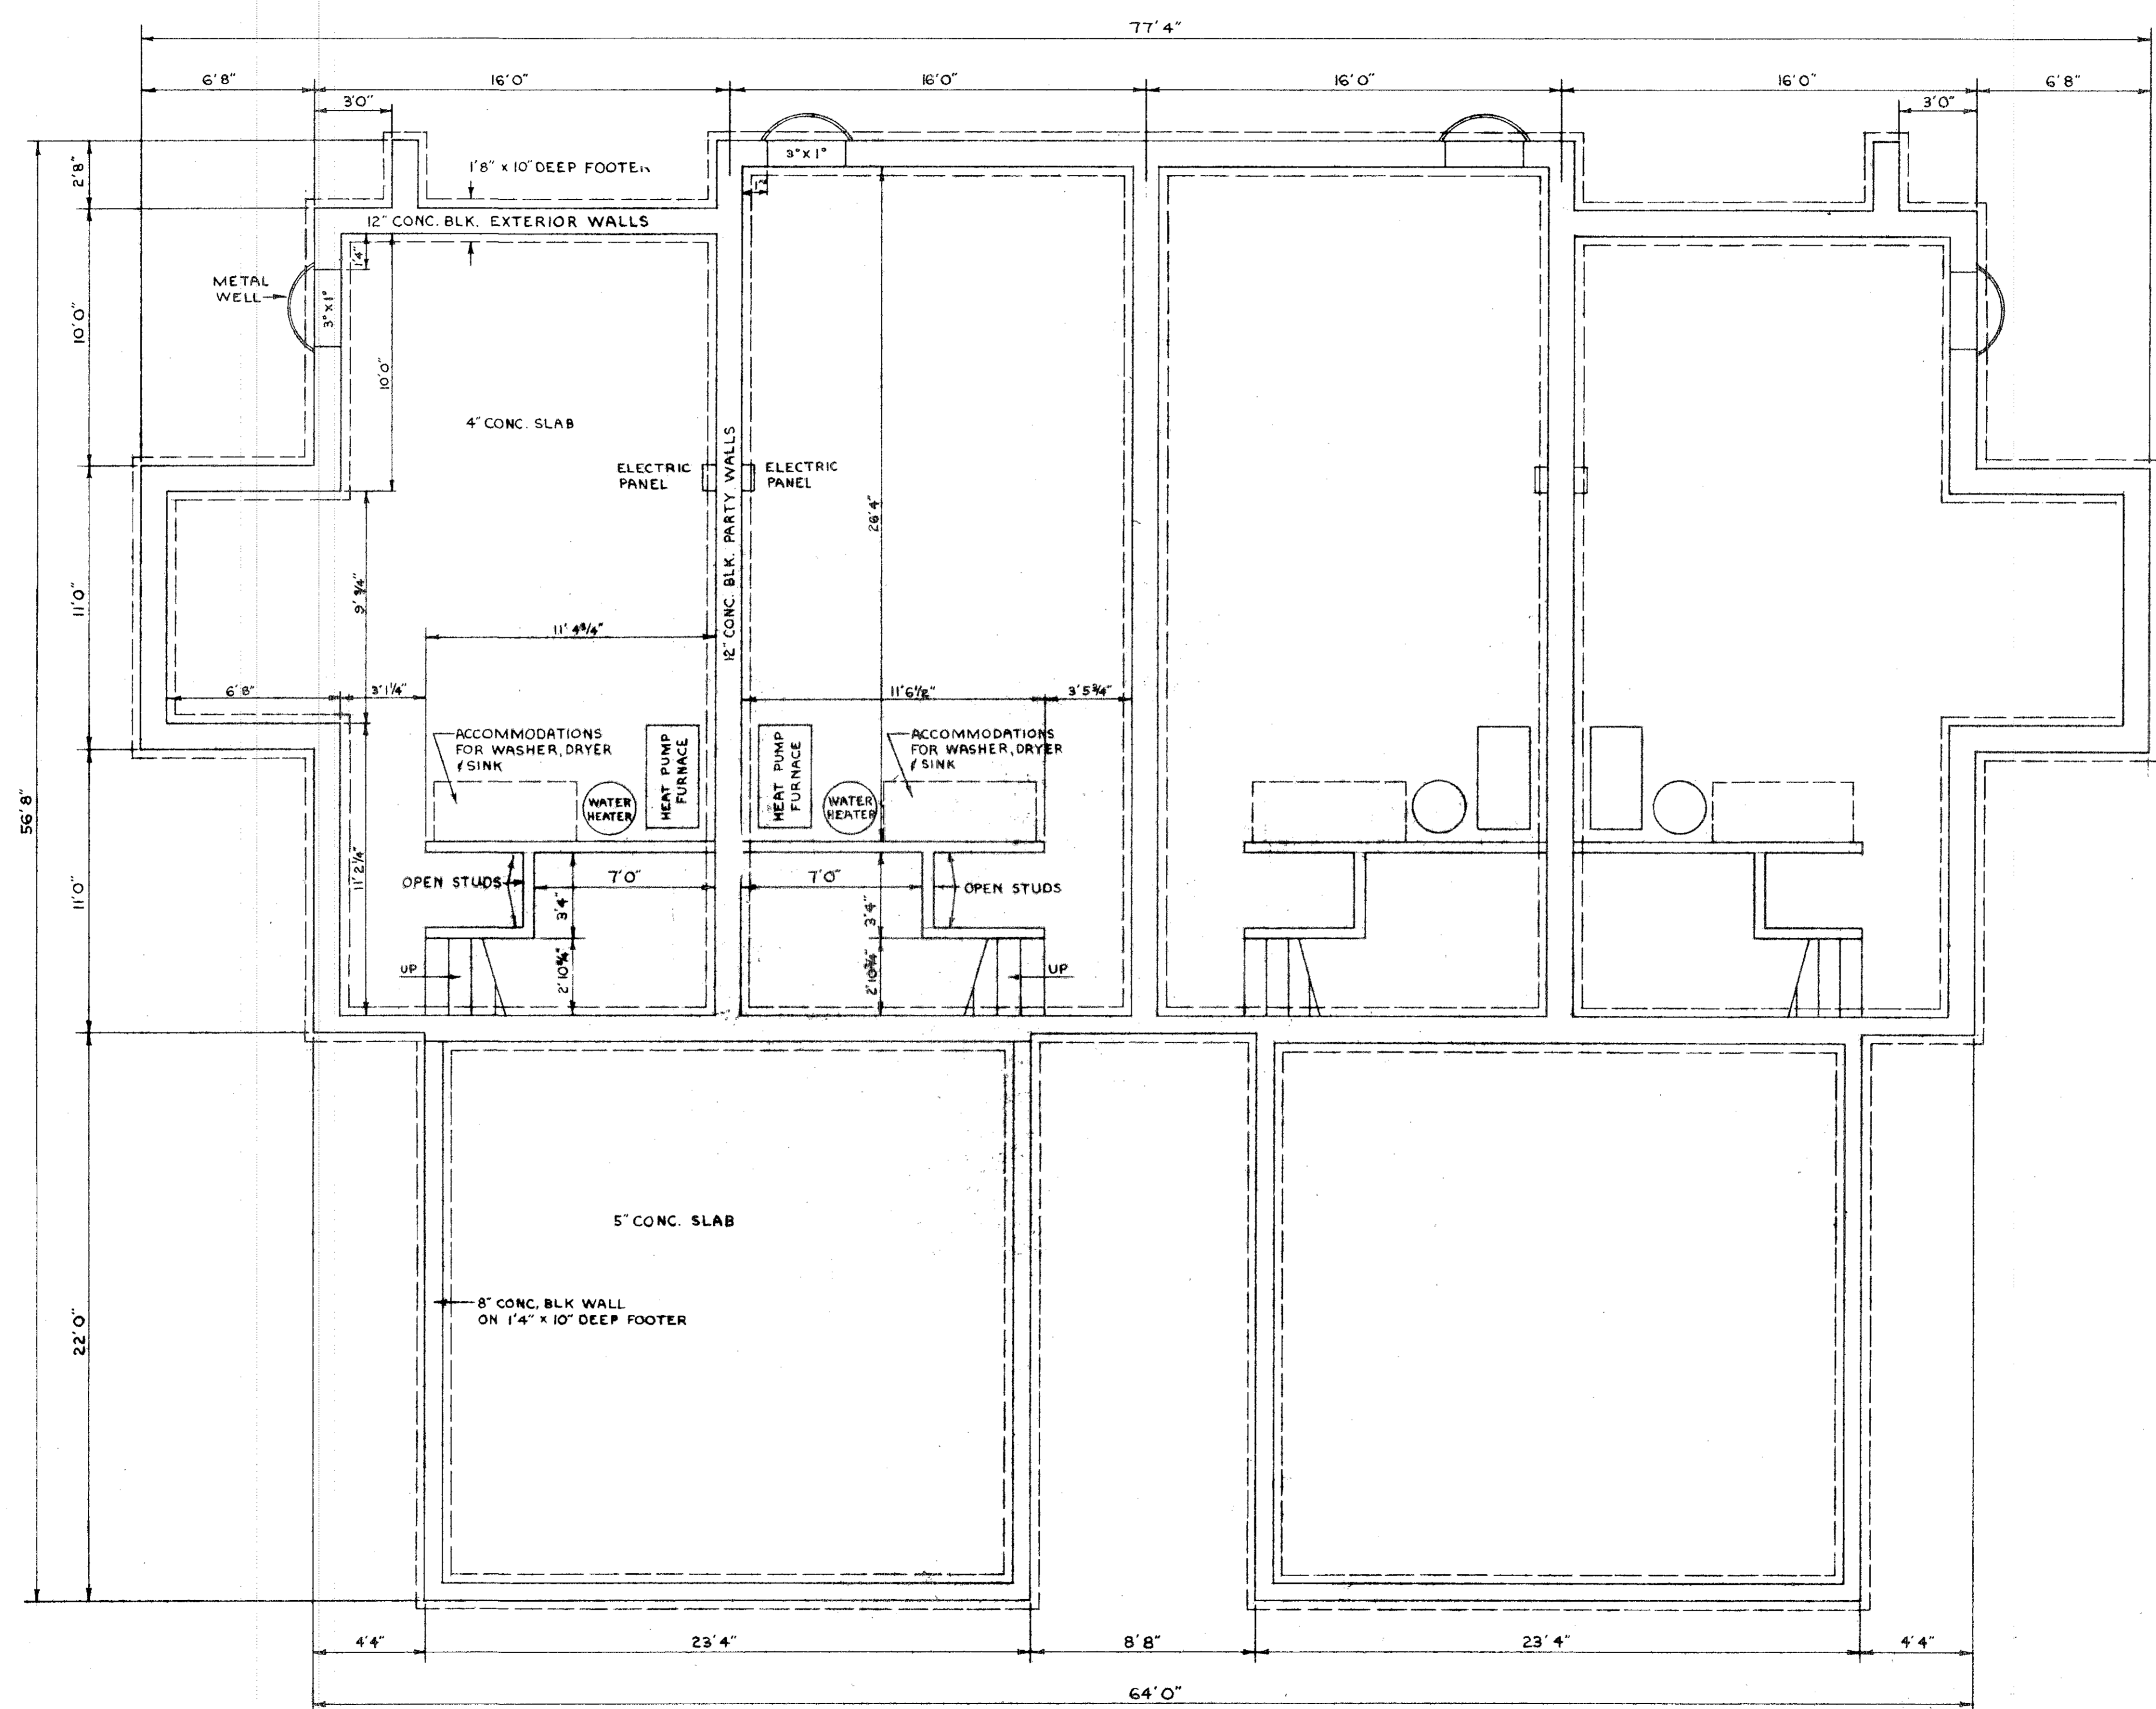


STATEMENT OF CERTIFICATION
I CERTIFY THAT THE ATTACHED DRAWINGS CORRECTLY REPRESENT THE DIMENSIONS OF THE BUILDINGS AS CONSTRUCTED AND THAT THERE ARE NO ENCROACHMENTS ON ANY ABUTTING PREMISES EXCEPT AS SHOWN.

James H. Schmidt
JAMES H. SCHMIDT
REGISTERED SURVEYOR


STATEMENT OF CERTIFICATION
I CERTIFY THAT THE ATTACHED DRAWINGS CORRECTLY REPRESENT THE DIMENSIONS OF THE BUILDINGS AS CONSTRUCTED.

Robert E. Kleinoeder
ROBERT E. KLEINOEDER
REGISTERED ENGINEER

FOUNDATION & BASEMENT PLAN
SCALE: 1"=4'0"

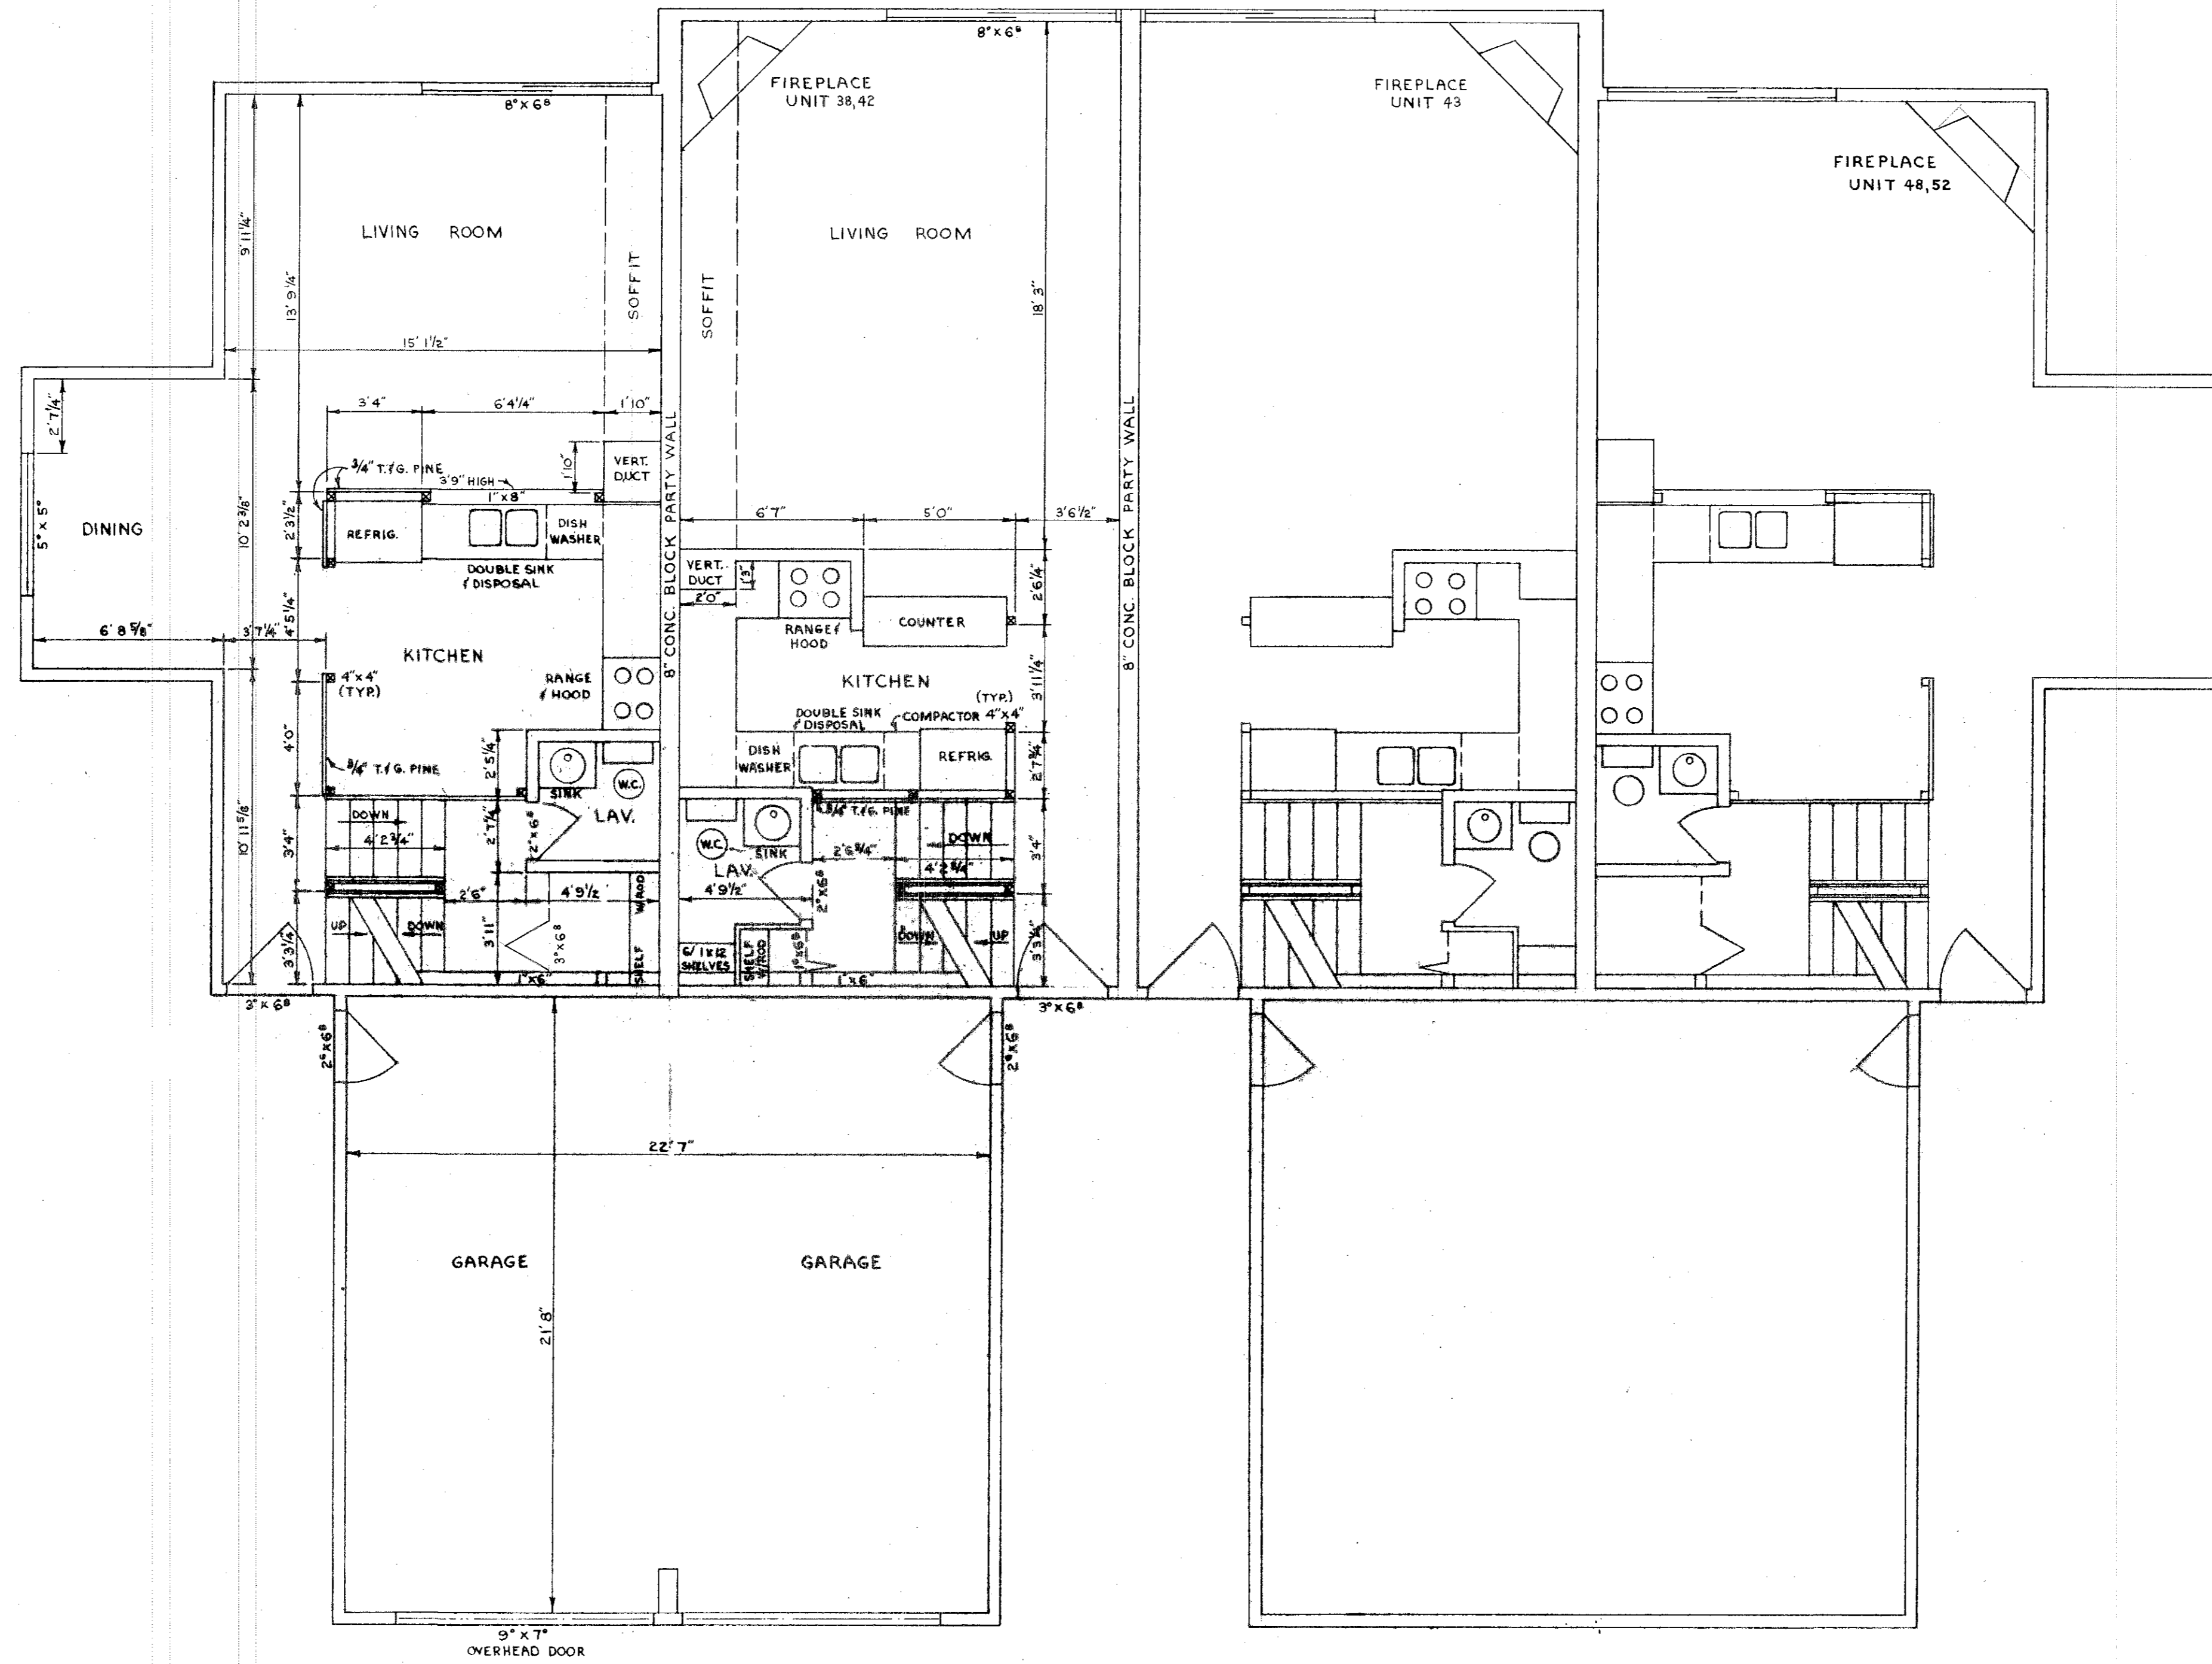

STATEMENT OF CERTIFICATION
 I CERTIFY THAT THE ATTACHED DRAWINGS CORRECTLY REPRESENT THE DIMENSIONS OF THE BUILDINGS AS CONSTRUCTED AND THAT THERE ARE NO ENCROACHMENTS ON ANY ABUTTING PREMISES EXCEPT AS SHOWN.

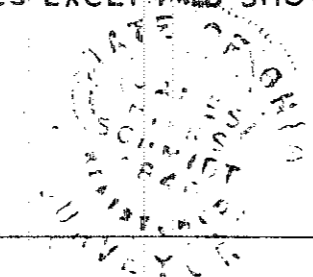


James H. Schmidt
 JAMES H. SCHMIDT
 REGISTERED SURVEYOR

STATEMENT OF CERTIFICATION
 I CERTIFY THAT THE ATTACHED DRAWING CORRECTLY REPRESENT THE DIMENSIONS OF THE BUILDINGS AS CONSTRUCTED

Robert E. Kleinoeder
 ROBERT E. KLEINOEDER
 REGISTERED ENGINEER

FIRST FLOOR PLAN
 SCALE: 1" = 4'-0"

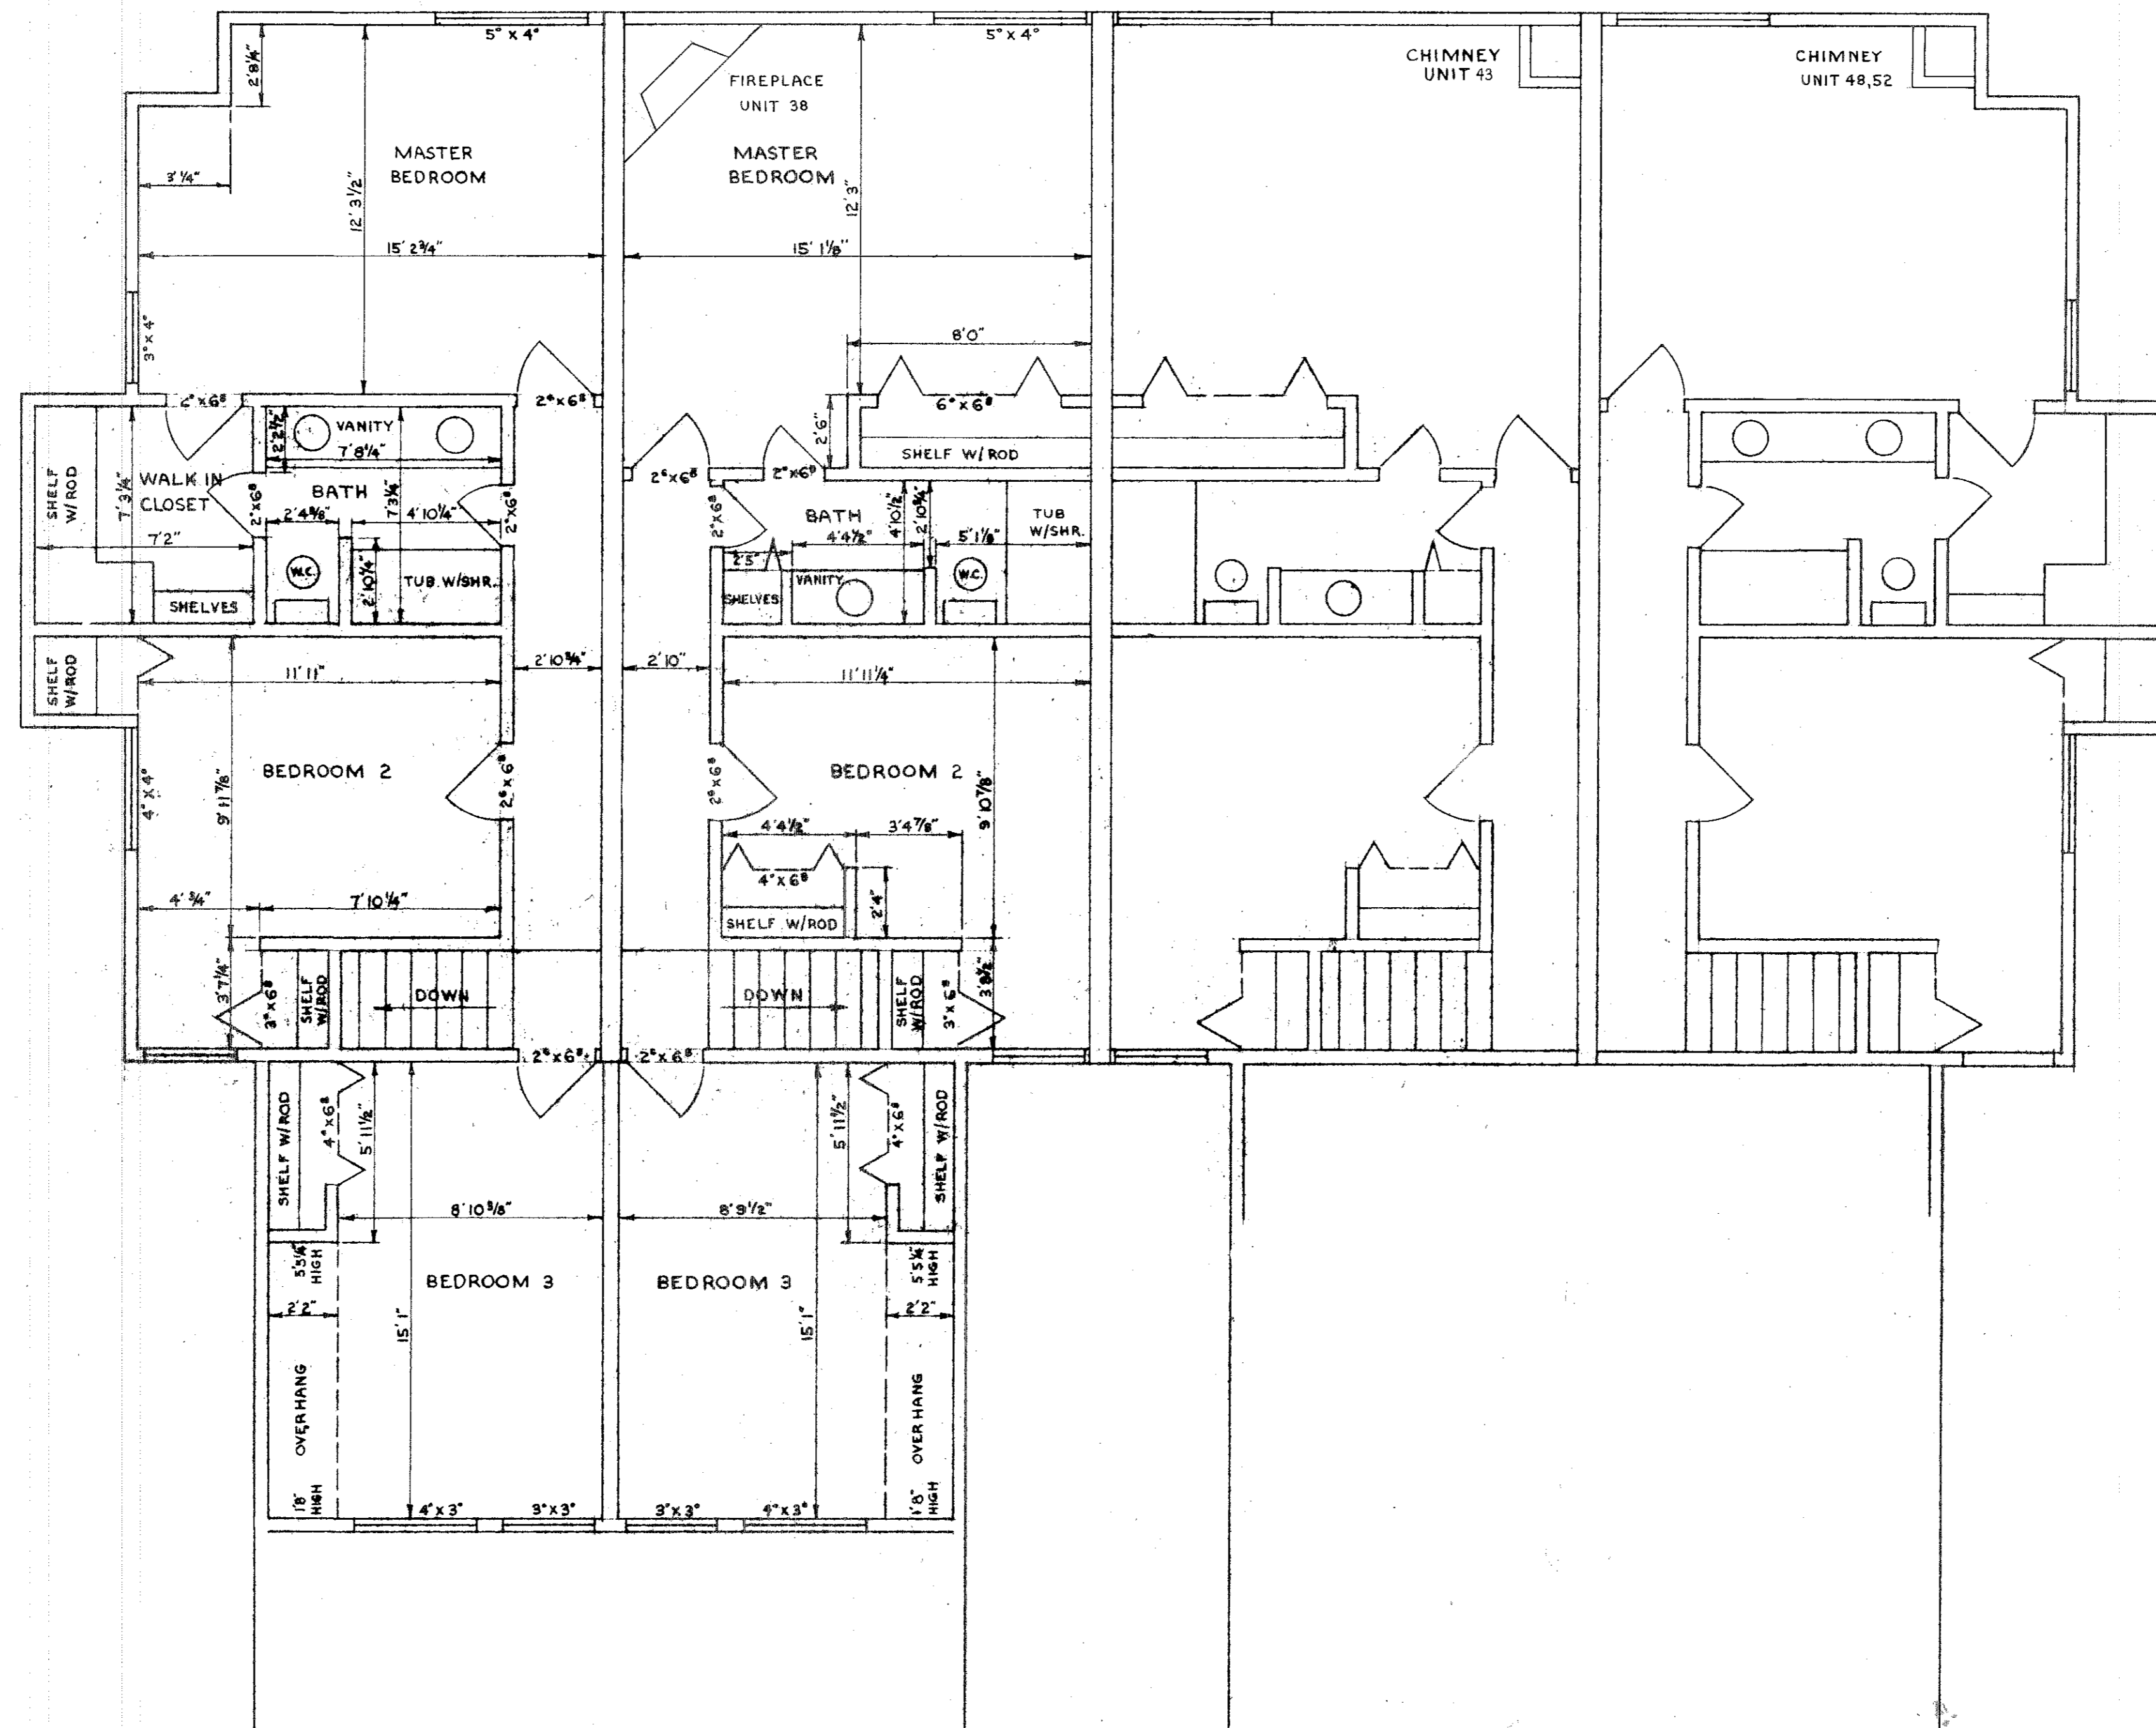

STATEMENT OF CERTIFICATION
 I CERTIFY THAT THE ATTACHED DRAWINGS CORRECTLY REPRESENT THE DIMENSIONS OF THE BUILDINGS AS CONSTRUCTED AND THAT THERE ARE NO ENCROACHMENTS ON ANY ABUTTING PREMISES EXCEPT AS SHOWN.

James H. Schmidt
JAMES H. SCHMIDT
 REGISTERED SURVEYOR

STATEMENT OF CERTIFICATION
 I CERTIFY THAT THE ATTACHED DRAWINGS CORRECTLY REPRESENT THE DIMENSIONS OF THE BUILDINGS AS CONSTRUCTED.

Robert E. Kleinoeder
ROBERT E. KLEINOEDER
 REGISTERED ENGINEER

SECOND FLOOR PLAN
 SCALE: 1" = 4'0"