



969526

THE LANDINGS
CONDOMINIUM NO.1
P.V.32 P.16-23

THE LANDINGS
CONDOMINIUM NO.3
P.V.32 P.61-68

THE LANDINGS SUBDIVISION NO.3
P.V.33 P.11-13

THE LANDINGS
CONDOMINIUM NO.2
P.V.32 P.53-60

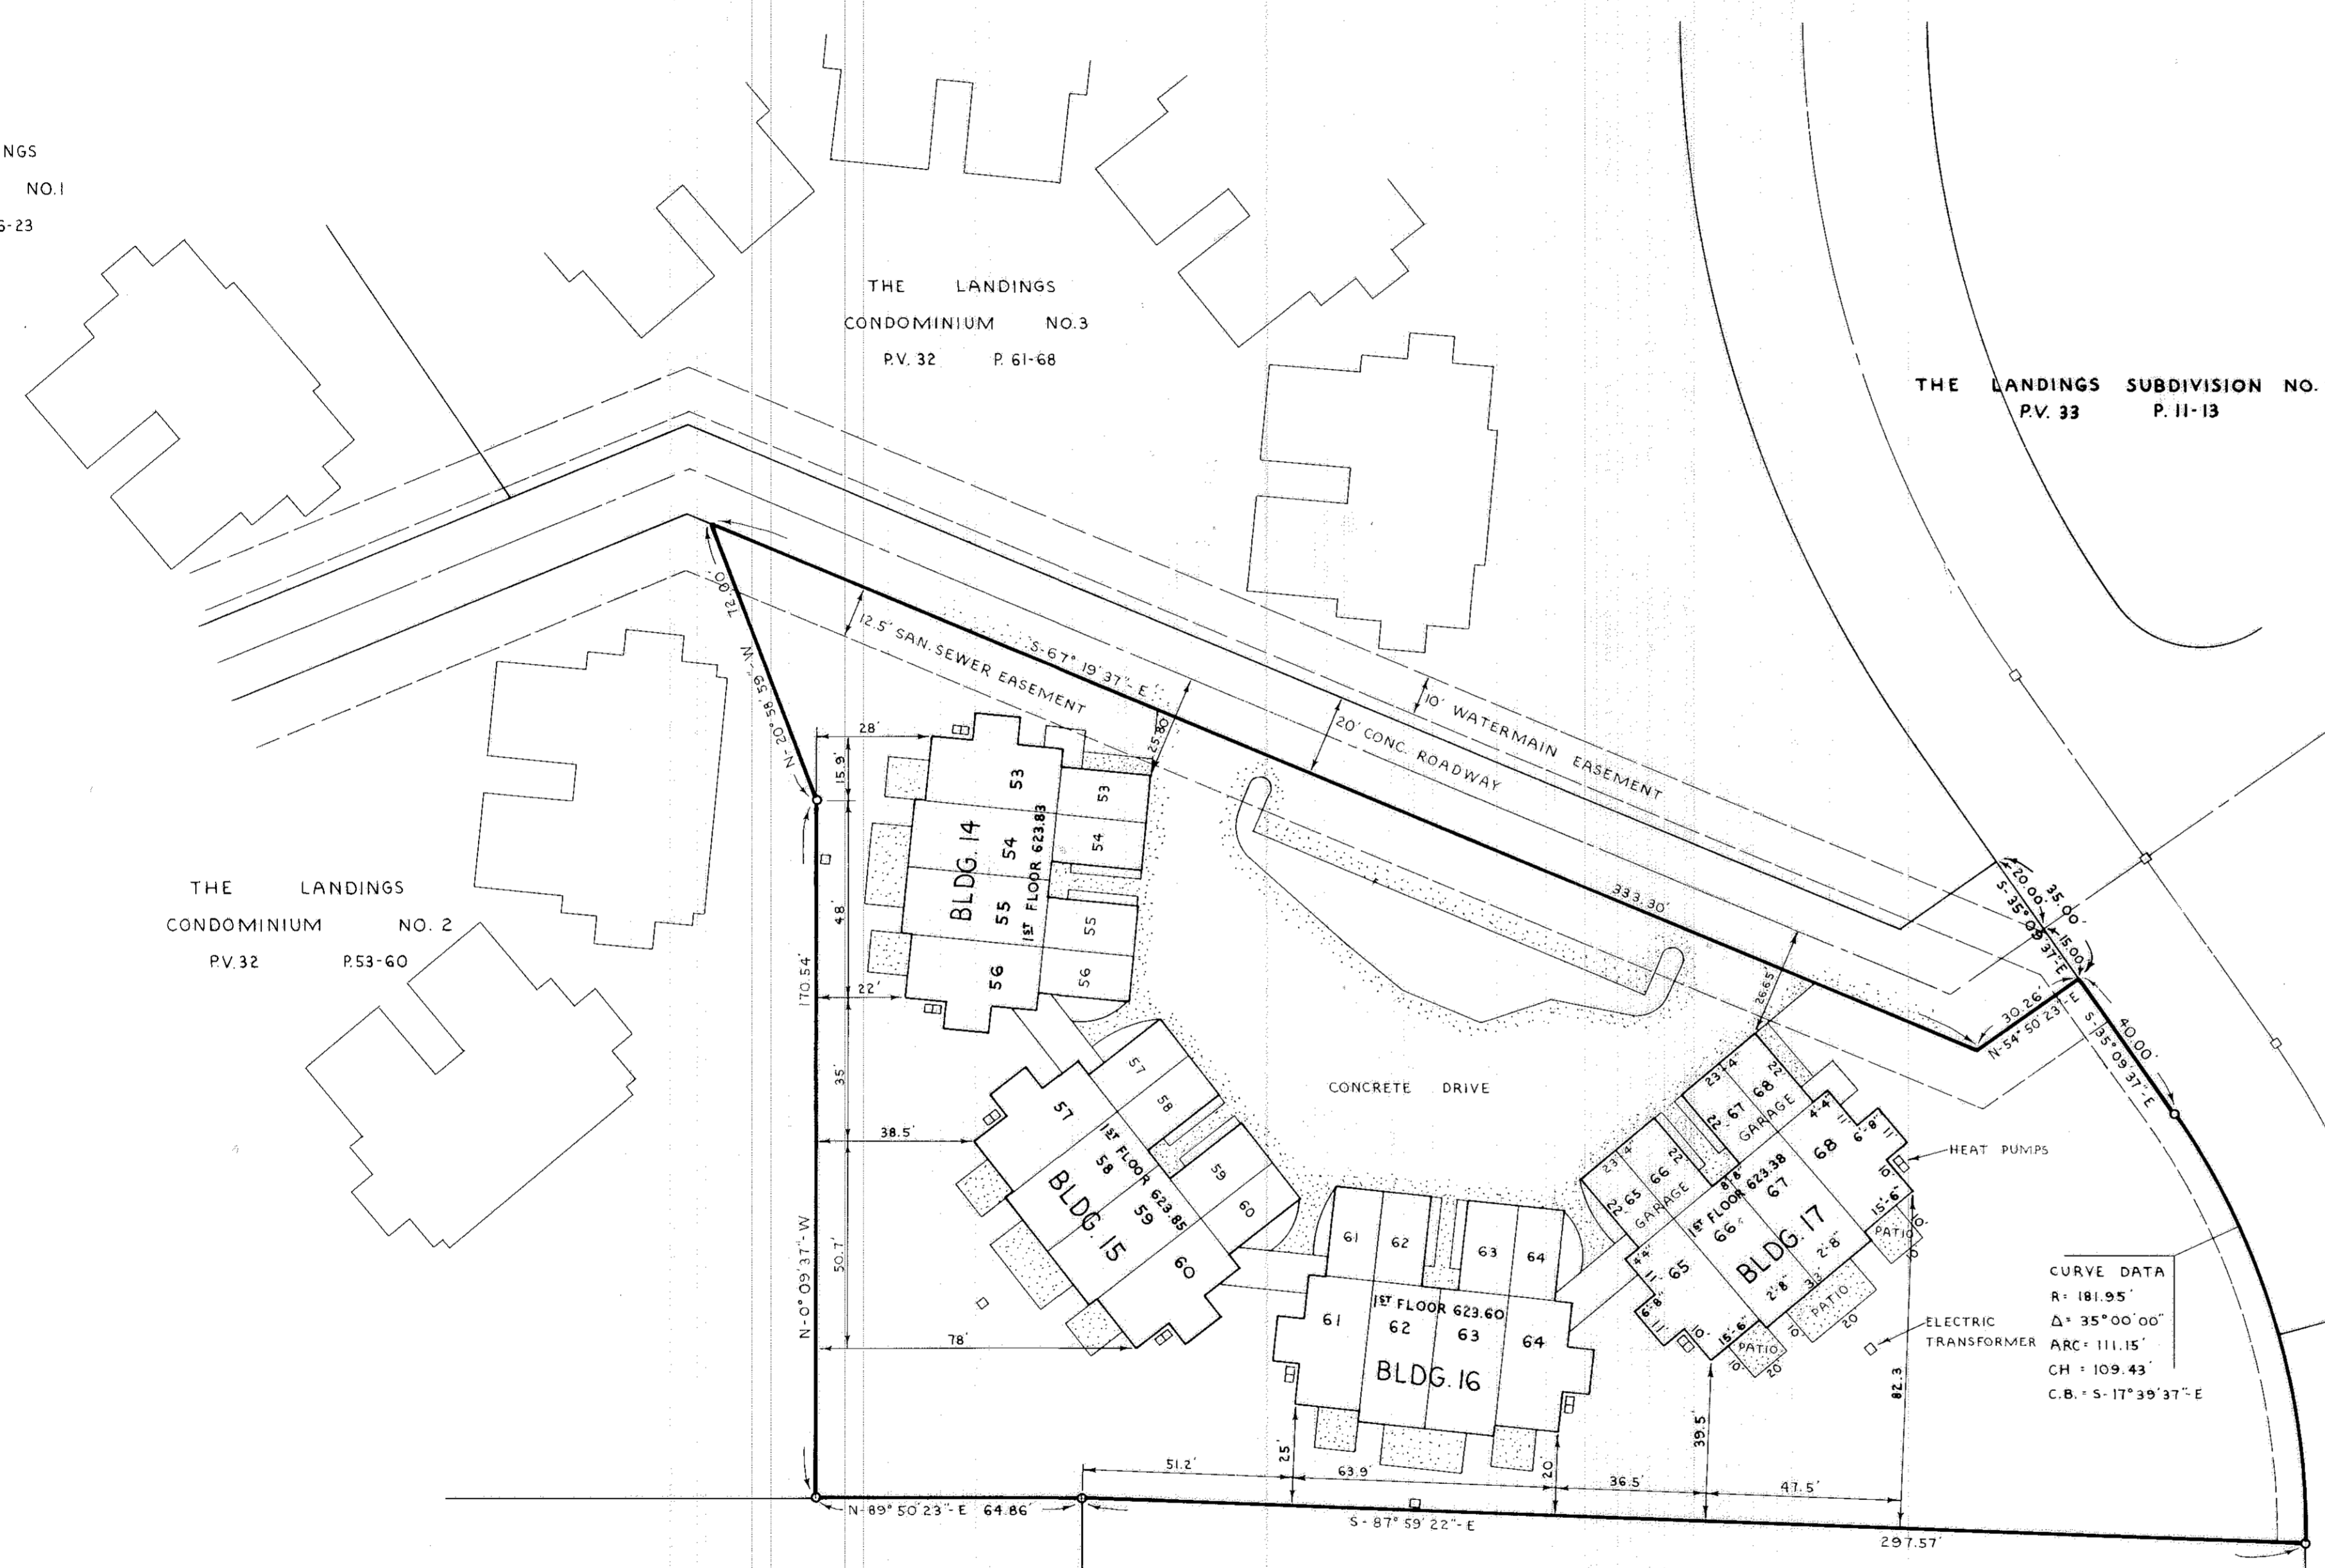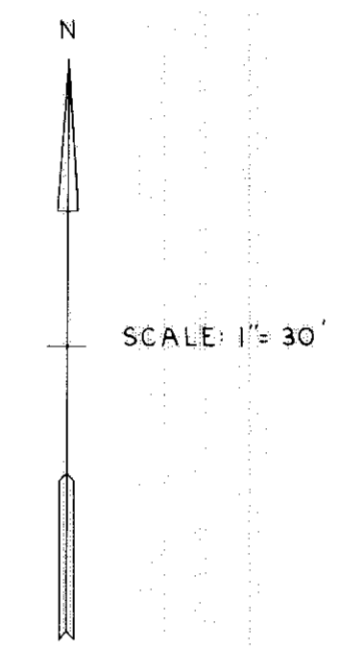

THE LANDINGS RACQUET AND SWIM CLUB
3.467 AC.

NOTE: DIMENSIONS SHOWN FOR BLDG.17 ARE TYPICAL
AND SHALL ALSO APPLY TO BLDG. 14, 15 & 16.
WATERMAIN, ROADWAY & SAN SEWER EASEMENTS
ARE RECORDED IN D.V.1186 P.841

STATEMENT OF CERTIFICATION

I CERTIFY THAT THE ATTACHED DRAWINGS
CORRECTLY REPRESENT THE DIMENSIONS OF THE
BUILDINGS AS CONSTRUCTED AND THAT THERE
ARE NO ENCRAGEMENTS ON ANY ADJACENT
PREMISES.

James H. Schmidt
JAMES H. SCHMIDT REGISTERED SURVEYOR

THE LANDINGS SUBDIVISION NO.2
P.V.32 P.28-31

WOODSTOCK ST. 60'

THE LANDINGS
CONDOMINIUM NO.4

1.309 ACRES EXHIBIT 'A'
CITY OF AVON LAKE COUNTY OF LORAIN
PART OF AVON TOWNSHIP SECTION 18


Received for Record NOV. 14, 1977
at 10:38 AM in PLAT RECORD
VOL. 33
PAGE 14-21
Lorain County Register
Pages 14 thru 21 inclusive


PREPARED FOR: HERMAN R. KOPF
PREPARED BY: KLEINOEDER-SCHMIDT & ASSOCIATES
CONSULTING ENGINEERS & SURVEYORS
ELYRIA

\$ 138.24

Box: Lorain county title

R.H.

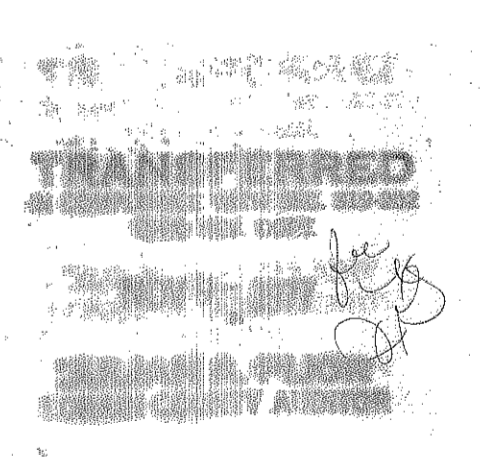

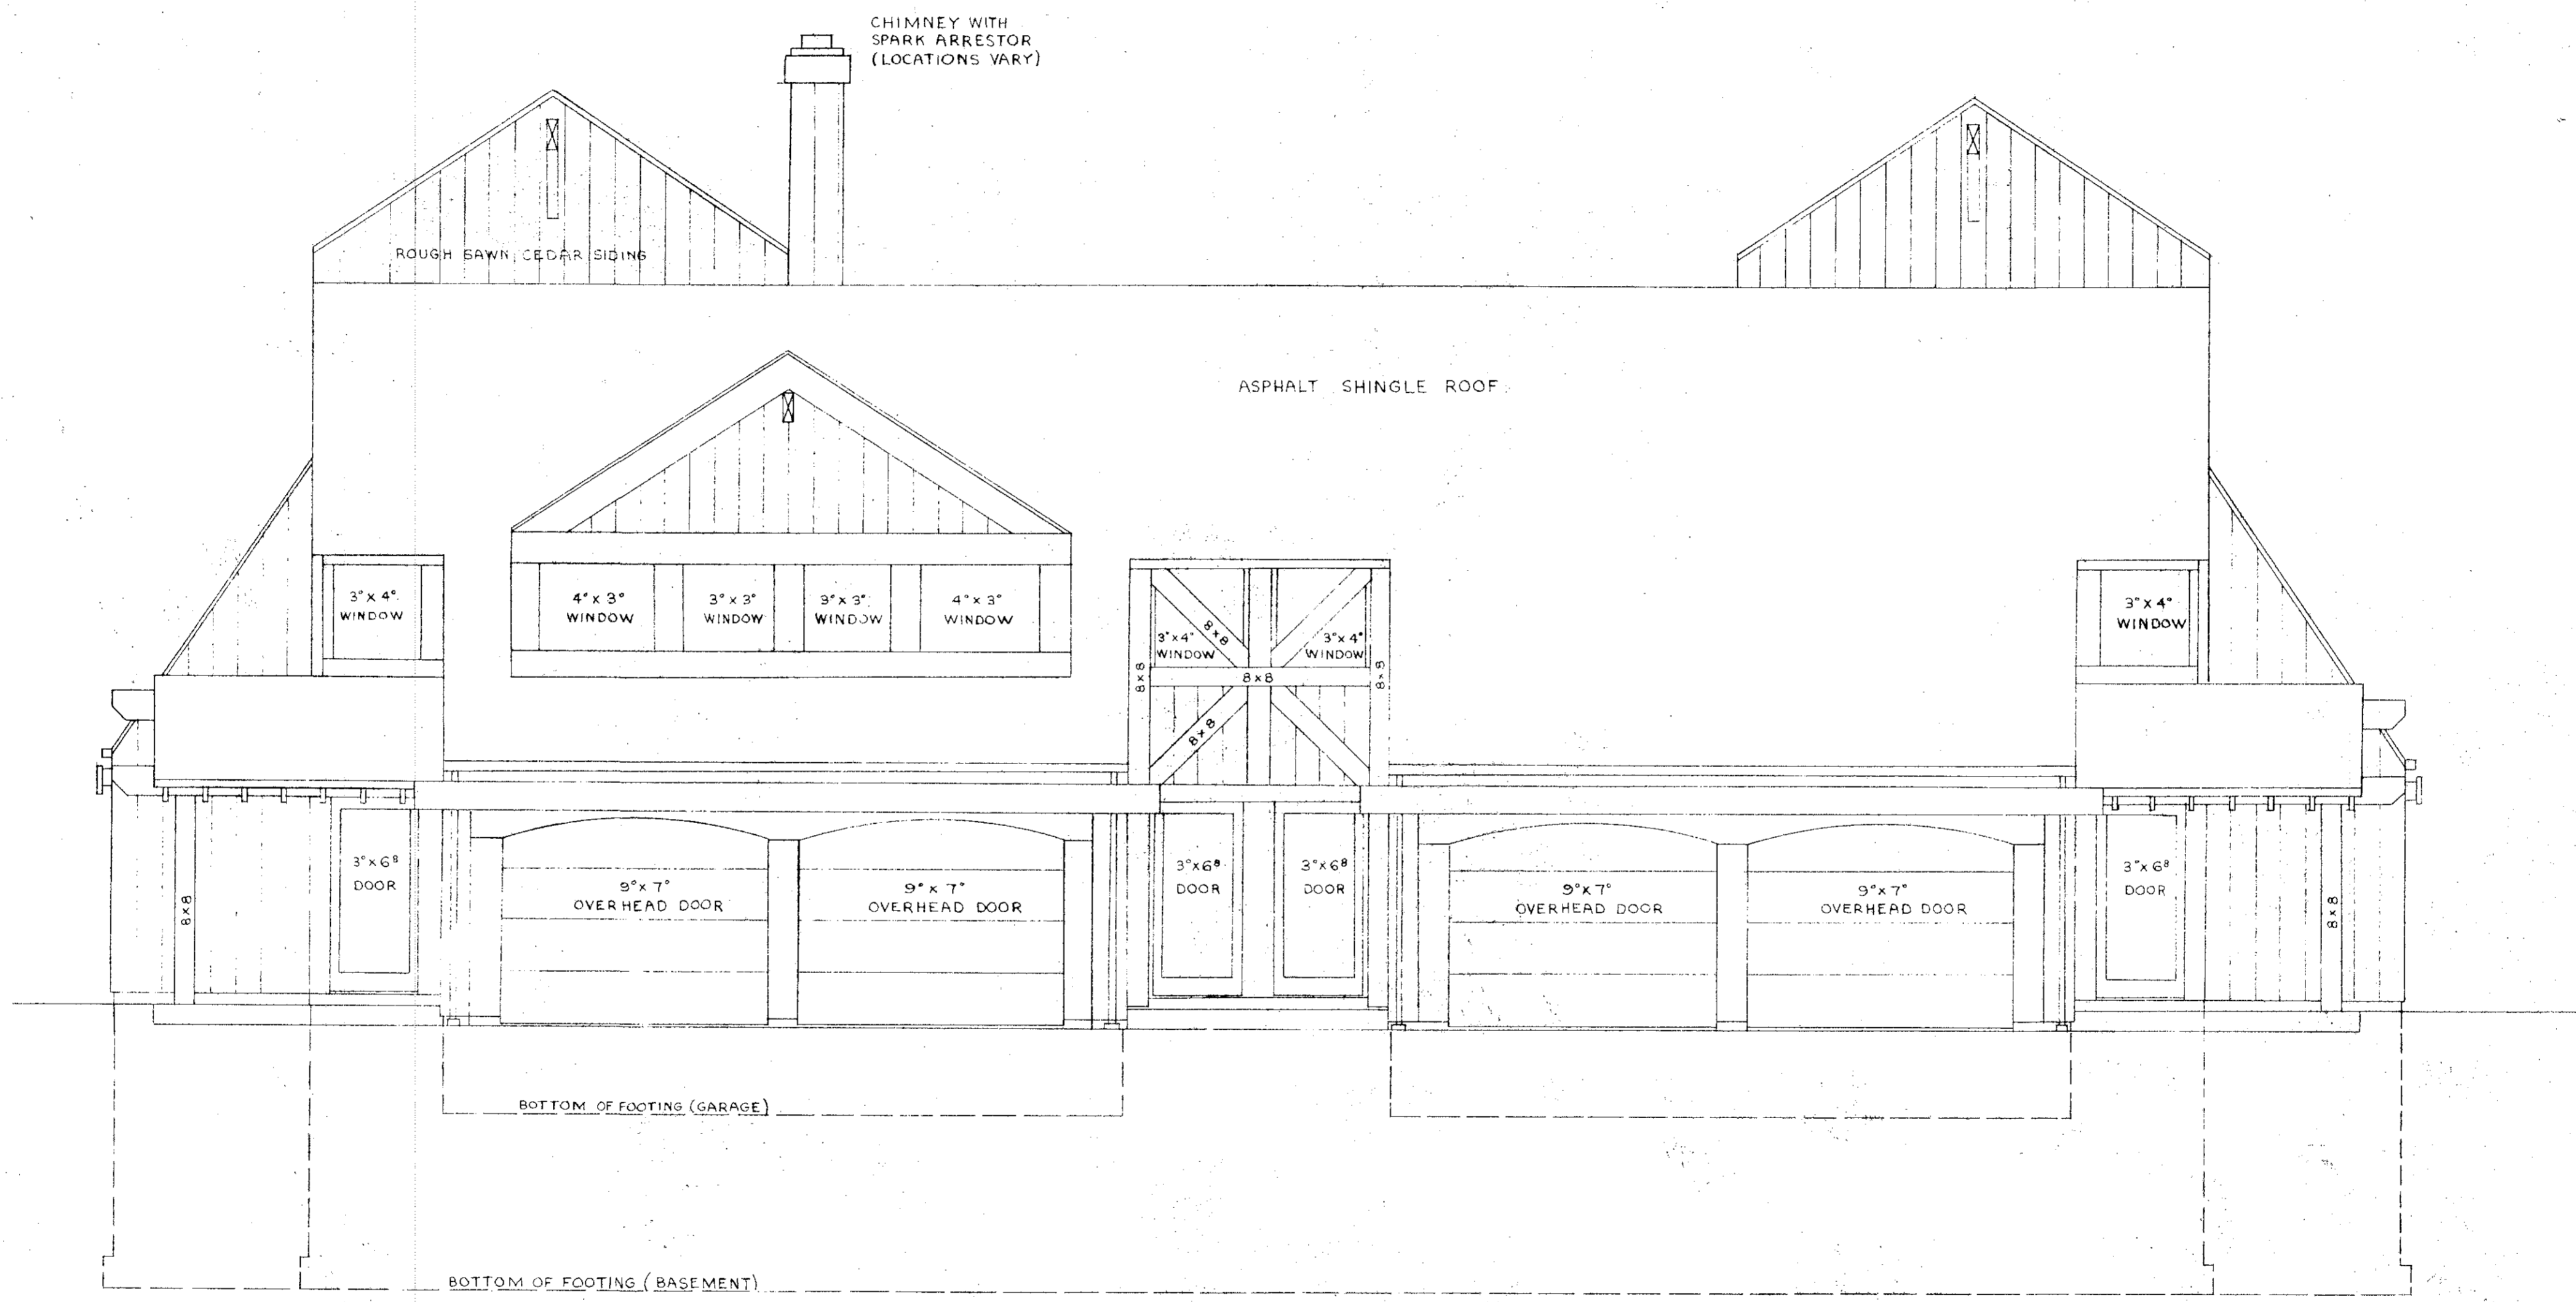


STATEMENT OF CERTIFICATION
 I CERTIFY THAT THE ATTACHED DRAWINGS CORRECTLY REPRESENT THE DIMENSIONS OF THE BUILDINGS AS CONSTRUCTED AND THAT THERE ARE NO ENCROACHMENTS ON ANY ABUTTING PREMISES EXCEPT AS SHOWN.

James H. Schmidt
 JAMES H. SCHMIDT

STATEMENT OF CERTIFICATION
 I CERTIFY THAT THE ATTACHED DRAWINGS CORRECTLY REPRESENT THE DIMENSIONS OF THE BUILDINGS AS CONSTRUCTED.

Robert E. Kleinoeder
 ROBERT E. KLEINOEDER
 REGISTERED ENGINEER

FRONT ELEVATION
 SCALE: 1" = 4'0"

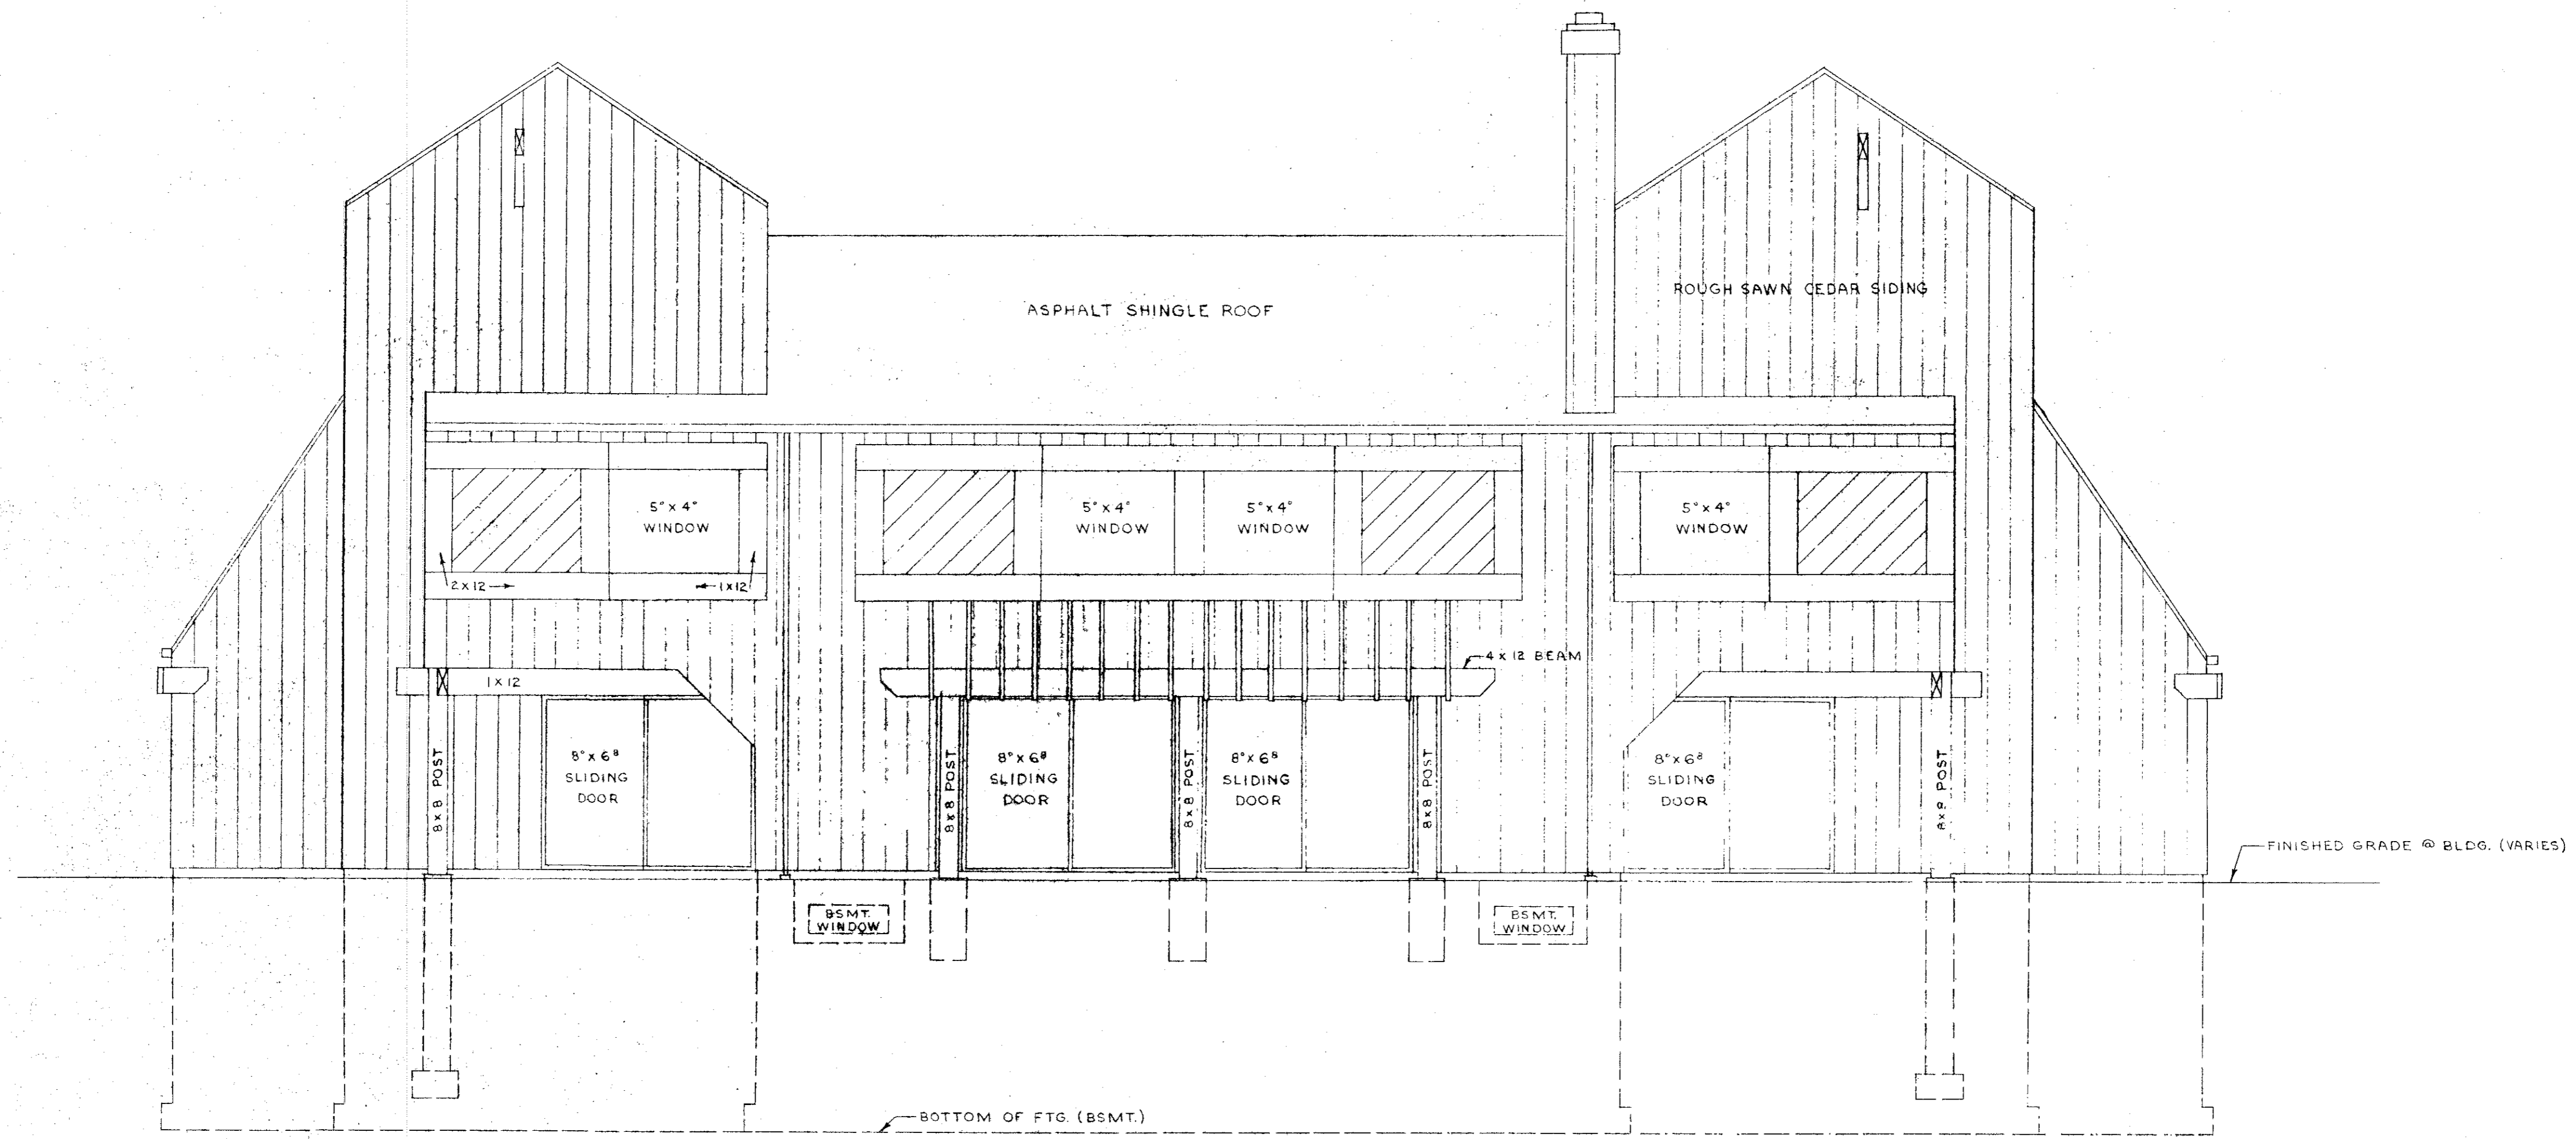

STATEMENT OF CERTIFICATION

I CERTIFY THAT THE ATTACHED DRAWINGS CORRECTLY REPRESENT THE DIMENSIONS OF THE BUILDINGS AS CONSTRUCTED AND THAT THERE ARE NO ENCROACHMENTS ON ANY ABUTTING PREMISES EXCEPT AS SHOWN.



James H. Schmidt
JAMES H. SCHMIDT
REGISTERED SURVEYOR


STATEMENT OF CERTIFICATION

I CERTIFY THAT THE ATTACHED DRAWINGS CORRECTLY REPRESENT THE DIMENSIONS OF THE BUILDINGS AS CONSTRUCTED.


Robert E. Kleinoeder
ROBERT E. KLEINOEDER
REGISTERED ENGINEER

REAR ELEVATION

SCALE: 1" = 4' 0"

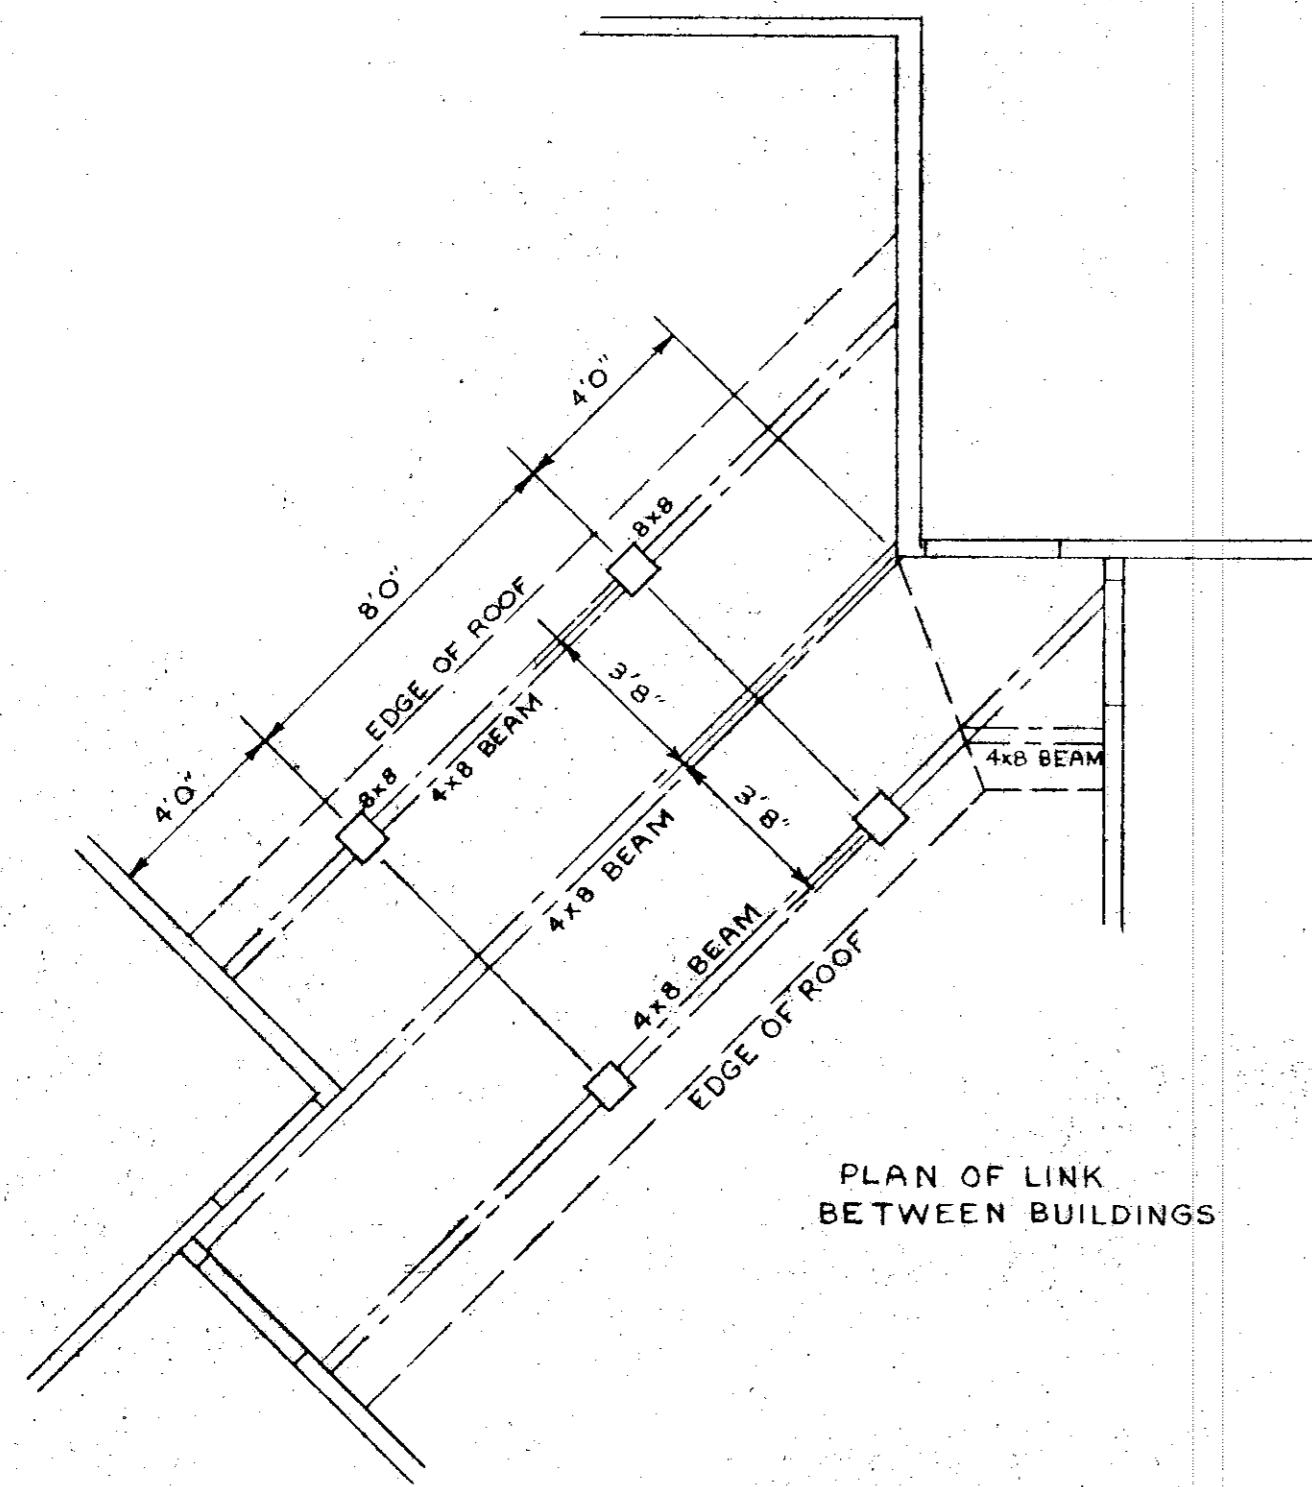


PLAN OF LINK BETWEEN BUILDINGS

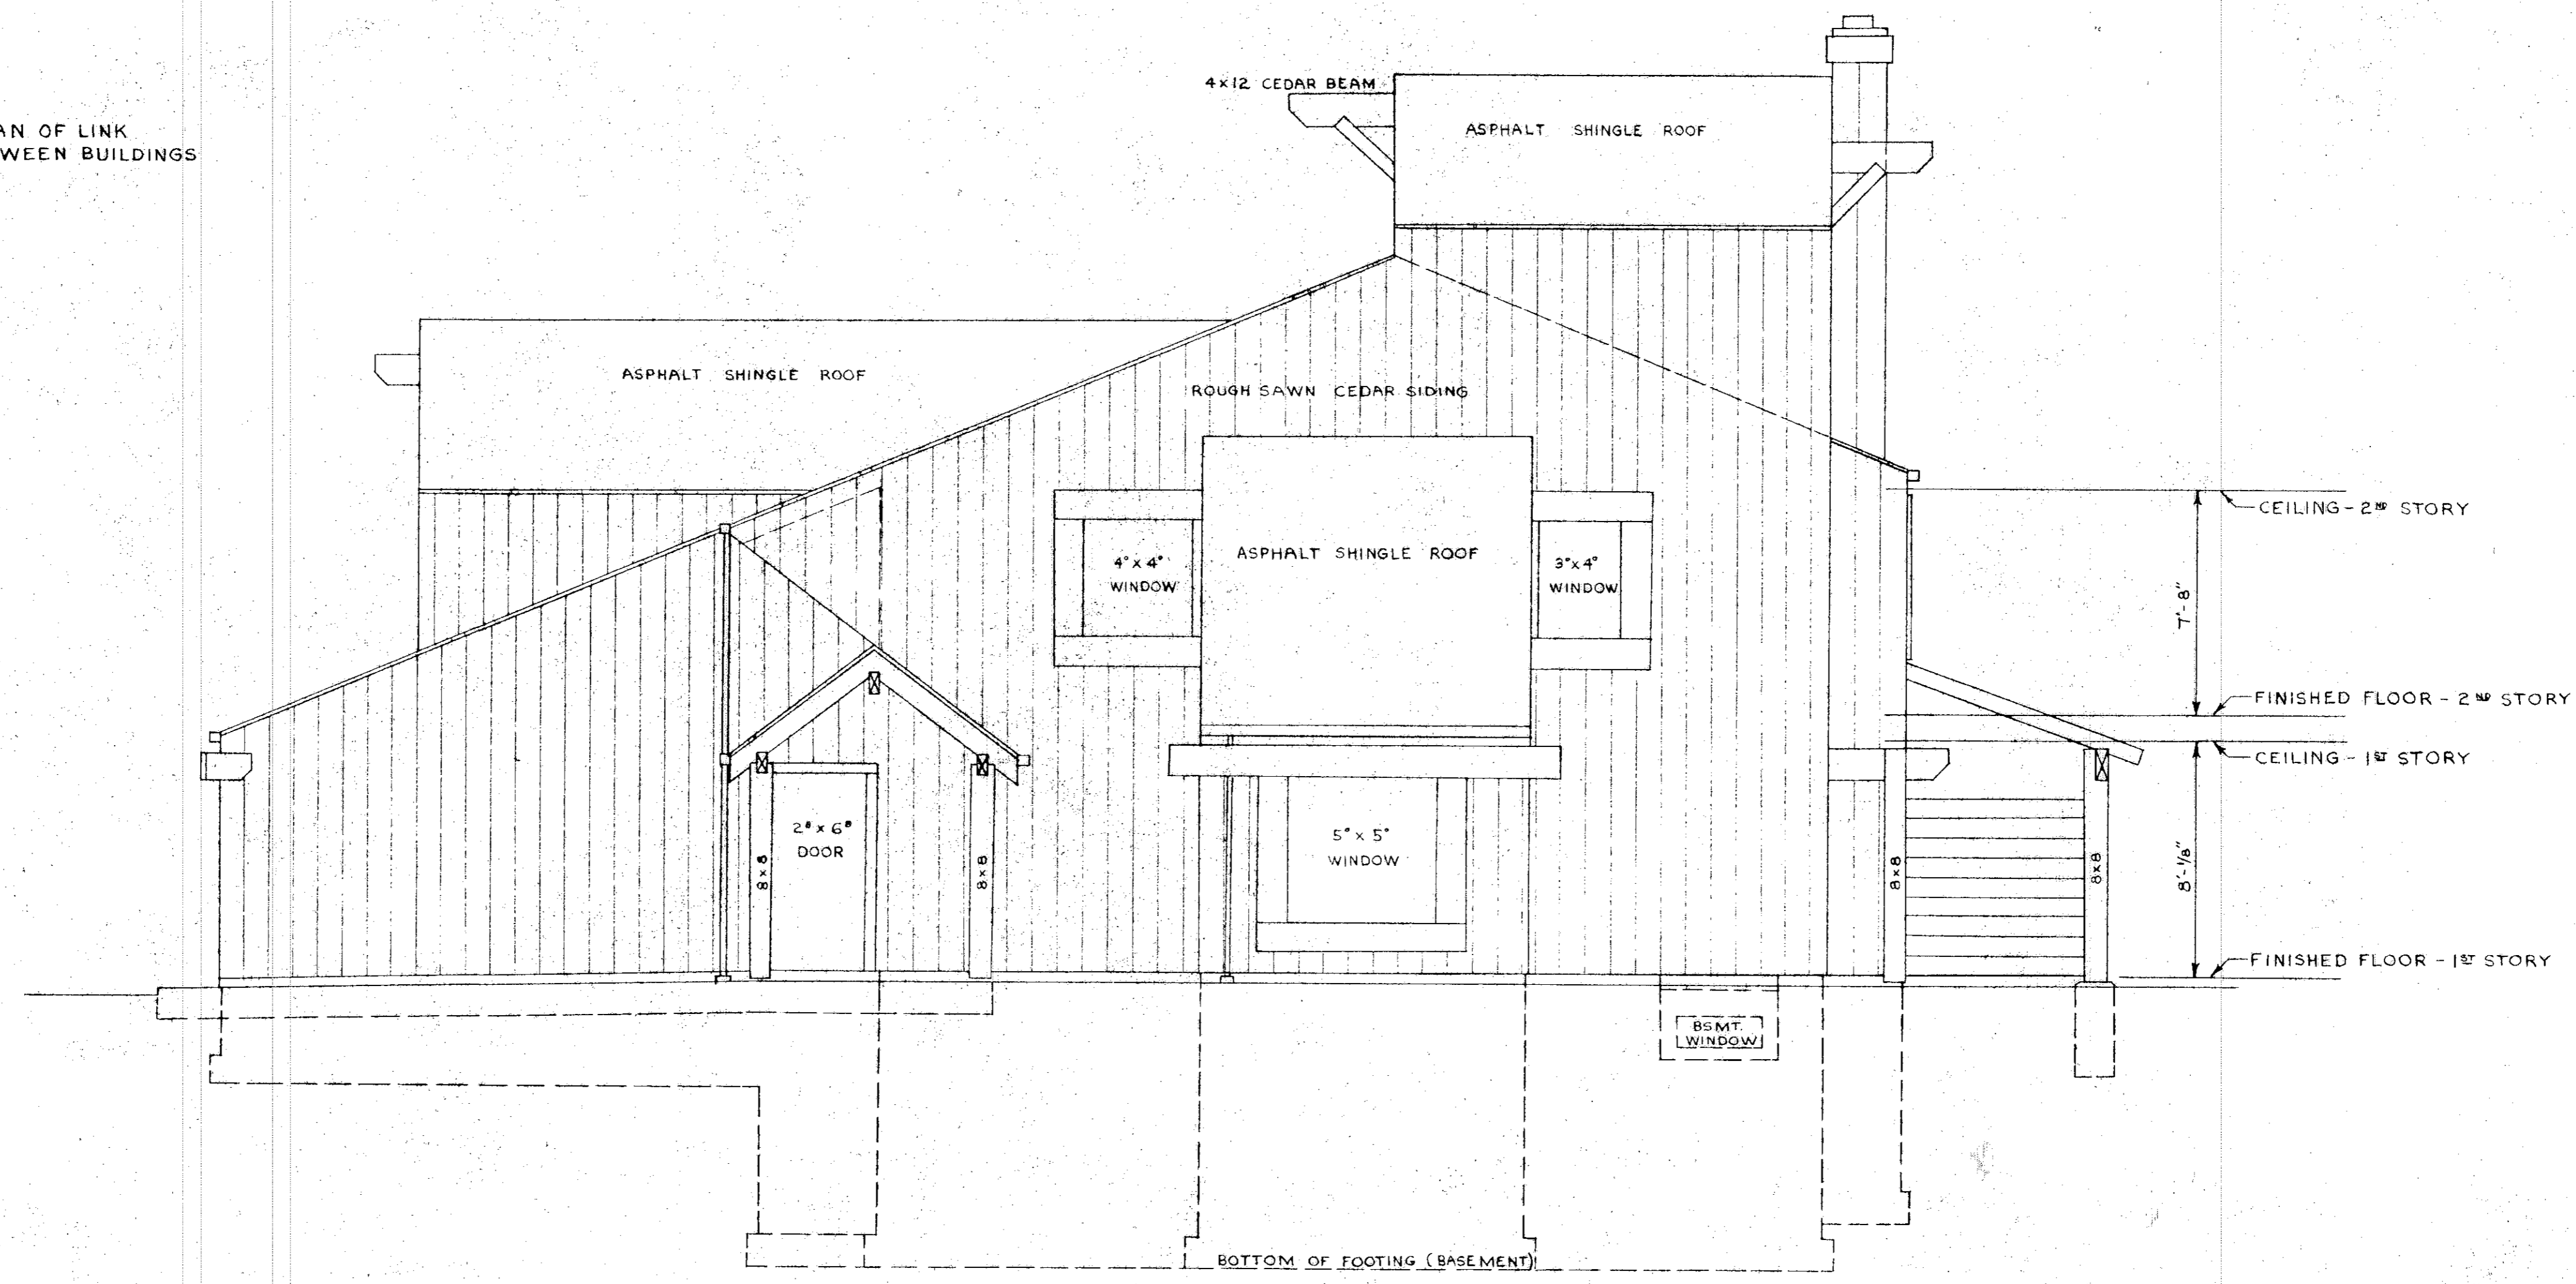

RIGHT SIDE ELEVATION
SCALE: 1" = 4'-0"


STATEMENT OF CERTIFICATION
 I CERTIFY THAT THE ATTACHED DRAWINGS CORRECTLY REPRESENT THE DIMENSIONS OF THE BUILDINGS AS CONSTRUCTED AND THAT THERE ARE NO ENCROACHMENTS ON ANY ABUTTING PREMISES EXCEPT AS SHOWN.

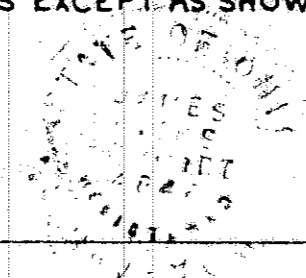

James H. Schmidt
 JAMES H. SCHMIDT
 REGISTERED SURVEYOR

STATEMENT OF CERTIFICATION
 I CERTIFY THAT THE ATTACHED DRAWINGS CORRECTLY REPRESENT THE DIMENSIONS OF THE BUILDINGS AS CONSTRUCTED.

Robert E. Kleinoeder
 ROBERT E. KLEINOEDER
 REGISTERED ENGINEER

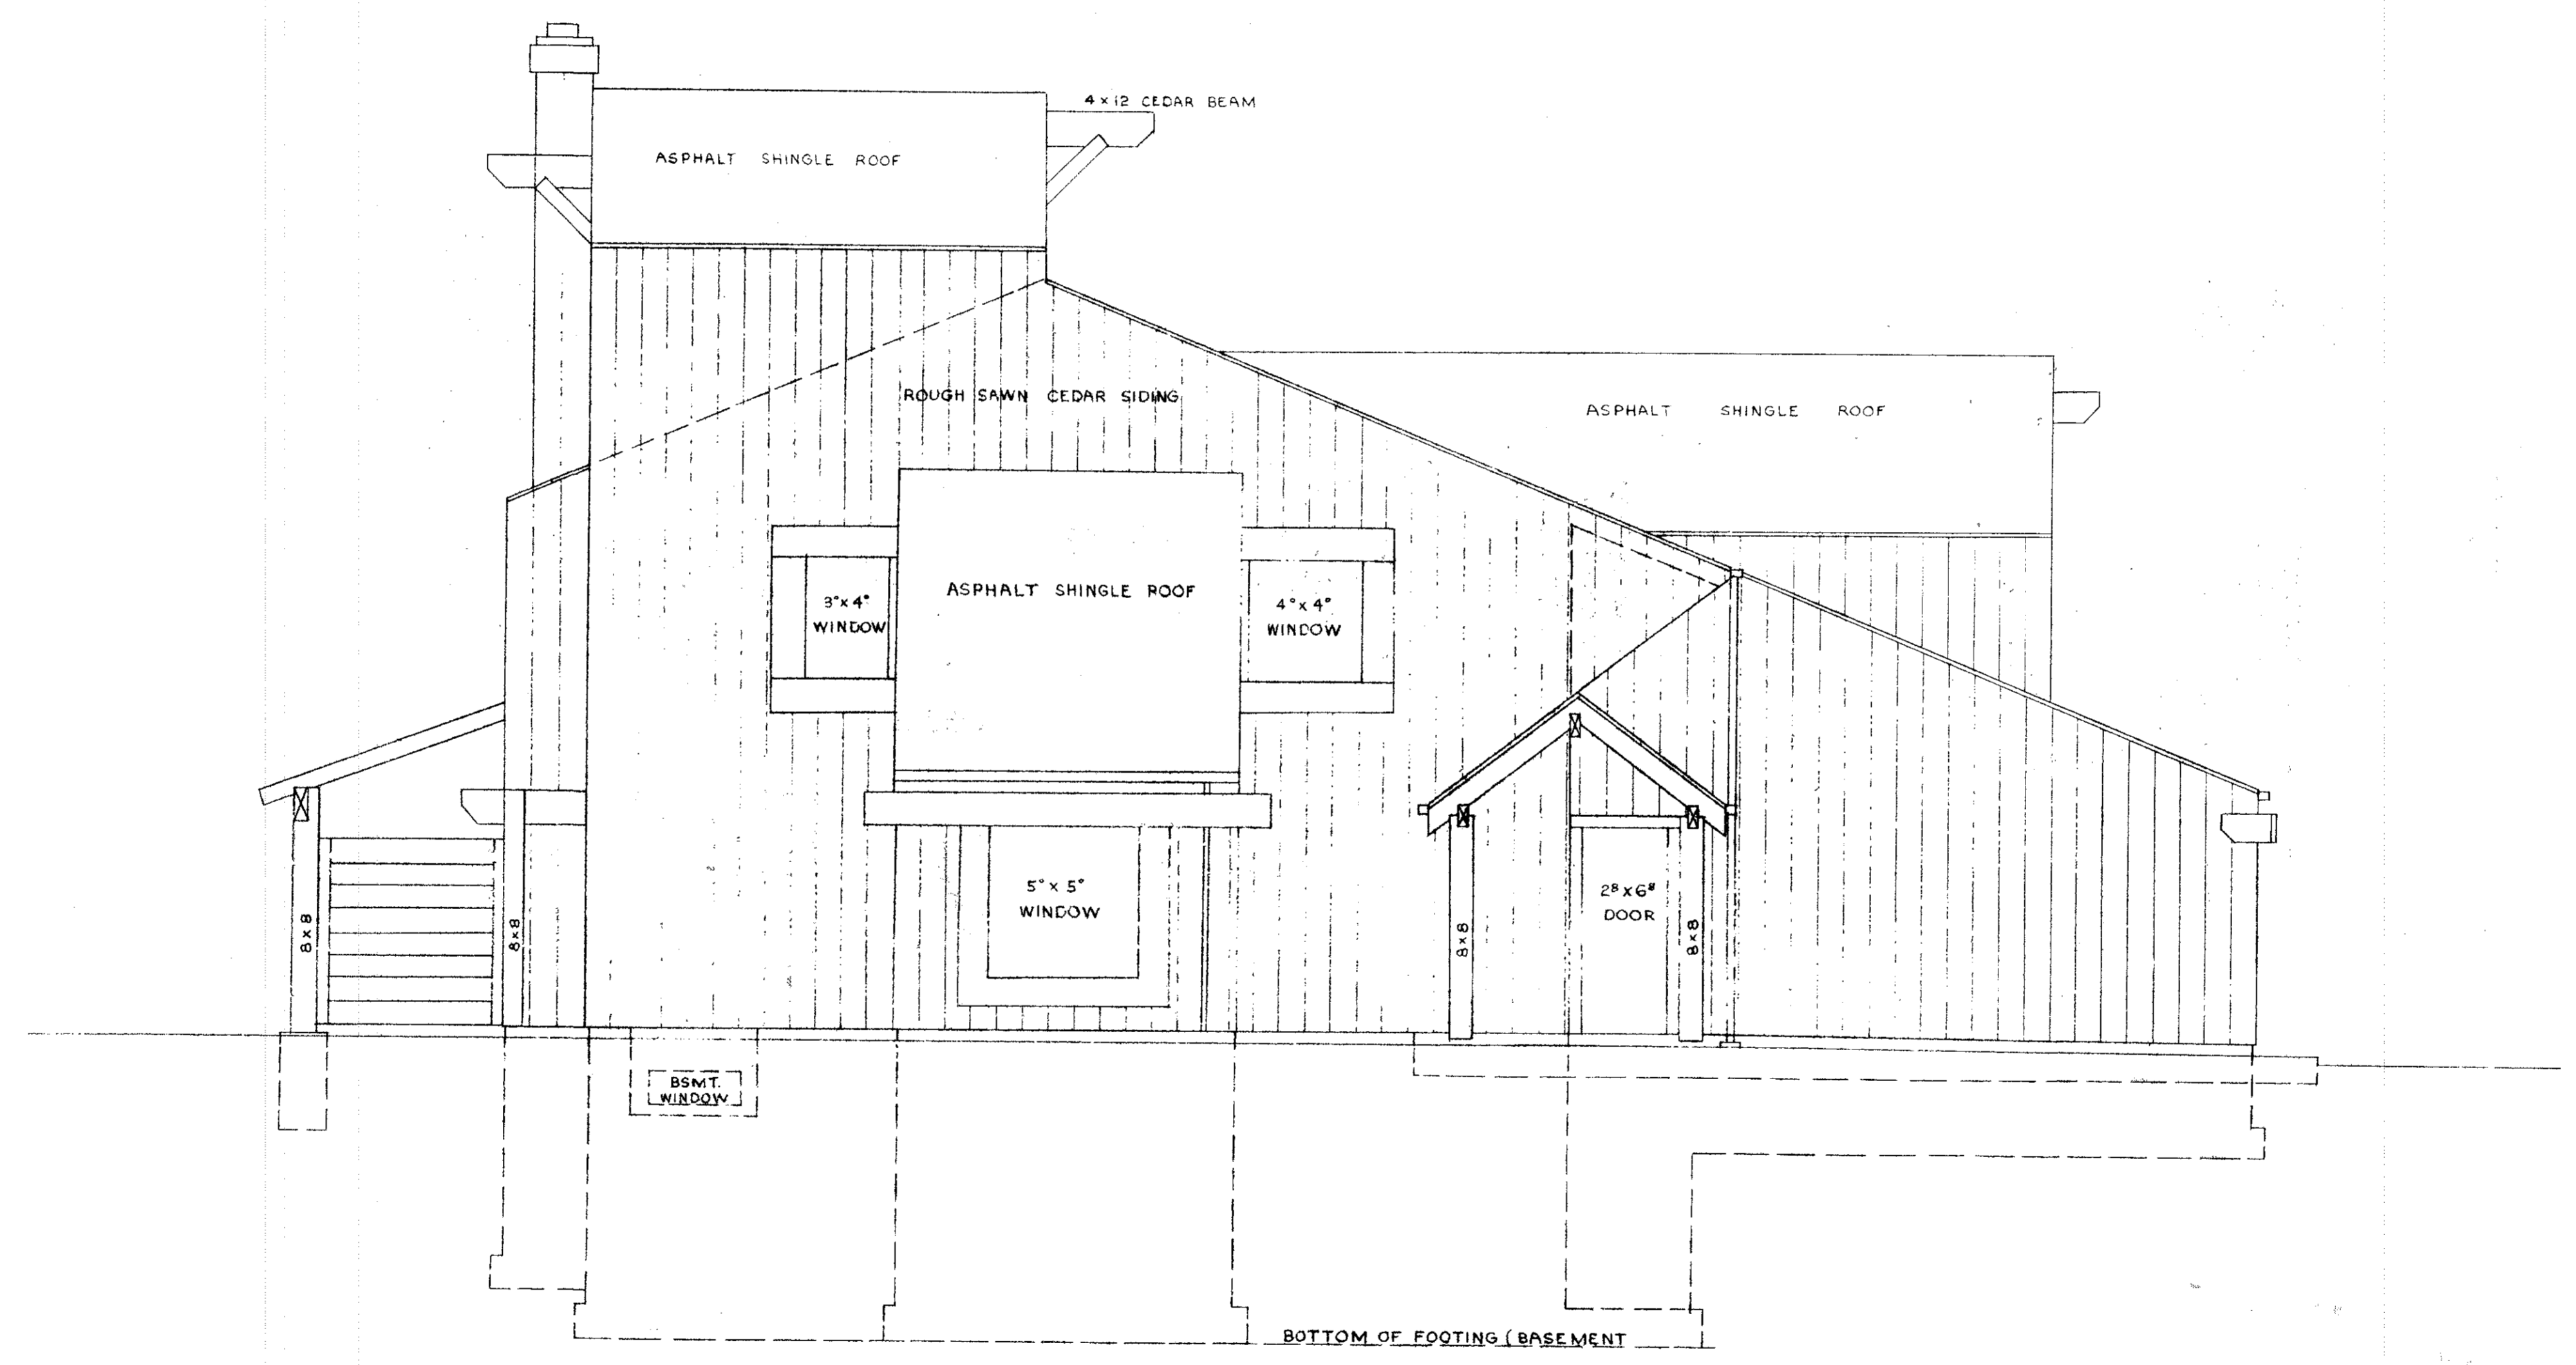

STATEMENT OF CERTIFICATION
 I CERTIFY THAT THE ATTACHED DRAWINGS CORRECTLY REPRESENT THE DIMENSIONS OF THE BUILDINGS AS CONSTRUCTED AND THAT THERE ARE NO ENCROACHMENTS ON ANY ABUTTING PREMISES EXCEPT AS SHOWN.




James H. Schmidt
 JAMES H. SCHMIDT
 REGISTERED SURVEYOR

STATEMENT OF CERTIFICATION
 I CERTIFY THAT THE ATTACHED DRAWINGS CORRECTLY REPRESENT THE DIMENSIONS OF THE BUILDINGS AS CONSTRUCTED.

Robert E. Keinoeder
 ROBERT E. KEINOEDER
 REGISTERED ENGINEER

LEFT SIDE ELEVATION
 SCALE: 1" = 4'-0"

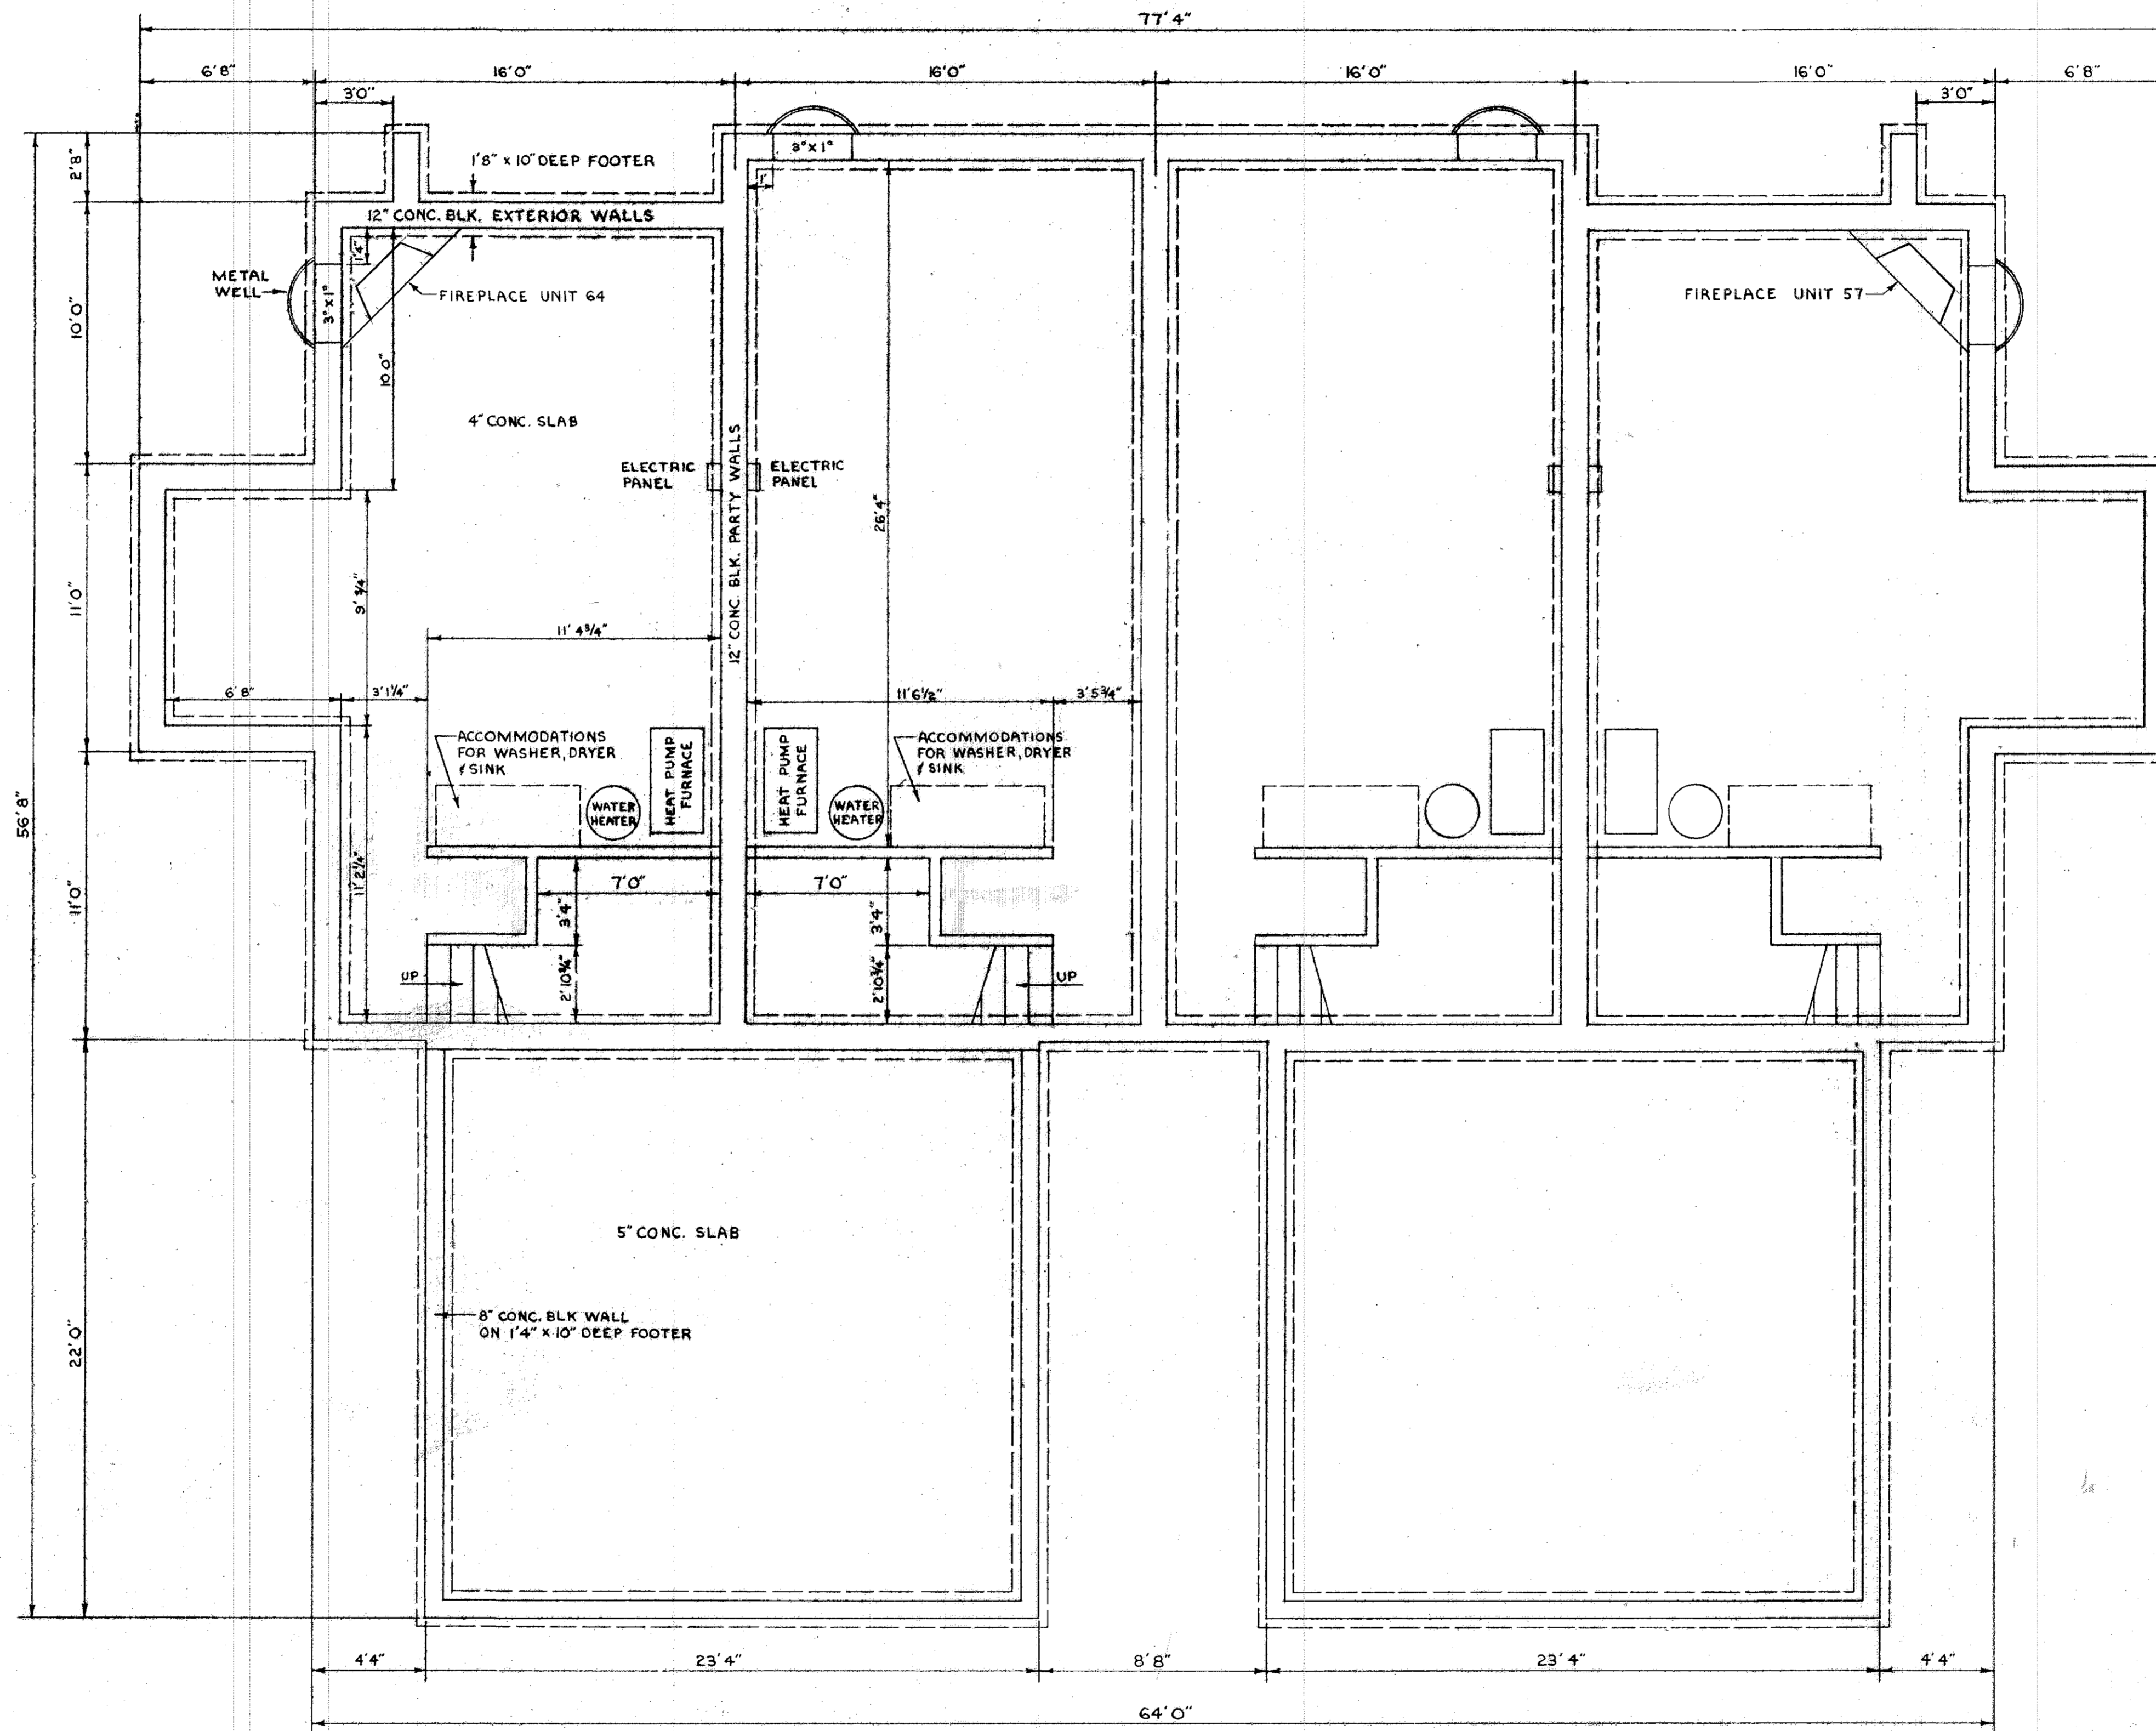


STATEMENT OF CERTIFICATION
 I CERTIFY THAT THE ATTACHED DRAWINGS CORRECTLY REPRESENT THE DIMENSIONS OF THE BUILDINGS AS CONSTRUCTED AND THAT THERE ARE NO ENCROACHMENTS ON ANY ABUTTING PREMISES EXCEPT AS SHOWN.

James H. Schmidt
 JAMES H. SCHMIDT
 REGISTERED SURVEYOR


STATEMENT OF CERTIFICATION
 I CERTIFY THAT THE ATTACHED DRAWINGS CORRECTLY REPRESENT THE DIMENSIONS OF THE BUILDINGS AS CONSTRUCTED.

Robert E. Kleinoeder
 ROBERT E. KLEINOEDER
 REGISTERED ENGINEER

FOUNDATION & BASEMENT PLAN
 SCALE: 1" = 4' 0"

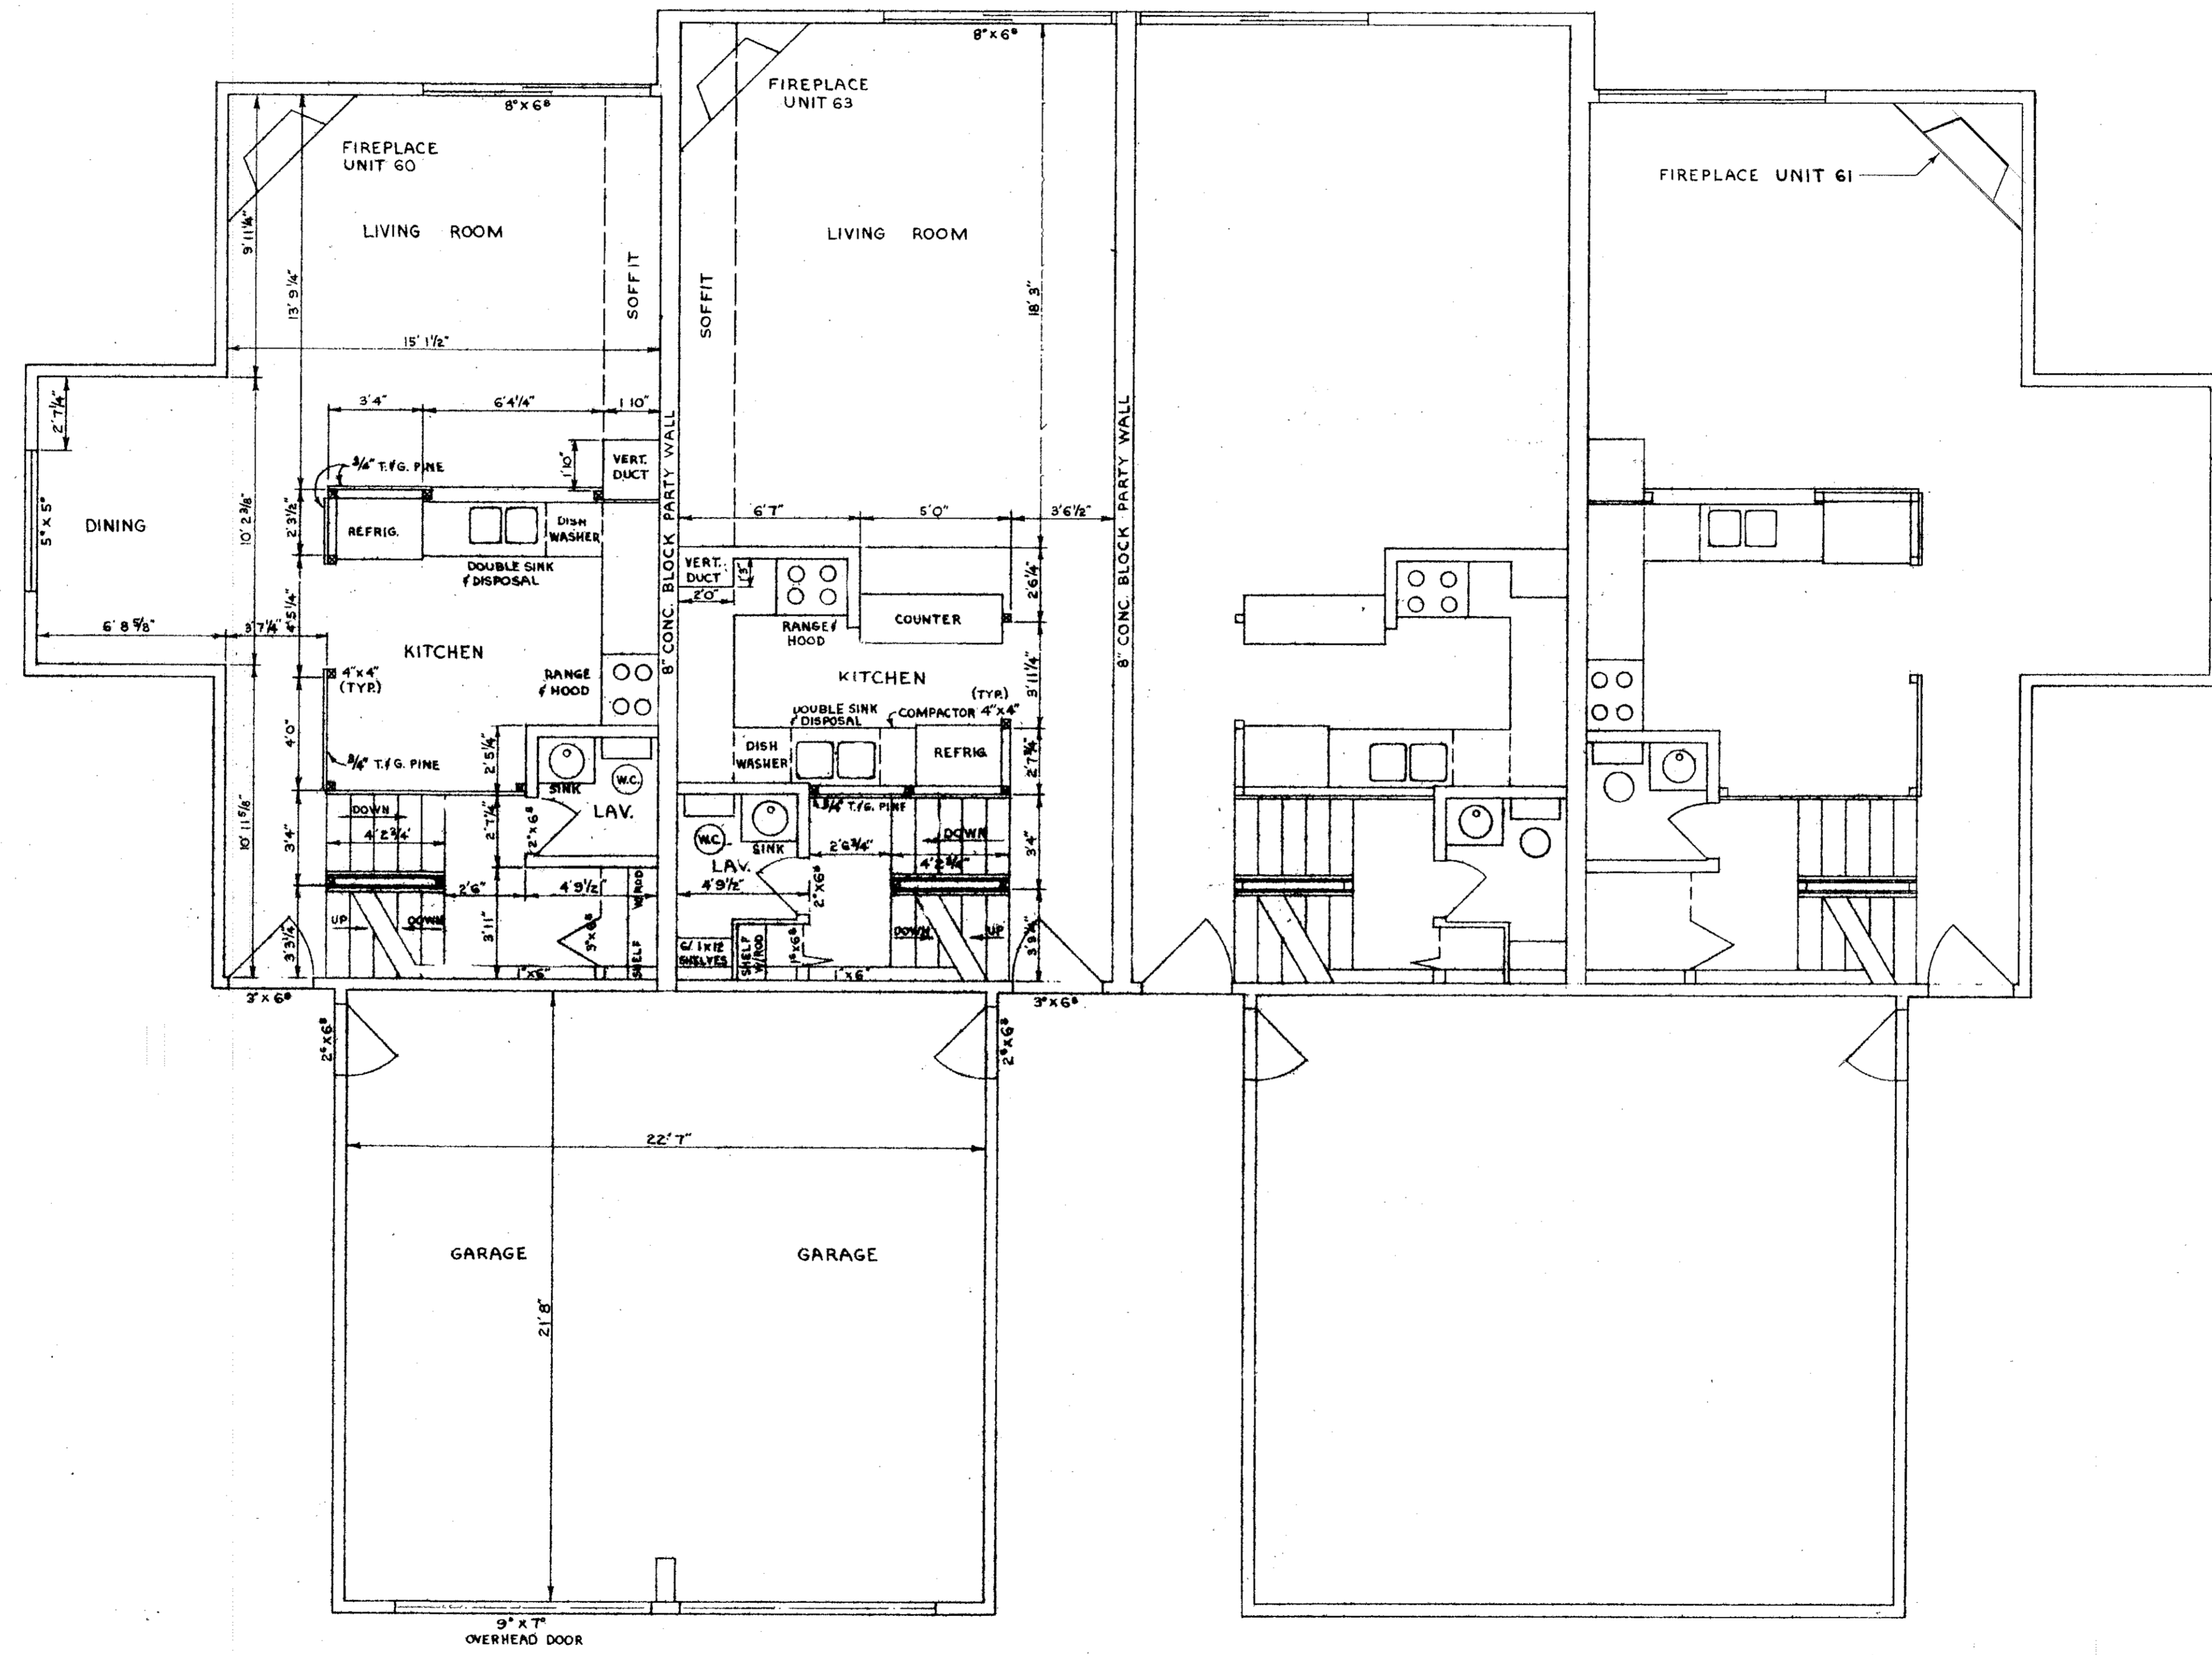

STATEMENT OF CERTIFICATION
 I CERTIFY THAT THE ATTACHED DRAWINGS CORRECTLY REPRESENT THE DIMENSIONS OF THE BUILDINGS AS CONSTRUCTED AND THAT THERE ARE NO ENCROACHMENTS ON ANY ABUTTING PREMISES EXCEPT AS SHOWN.

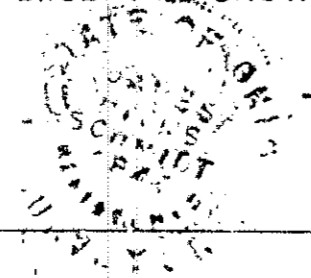


James H. Schmidt
 JAMES H. SCHMIDT
 REGISTERED SURVEYOR

STATEMENT OF CERTIFICATION
 I CERTIFY THAT THE ATTACHED DRAWING CORRECTLY REPRESENT THE DIMENSIONS OF THE BUILDINGS AS CONSTRUCTED


Robert E. Kleinoeder
 ROBERT E. KLEINOEDER
 REGISTERED ENGINEER

FIRST FLOOR PLAN
 SCALE: 1"=4'-0"

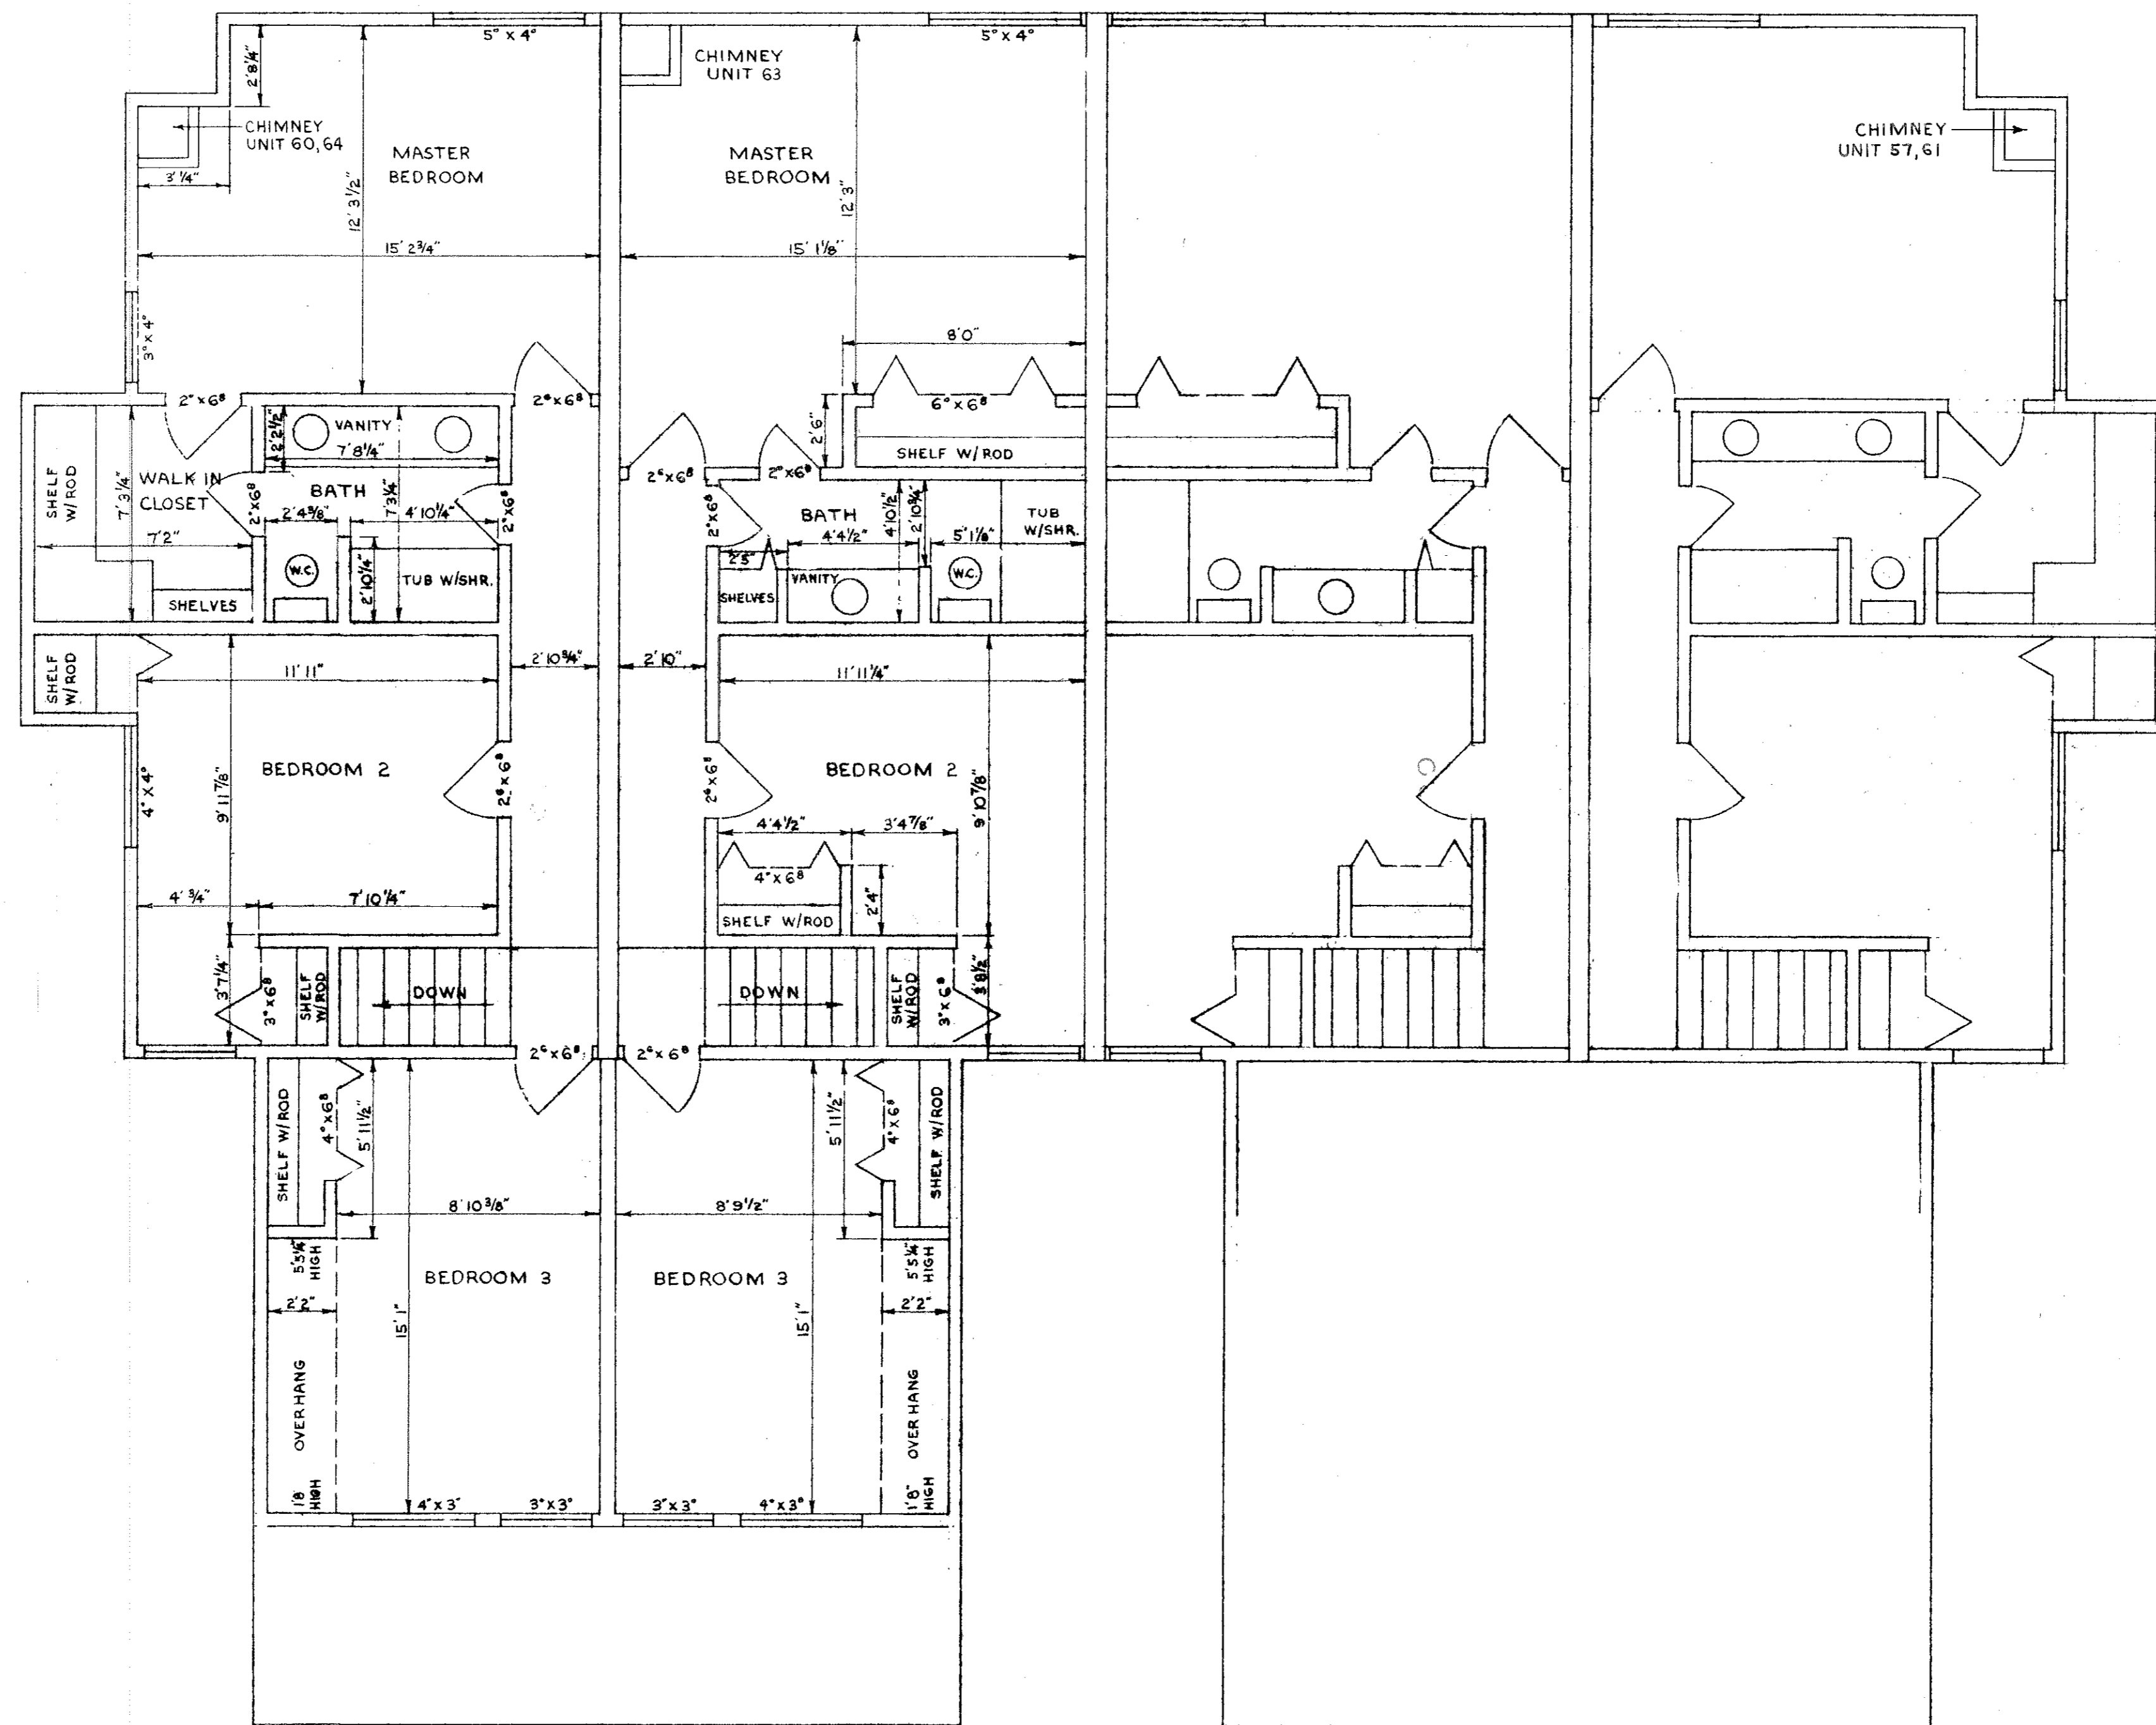

STATEMENT OF CERTIFICATION

I CERTIFY THAT THE ATTACHED DRAWINGS CORRECTLY REPRESENT THE DIMENSIONS OF THE BUILDINGS AS CONSTRUCTED AND THAT THERE ARE NO ENCROACHMENTS ON ANY ABUTTING PREMISES EXCEPT AS SHOWN.

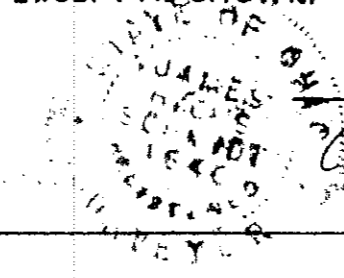

James H. Schmidt
 JAMES H. SCHMIDT
 REGISTERED SURVEYOR

STATEMENT OF CERTIFICATION

I CERTIFY THAT THE ATTACHED DRAWINGS CORRECTLY REPRESENT THE DIMENSIONS OF THE BUILDINGS AS CONSTRUCTED.

Robert E. Kleinoeder
 ROBERT E. KLEINOEDER
 REGISTERED ENGINEER

SECOND FLOOR PLAN

SCALE: 1" = 4' 0"