



CENTER RIDGE ROAD U.S. Route 20

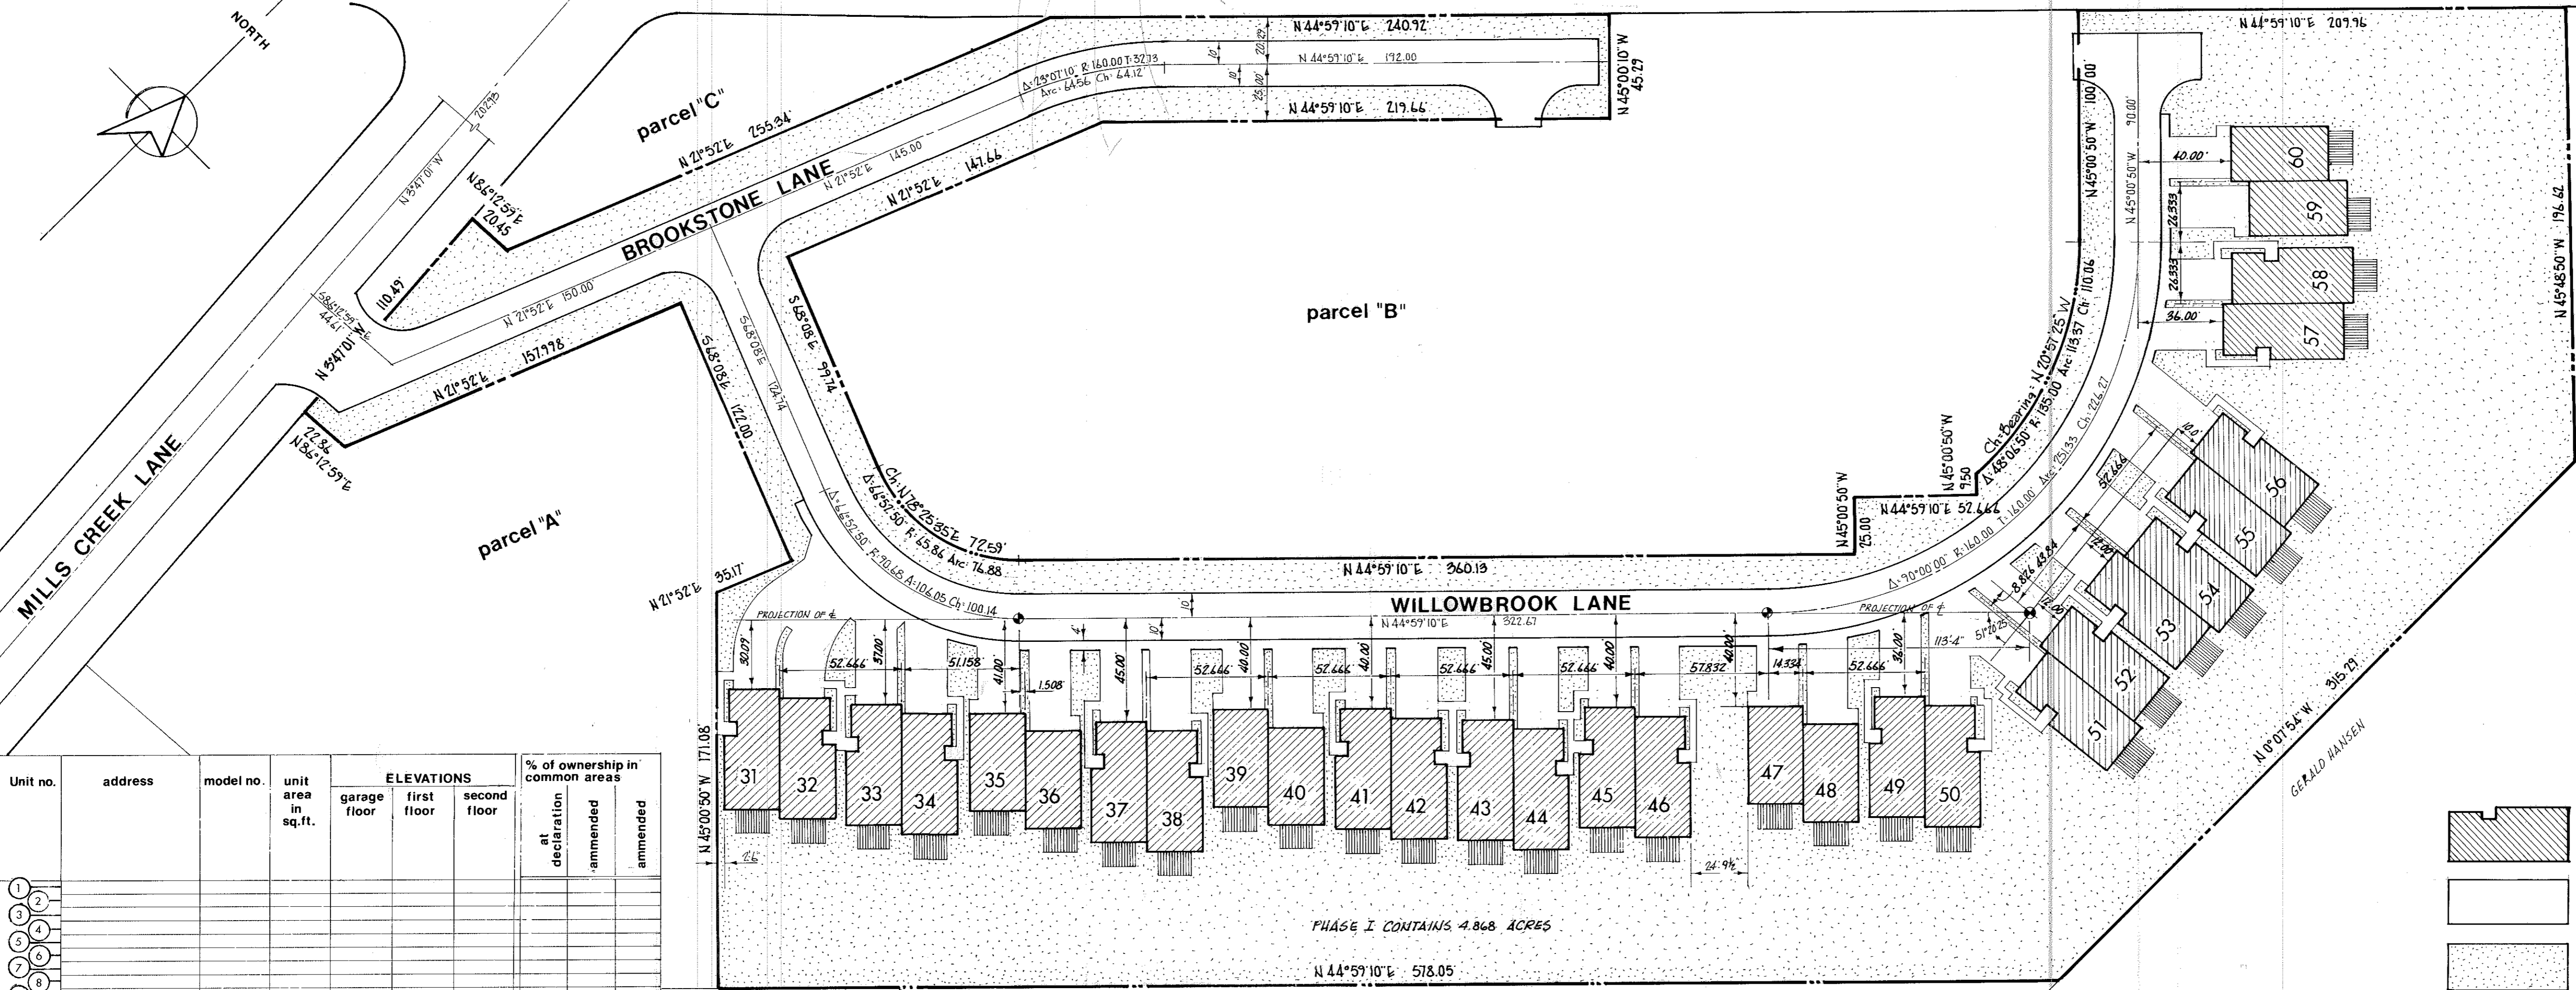

Unit no.	address	model no.	unit area in sq.ft.	ELEVATIONS			% of ownership in common areas	
				garage floor	first floor	second floor	at declaration	amended
31	32177 Willowbrook	2250-D	2250	723.20	723.64	732.68	3.3802	
32	32177 Willowbrook	2250-D	2250	723.20	723.64	732.68	3.3802	
33	32177 Willowbrook	2250-D	2250	723.20	723.64	732.68	3.3802	
34	32175 Willowbrook	2250-D	2250	723.20	723.64	732.68	3.3802	
35	32163 Willowbrook	2160	2160	723.20	723.64	732.68	3.2450	
36	32161 Willowbrook	2160	2160	723.20	723.64	732.68	3.2450	
37	32159 Willowbrook	2250-D	2250	723.20	723.64	732.68	3.3802	
38	32158 Willowbrook	2250-D	2250	723.20	723.64	732.68	3.3802	
39	32147 Willowbrook	2160	2160	723.20	723.64	732.68	3.2450	
40	32145 Willowbrook	2160	2160	723.20	723.64	732.68	3.2450	
41	32139 Willowbrook	2202	2202	723.53	723.97	733.01	3.3081	
42	32137 Willowbrook	2202	2202	723.53	723.97	733.01	3.3081	
43	32131 Willowbrook	2202	2202	723.85	724.29	733.33	3.3081	
44	32129 Willowbrook	2202	2202	723.85	724.29	733.33	3.3081	
45	32125 Willowbrook	2250-B	2250	724.20	724.64	733.68	3.3802	
46	32121 Willowbrook	2250-B	2250	724.20	724.64	733.68	3.3802	
47	32115 Willowbrook	2160	2160	724.53	724.97	734.01	3.2450	
48	32113 Willowbrook	2160	2160	724.53	724.97	734.01	3.2450	
49	32107 Willowbrook	2250-B	2250	724.85	725.29	734.33	3.3802	
50	32105 Willowbrook	2250-B	2250	724.85	725.29	734.33	3.3802	
51	32109 Willowbrook	2244-B	2244	725.20	725.64	734.68	3.3802	
52	32671 Willowbrook	2244-B	2244	725.20	725.64	734.68	3.3802	
53	32471 Willowbrook	2244-A	2244	725.50	725.94	734.98	3.3712	
54	32489 Willowbrook	2244-A	2244	725.50	725.94	734.98	3.3712	
55	32488 Willowbrook	2244-A	2244	725.85	726.29	735.33	3.3712	
56	32481 Willowbrook	2244-A	2244	725.85	726.29	735.33	3.3712	
57	32675 Willowbrook	2250-B	2250	726.85	727.29	735.33	3.3802	
58	32673 Willowbrook	2250-B	2250	726.85	727.29	735.33	3.3802	
59	32669 Willowbrook	2160	2160	727.20	727.64	734.68	3.2450	
60	32665 Willowbrook	2160	2160	727.20	727.64	734.68	3.2450	

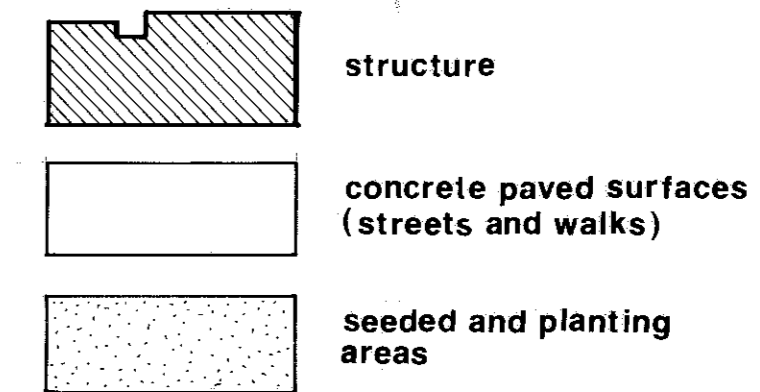

PHASE I CONTAINS 4.868 ACRES



MILLS CREEK LOT OWNERS' ASSOCIATION
VOL. 25 - PAGE 11

WE, THE UNDERSIGNED DONALD E. HIMES AND MICHAEL G. HURA, REGISTERED SURVEYORS, AND EDWARD A. SCHMITT, REGISTERED ARCHITECT, HEREBY CERTIFY THAT THE WITHIN DRAWINGS (SHEETS NUMBERED 1 THROUGH 4 INCLUSIVE) FOR CREEKSTONE COMMONS CONDOMINIUMS, ACCURATELY SHOW THE BUILDINGS AS CONSTRUCTED.

Donald E. Himes
DONALD E. HIMES
REGISTERED SURVEYOR #4113

Michael G. Hura
MICHAEL G. HURA
REGISTERED SURVEYOR #4712

Edward A. Schmitt
EDWARD A. SCHMITT
REGISTERED ARCHITECT #4044

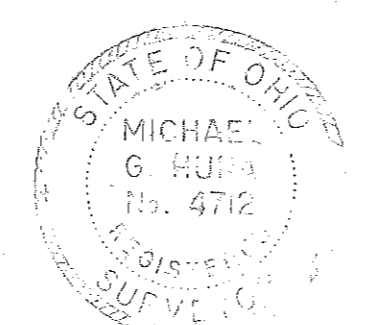
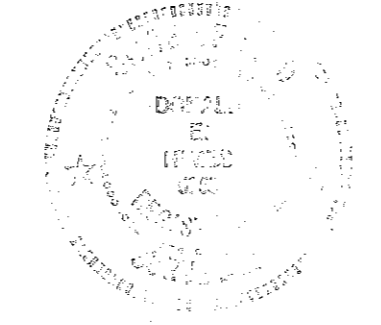


**PHASE I
CREEKSTONE COMMONS
CONDOMINIUM**

Parts of Original Lots 5 & 6 of Ridgeville Township
now City of North Ridgeville, Lorain Co., Ohio
May 1978 Scale 1" = 40'



Donald E. Himes _____ Registered Surveyor
Michael G. Hura _____ Registered Surveyor
Edward A. Schmitt _____ Registered Architect


Recorded for Record JUN 12 1979
at 10:15 a.m. in PLAT RECORD.
VOL. 33
PAGE 6467
Dorothy L. Eason
Lorain County Recorder

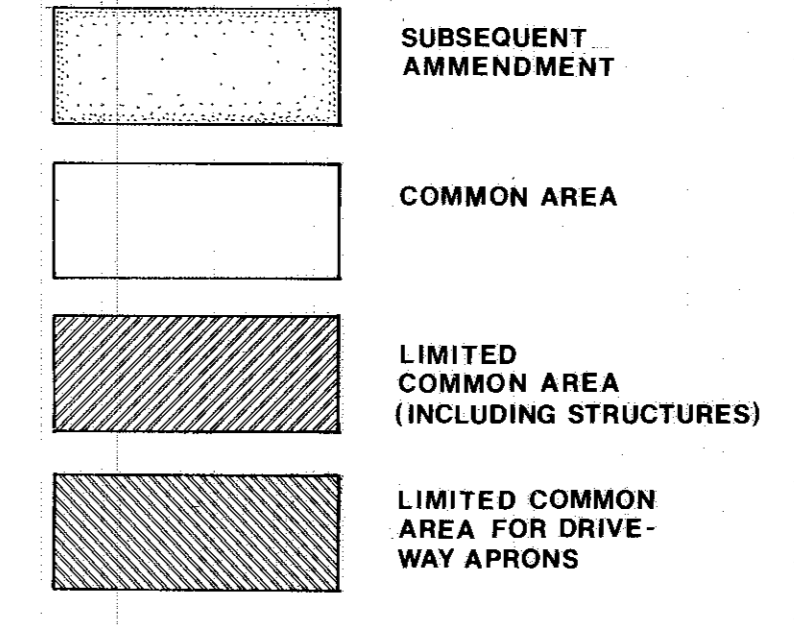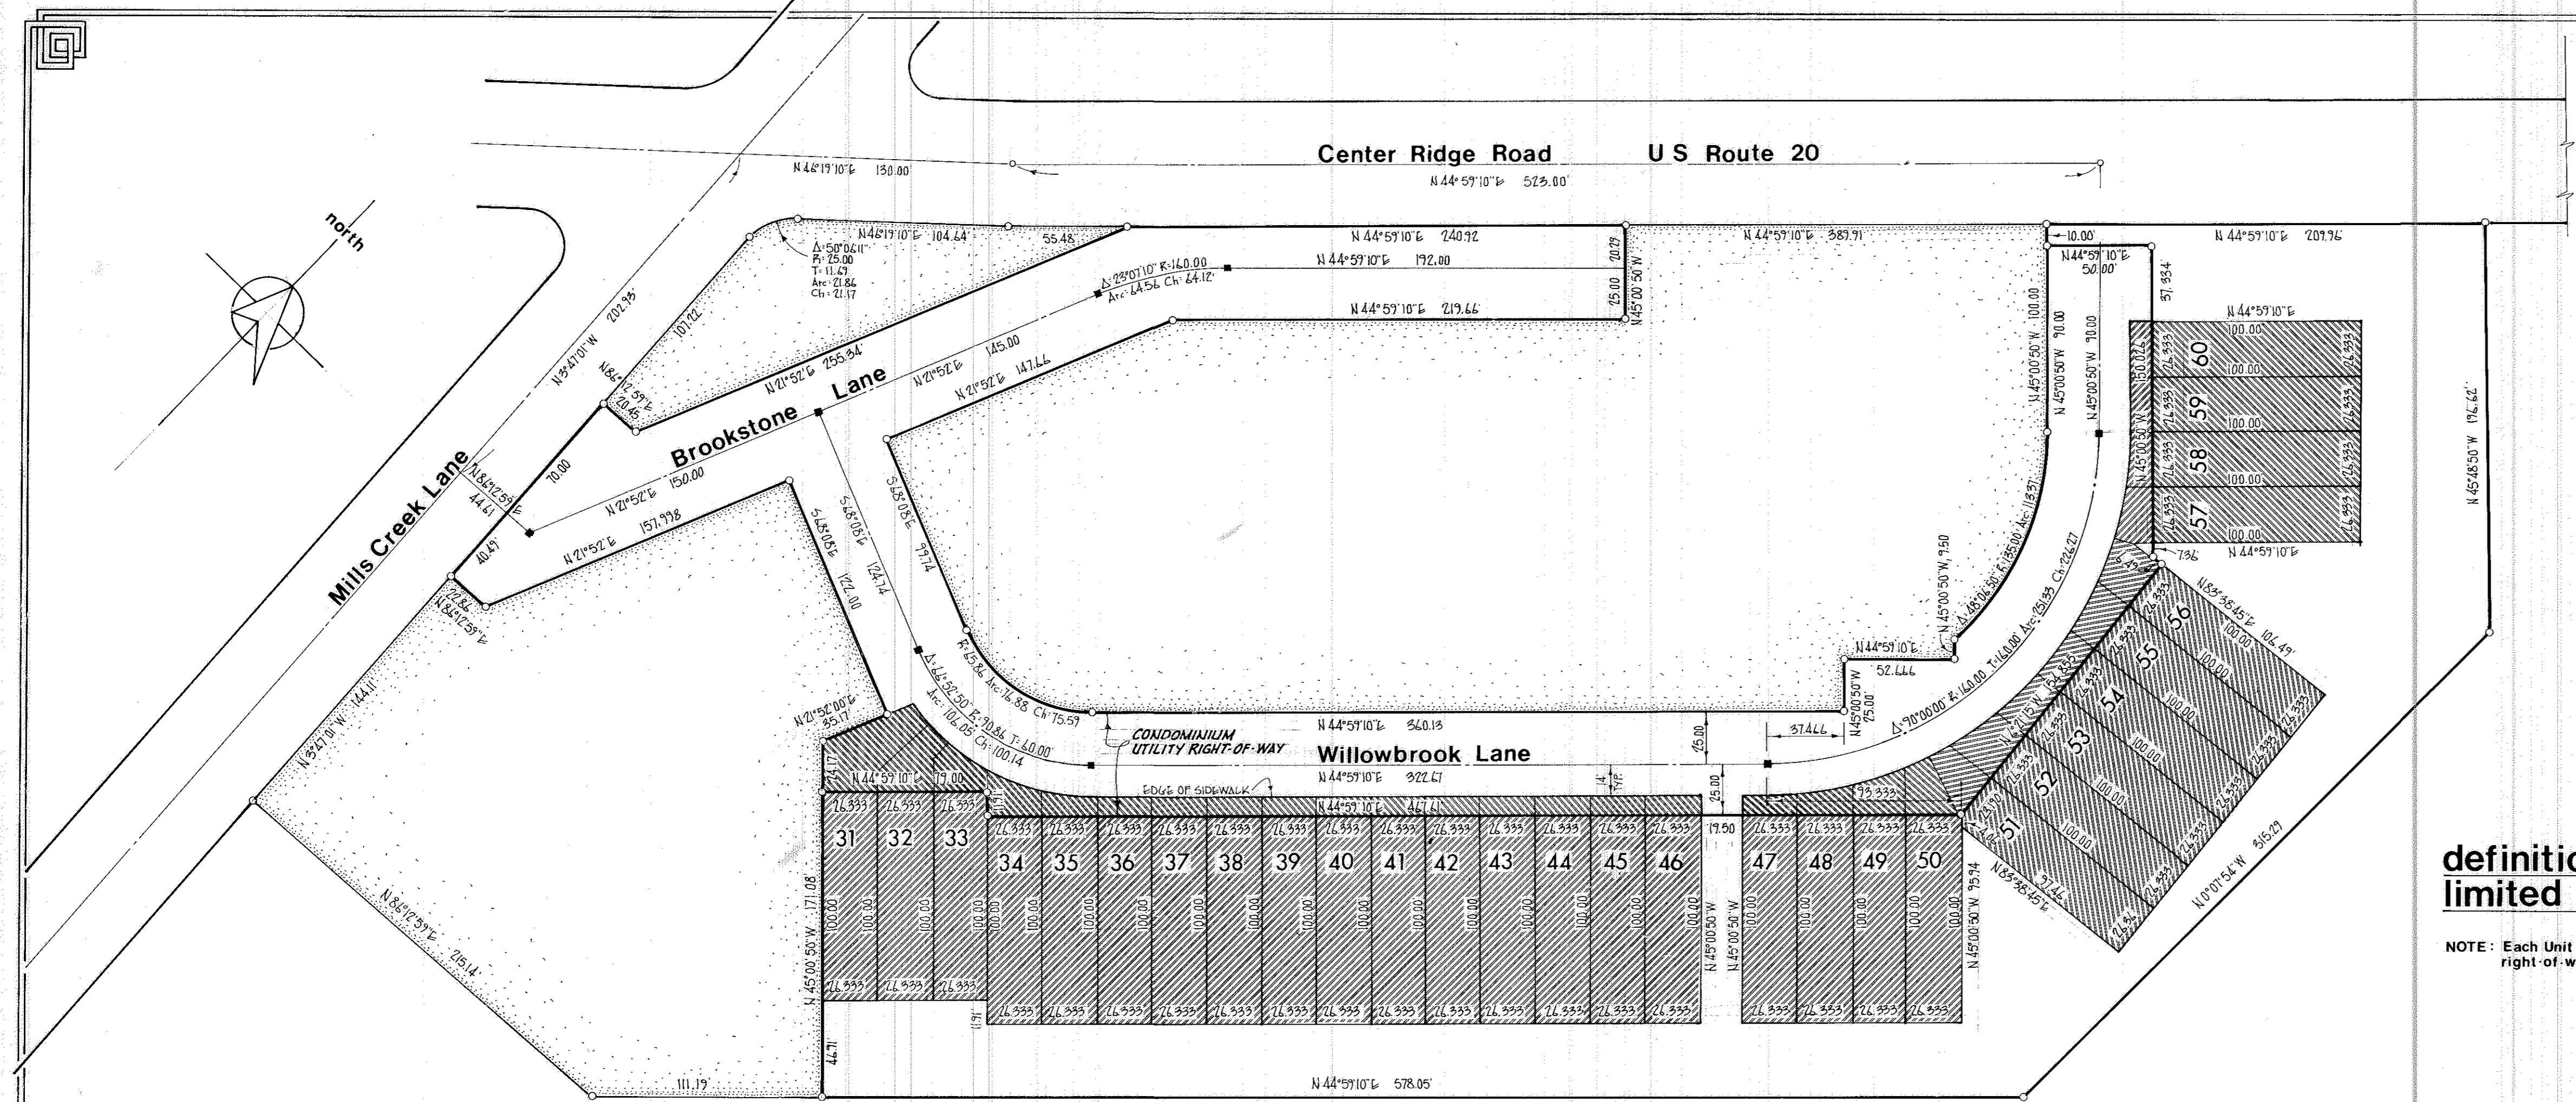


definition of common and limited common areas Scale 1"=50'

NOTE: Each Unit Limited Common Area outside of the utility (street) right-of-way embraces 2,633.3 square feet of area.

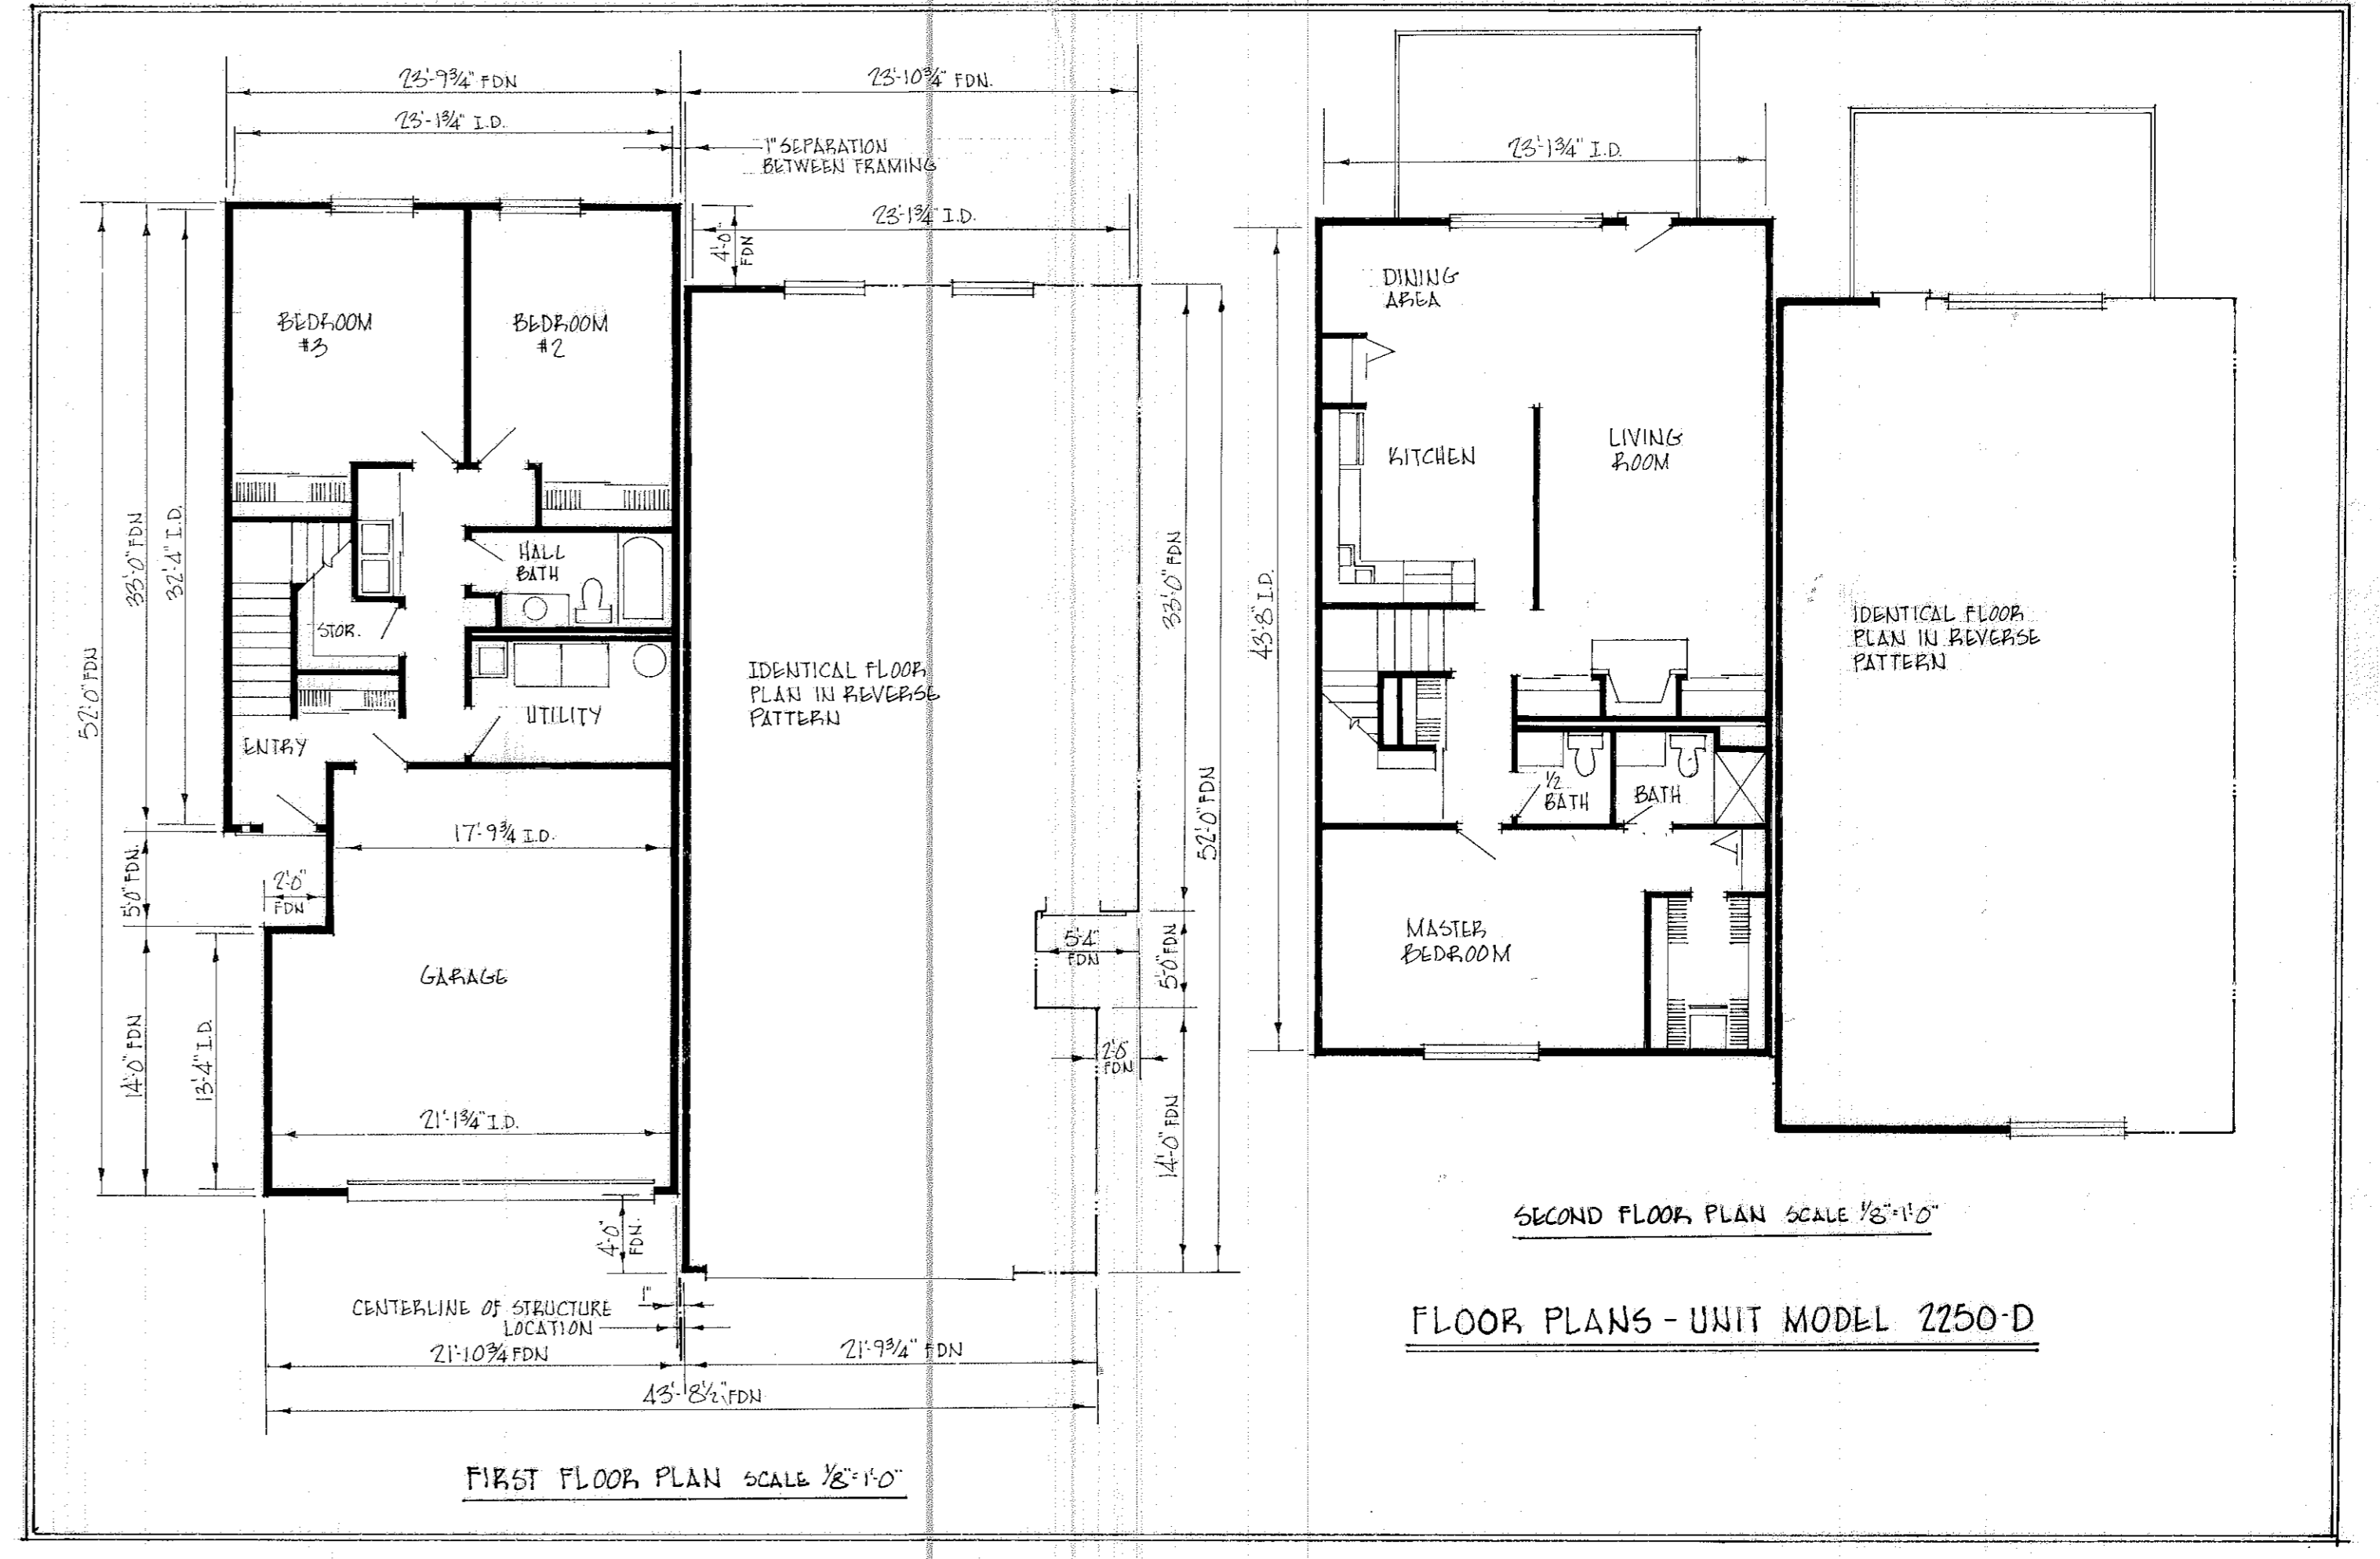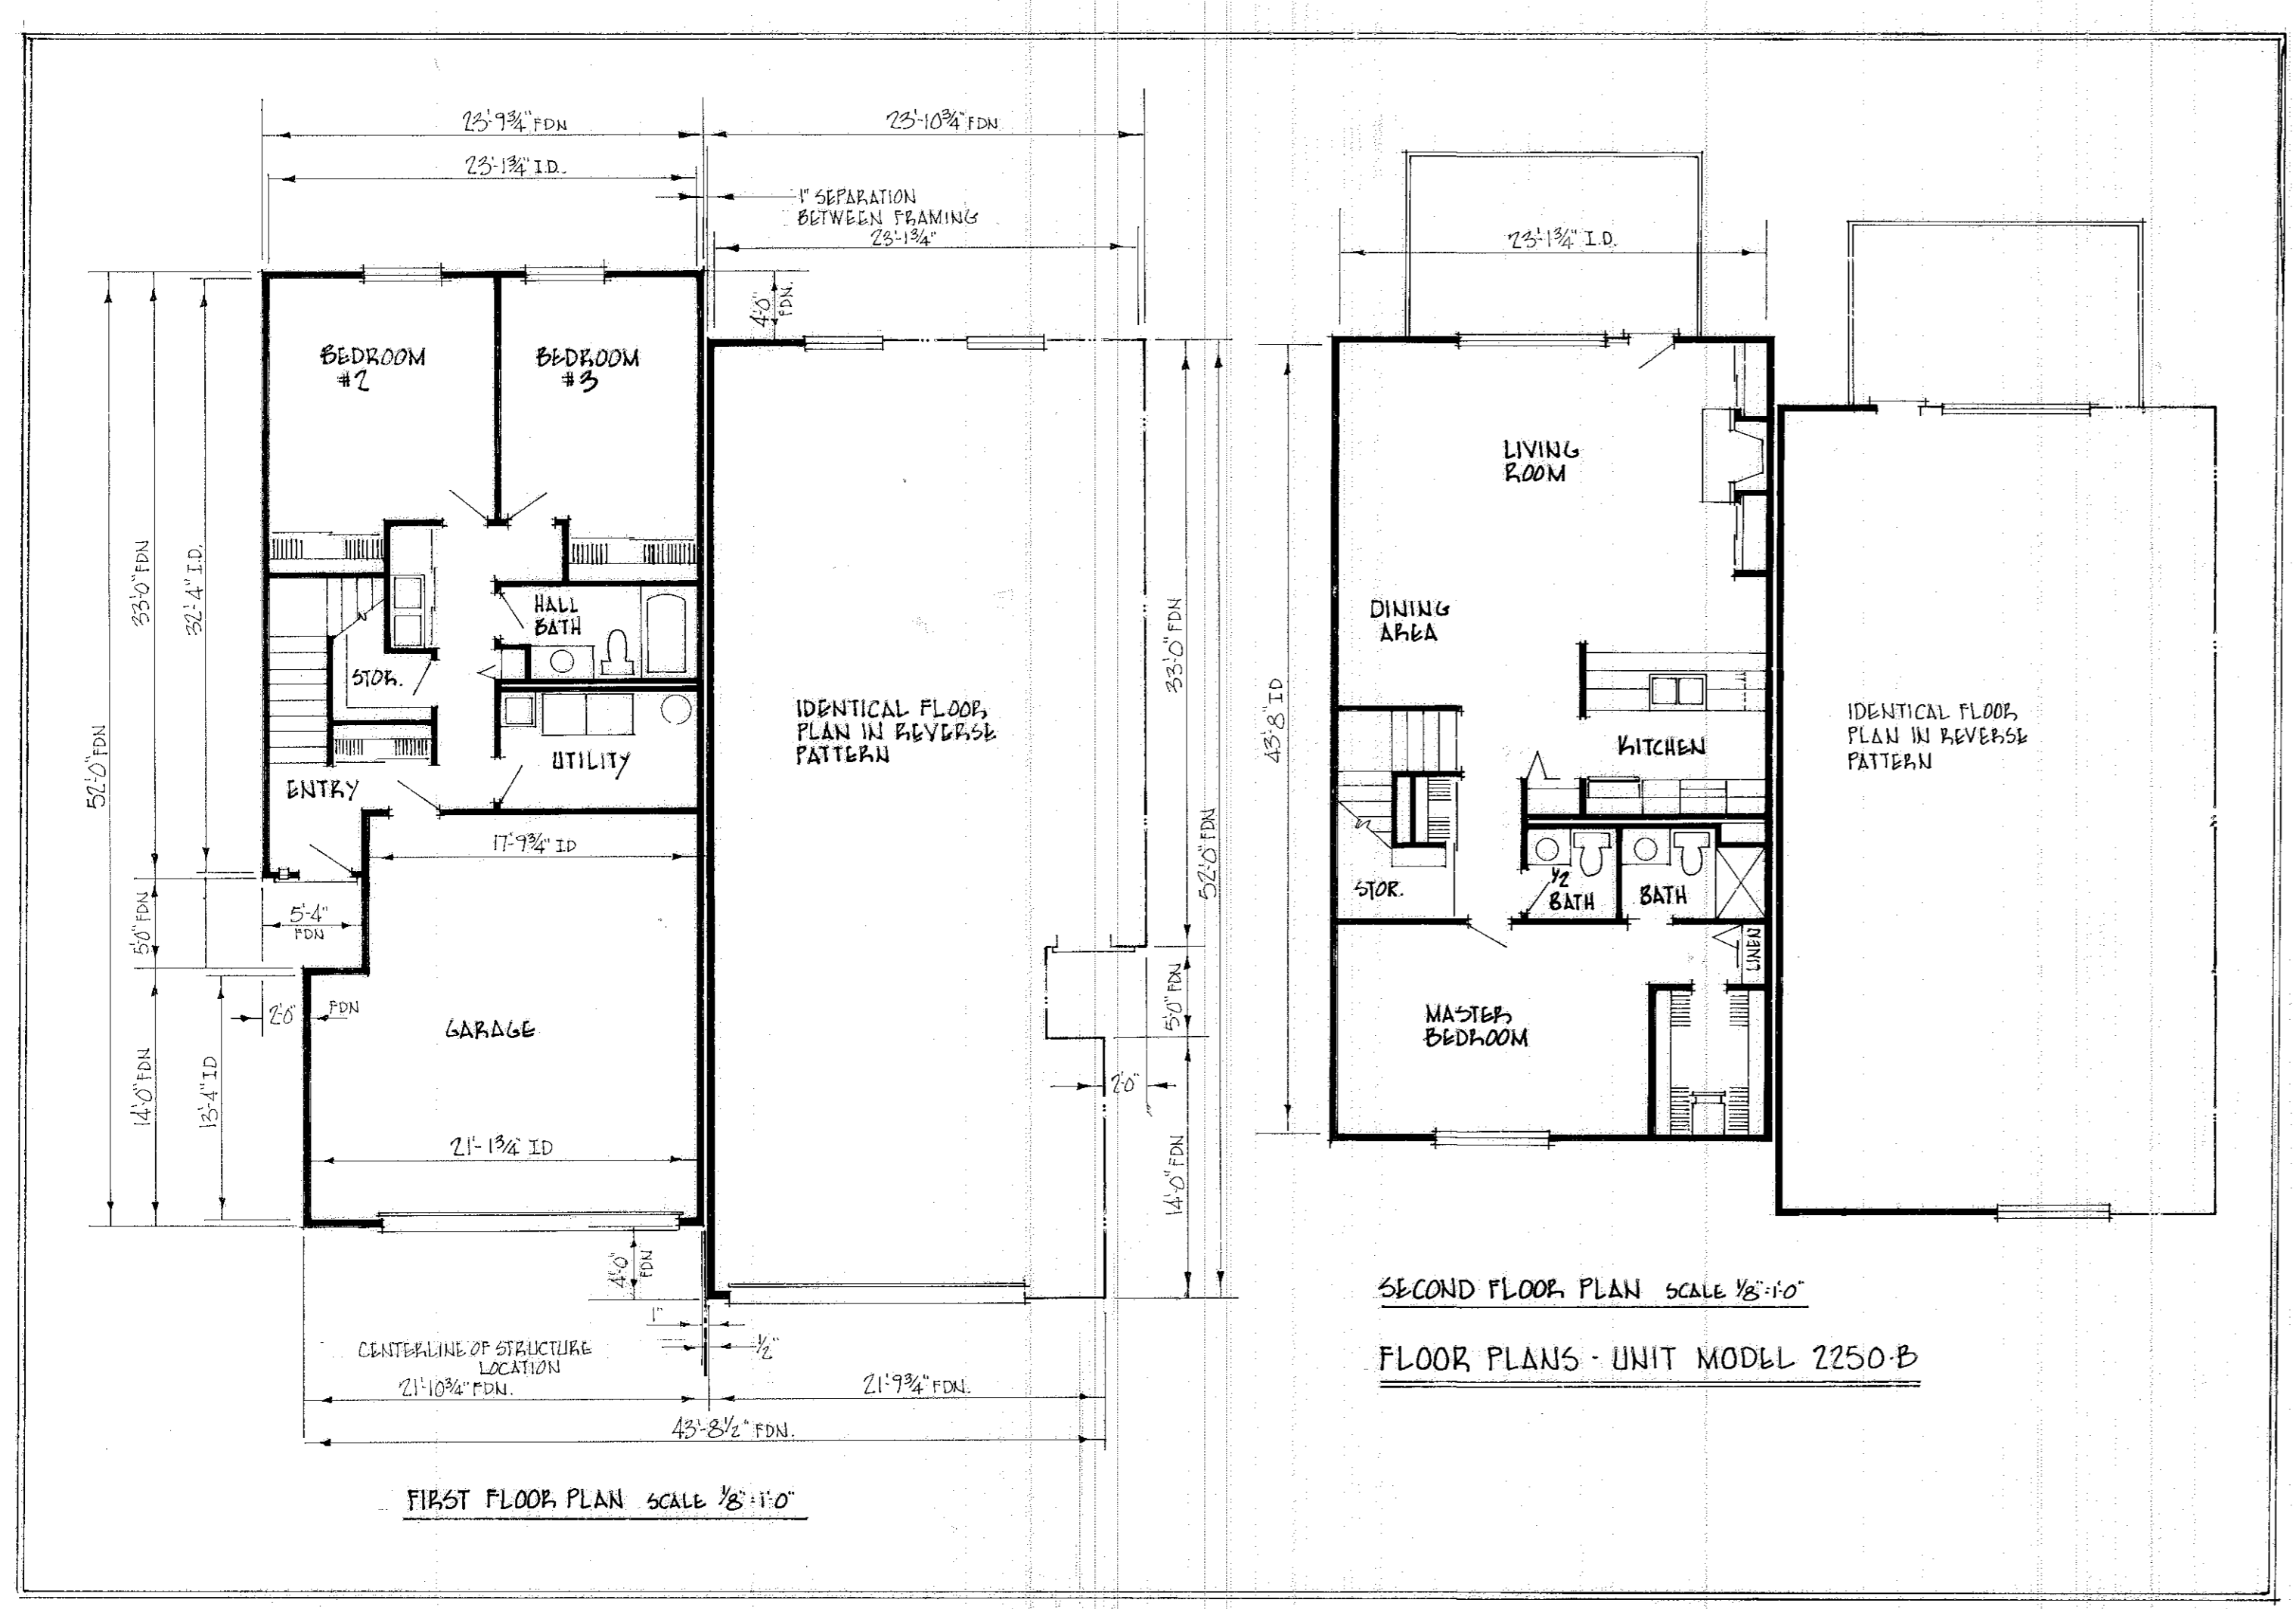


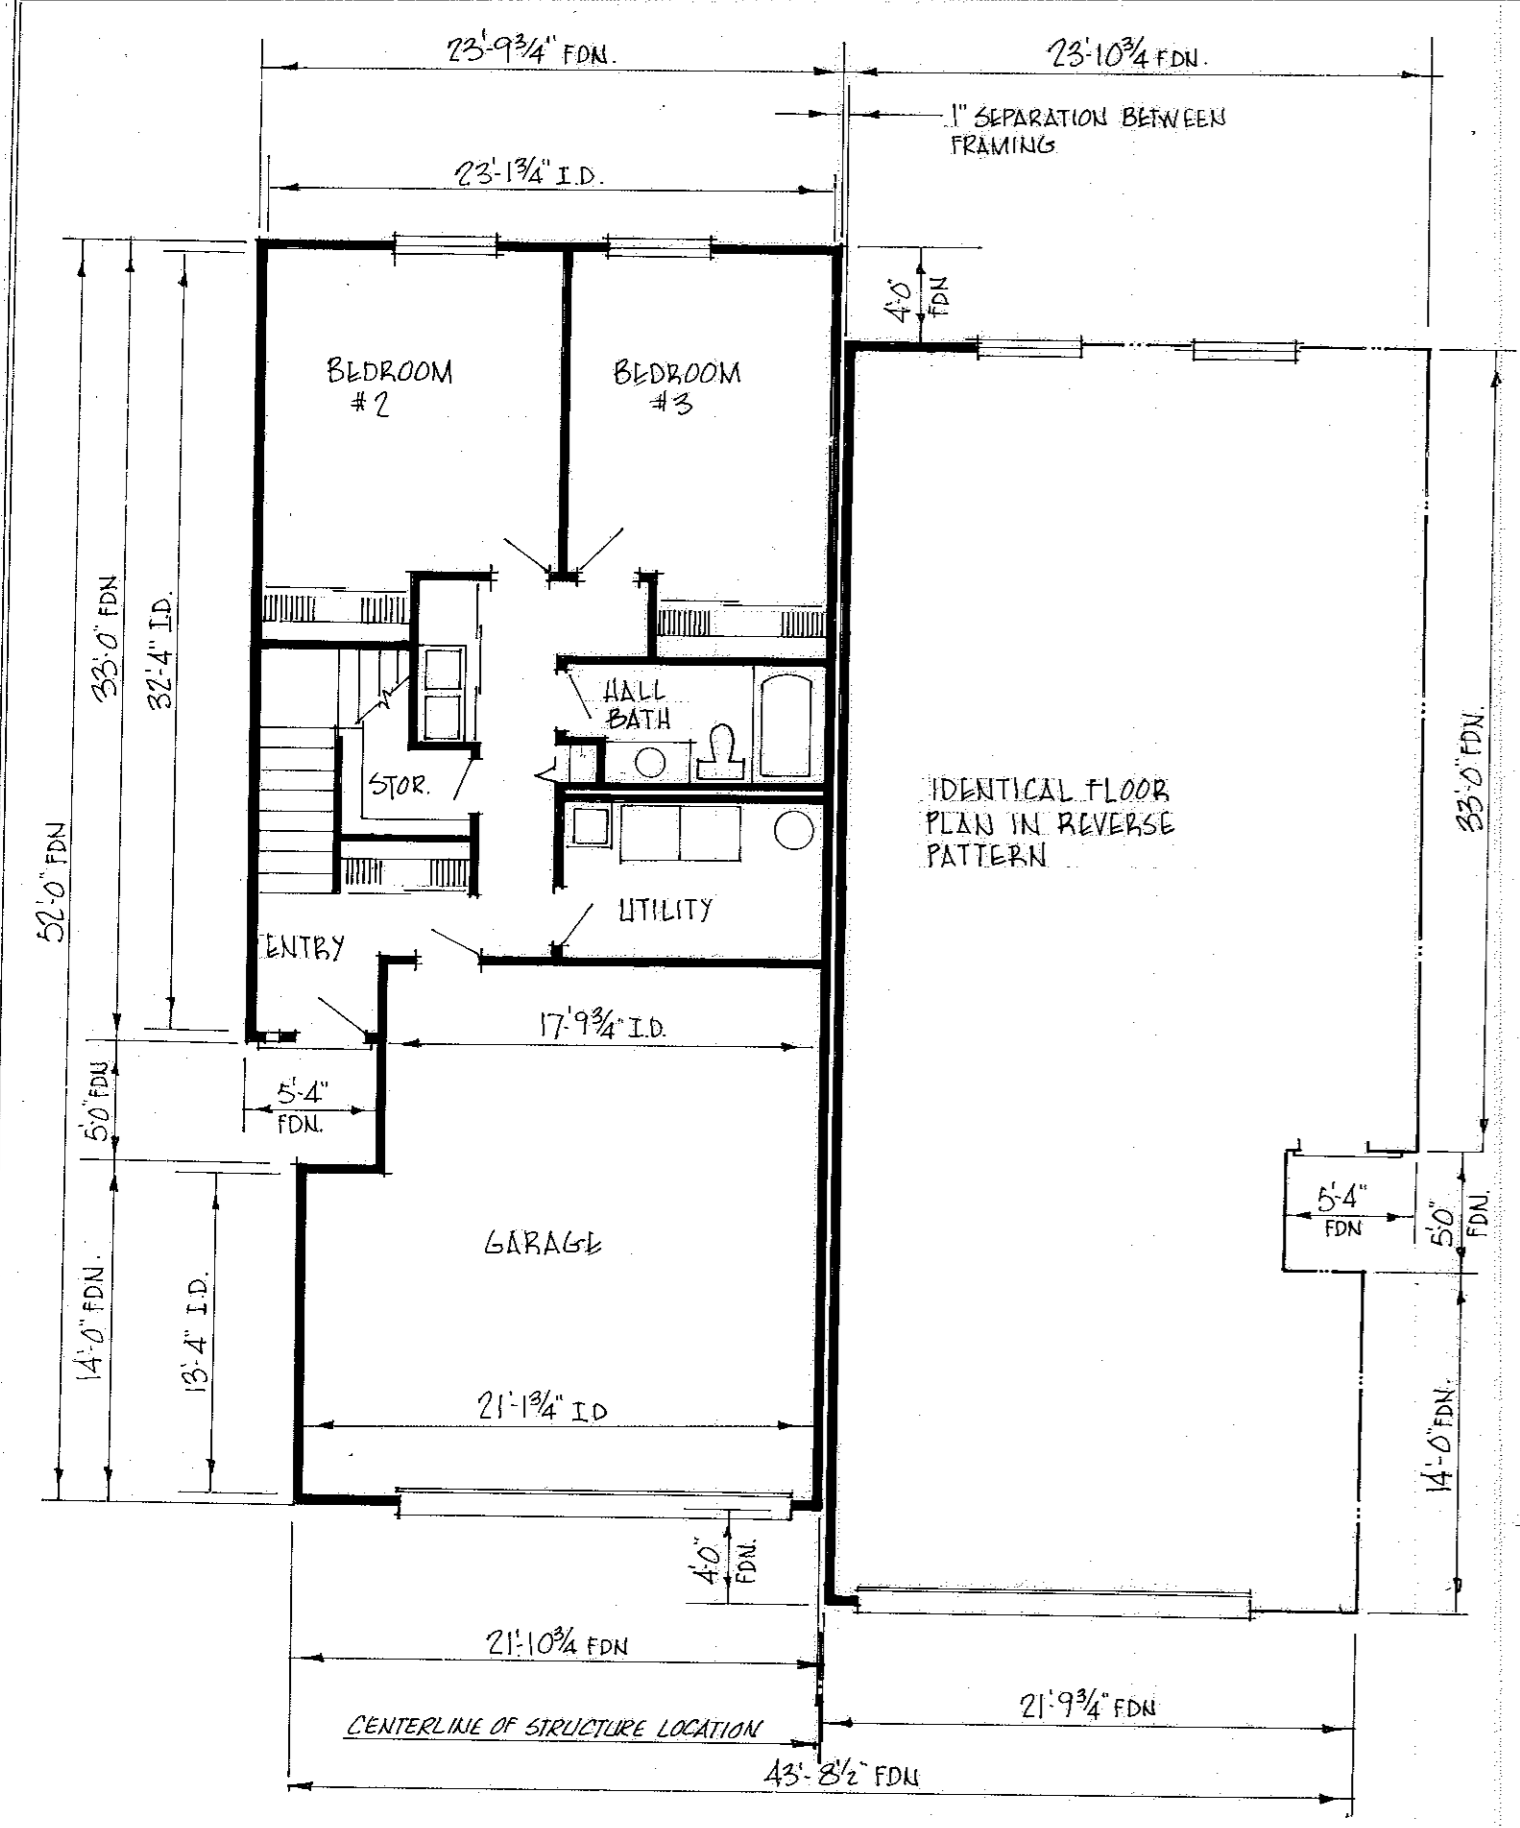


FIRST FLOOR PLAN SCALE 1/8"=1'-0"

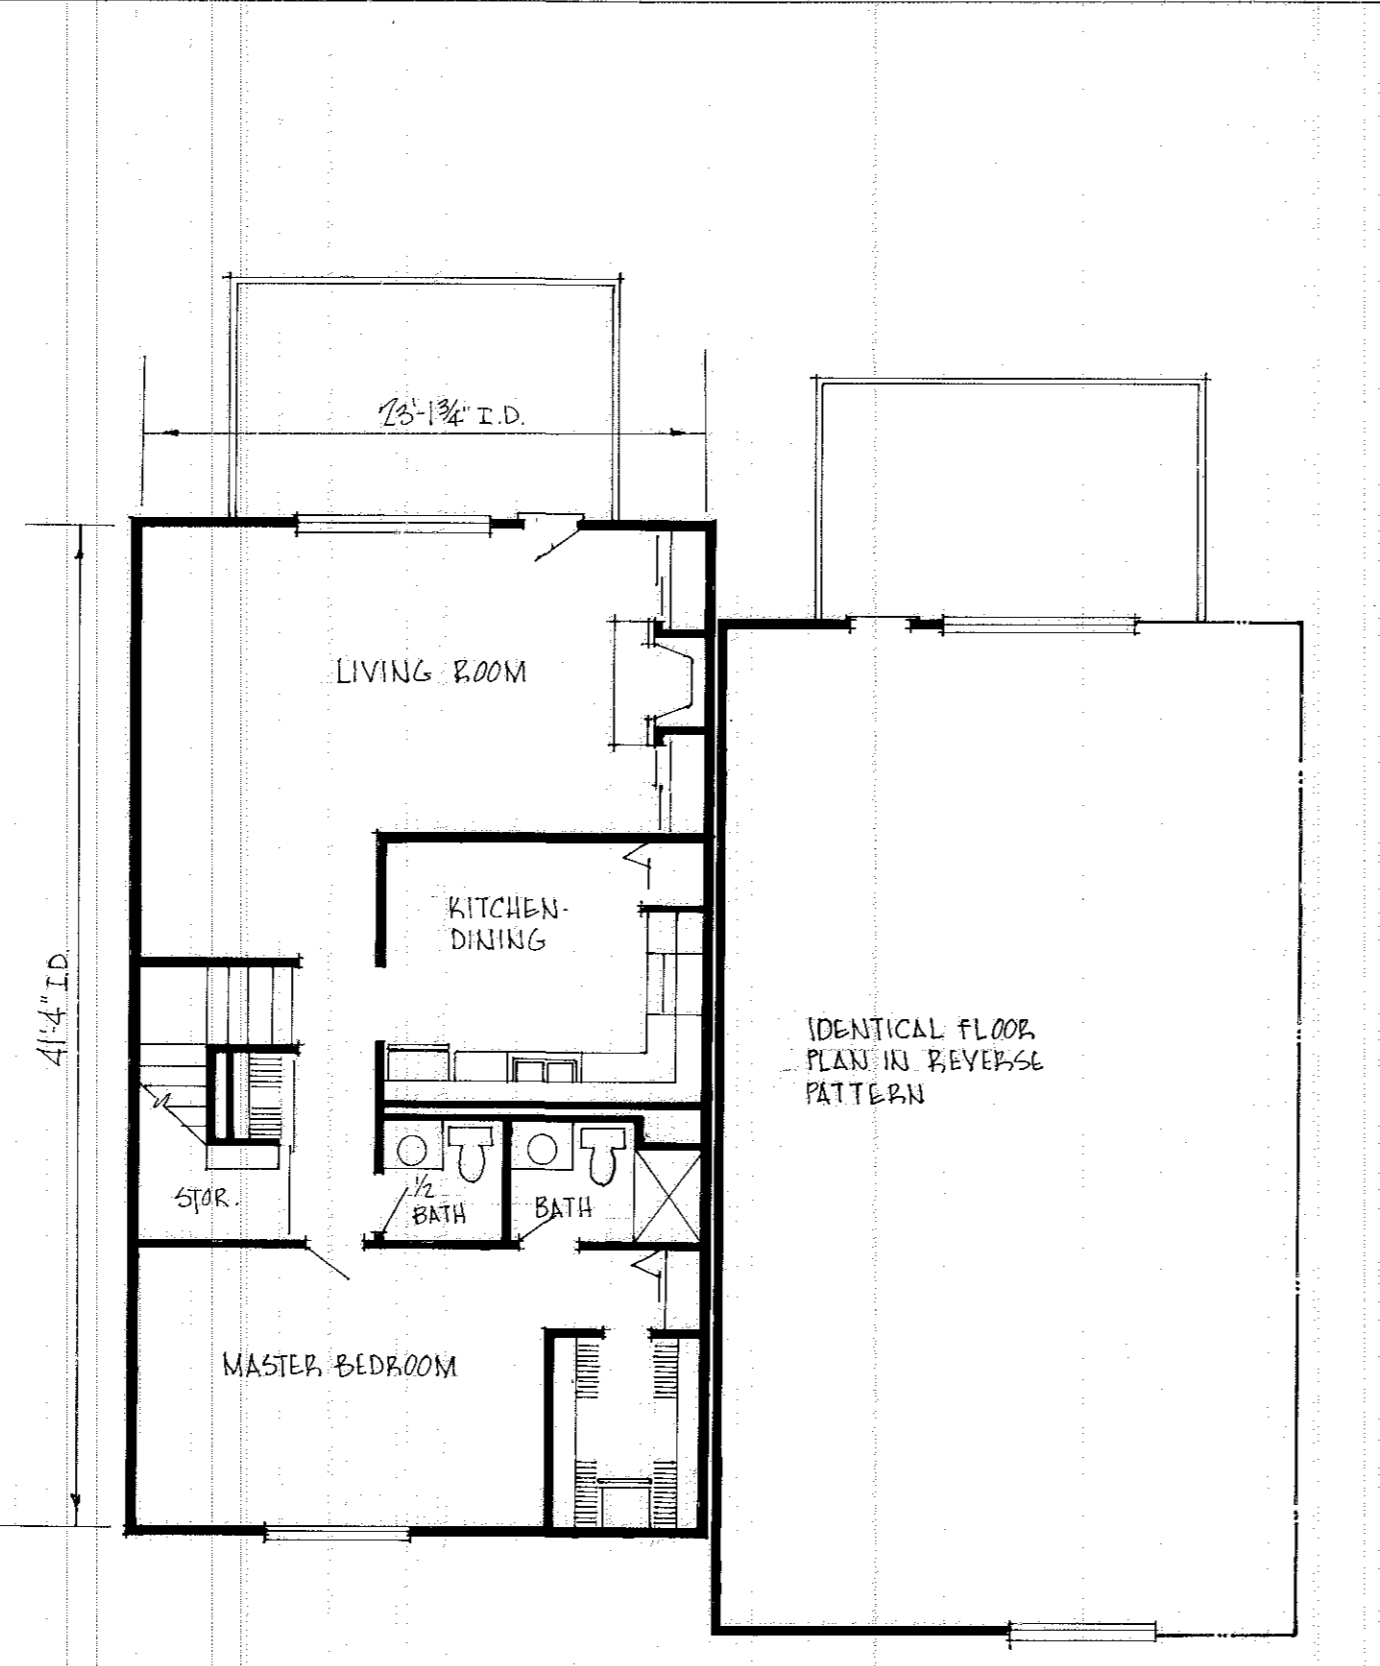


SECOND FLOOR PLAN SCALE 1/8"=1'-0"
FLOOR PLANS - UNIT MODEL 2202

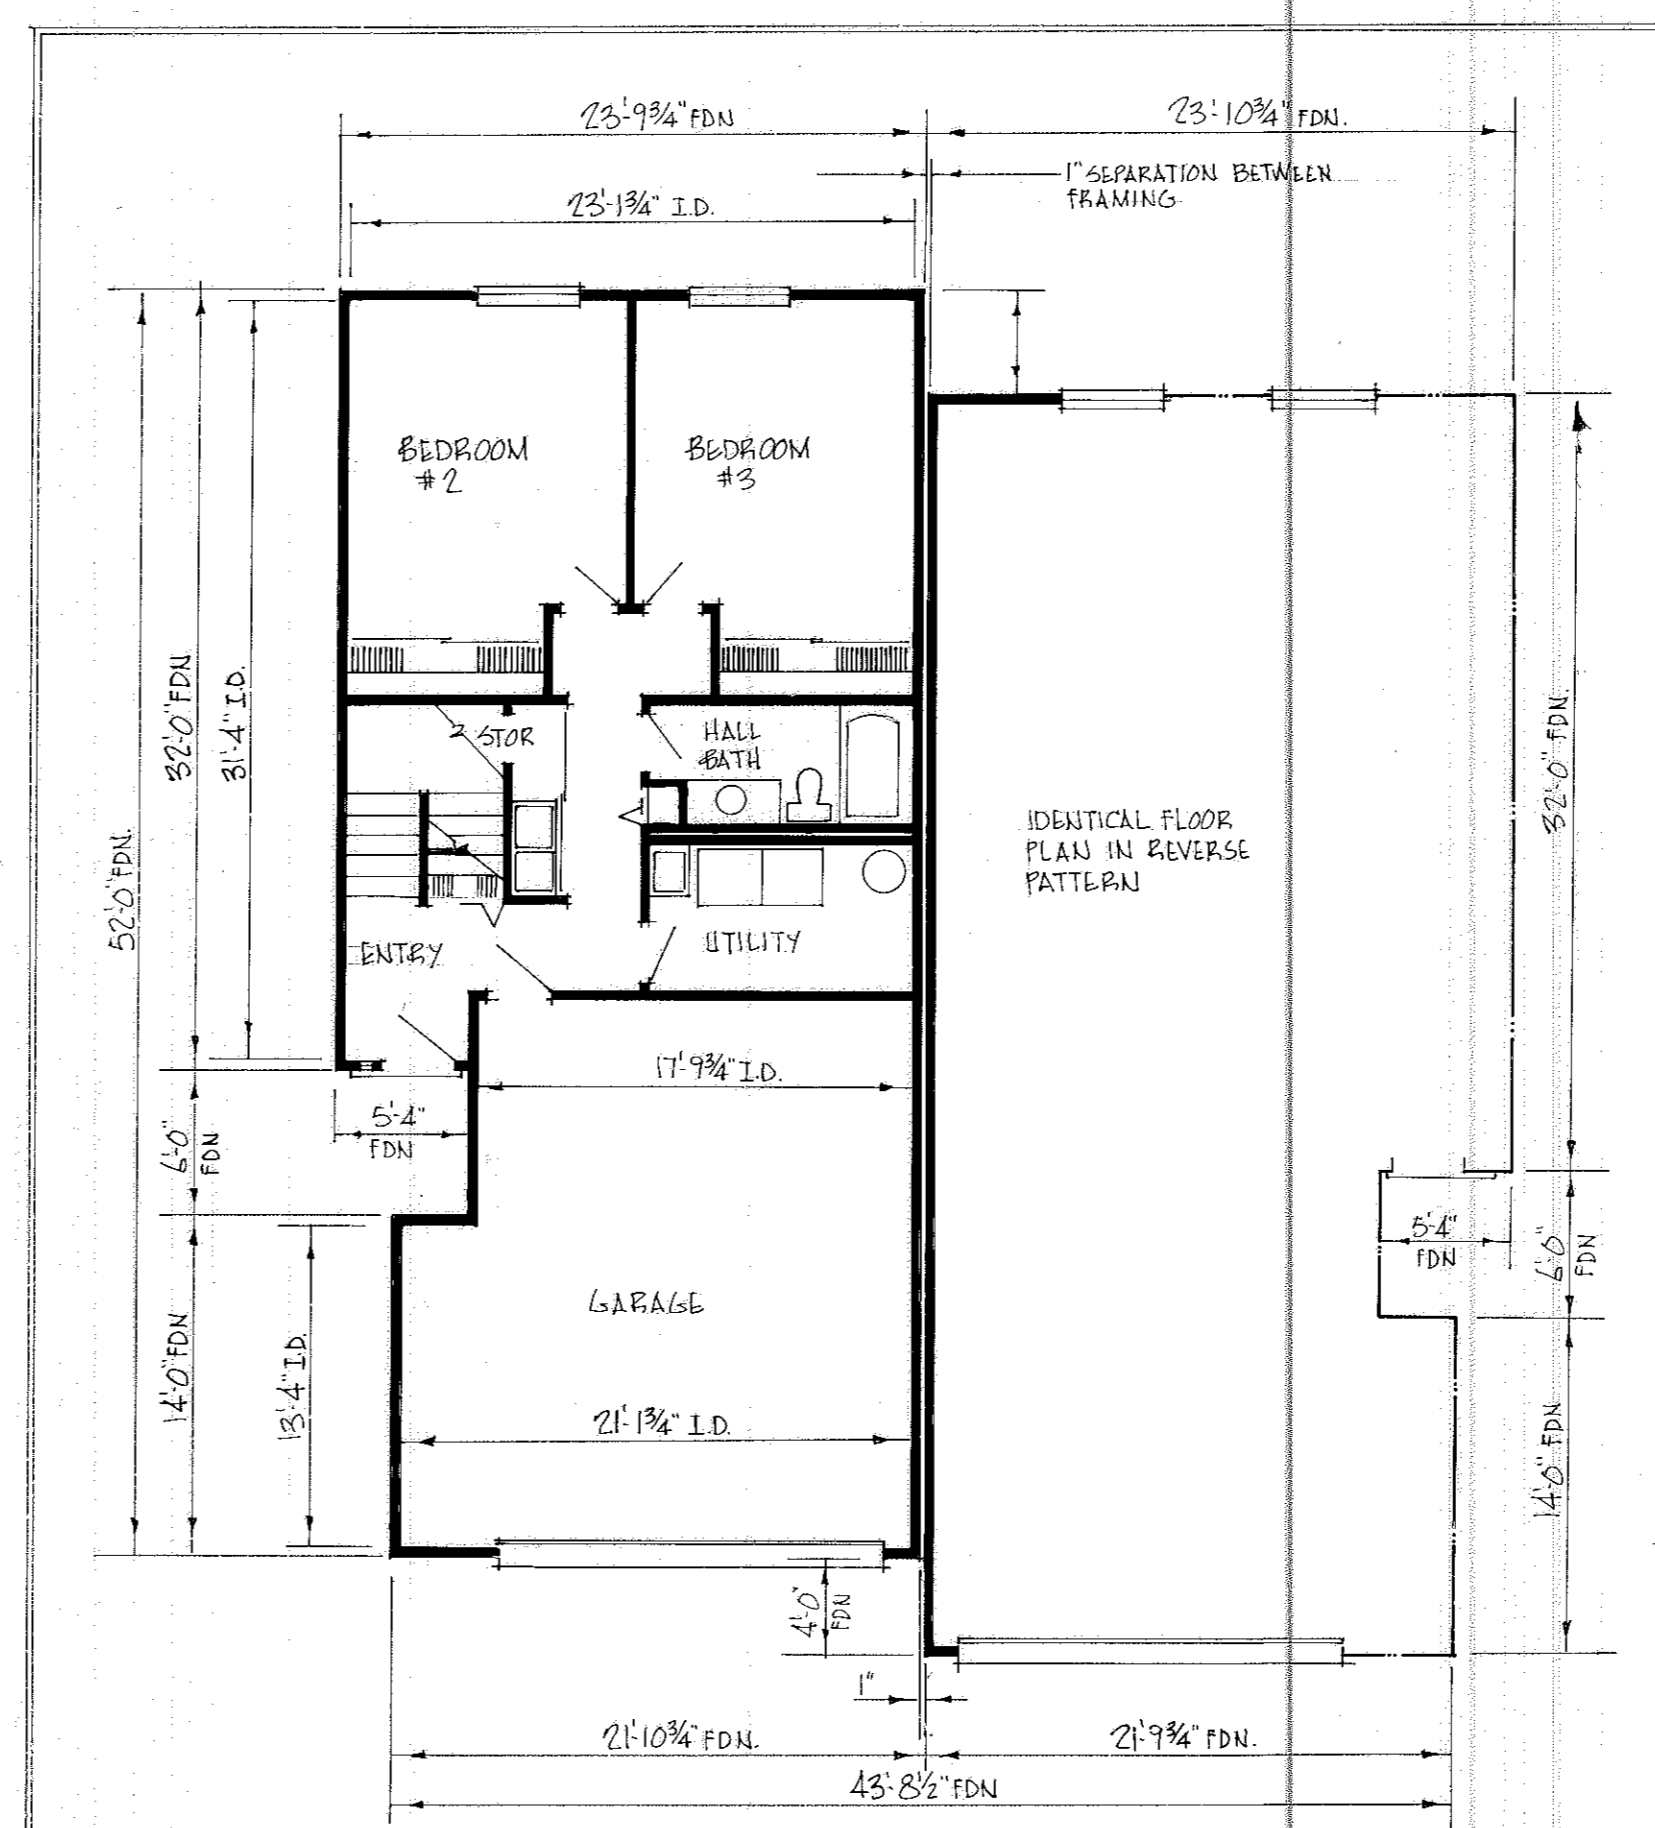


FIRST FLOOR PLAN SCALE 1/8"=1'-0"

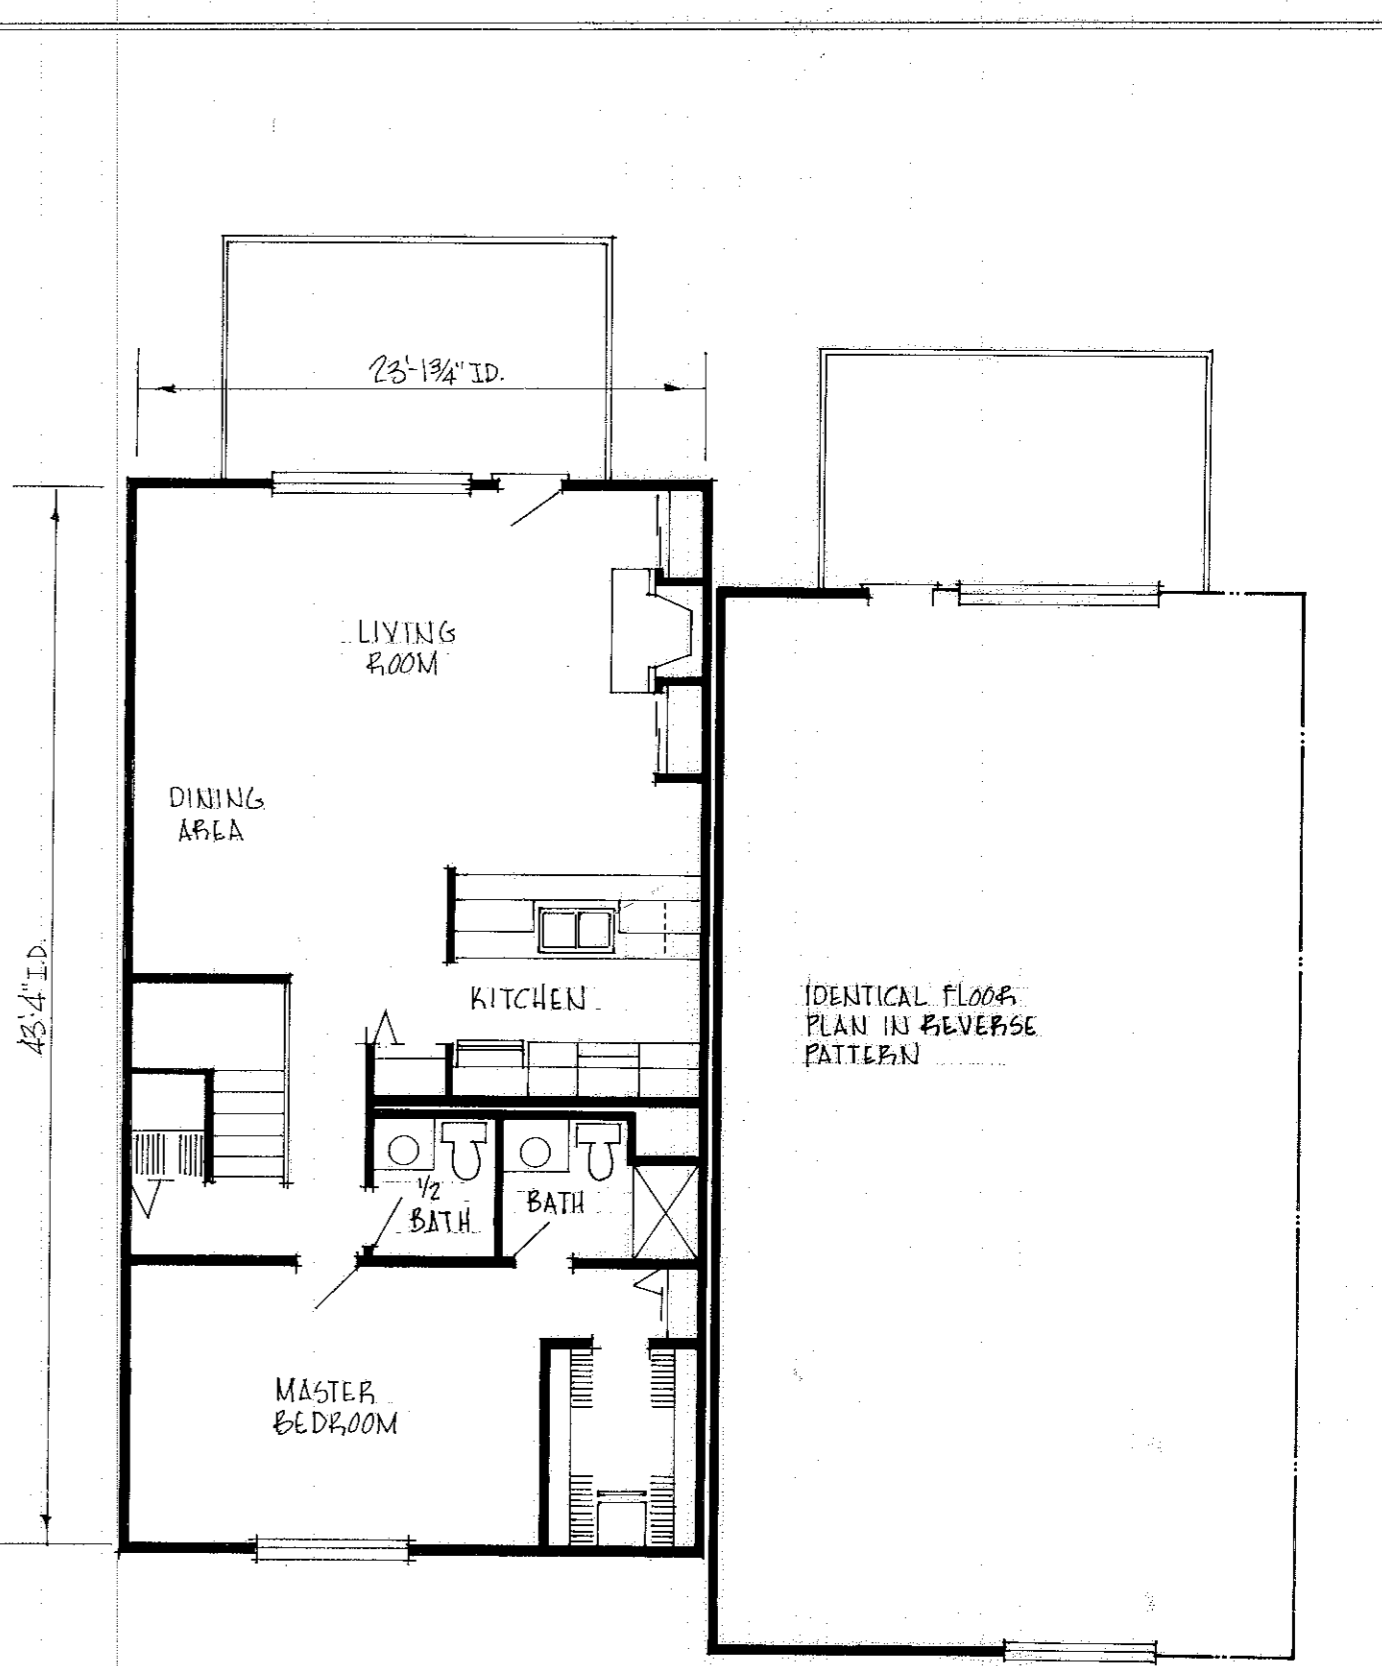

SECOND FLOOR PLAN SCALE 1/8"=1'-0"
FLOOR PLANS - UNIT MODEL 2244-B

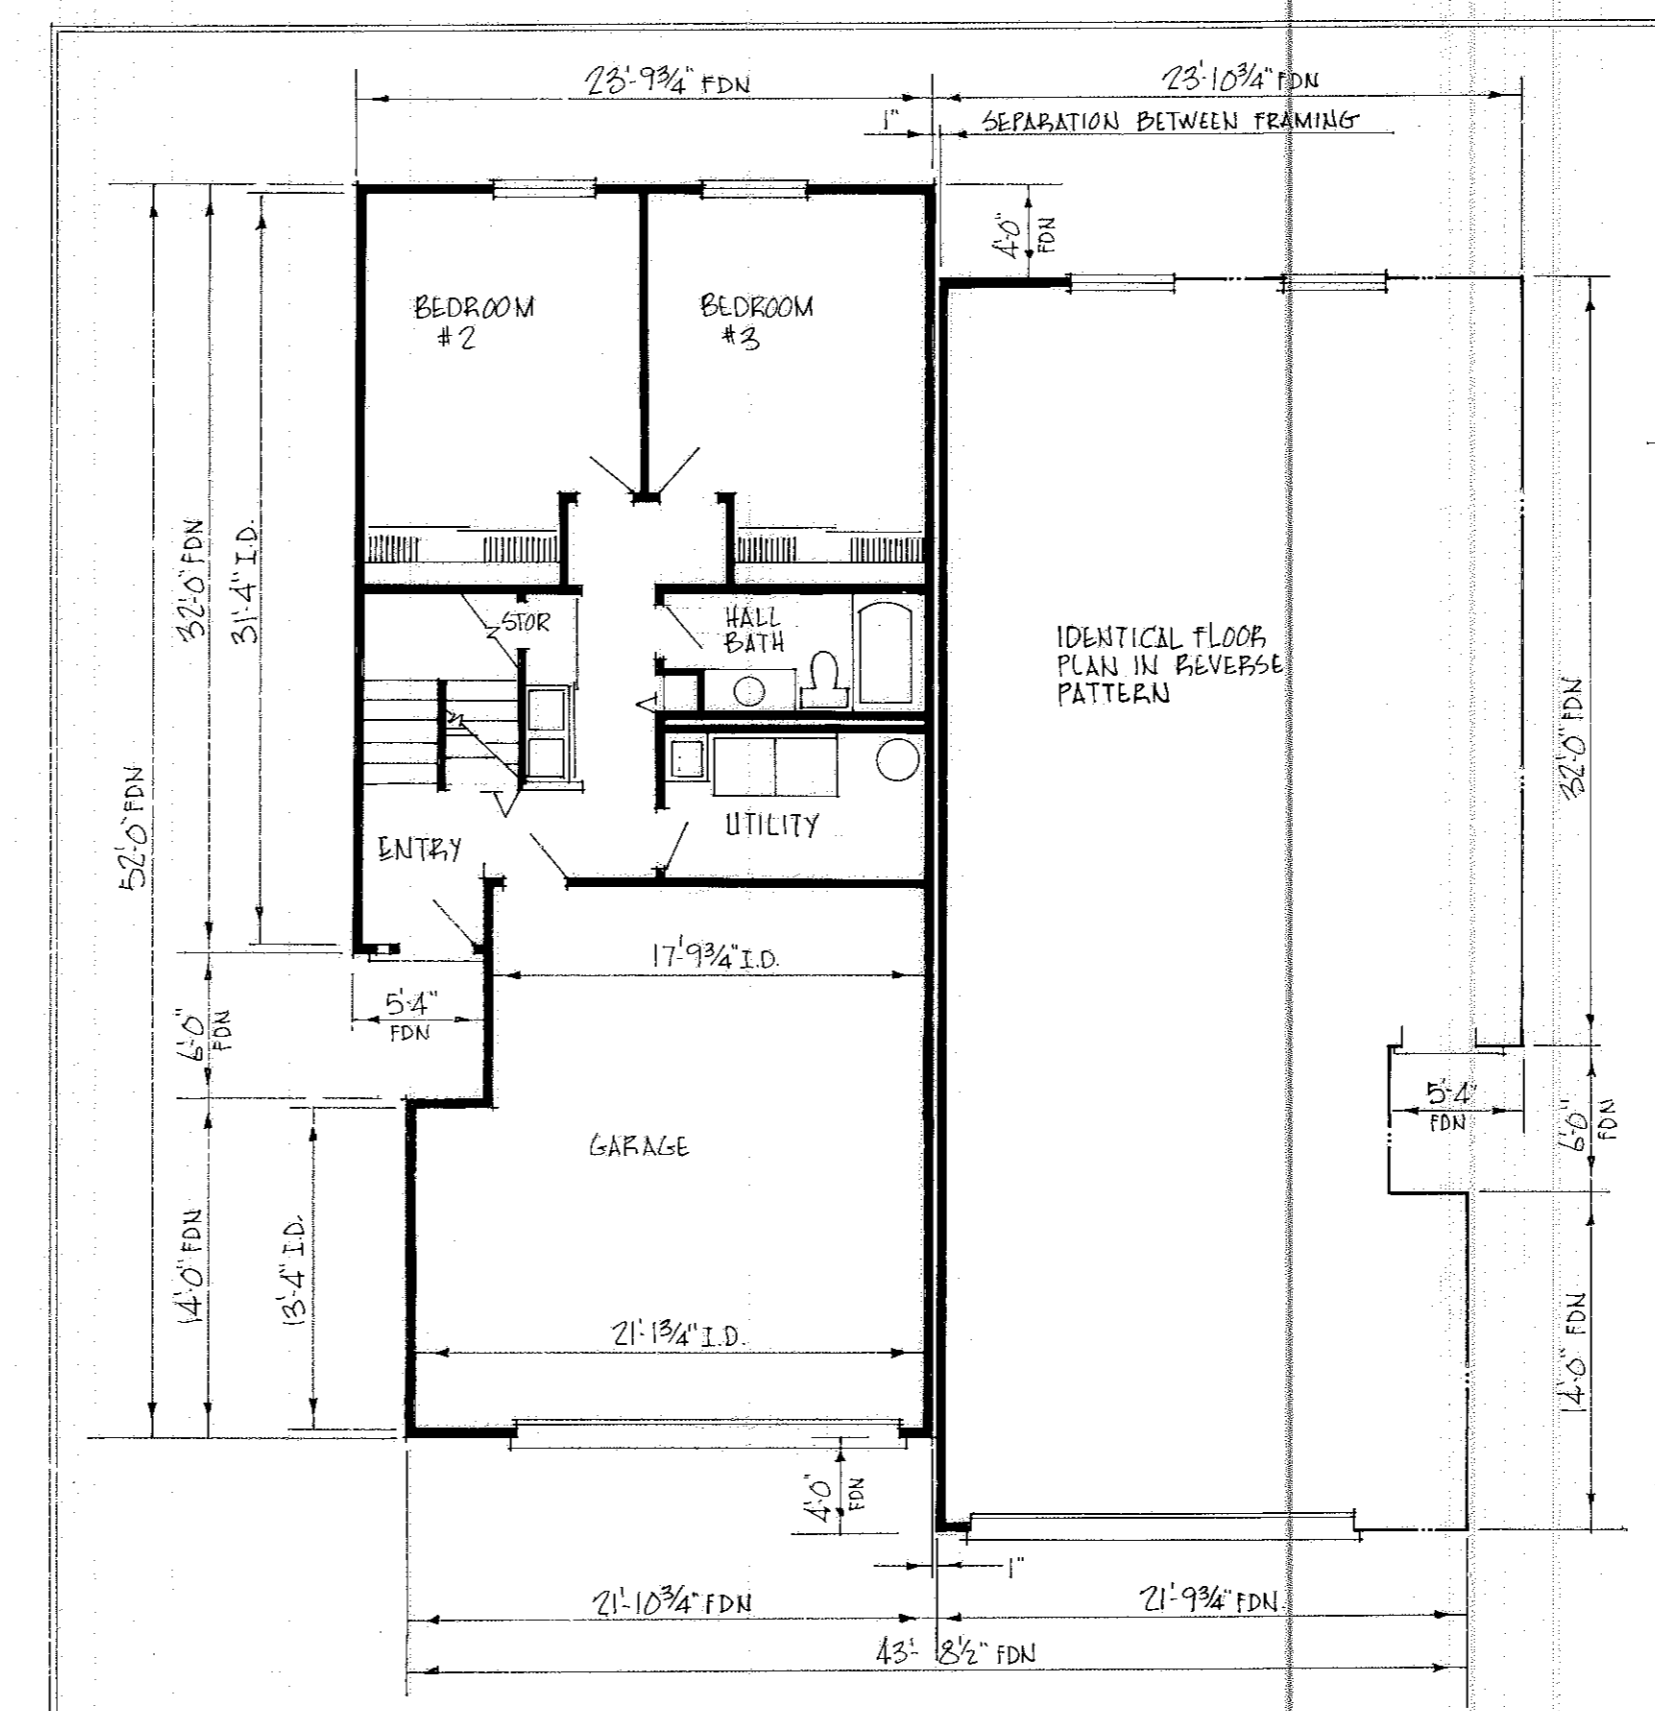

FIRST FLOOR PLAN SCALE 1/8"=1'-0"

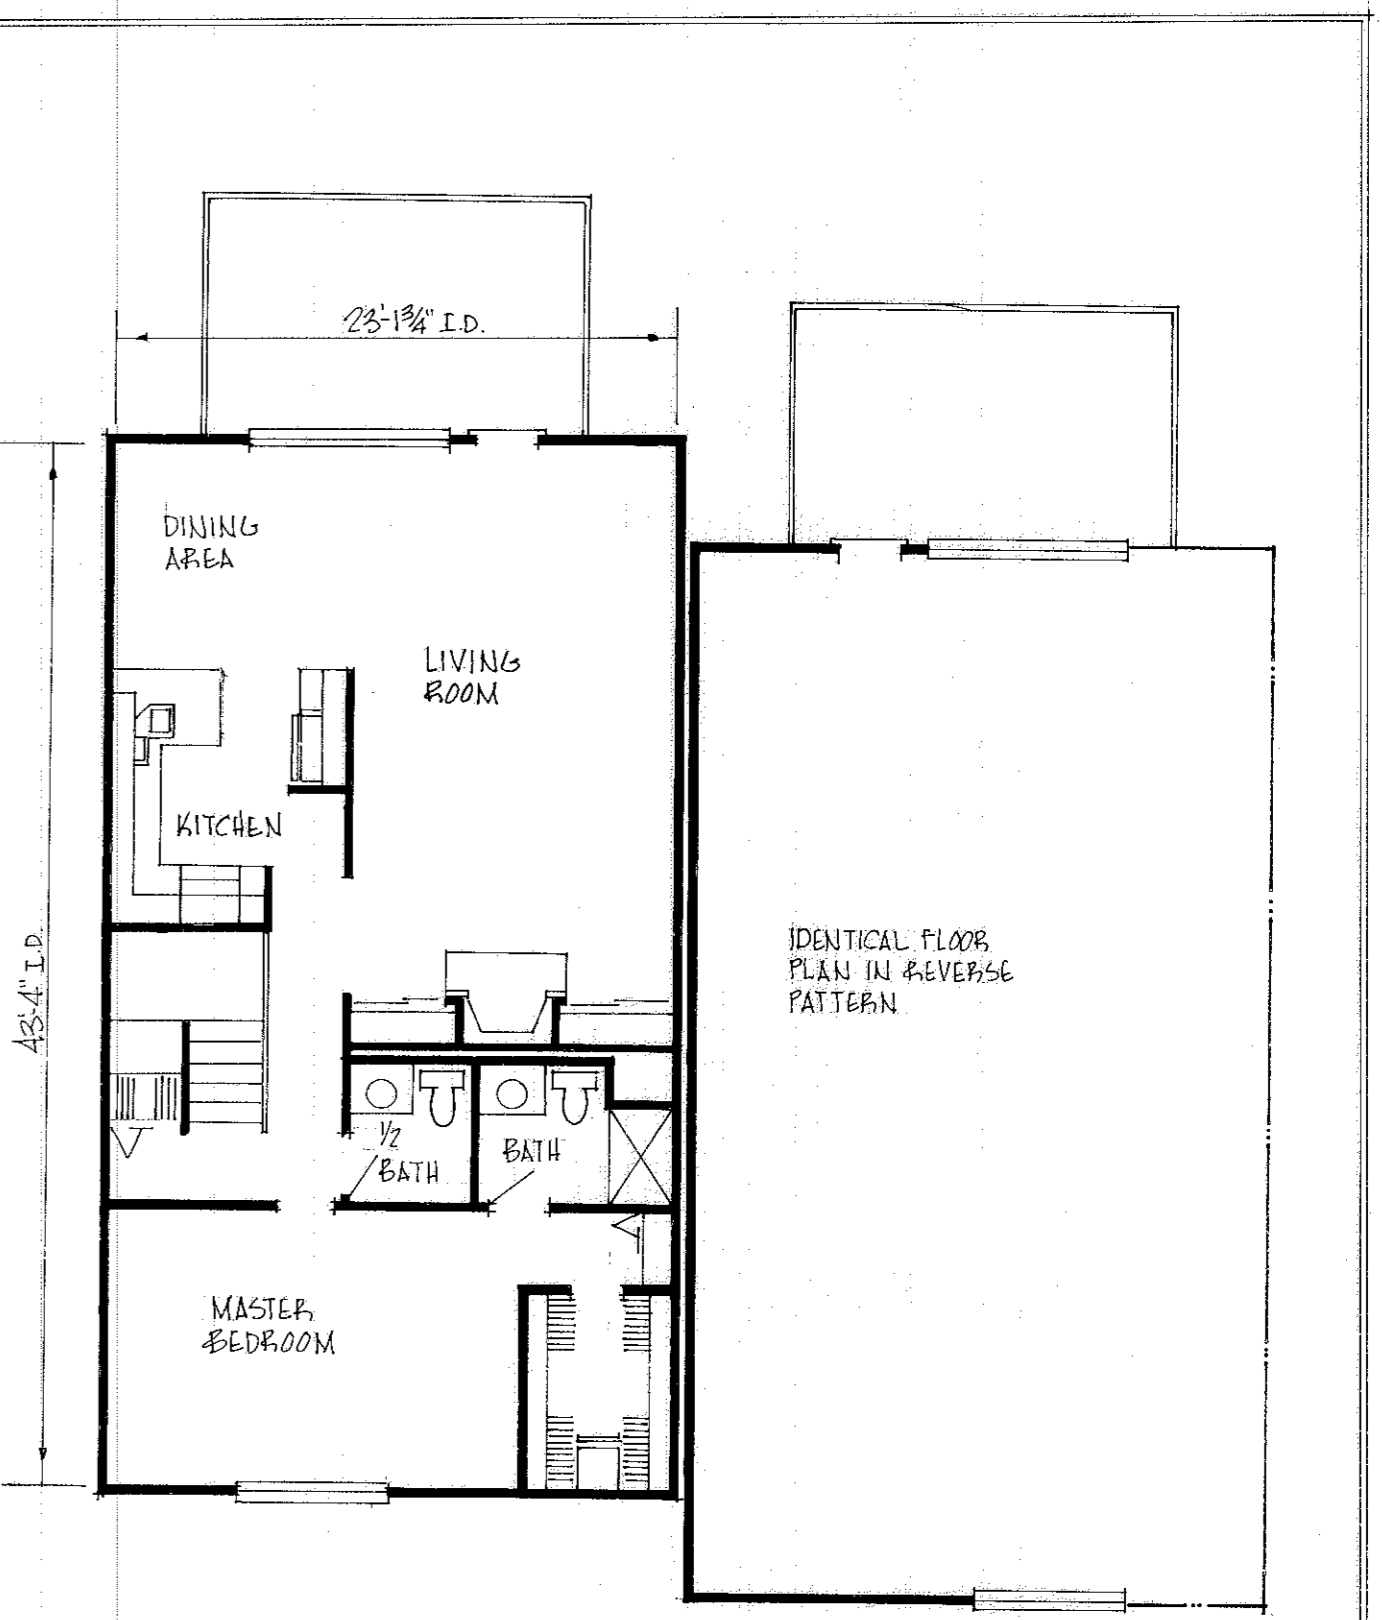

SECOND FLOOR PLAN SCALE 1/8"=1'-0"
FLOOR PLANS - UNIT MODEL 2244-A