

NOTE: DIMENSIONS SHOWN FOR BUILDING 22 ARE TYPICAL AND SHALL ALSO APPLY TO BUILDINGS 23, 24 & 25.

WATERMAIN AND ROADWAY EASEMENTS ARE RECORDED IN D.V. 1186 P. 041

THE LANDINGS SUBDIVISION NO. 2  
P.V. 32 P. 28-31

**THE LANDINGS CONDOMINIUM NO. 6**

1.485 ACRES EXHIBIT A


PART OF AVON TOWNSHIP SECTION 18  
CITY OF AVON LAKE COUNTY OF LORAIN

**STATEMENT OF CERTIFICATION**

I CERTIFY THAT THE ATTACHED DRAWINGS CORRECTLY REPRESENT THE DIMENSIONS OF THE BUILDINGS AS CONSTRUCTED AND THAT THERE ARE NO ENCROACHMENTS ON ANY ADJUTING PREMISES.

*James H. Schmidt*  
JAMES H. SCHMIDT REGISTERED SURVEYOR

PREPARED FOR: H. R. KOPF  
PREPARED BY: KLEINOEDER-SCHMIDT & ASSOCIATES  
CONSULTING ENGINEERS & SURVEYORS  
ELYRIA, OHIO

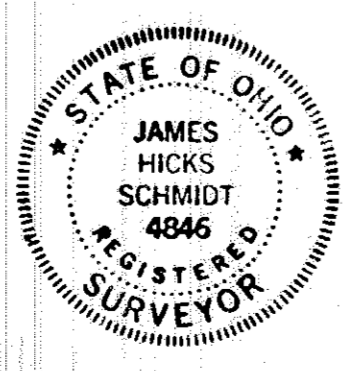


Received for Record  
on 2:25 clock P.M. in P.L.M. RECORDS  
VOL. 33  
PAGE 138.24  
Dorothy L. Coates  
Lorain County Recorder

TRANSFERRED  
IN COMPLIANCE WITH SECTION 133.02  
OHIO REV. CODE  
JUN 16 1978  
JULIAN A. PIJOR  
LORAIN COUNTY AUDITOR

KH Vol. Lorain County Title

Page 68, 69, 70, 71, 72, 73, 74, 75

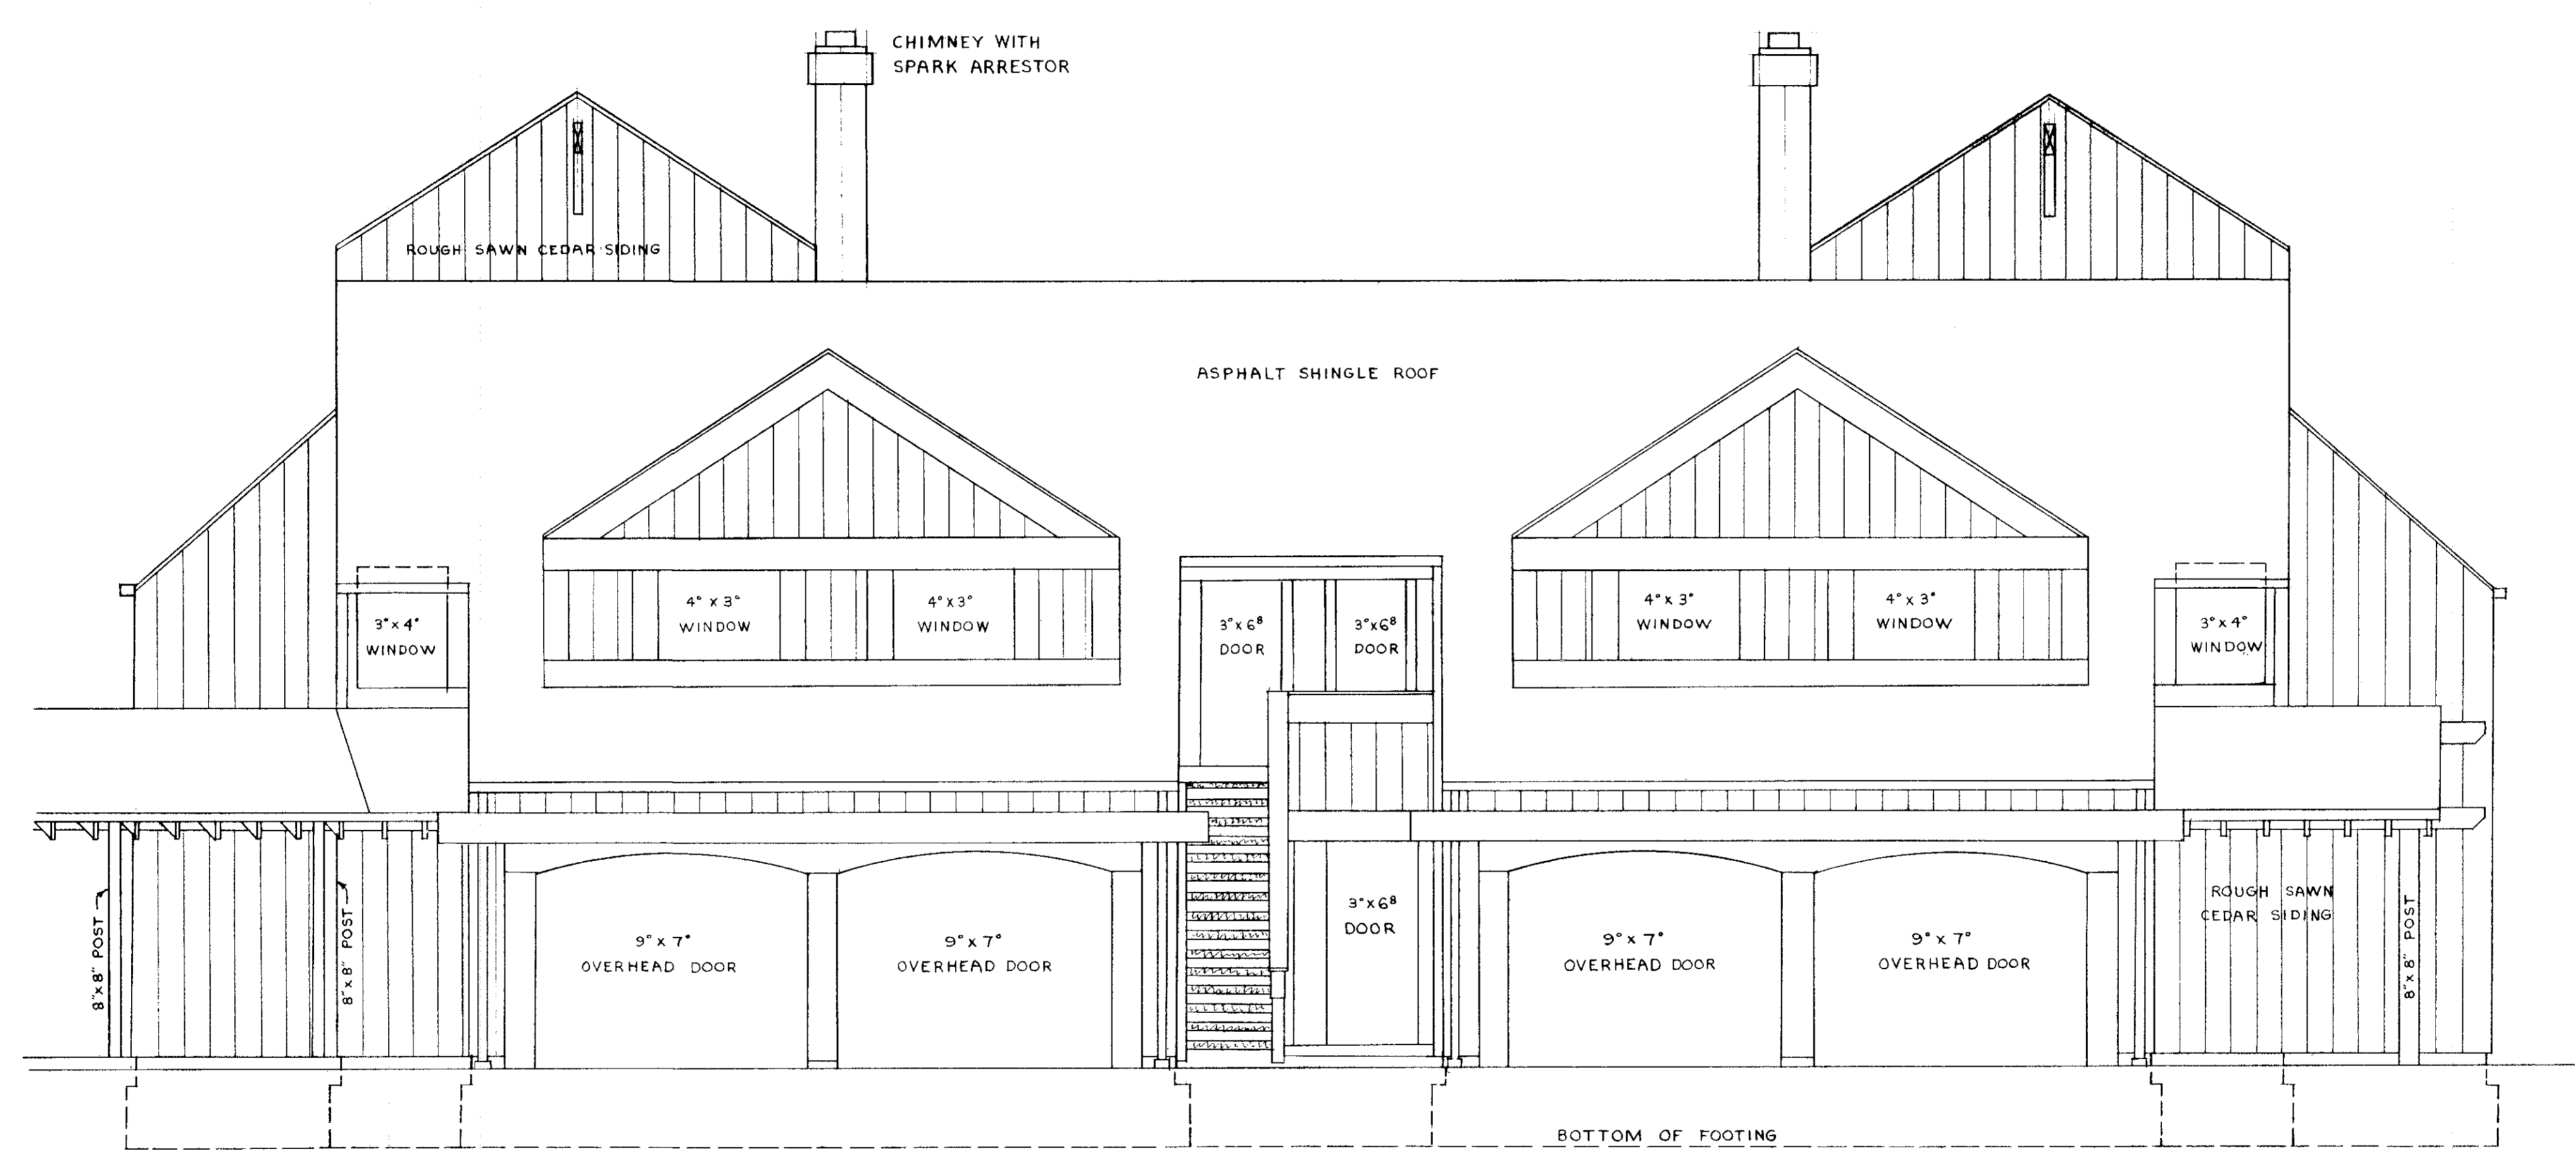

STATEMENT OF CERTIFICATION  
 I CERTIFY THAT THE ATTACHED DRAWINGS CORRECTLY REPRESENT THE DIMENSIONS OF THE BUILDINGS AS CONSTRUCTED AND THAT THERE ARE NO ENCROACHMENTS ON ANY ABUTTING PREMISES EXCEPT AS SHOWN.


*James H. Schmidt*  
 JAMES H. SCHMIDT  
 REGISTERED SURVEYOR

STATEMENT OF CERTIFICATION  
 I CERTIFY THAT THE ATTACHED DRAWINGS CORRECTLY REPRESENT THE DIMENSIONS OF THE BUILDINGS AS CONSTRUCTED.

*Robert E. Kleinoeder*  
 ROBERT E. KLEINOEDER  
 REGISTERED ENGINEER

FRONT ELEVATION  
 SCALE: 1/4" = 1'-0"

TRANSFERRED  
 IN COMPLIANCE WITH R.C.  
 OHIO REV. CODE  
 JUN 16 1978  
 JULIAN A. PIJOR  
 LORAIN COUNTY AUDITOR

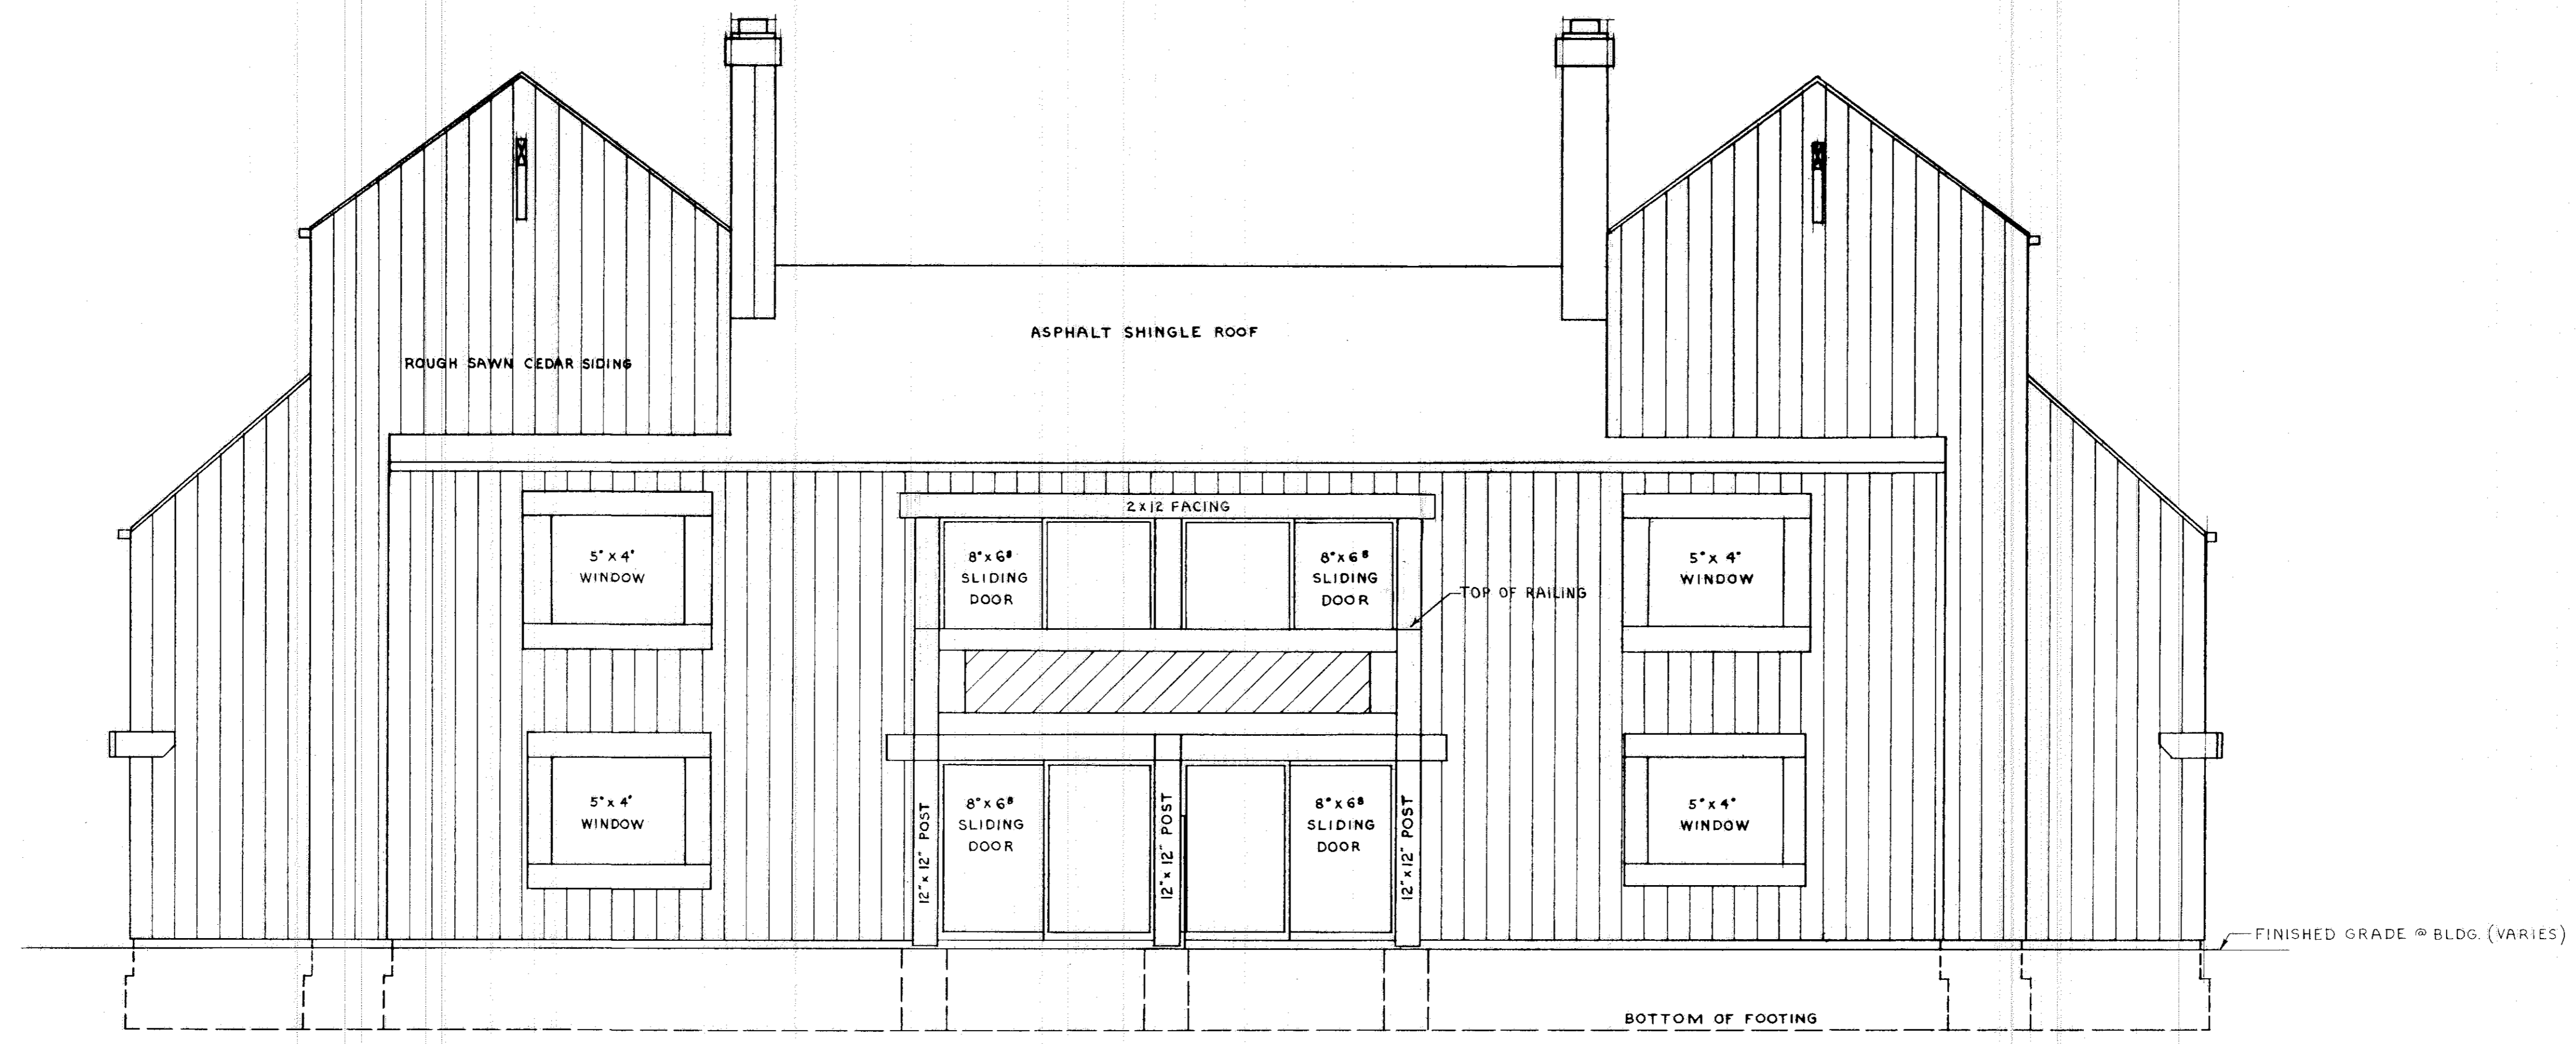

**STATEMENT OF CERTIFICATION**  
 I CERTIFY THAT THE ATTACHED DRAWINGS CORRECTLY REPRESENT THE DIMENSIONS OF THE BUILDINGS AS CONSTRUCTED AND THAT THERE ARE NO ENCROACHMENTS ON ANY ABUTTING PREMISES EXCEPT AS SHOWN.


*James H. Schmidt*  
 JAMES H. SCHMIDT  
 REGISTERED SURVEYOR

**STATEMENT OF CERTIFICATION**  
 I CERTIFY THAT THE ATTACHED DRAWINGS CORRECTLY REPRESENT THE DIMENSIONS OF THE BUILDINGS AS CONSTRUCTED.

*Robert C. Kleinoeder*  
 ROBERT C. KLEINOEDER  
 REGISTERED ENGINEER

**REAR ELEVATION**  
 SCALE: 1/4" = 1'-0"

TRANSFERRED  
 IN COMPLIANCE WITH SEC. 319-022  
 OHIO REV. CODE  
 JUN 16 1978  
*See Book*  
 JULIAN A. PIJOR  
 LORAIN COUNTY AUDITOR

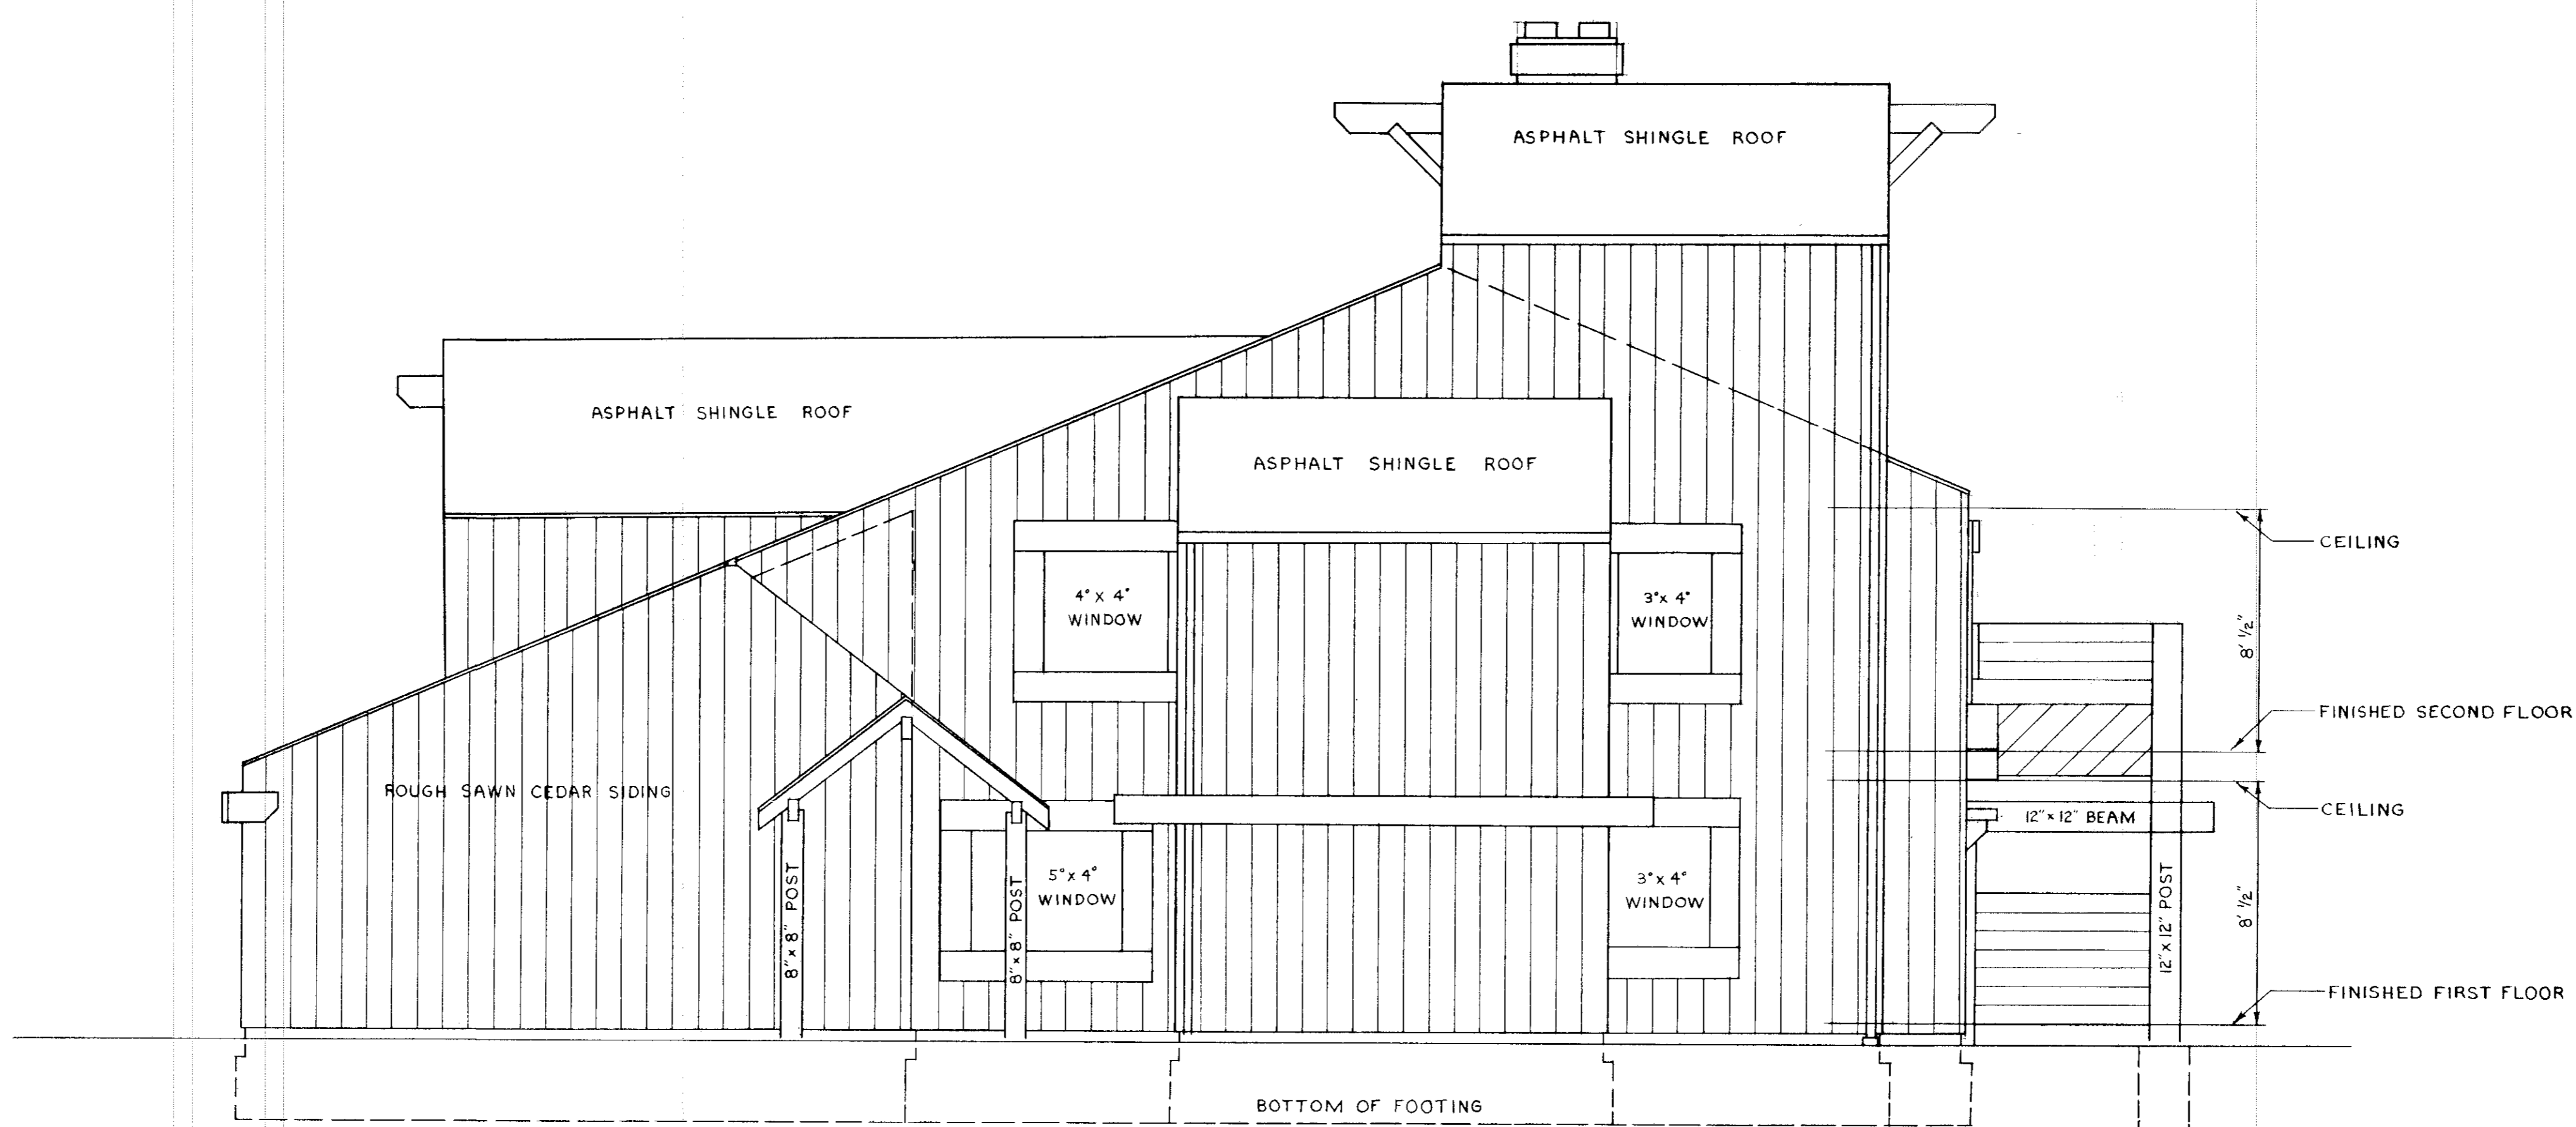

STATEMENT OF CERTIFICATION  
 I CERTIFY THAT THE ATTACHED DRAWINGS CORRECTLY  
 REPRESENT THE DIMENSIONS OF THE BUILDINGS AS CONSTRUCTED  
 AND THAT THERE ARE NO ENCROACHMENTS ON ANY ABUTTING  
 PREMISES EXCEPT AS SHOWN.


*James H. Schmidt*  
 JAMES H. SCHMIDT  
 REGISTERED SURVEYOR

STATEMENT OF CERTIFICATION  
 I CERTIFY THAT THE ATTACHED DRAWINGS CORRECTLY  
 REPRESENT THE DIMENSIONS OF THE BUILDINGS AS CONSTRUCTED.

*Robert E. Kleinoeder*  
 ROBERT E. KLEINOEDER  
 REGISTERED ENGINEER

RIGHT SIDE ELEVATION  
 SCALE: 1/4" = 1'-0"

TRANSFERRED  
 IN COMPLIANCE WITH SEC. 319-202  
 OHIO REV. CODE  
 JUN 16 1978  
 JULIAN A. PIJOR  
 LORAIN COUNTY AUDITOR

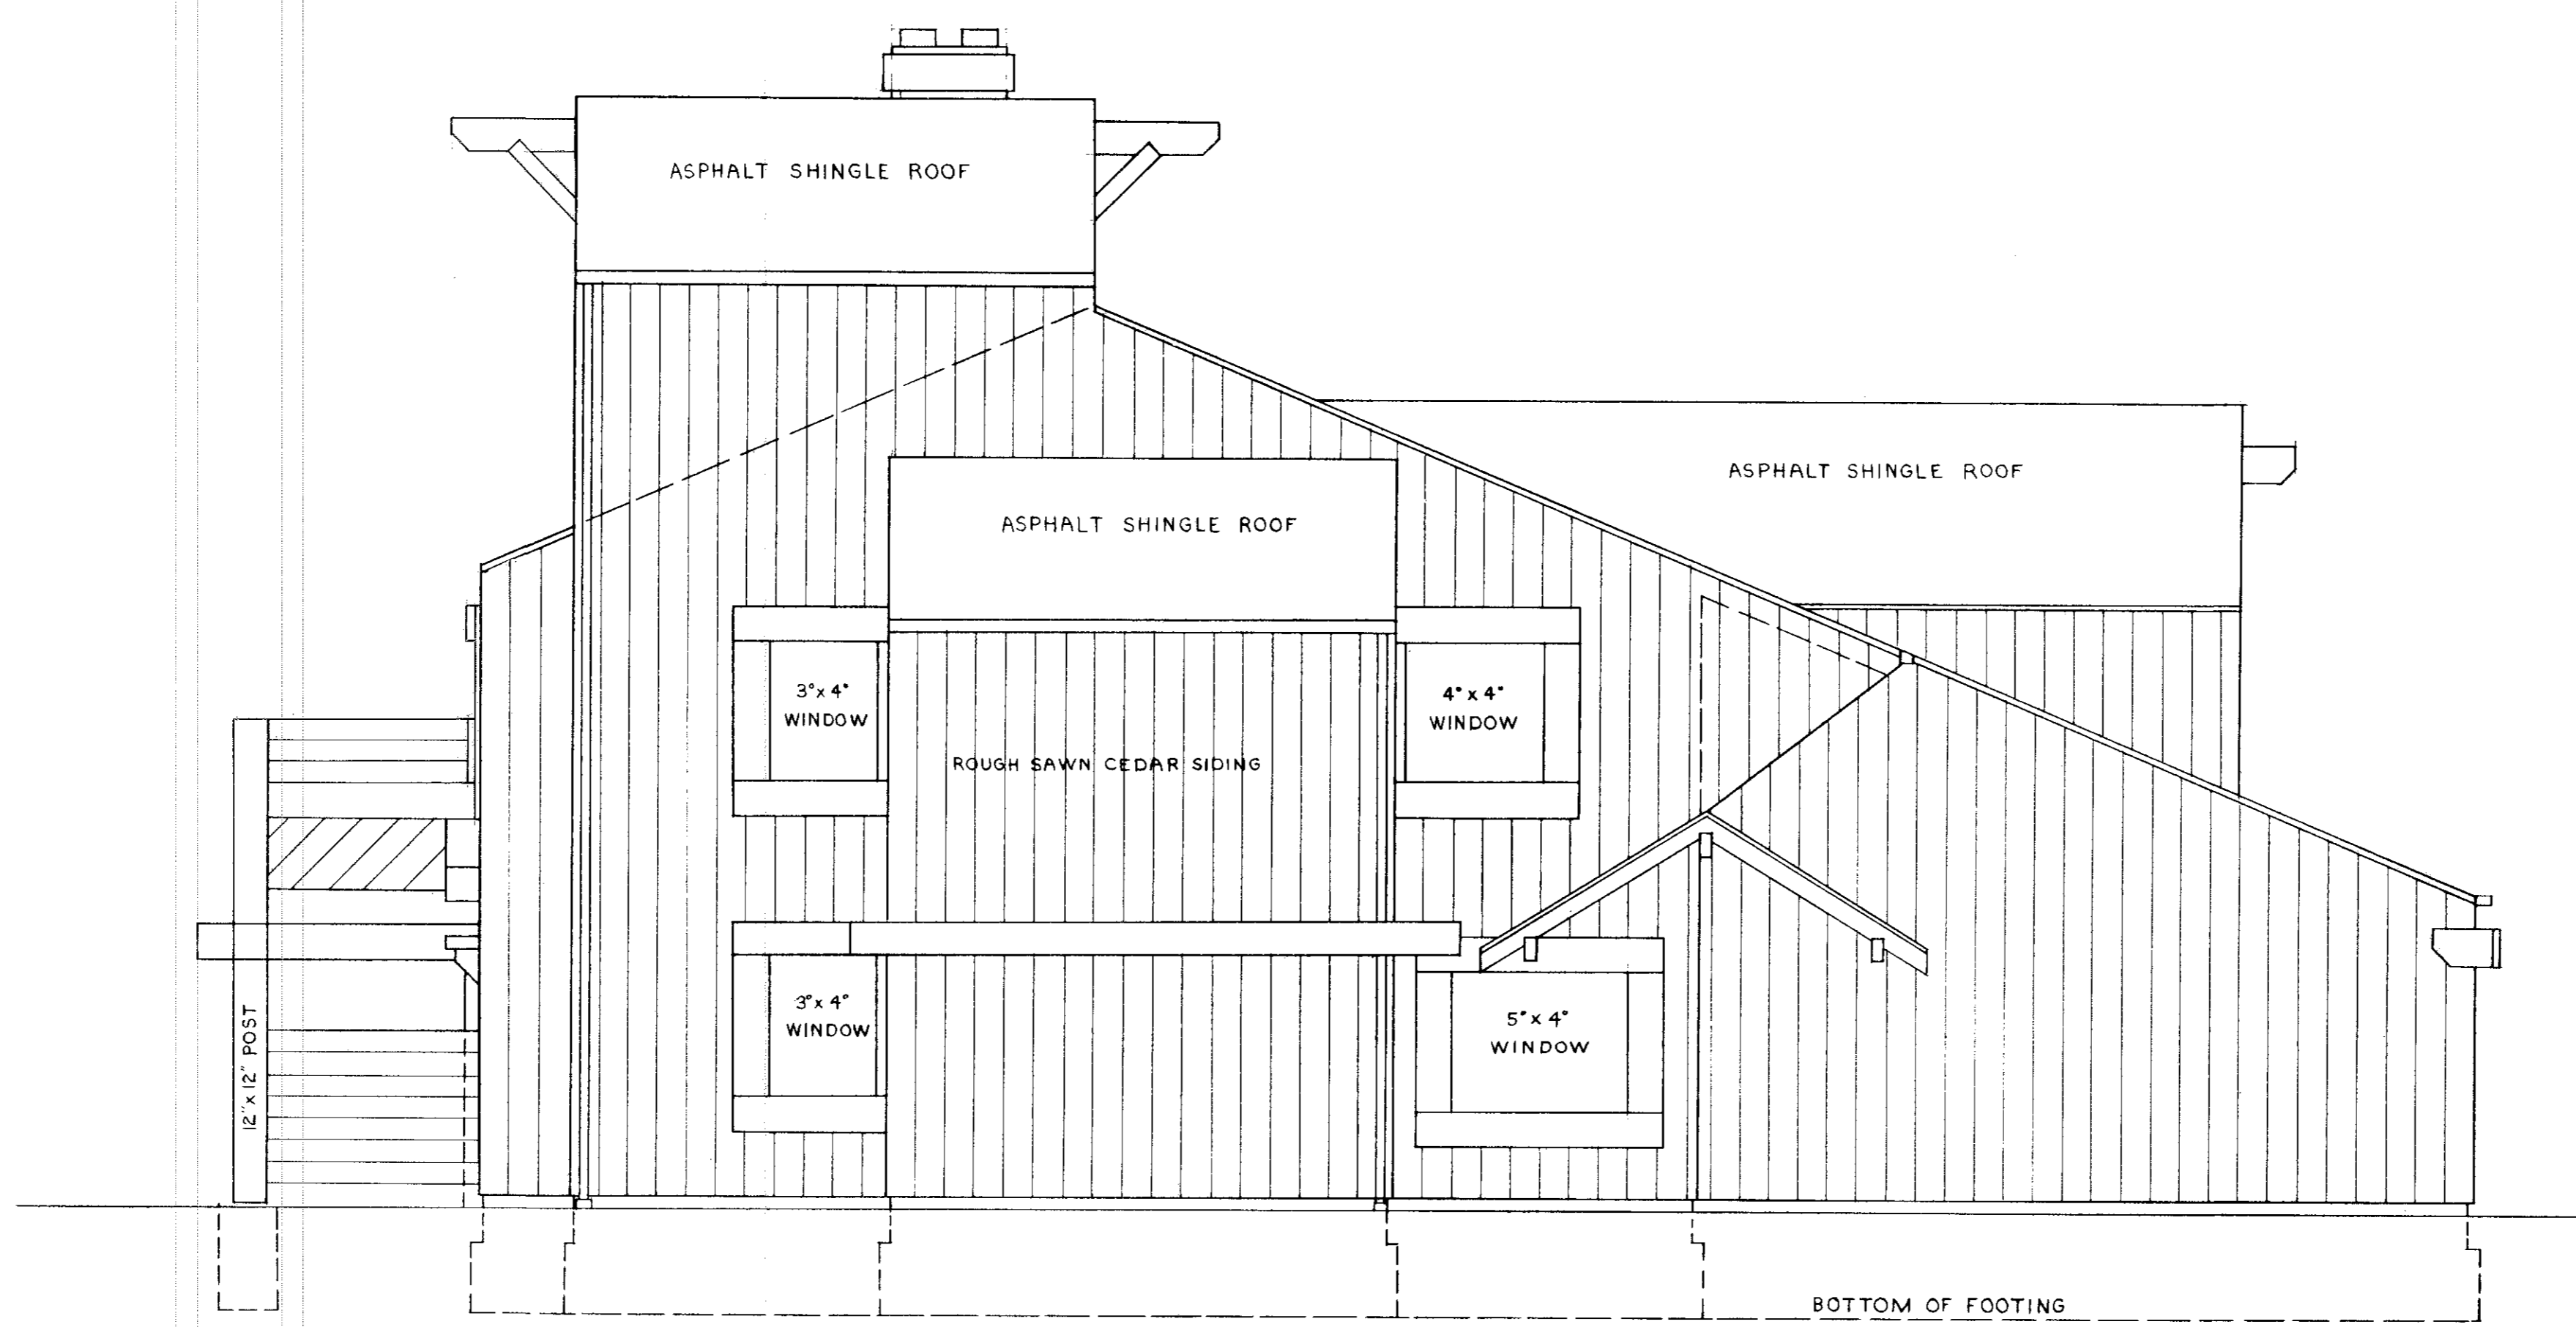

STATEMENT OF CERTIFICATION  
 I CERTIFY THAT THE ATTACHED DRAWINGS CORRECTLY  
 REPRESENT THE DIMENSIONS OF THE BUILDINGS AS CONSTRUCTED  
 AND THAT THERE ARE NO ENCROACHMENTS ON ANY ABUTTING  
 PREMISES EXCEPT AS SHOWN.


*James H. Schmidt*  
 JAMES H. SCHMIDT  
 REGISTERED SURVEYOR

STATEMENT OF CERTIFICATION  
 I CERTIFY THAT THE ATTACHED DRAWINGS CORRECTLY  
 REPRESENT THE DIMENSIONS OF THE BUILDINGS AS CONSTRUCTED.

*Robert E. Kueinoder*  
 ROBERT E. KUEINODER  
 REGISTERED ENGINEER

LEFT SIDE ELEVATION  
 SCALE: 1/4" = 1'-0"

TRANSFERRED  
 IN COMPLIANCE WITH SEC. 133-9-022  
 OHIO REV. CODE  
 JUN 16 1978  
 JULIAN A. PIJOR  
 LORAIN COUNTY AUDITOR

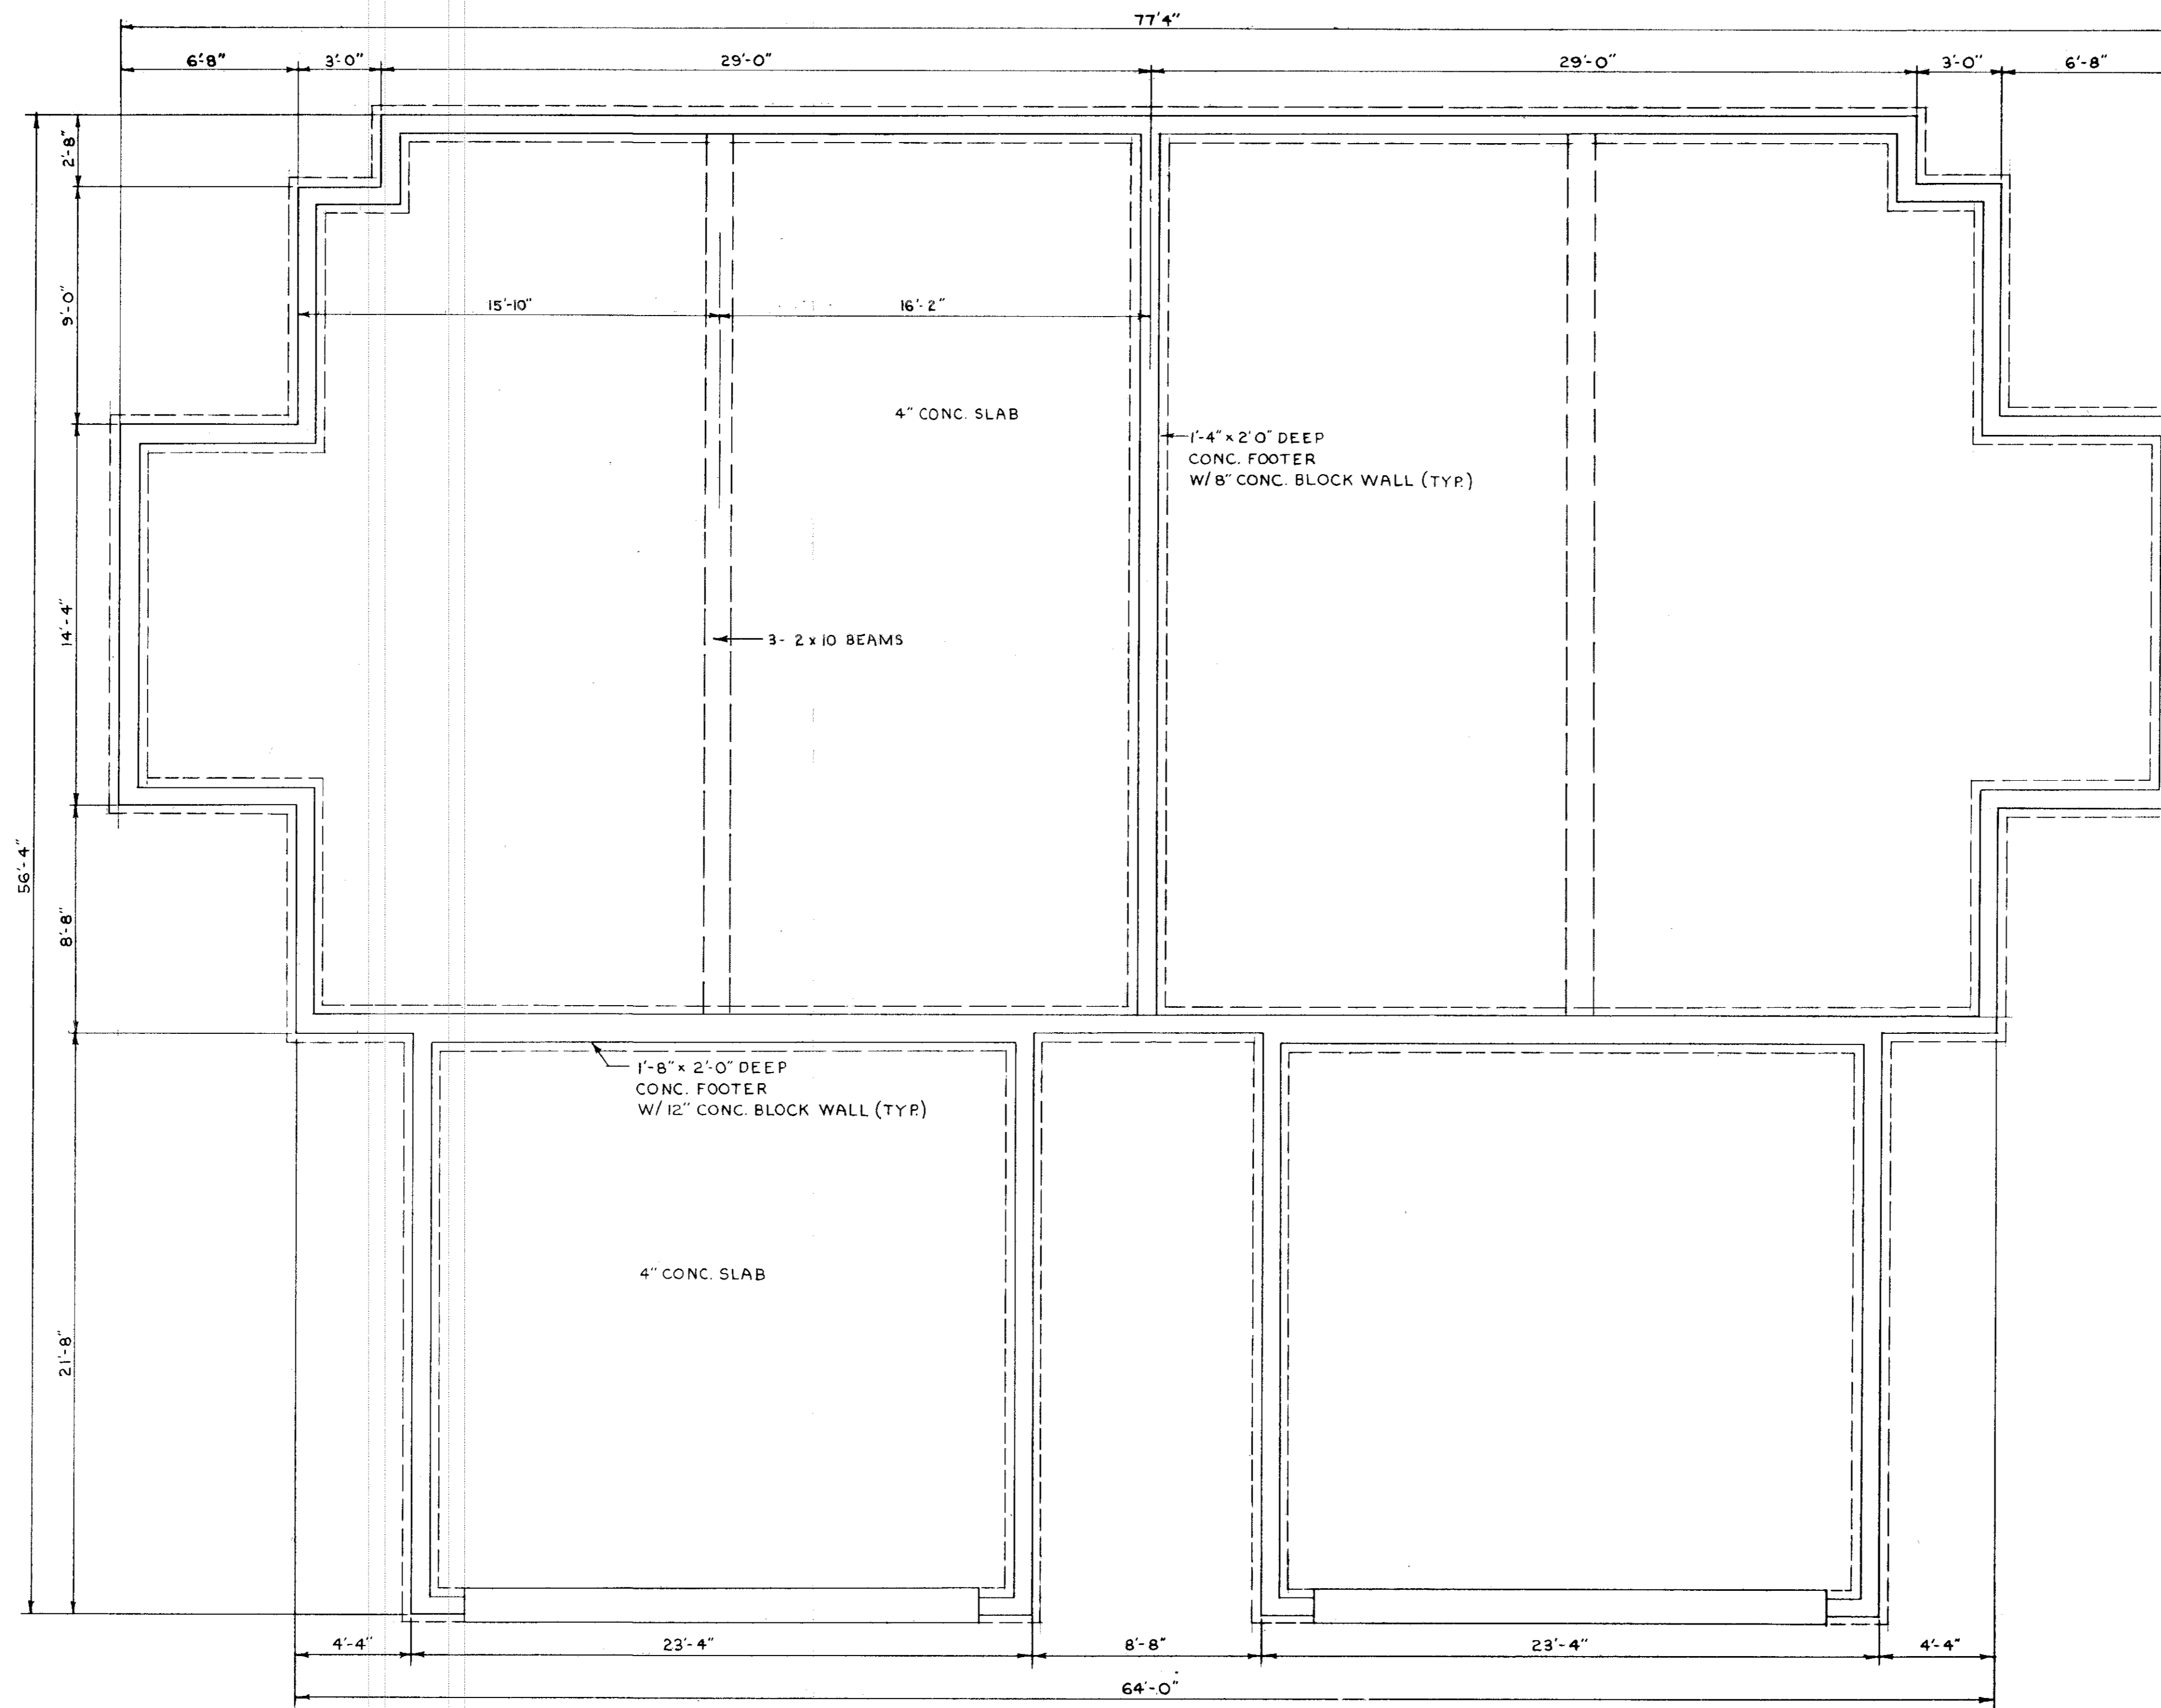

STATEMENT OF CERTIFICATION  
 I CERTIFY THAT THE ATTACHED DRAWINGS CORRECTLY  
 REPRESENT THE DIMENSIONS OF THE BUILDINGS AS CONSTRUCTED  
 AND THAT THERE ARE NO ENCROACHMENTS ON ANY ABUTTING  
 PREMISES EXCEPT AS SHOWN.


*James H. Schmidt*  
 JAMES H. SCHMIDT  
 REGISTERED SURVEYOR

STATEMENT OF CERTIFICATION  
 I CERTIFY THAT THE ATTACHED DRAWINGS CORRECTLY  
 REPRESENT THE DIMENSIONS OF THE BUILDINGS AS CONSTRUCTED.

*Robert E. Kleinoeder*  
 ROBERT E. KLEINOEDER  
 REGISTERED ENGINEER

FOUNDATION PLAN JULIAN A. PIJOR  
 LORAIN COUNTY AUDITOR  
 SCALE: 1/4" = 1'-0"

TRANSFERRED  
 IN COMPLIANCE WITH SEC. 915-202  
 OHIO REV. CODE  
 JUN 16 1978  
*See file*

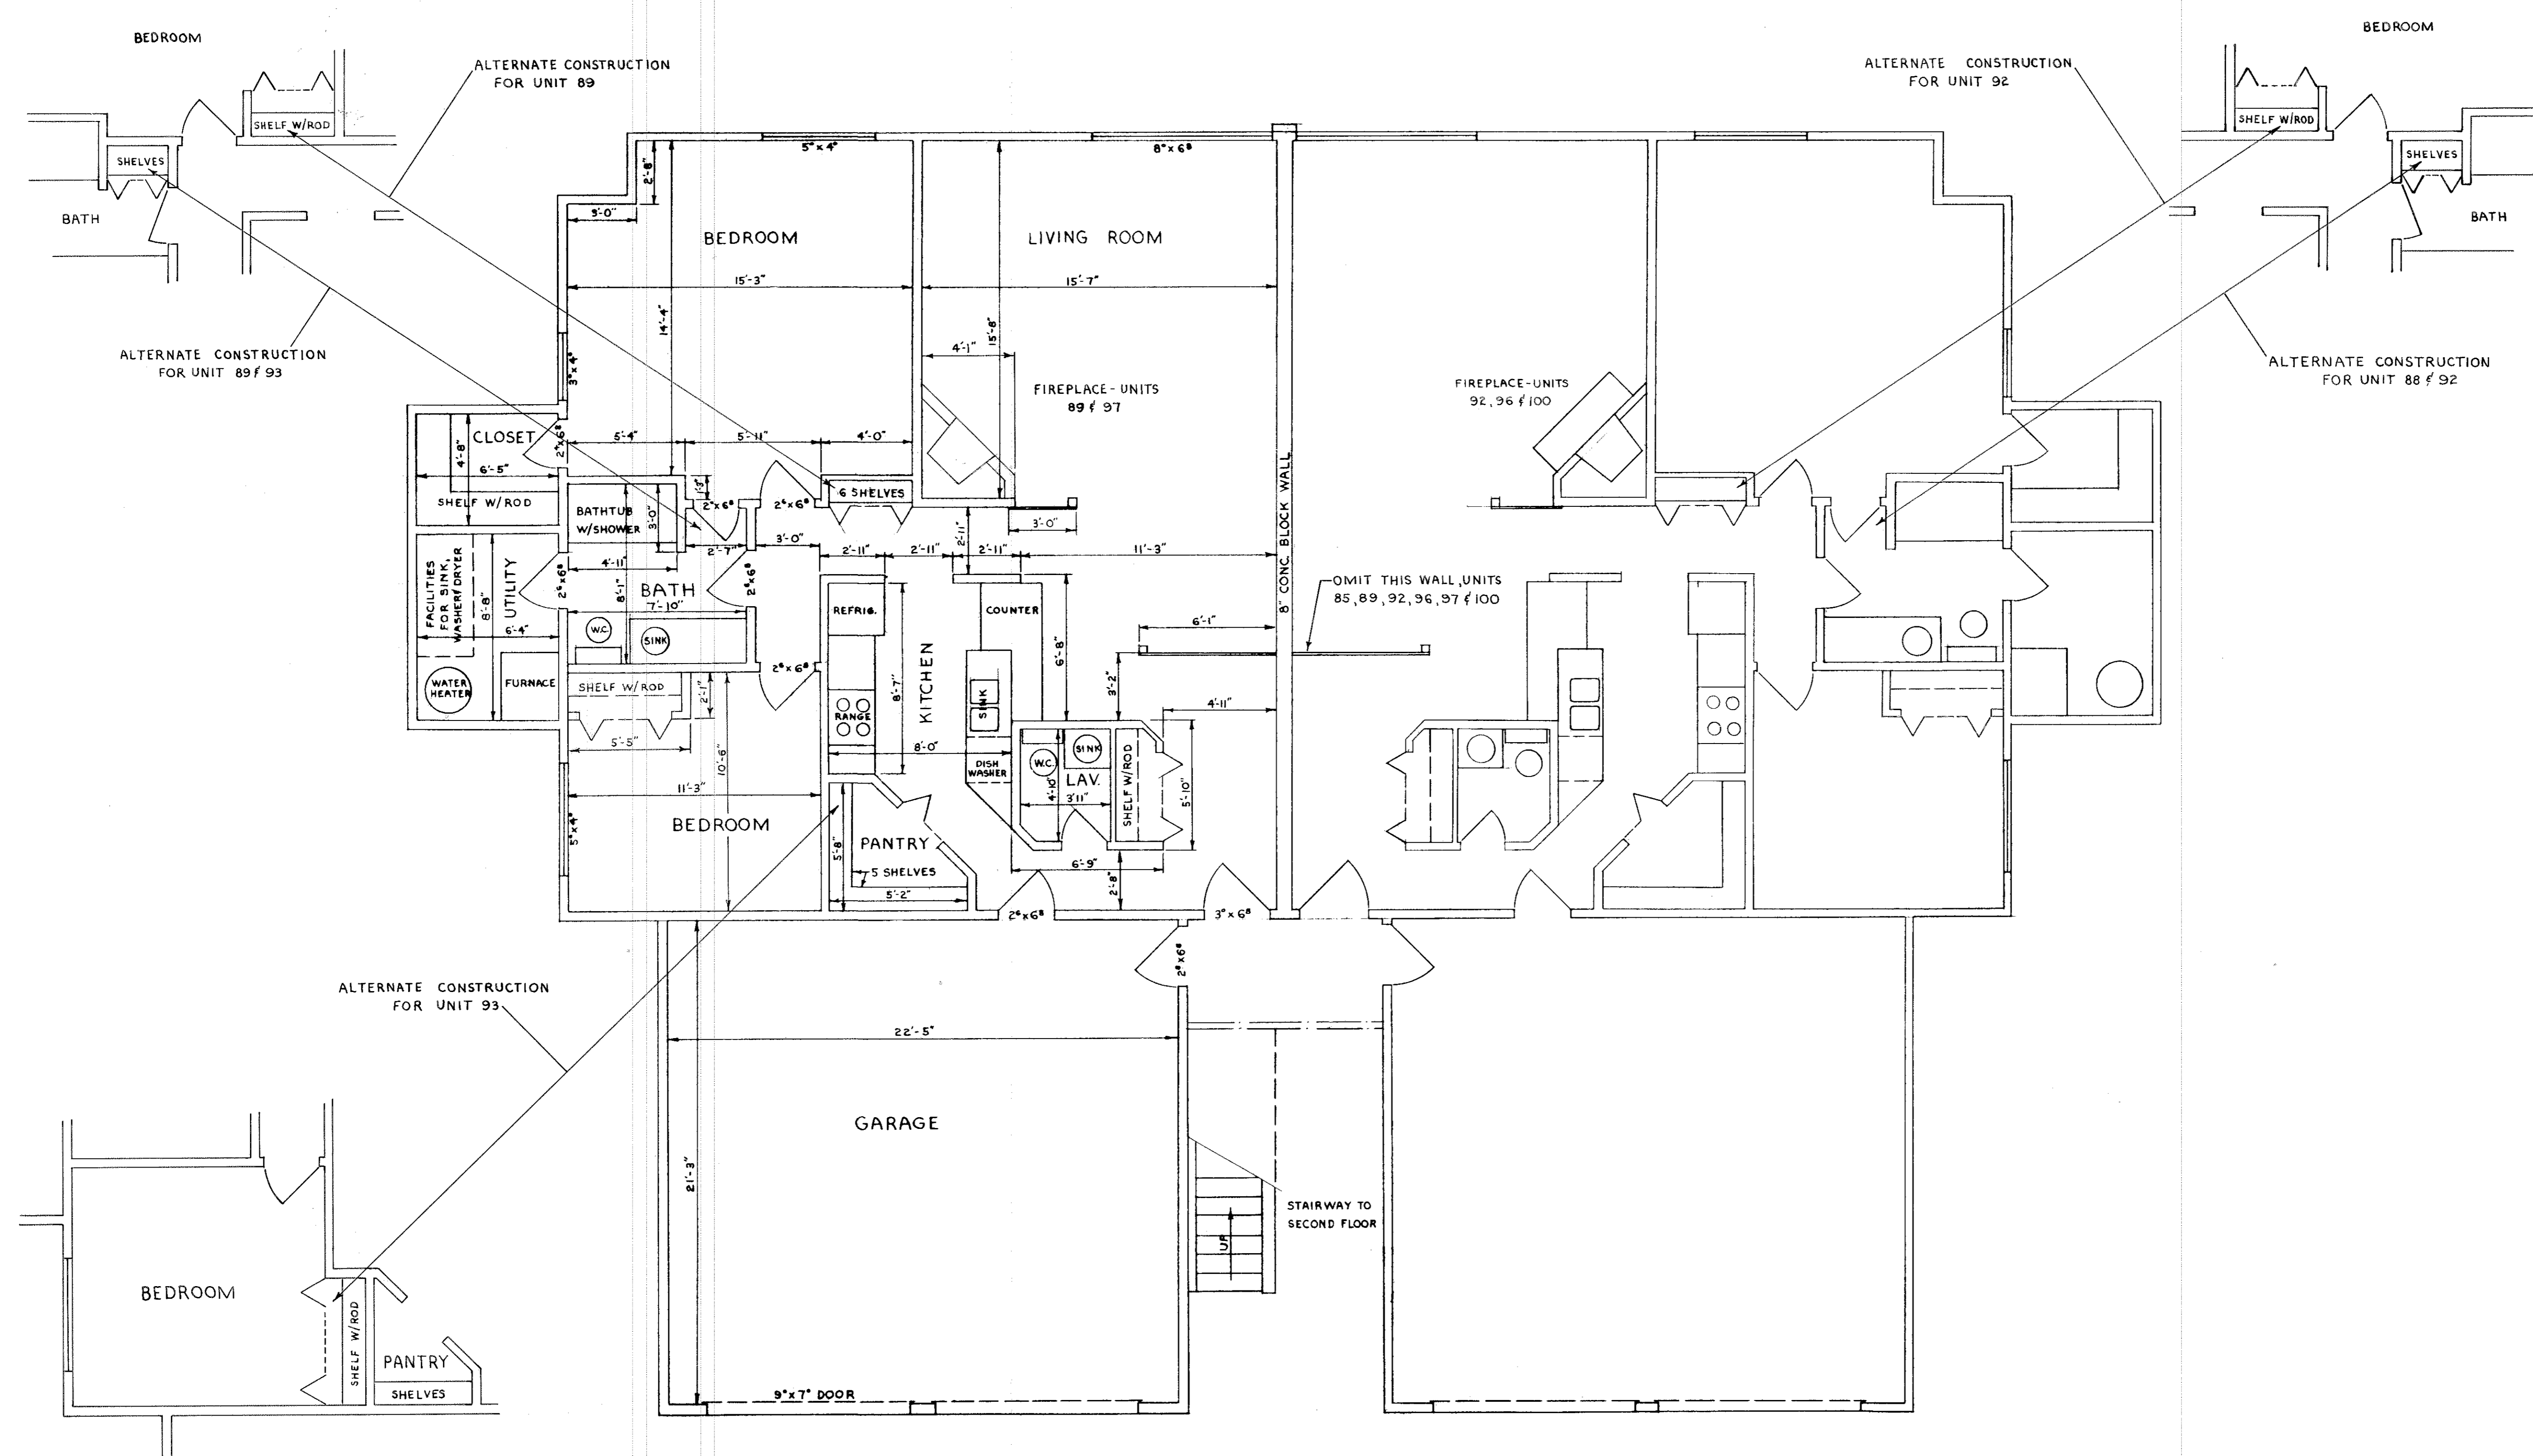

STATEMENT OF CERTIFICATION  
 I CERTIFY THAT THE ATTACHED DRAWINGS CORRECTLY REPRESENT THE DIMENSIONS OF THE BUILDINGS AS CONSTRUCTED AND THAT THERE ARE NO ENCROACHMENTS ON ANY ABUTTING PREMISES EXCEPT AS SHOWN.

*James H. Schmidt*  
 JAMES H. SCHMIDT  
 REGISTERED SURVEYOR


STATEMENT OF CERTIFICATION  
 I CERTIFY THAT THE ATTACHED DRAWINGS CORRECTLY REPRESENT THE DIMENSIONS OF THE BUILDINGS AS CONSTRUCTED.

*Robert E. Kleinoeder*  
 ROBERT E. KLEINOEDER  
 REGISTERED ENGINEER

FIRST FLOOR PLAN  
 SCALE: 1/4" = 1'-0"

TRANSFERRED  
 IN COMPLIANCE WITH SEC. 315-202  
 OHIO REV. CODE  
 JUN 16 1978  
 JULIAN A. PIJOR  
 LORAIN COUNTY AUDITOR

33  
 74

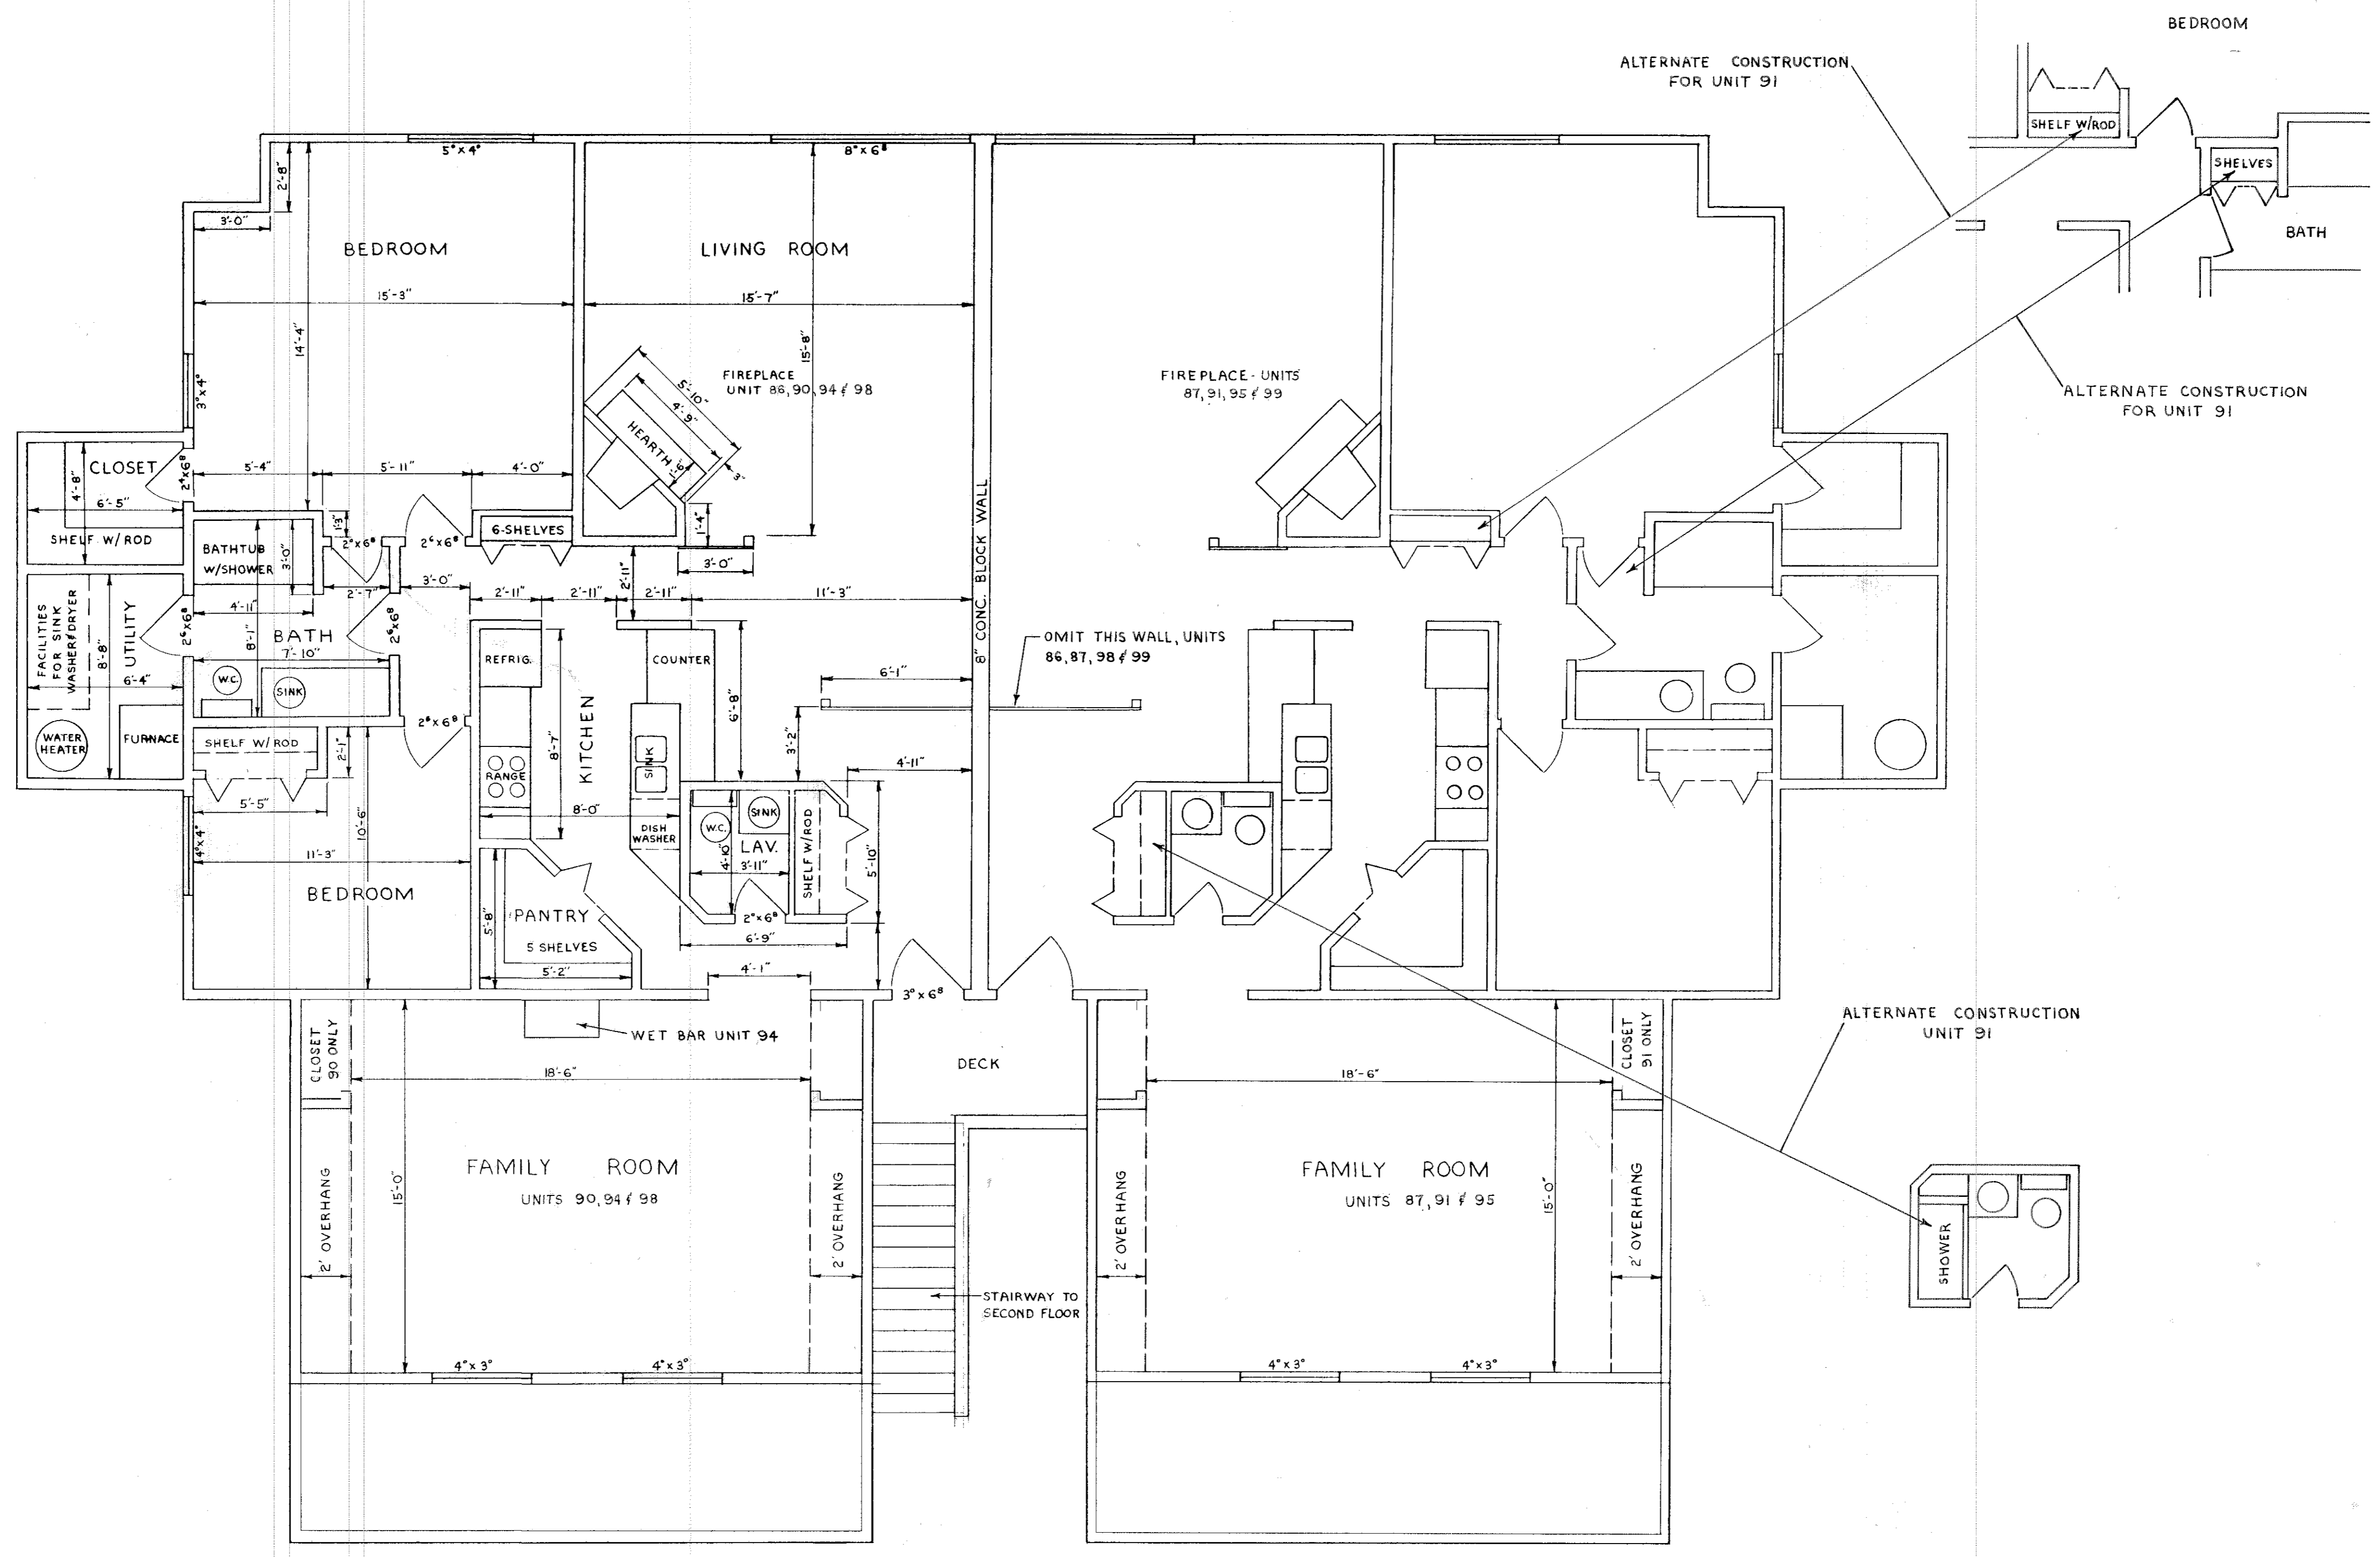

**STATEMENT OF CERTIFICATION**  
 I CERTIFY THAT THE ATTACHED DRAWINGS CORRECTLY REPRESENT THE DIMENSIONS OF THE BUILDINGS AS CONSTRUCTED AND THAT THERE ARE NO ENCROACHMENTS ON ANY ABUTTING PREMISES EXCEPT AS SHOWN.

*James H. Schmidt*  
 JAMES H. SCHMIDT  
 REGISTERED SURVEYOR

**STATEMENT OF CERTIFICATION**  
 I CERTIFY THAT THE ATTACHED DRAWINGS CORRECTLY REPRESENT THE DIMENSIONS OF THE BUILDINGS AS CONSTRUCTED.

*Robert E. Kleinoeder*  
 ROBERT E. KLEINOEDER  
 REGISTERED ENGINEER

**SECOND FLOOR PLAN**  
 SCALE: 1/4" = 1'-0"

TRANSFERRED  
 IN COMPLIANCE WITH SEC. 515-202  
 OHIO REV. CODE  
 JUN 16 1978  
*See Set*  
 JULIAN A. PIJOR  
 LOREN COUNTY AUDITOR