

**SHEET INDEX**

SHT. NO.	DESCRIPTION
1.	SURVEY & LIMIT DATA
2.	FLOOR PLAN UNIT 25
3.	FLOOR PLAN UNIT 26
4.	FLOOR PLAN UNIT 27
5.	FLOOR PLAN UNIT 28
6.	ELEVATIONS




**PERCENTAGE OF OWNERSHIP**

UNIT NO.	AREA (S.F.)	%
1	1451	3.0665
2	1776	3.7534
3	1491	3.1510
4	1207	2.5508
5	1207	2.5508
6	1491	3.1510
7	1776	3.7534
8	1451	3.0665
9	1451	3.0665
10	1776	3.7534
11	1491	3.1510
12	1207	2.5508
13	1207	2.5508
14	1491	3.1510
15	1776	3.7534
16	1451	3.0665
56	1451	3.0665
57	1491	3.1510
58	1491	3.1510
59	1491	3.1510
60	1491	3.1510
12	1207	2.5508
13	1207	2.5508
14	1491	3.1510
15	1776	3.7534
16	1491	3.1510
17	1451	3.0665
18	1491	3.1510
19	1491	3.1510
20	1451	3.0665
25	1451	3.0665
26	1491	3.1510
27	1491	3.1510
28	1451	3.0665

**CERTIFICATION:**  
 THIS IS TO CERTIFY THAT THE ATTACHED DRAWINGS CORRECTLY REPRESENT THE BUILDINGS AS CONSTRUCTED AND THAT THERE ARE NO ENCROACHMENTS ON ADJUTING PROPERTIES.



James H. Schmidt - REG. SURVEYOR NO. 4844  
 Robert E. Kleingeder  
 ROBERT E. KLEINGEDER, REG. ENGINEER NO. 18258

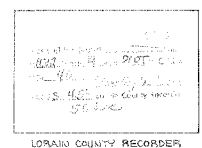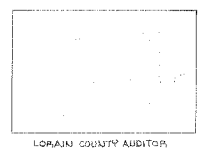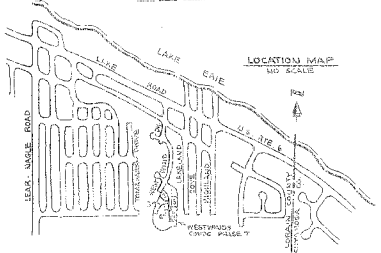


**WESTWINDS CONDOMINIUM - PHASE 7**  
 PART OF AVON TOWNSHIP SECTION NO. 30  
 CITY OF AVON LAKE, COUNTY OF LORAIN, STATE OF OHIO  
 SCALE: 1" = 40'  
 JULY 1985

PREPARED BY  
**KLEINGEDER - SCHMIDT & ASSOC.**  
 CONSULTING ENGINEERS & SURVEYORS


191588

191588

40/46

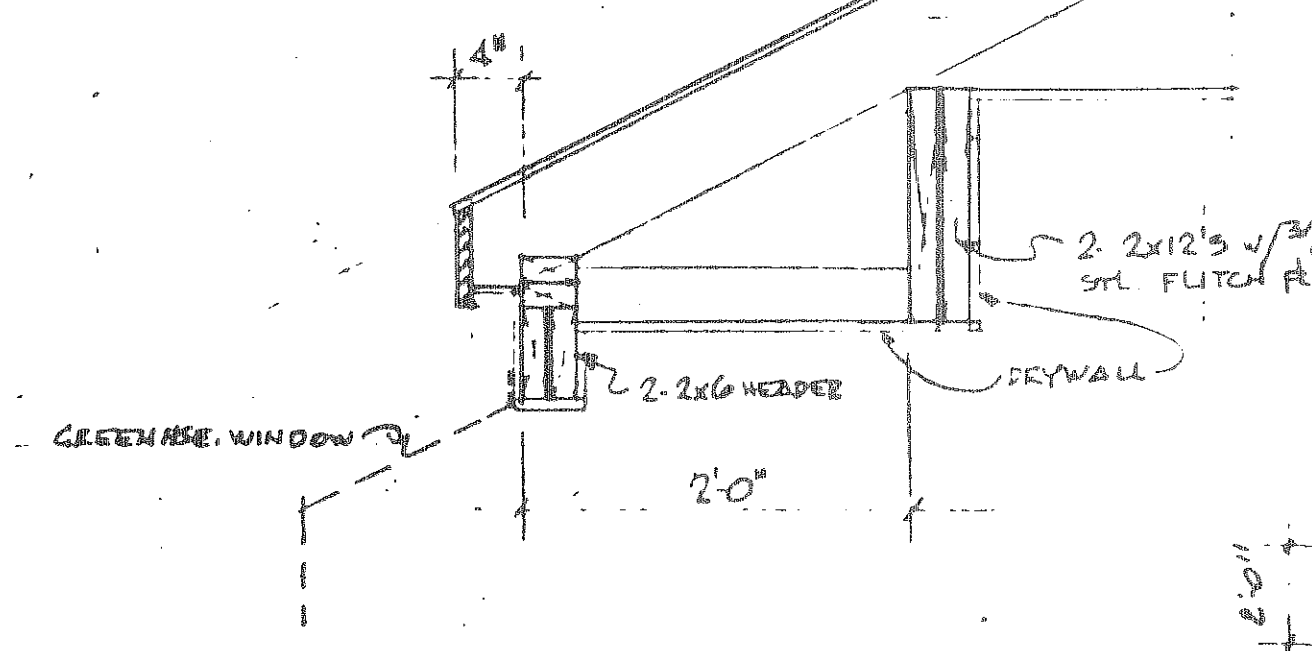


- NOTES**
1. ALL WALLS SHALL BE 3 1/2" UNLESS NOTED OTHERWISE.
  2. ALL DIMENSIONS ARE TO ROUGH FRAMING.
  3. REFER TO WALL SECTION SHEET FOR STRUCTURAL INFORMATION.

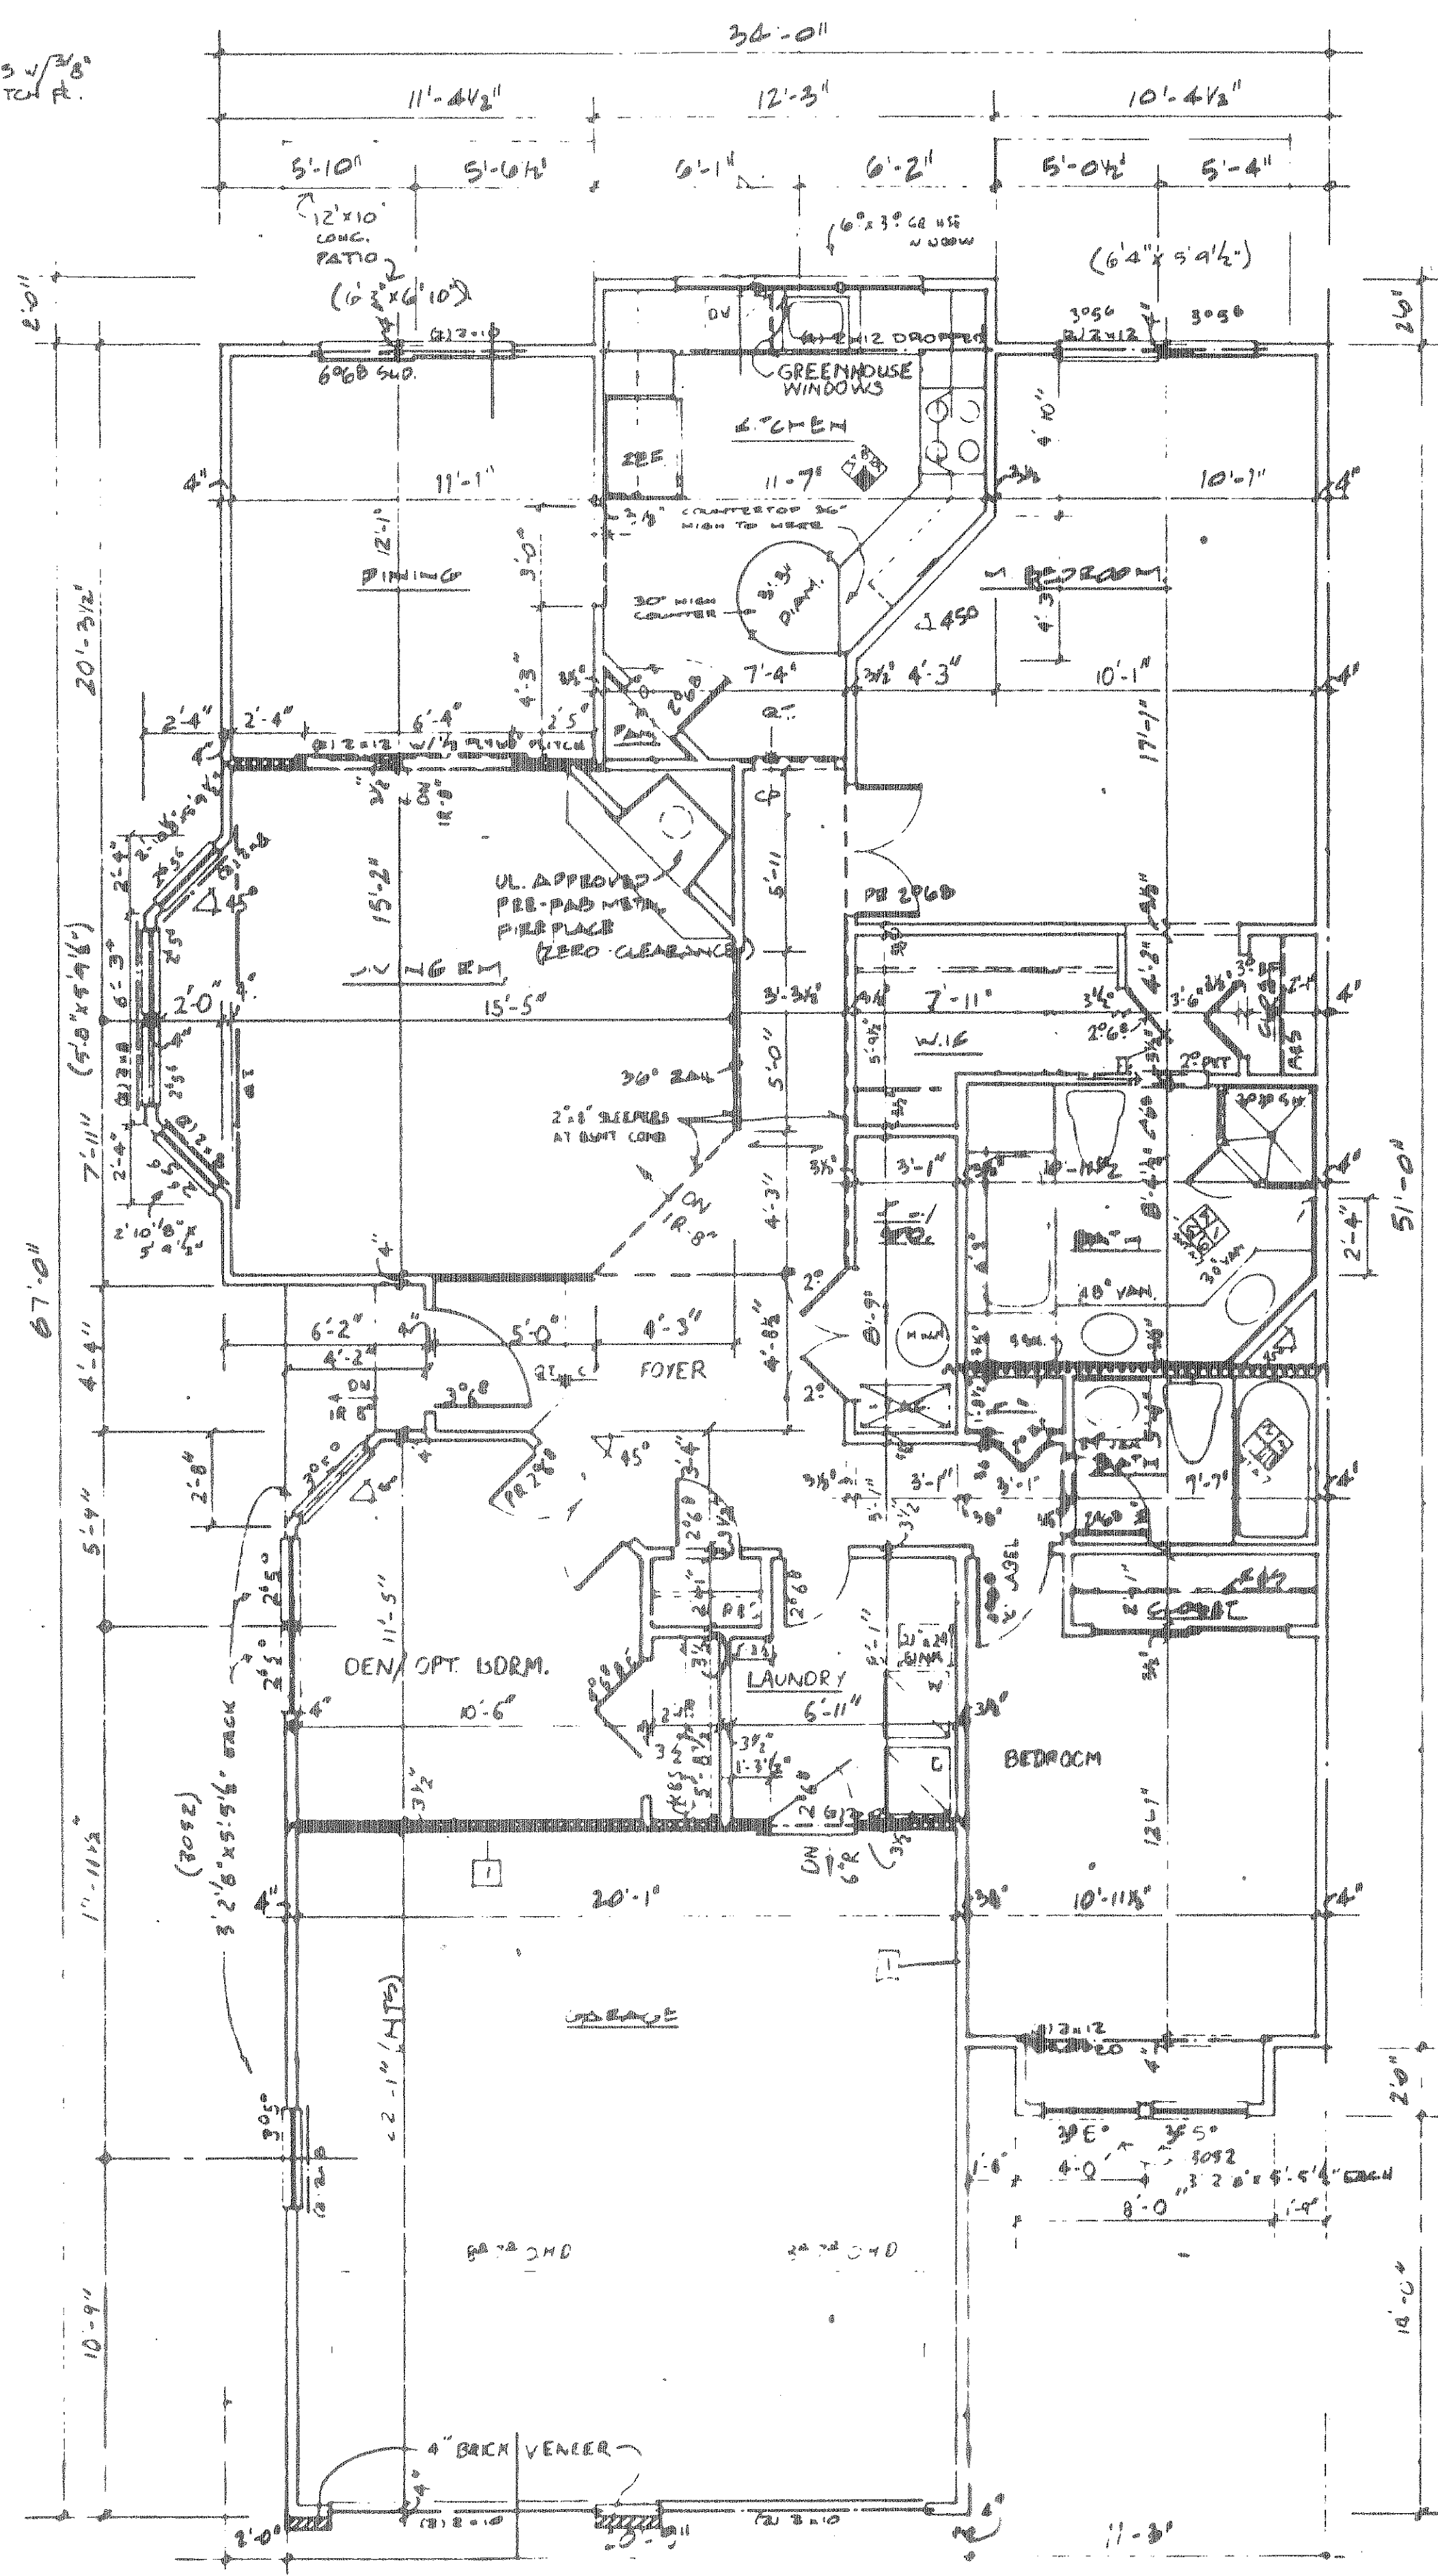

FIRST FLOOR UNIT 25

1/4" = 1'-0"

FOR ROOF TRUSSES SEE DRAWING A 20 ROOF FRAMING

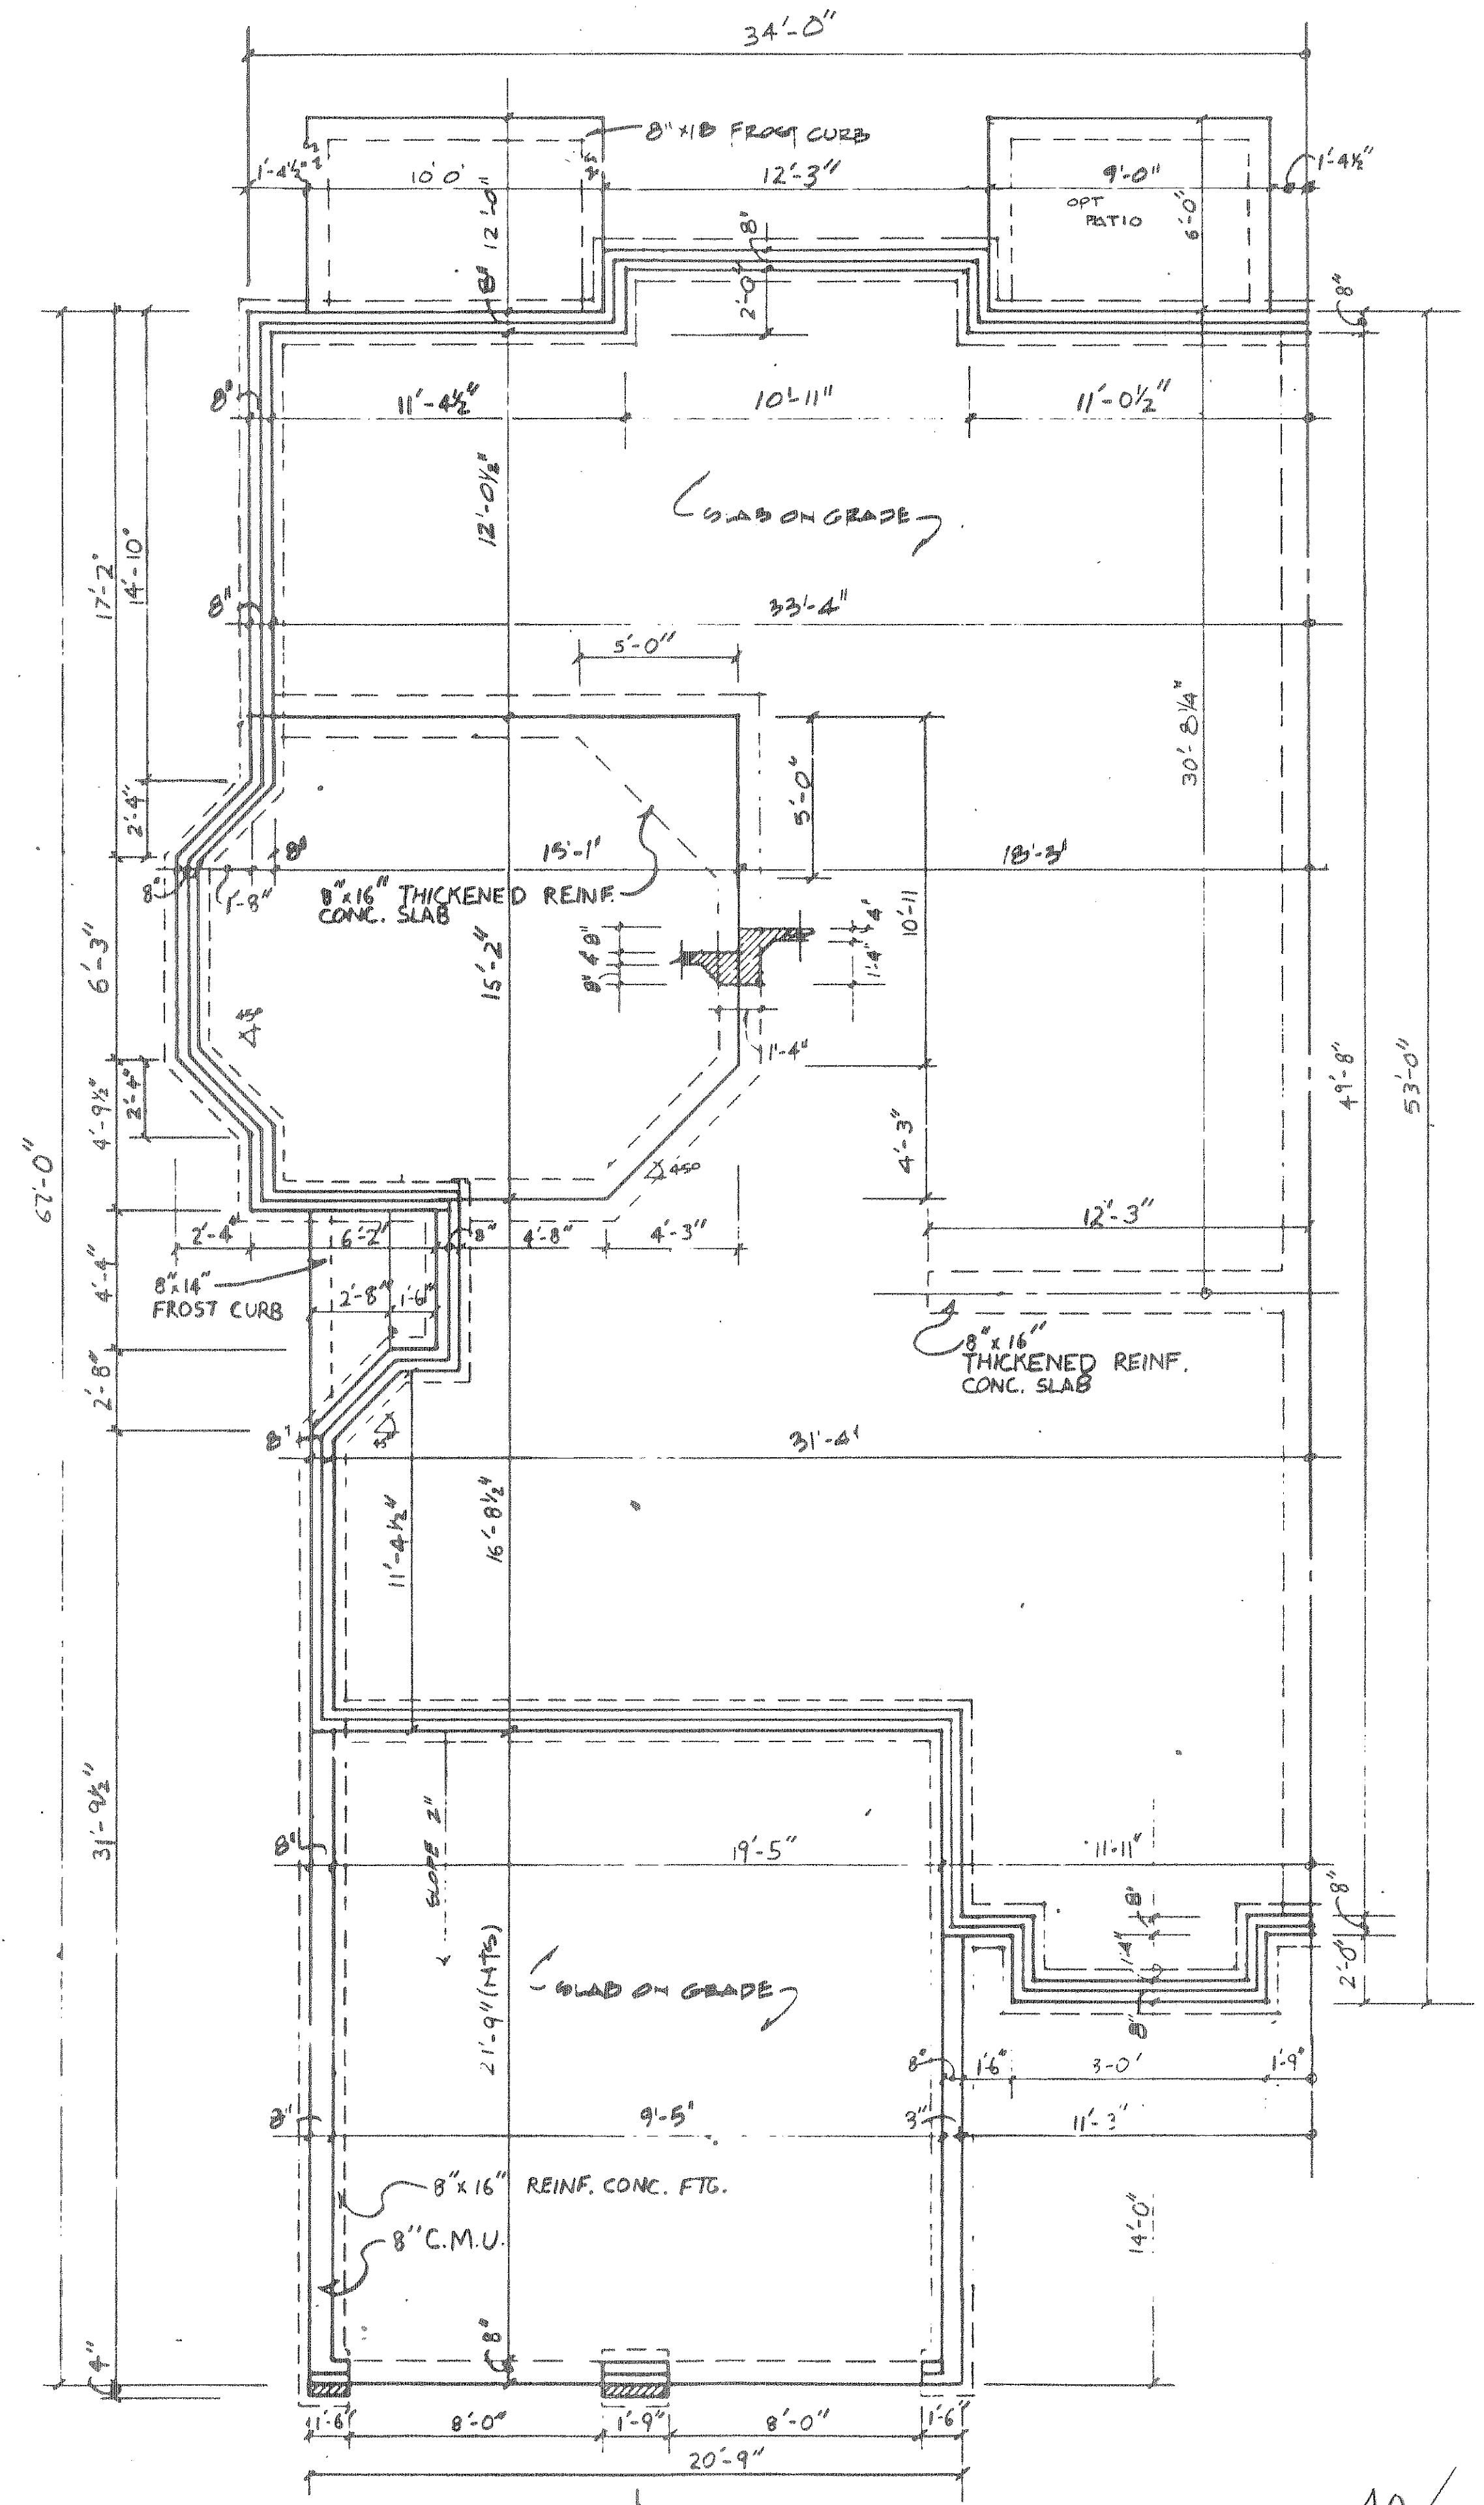

FOUNDATION UNIT 25

1/4" = 1'-0"

40/46


C-2/6




8821P1

40/47


8821P1

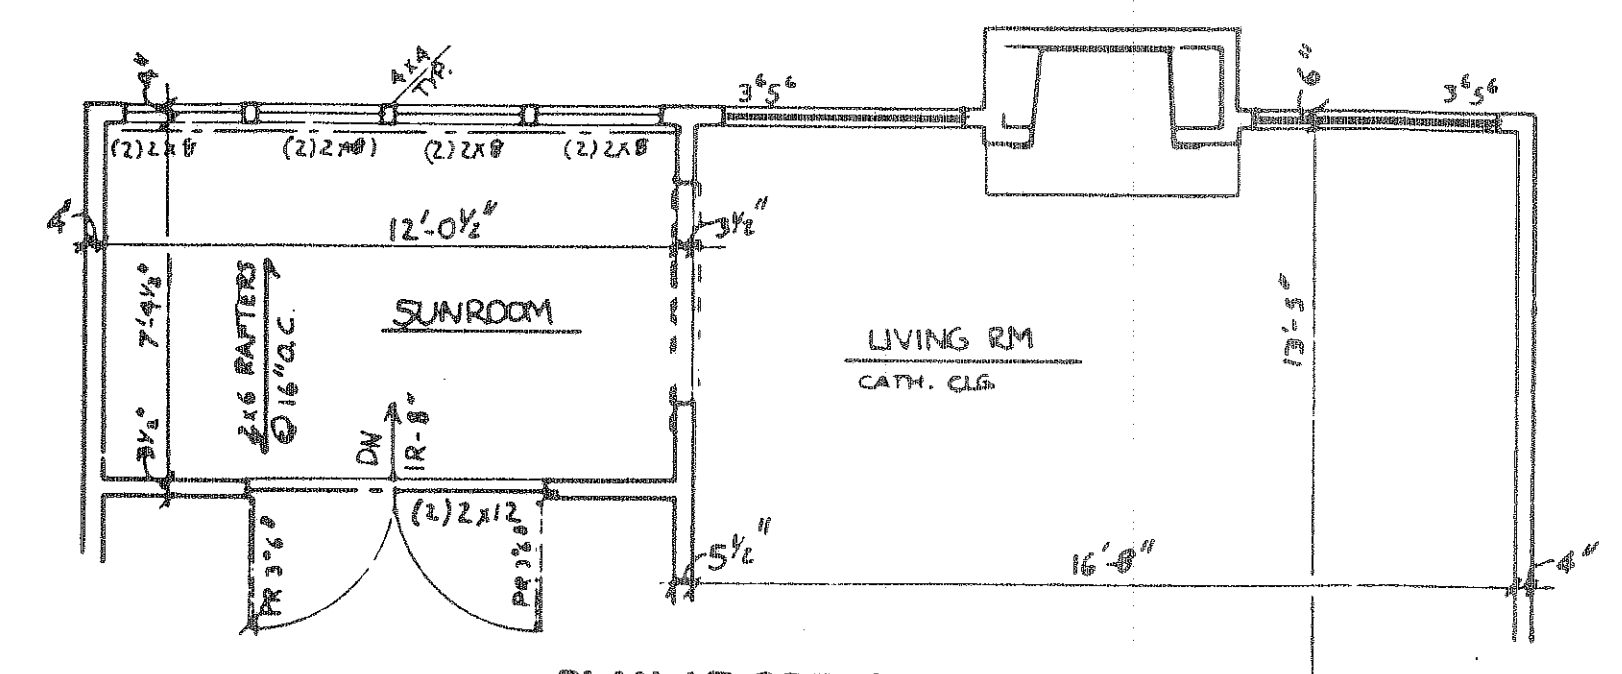


PLAN AT OPT. SUNROOM  
1/4" 1'-0"

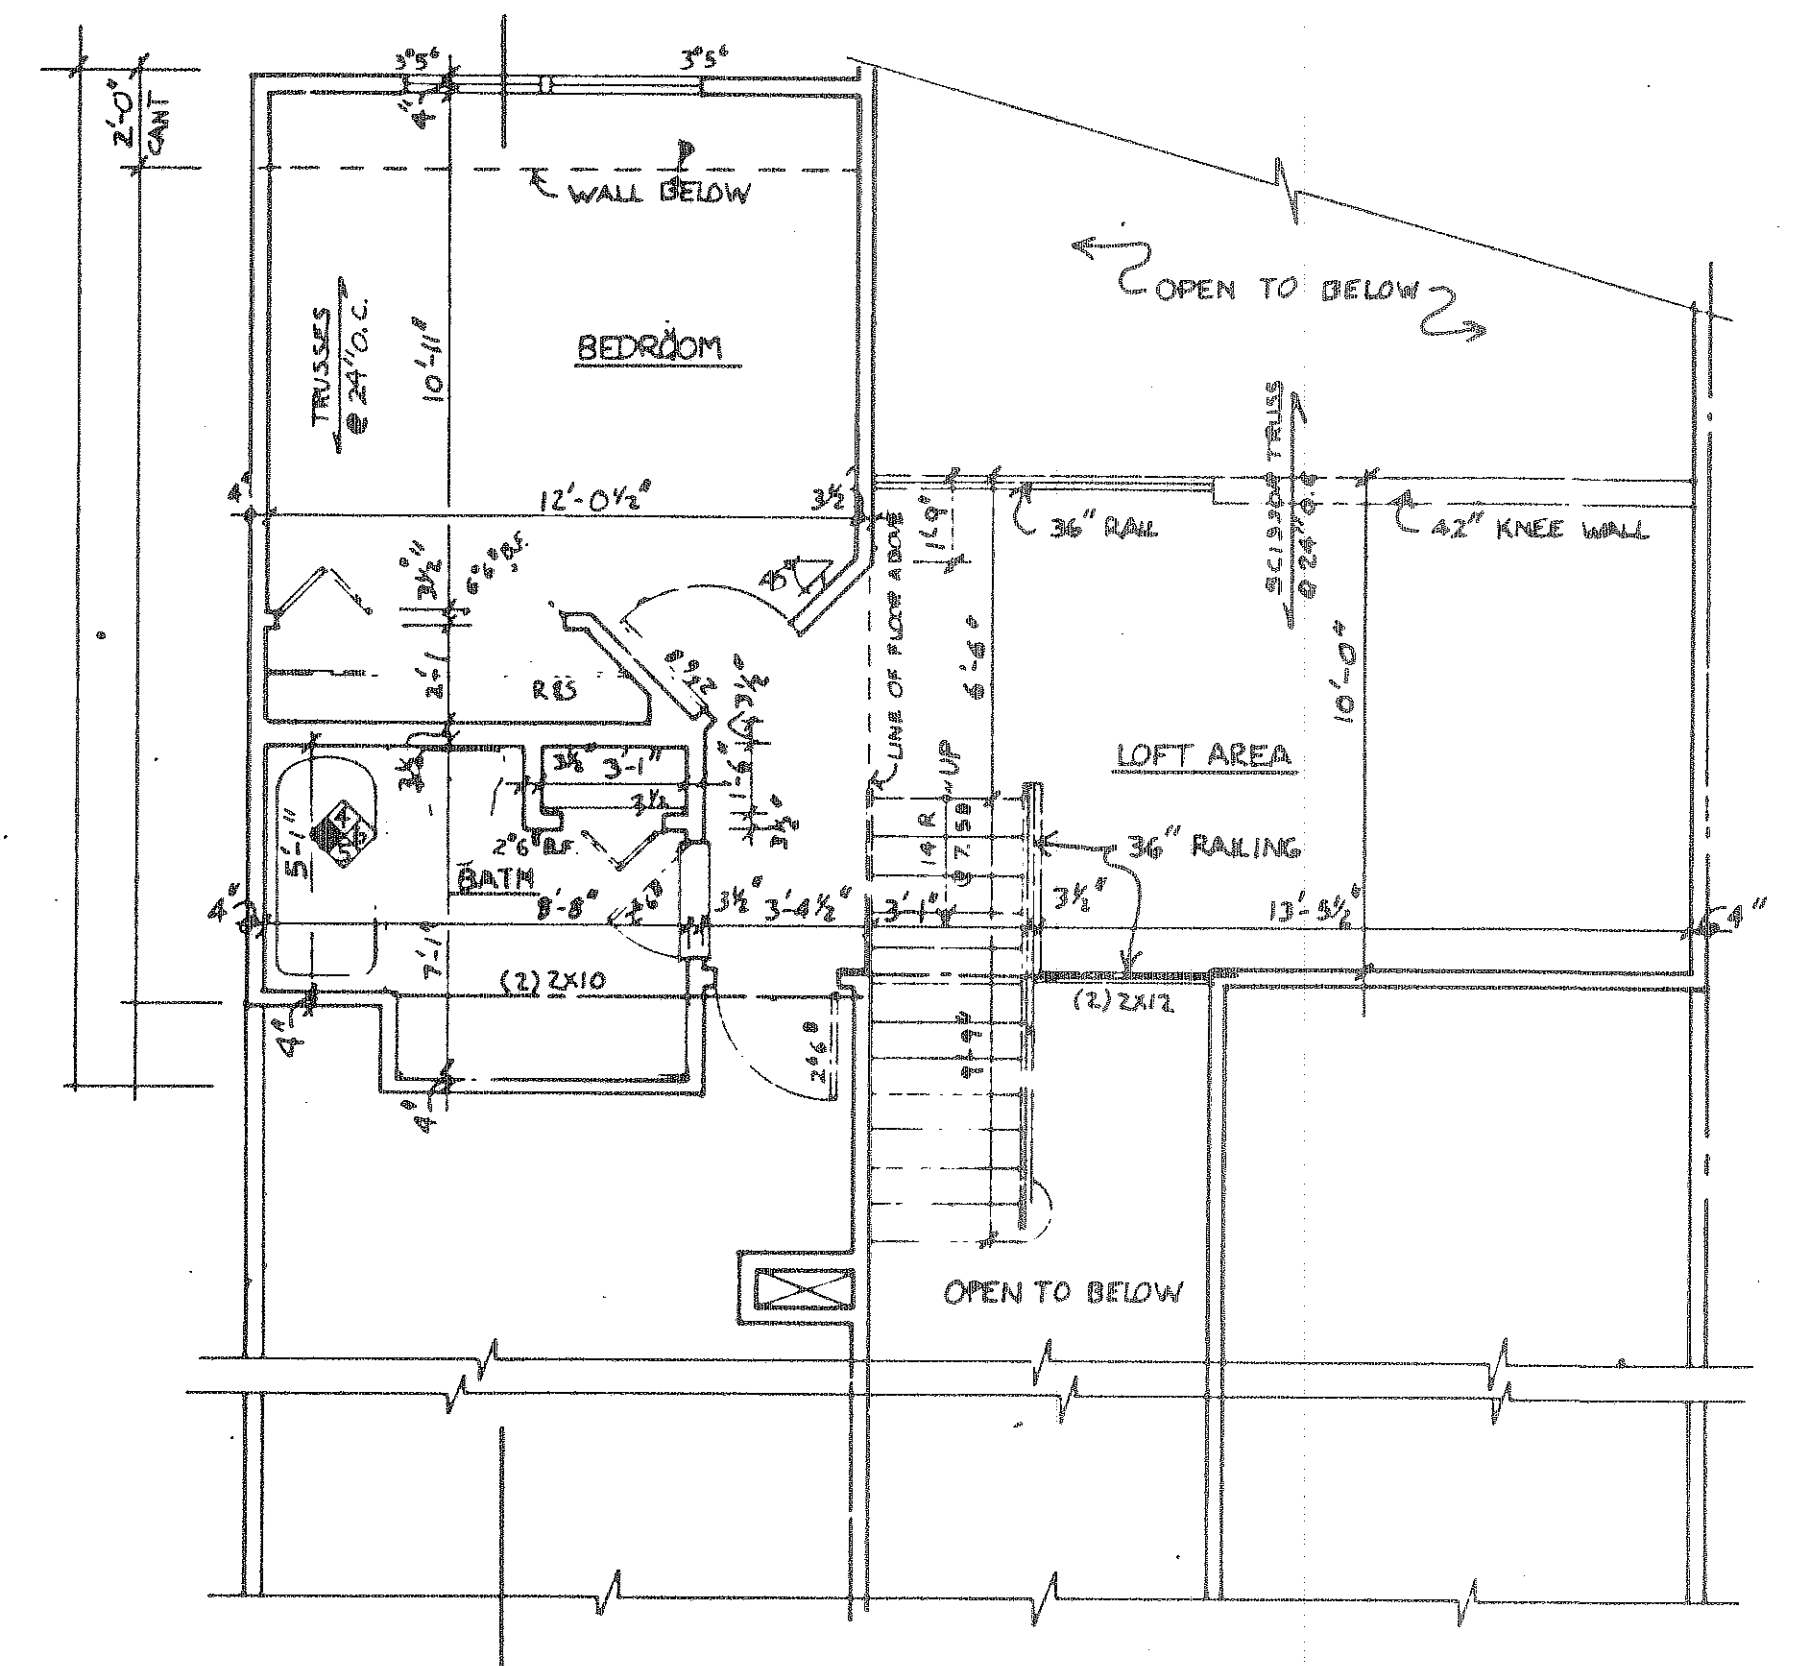

SECOND FLOOR UNIT 26  
1/4" 1'-0"

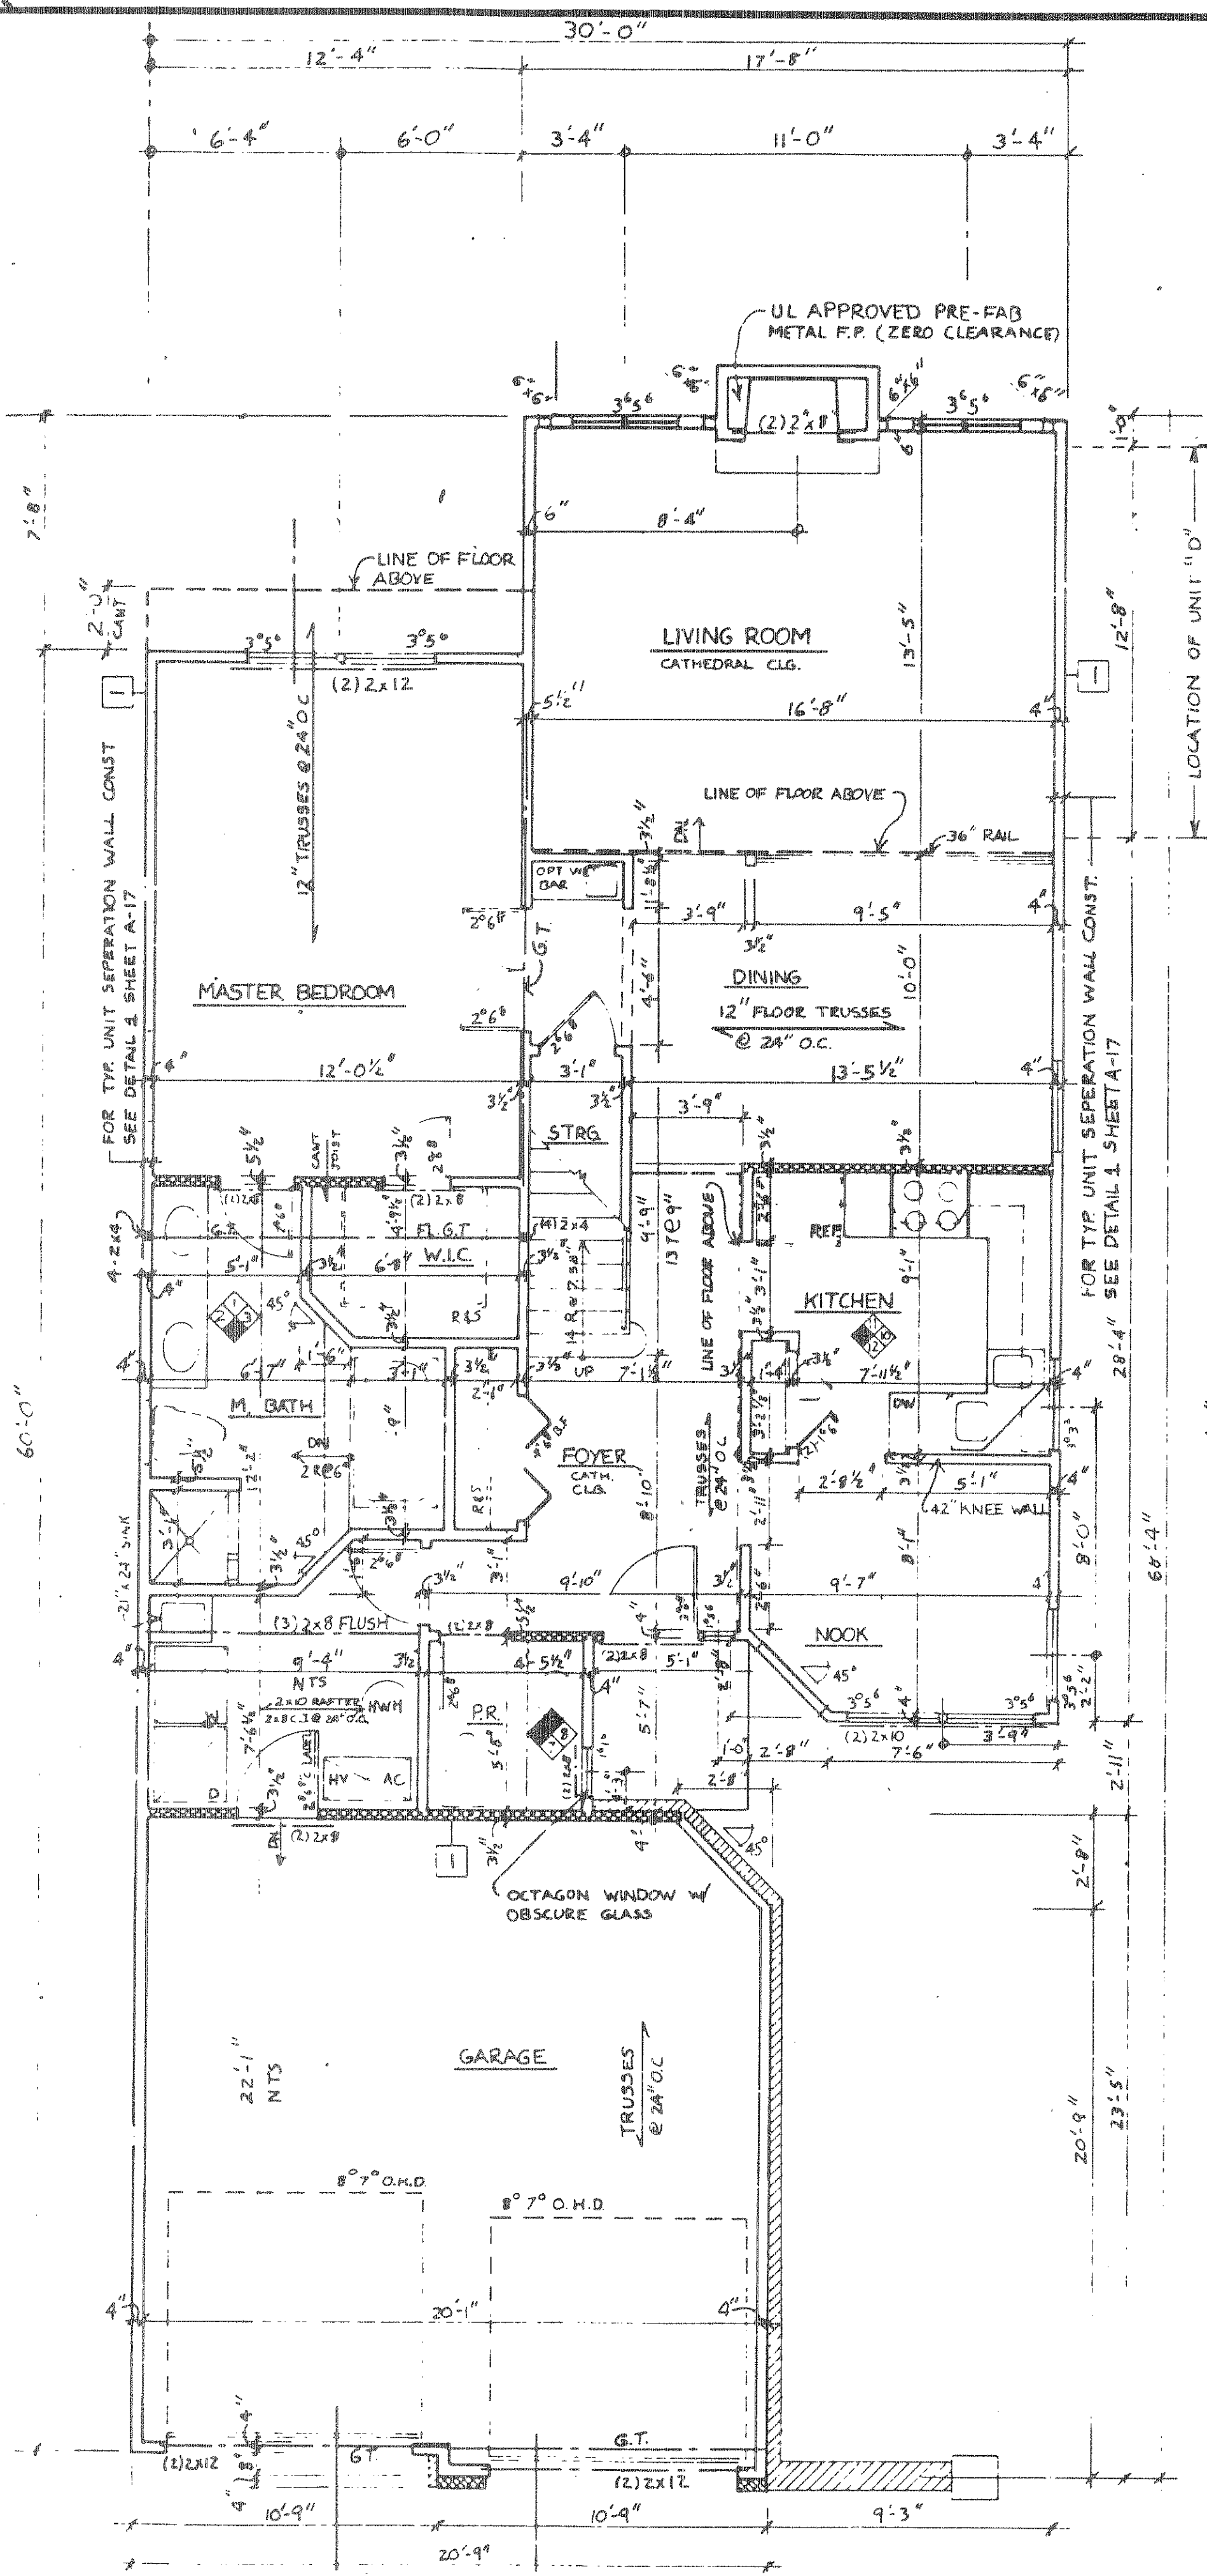

FIRST FLOOR UNIT 26  
1/4" 1'-0"

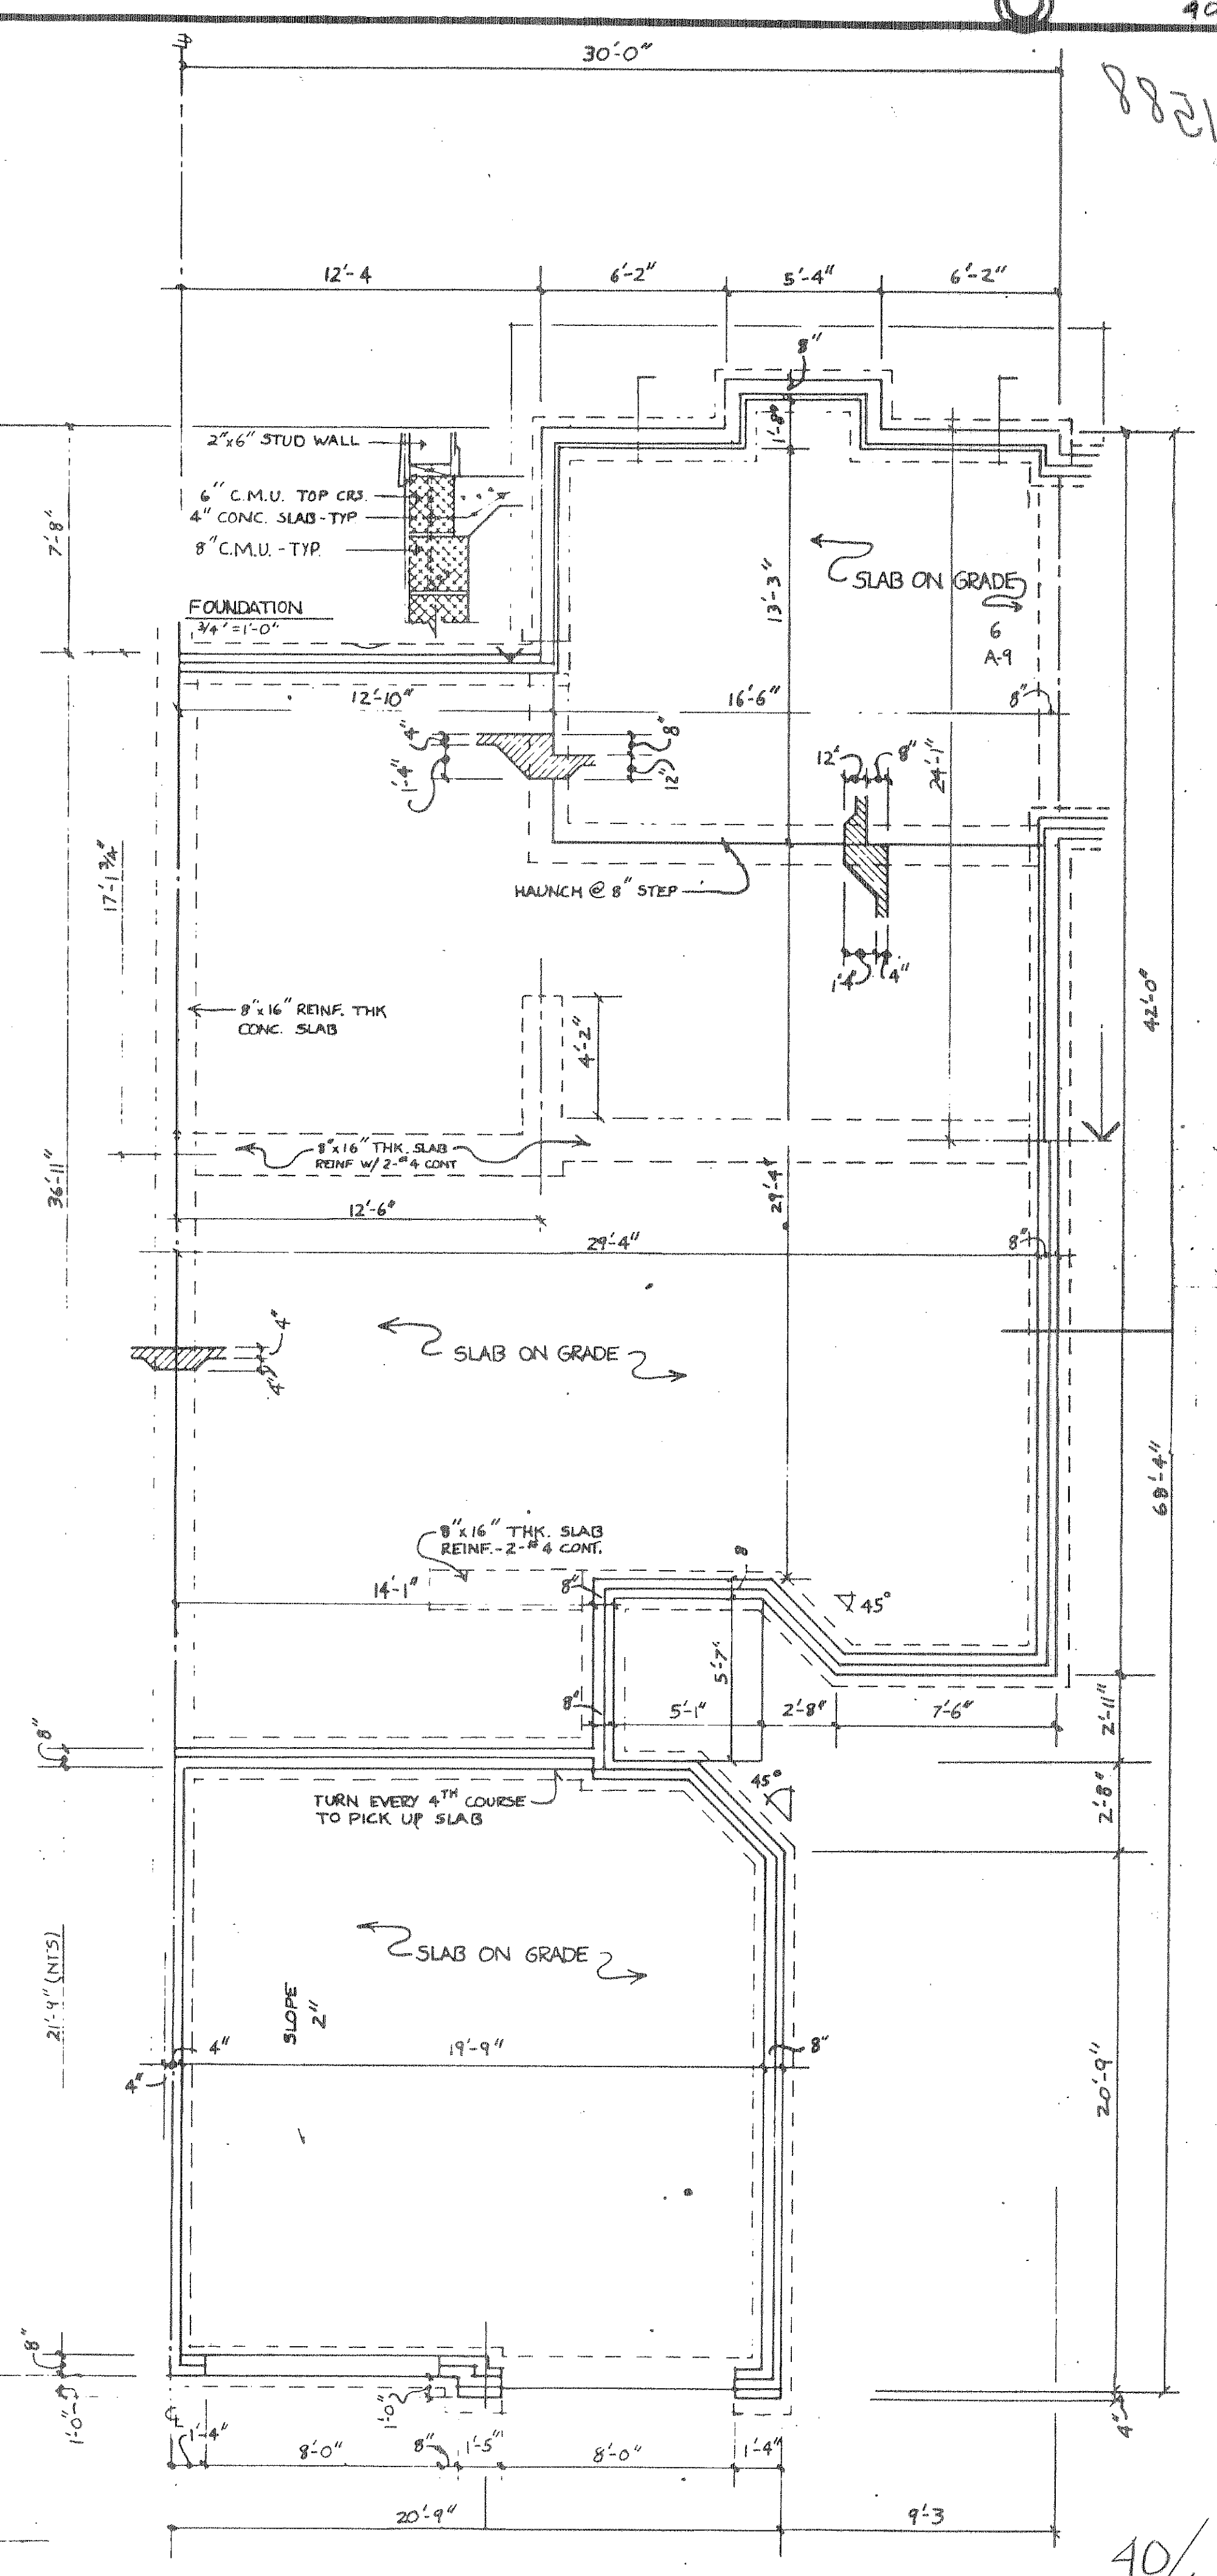

FOUNDATION UNIT 26  
1/4" 1'-0"

KEY	
	BEARING WALL W/ 1 HR. FIRE RATING
	1 HOUR FIRE RATED WALL
	1 LAYER 5/8" TYPE 'X' DRYWALL EACH SIDE

- NOTES
1. ALL WALLS SHALL BE 3 1/2" UNLESS NOTED OTHERWISE.
  2. ALL DIMENSIONS ARE TO ROUGH FRAMING.
  3. REFER TO WALL SECTION SHEET FOR STRUCTURAL INFORMATION.

40/47

C-3/6








191588


40/49

191588

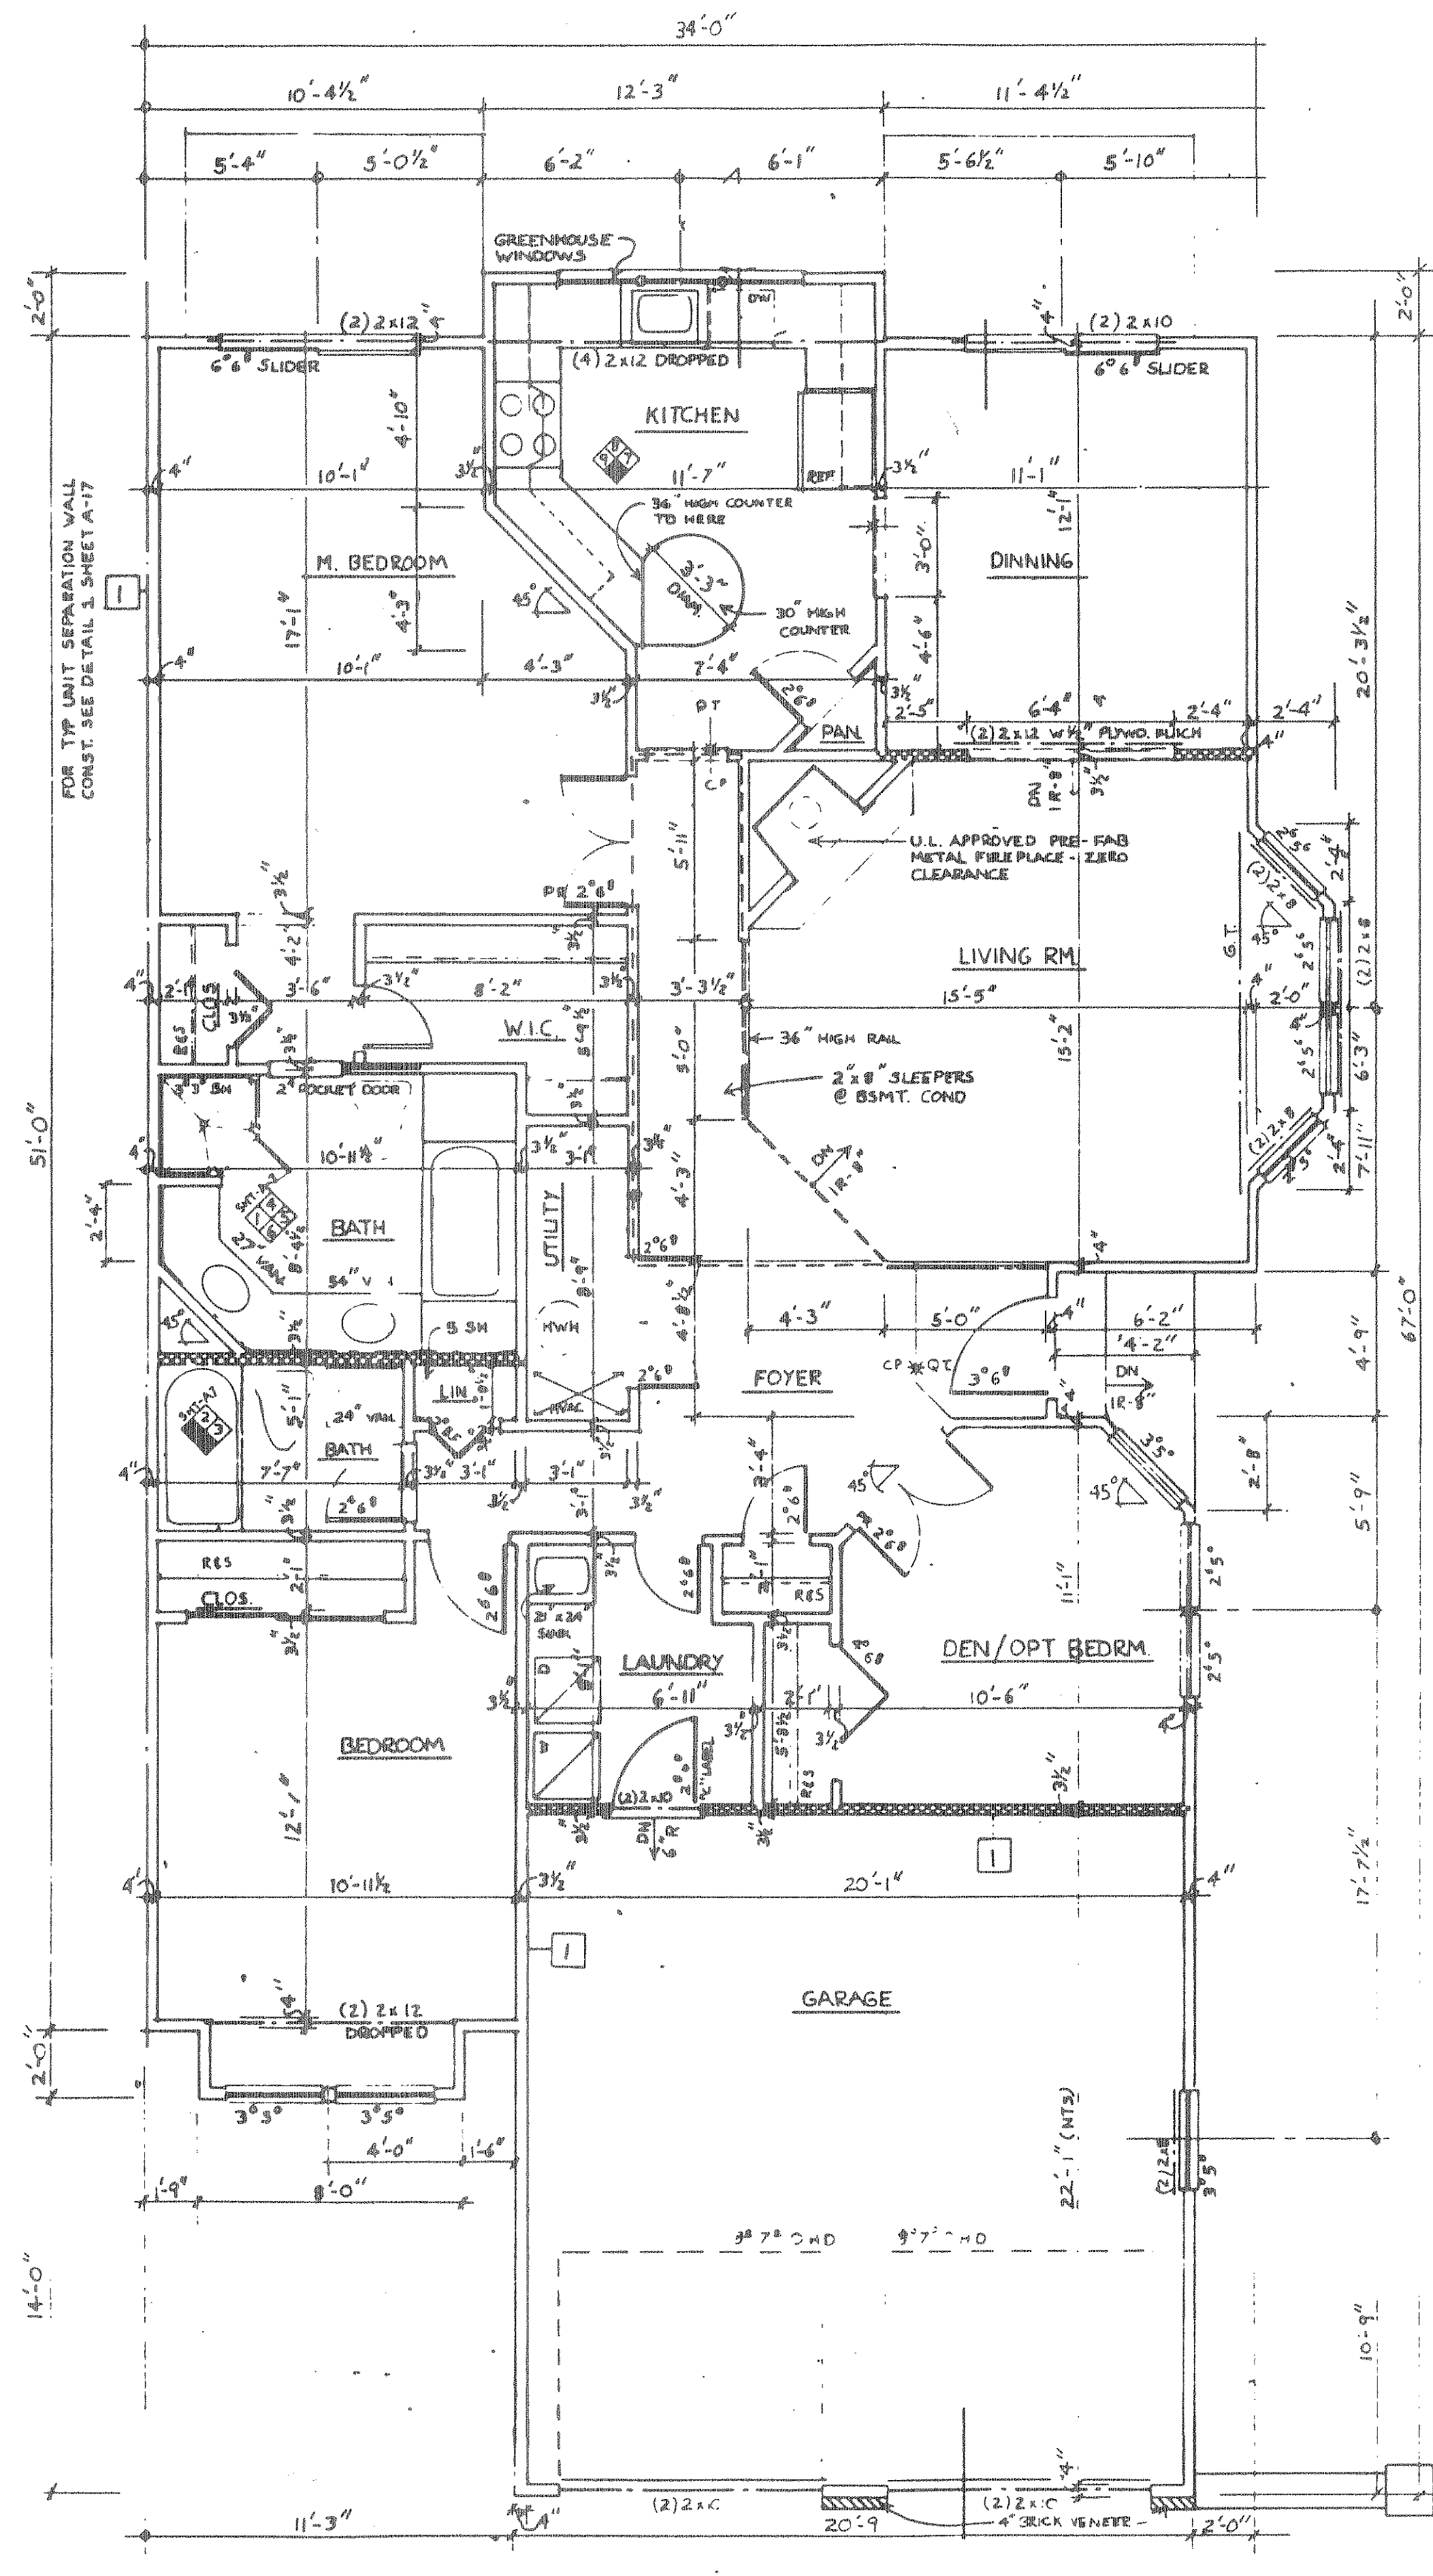

FIRST FLOOR UNIT 28

1/4" = 1'-0"

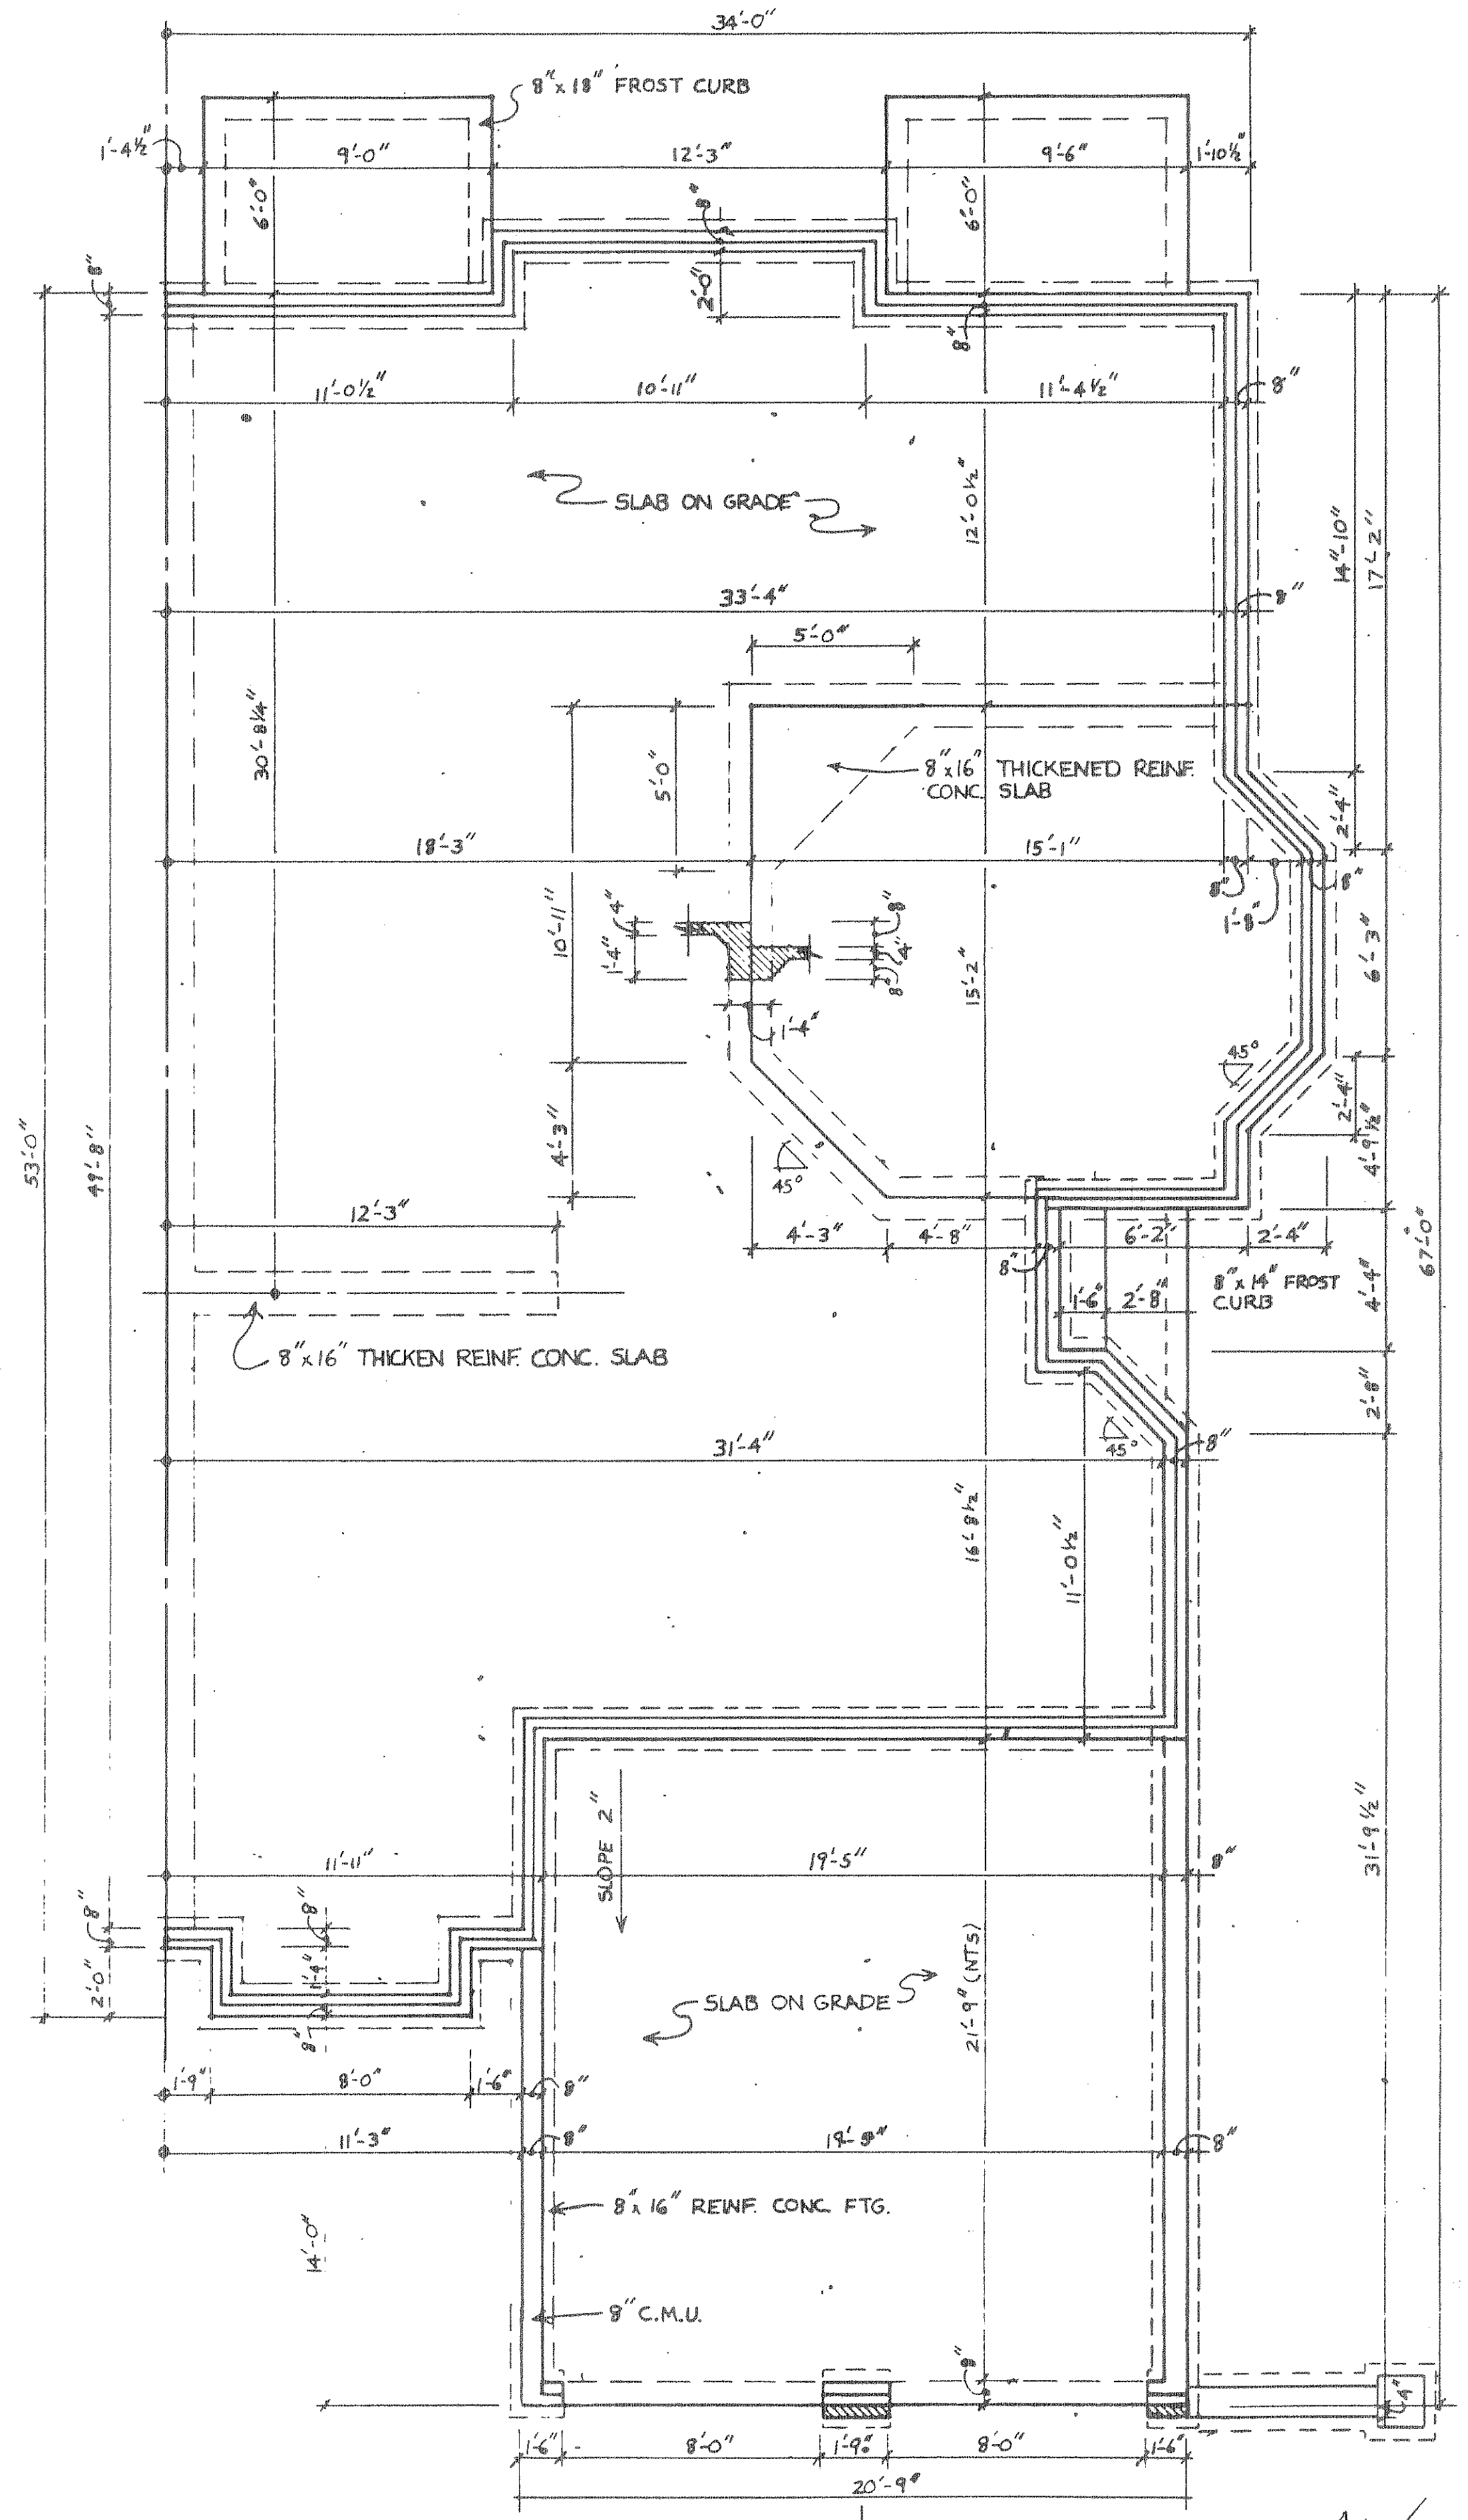

FOUNDATION UNIT 28

1/4" = 1'-0"

NOTES

1. ALL WALLS SHALL BE 3 1/2" UNLESS NOTED OTHERWISE.
2. ALL DIMENSIONS ARE TO ROUGH FRAMING.
3. REFER TO WALL SECTION SHEET FOR STRUCTURAL INFORMATION.

KEY

	BEARING WALL W/ 1 HR. FIRE RATING
	1 HOUR FIRE RATED WALL 1 LAYER 5/8" TYPE 'X' DRYWALL EACH SIDE

40/49


C-65

191588

191588


191588

40/50

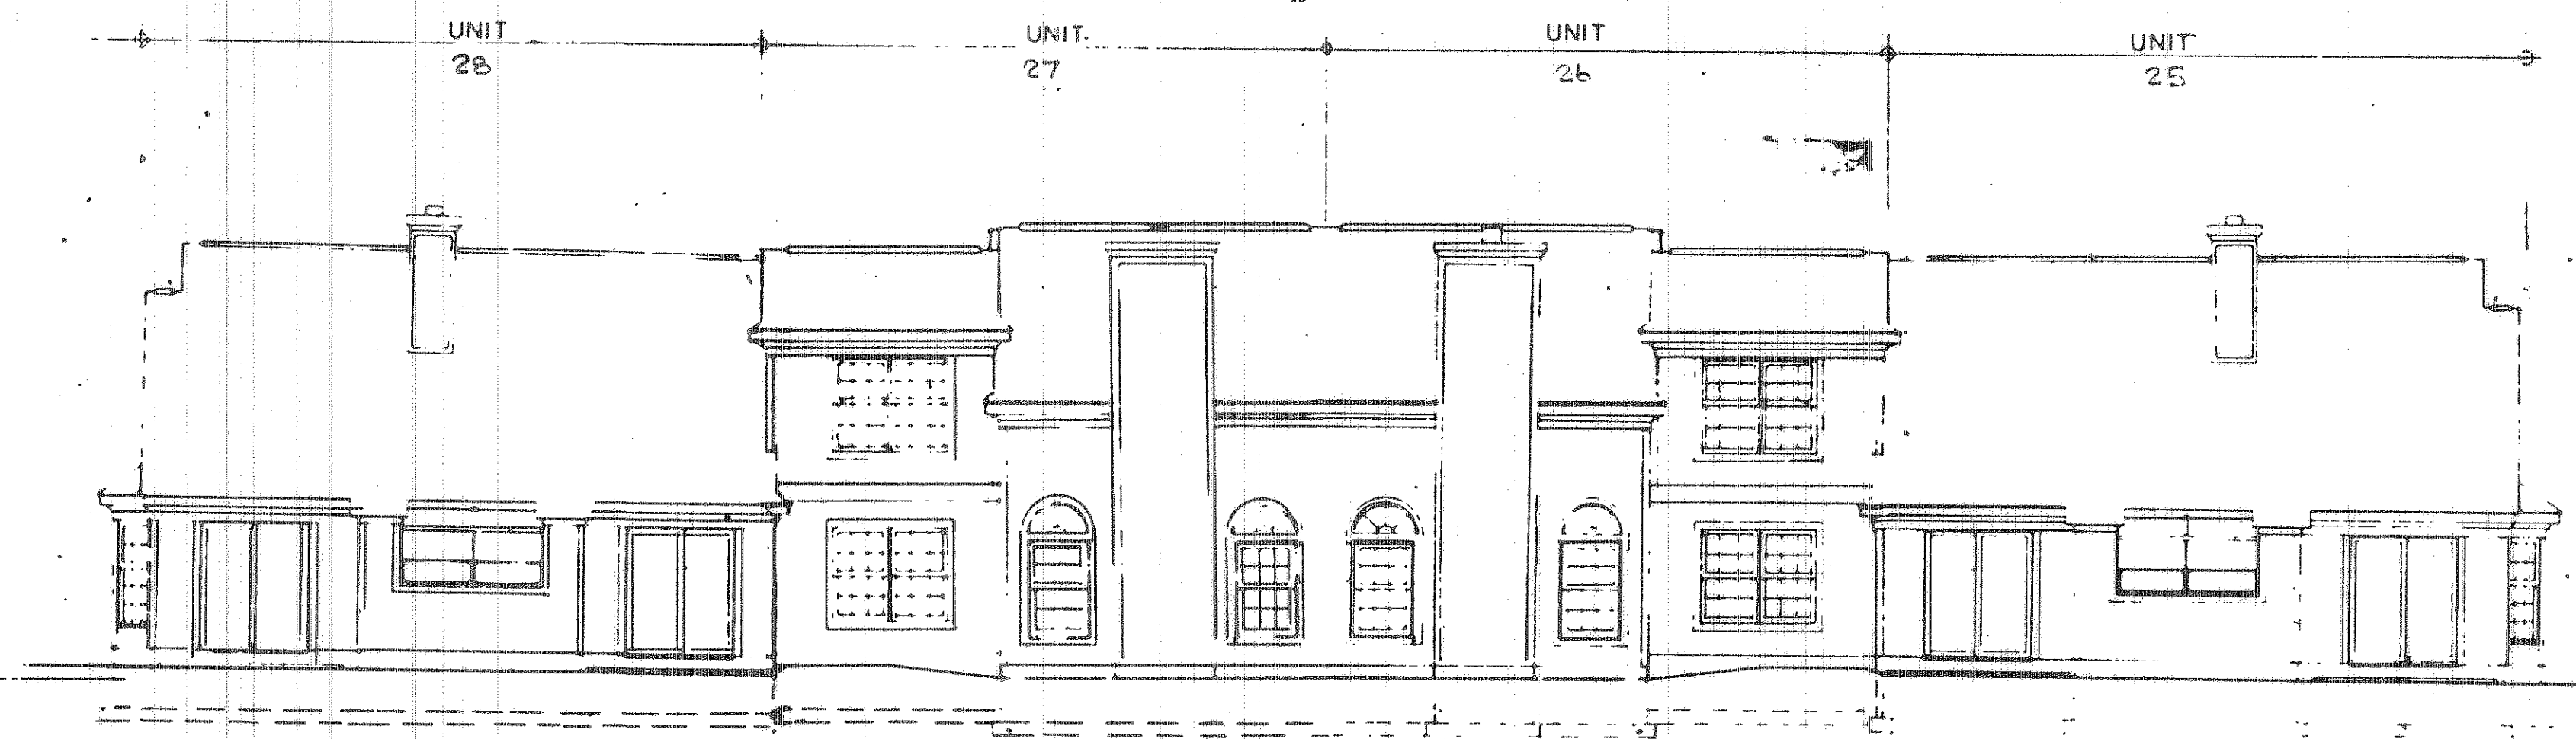


REAR

SCALE 1/8" = 1'-0"

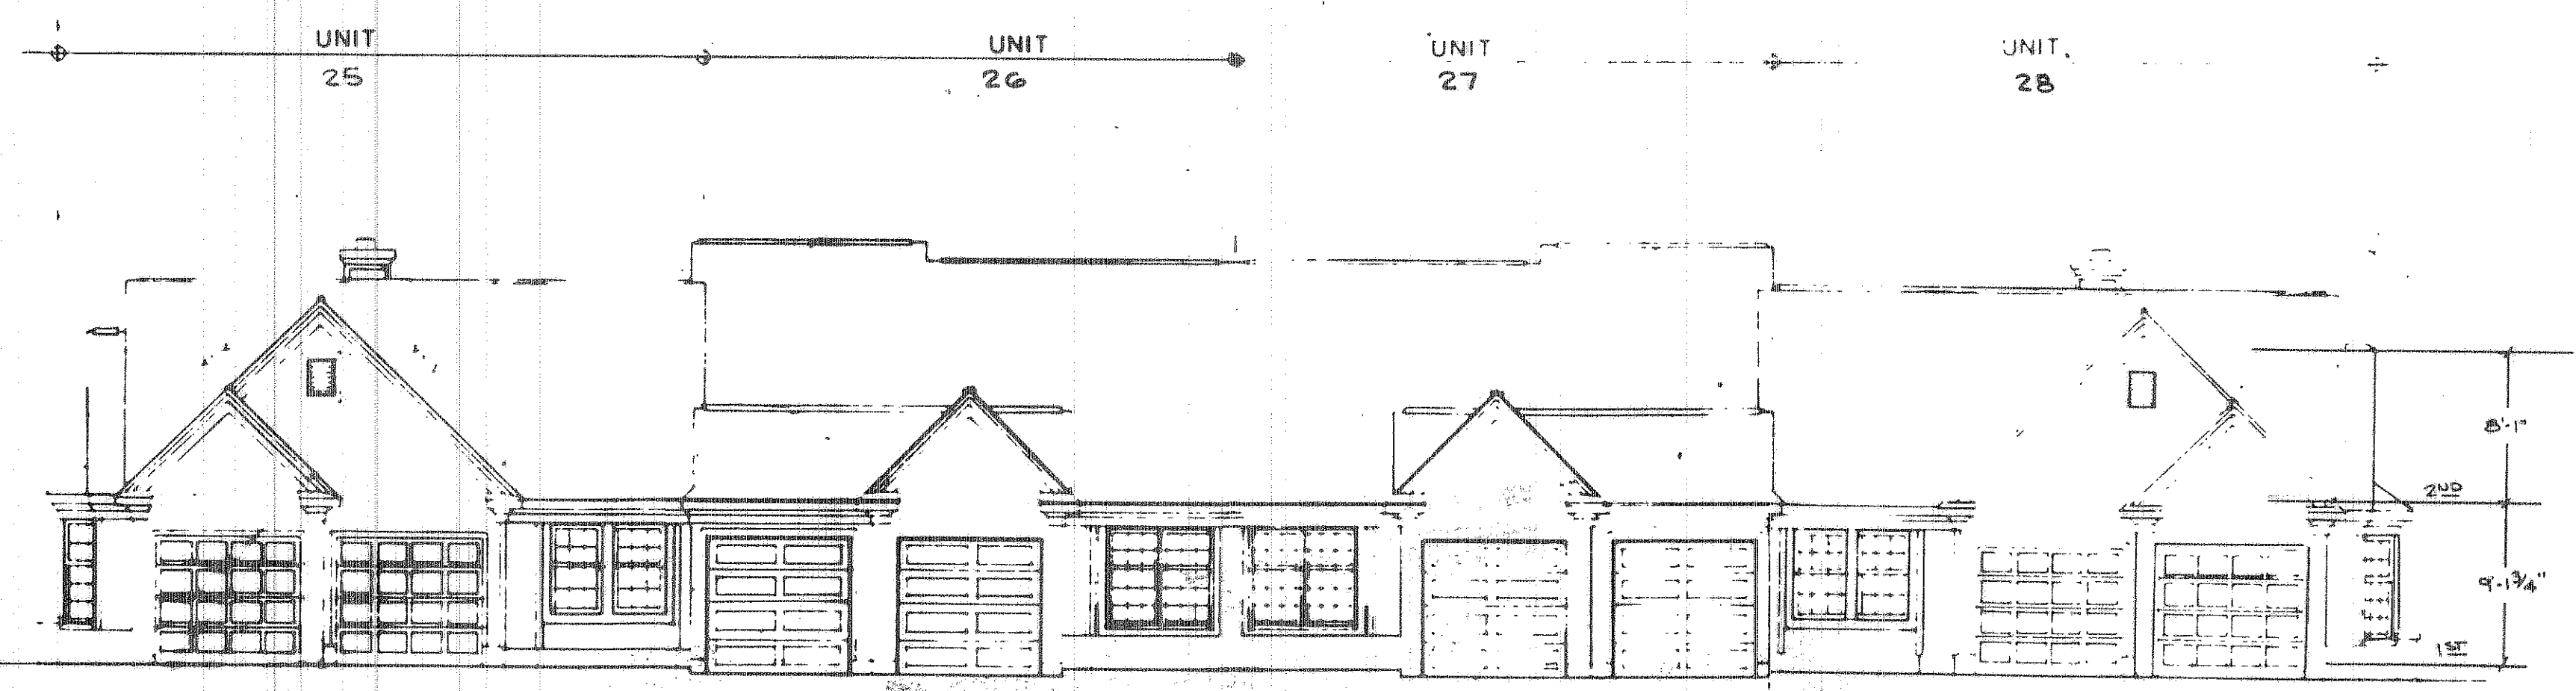


FRONT

SCALE 1/8" = 1'-0"

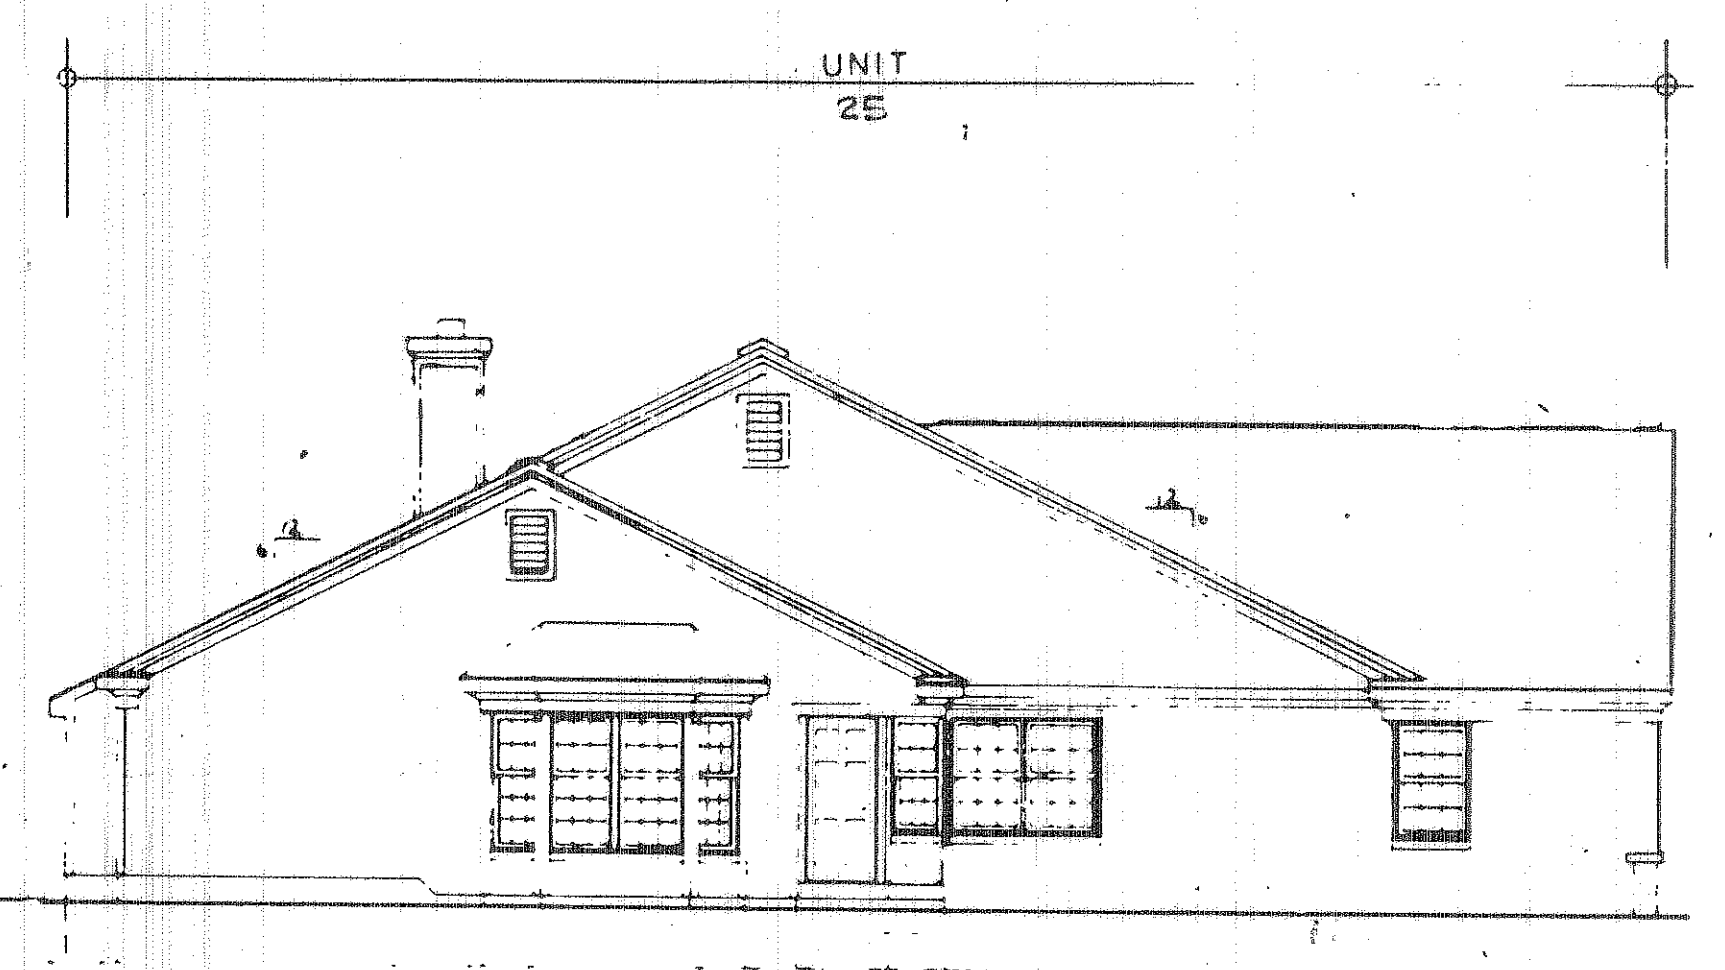

LEFT SIDE

SCALE 1/8" = 1'-0"

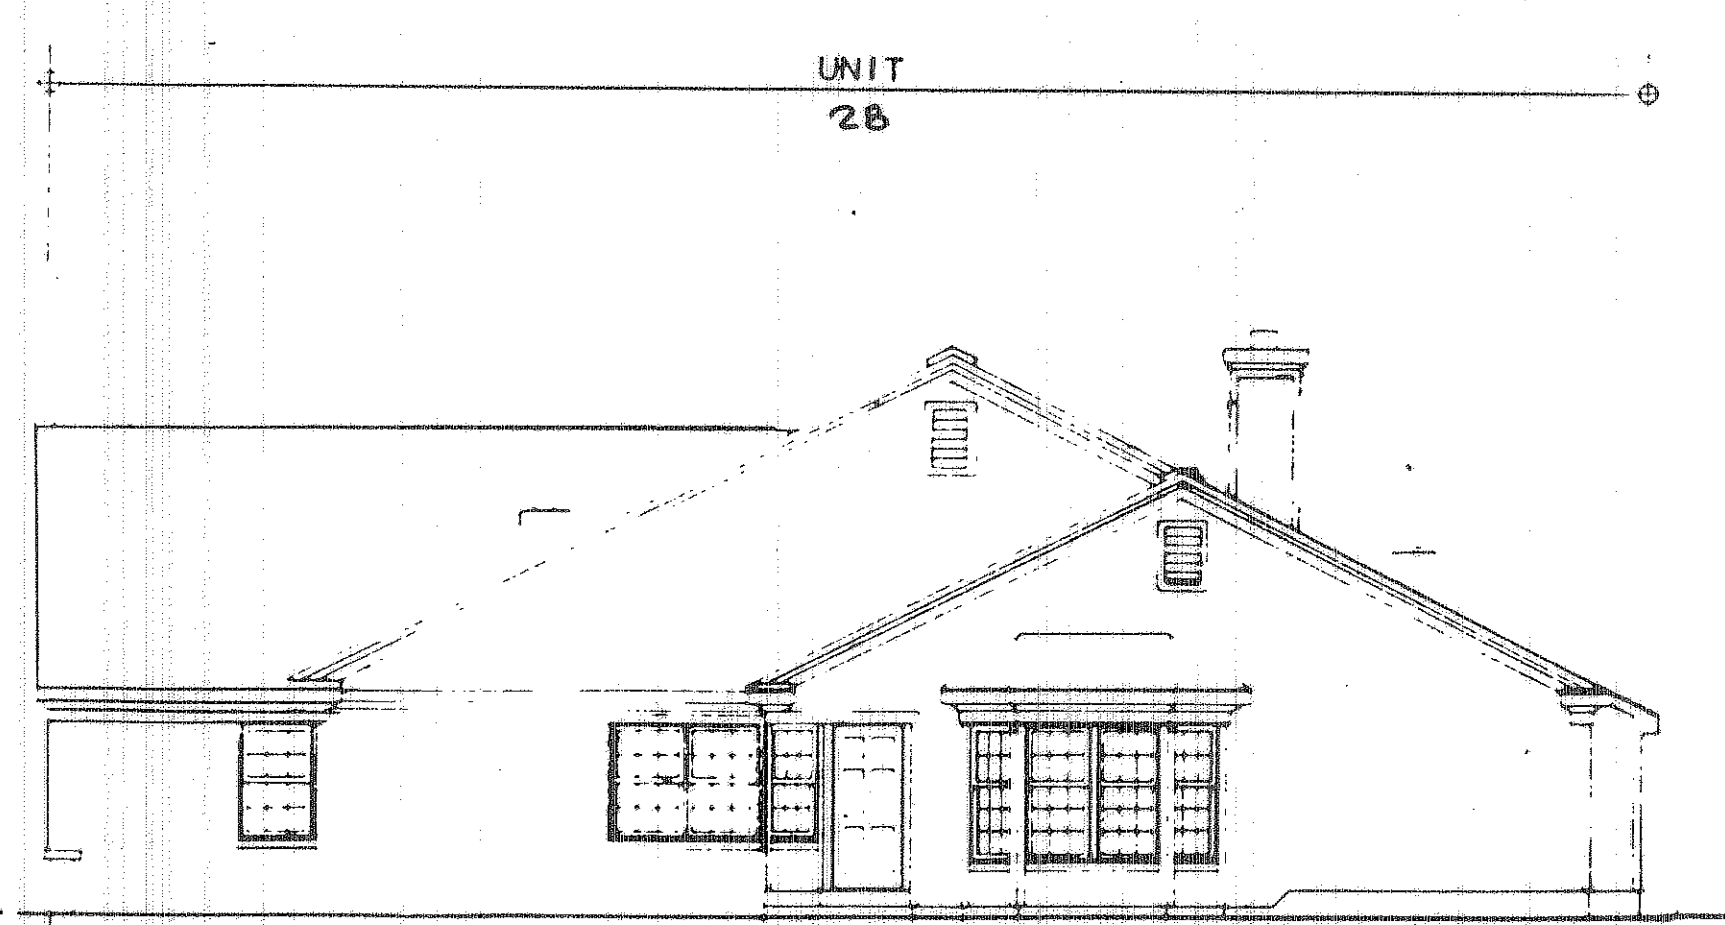

RIGHT SIDE

SCALE 1/8" = 1'-0"

40/50

C-6