
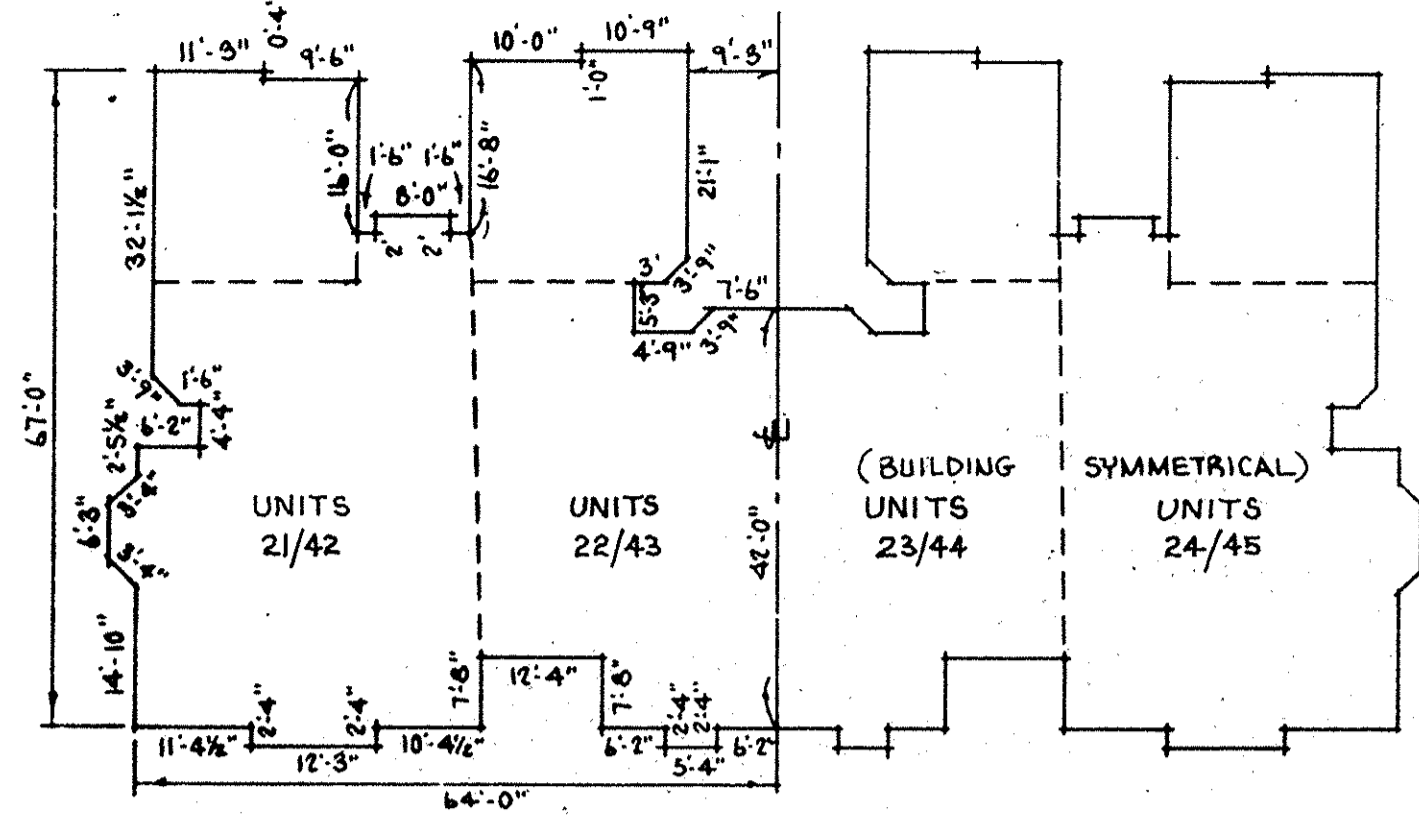


212295

SHEET INDEX 212295

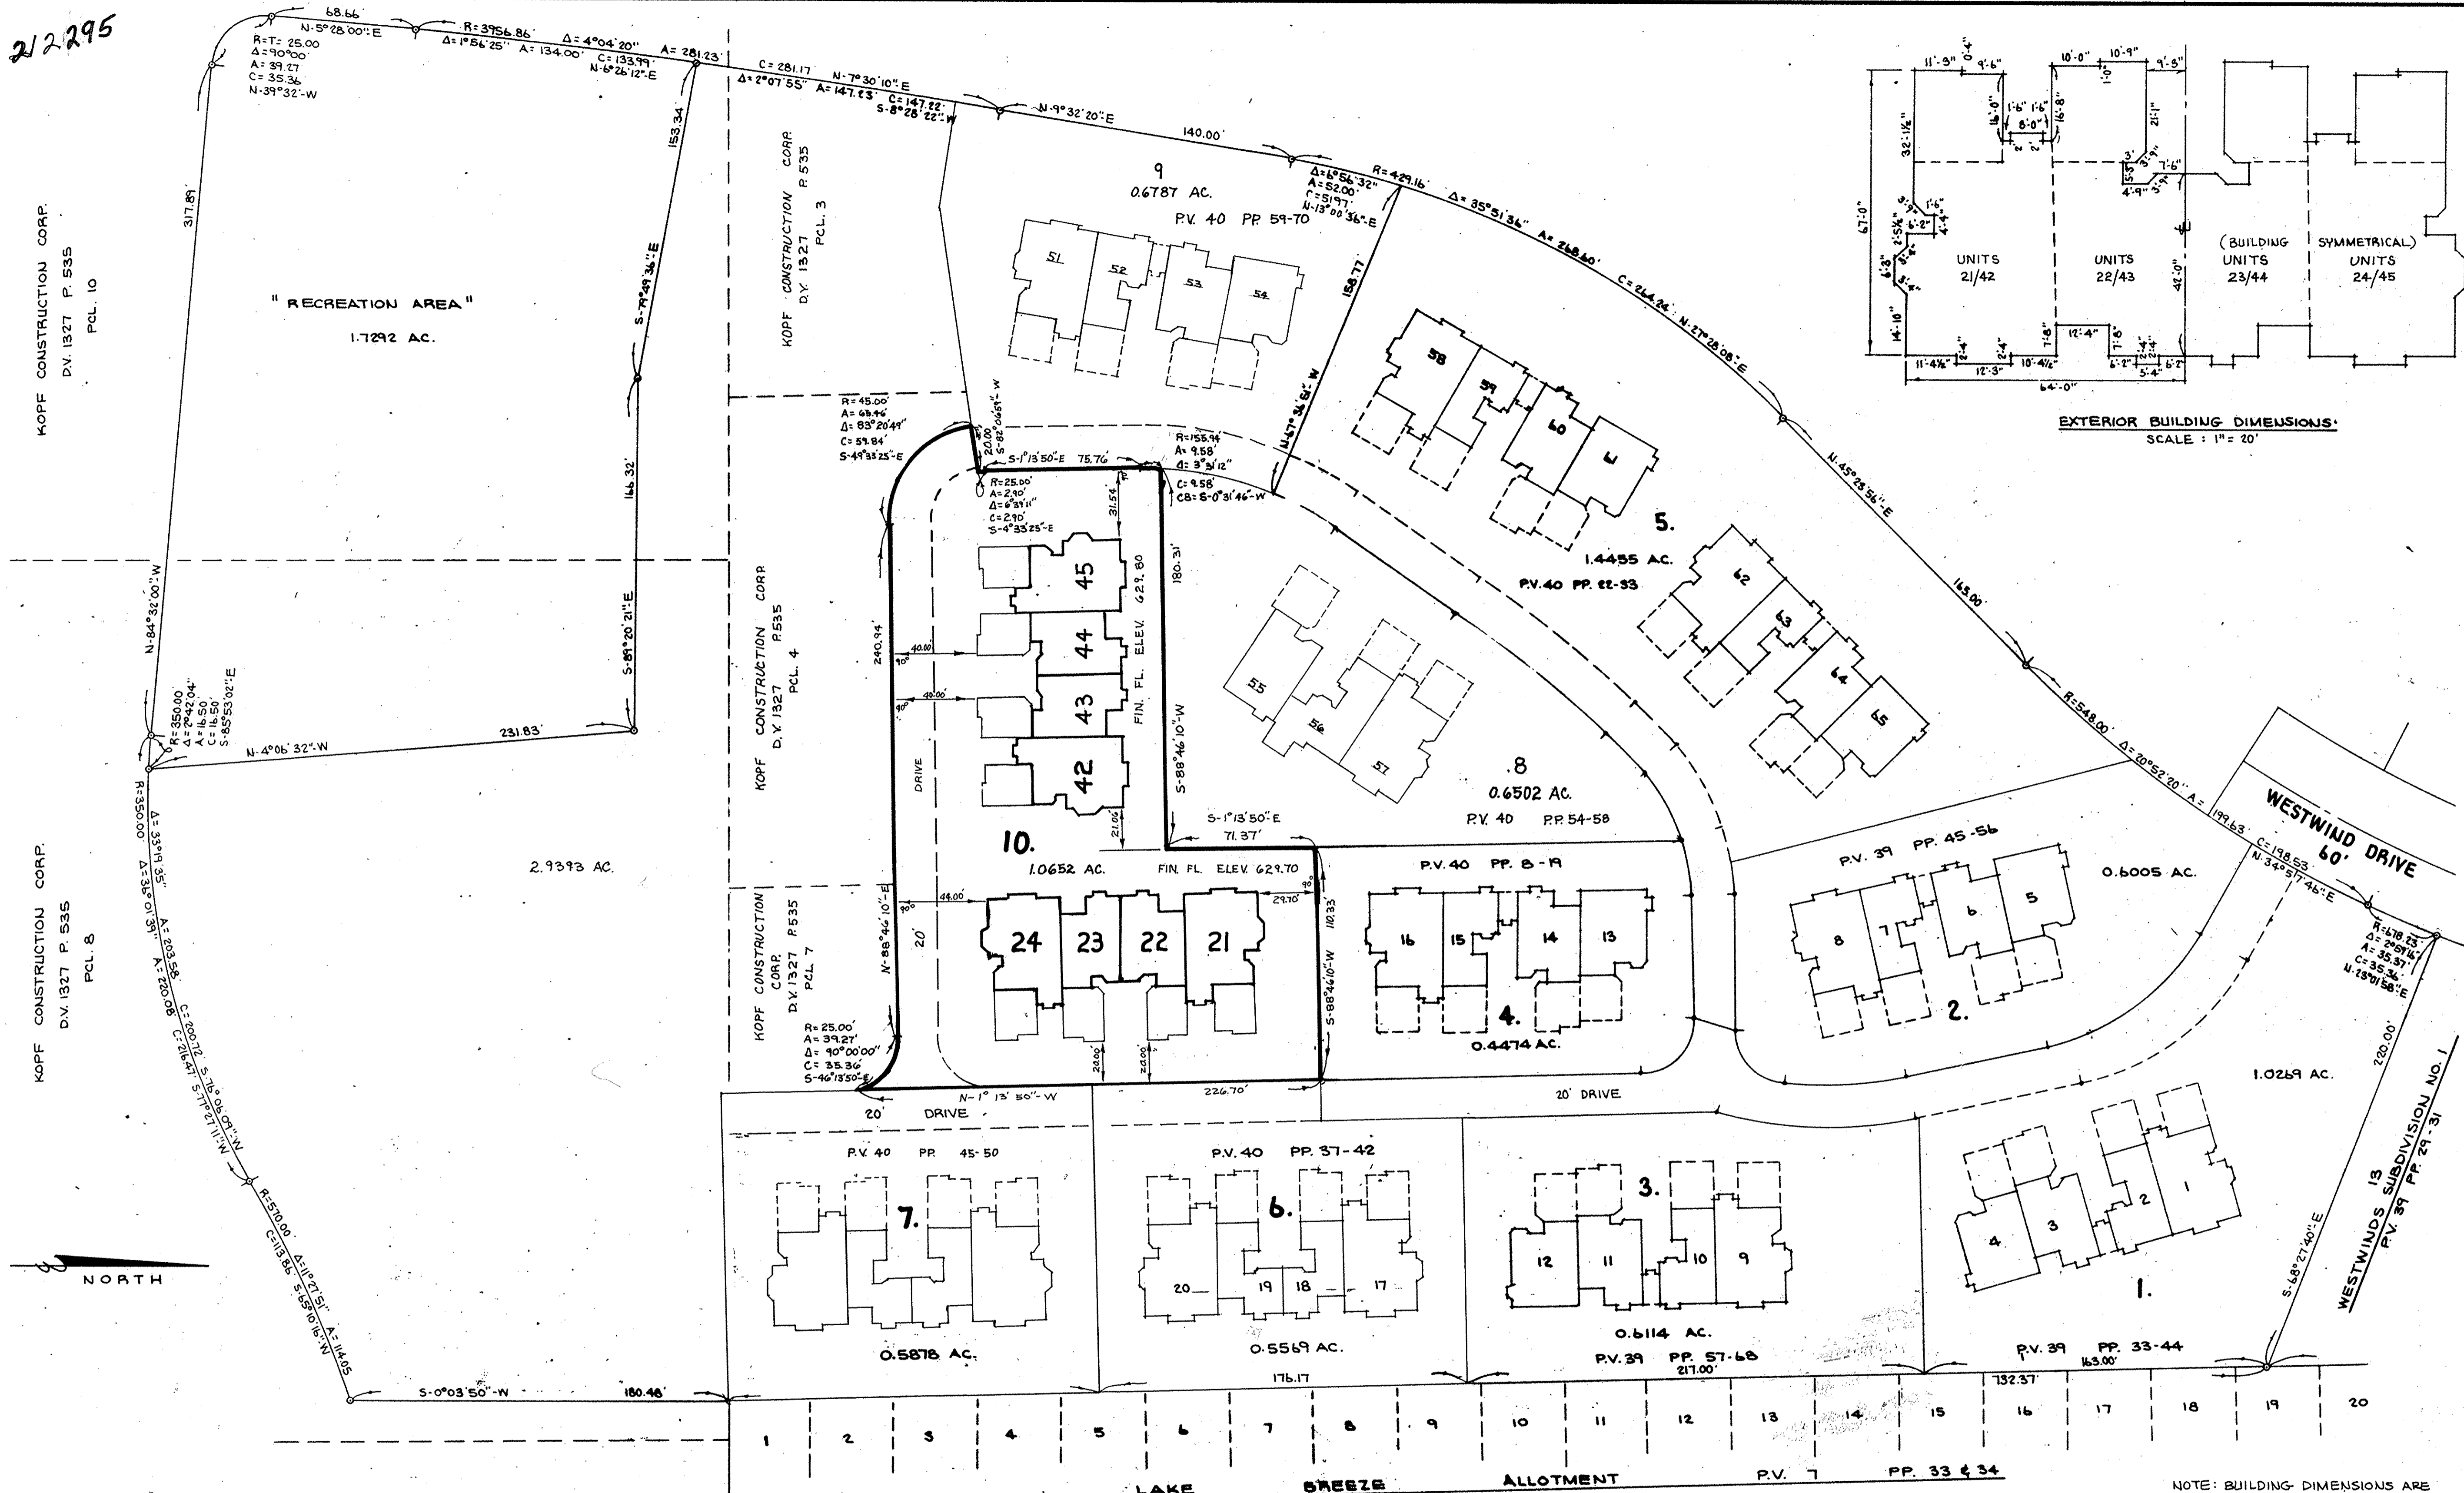



SHT. NO.	DESCRIPTION
1.	SURVEY & UNIT DATA
2.	FLOOR PLAN UNIT 21/45
3.	FLOOR PLAN UNIT 23/44
4.	FLOOR PLAN UNIT 22/43
5.	FLOOR PLAN UNIT 21/42
6.	ELEVATIONS

PERCENTAGE OF OWNERSHIP		
UNIT NO.	AREA (S.F.)	%
1	1451	2.0809
2	1776	2.5470
3	1491	2.1383
4	1207	1.7310
5	1207	1.7310
6	1491	2.1383
7	1776	2.5470
8	1451	2.0809
9	1451	2.0809
10	1776	2.5470
11	1491	2.1383
12	1207	1.7310
13	1207	1.7310
14	1491	2.1383
15	1776	2.5470
16	1451	2.0809
17	1451	2.0809
18	1776	2.5470
19	1491	2.1383
20	1451	2.0809
21	1451	2.0809
22	1491	2.1383
23	1491	2.1383
24	1451	2.0809
25	1451	2.0809
26	1491	2.1383
27	1491	2.1383
28	1451	2.0809
29	1491	2.1383
30	1776	2.5470
31	1451	2.0809
32	1776	2.5470
33	1451	2.0809
34	1491	2.1383
35	1491	2.1383
36	1451	2.0809
37	1451	2.0809
38	1776	2.5470
39	1451	2.0809
40	1776	2.5470
41	1491	2.1383
42	1451	2.0809
43	1491	2.1383
44	1491	2.1383
45	1451	2.0809

CERTIFICATION:
THIS IS TO CERTIFY THAT THE ATTACHED DRAWINGS CORRECTLY REPRESENT THE BUILDINGS AS CONSTRUCTED AND THAT THERE ARE NO ENCROACHMENTS ON ADJUTING PROPERTIES.

LORAIN COUNTY TAX MAP DEPARTMENT COPY

JAMES H. SCHMIDT - REG. SURVEYOR NO. 4844
ROBERT E. KLEINOEDER - REG. ENGINEER NO. 18258

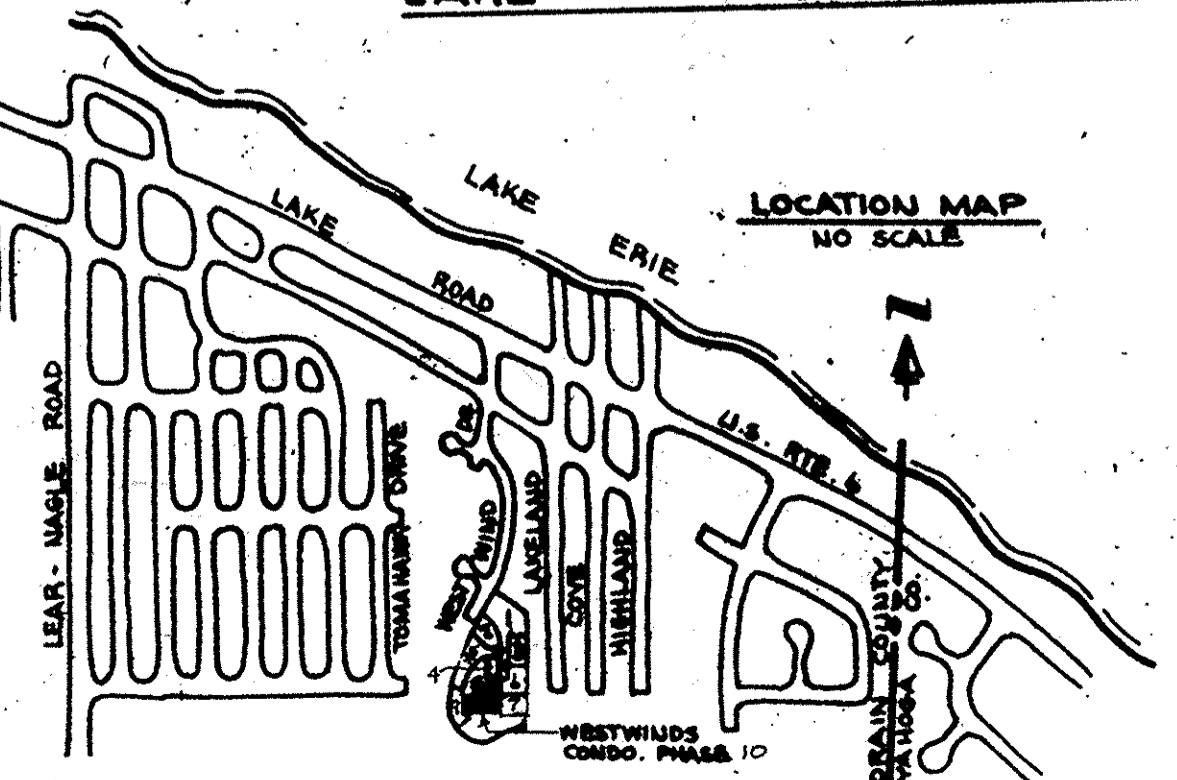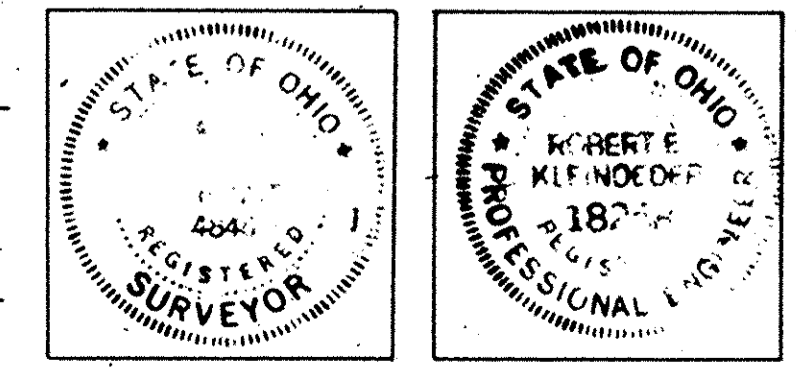

TRANSFERRED
JULIAN A. FLOR
LORAIN COUNTY AUDITOR

Received for Record MAR 13 1988
Dorothy L. Esca
LORAIN COUNTY RECORDER


WESTWINDS CONDOMINIUM PHASE 10
PART OF AVON TOWNSHIP SECTION NO. 30
CITY OF AVON LAKE COUNTY OF LORAIN
STATE OF OHIO

SCALE: 1" = 40'
MARCH 1986
PREPARED BY
KLEINOEDER SCHMIDT & ASSOC.
CONSULTING ENGINEERS SURVEYORS


By: LORAIN CO. TITLE CO. S.K.

212295


212295

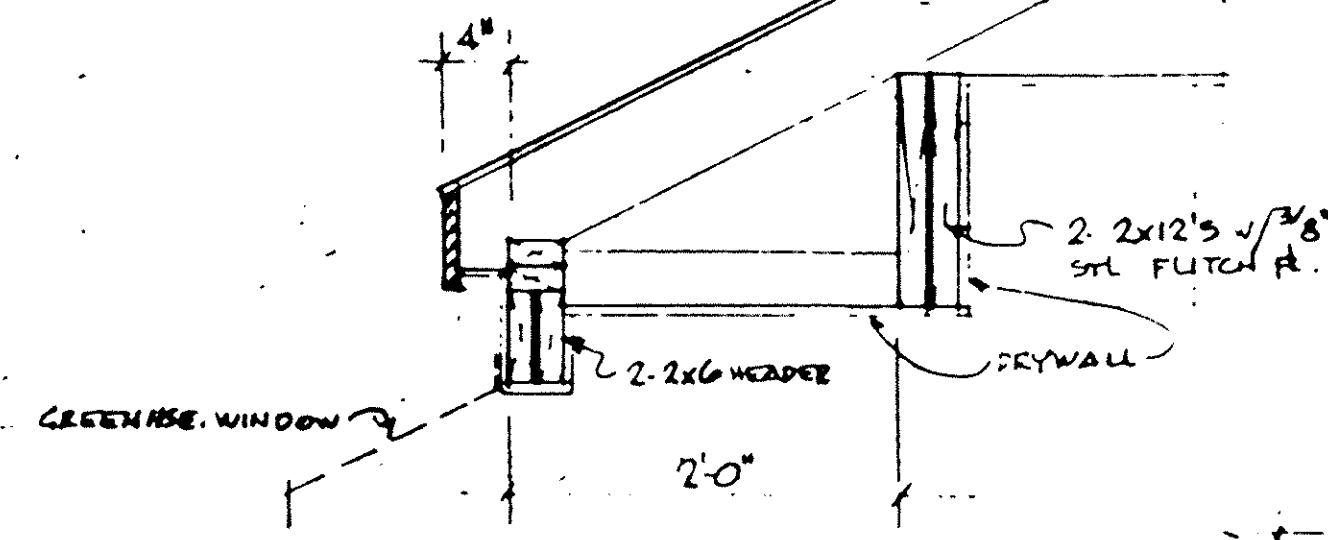

- NOTES**
1. ALL WALLS SHALL BE 3 1/2" UNLESS NOTED OTHERWISE.
 2. ALL DIMENSIONS ARE TO ROUGH FRAMING.
 3. REFER TO WALL SECTION SHEET FOR STRUCTURAL INFORMATION.

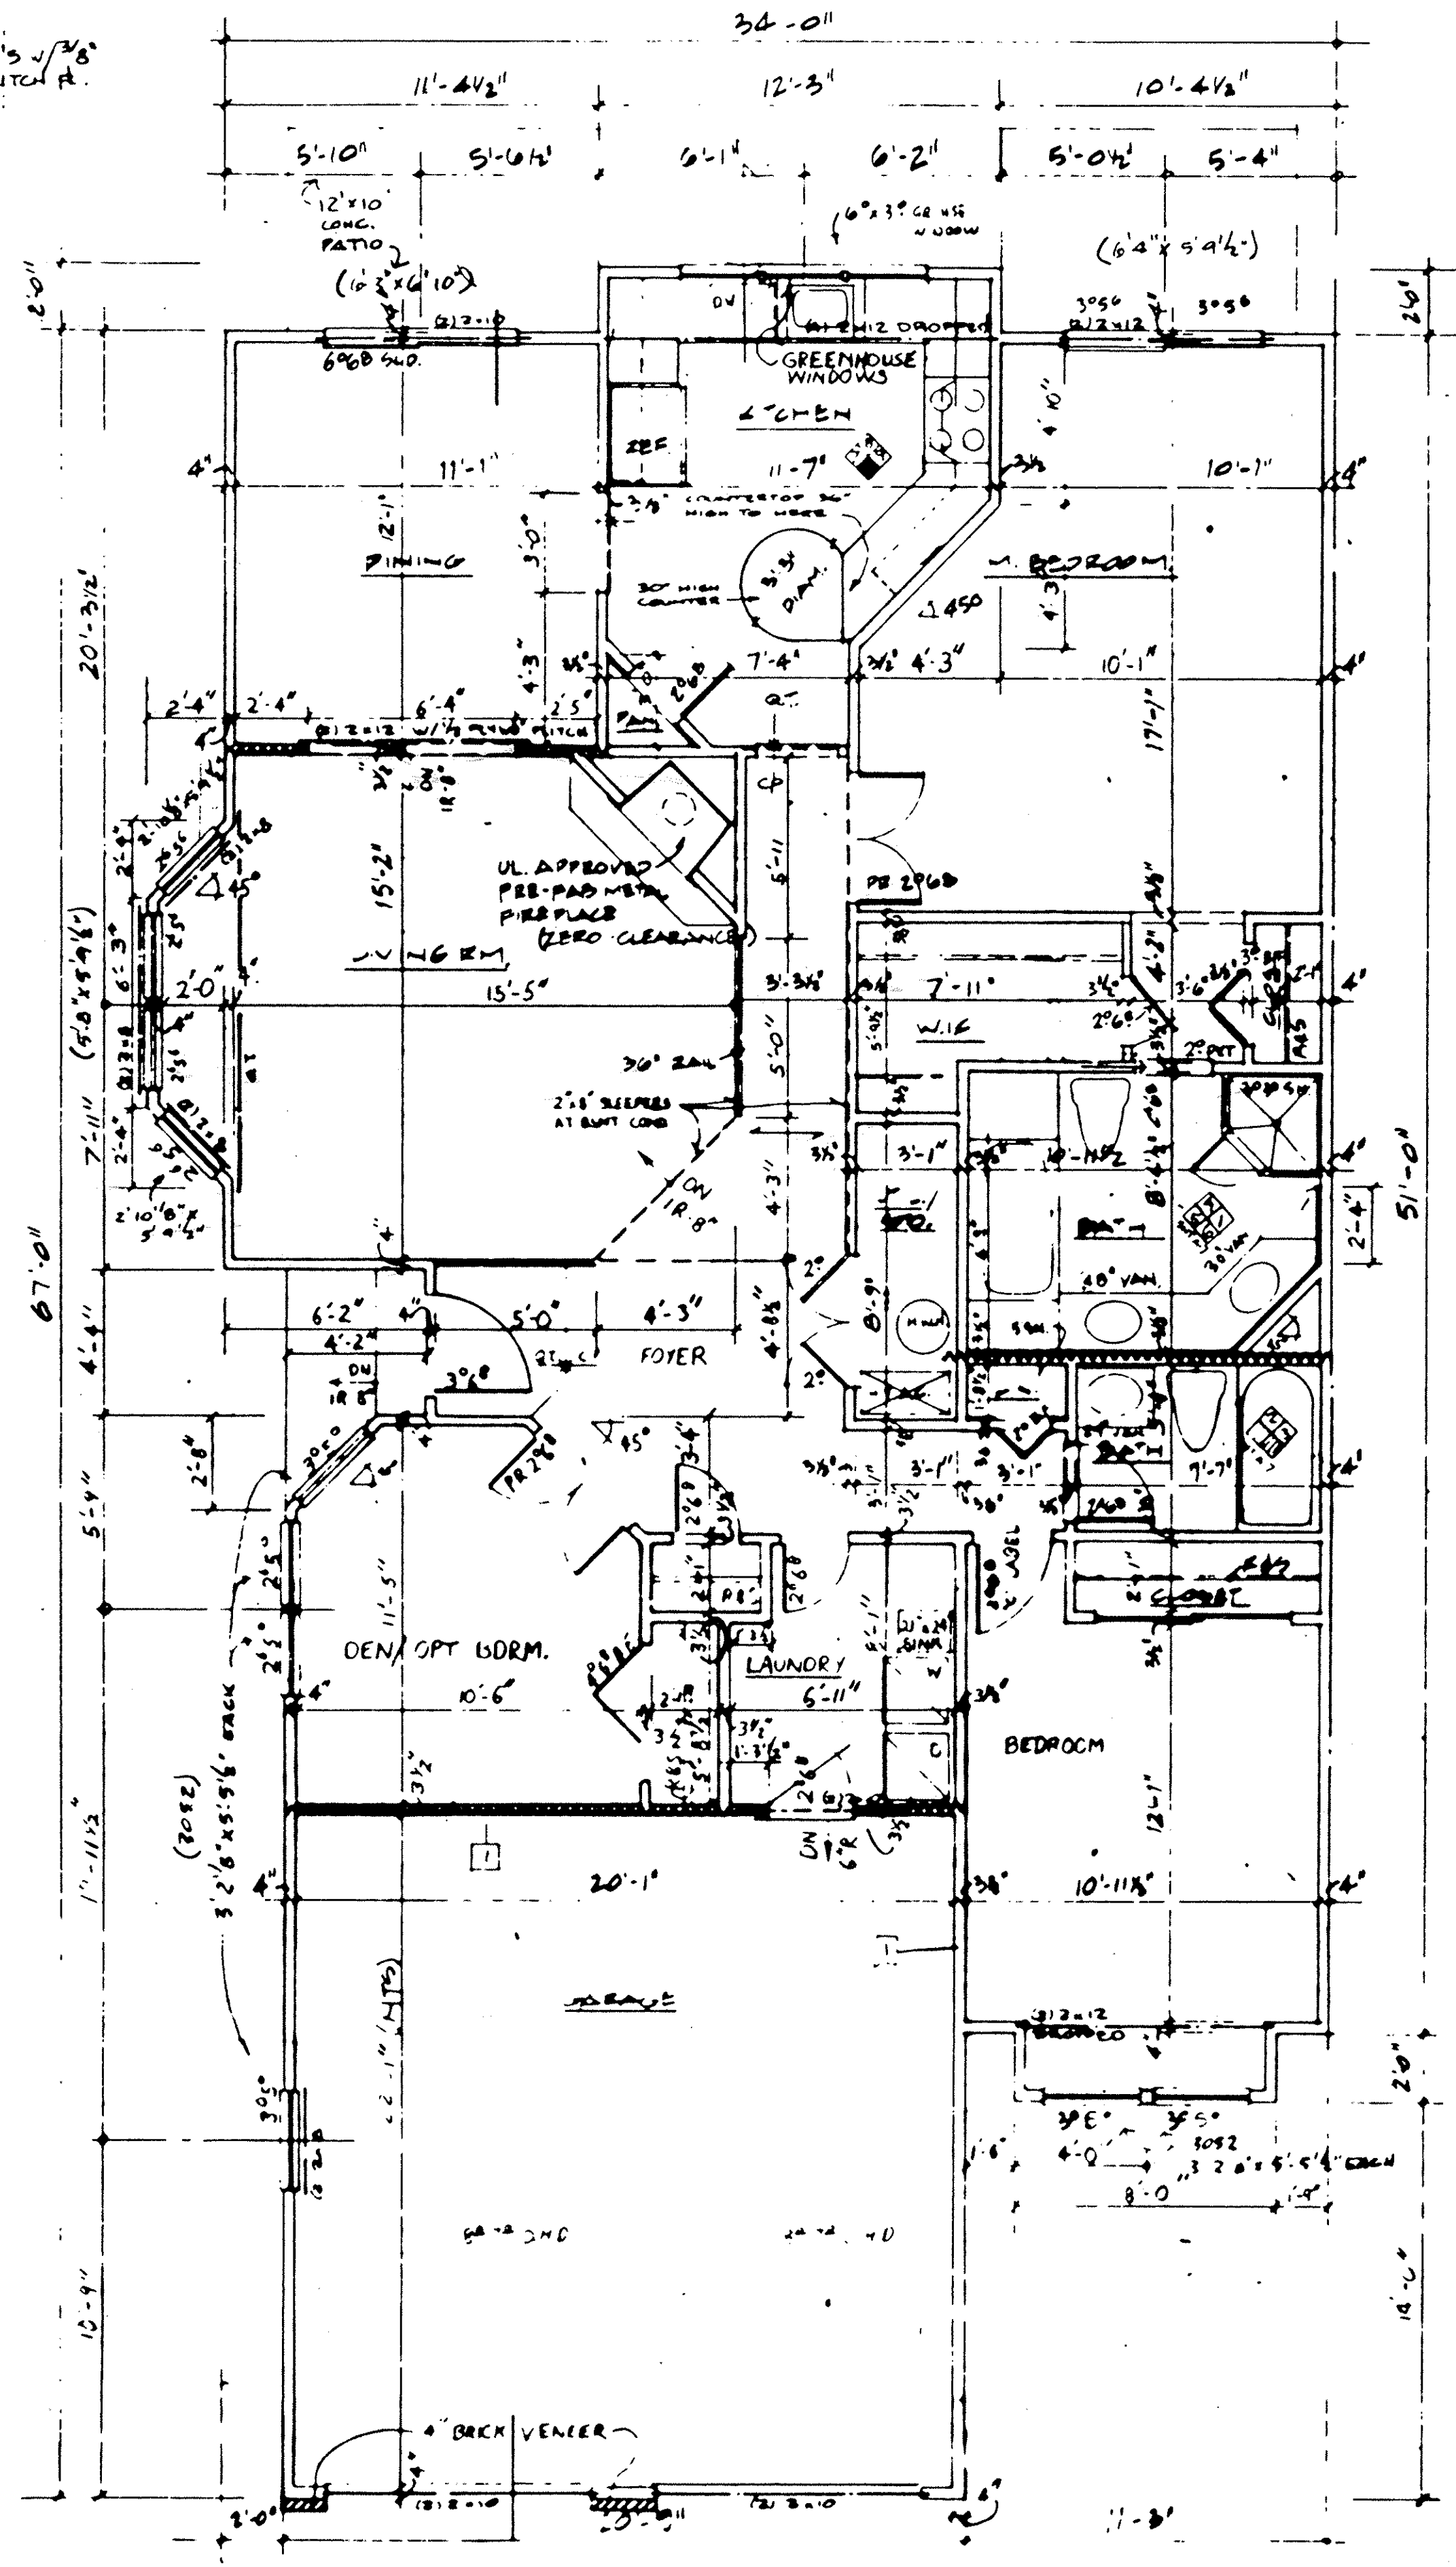

FIRST FLOOR UNIT 24/45

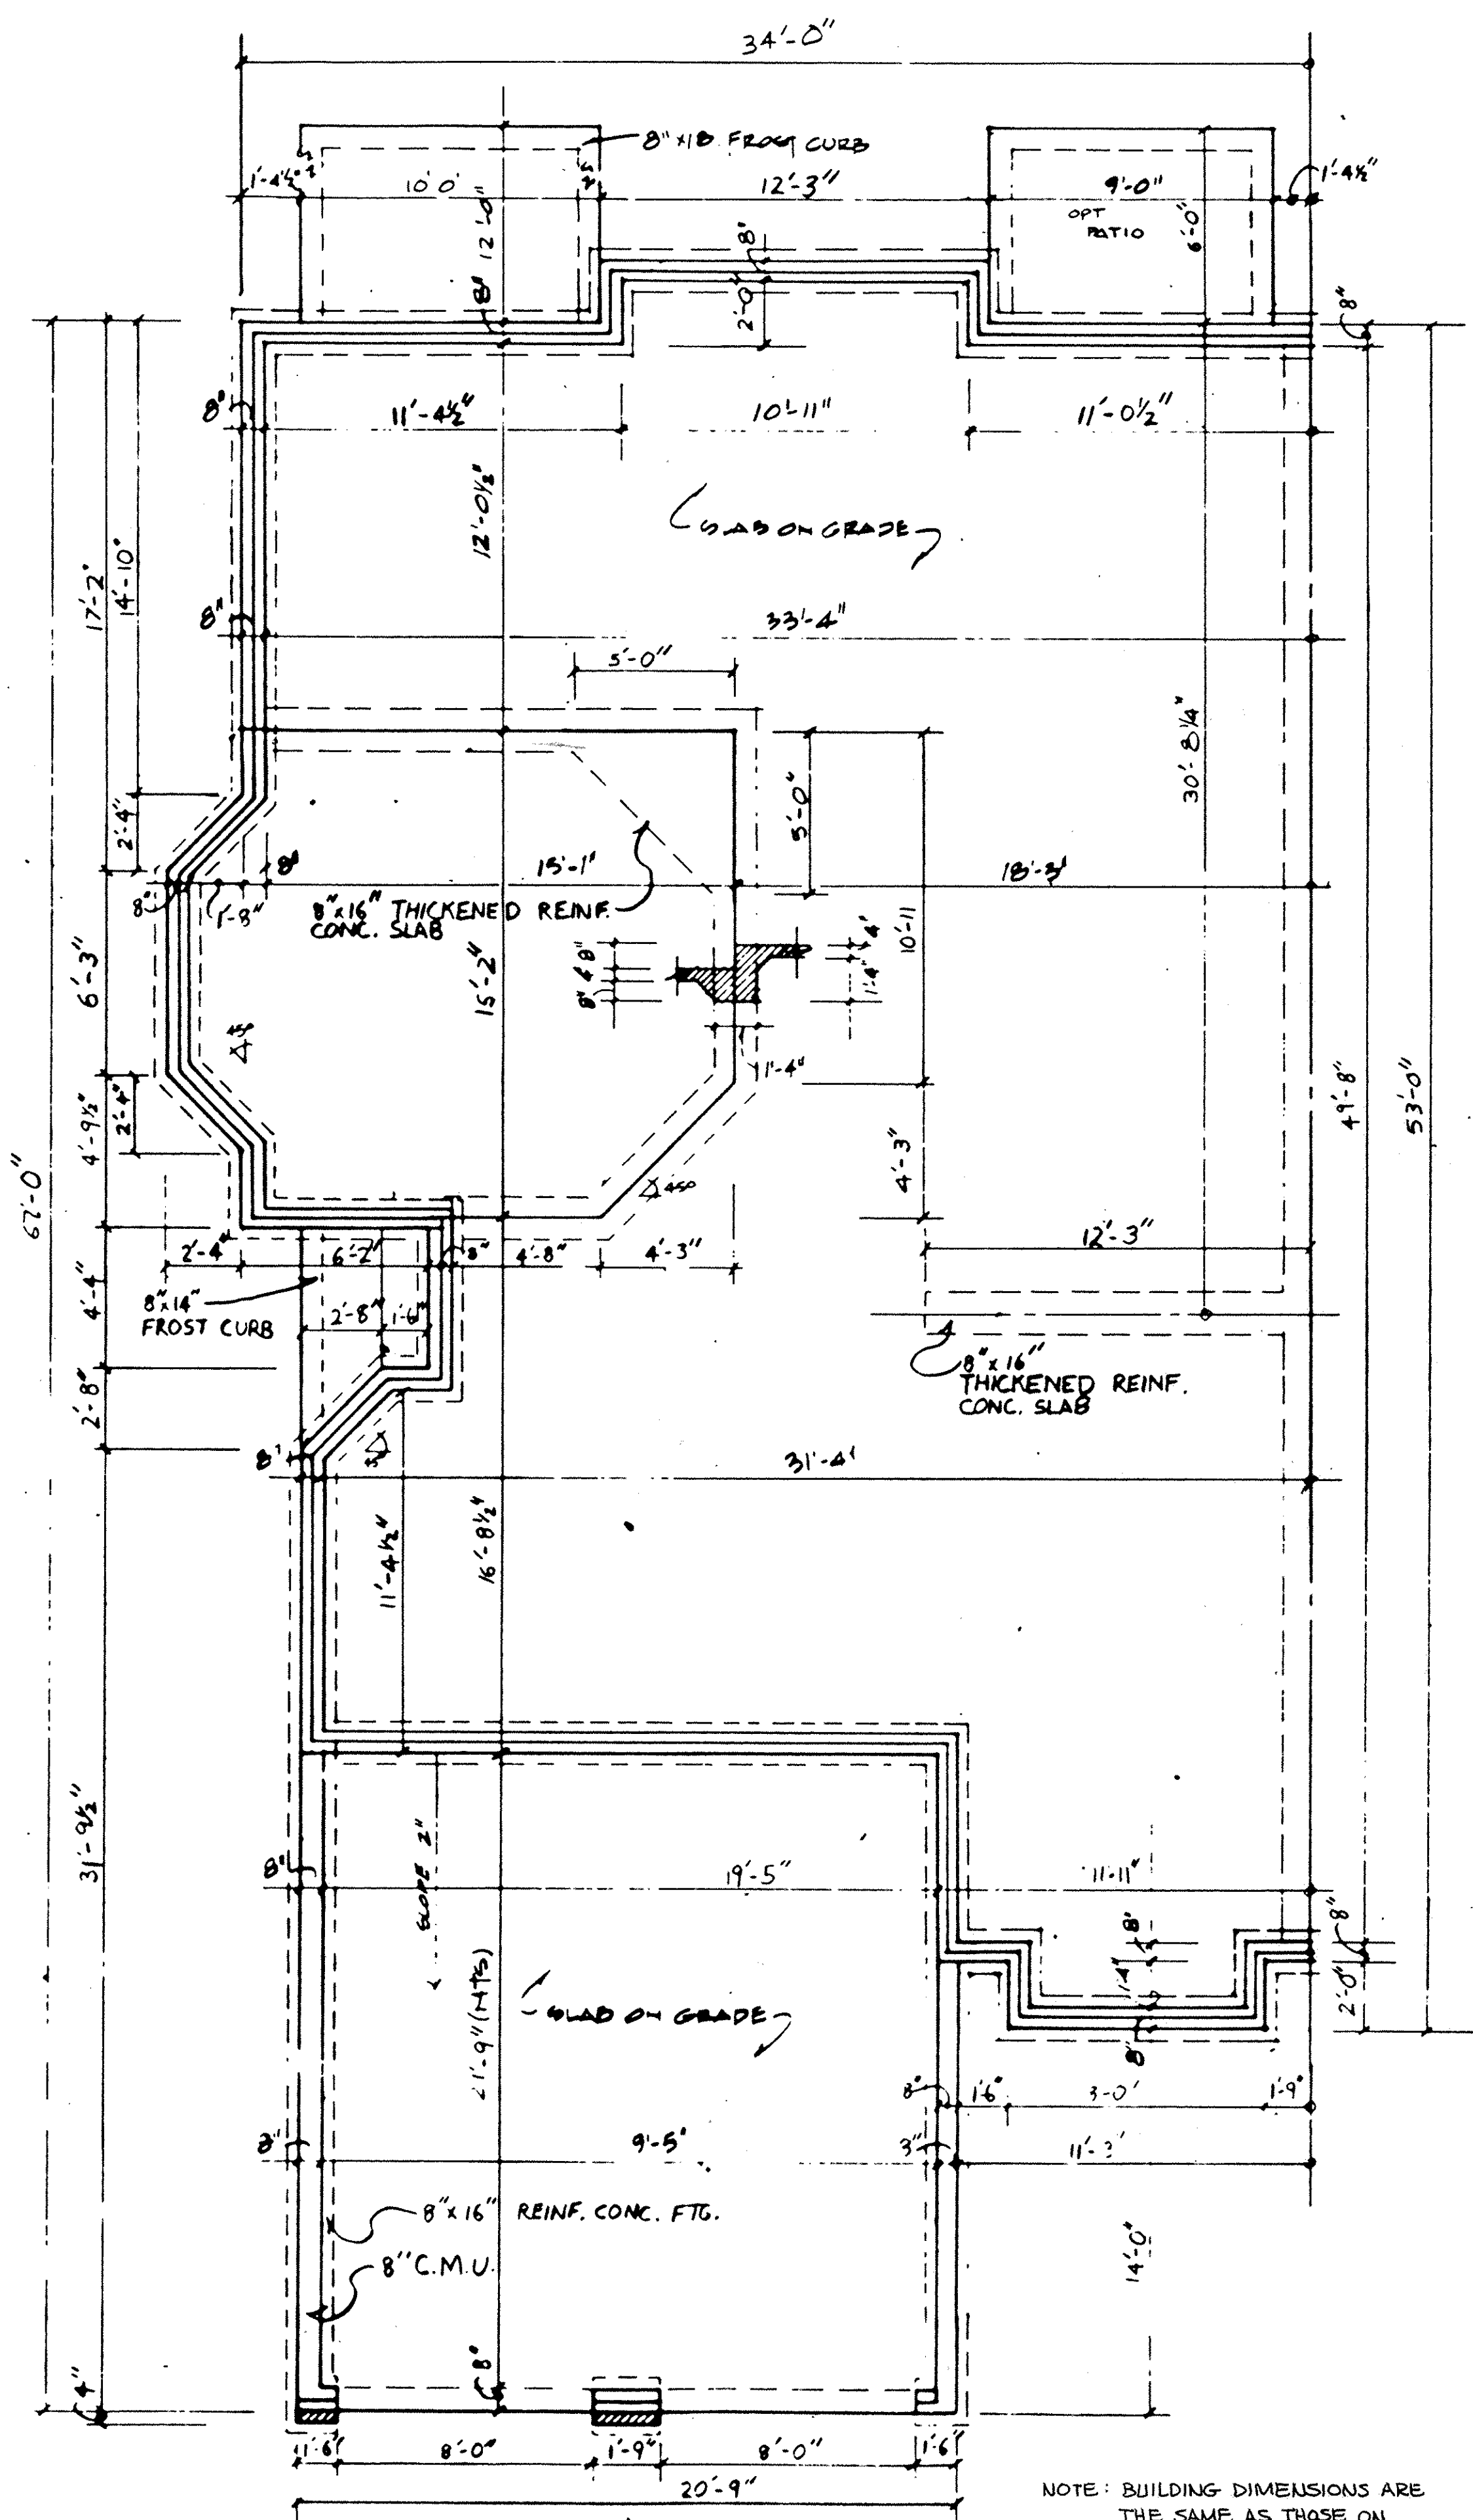



FOUNDATION UNIT 24/45

NOTE: BUILDING DIMENSIONS ARE THE SAME AS THOSE ON PHASE 6 - P.V. 40 PP. 37-42.

LORAIN COUNTY TAX MAP DEPARTMENT COPY

41/8
C-2



212295

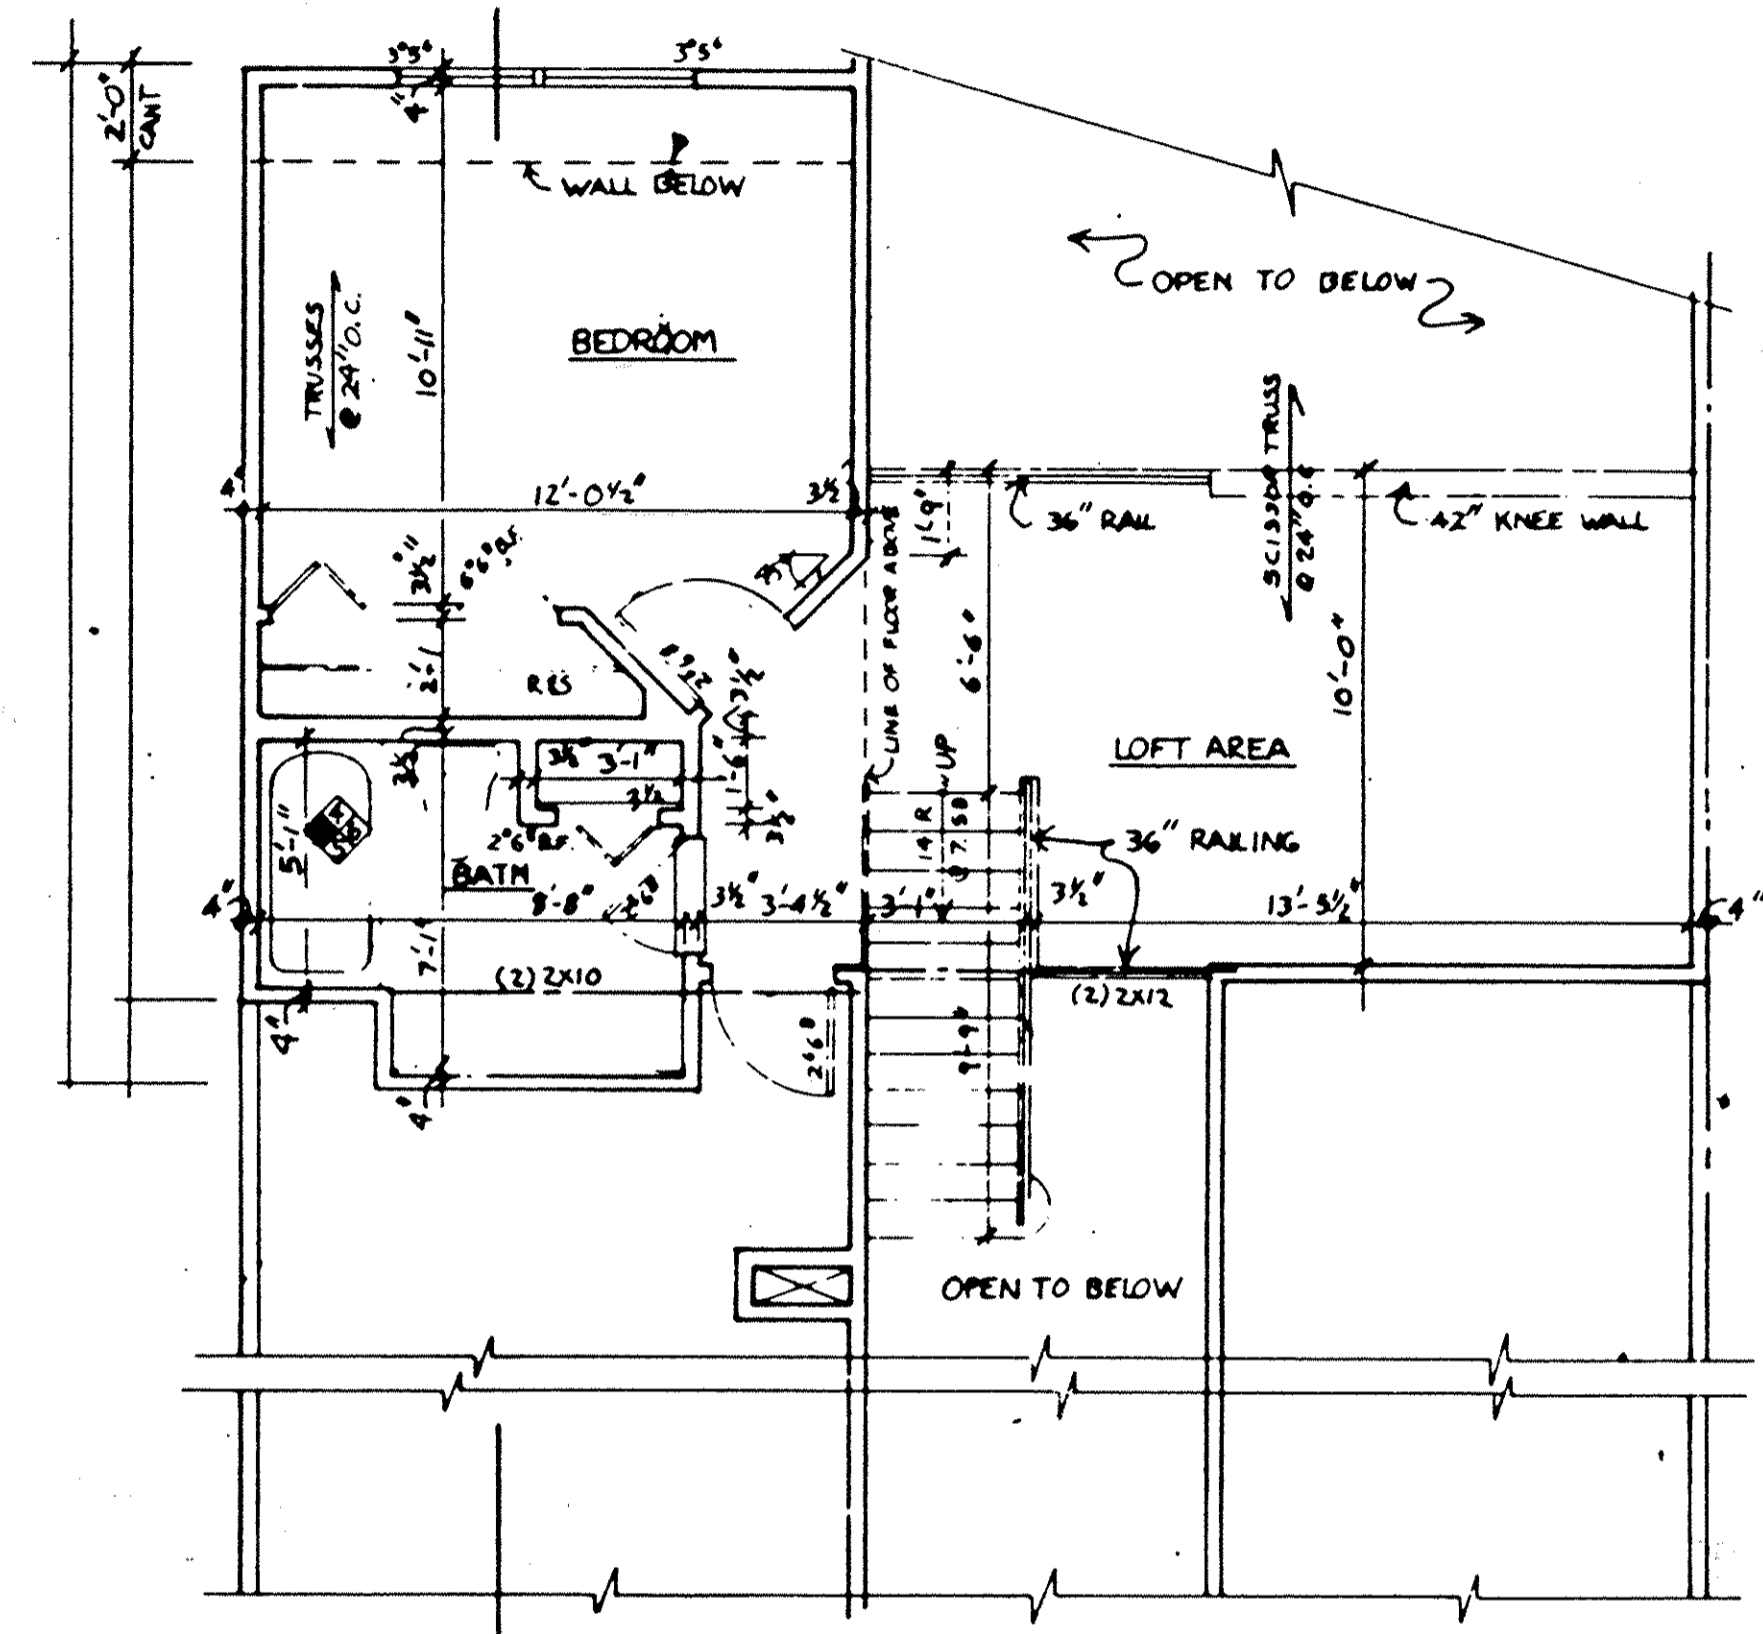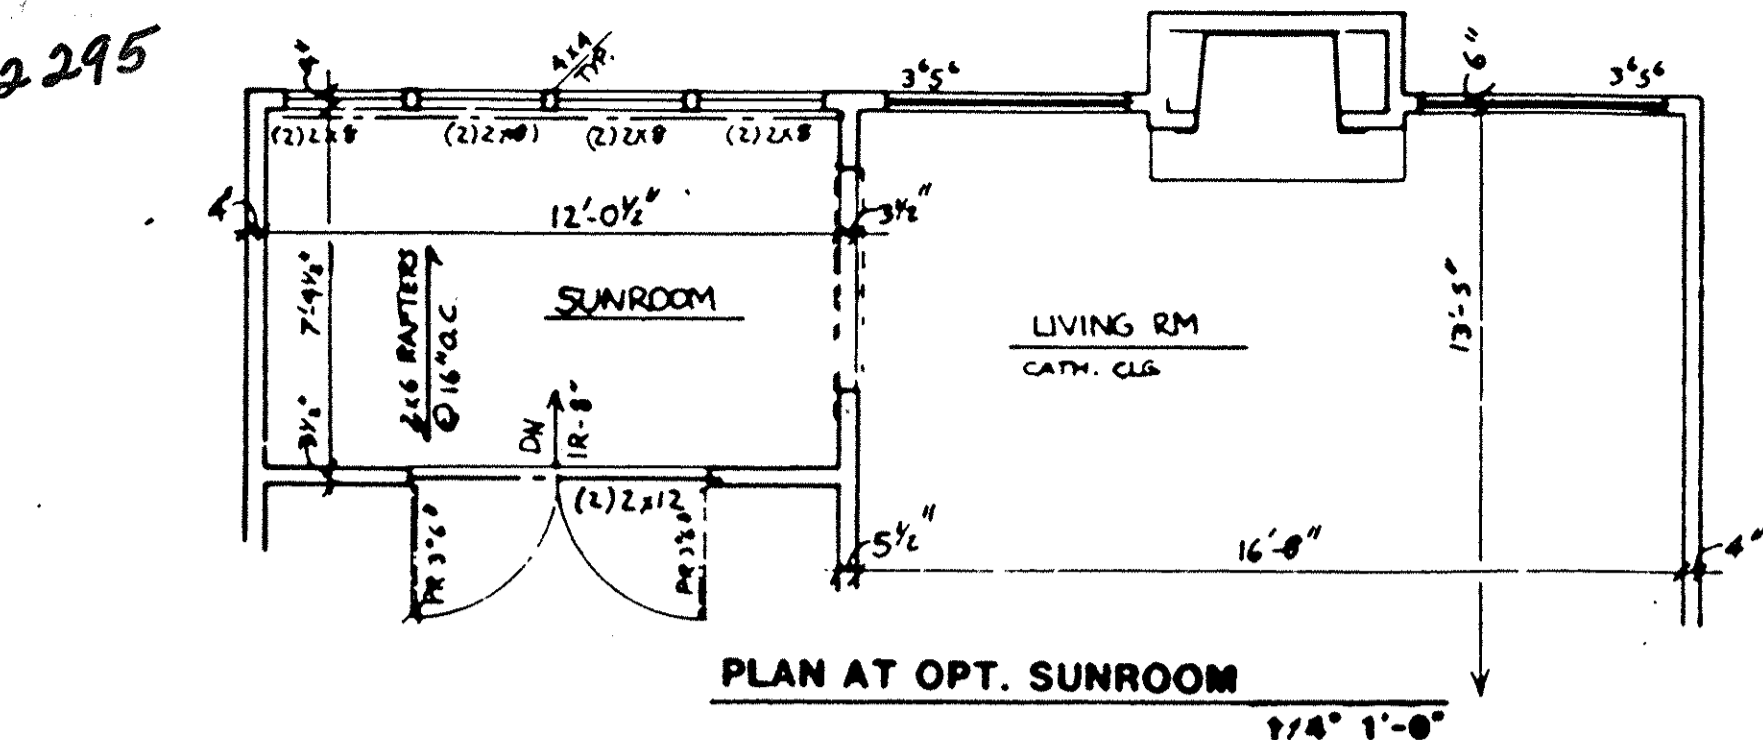

LORAIN COUNTY TAX MAP DEPARTMENT COPY

KEY	
	BEARING WALL W/ 1 HR. FIRE RATING
	1 HOUR FIRE RATED WALL 1 LAYER 5/8\"/>


- NOTES**
- ALL WALLS SHALL BE 3 1/2\"/>

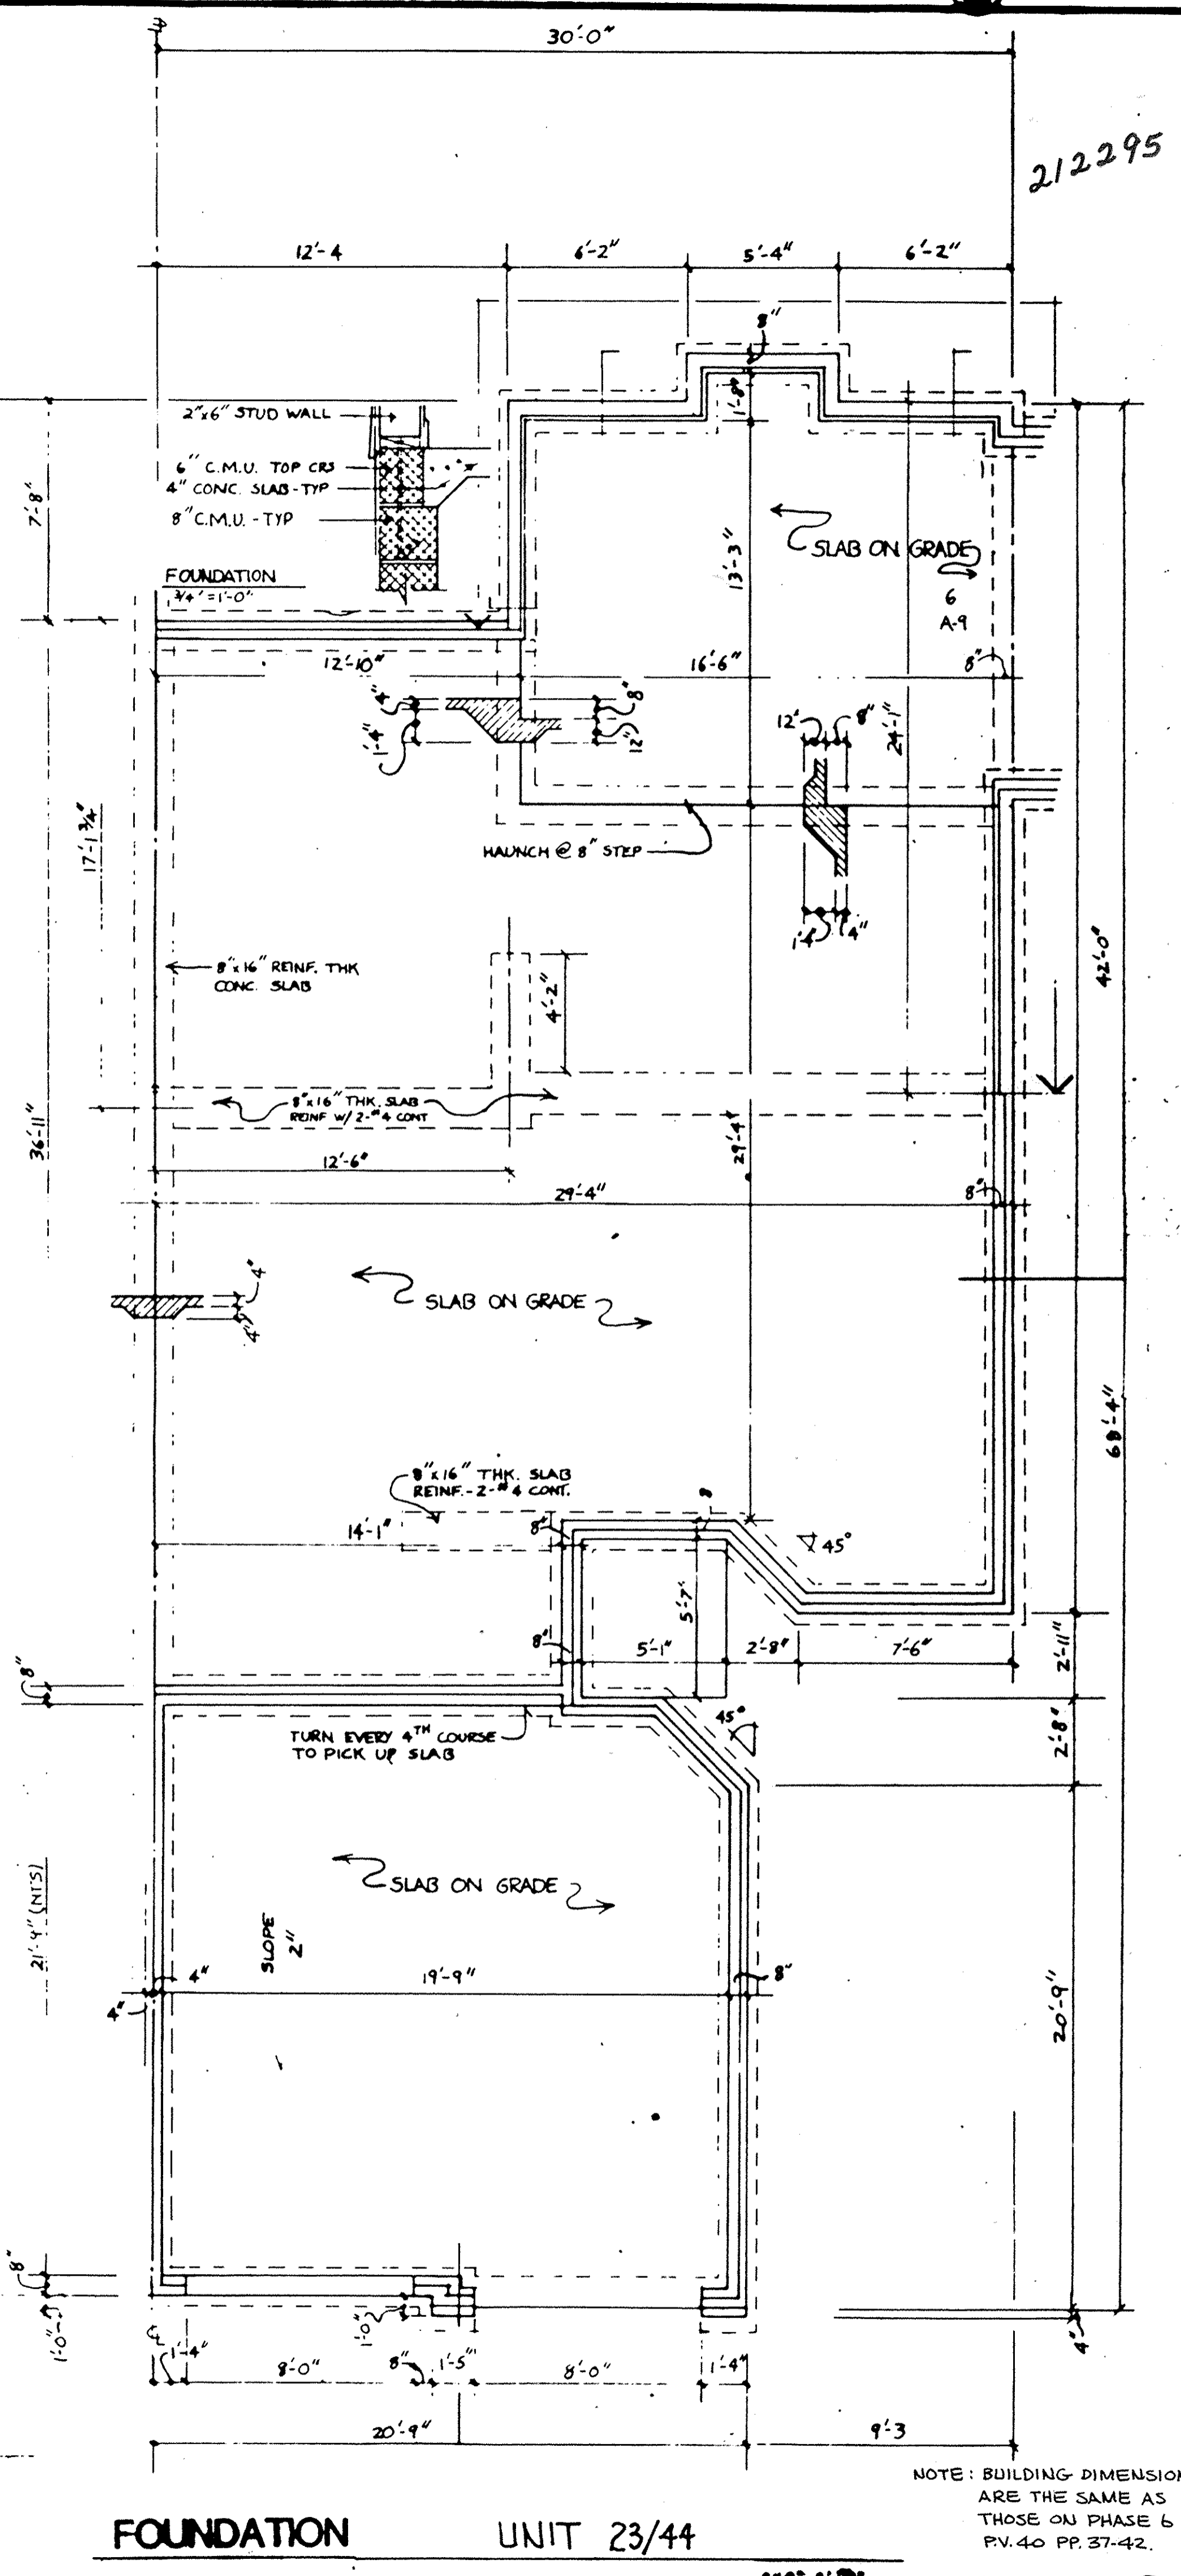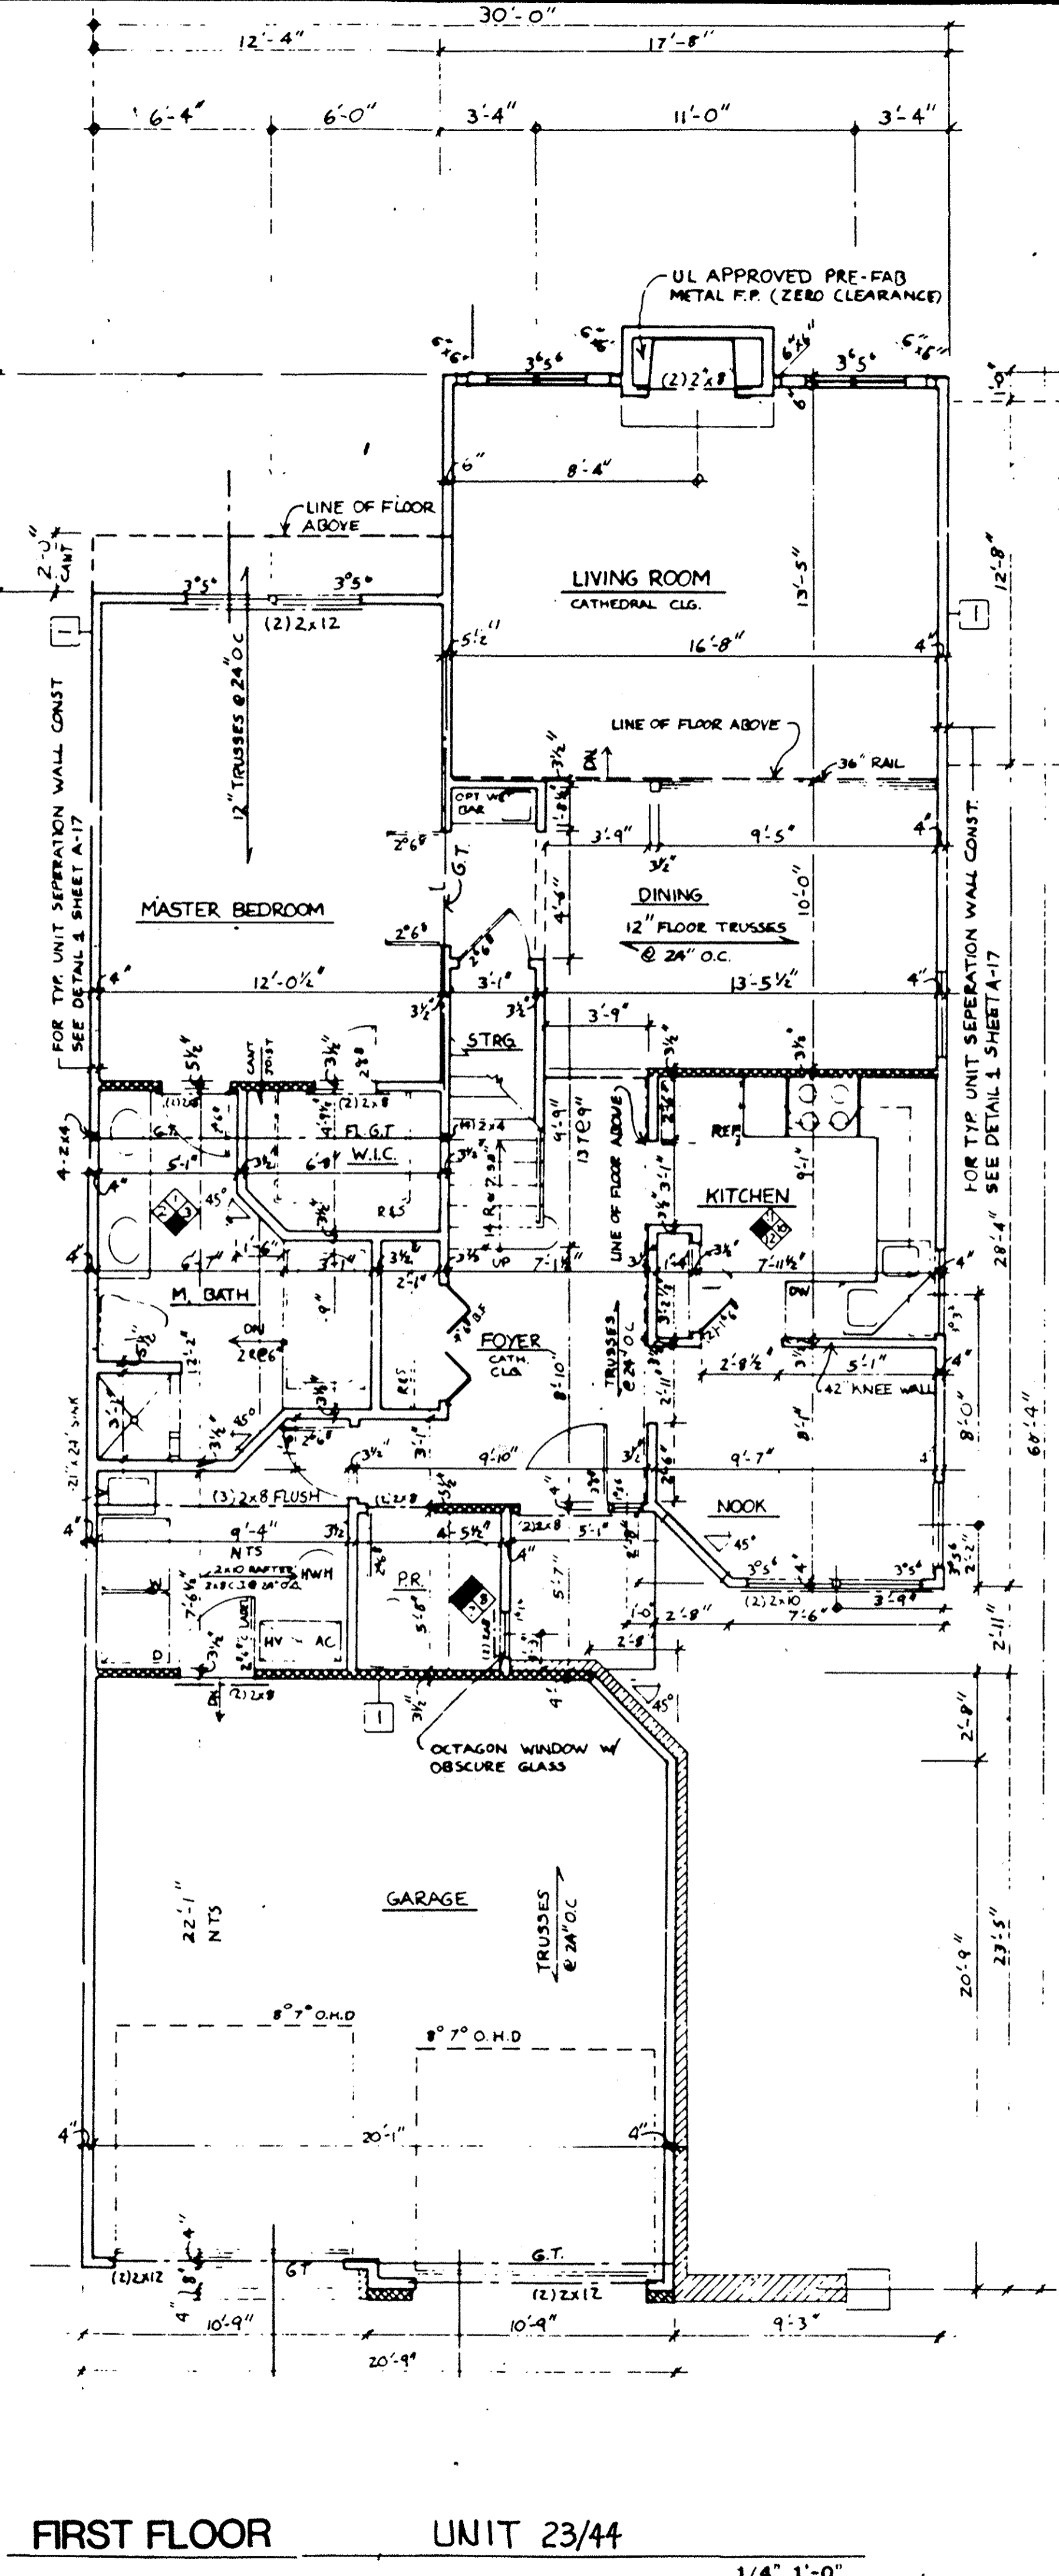

212295

NOTE: BUILDING DIMENSIONS ARE THE SAME AS THOSE ON PHASE 6 - P.V. 40 PP. 37-42.

212295

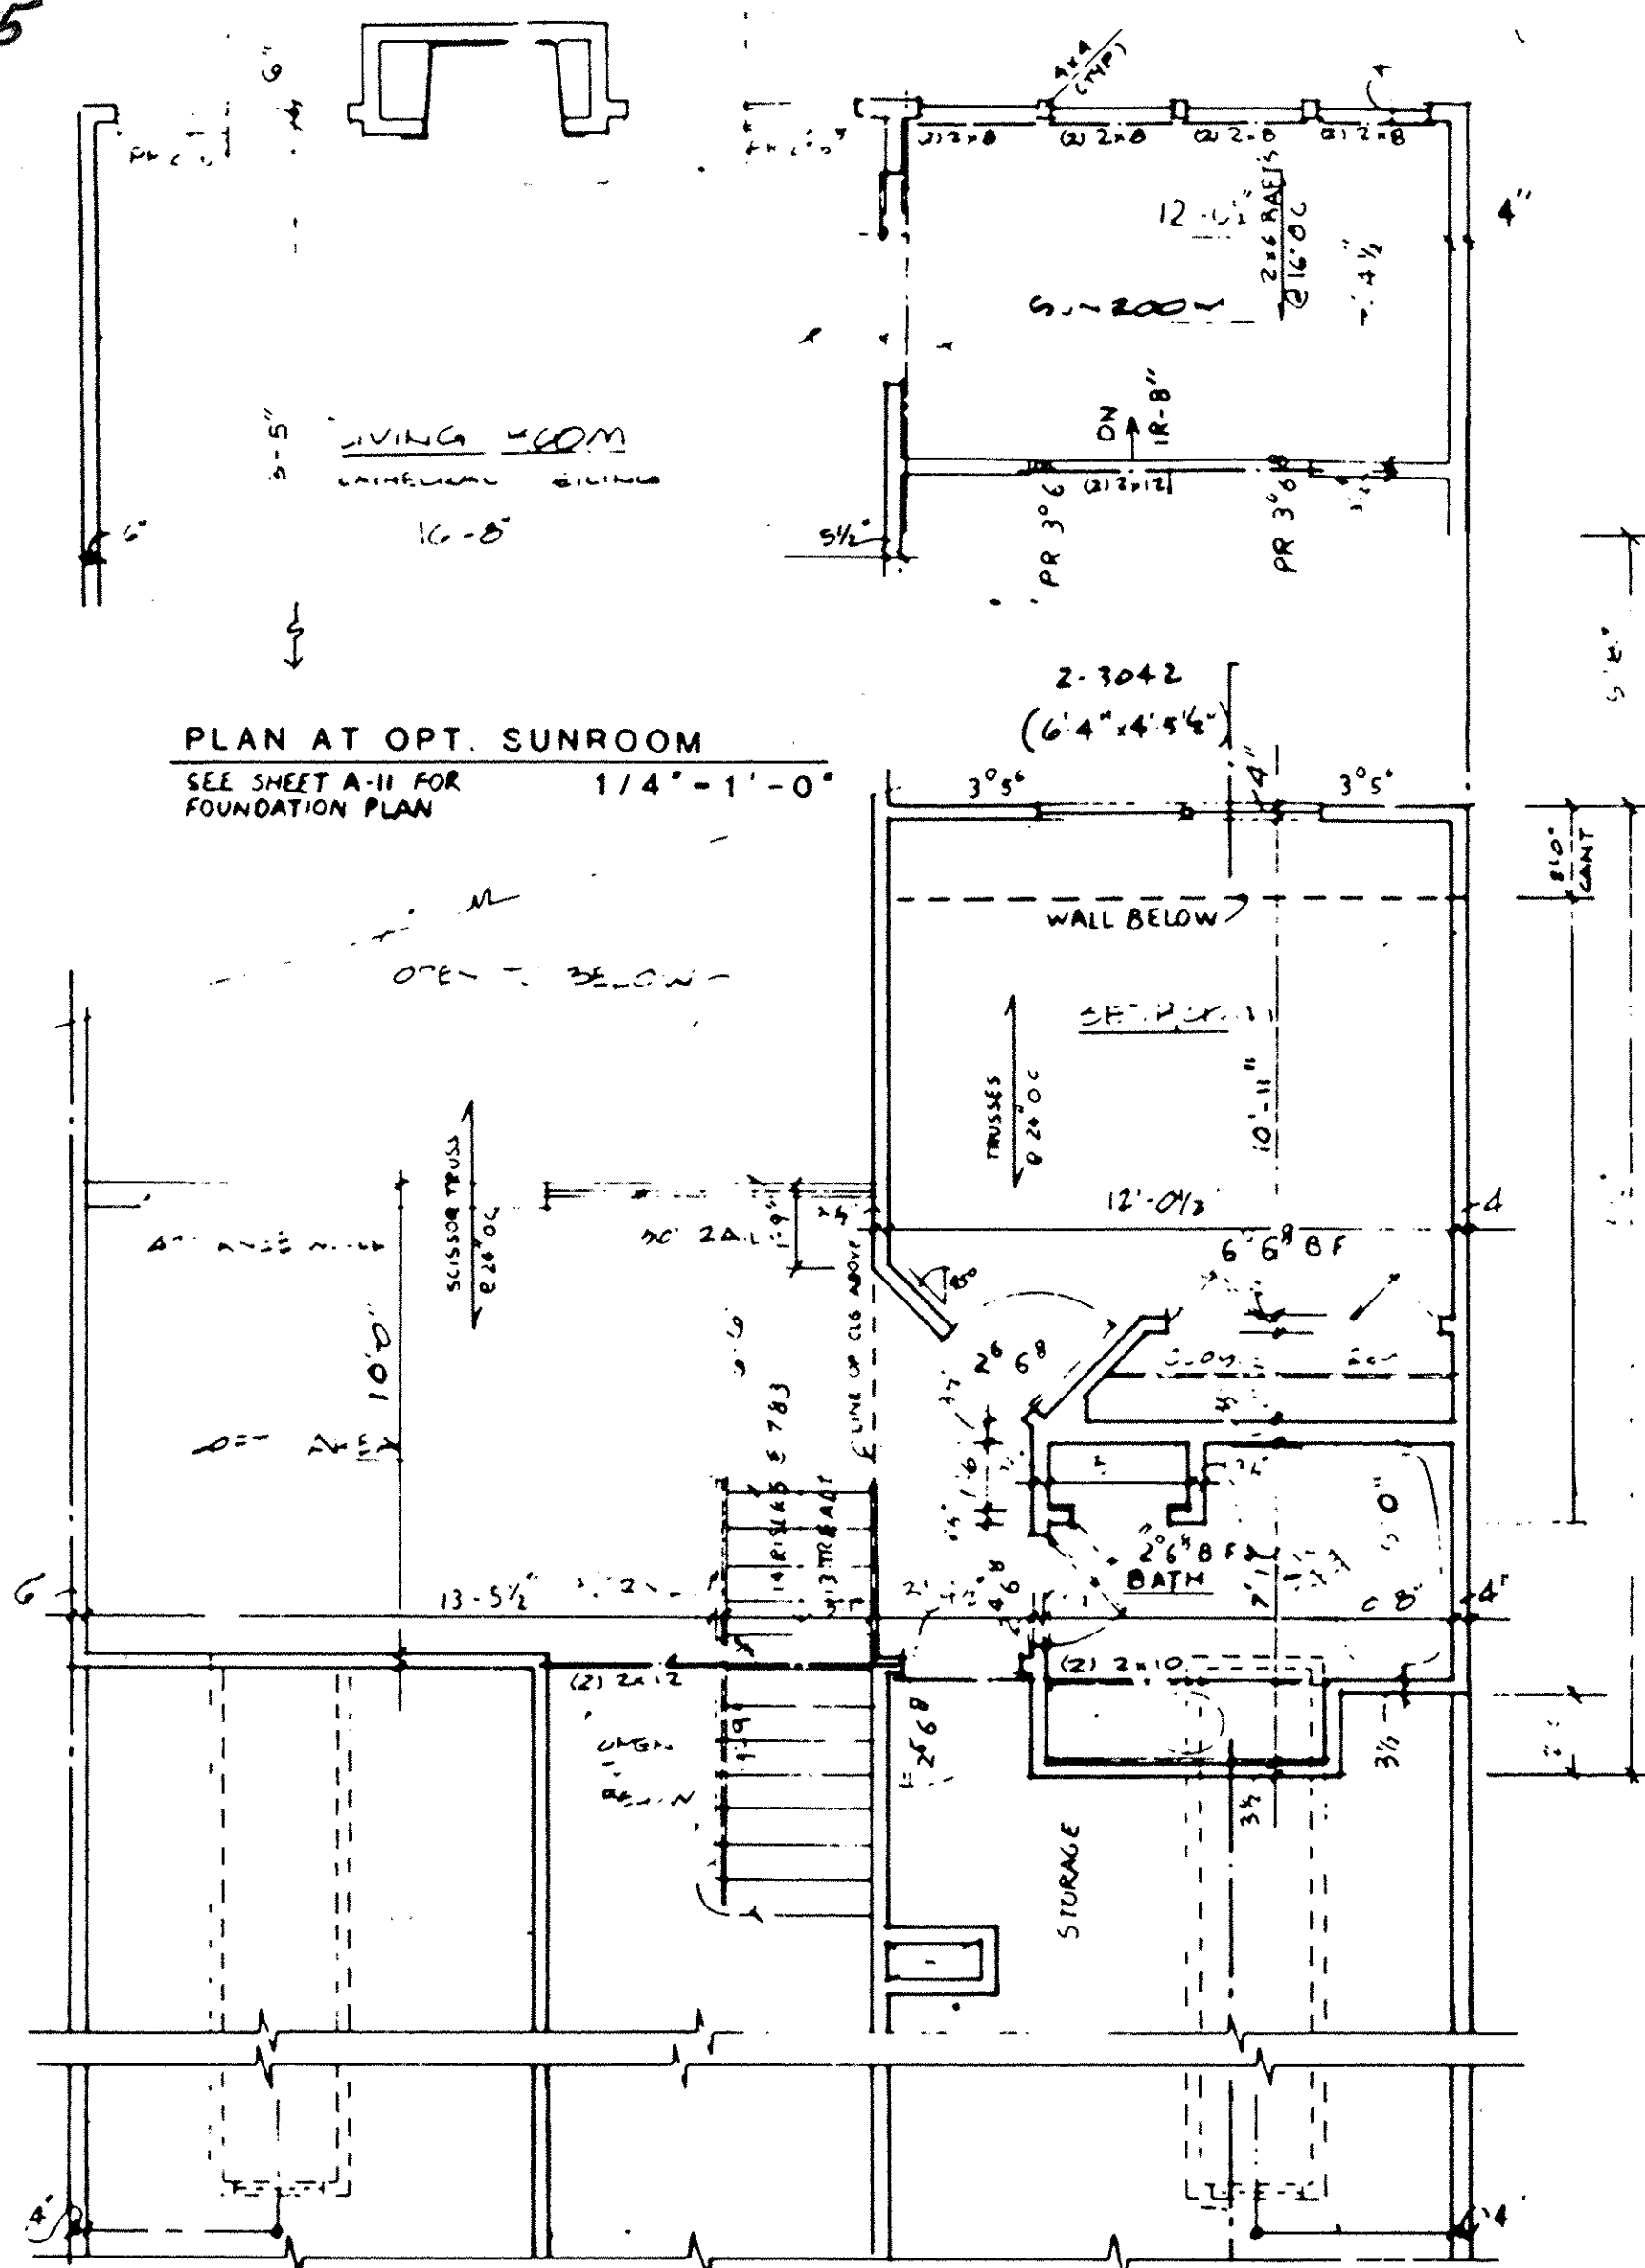


SECOND FLOOR UNIT 22/43
1/4" = 1'-0"

NOTES

- - - - - BEARING WALL
 - - - - - 1 HR FIRERATED WALL
 - - - - - 1 LAYER 5/8" TYPE X DRYWALL EACH SIDE


- NOTES**
- 1 ALL WALLS SHALL BE 3 1/2" UNLESS NOTED OTHERWISE
 - 2 ALL DIMENSIONS ARE TO ROUGH FRAMING
 - 3 REFER TO WALL SECTION SHEET FOR STRUCTURAL INFORMATION

LORAIN COUNTY TAX MAP DEPARTMENT COPY

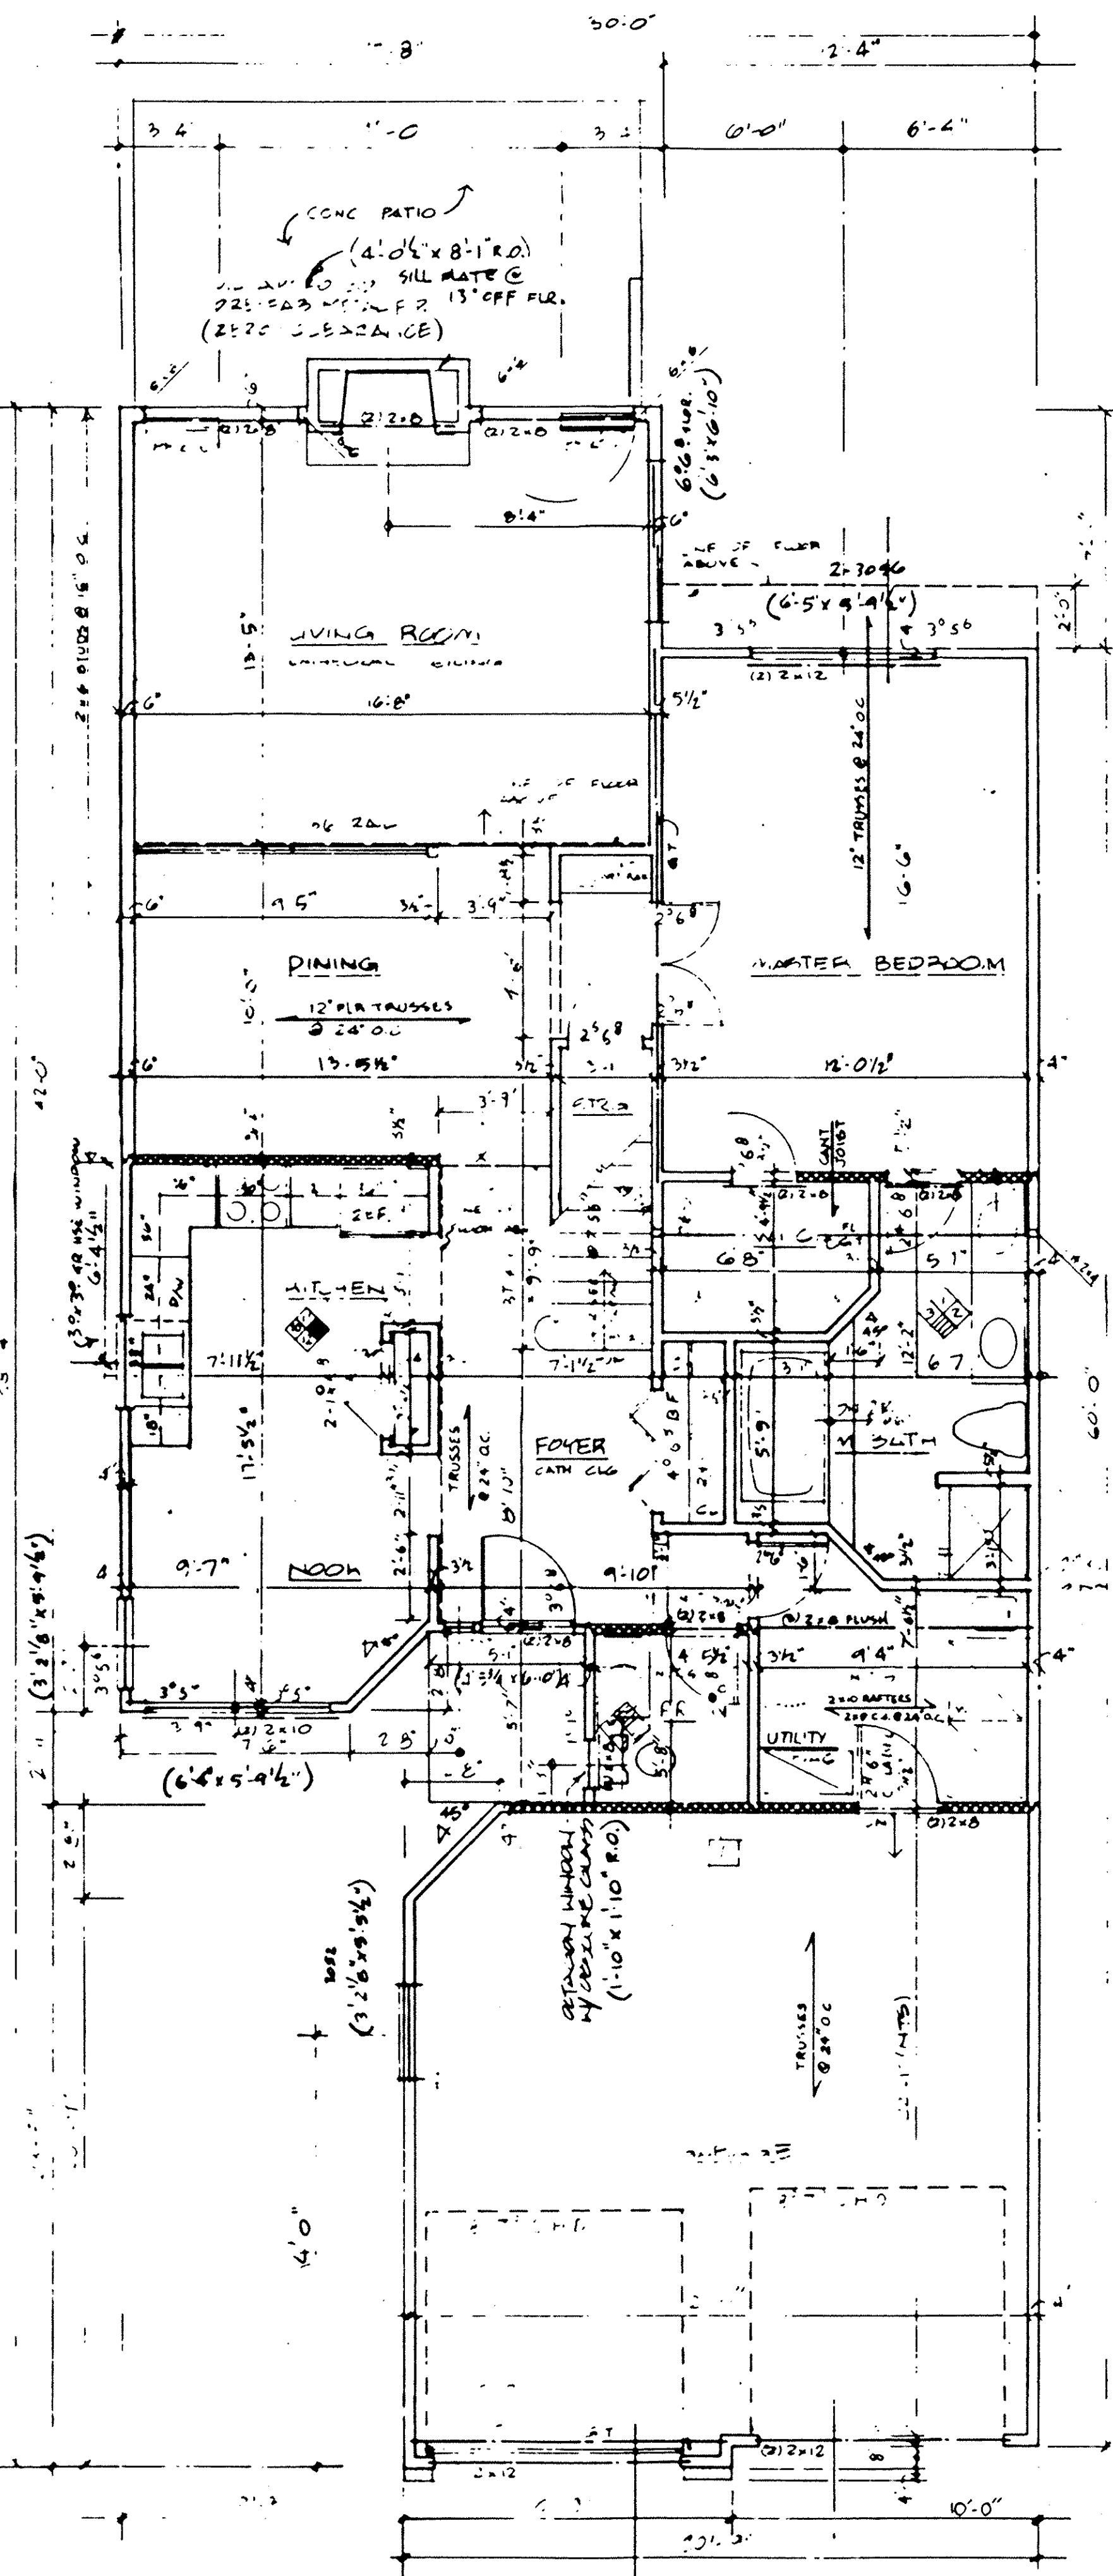

FIRST FLOOR UNIT 22/43
1/4" = 1'-0"



212295

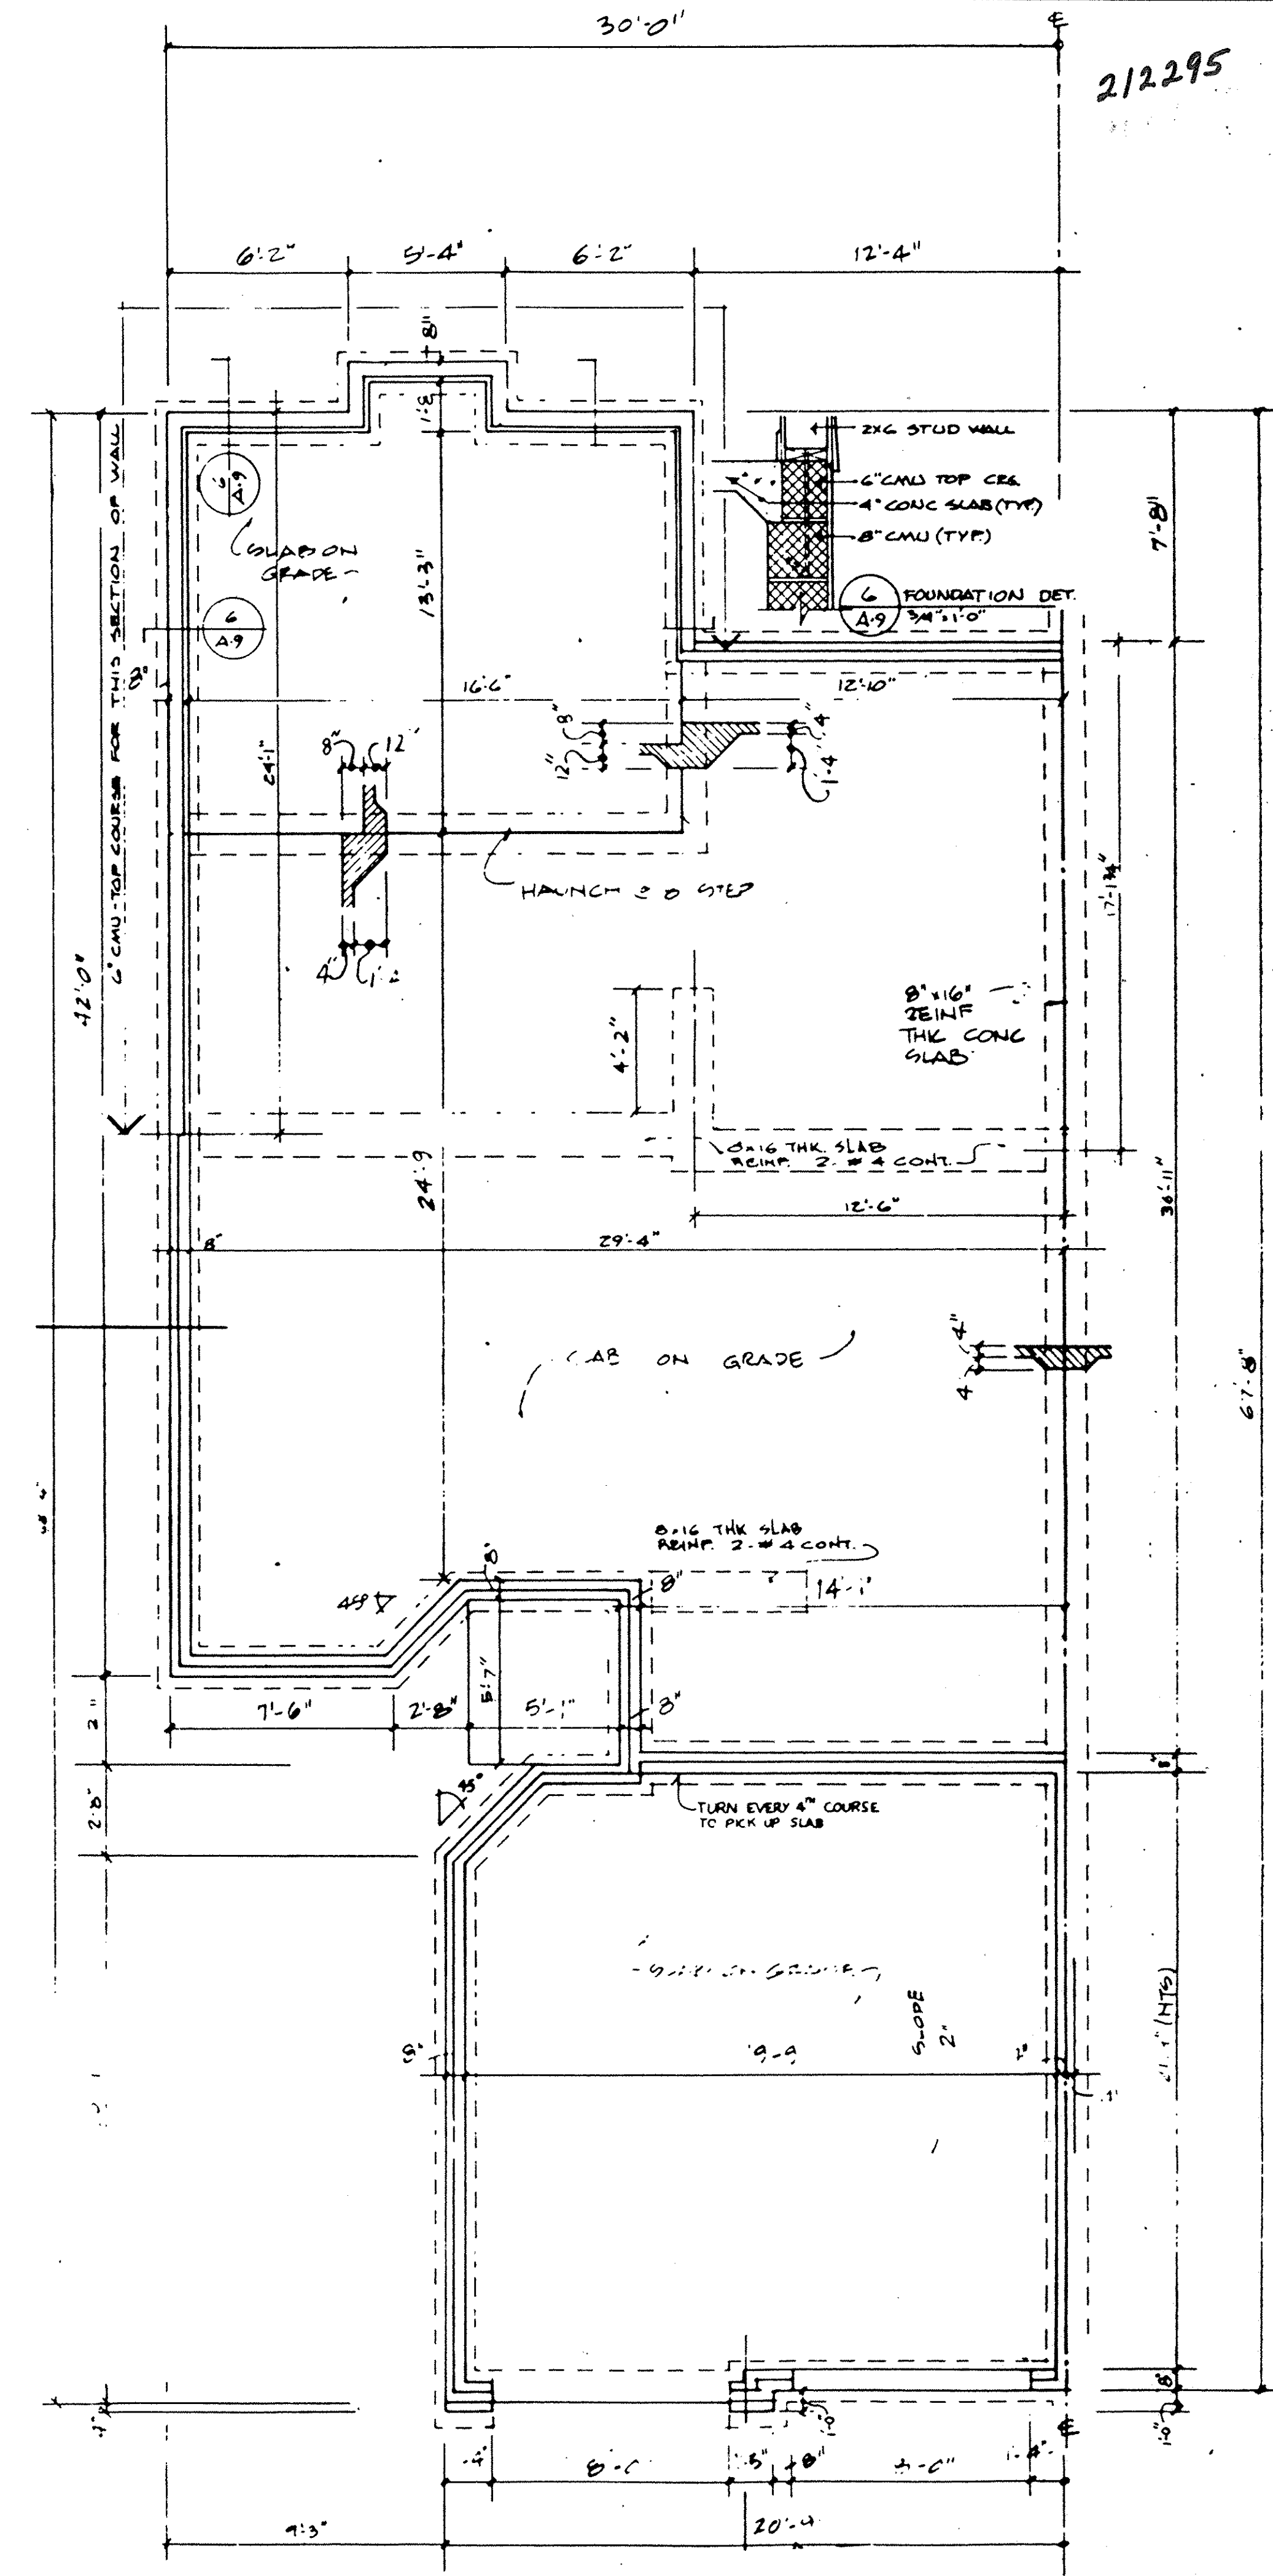

FOUNDATION UNIT 22/43
1/4" = 1'-0"

NOTE: BUILDING DIMENSIONS ARE THE SAME AS THOSE ON PHASE 6-PV-40 PP. 37-42.

C-4/6 41/10

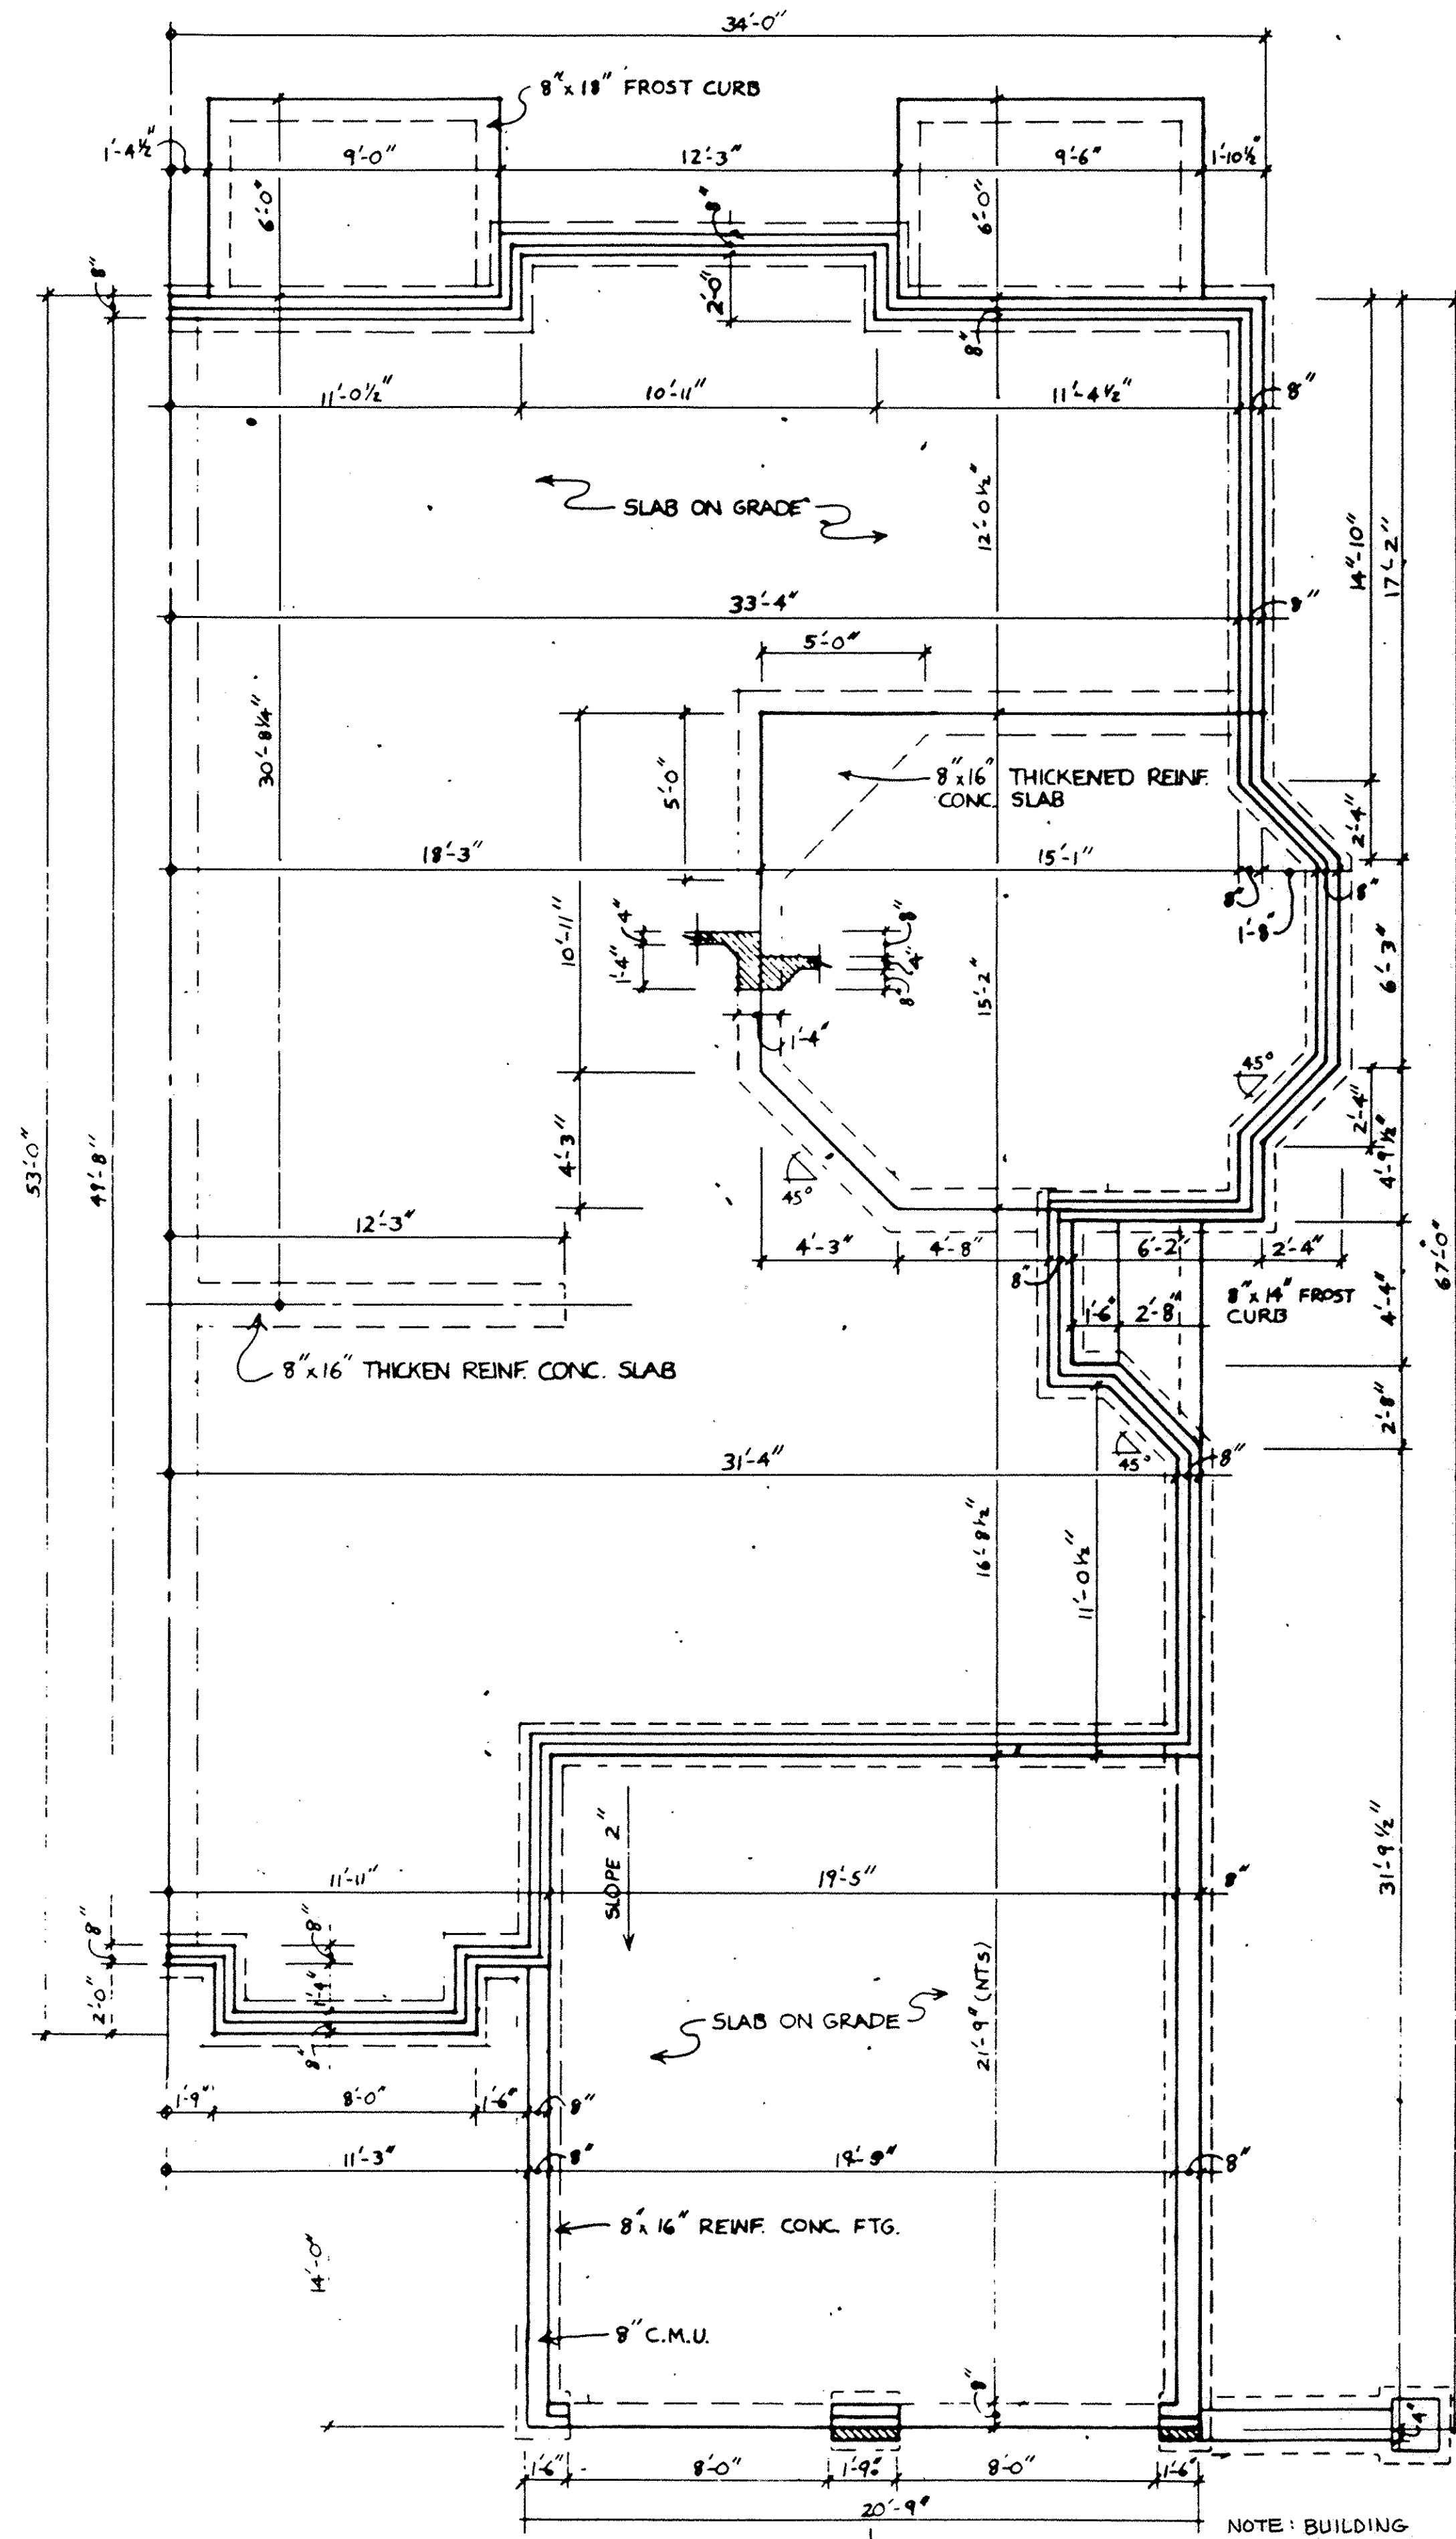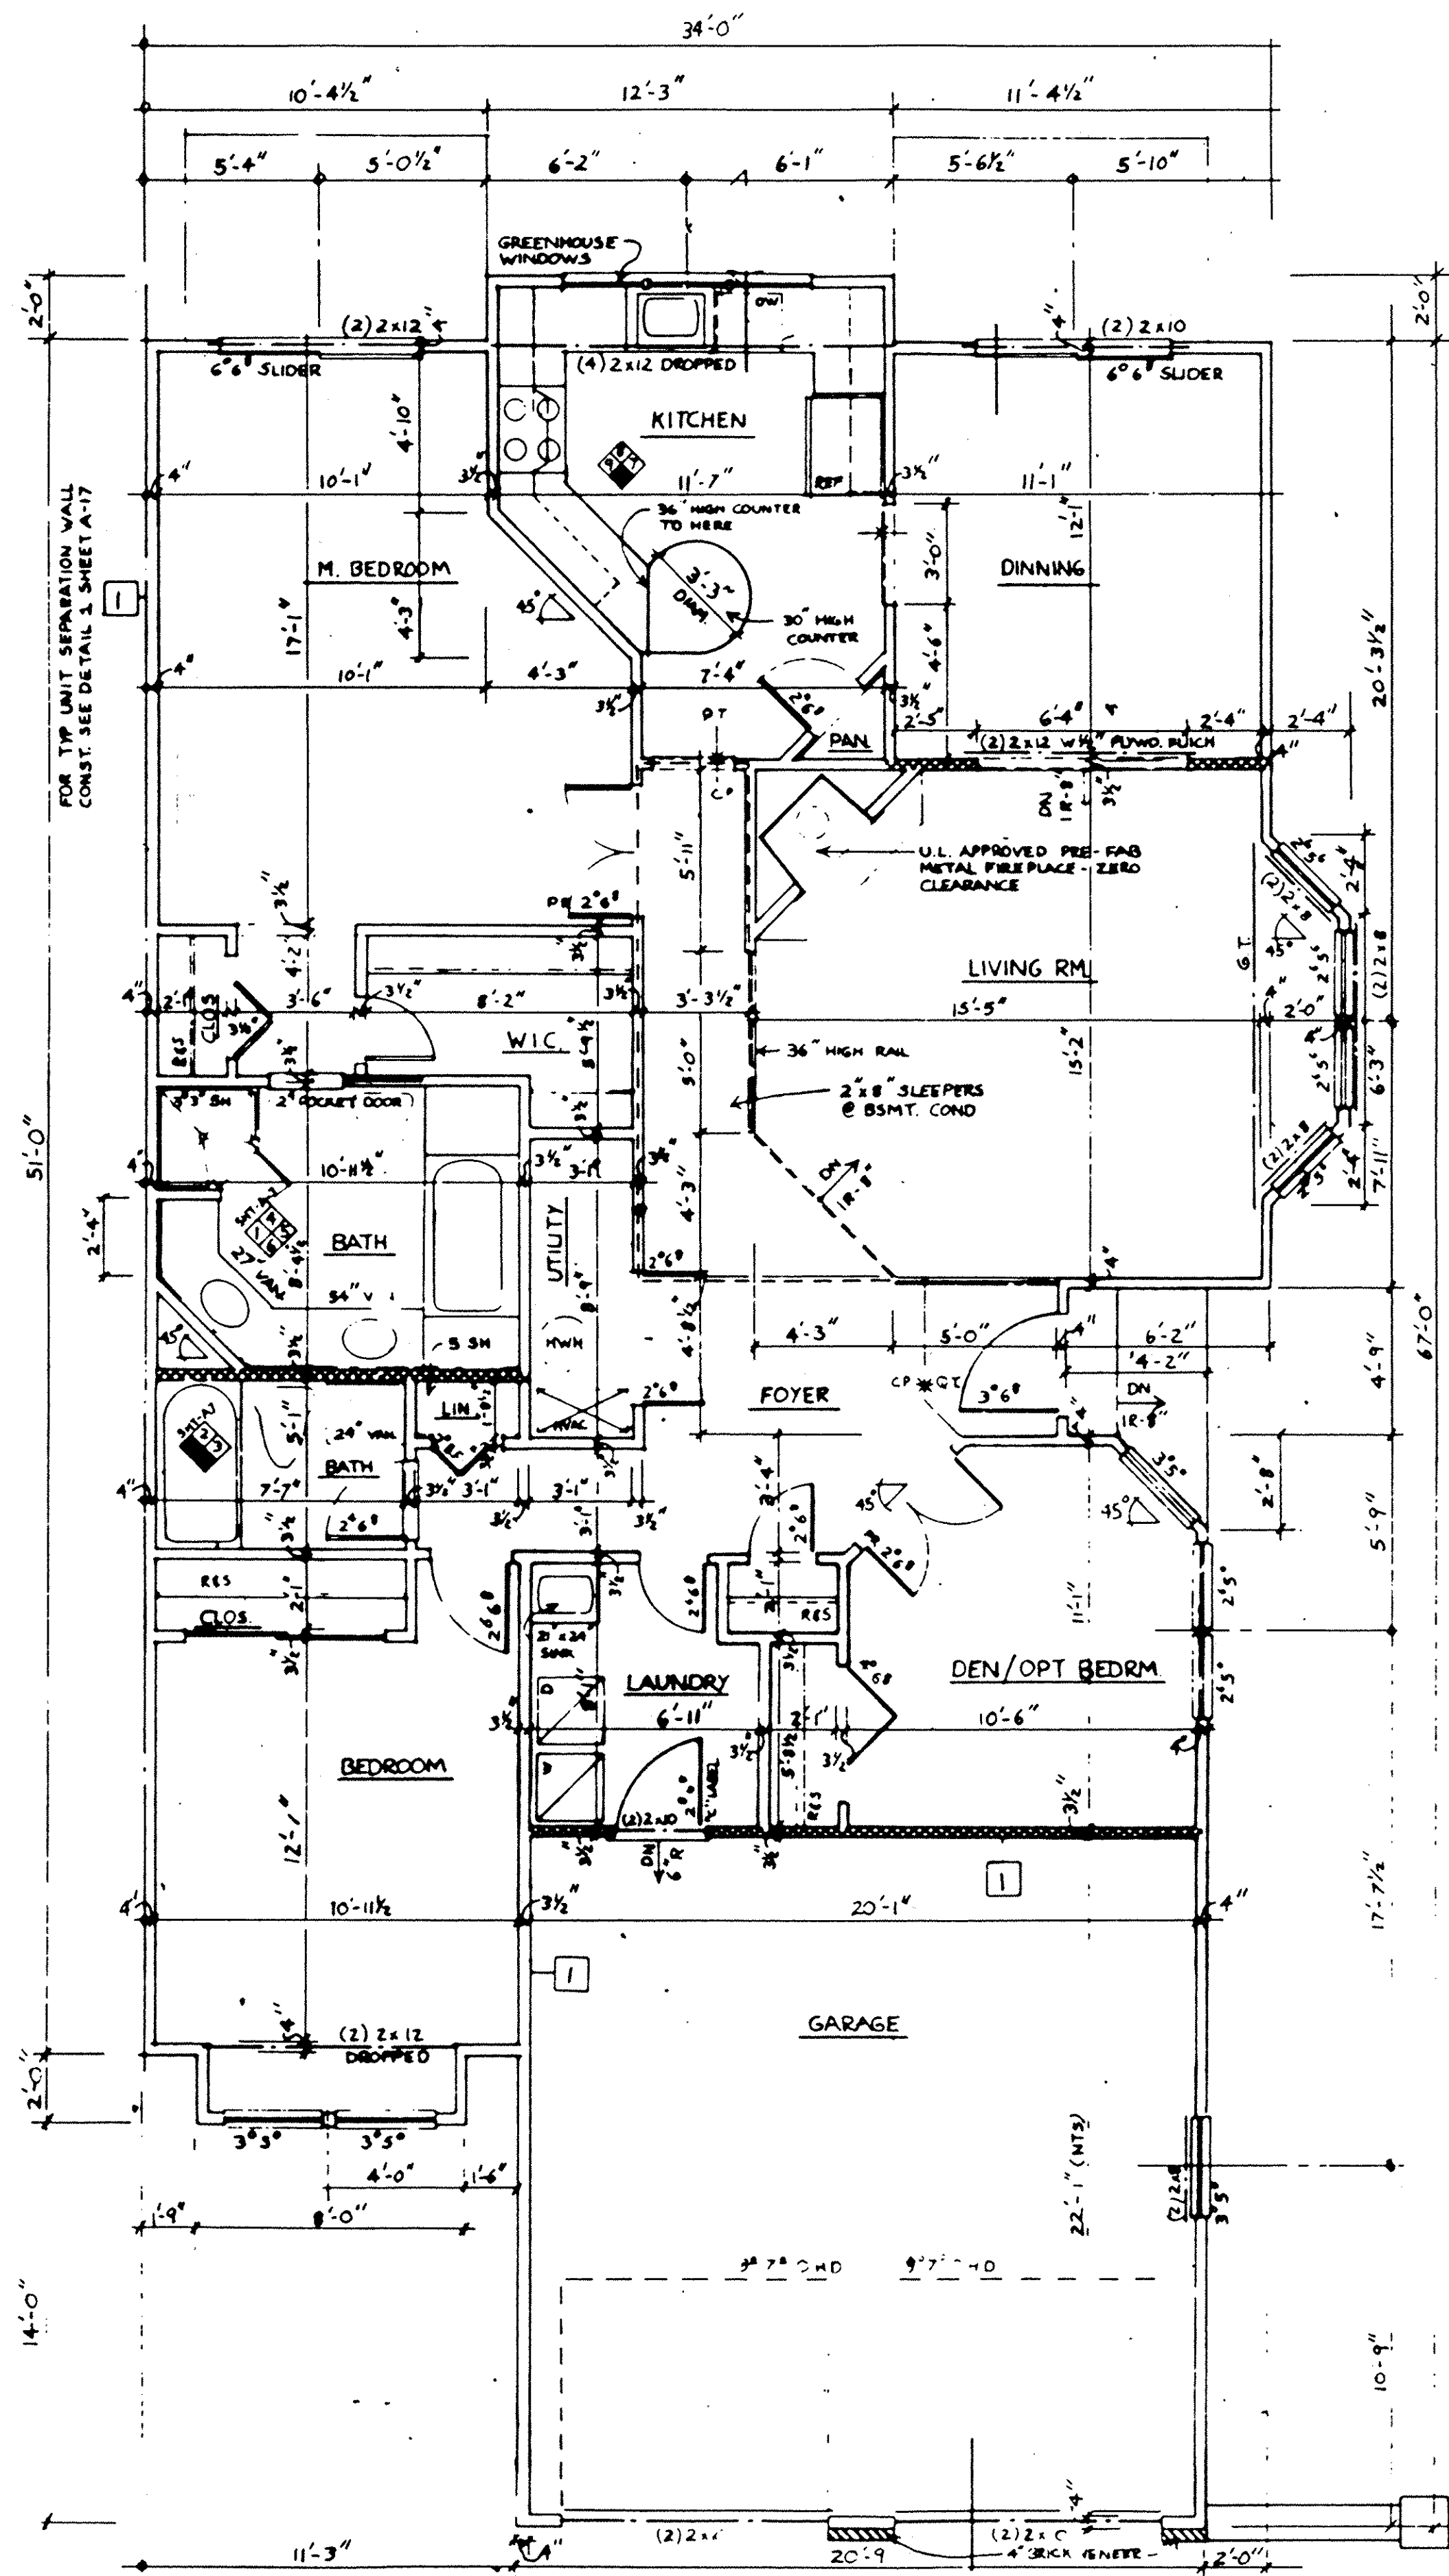

NOTES

- 1. ALL WALLS SHALL BE 31/2" UNLESS NOTED OTHERWISE.
- 2. ALL DIMENSIONS ARE TO ROUGH FRAMING.
- 3. REFER TO WALL SECTION SHEET FOR STRUCTURAL INFORMATION.

KEY

	BEARING WALL W/ 1 HR. FIRE RATING
	1 HOUR FIRE RATED WALL
	1 LAYER 5/8" TYPE 'X' DRYWALL EACH SIDE

FIRST FLOOR UNIT 21/42
LORAIN COUNTY TAX MAP DEPARTMENT COPY

UNIT 21/42

1/4" = 1'-0"


FOUNDATION

UNIT 21/42


1/4" = 1'-0"

NOTE: BUILDING DIMENSIONS ARE THE SAME AS THOSE ON PHASE 6 - PV.40 PP.37-42.


4/11 C-5/6

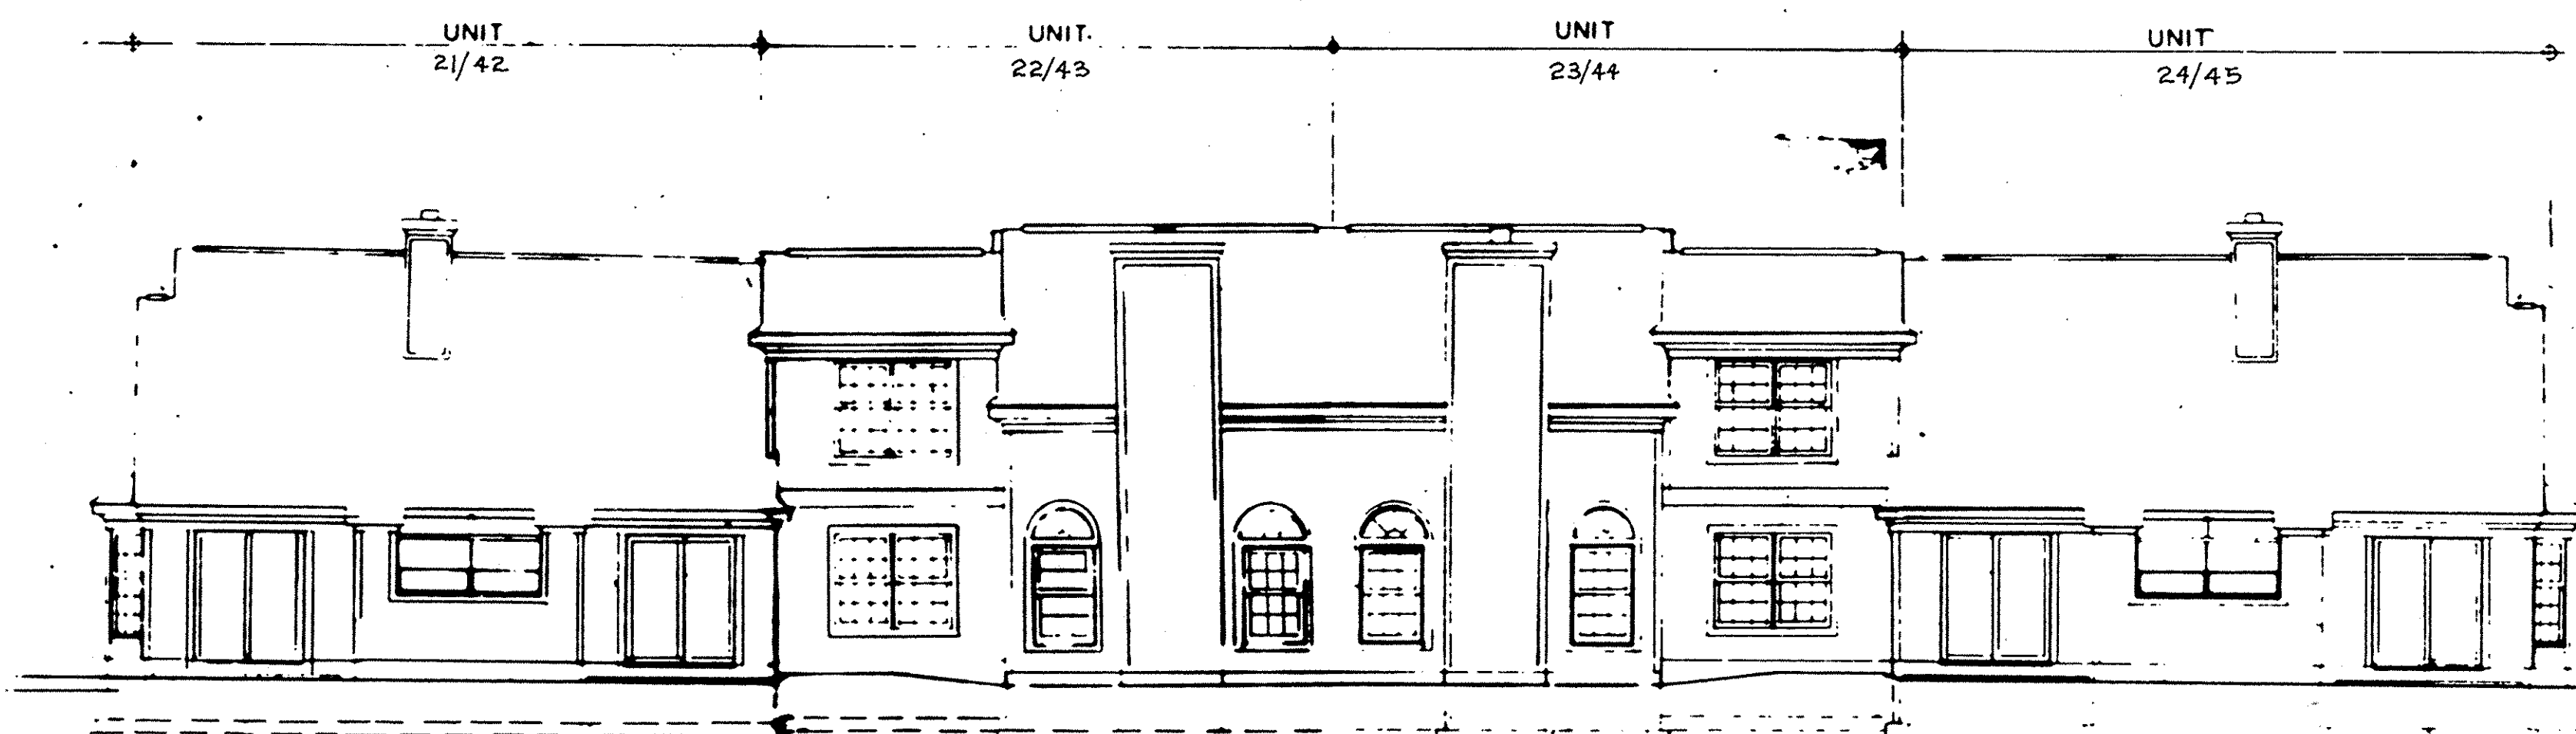


REAR

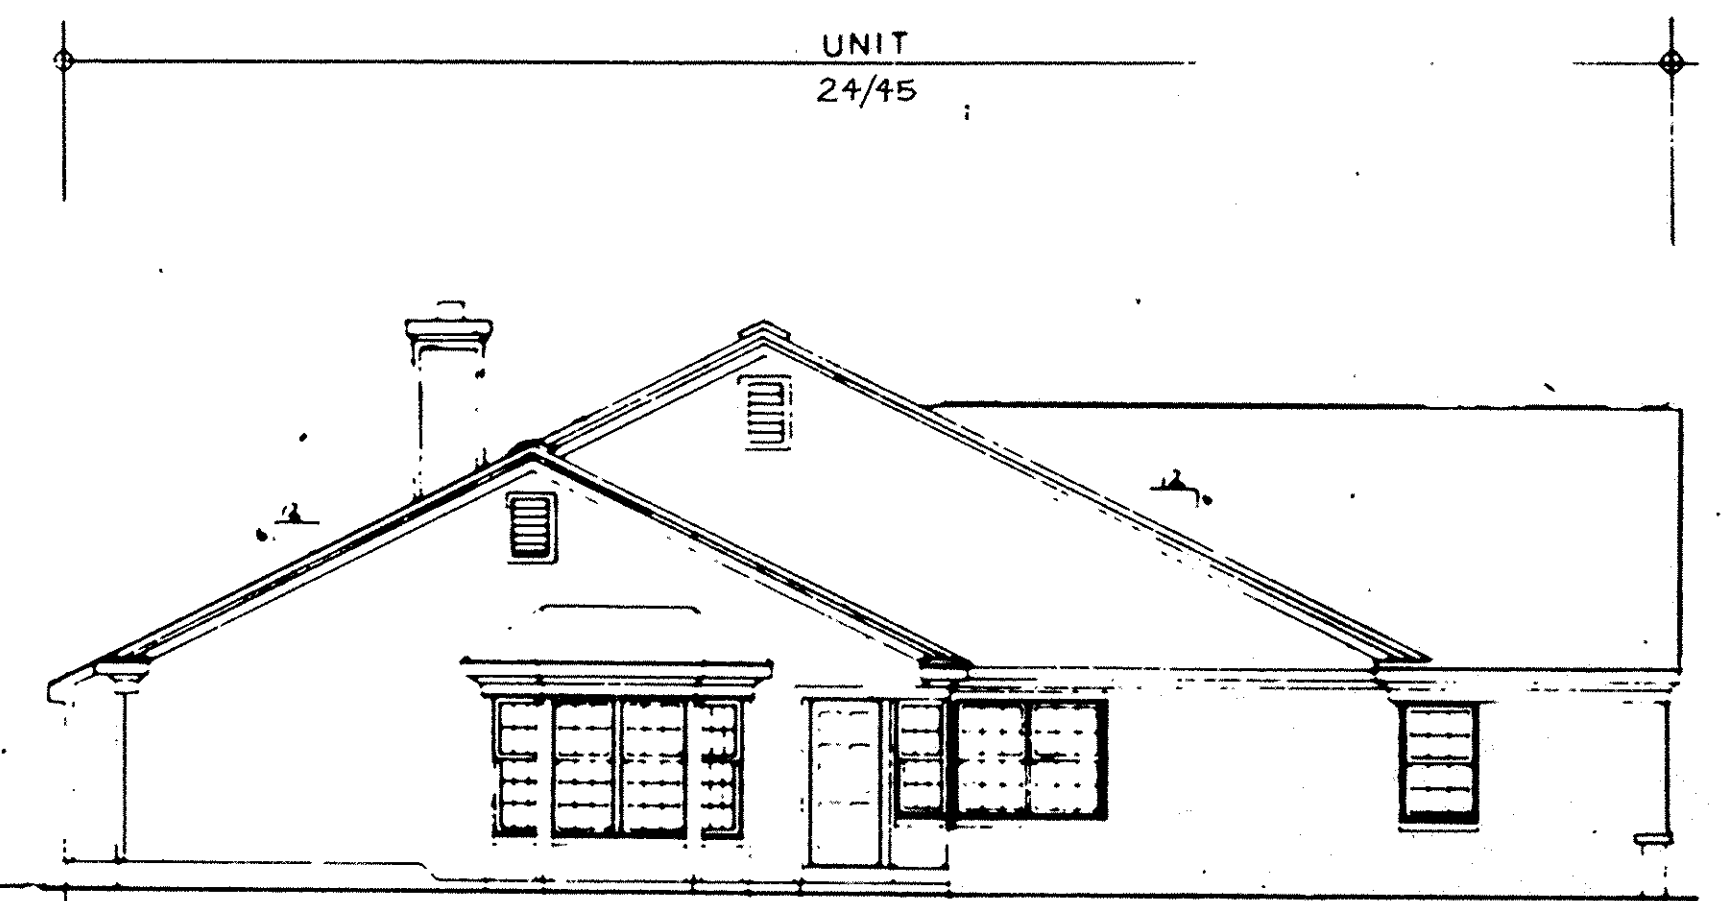

LEFT SIDE

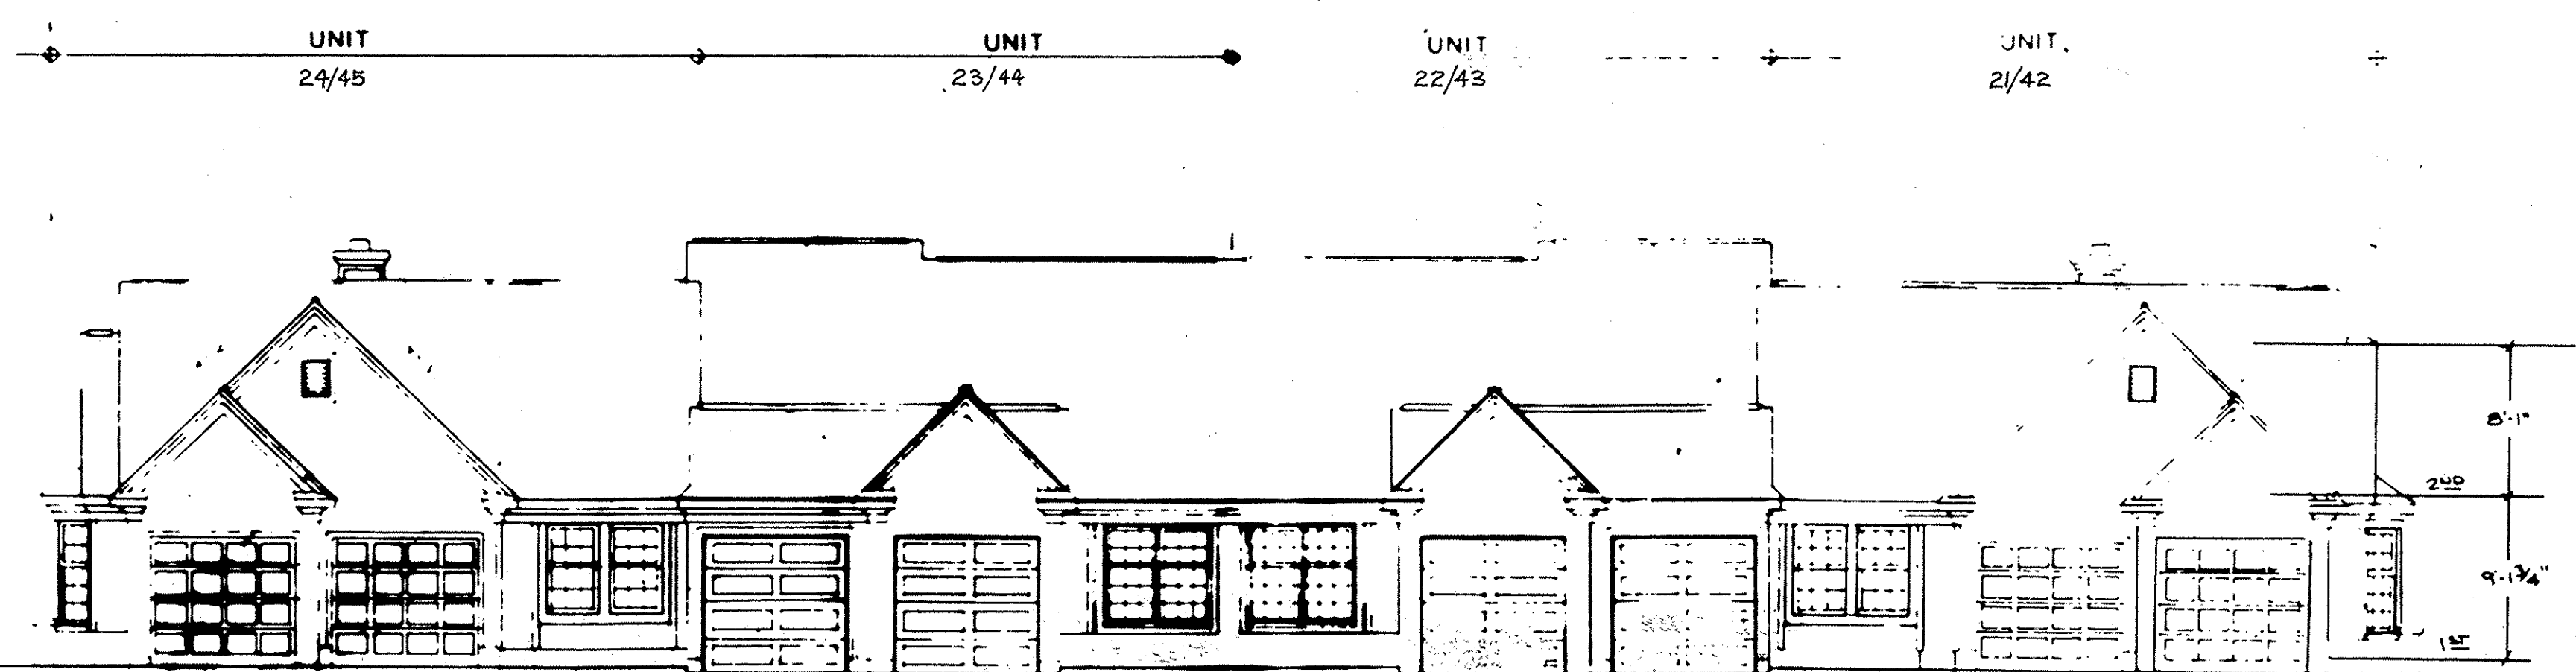

FRONT

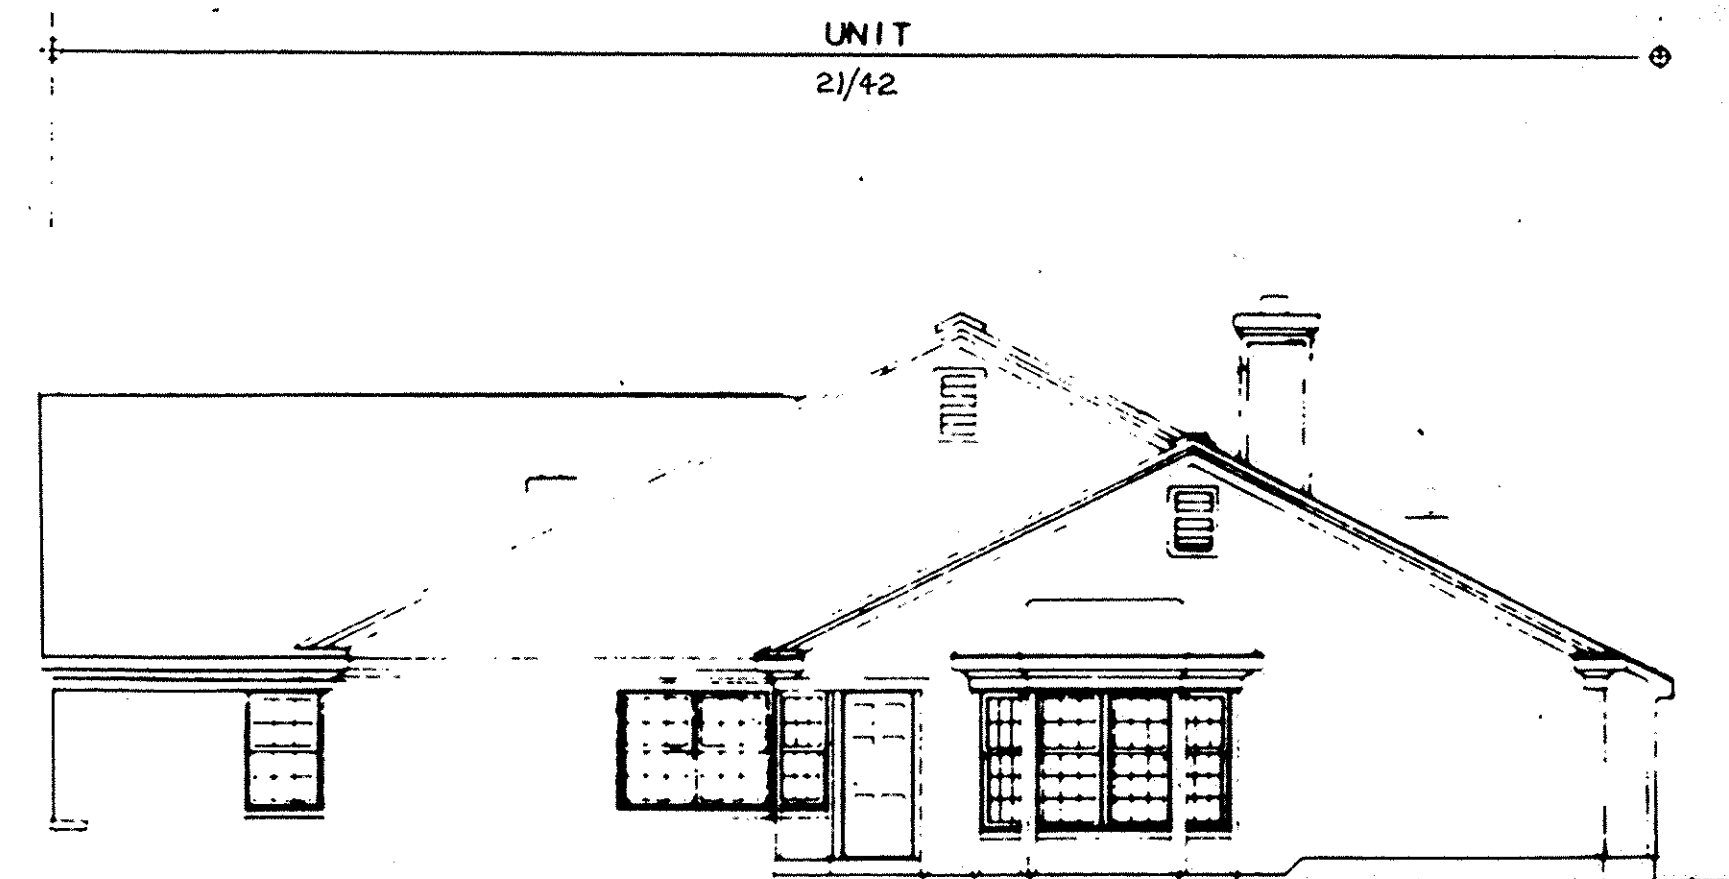

RIGHT SIDE

NOTE: BUILDING DIMENSIONS
ARE THE SAME AS
THOSE ON PHASE B -
PV. 40 PR. 37-42.