







NOTE:  
1. DIMENSIONS SHOWN IN DECIMALS  
INDICATE AS BUILT DIMENSIONS.  
FINISHED WALL TO FINISHED WALL

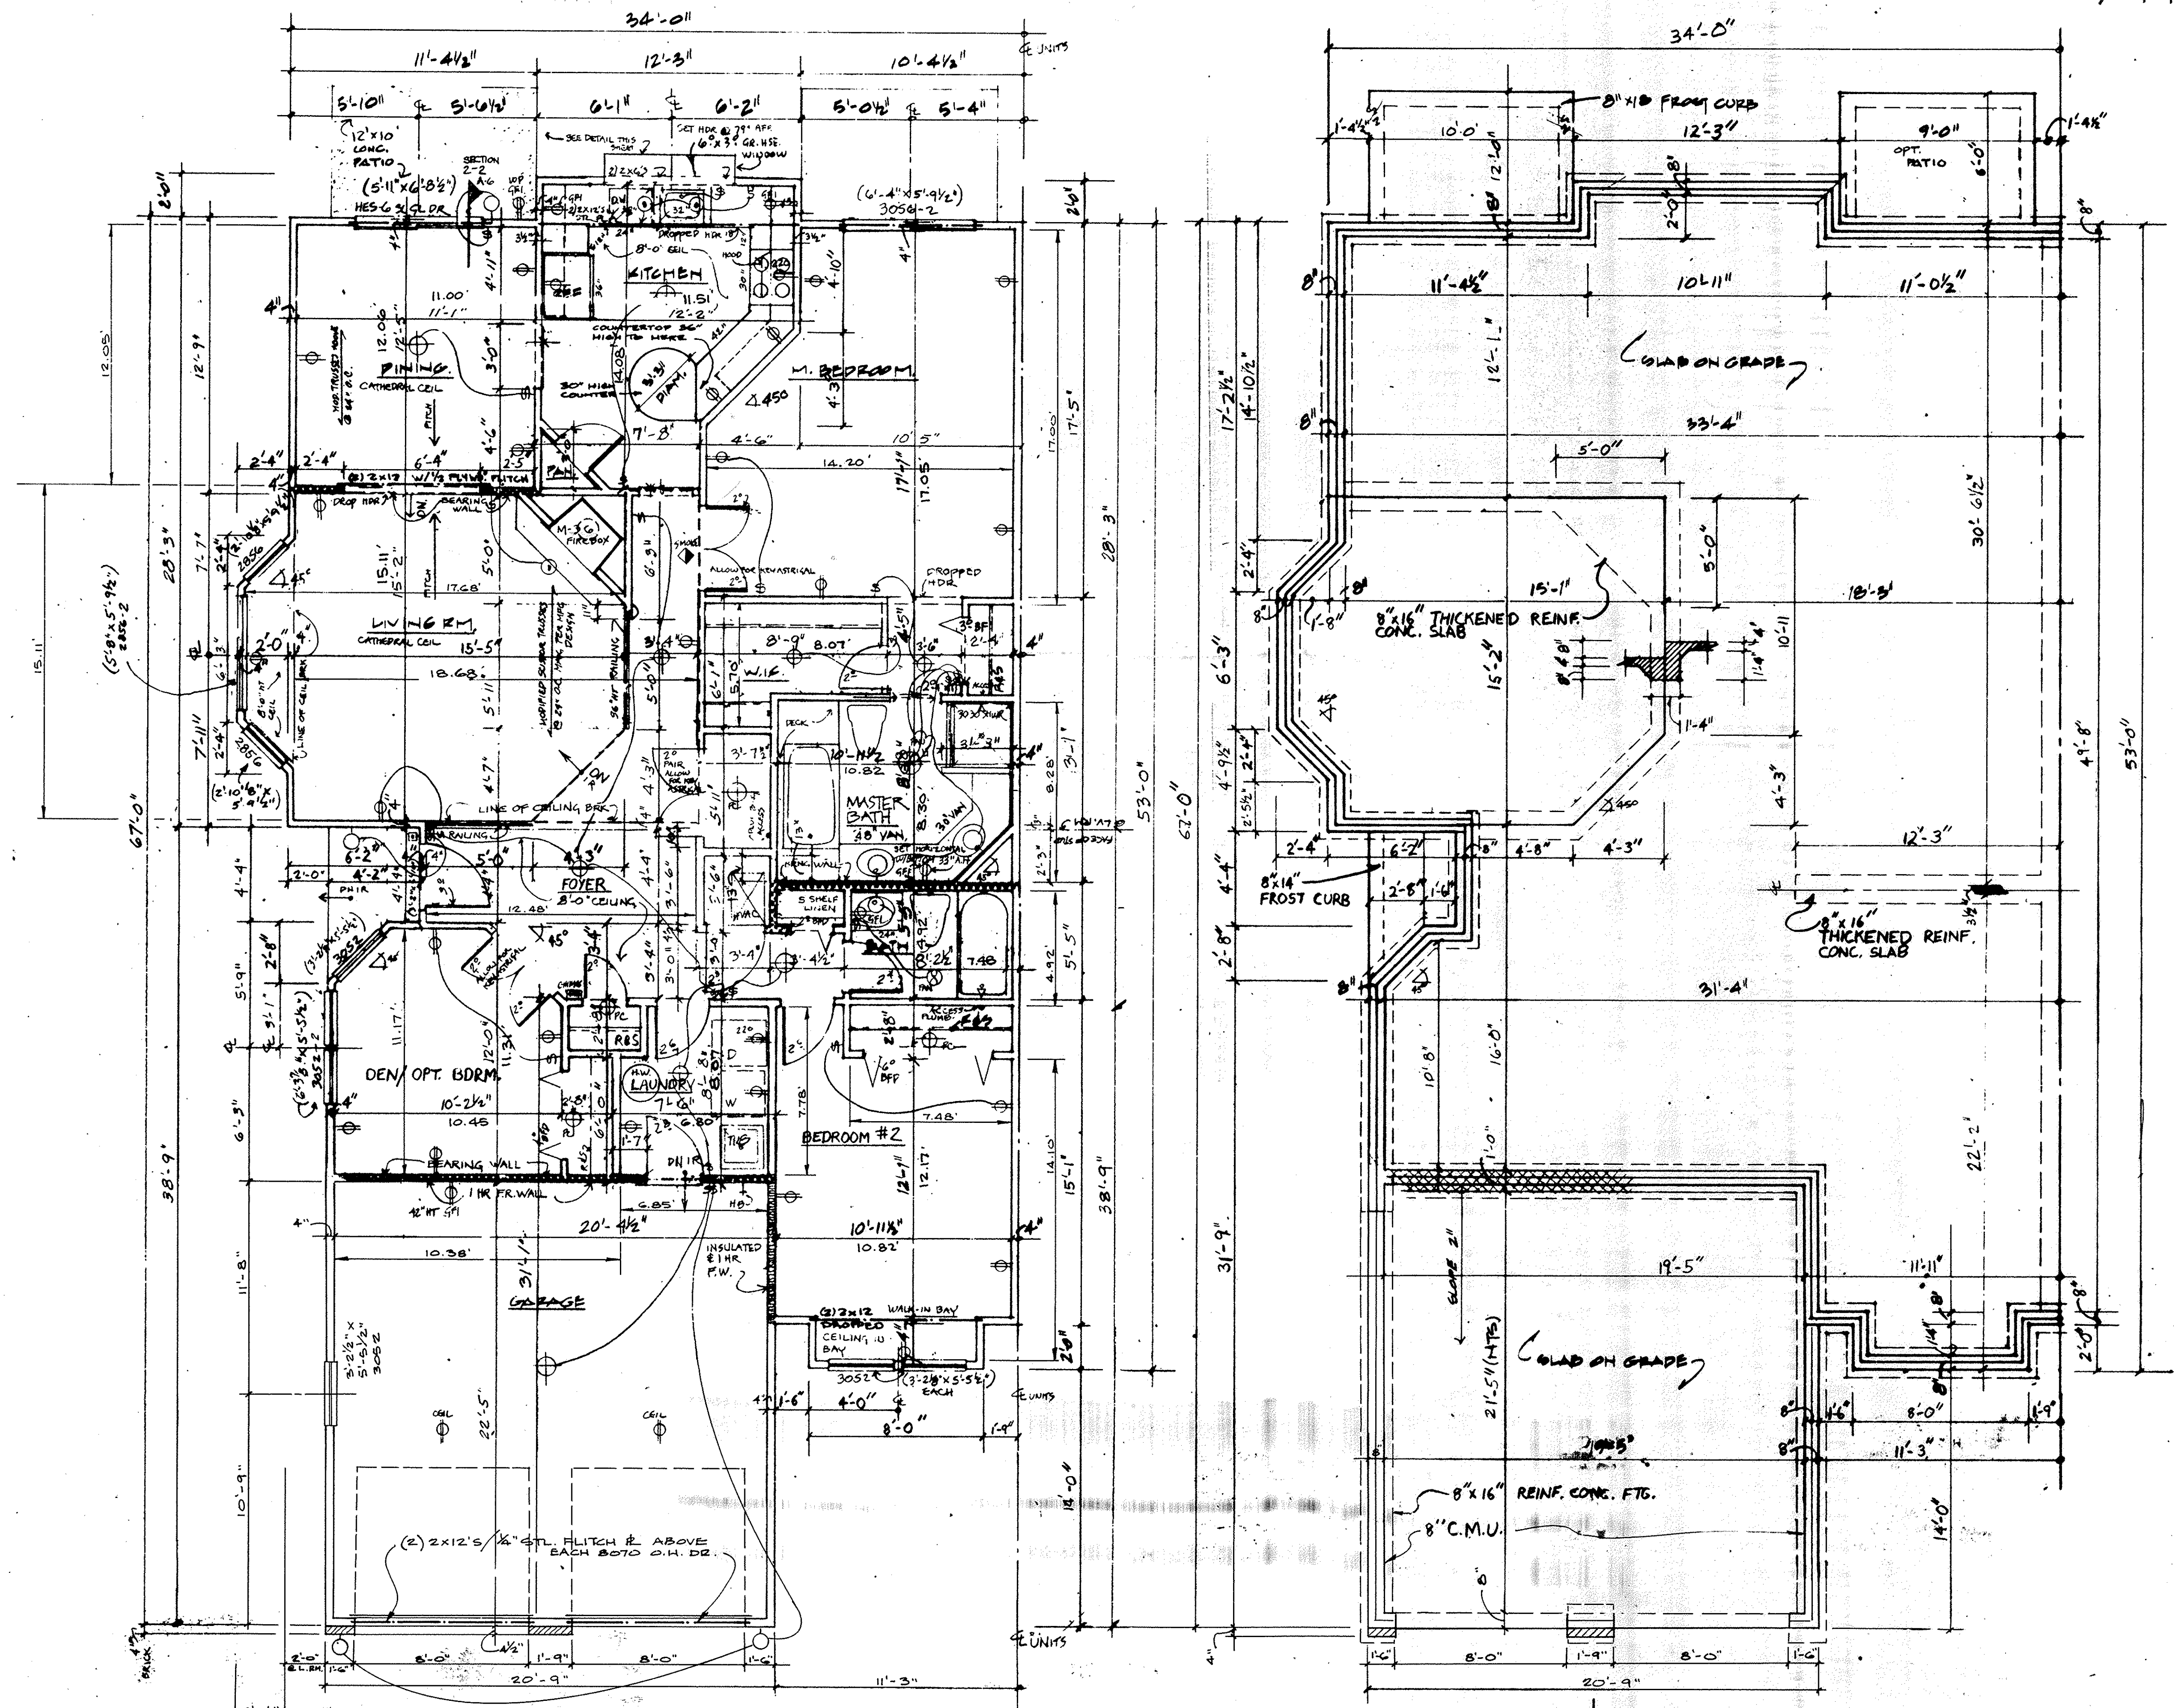

FIRST FLOOR


FOUNDATION - B GARAGE LEFT

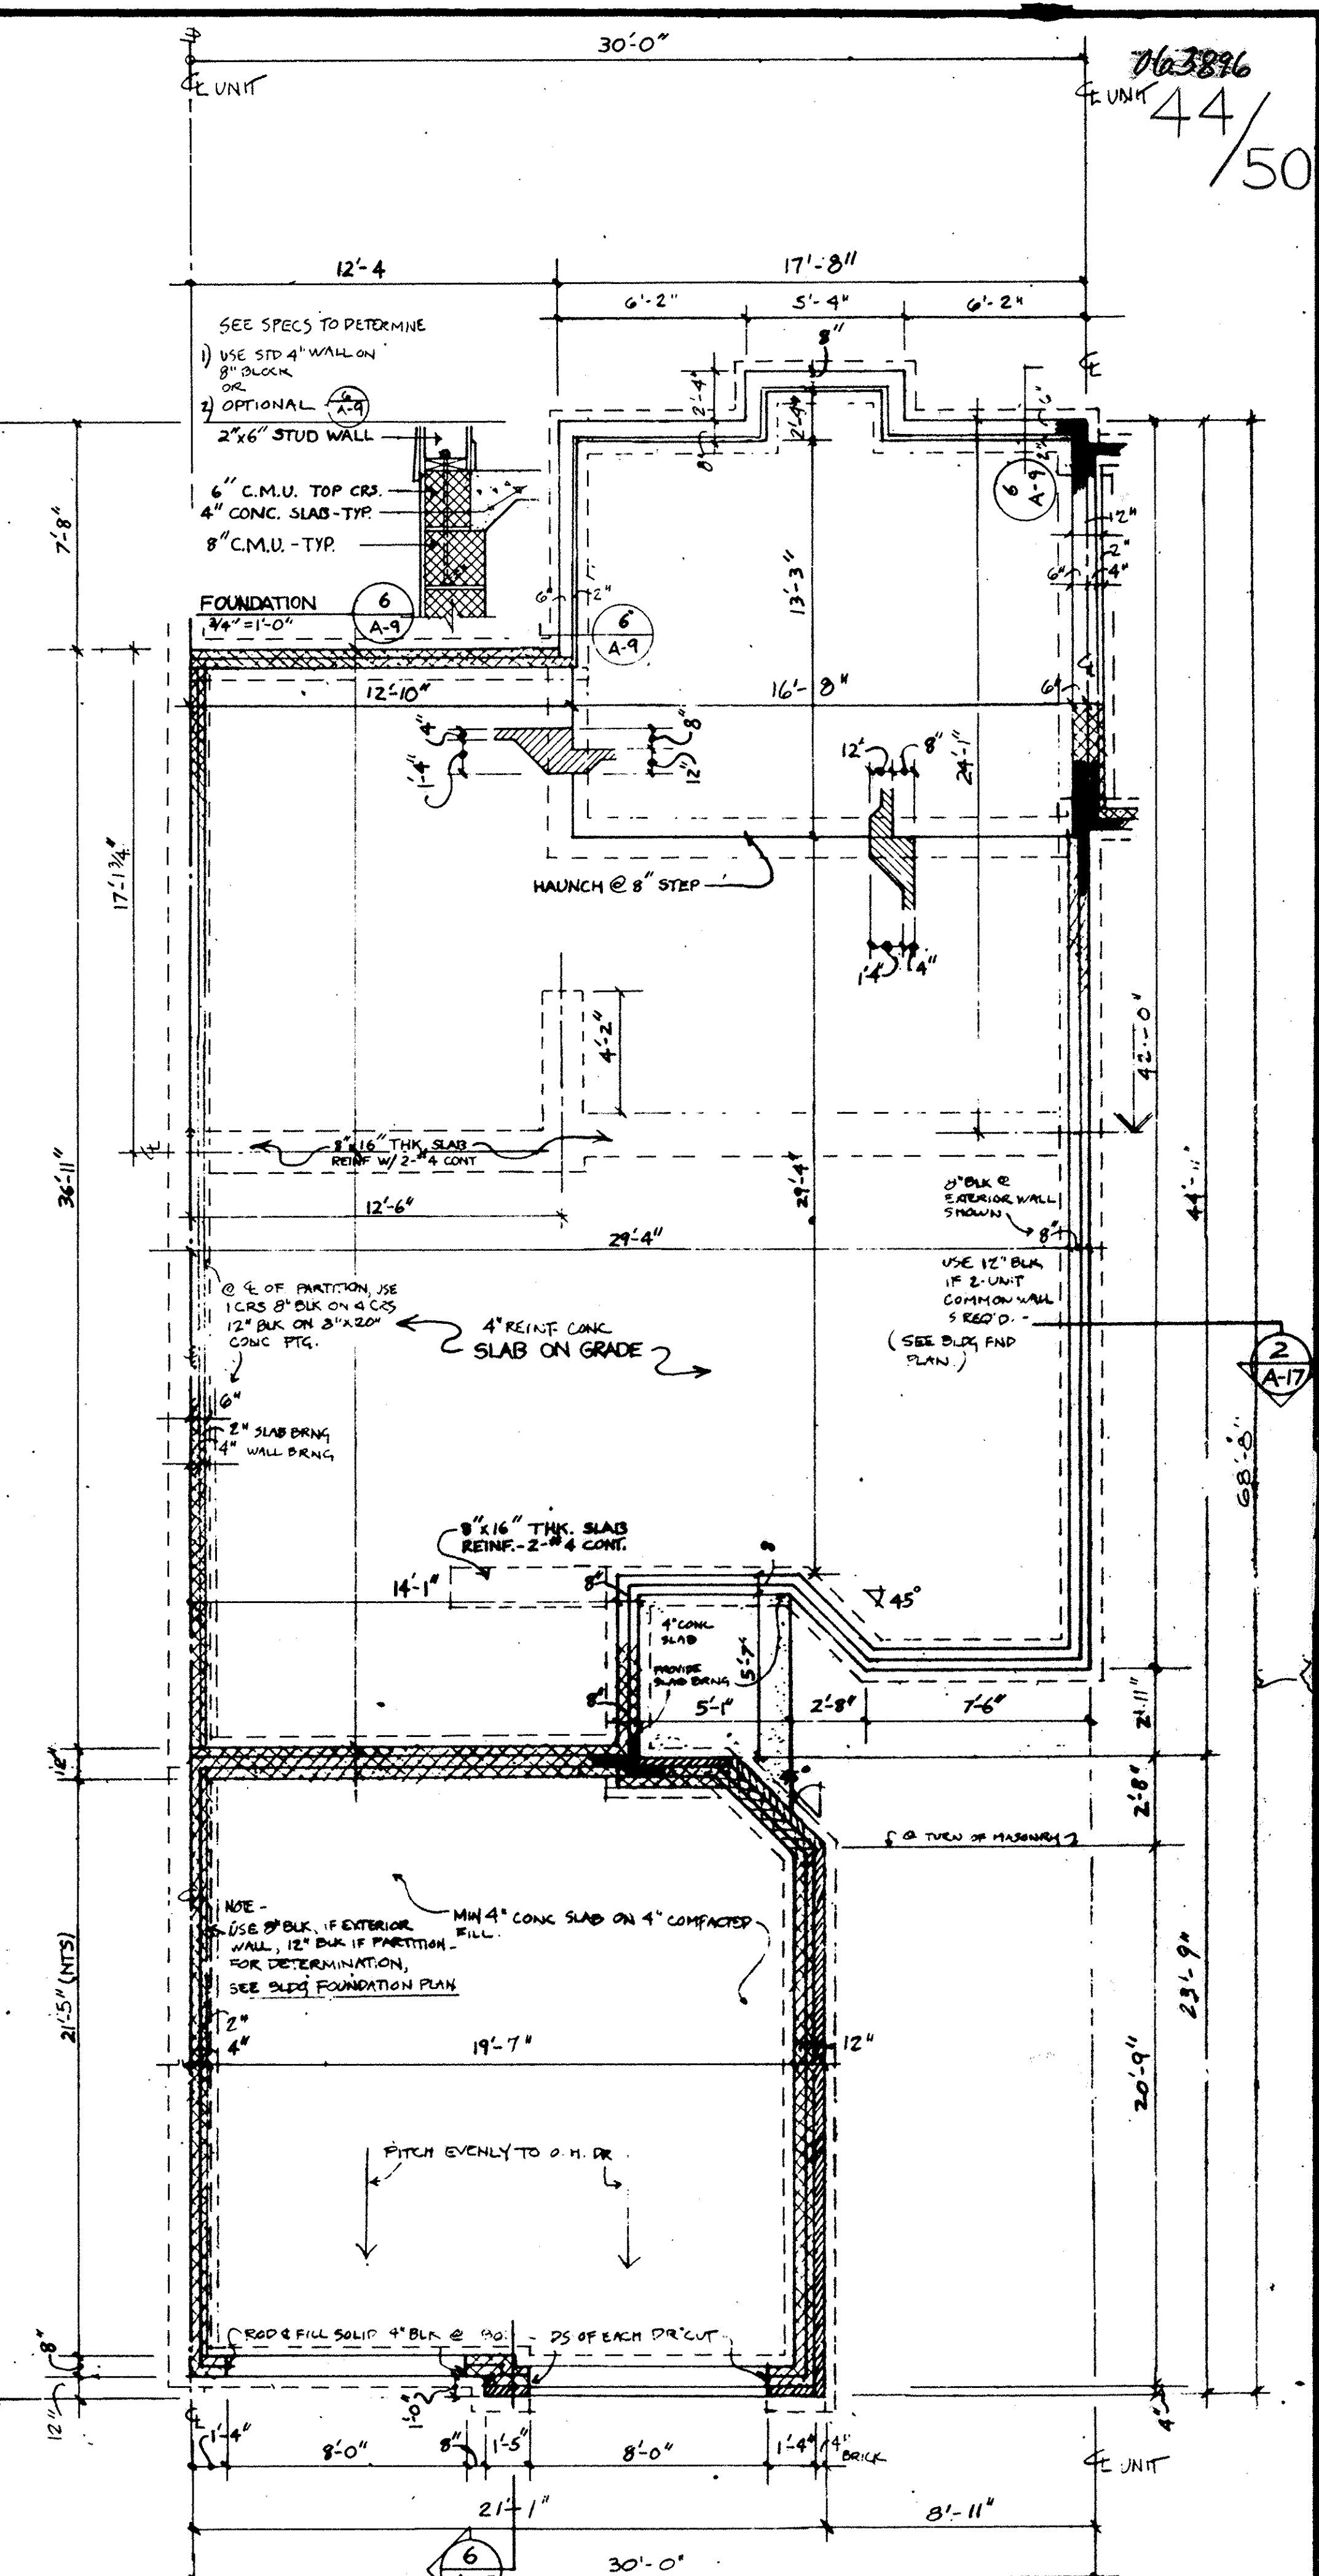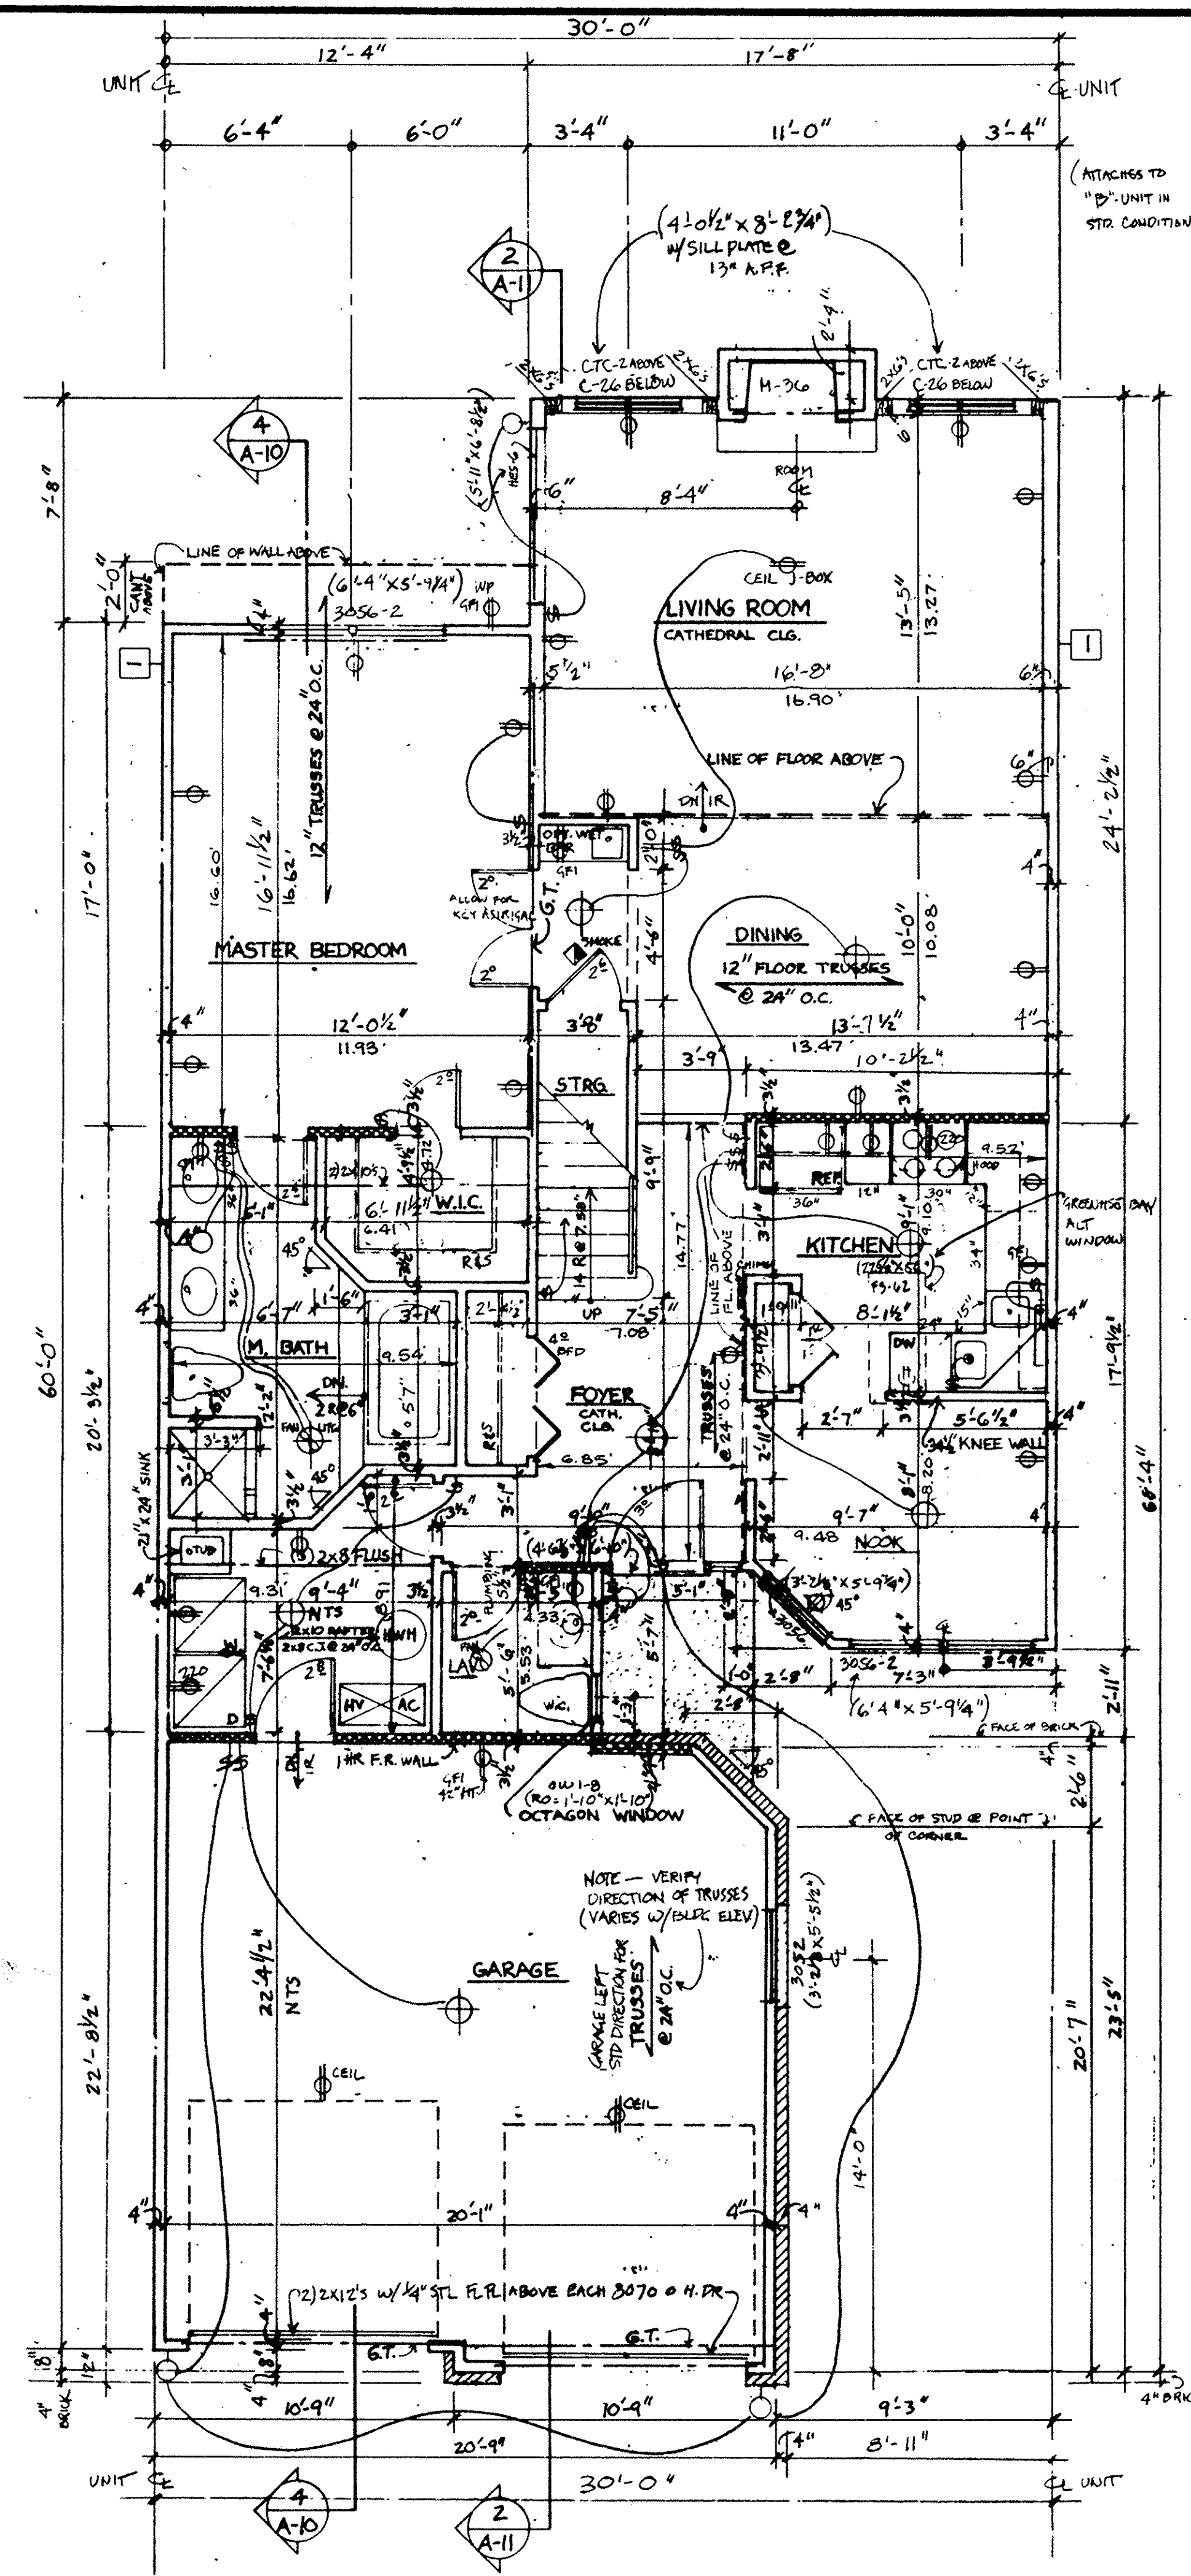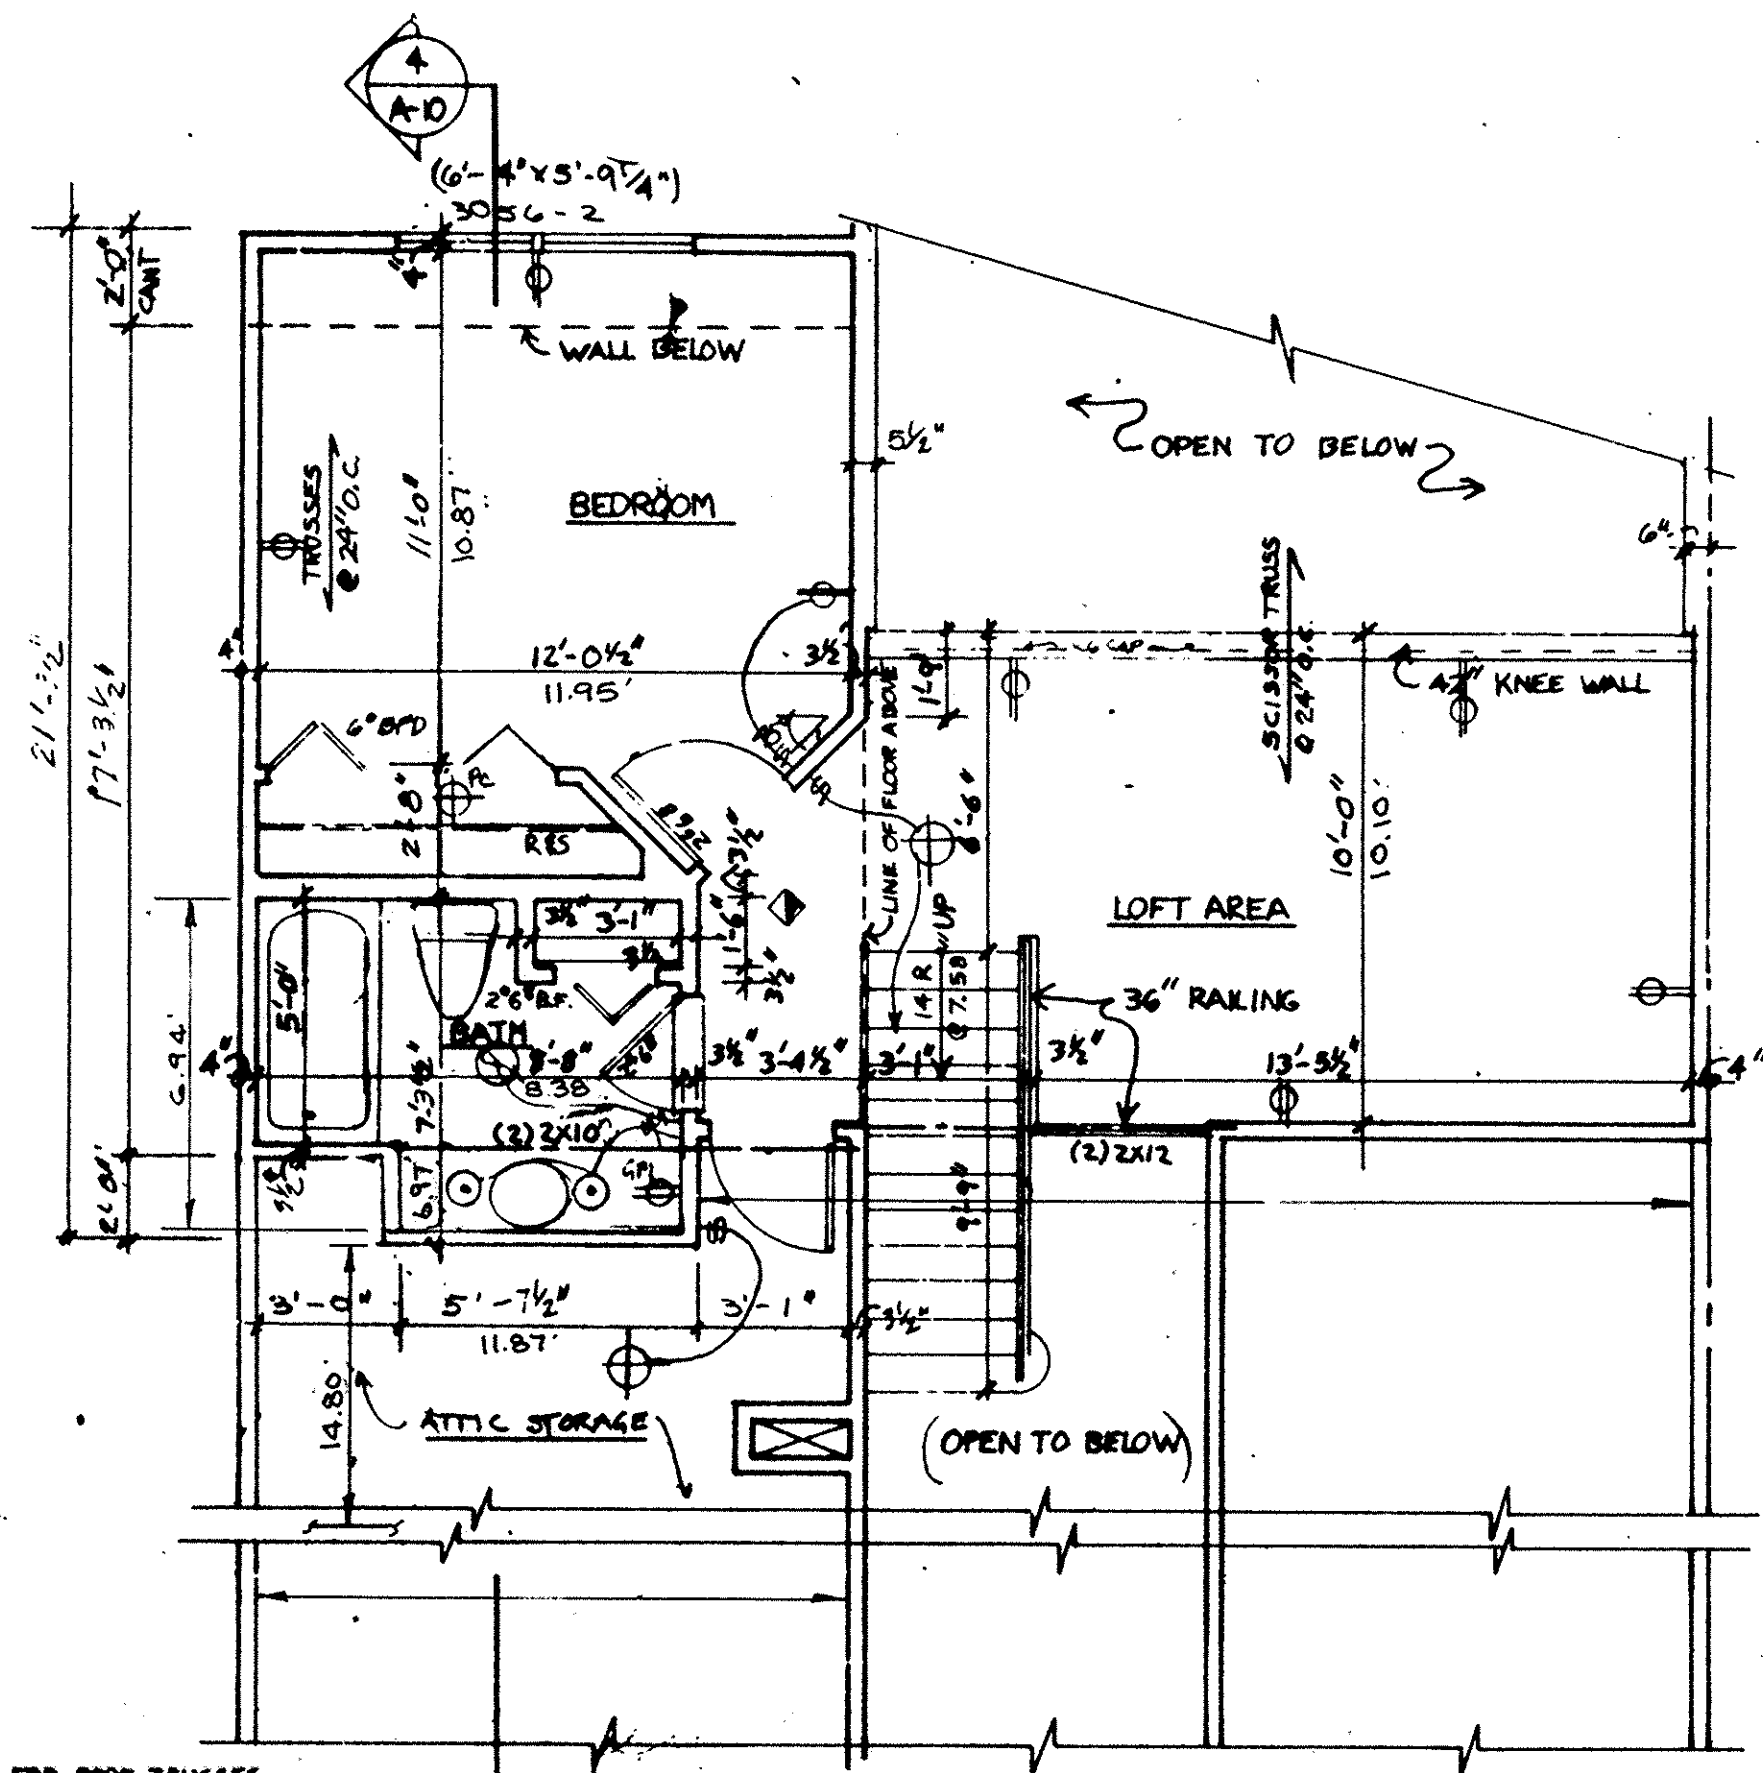

THE WESTWINDS CONDOMINIUM

KEY	
	BEARING WALL W/ 1 HR. FIRE RATING
	1 HOUR FIRE RATED WALL
	1 LAYER 5/8" TYPE 'X' DRYWALL EACH SIDE

- NOTES**
1. ALL WALLS SHALL BE 3 1/2" UNLESS NOTED OTHERWISE.
  2. ALL DIMENSIONS ARE TO ROUGH FRAMING.
  3. REFER TO WALL SECTION SHEET FOR STRUCTURAL INFORMATION.

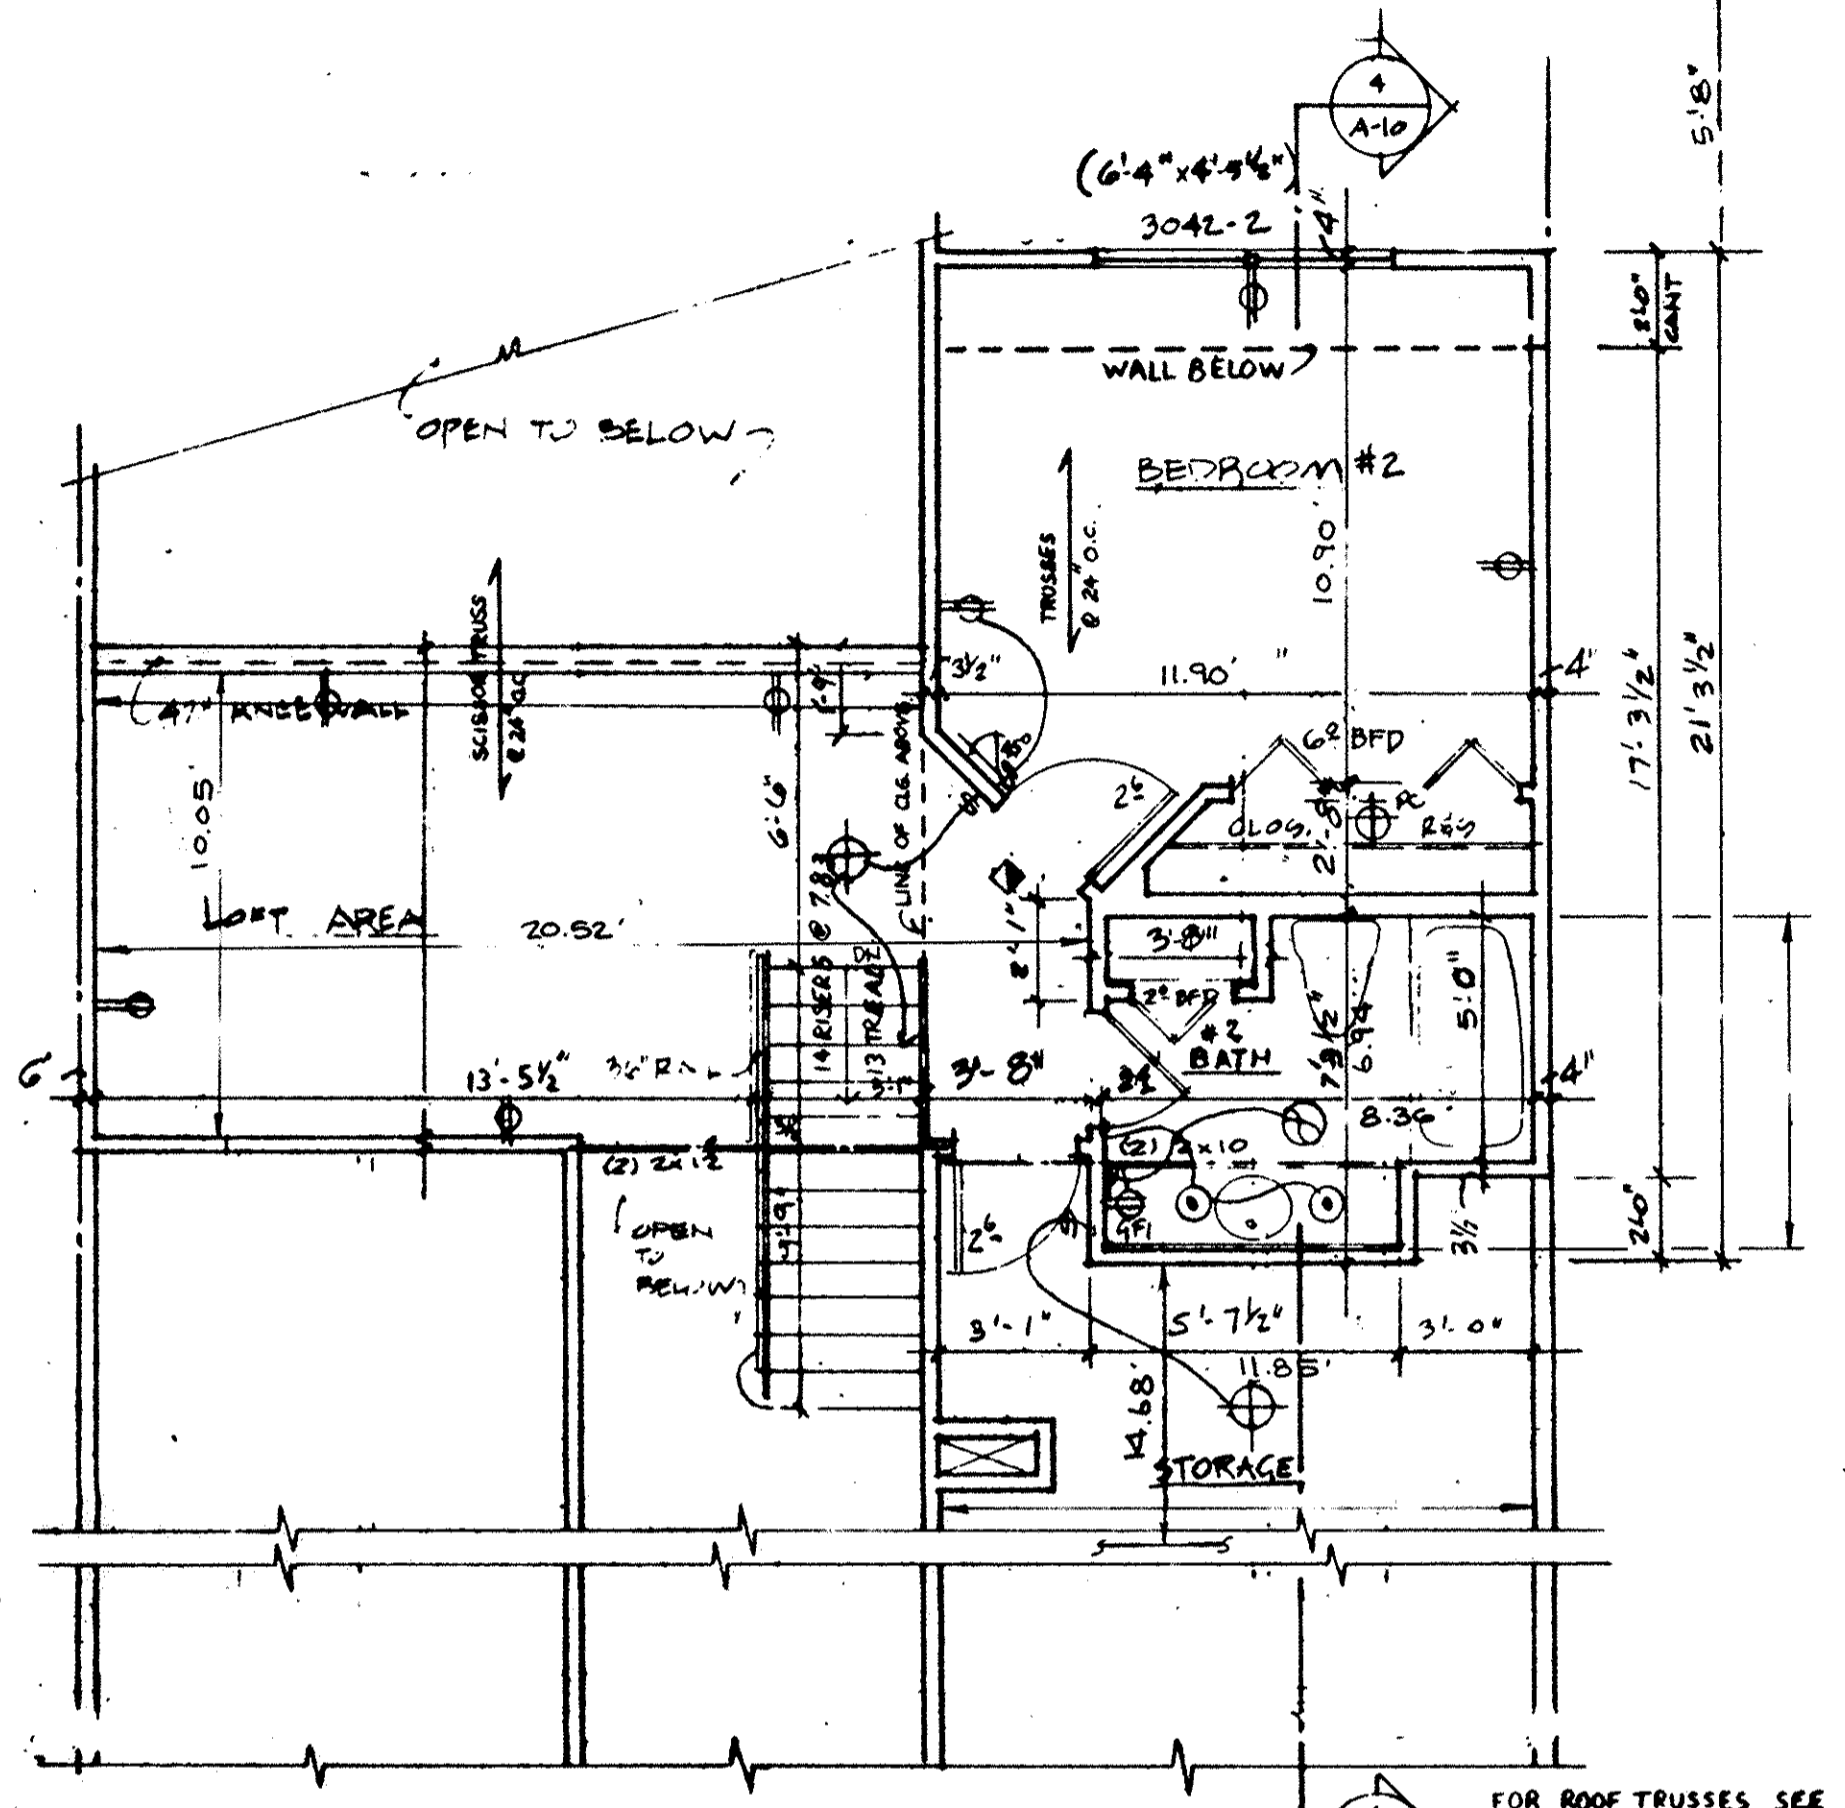


4 SECOND FLOOR "C" UNIT  
1/4"-1'-0"

**NOTES**


	BEARING WALL
	1 HR. FIRERATED WALL
	1 LAYER 5/8" TYPE X DRYWALL EACH SIDE

- NOTES**
1. ALL WALLS SHALL BE 3/12" UNLESS NOTED OTHERWISE.
  2. ALL DIMENSIONS ARE TO ROUGH FRAMING.
  3. REFER TO WALL SECTION SHEET FOR STRUCTURAL INFORMATION.



NOTE: DIMENSIONS SHOWN IN DECIMALS INDICATE AS BUILT DIMENSIONS, FINISHED WALL TO FINISHED WALL.

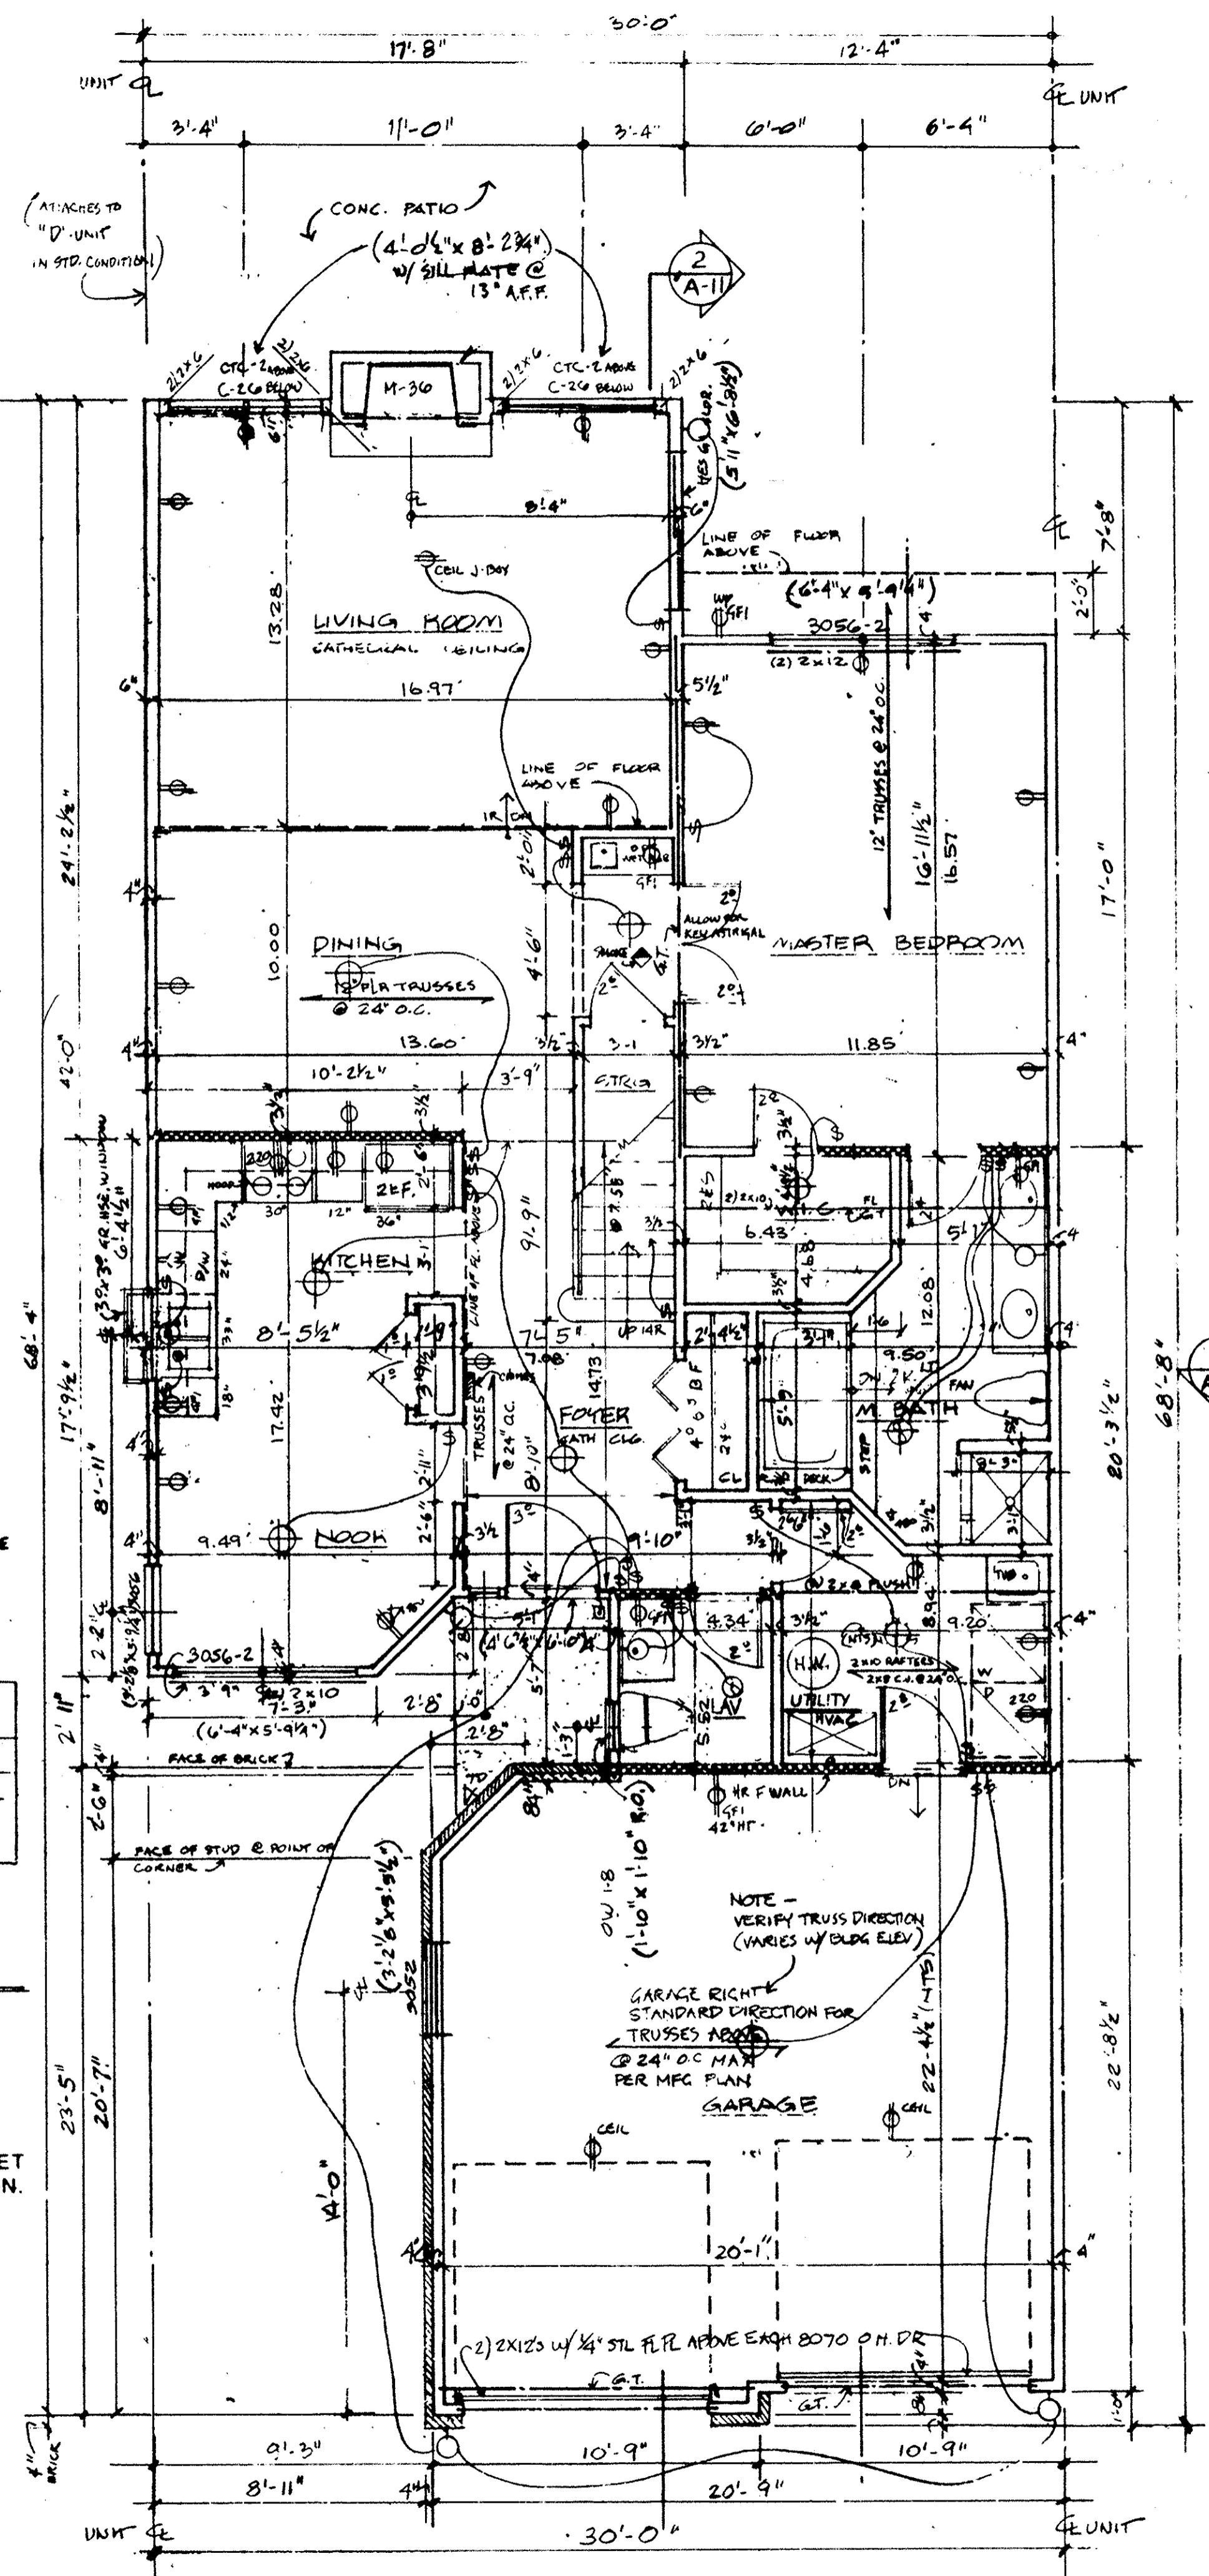

2 FIRST FLOOR  
1/4"-1'-0"  
UNITS 117 & 126

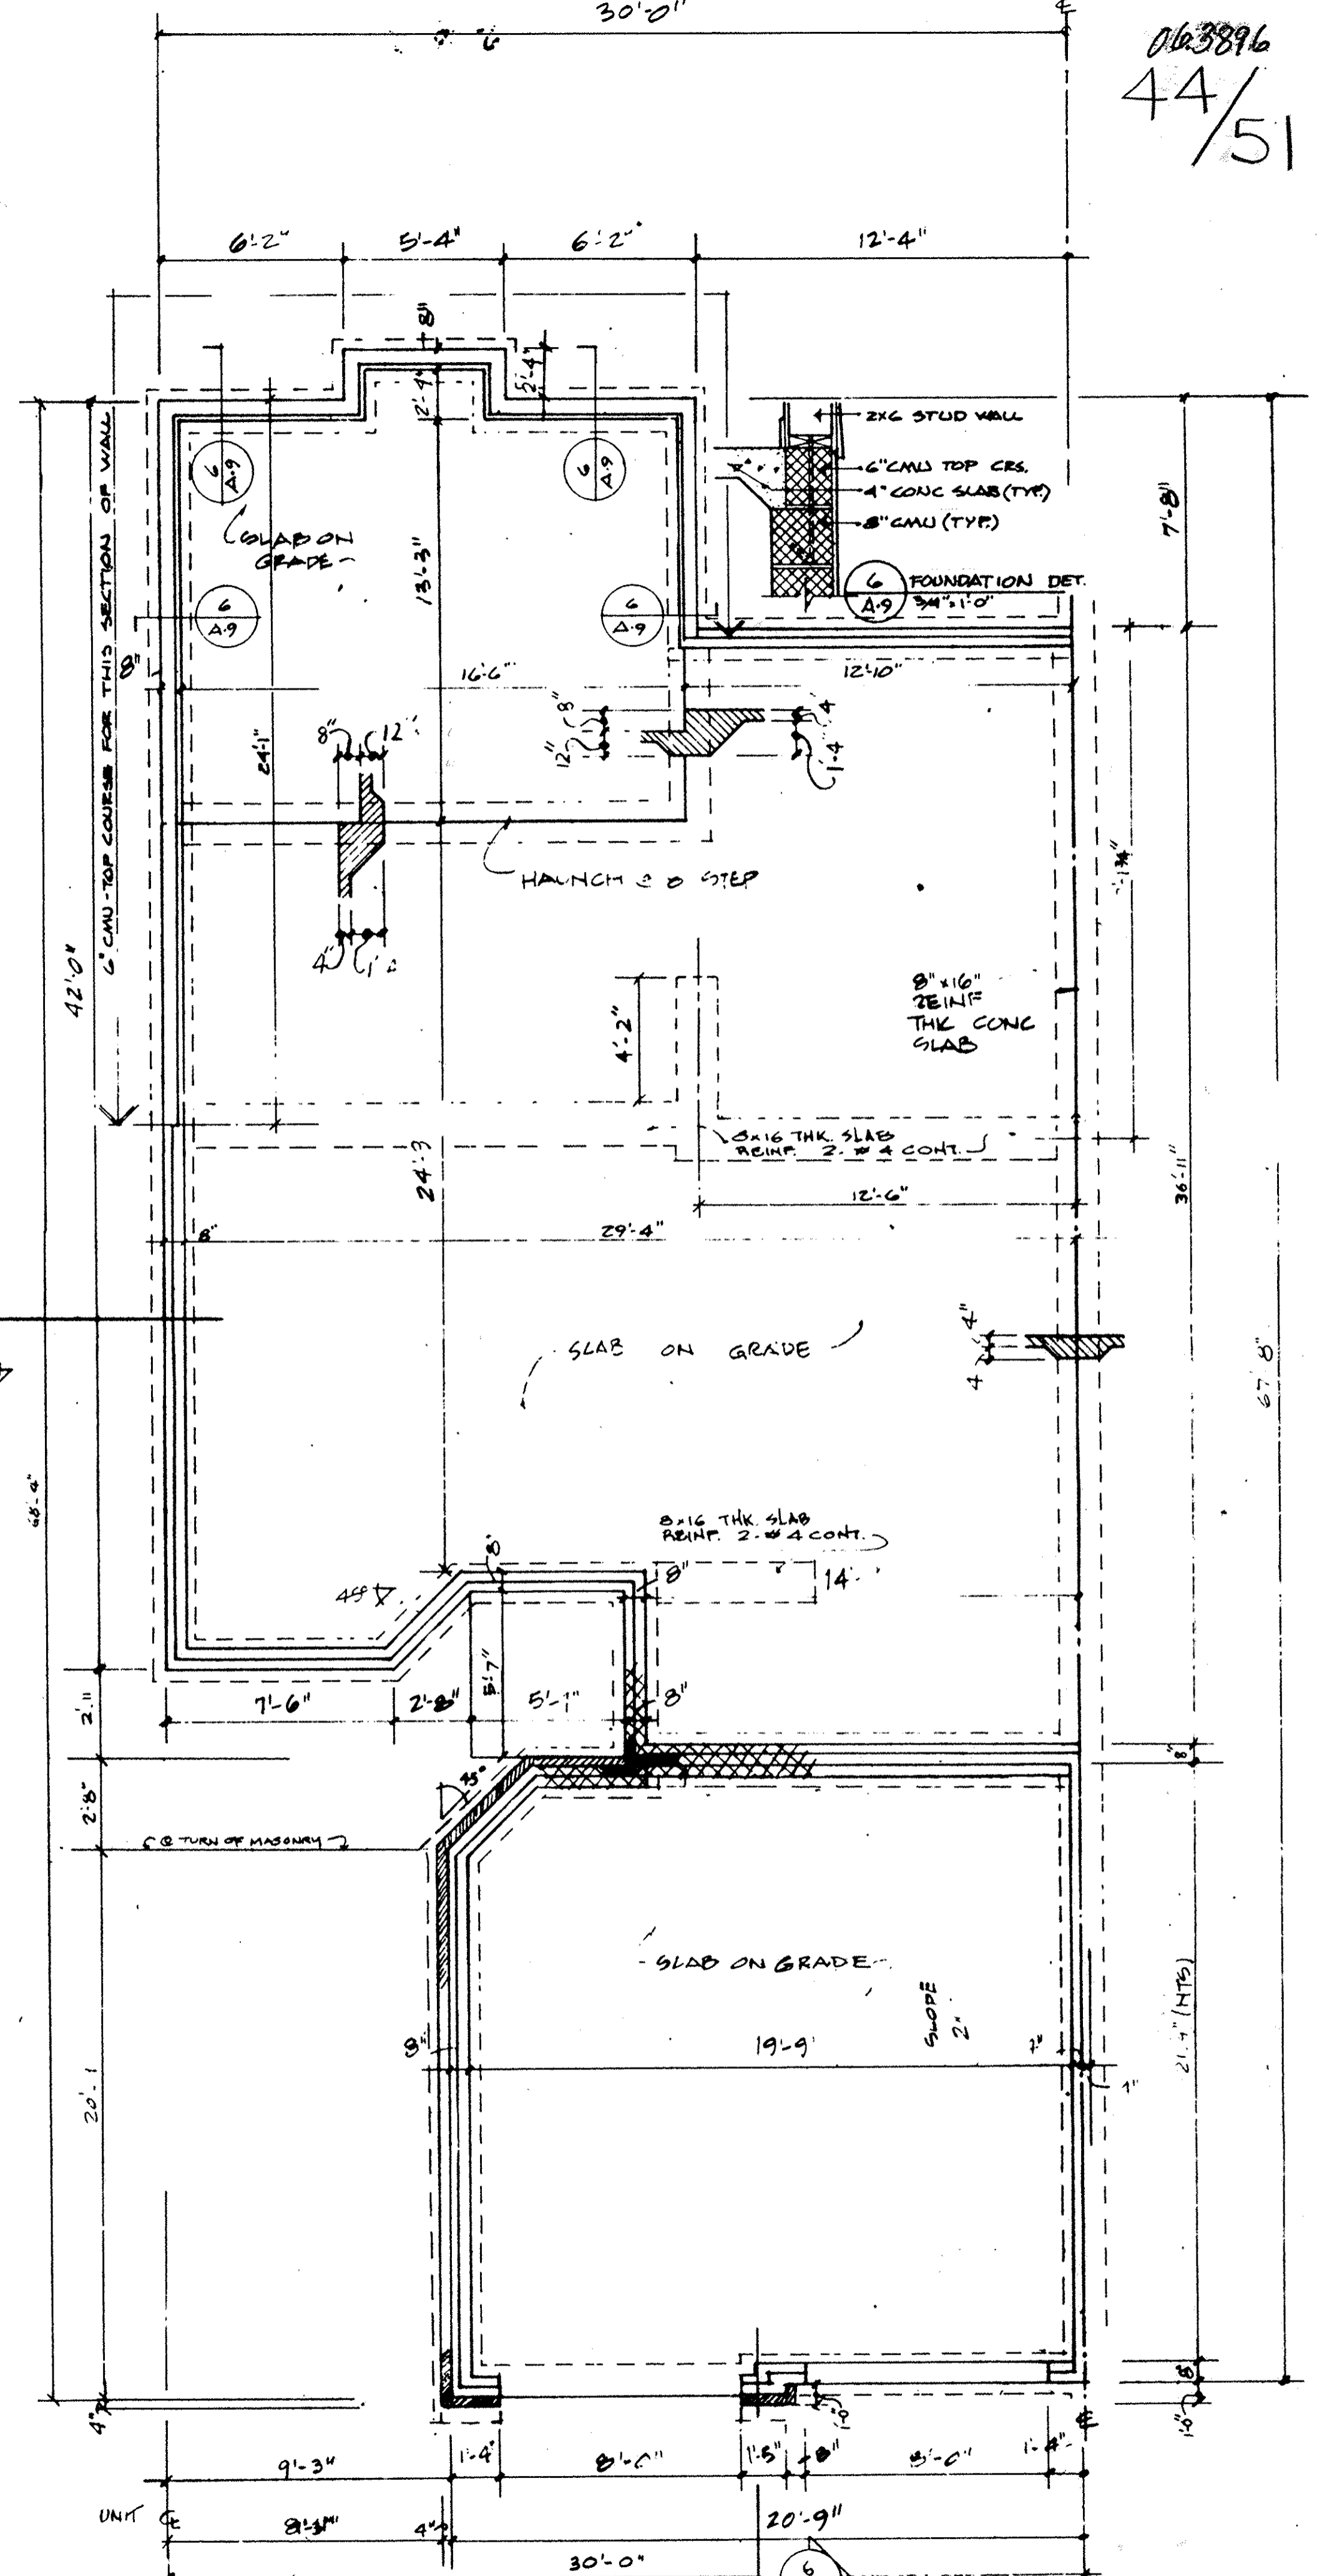

1 FOUNDATION  
1/4"-1'-0"

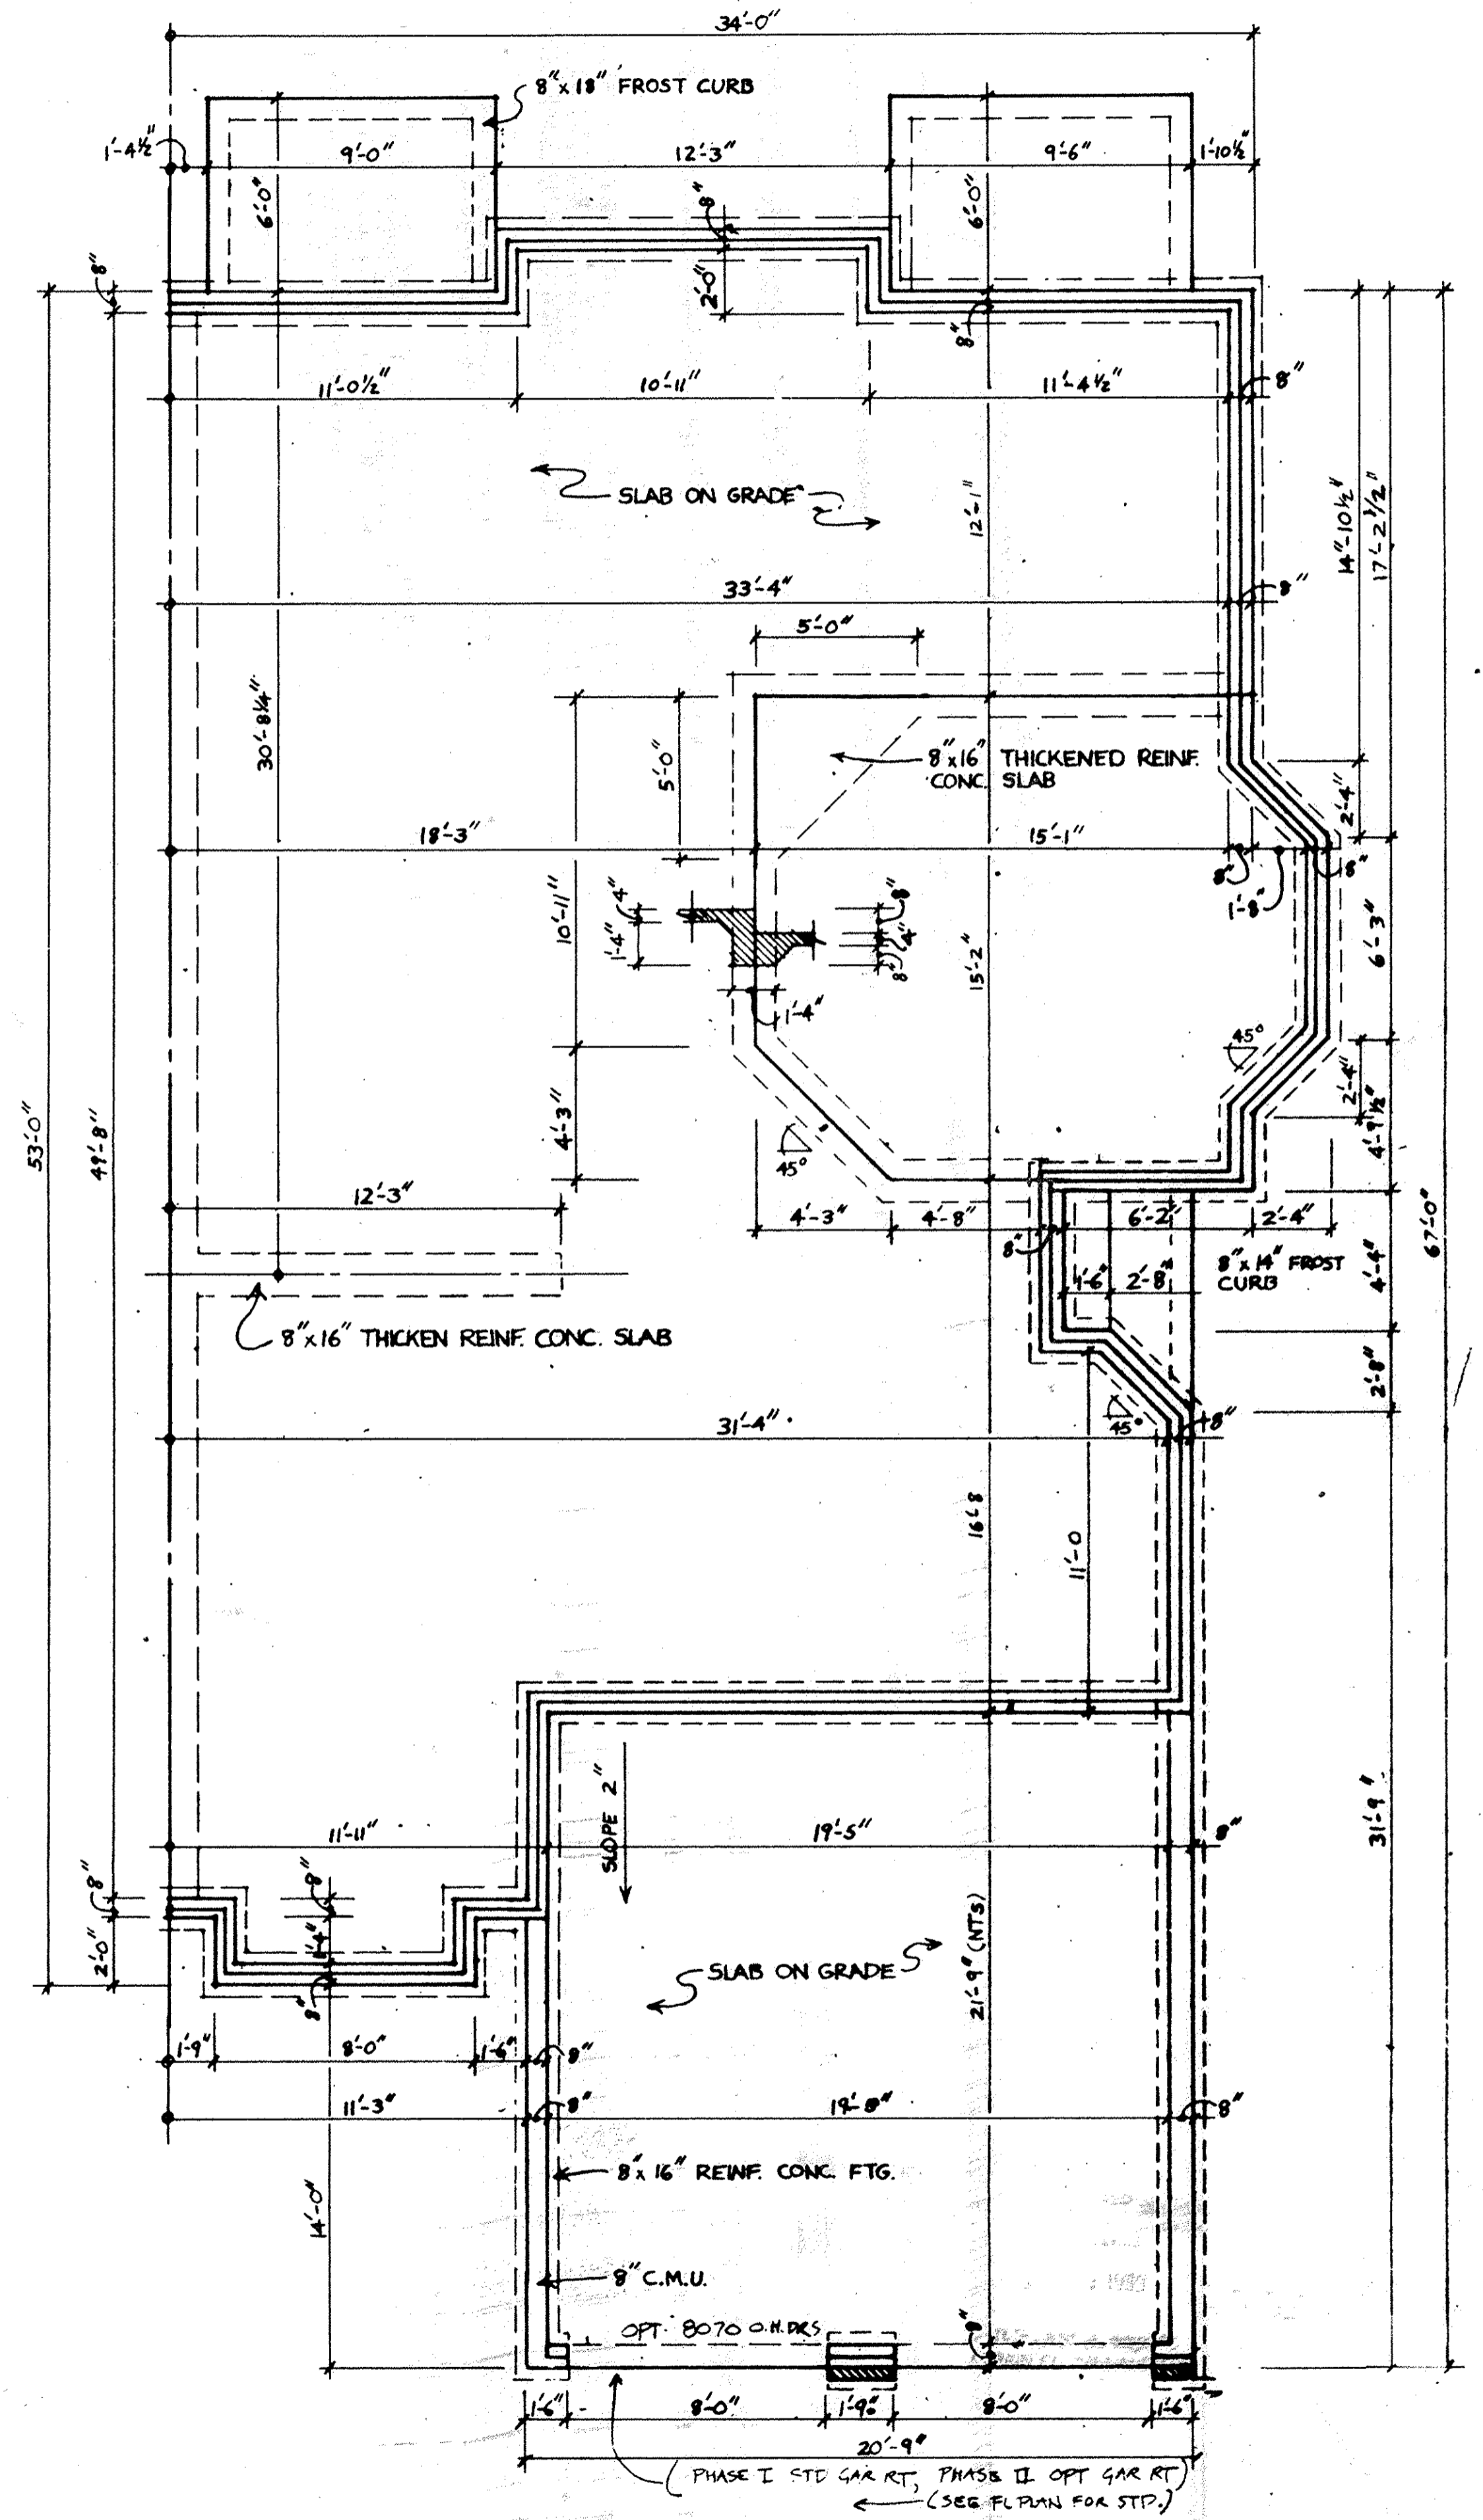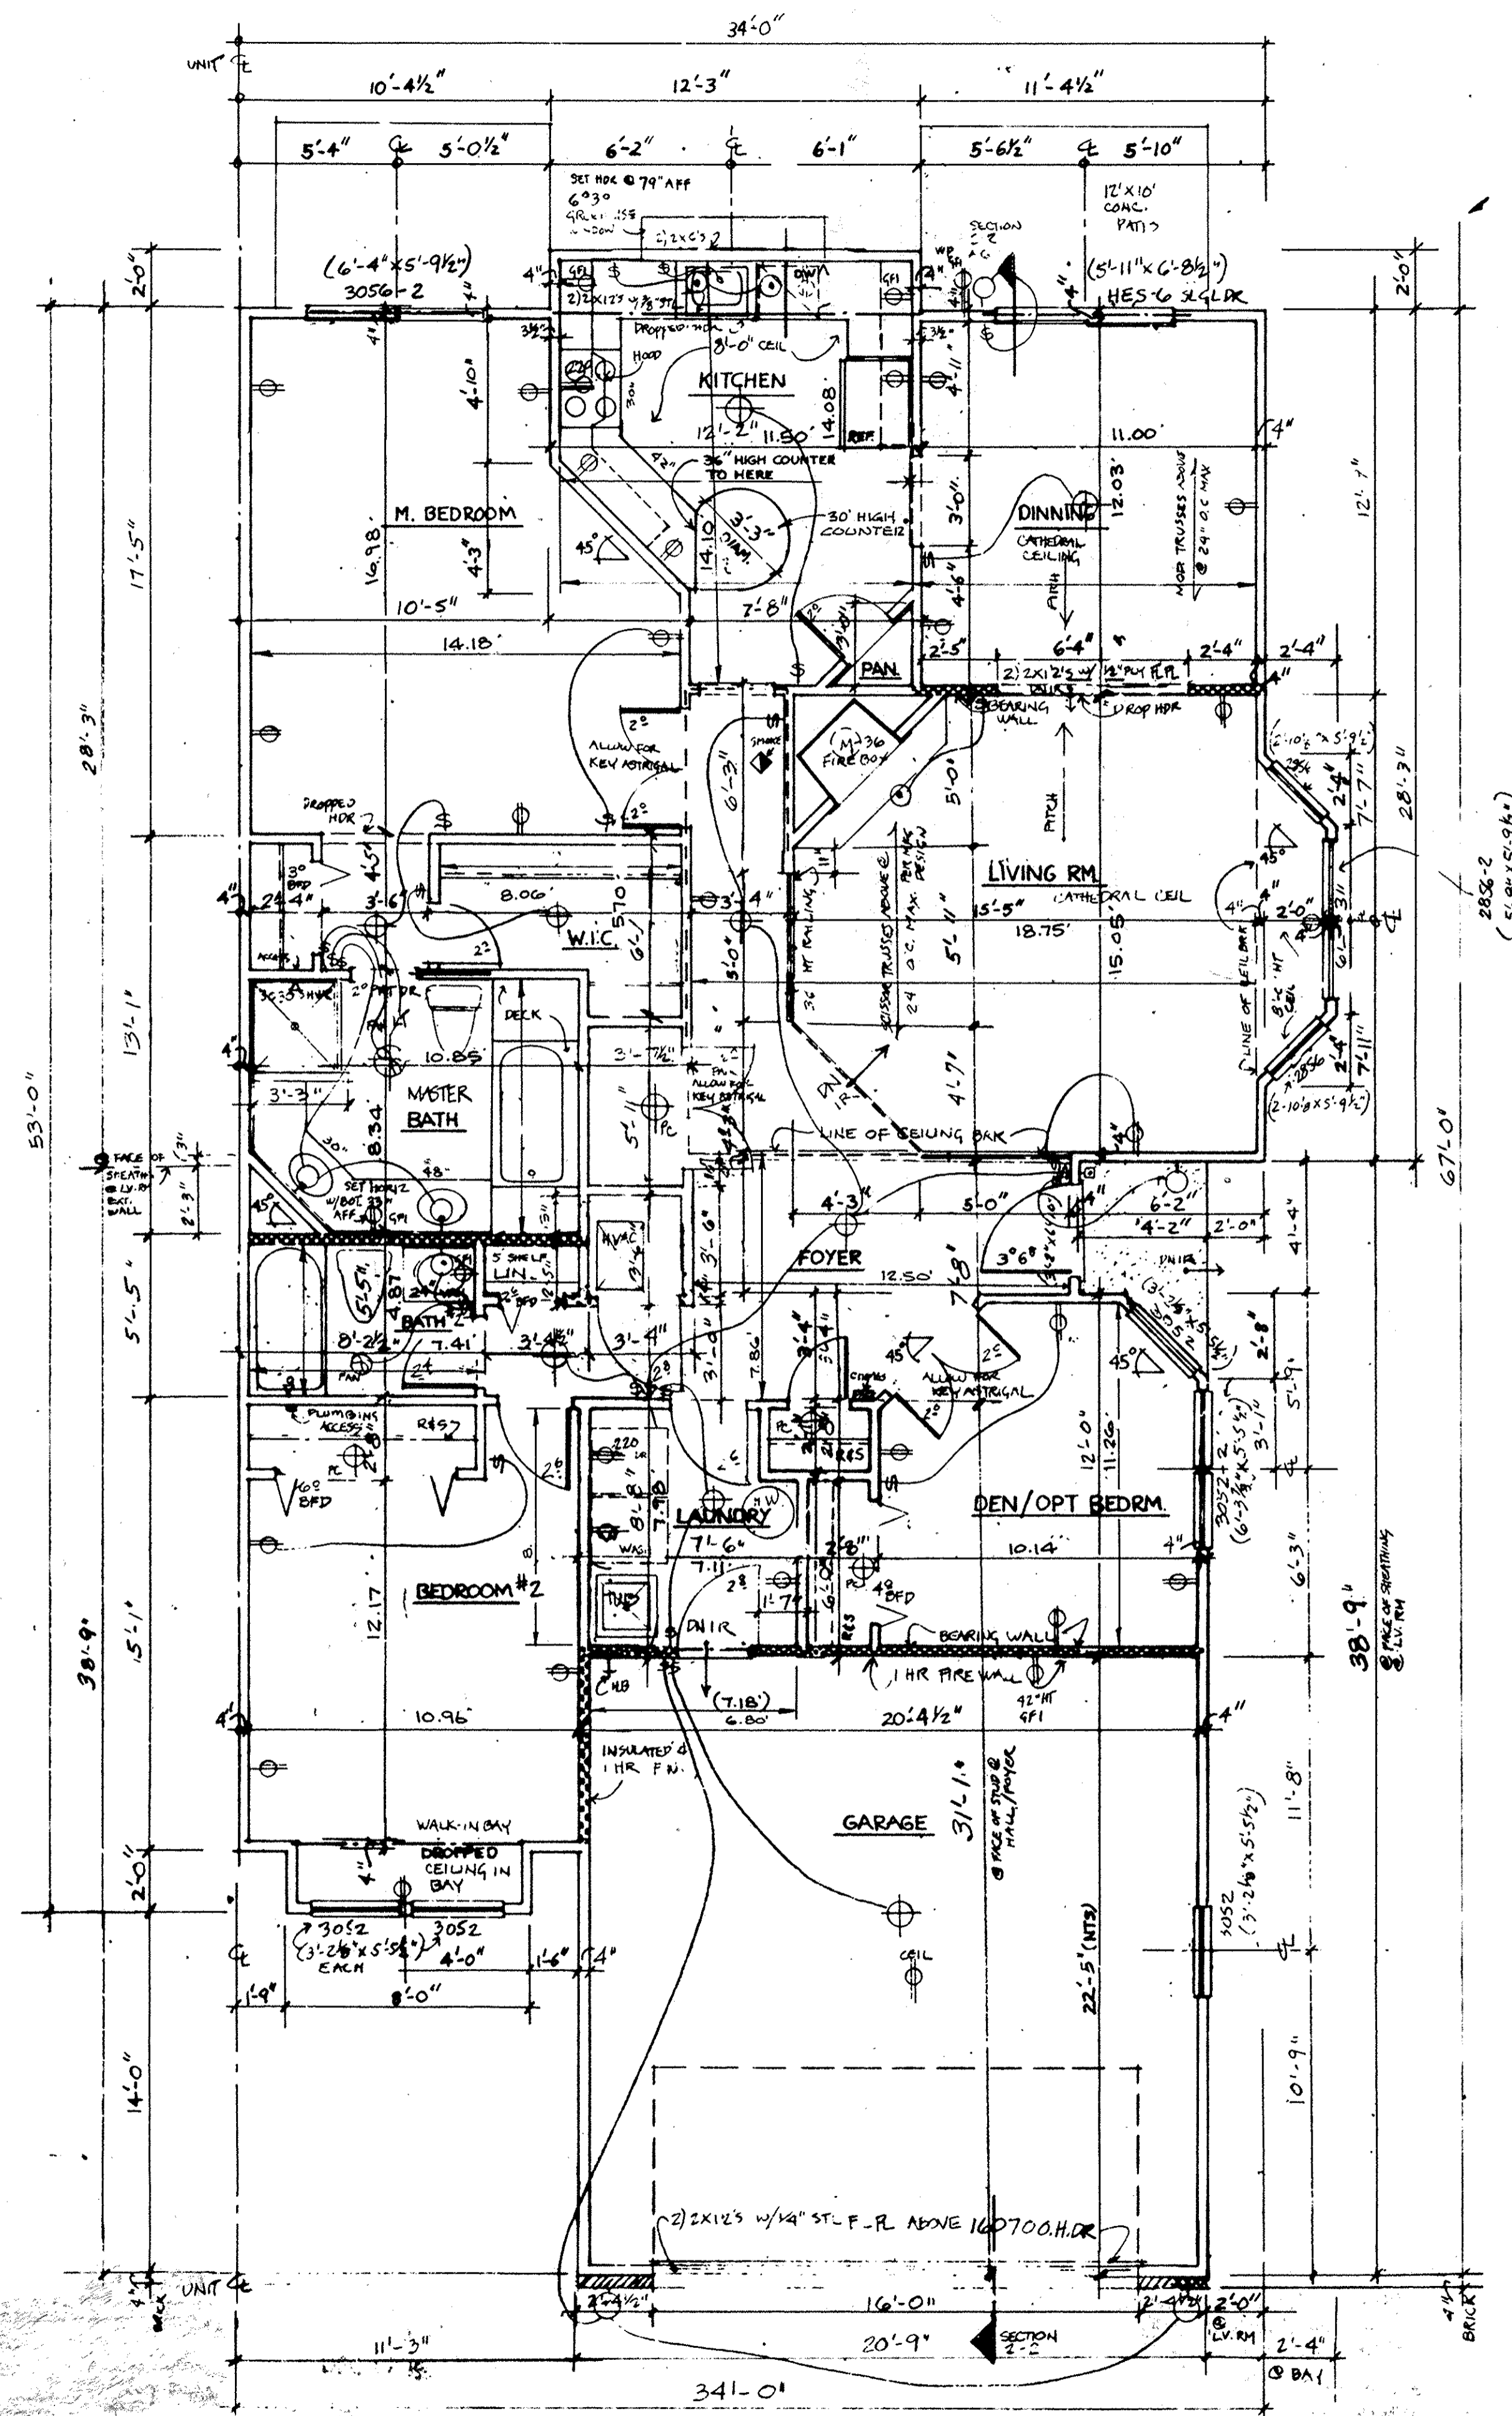

NOTE:  
1. DIMENSIONS SHOWN IN DECIMALS  
INDICATE AS BUILT DIMENSIONS,  
FINISHED WALL TO FINISHED WALL

**NOTES**

1. ALL WALLS SHALL BE 3 1/2" UNLESS NOTED OTHERWISE, EXTERIOR = 4"
2. ALL DIMENSIONS ARE TO ROUGH FRAMING.
3. REFER TO WALL SECTION SHEET FOR STRUCTURAL INFORMATION.

**KEY**

	BEARING WALL W/ 1 HR. FIRE RATING
	1 HOUR FIRE RATED WALL 1 LAYER 5/8" TYPE 'X' DRYWALL EACH SIDE

**FIRST FLOOR**

**FOUNDATION**

UNITS 118 & 127

THE WESTWINDS CONDOMINIUM