
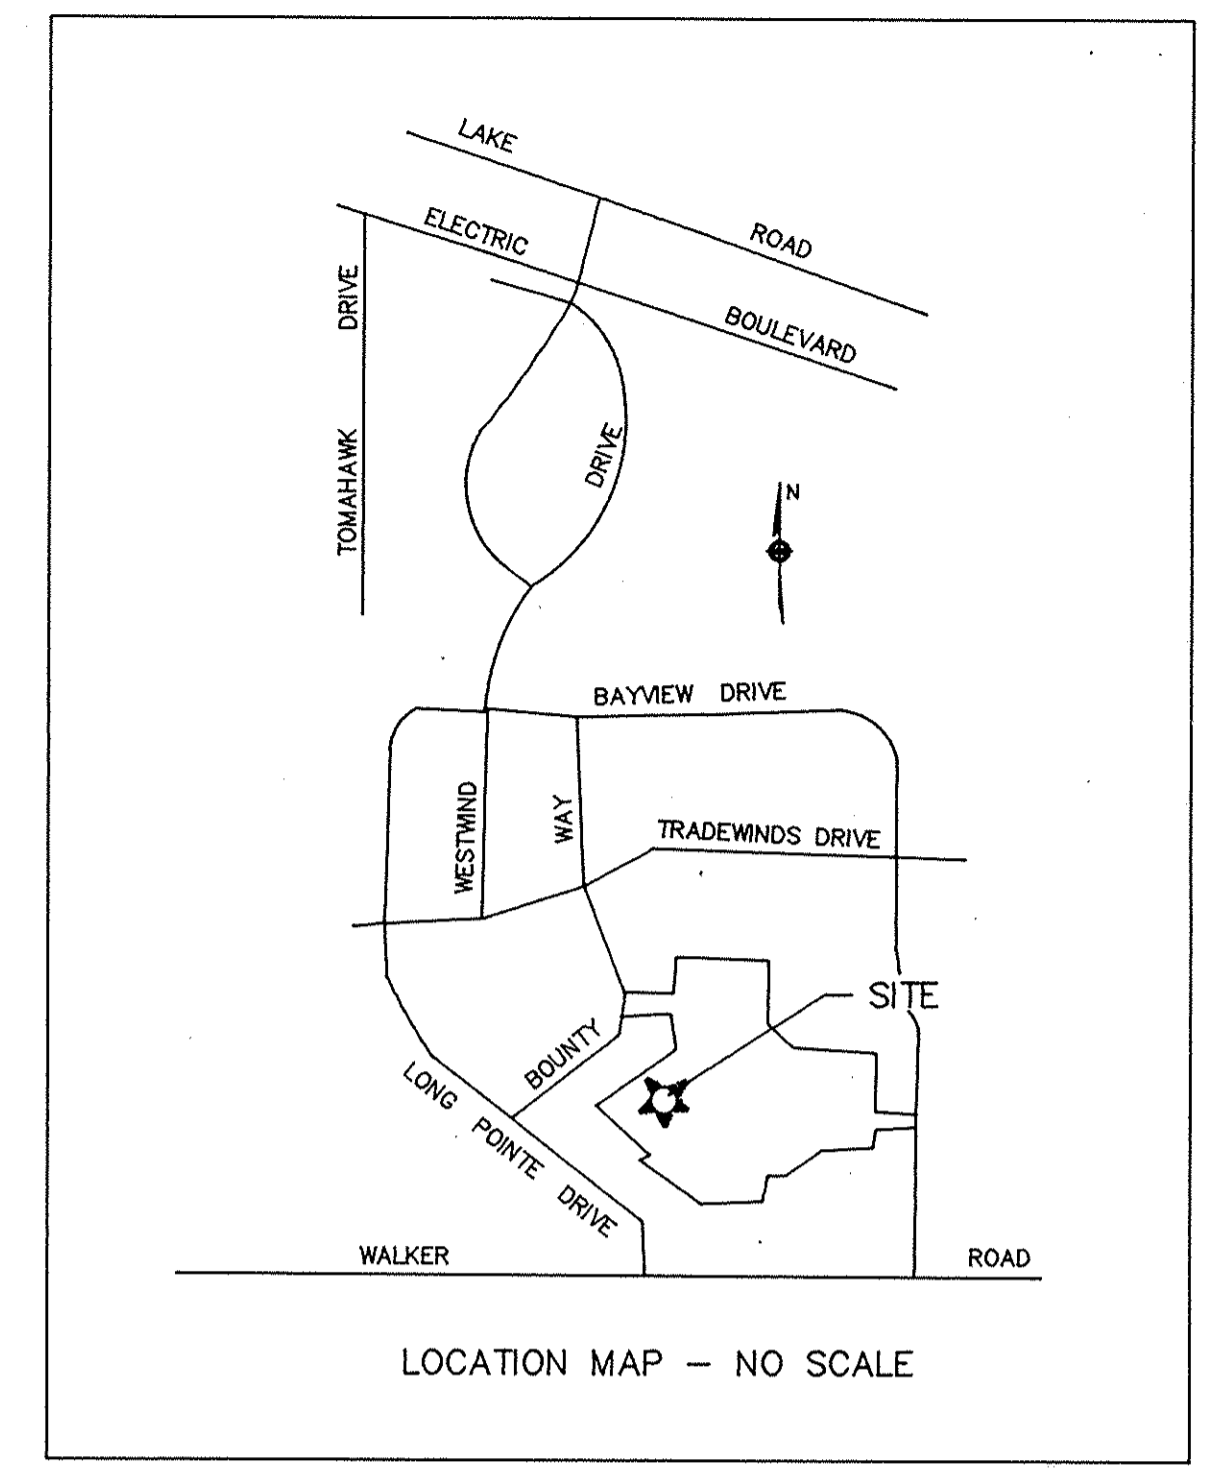
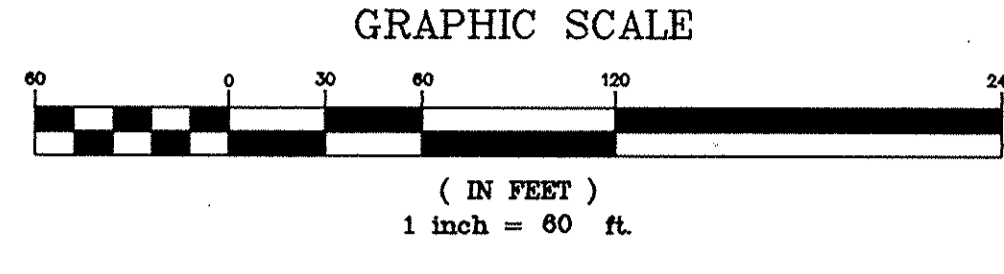


096566

096566

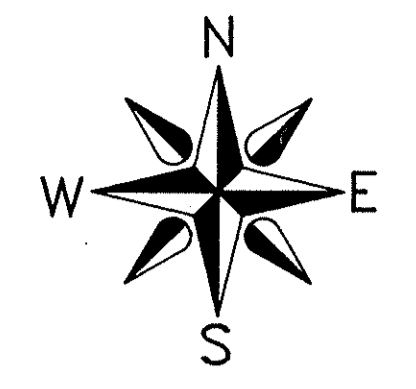


SHEET INDEX

SHEET NO.	DESCRIPTION
1	TITLE SHEET, SURVEY MAP, MISC.
2	EXTERIOR BUILDING DIMENSIONS
3	FLOOR PLANS
4	FLOOR PLANS
5	FLOOR PLANS & ELEVATIONS

Parcel No. 1:

Bldg.	Unit #	Area	% of Common Areas and Facilities	Floor Elevation
-------	--------	------	----------------------------------	-----------------

Bldg. 34	Unit # 1-148	401	5.9208%	632.44
Bldg. 34	2-149	"	7.0808%	632.44
Bldg. 34	3-150	"	7.4300%	632.44
Bldg. 34	4-151	"	5.9208%	632.44
<hr/>				
Bldg. 35	Unit # 5-152	401	5.9208%	632.40
Bldg. 35	6-153	"	7.9415%	632.40
Bldg. 35	7-154	"	7.0808%	632.40
Bldg. 35	8-155	"	5.9208%	632.40
<hr/>				
Bldg. 36	Unit # 9-156	401	5.9208%	632.35
Bldg. 36	10-157	"	7.0808%	632.35
Bldg. 36	11-158	"	7.4300%	632.35
Bldg. 36	12-159	"	5.9208%	632.35
<hr/>				
Bldg. 37	Unit # 13-160	401	7.0808%	632.50
Bldg. 37	14-161	"	7.4300%	632.50
Bldg. 37	15-162	"	5.9208%	632.50


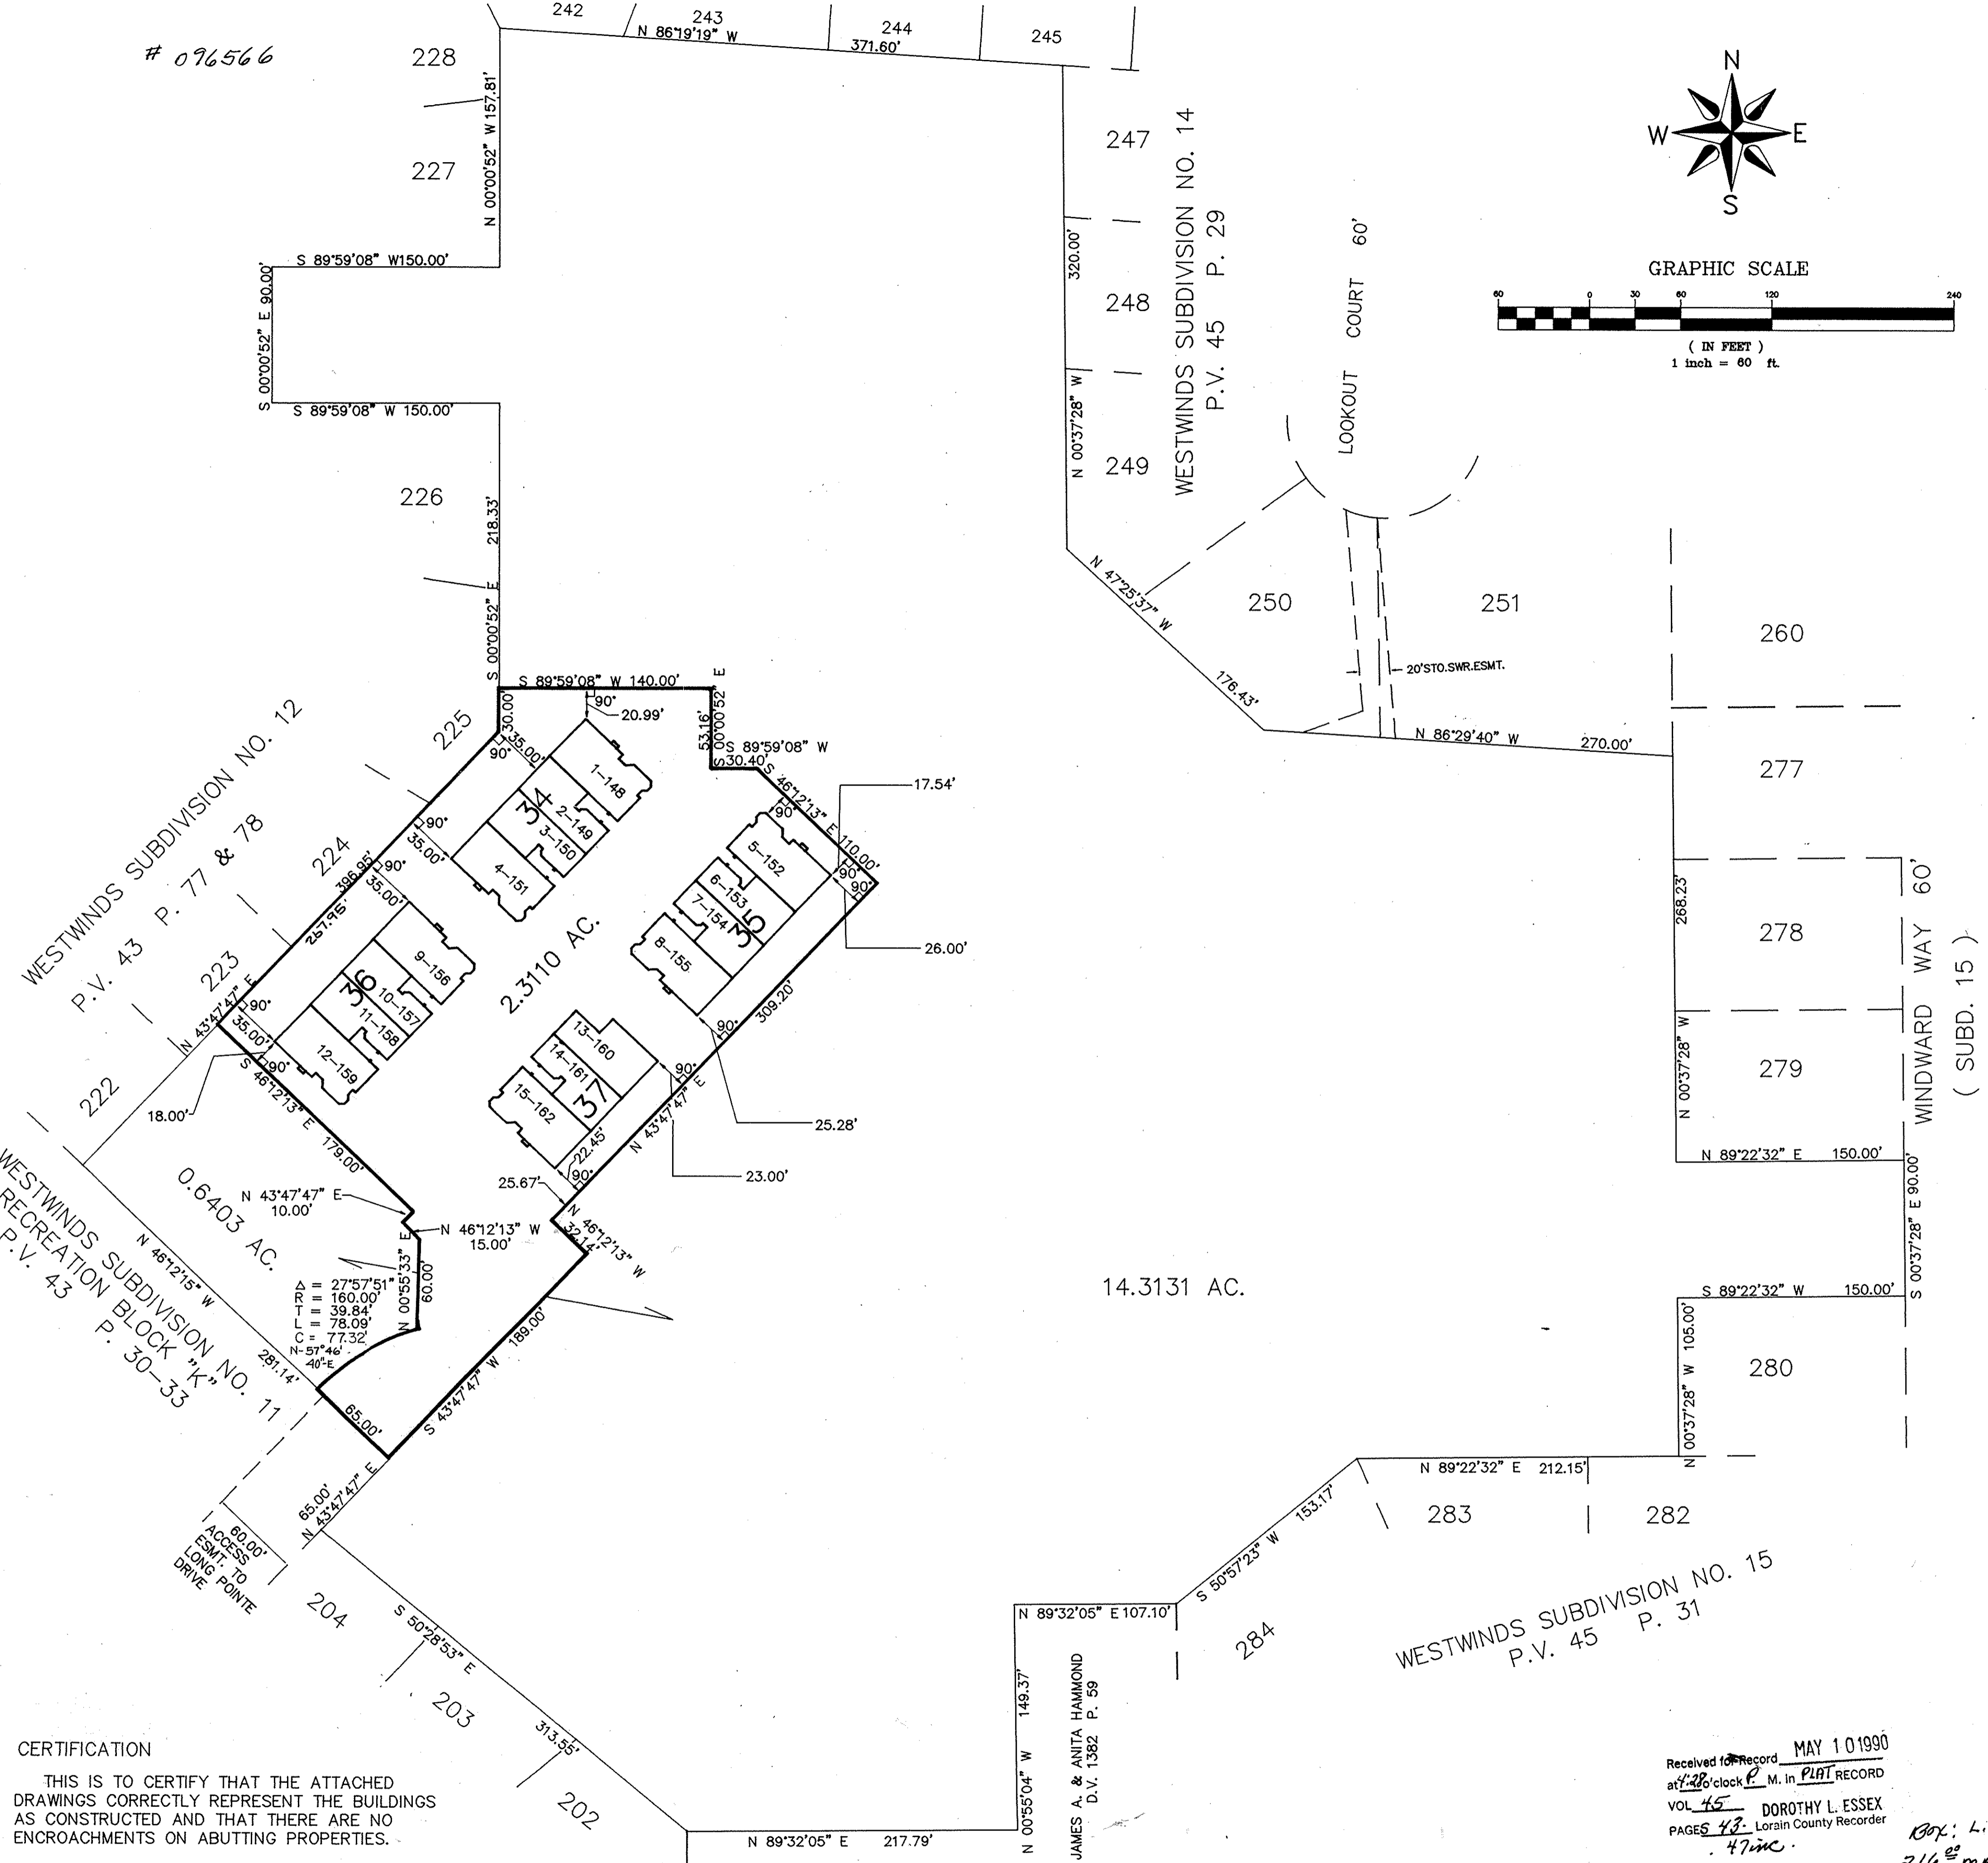


CERTIFICATION

THIS IS TO CERTIFY THAT THE ATTACHED DRAWINGS CORRECTLY REPRESENT THE BUILDINGS AS CONSTRUCTED AND THAT THERE ARE NO ENCROACHMENTS ON ADJUTING PROPERTIES.

David L. Elwell
DAVID L. ELWELL
REG. SURVEYOR NO. 6333

Mark Skellenger
MARK SKELLENGER
REG. ENGINEER NO. 46461

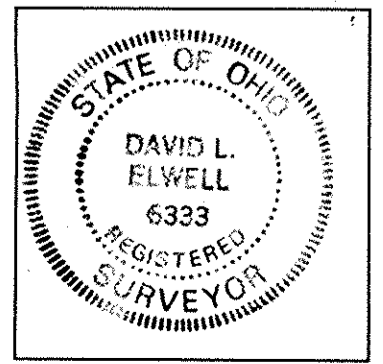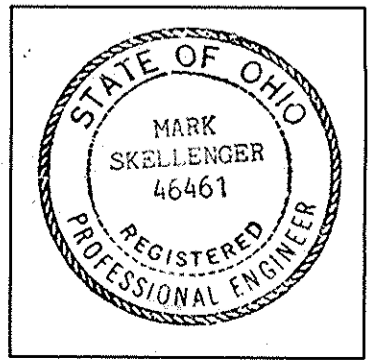

JOAN CONNOR
D.V. 1211 P. 493

LORAIN COUNTY TAX
MAP DEPARTMENT COPY

TRANSFERRED
IN COMPLIANCE WITH SEC. 319.202
OHIO REV. CODE
MAY 10 1990
JULIAN A. PIJOK
LORAIN COUNTY AUDITOR


Received for Record MAY 10 1990
at 1:26 clock P.M. in PLAT RECORD
VOL 45 DOROTHY L. ESSEX
PAGES 42 Lorain County Recorder
47mc

Off: L.C.T. (S.K.)
216 MR.

WESTWINDS SOUTH CONDOMINIUM NO. 1
PART OF AVON TOWNSHIP SECTION NO. 30
CITY OF AVON LAKE, COUNTY OF LORAIN, STATE OF OHIO

KS ASSOCIATES, INC.

ENGINEERS/SURVEYORS
424 Middle Avenue
P.O. Box 89
Elyria, Ohio 44036

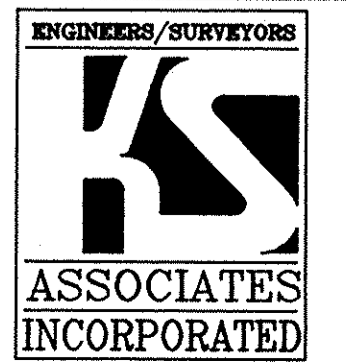





SHEET 1 OF 5

JOB NO. 7815G-P1
1/78/502/50000-1

ELYRIA (216) 322-6317 * LORAIN (216) 244-5757

#096566

#096566

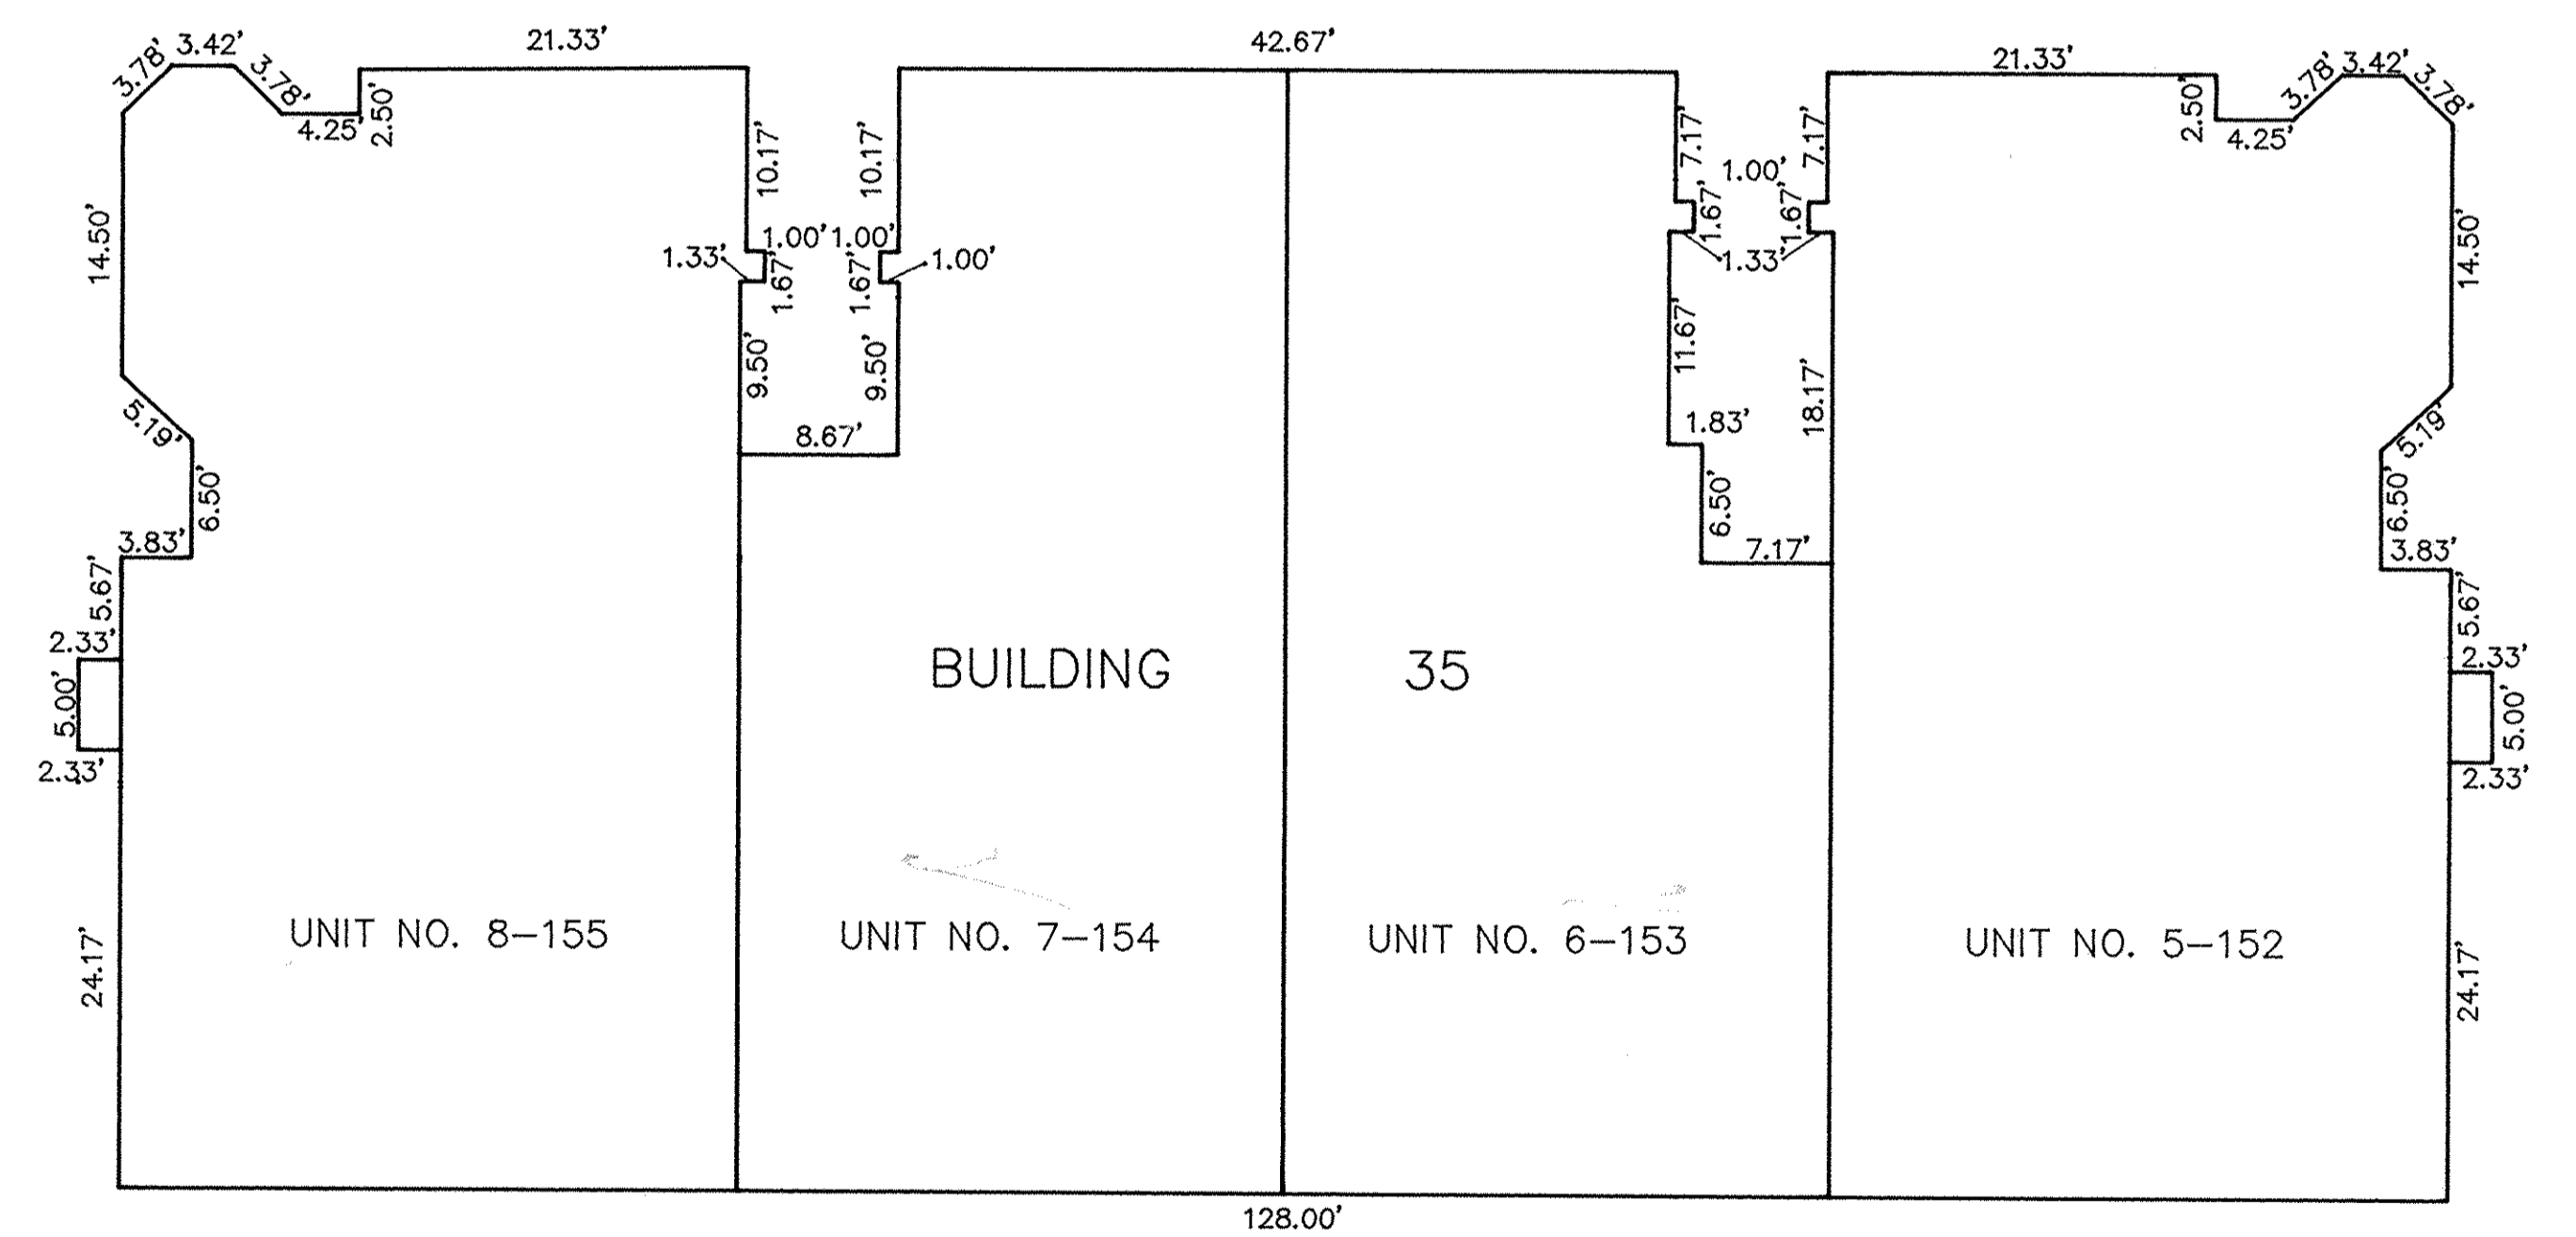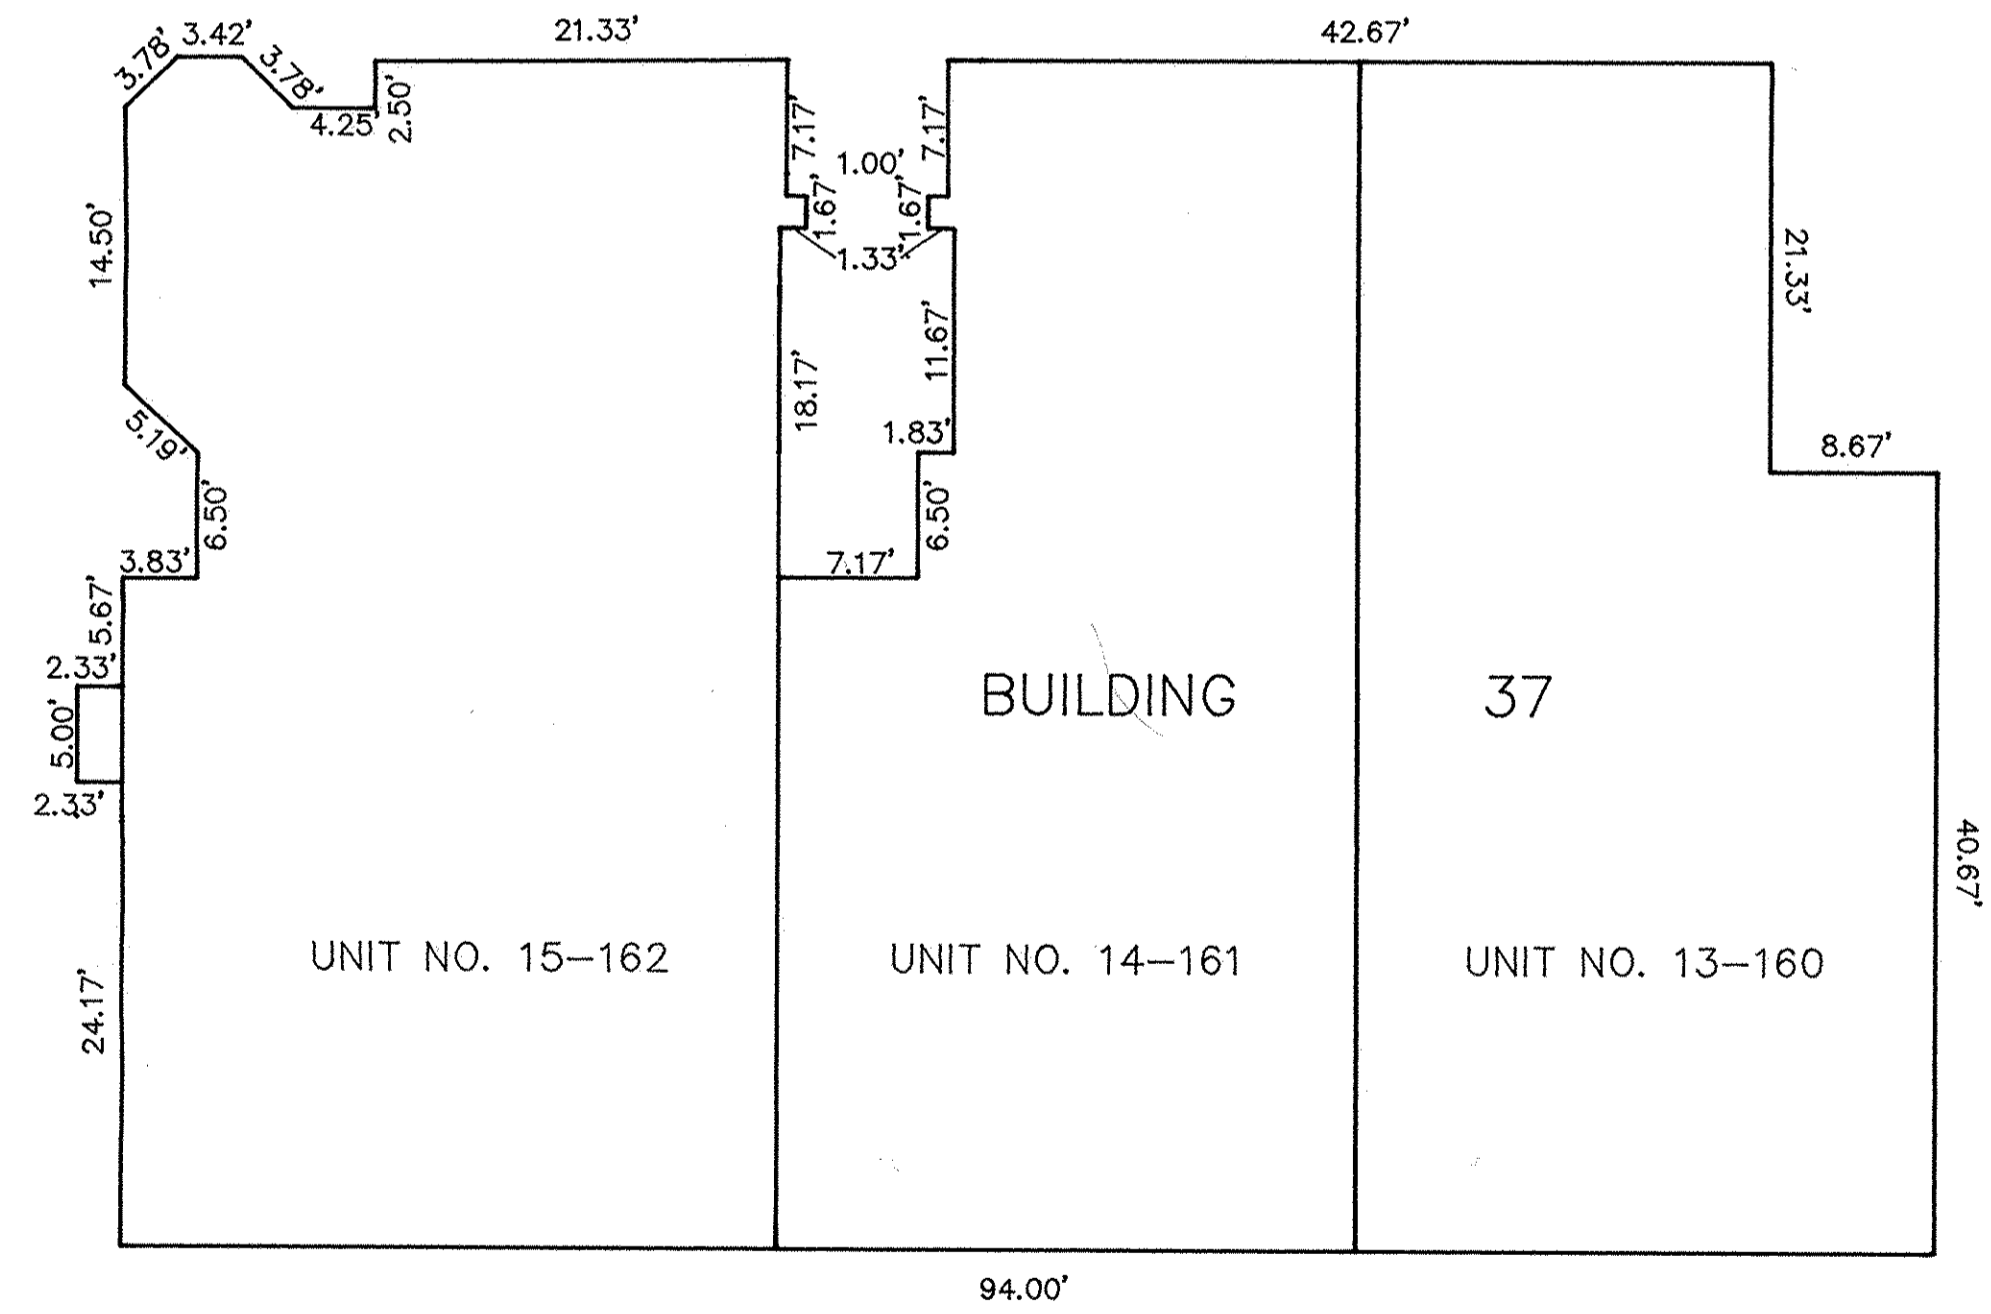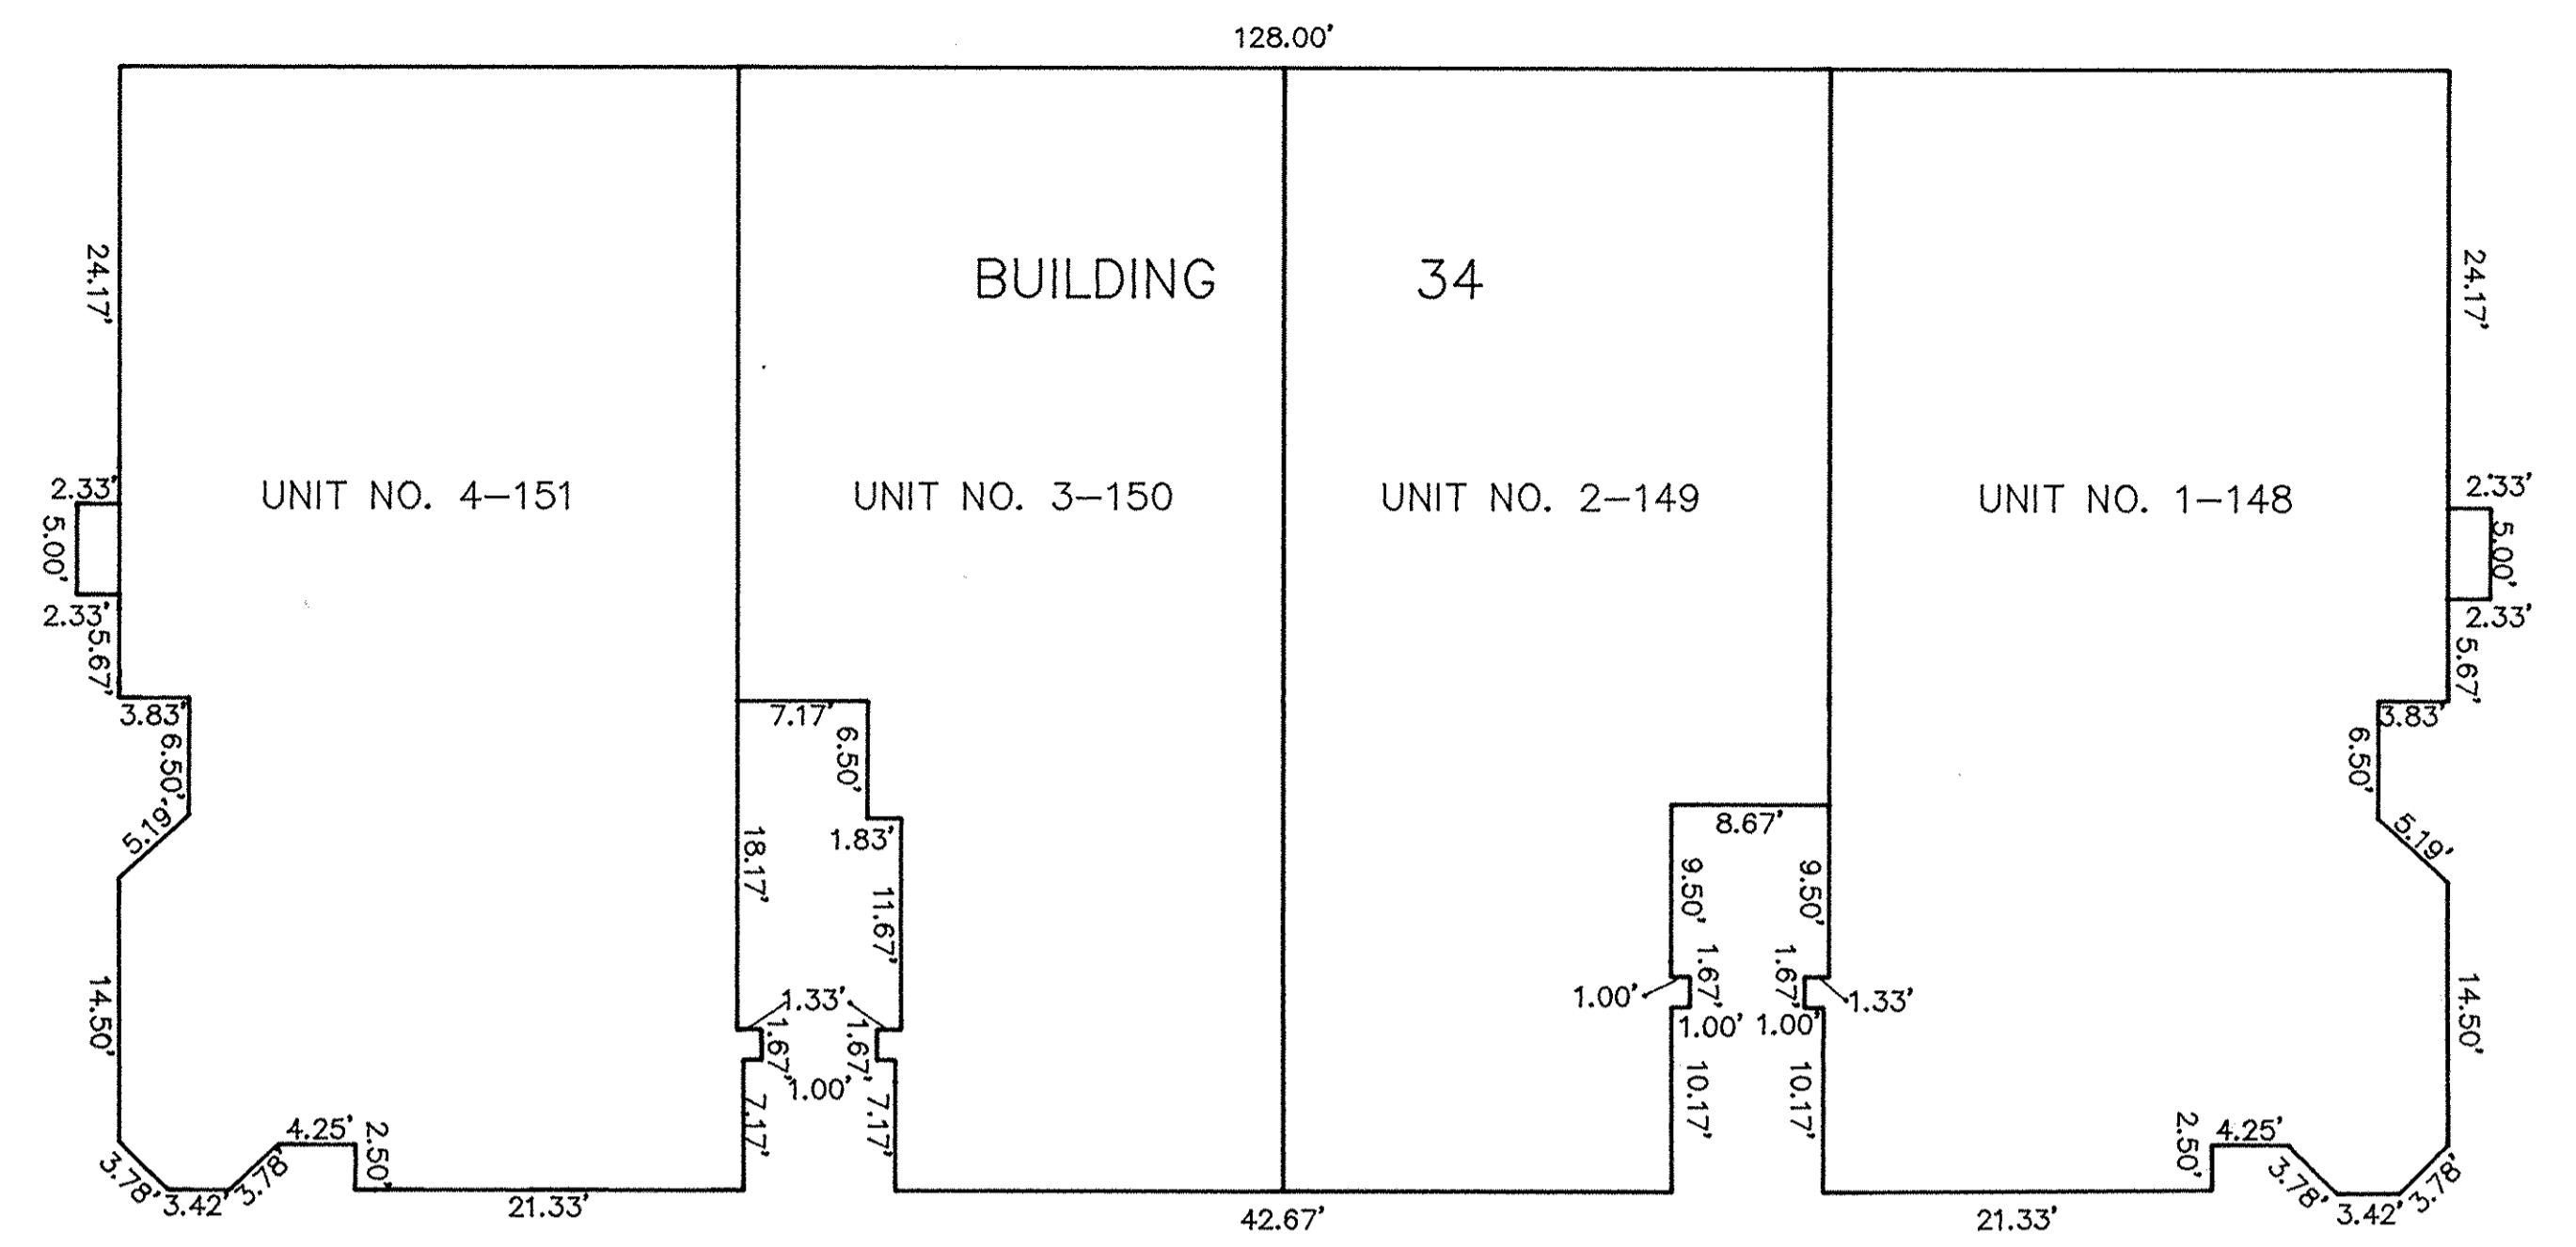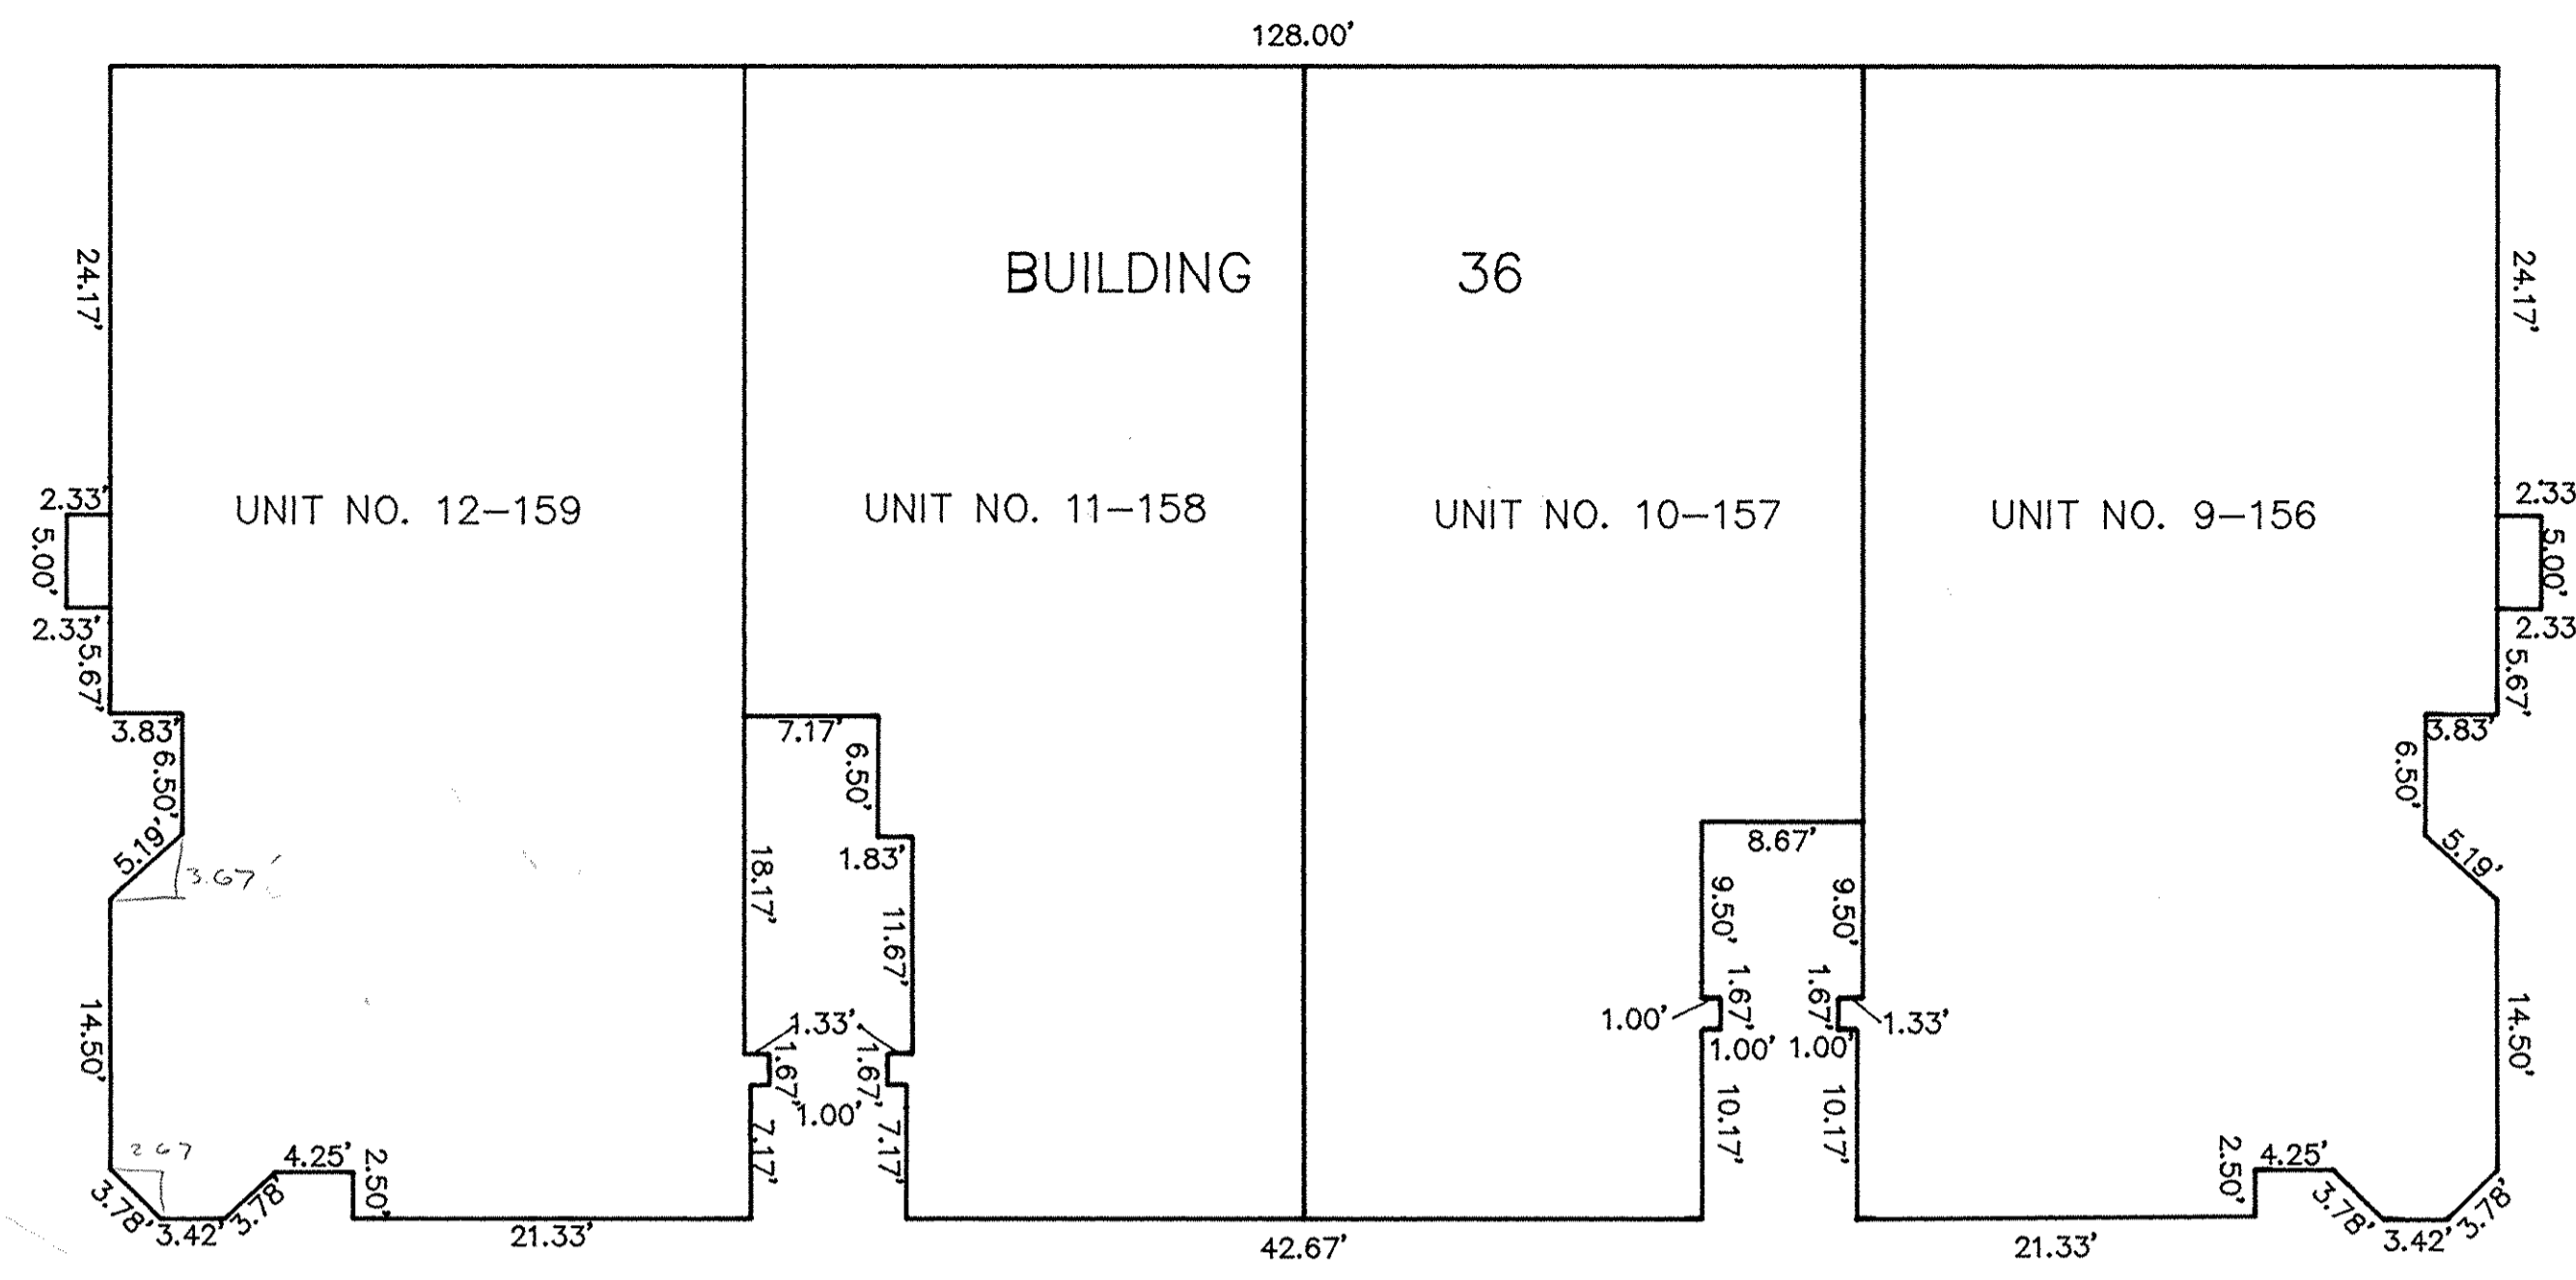

LORAIN COUNTY TAX MAP DEPARTMENT COPY

REVISIONS		


WESTWINDS SOUTH CONDOMINIUM NO. 1 EXTERIOR BUILDING DIMENSIONS

SCALE: 1"=10'

KS ASSOCIATES, INC.

ENGINEERS/SURVEYORS 424 Middle Avenue P.O. Box 89 Elyria, Ohio 44038


ELYRIA (216) 322-6317 * LORAIN (216) 244-5757

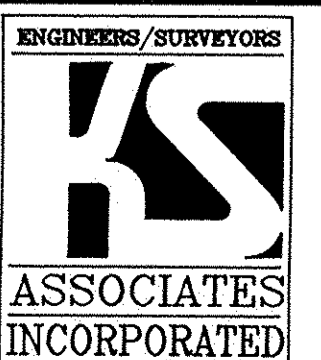


SHEET 2 OF 5

JOB NO. 7815G-P1

1/781502/BLDG

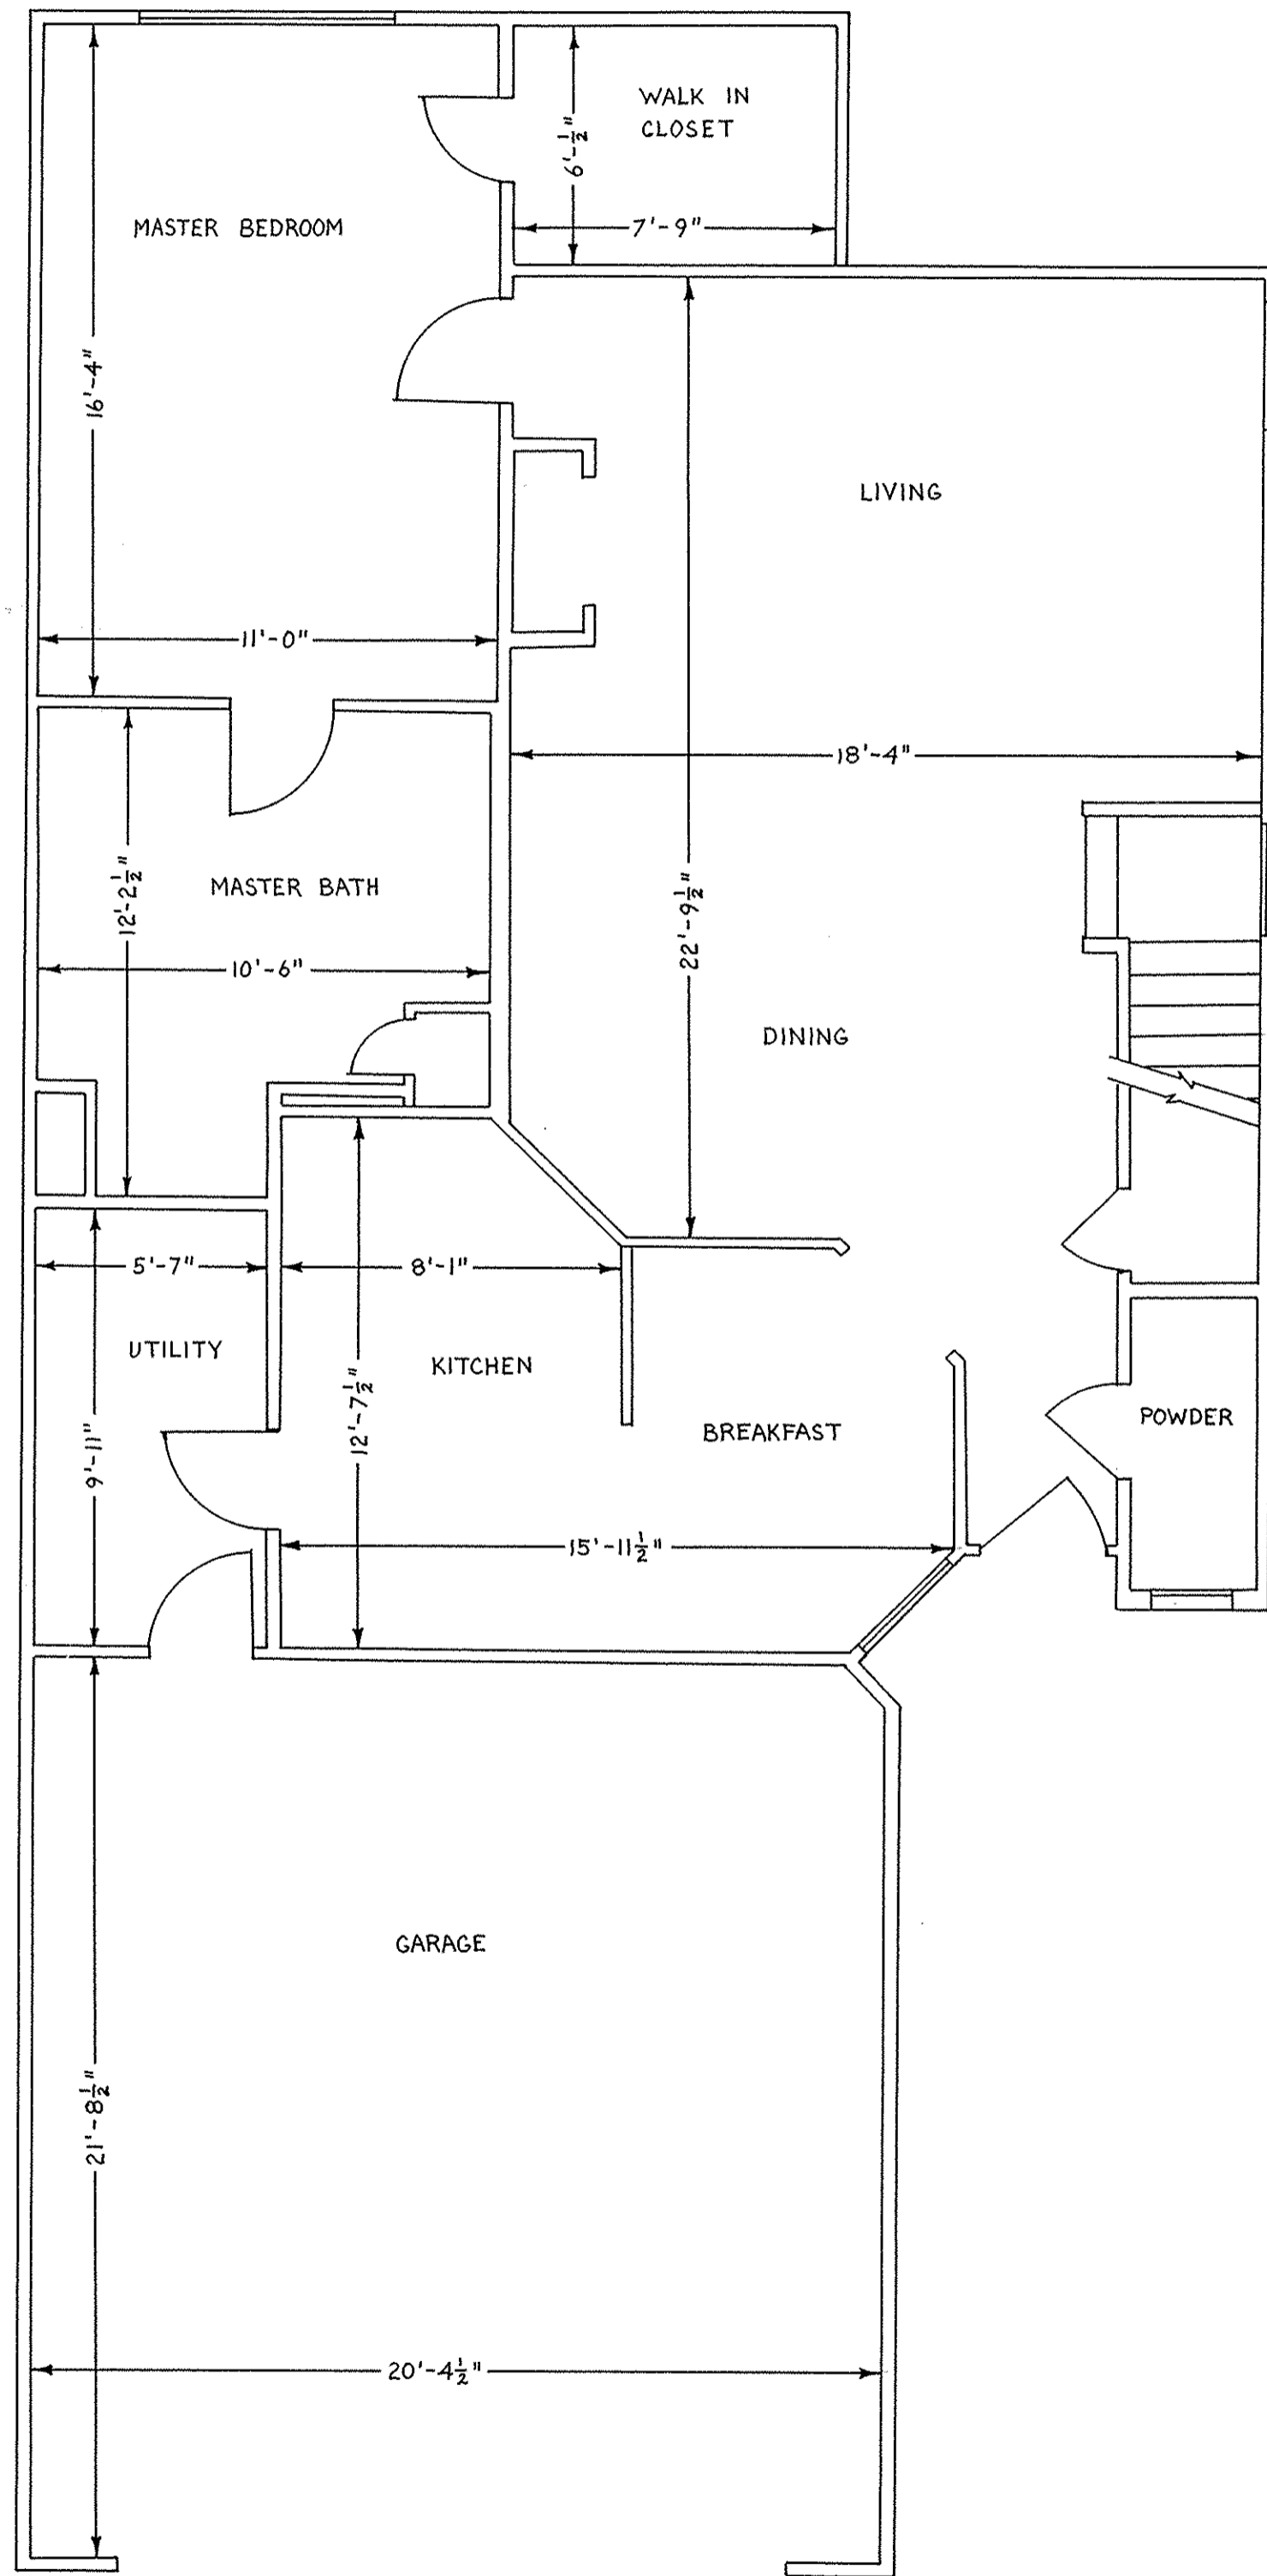

FIRST FLOOR PLAN

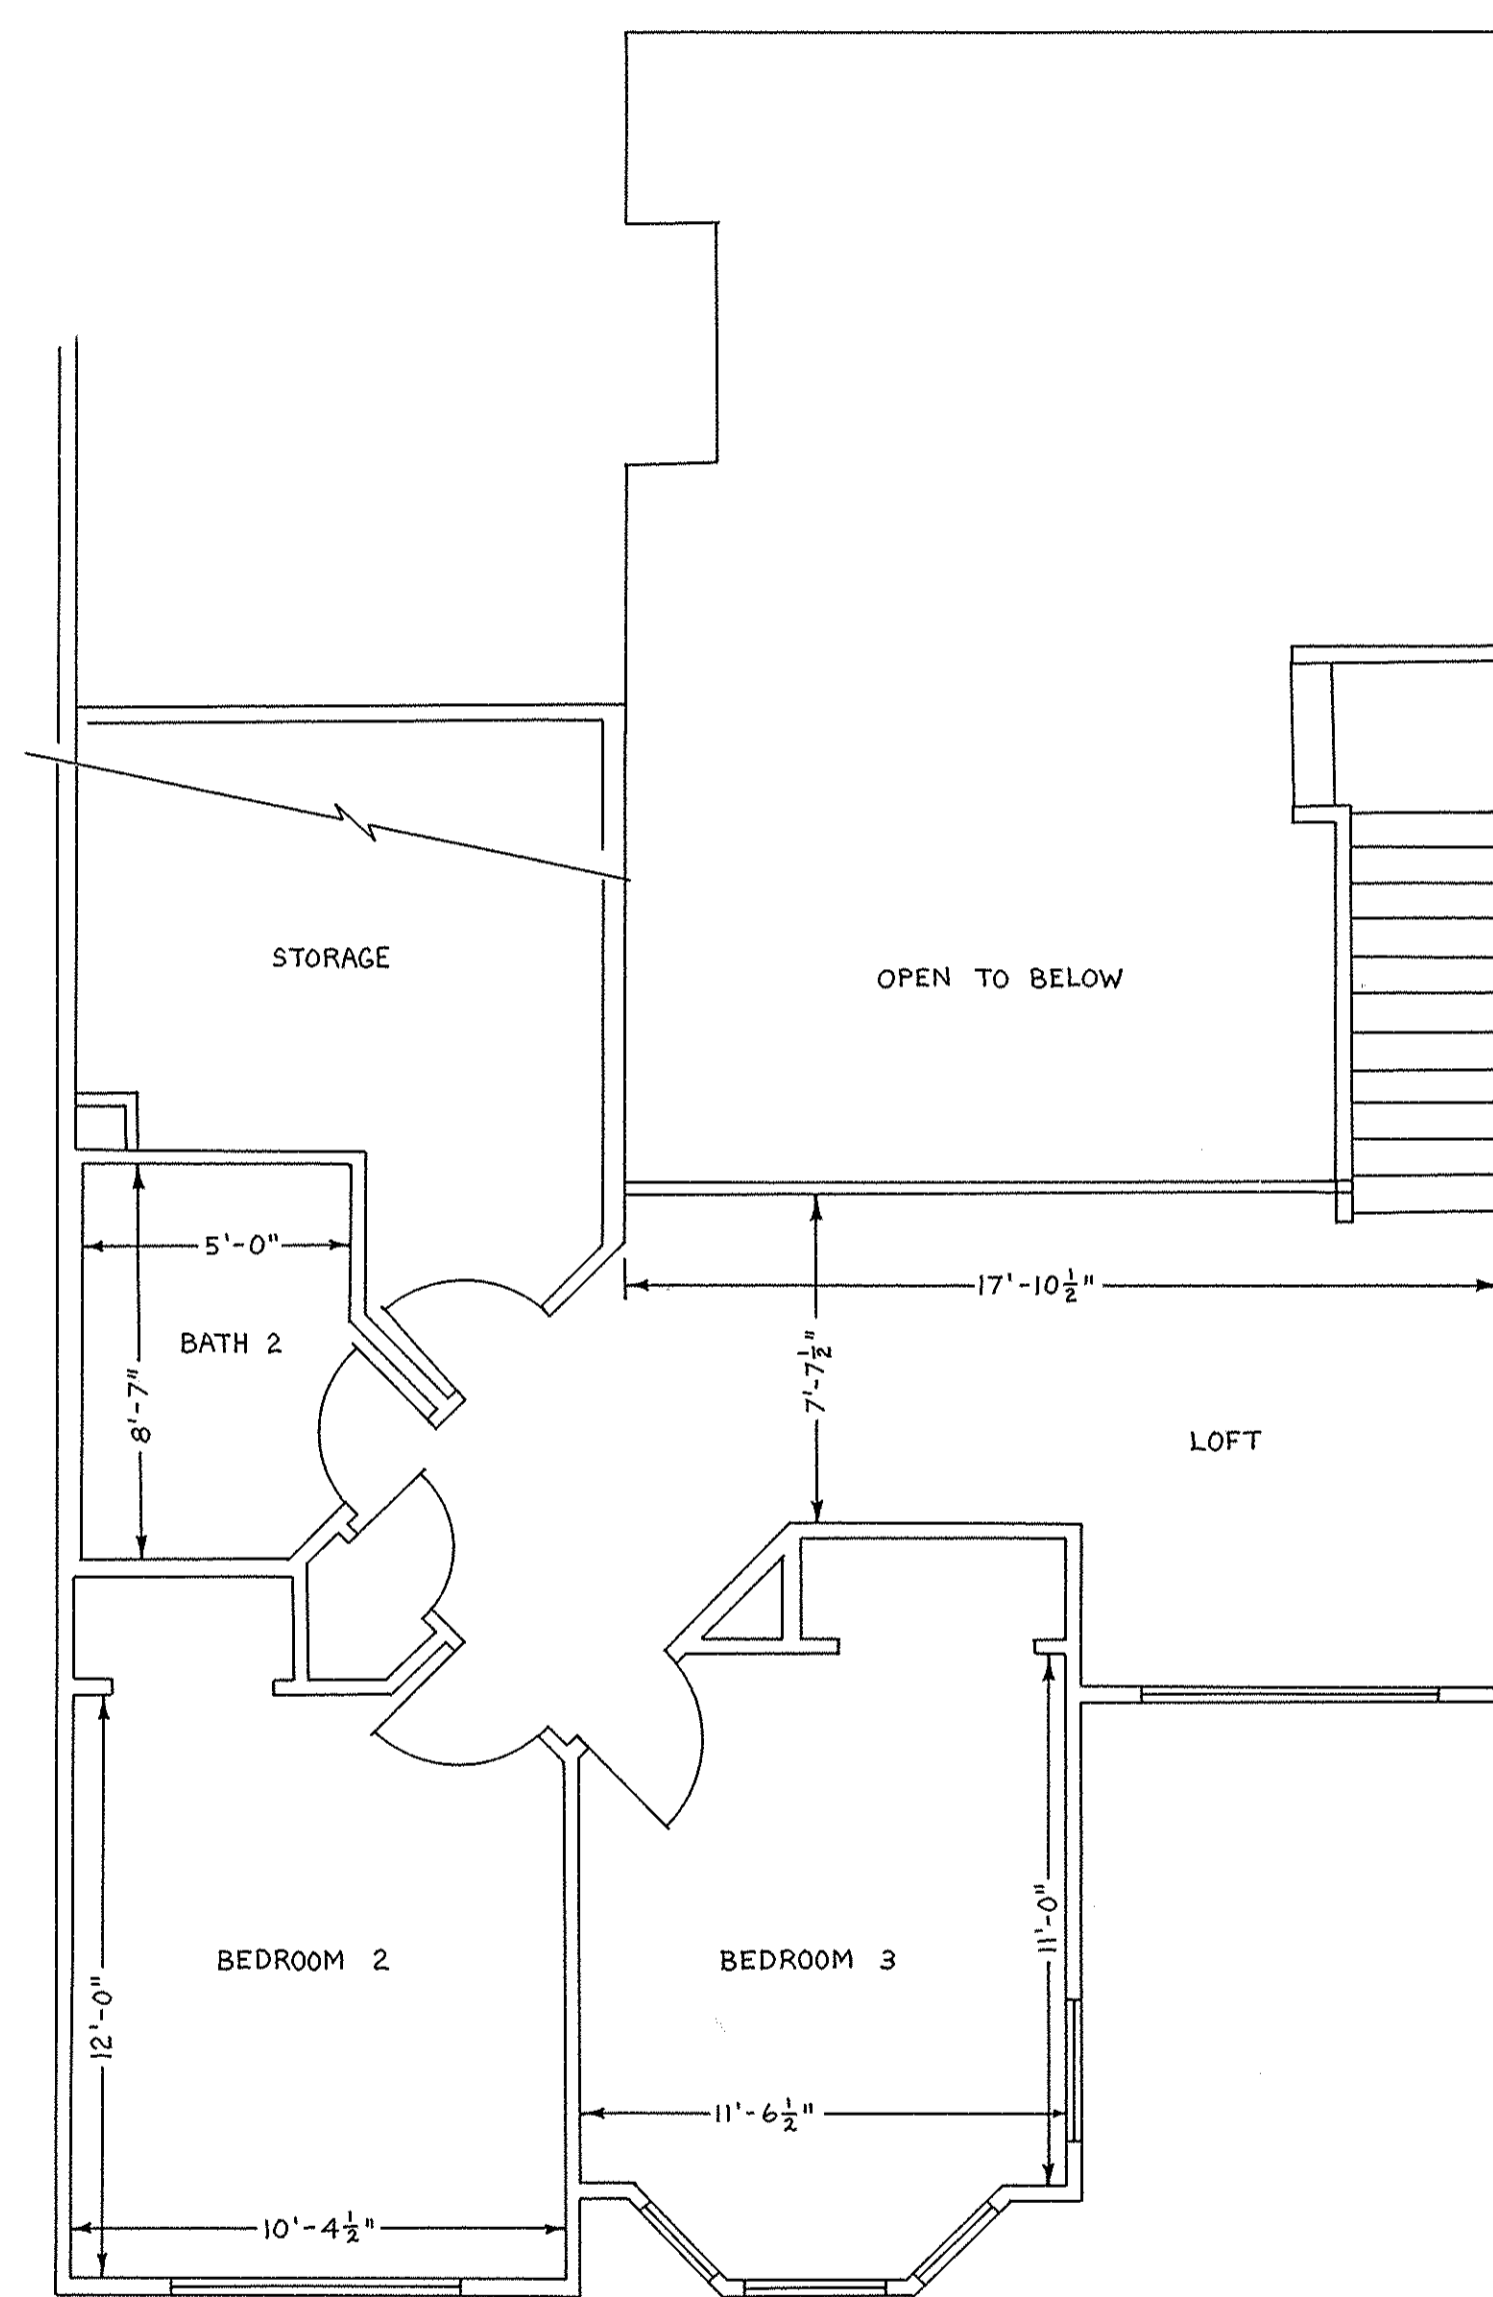


SECOND FLOOR PLAN

SCALE: 1/4" = 1'


UNIT NO. 2-149 : AS SHOWN
 UNIT NO. 7-154 : AS SHOWN
 UNIT NO. 10-157 : AS SHOWN
 UNIT NO. 13-160 : REVERSED

#096566

#096566

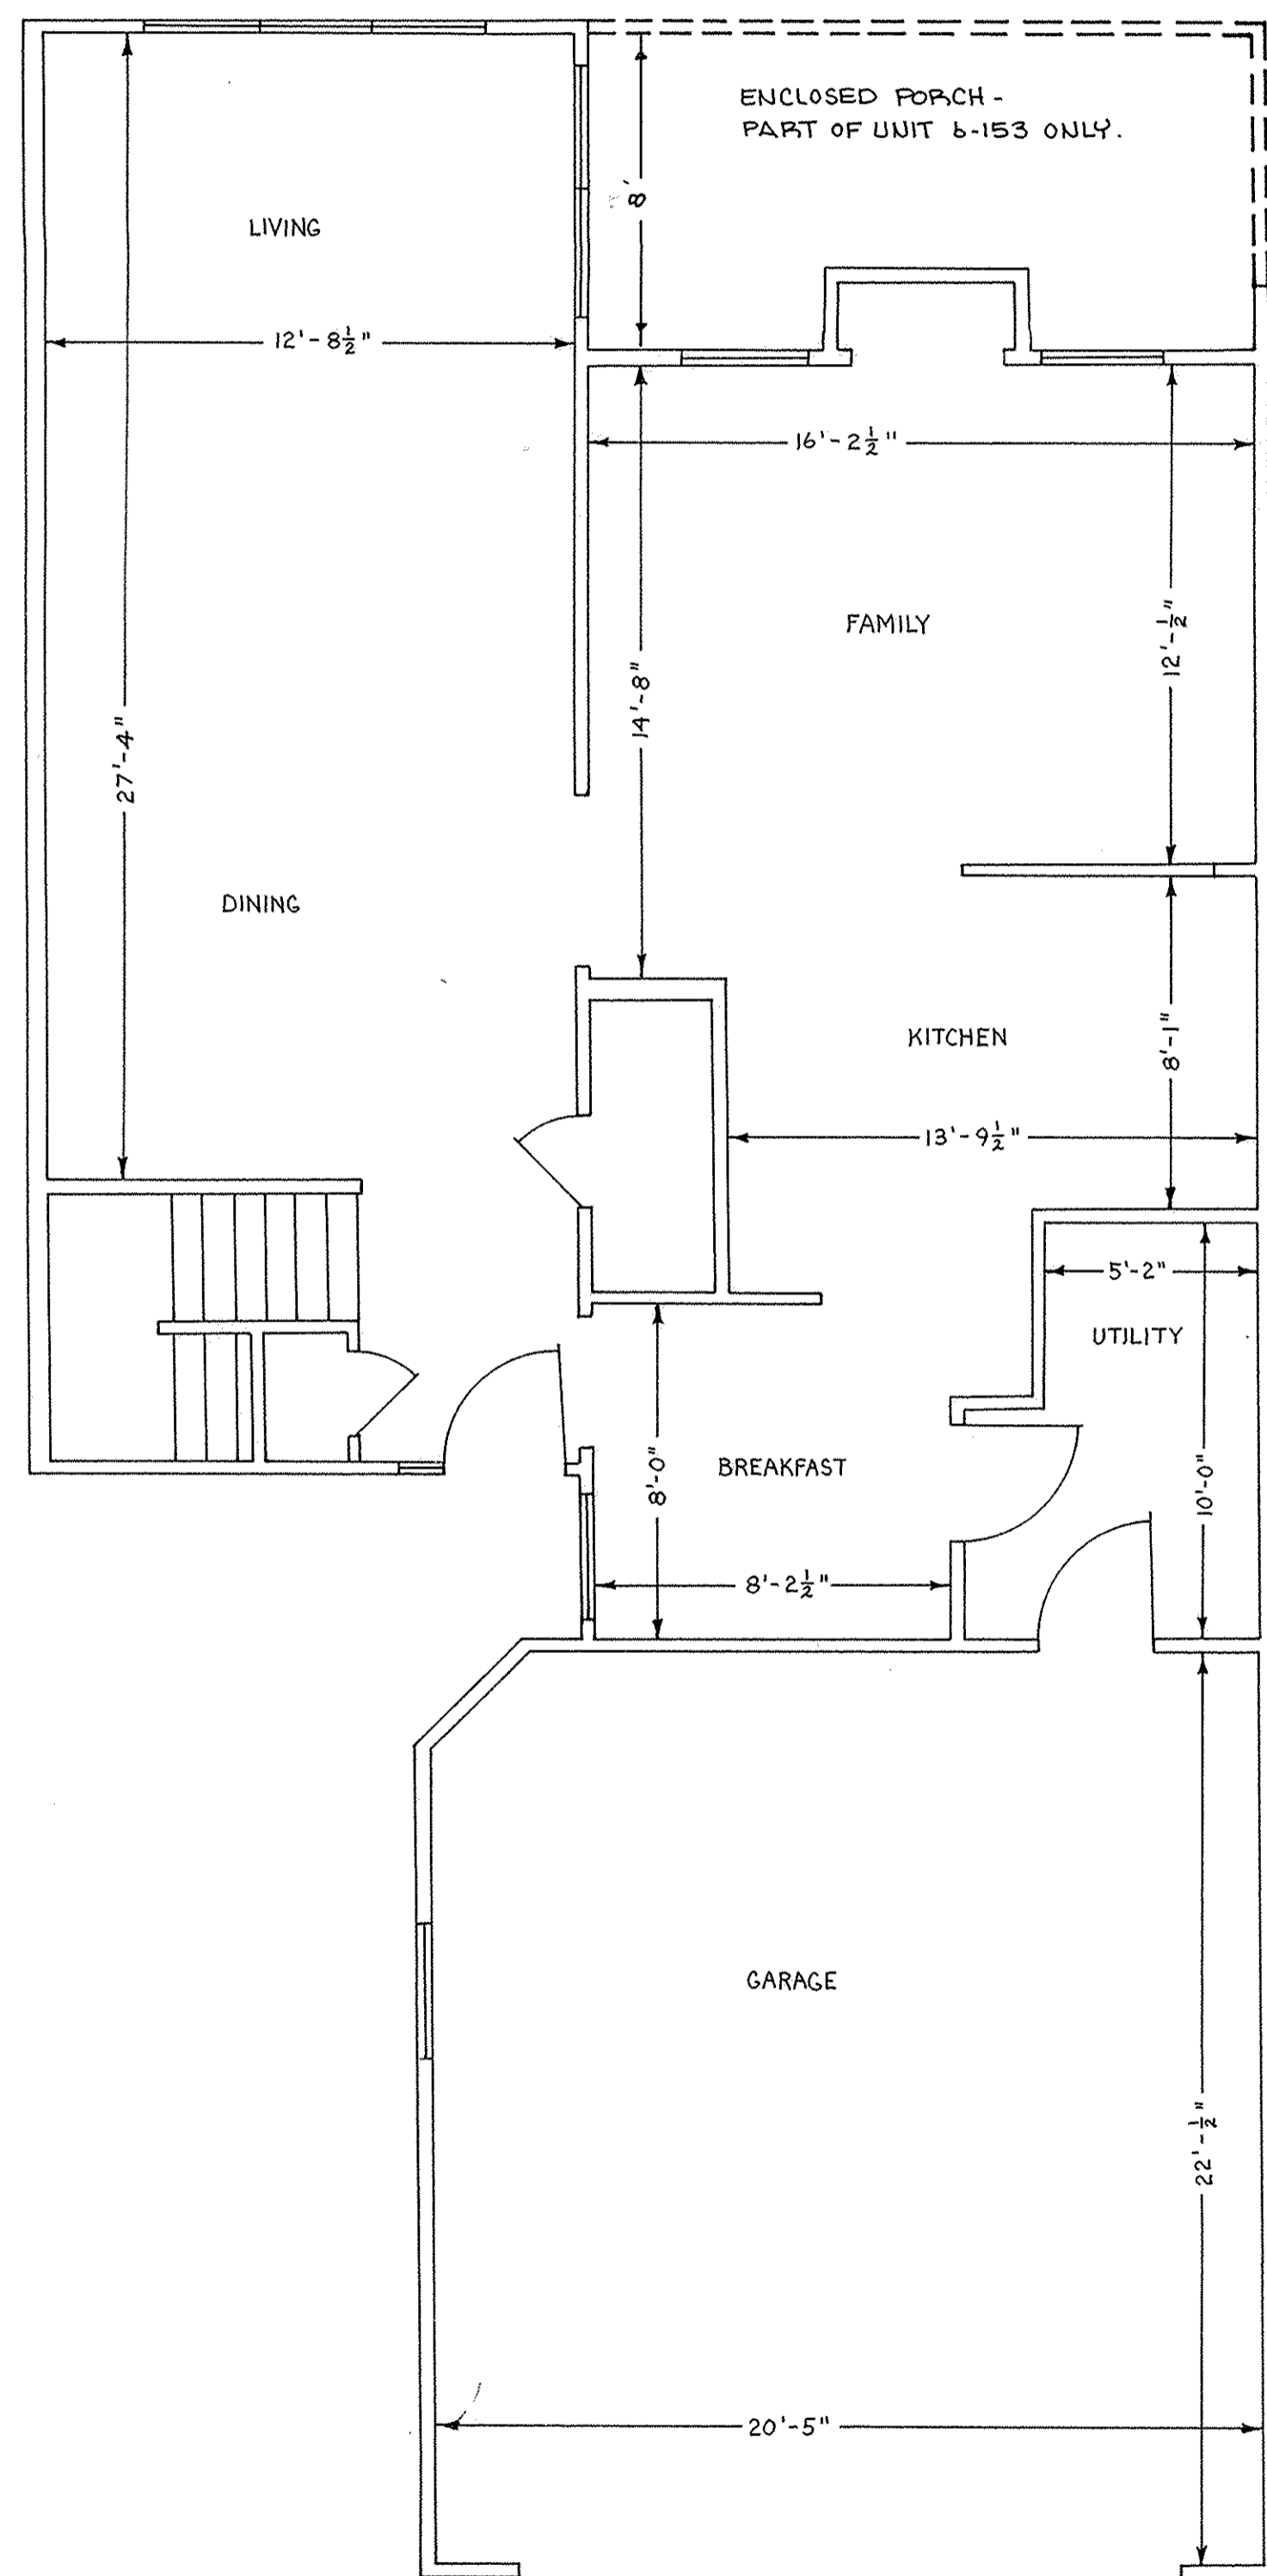

FIRST FLOOR PLAN

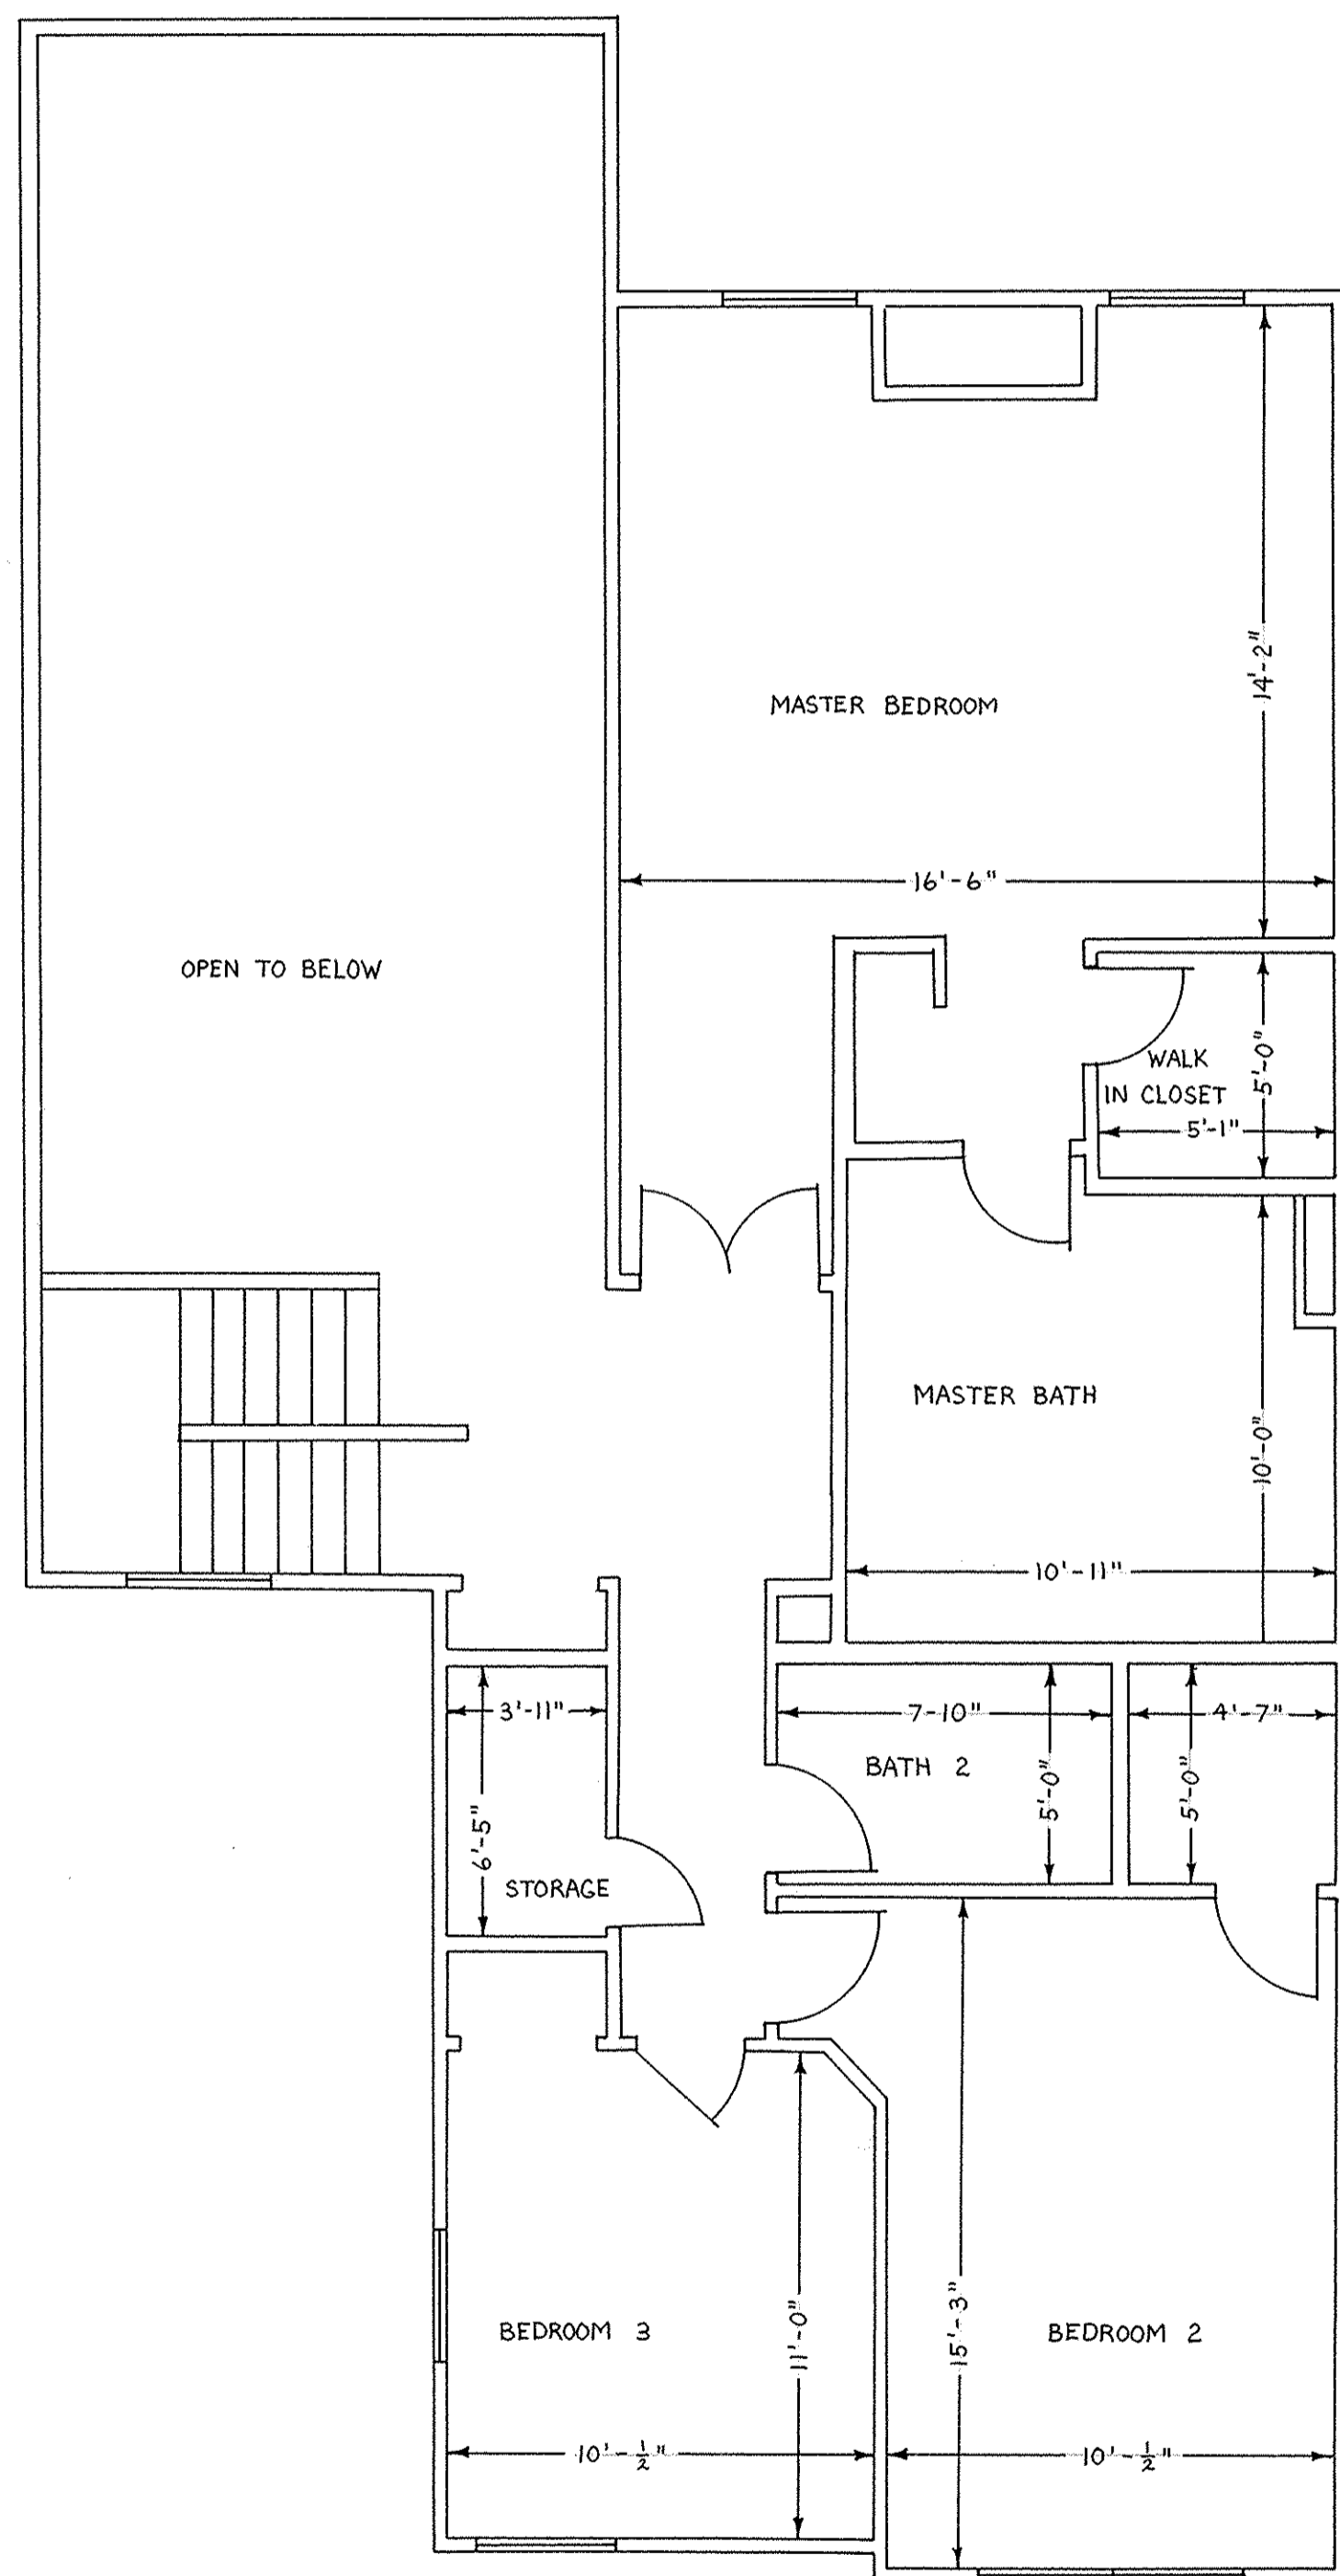

SECOND FLOOR PLAN


UNIT NO. 3-150 : AS SHOWN
 UNIT NO. 6-153 : AS SHOWN
 UNIT NO. 11-158 : AS SHOWN
 UNIT NO. 14-161 : REVERSED

SCALE: 1/4" = 1'


#096566

#096566

UNIT NO. 1-148 : REVERSED
 UNIT NO. 4-151 : AS SHOWN
 UNIT NO. 5-152 : AS SHOWN
 UNIT NO. 8-155 : REVERSED
 UNIT NO. 9-156 : REVERSED
 UNIT NO. 12-159 : AS SHOWN
 UNIT NO. 15-162 : REVERSED

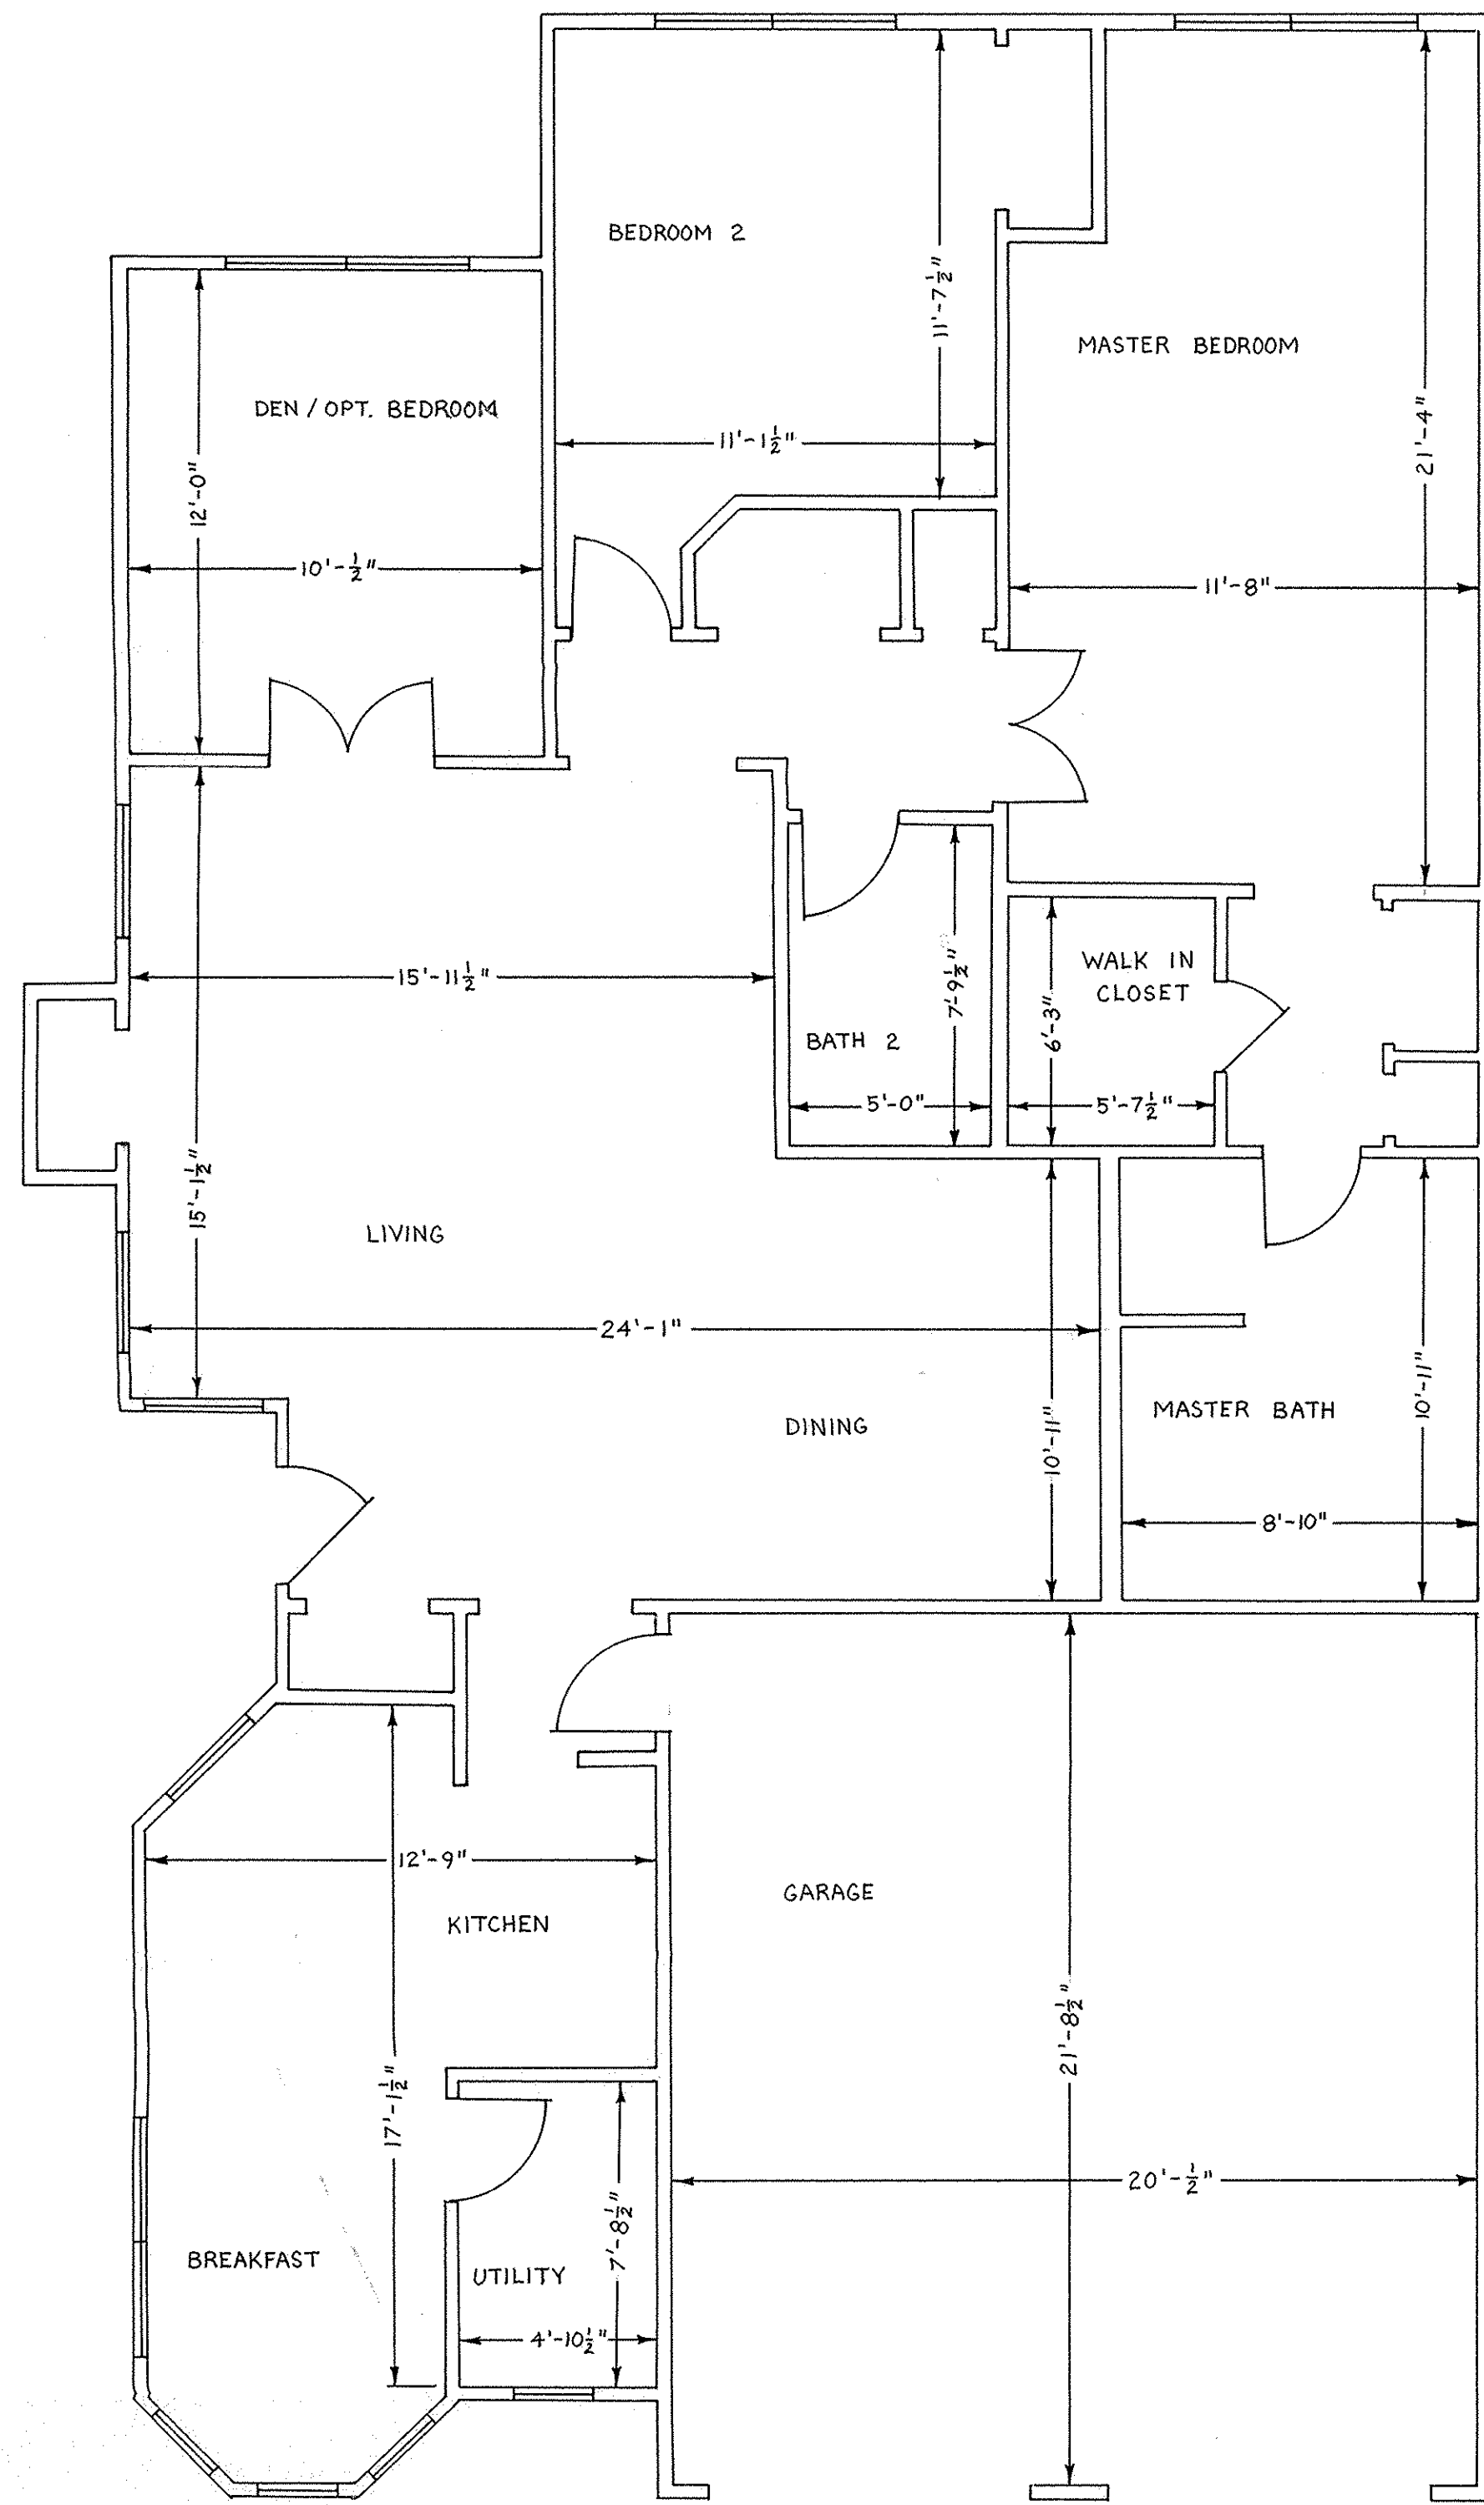


SCALE: 1/4" = 1'

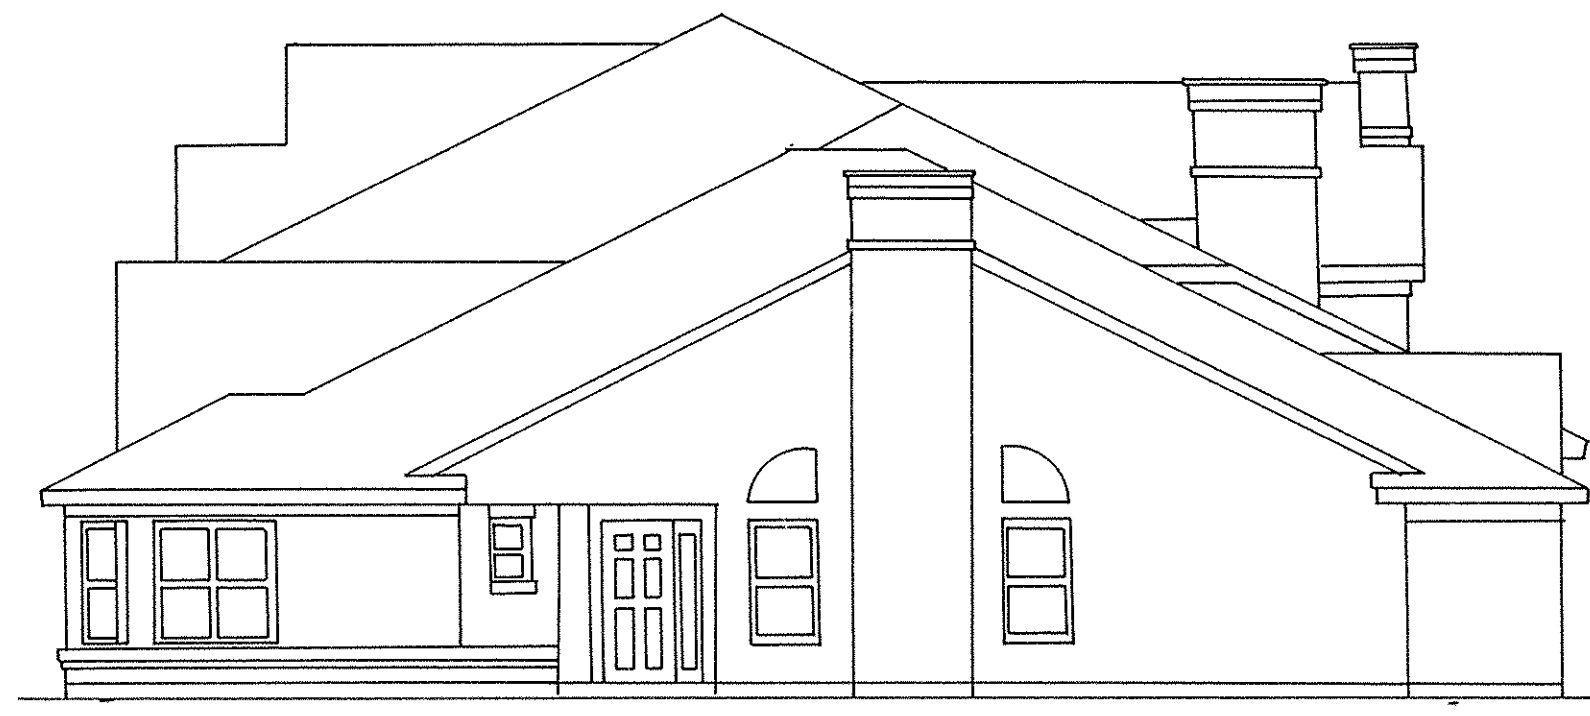

RIGHT SIDE ELEVATION



LEFT SIDE ELEVATION

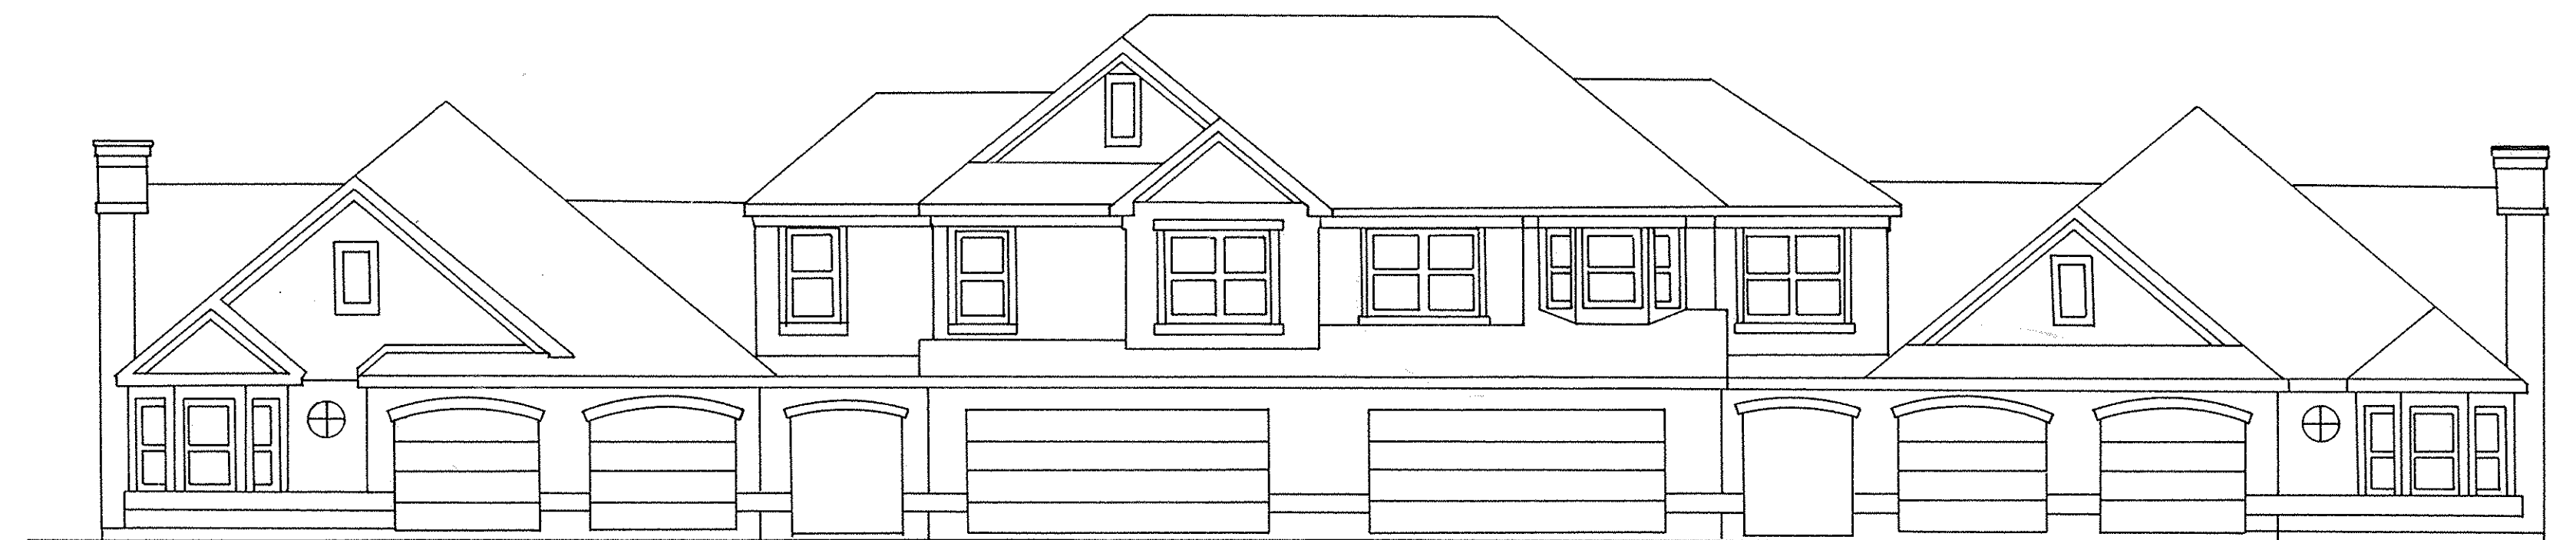

FRONT ELEVATION



REAR ELEVATION

LORAIN COUNTY TAX
MAP DEPARTMENT COPY