
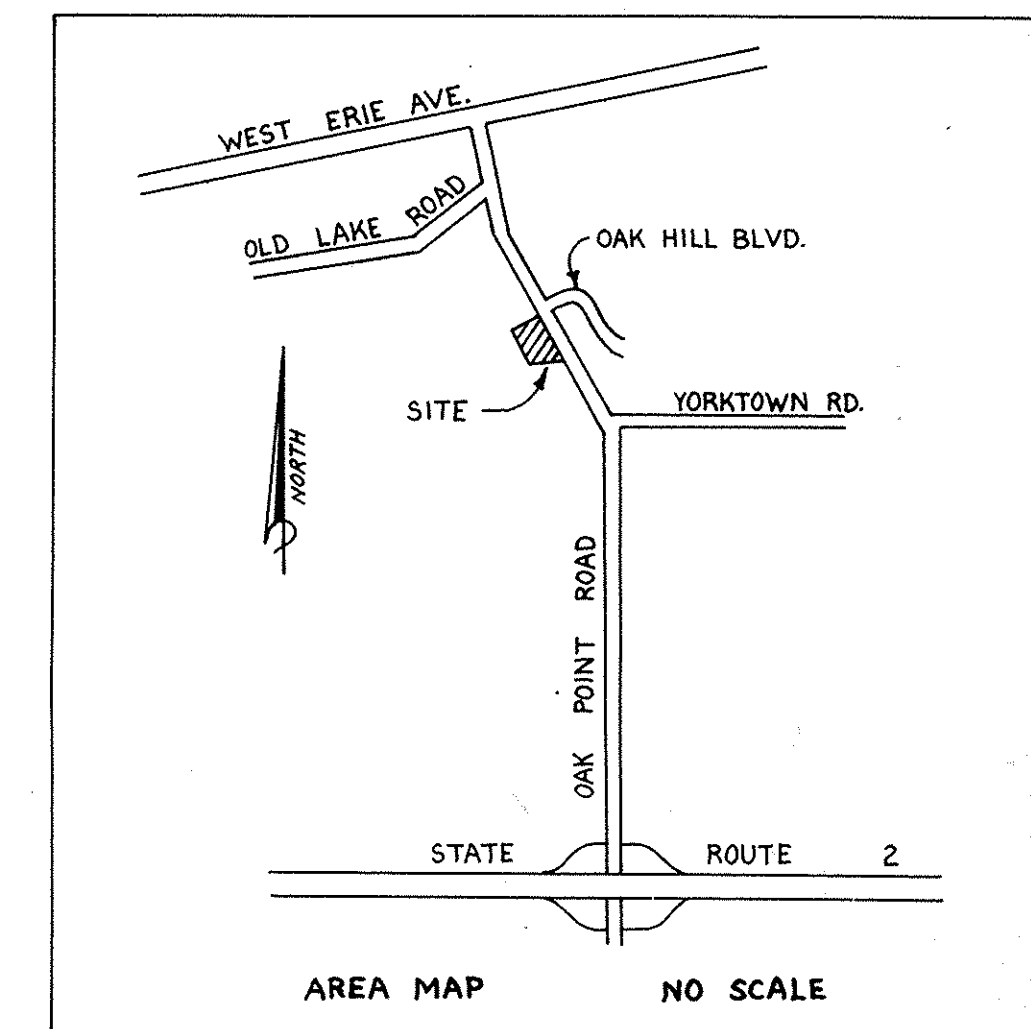
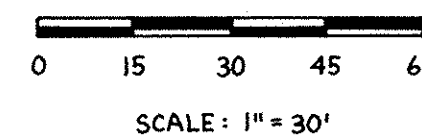
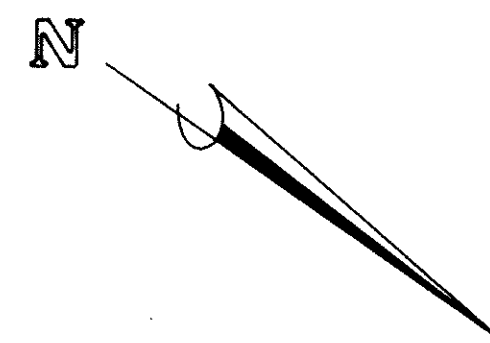
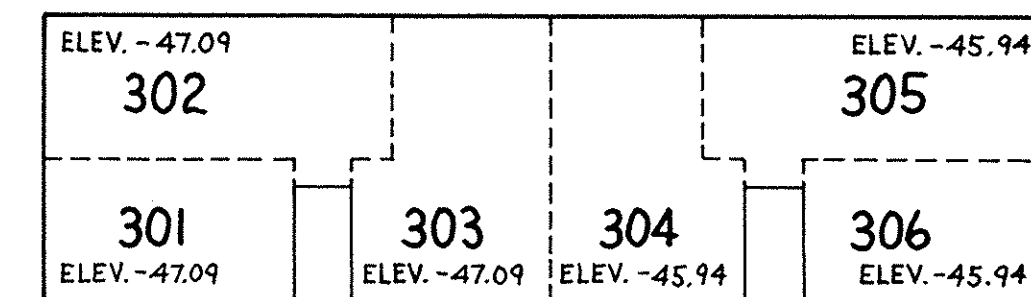
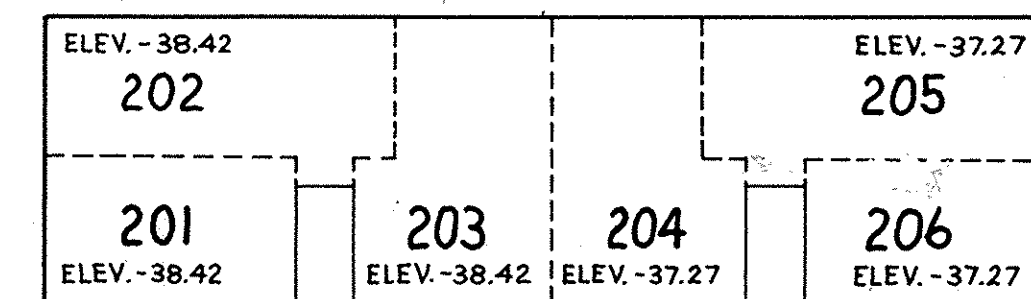
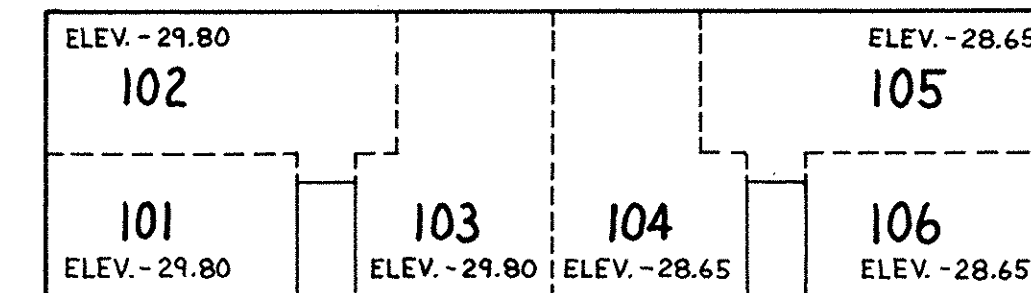
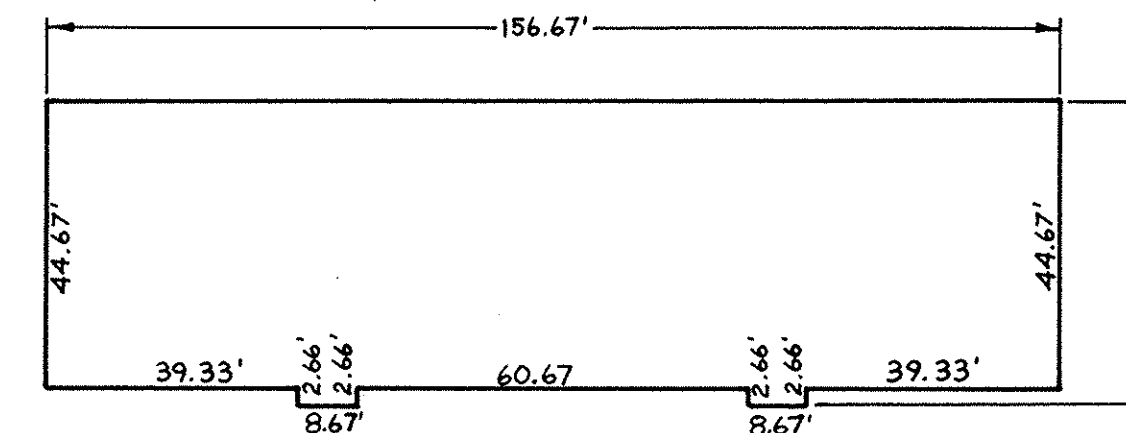


097489

45/55
097489

OAK POINT PARTNERSHIP O.R.V. 192 P. 543

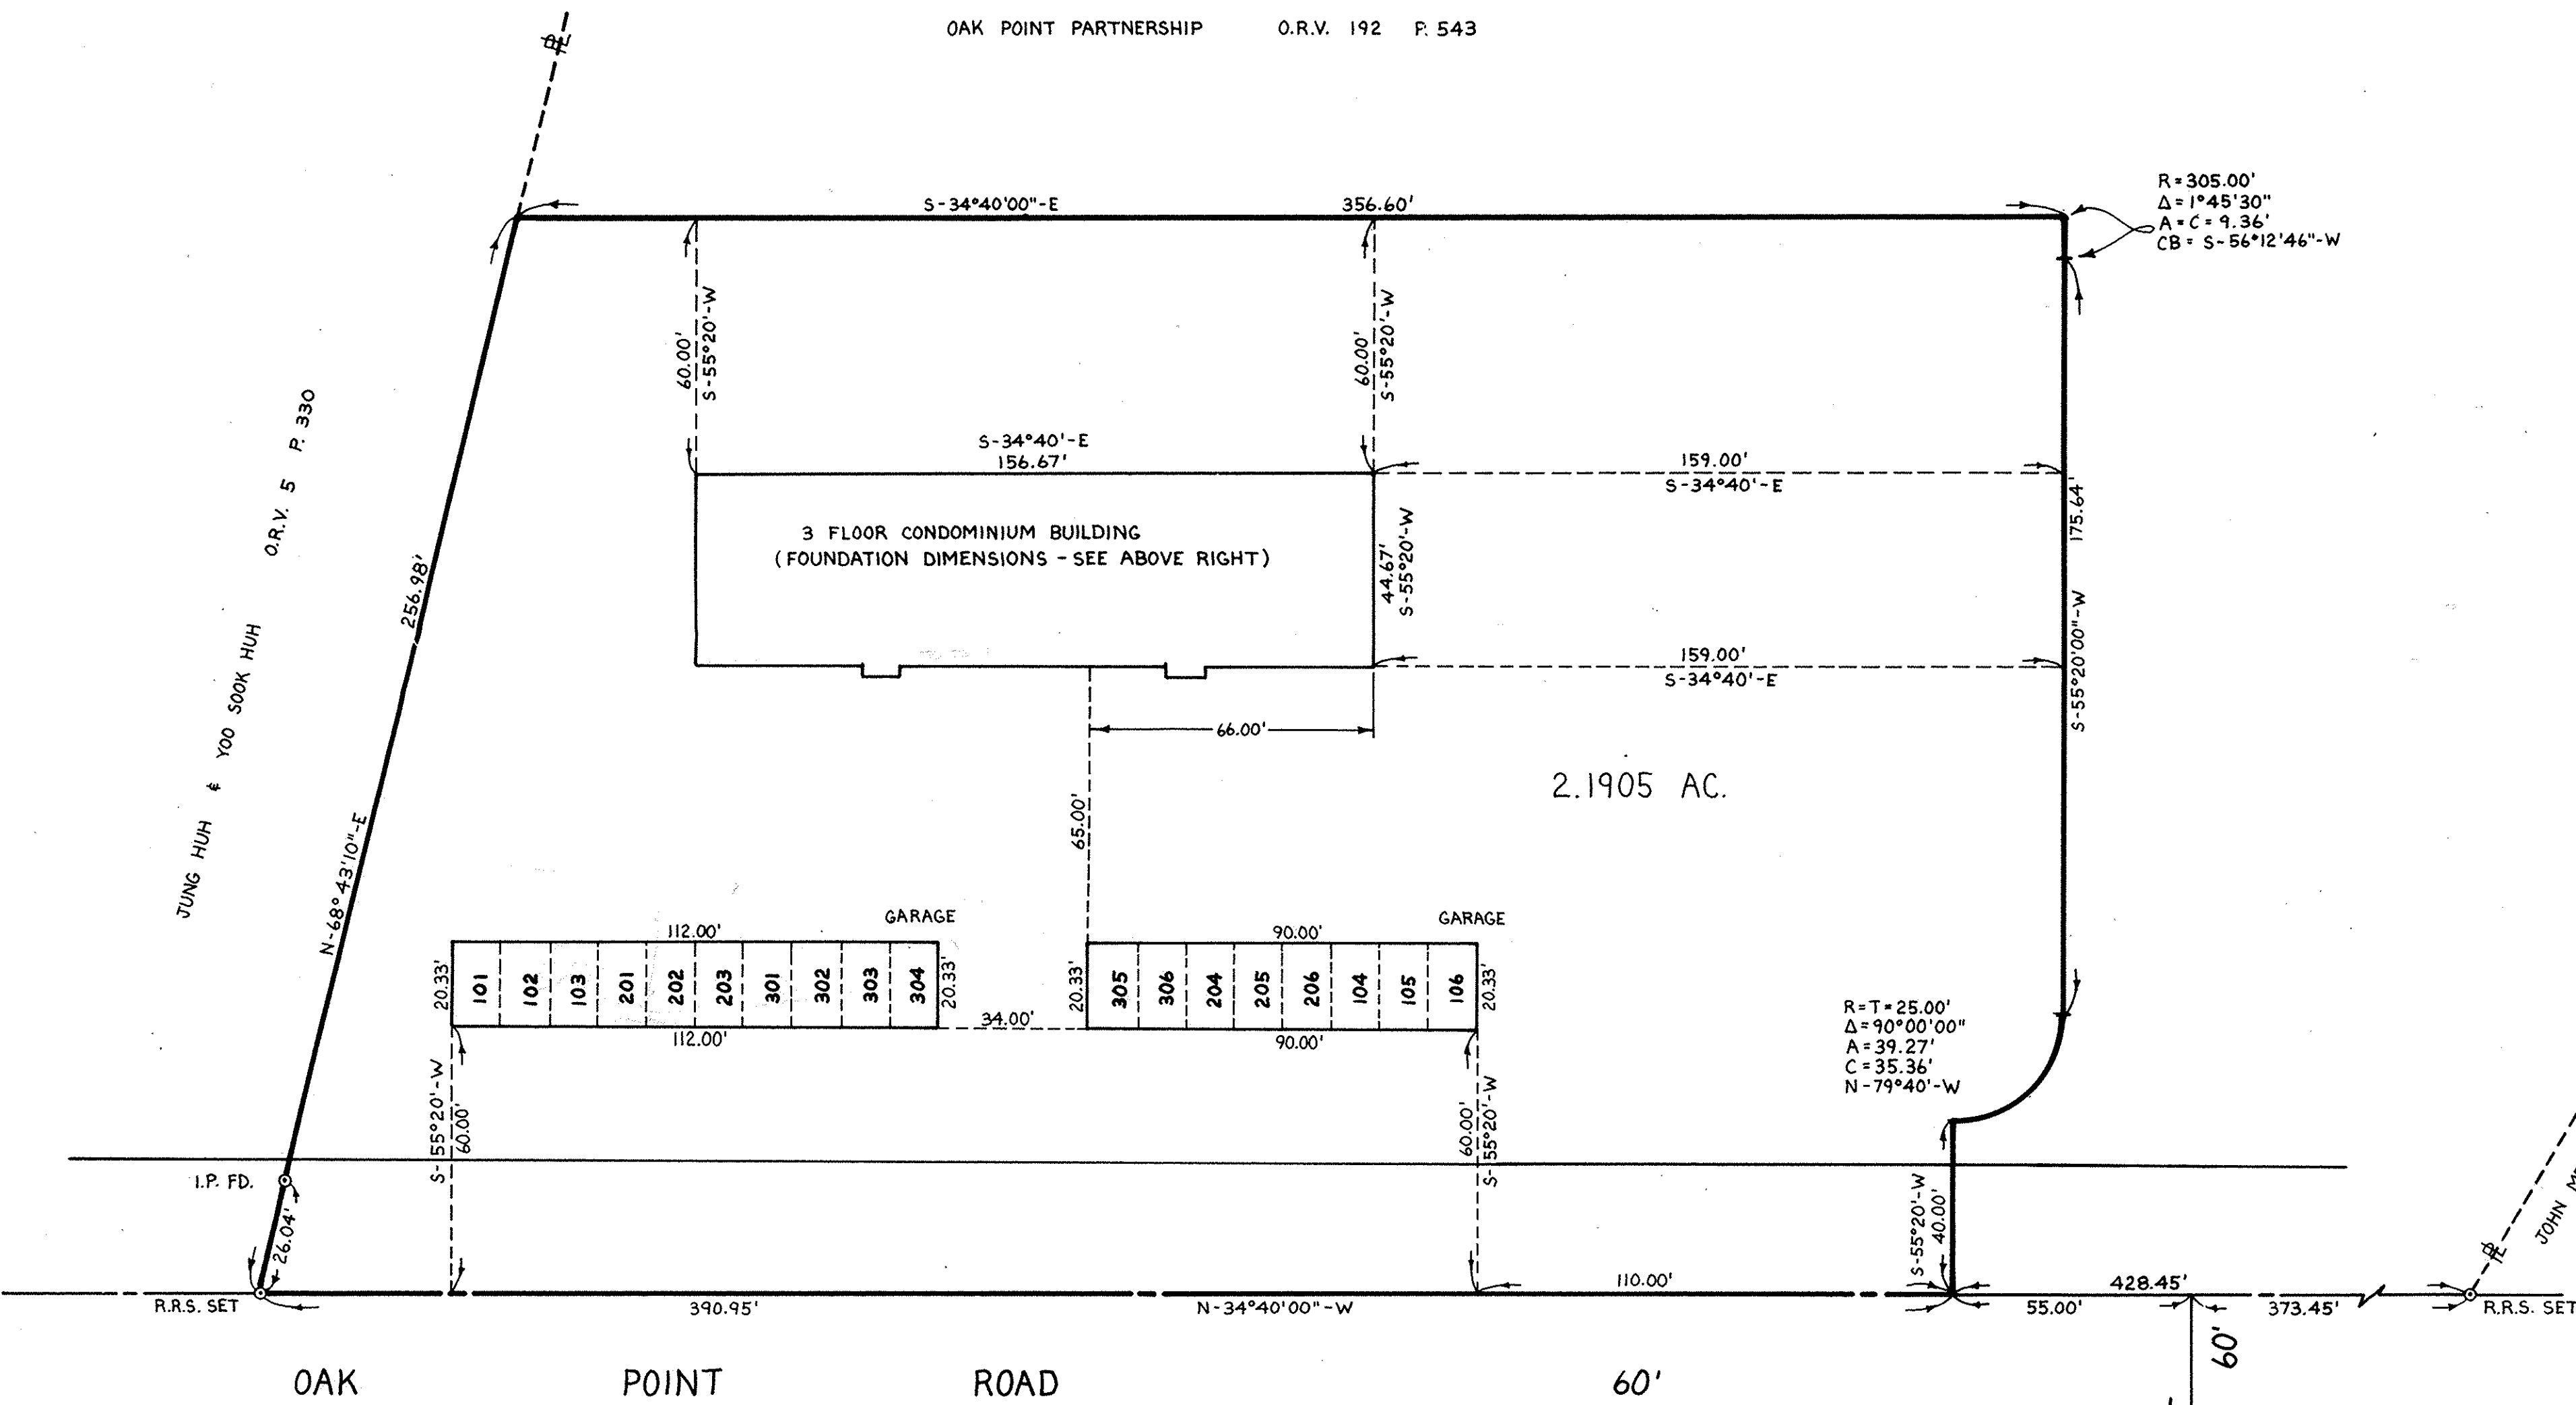


SHEET INDEX	
SHEET NO.	DESCRIPTION
1	SURVEY MAP & MISC.
2	FOUNDATION & OVERALL PLAN
3	FLOOR PLAN - RIGHT HALF
4	FLOOR PLAN - LEFT HALF
5	ELEVATIONS

UNIT NO.	AREA (S.F.)	% OWNERSHIP
101	866	4.45
102	1198	6.15
103	1181	6.07
104	1181	6.07
105	1198	6.15
106	866	4.45
201	866	4.45
202	1198	6.15
203	1181	6.07
204	1181	6.07
205	1198	6.15
206	866	4.45
301	866	4.45
302	1198	6.15
303	1181	6.07
304	1181	6.07
305	1198	6.15
306	866	4.45
TOTAL		100


CERTIFICATION:

THIS IS TO CERTIFY THAT THE ATTACHED DRAWINGS CORRECTLY REPRESENT THE BUILDINGS AS CONSTRUCTED AND THAT THERE ARE NO ENCROACHMENTS ON ADJACENT PROPERTIES.

David L. Elwell
DAVID L. ELWELL
REG. SURVEYOR NO. 6333

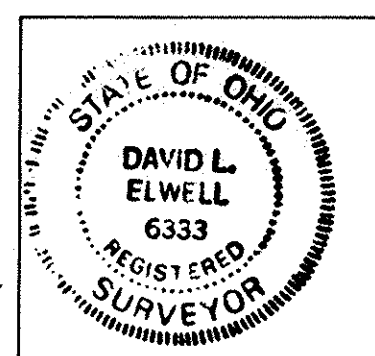

Mark Skellenger
MARK SKELLENGER
REG. ENGINEER NO. 46461

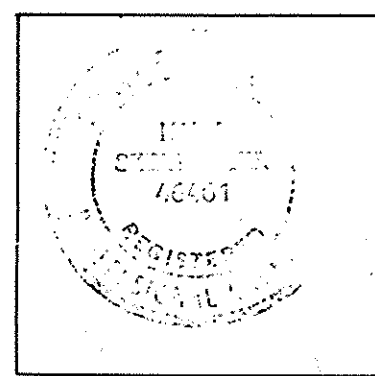

Received for Record
at 3:00 clock P.M. in Plat RECORD
VOL. 45
PAGE 557
DOROTHY L. ESSEX
Lorain County Recorder
59mil

TRANSFERRED
IN COMPLIANCE WITH SEC. 319.202
OHIO REV. CODE
MAY 18 1990
JULIAN A. IJOR
LORAIN COUNTY AUDITOR

LORAIN COUNTY RECORDER 21600 LORAIN COUNTY AUDITOR

HIDDEN CREEK CONDOMINIUMS




PART OF
BLACK RIVER TOWNSHIP · ORIGINAL LOT 4 · TRACT 3
CITY OF LORAIN · COUNTY OF LORAIN · STATE OF OHIO


LORAIN COUNTY
TAX MAP DEPARTMENT
COPY

Box: Lorain County Title Co.
S.K.




SHEET 1 of 5

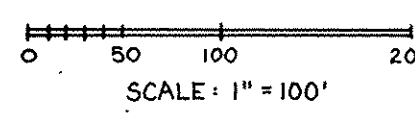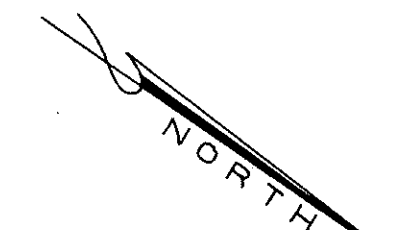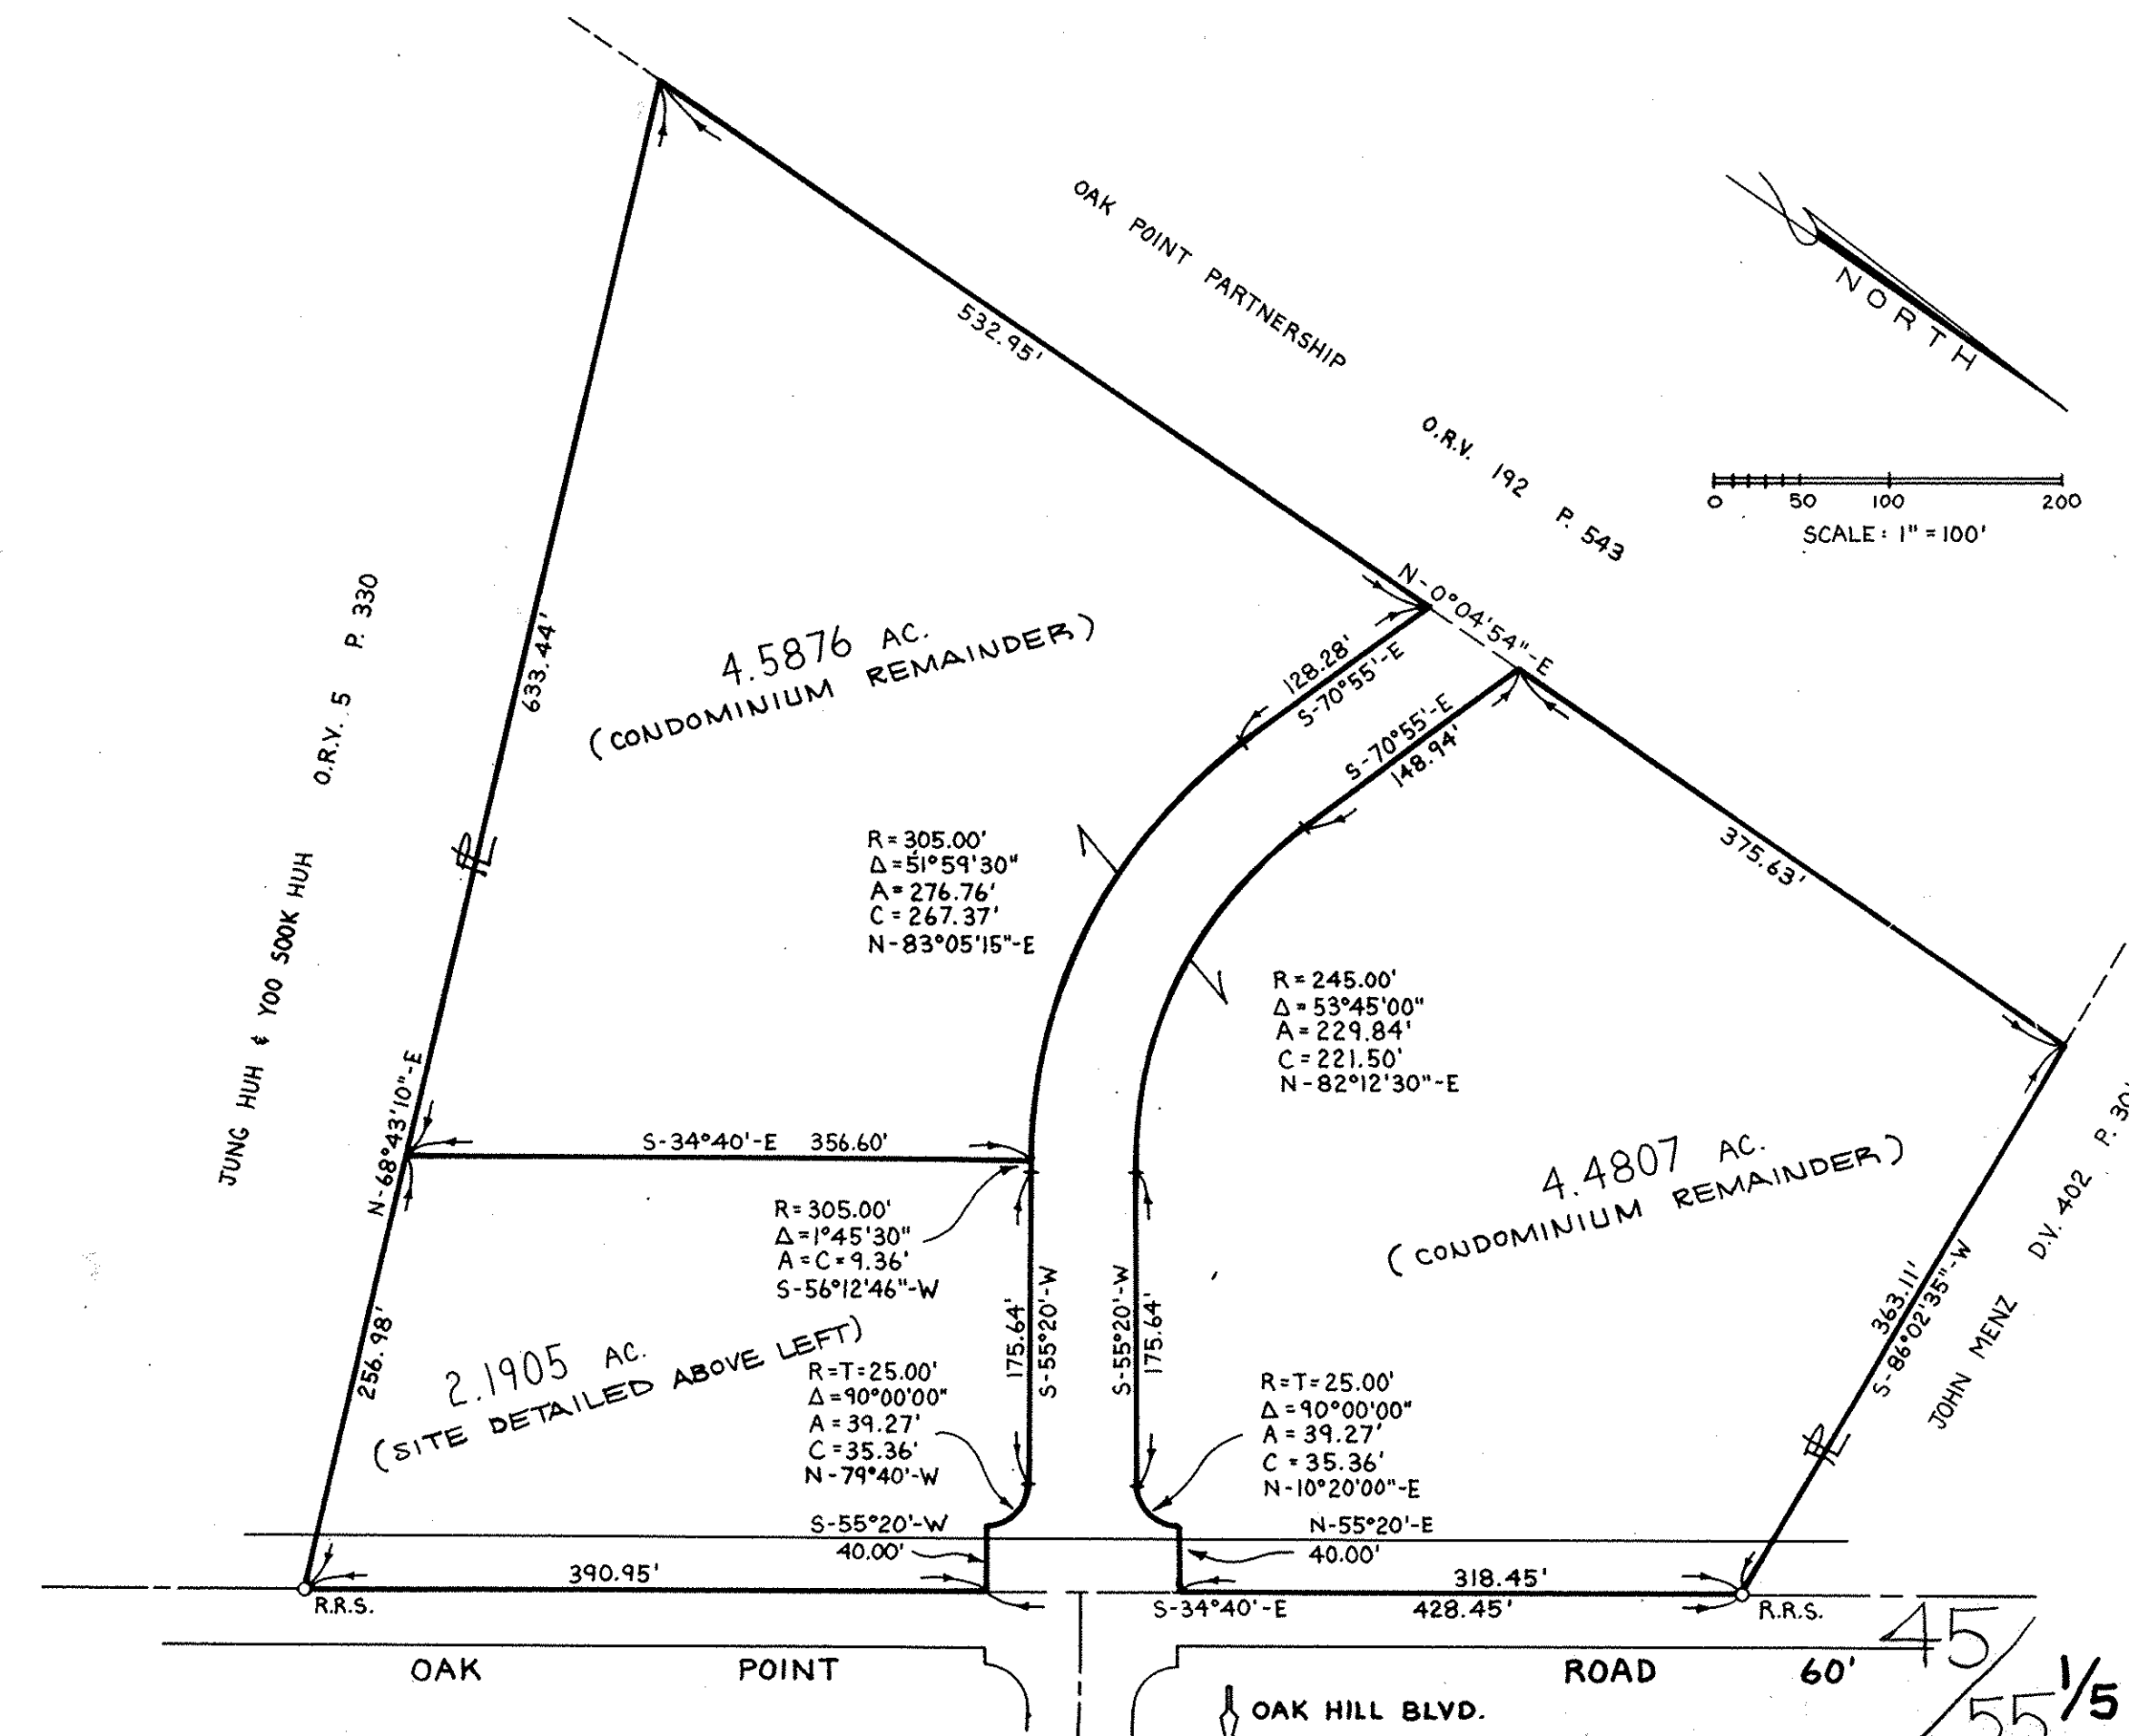


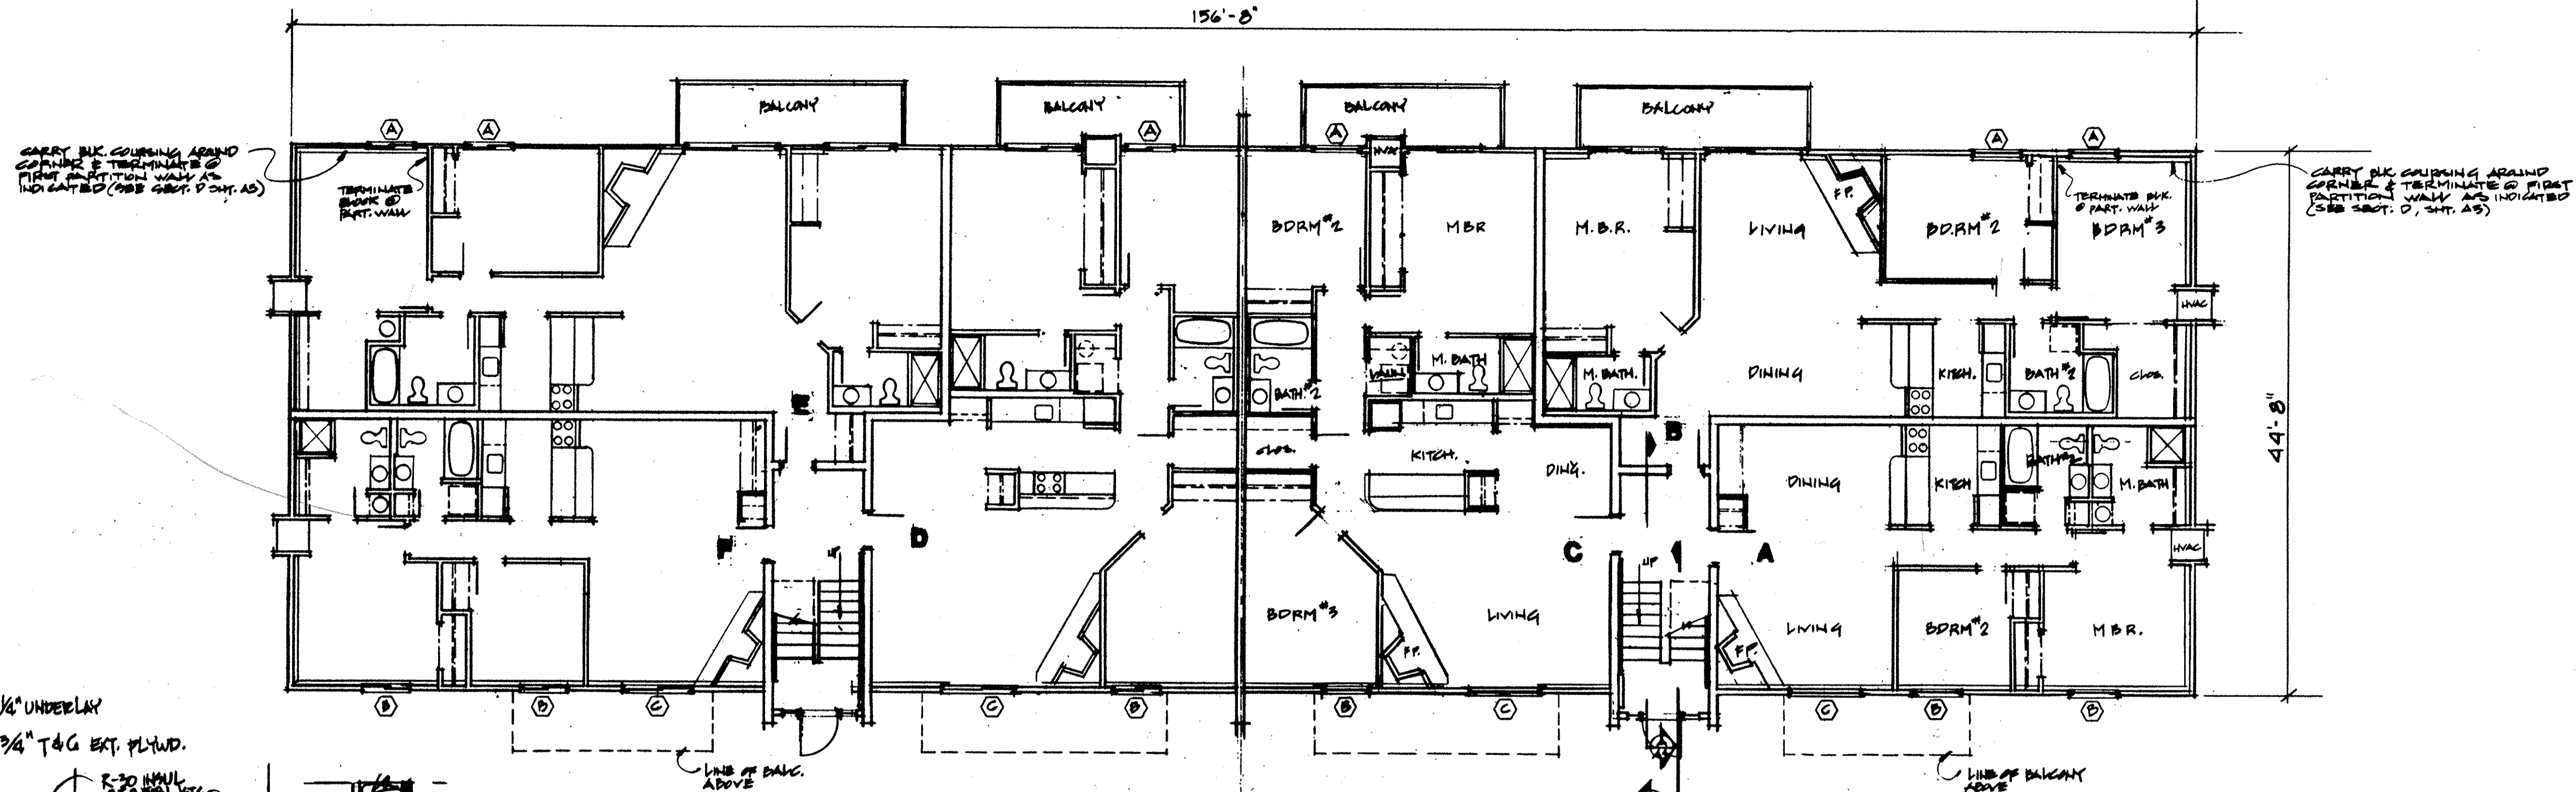

TYPICAL FLOOR PLAN
1/8" = 1'-0"

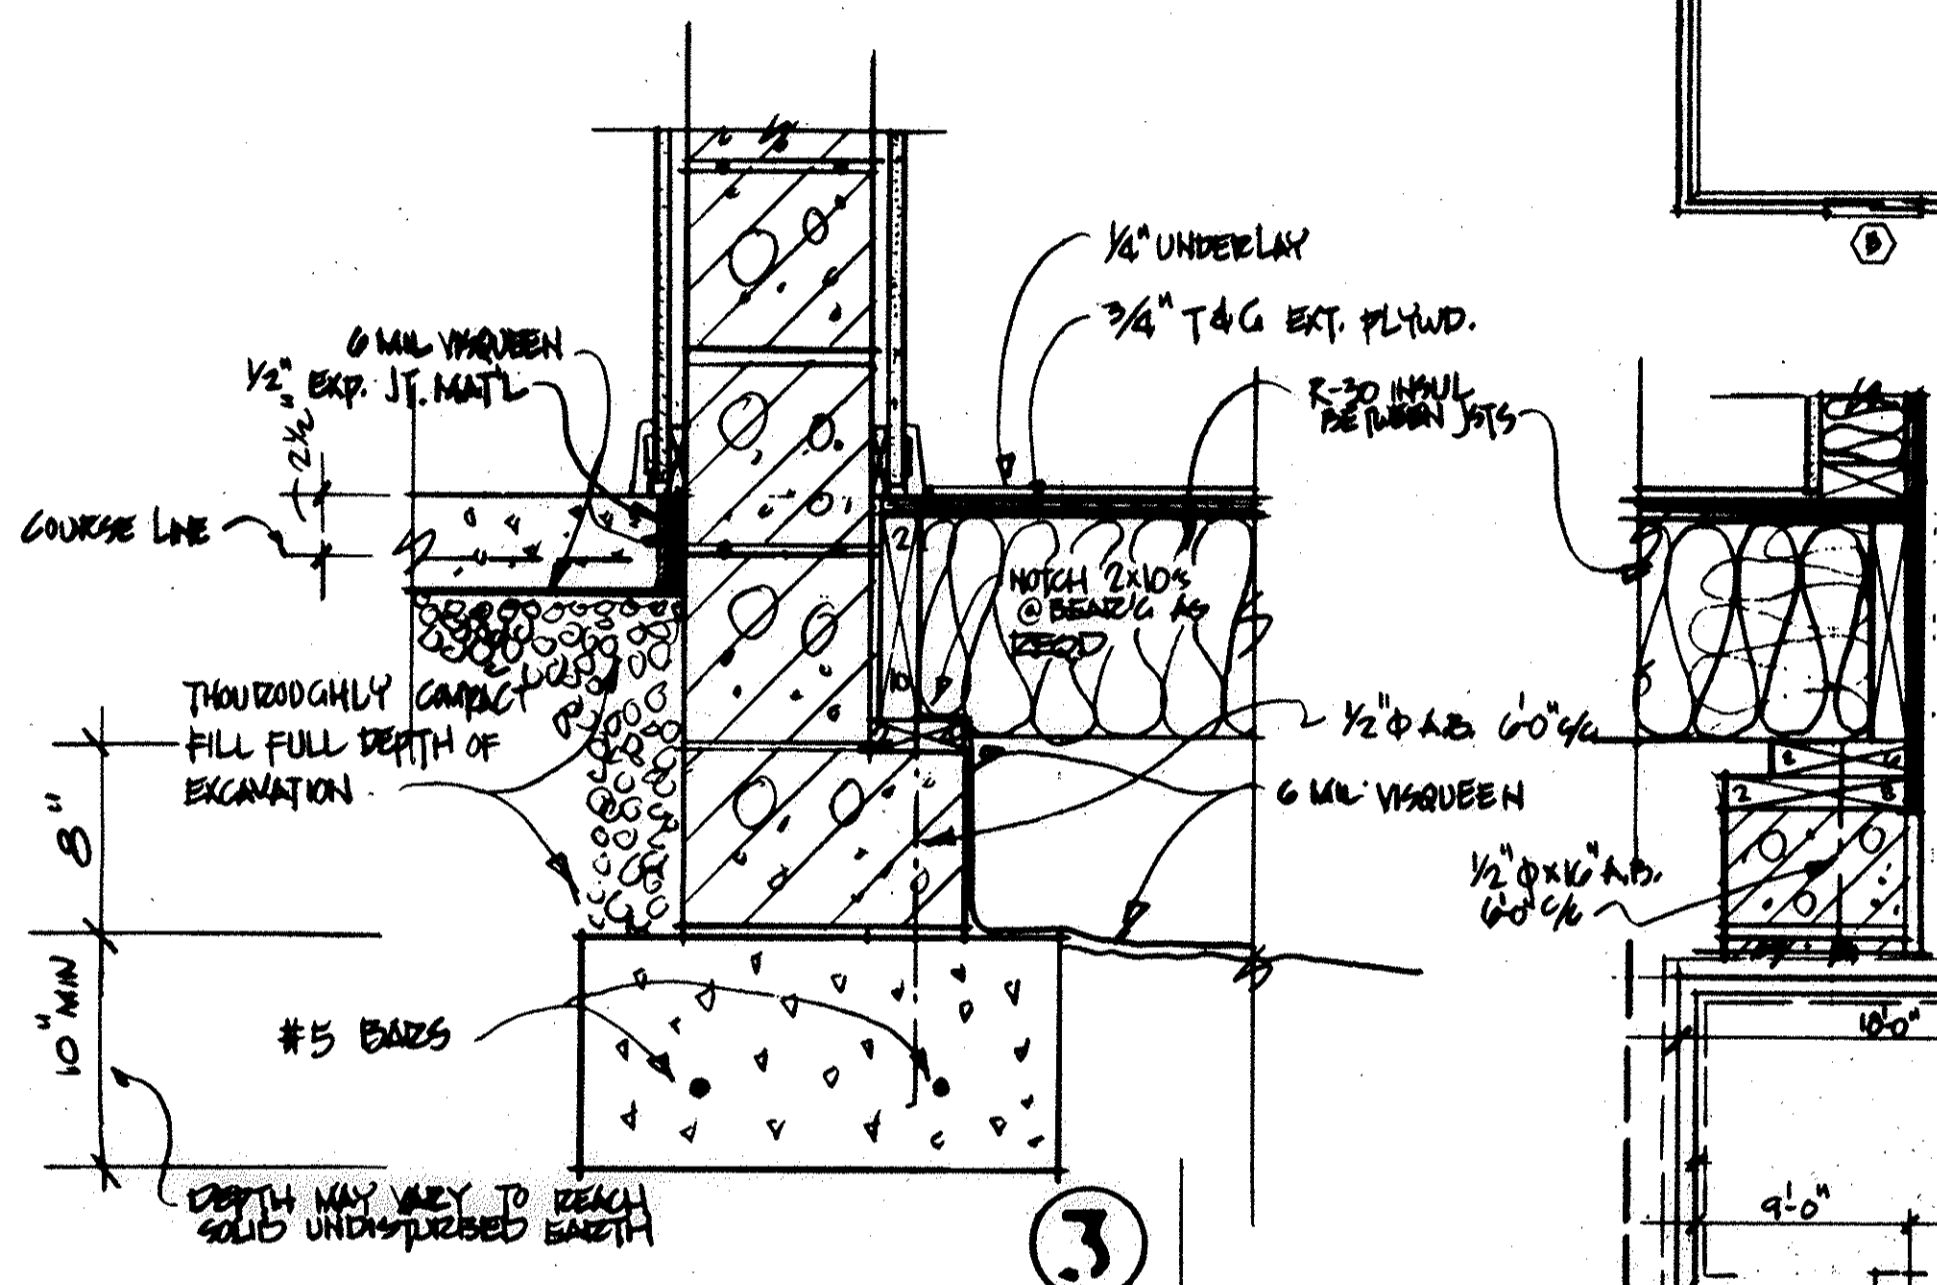

1 FOOTING DETAILS 2
1" = 1'-0"

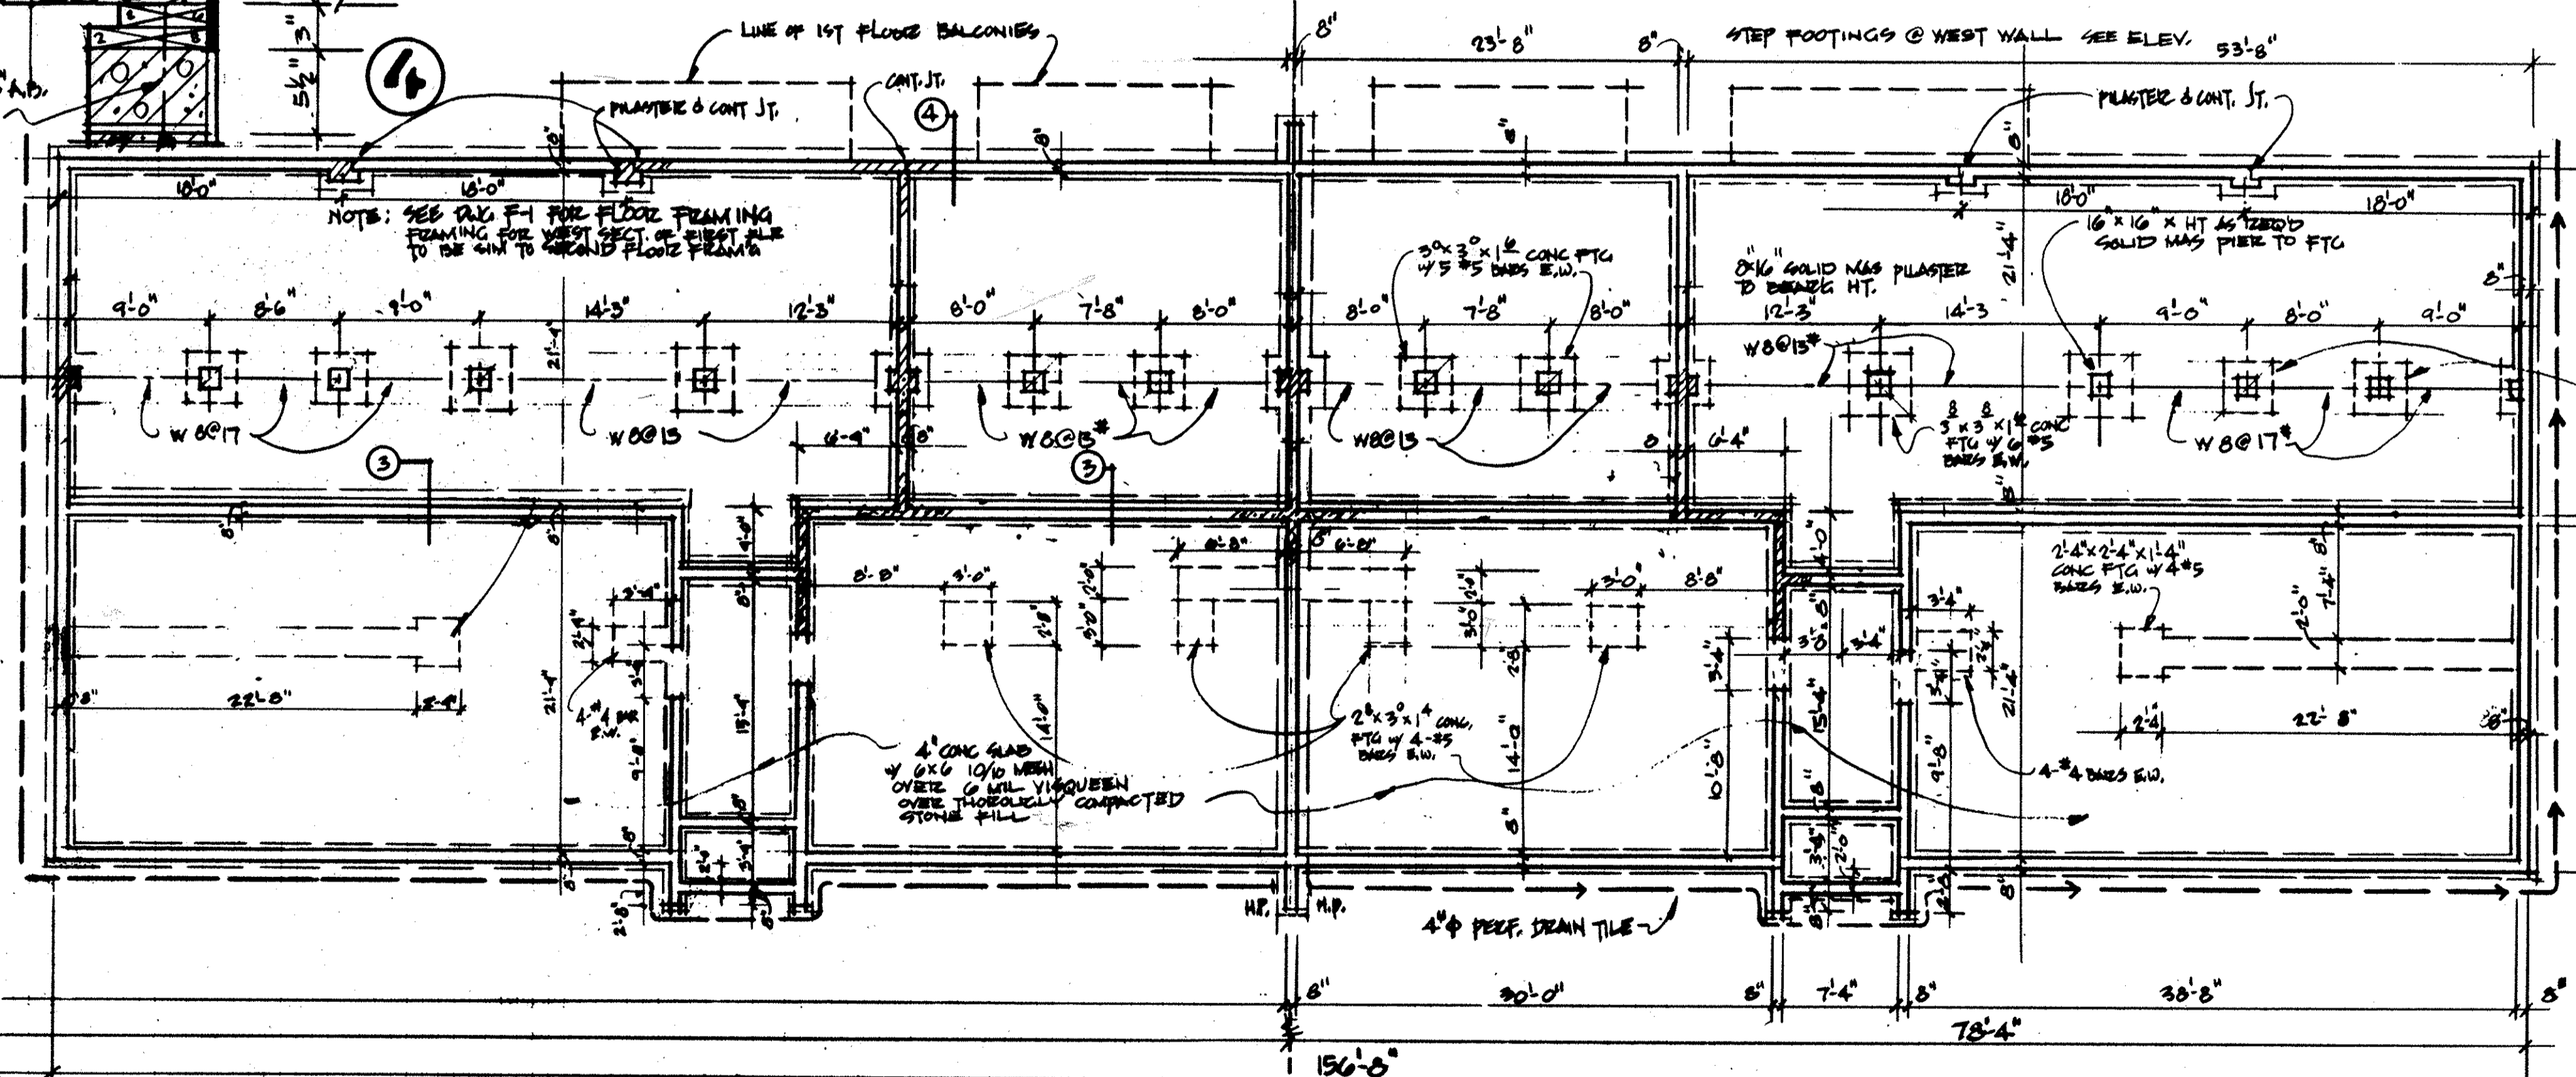

FOUNDATION PLAN
1/8" = 1'-0"

- NOTES:
1. ASSUMED SOIL BKG. PRESSURE 3000 PSF
 2. ALL FOOTINGS TO BEAR ON SOLID, UNDISTURBED EARTH
 3. BOTTOM OF ALL REINFORCING STEEL TO BE MIN 3" ABOVE BOT. OF FTG.

LORAIN COUNTY
TAX MAP DEPARTMENT
COPY




REVISIONS	JOB TITLE	DATE
	HIDDEN CREEK	9/15/18
	FLOOR 4 FOUNDATION PLAN	
	RICHARD SLY ARCHITECT INC.	SCALE
	3810 888 3452	DRAWN
		CHECKED
		2/5

DOOR SCHEDULE


DOOR NO.	DOOR SIZE	DOOR TYPE	DOOR MATER.	FRAME MATER.	DETAILS			HARDWARE	REMARKS
					JAMB	HEAD	SILL		
1	5'6" x 6'8" x 1 3/4"	FLUSH	HM.	HM.			CLOSURE	PERMANENT DOOR	
2	5'0" x 6'8" x 1 3/4"	FLUSH	HM.	HM.			CLOSURE & LOCK	PERMANENT DOOR	
3	2'6" x 6'8" x 1 3/4"	FLUSH	V.D.H.C.	VR			PRIVACY LOCK		
4	8' x 6'8"	DI-FOLD							
5	6' x 6'8"	DI-FOLD							
6	5' x 6'8"	DI-FOLD							
7	4' x 6'8"	DI-FOLD							
8	5' x 6'8"	DI-FOLD							
9	2' x 6'8"	DI-FOLD							
10	6' x 6'8"	BLDG. GL.	ALUM.	ALUM.			LOCKSET	SAFETY GLASS & GLAZING	
11	8' x 6'8"	BLDG. GL.	ALUM.	ALUM.			LOCKSET	SAFETY GLASS & GLAZING	

WINDOW SCHEDULE

MARK	TYPE	MANUFACTURER & MODEL NO.	R.O. SIZE	DETAILS			REMARKS
				HEAD	JAMB	SILL	
A	SLIDER	WARRANTY 1000 MOD. # DVEV 4040	48" x 48"				METALLIC FIN.
B	SLIDER	WARRANTY 1000 MOD. # DVEV 4032	48" x 36"				METALLIC FIN. (SEE DET. A1 FOR LOCATION)
C	SLIDER	WARRANTY 1000 MOD. # DVEV 5030	74" x 36"				METALLIC FIN. (SEE DET. A1 FOR LOCATION)

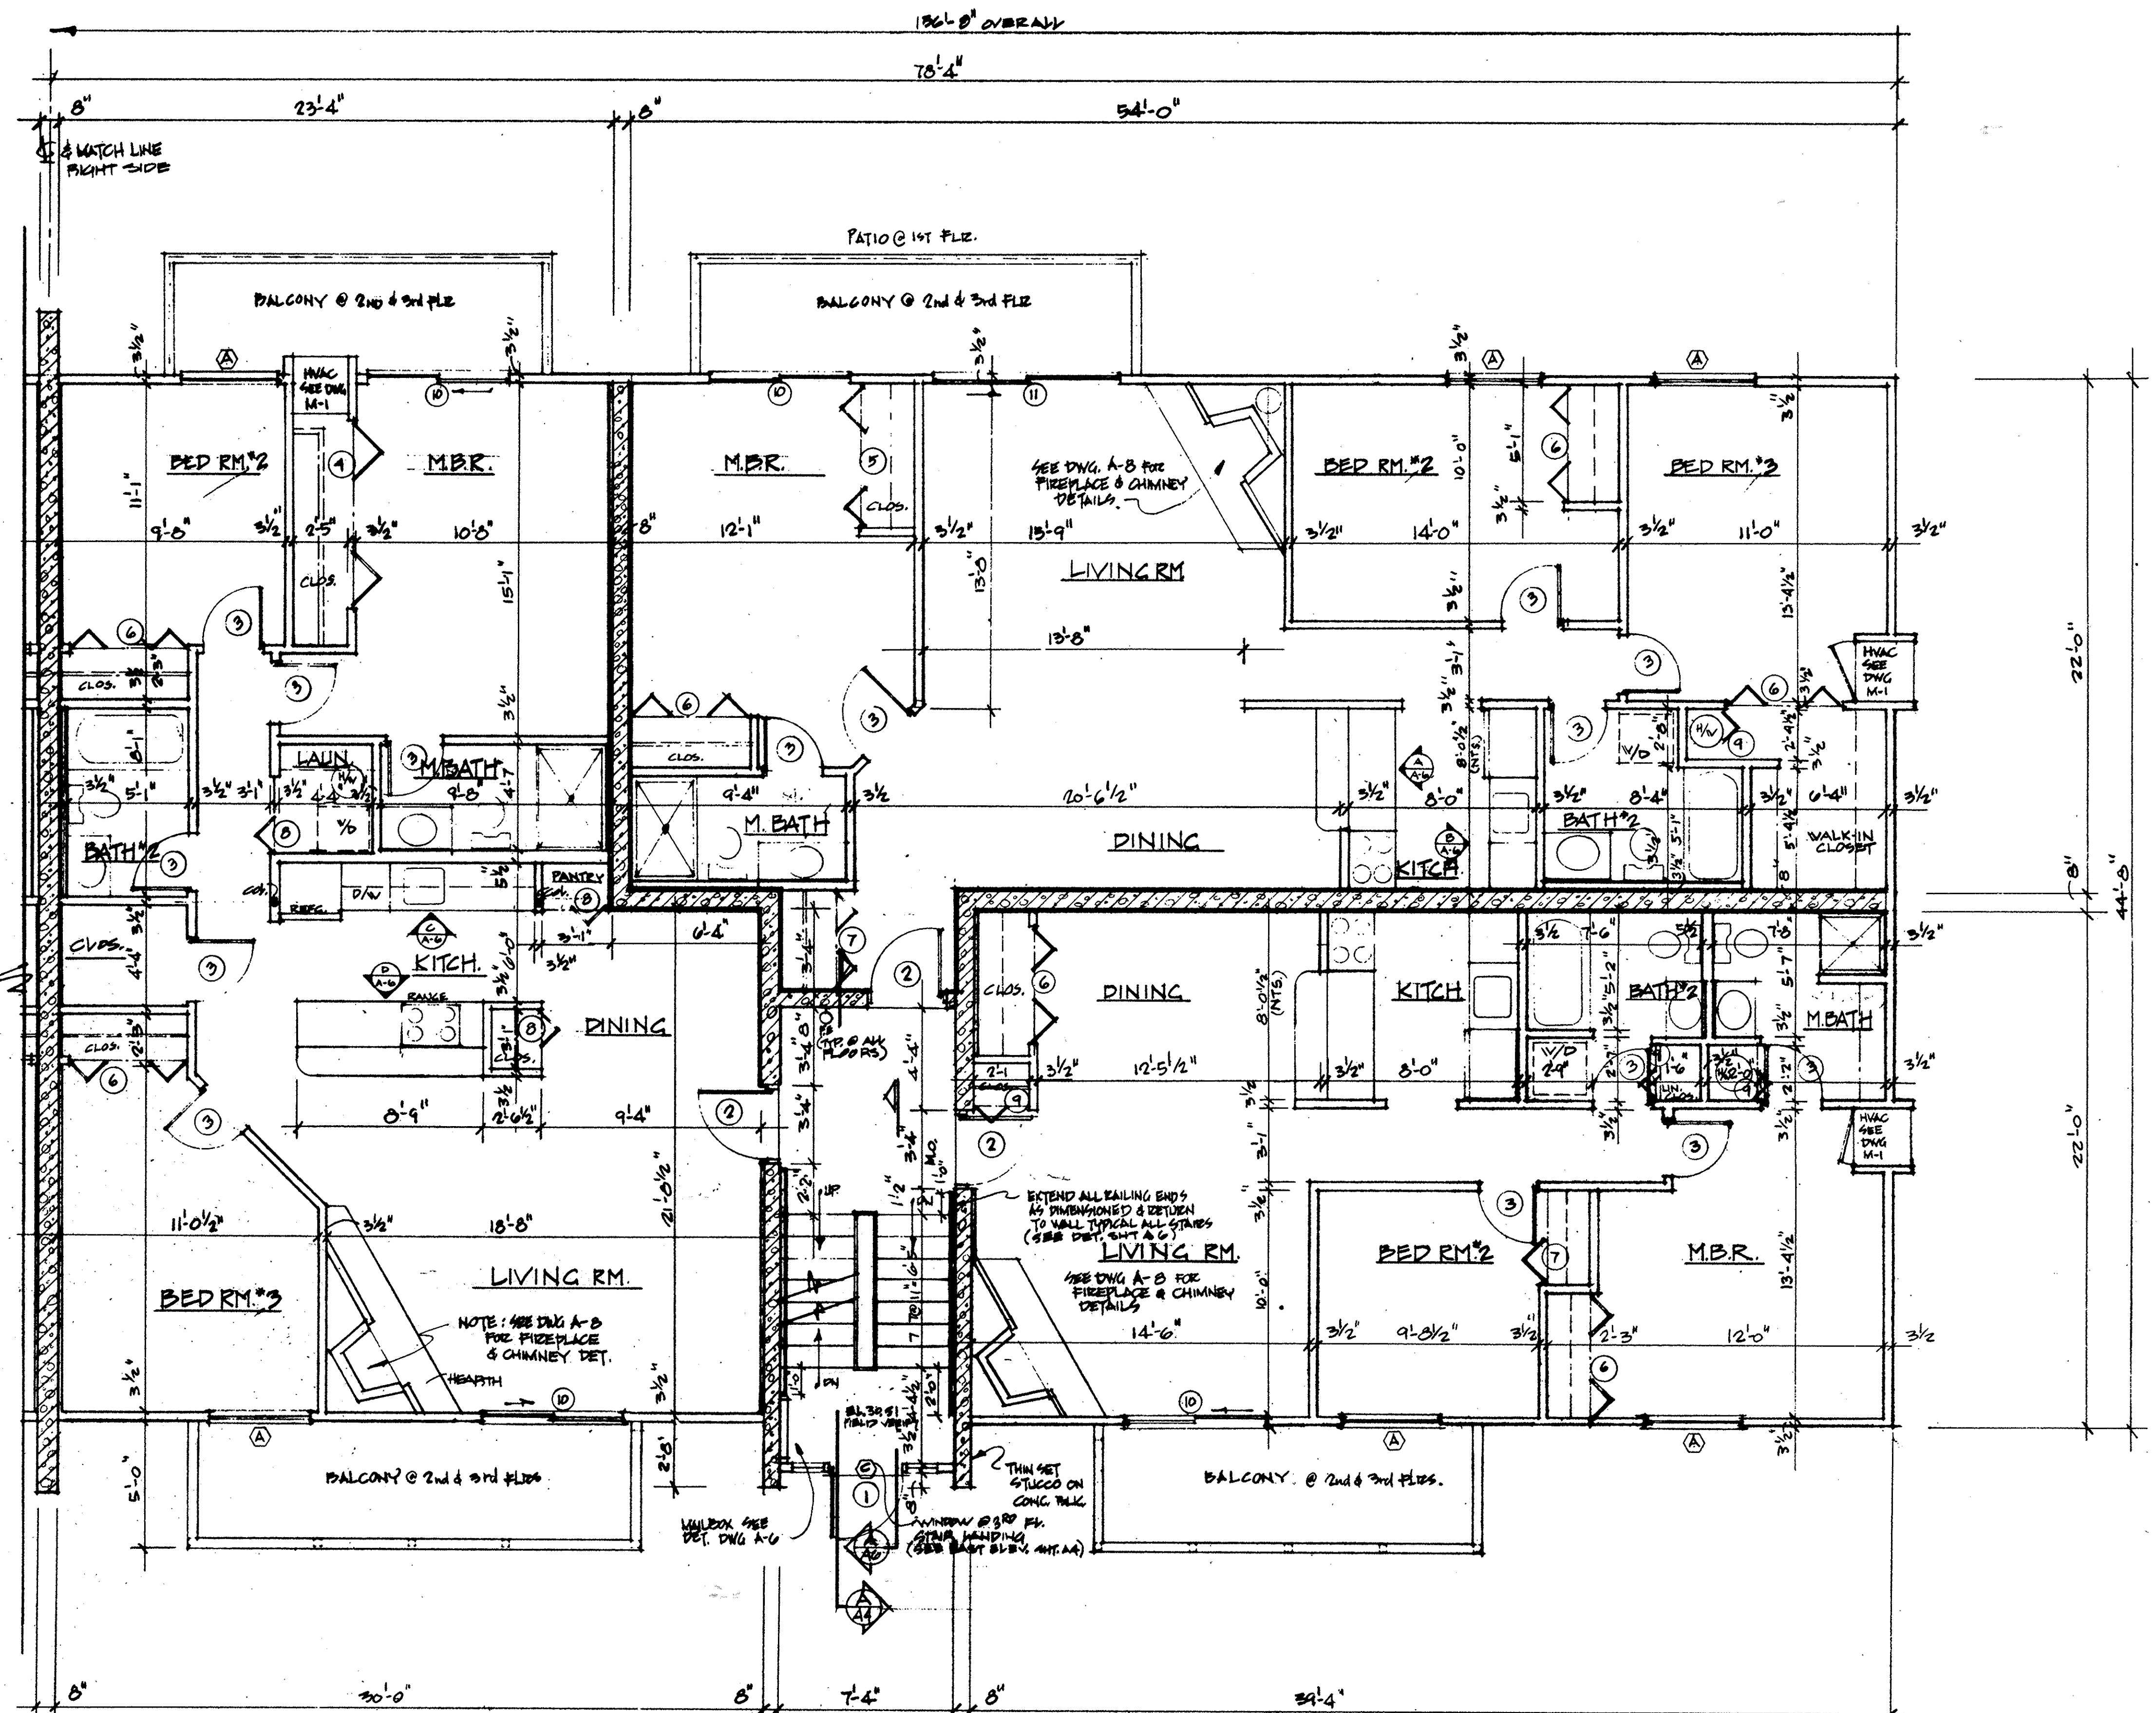

TYPICAL FLOOR PLAN (RIGHT SIDE)

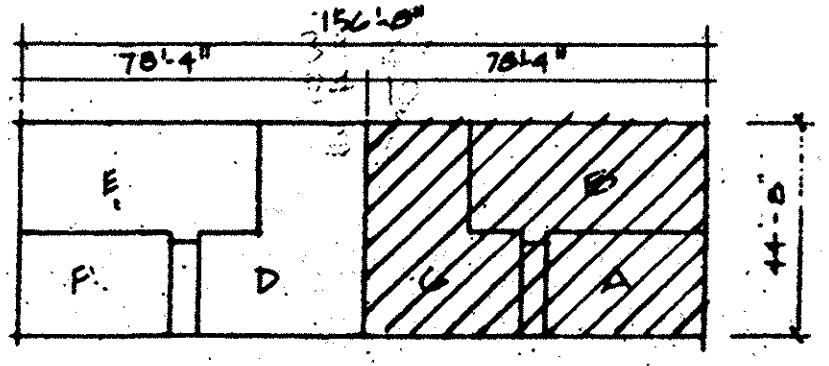


KEY PLAN


LORAIN COUNTY
TAX MAP DEPARTMENT
COPY



REVISIONS	JOB TITLE	HIDDEN CREEK	DATE
	DWG	F.P. PLAN RIGHT SIDE	8/15/89
	TITLE	RICHARD SLY ARCHITECT INC.	3/5

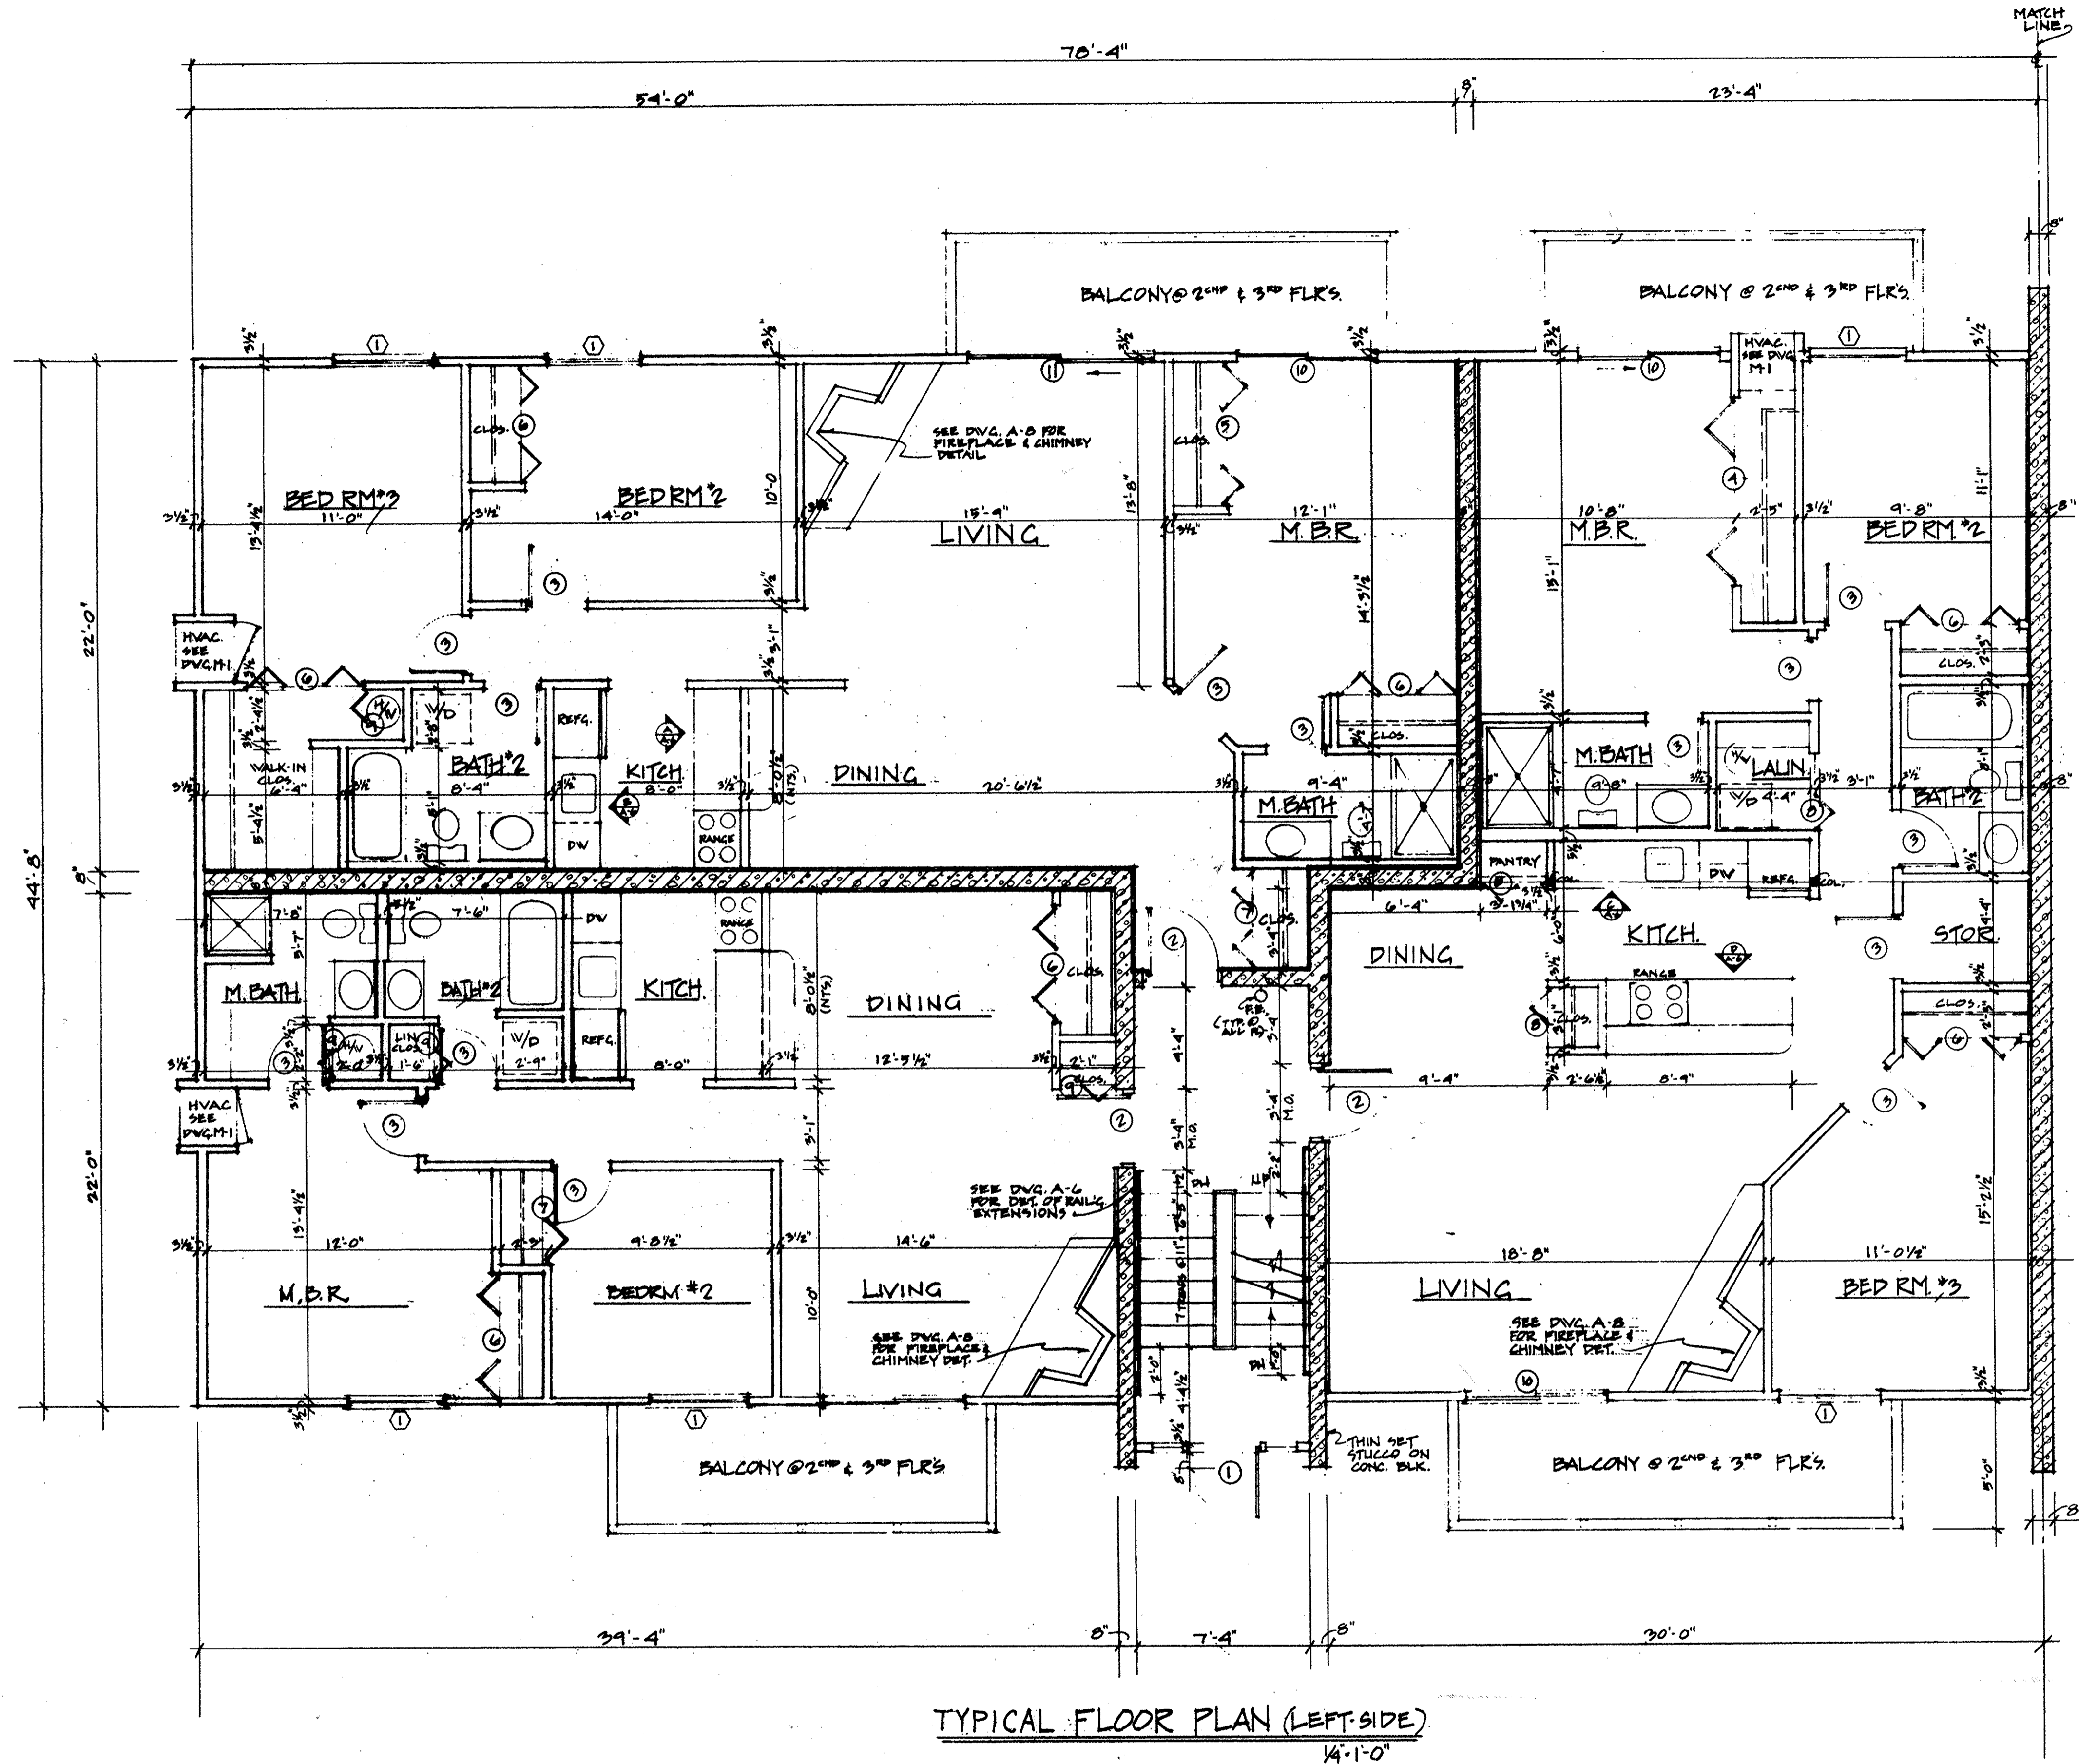

TYPICAL FLOOR PLAN (LEFT-SIDE)
14'-1-0"

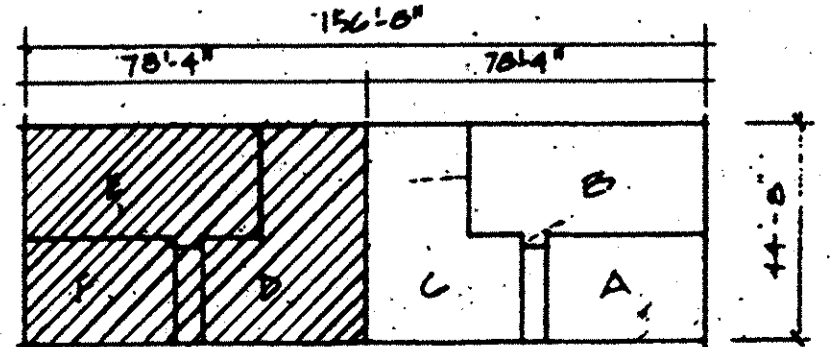


KEY PLAN


LORAIN COUNTY
TAX MAP DEPARTMENT
COPY




REVISIONS	JOB TITLE: HIDDEN CREEK	DATE: 7/15/84
	DWG TITLE: FLOOR PLAN (LEFT-SIDE)	SCALE: 1/8" = 1'-0"
	RICHARD BLY ARCHITECT INC. OHIO REG. 3450	DWT NO: 4/5
	CHECKED	

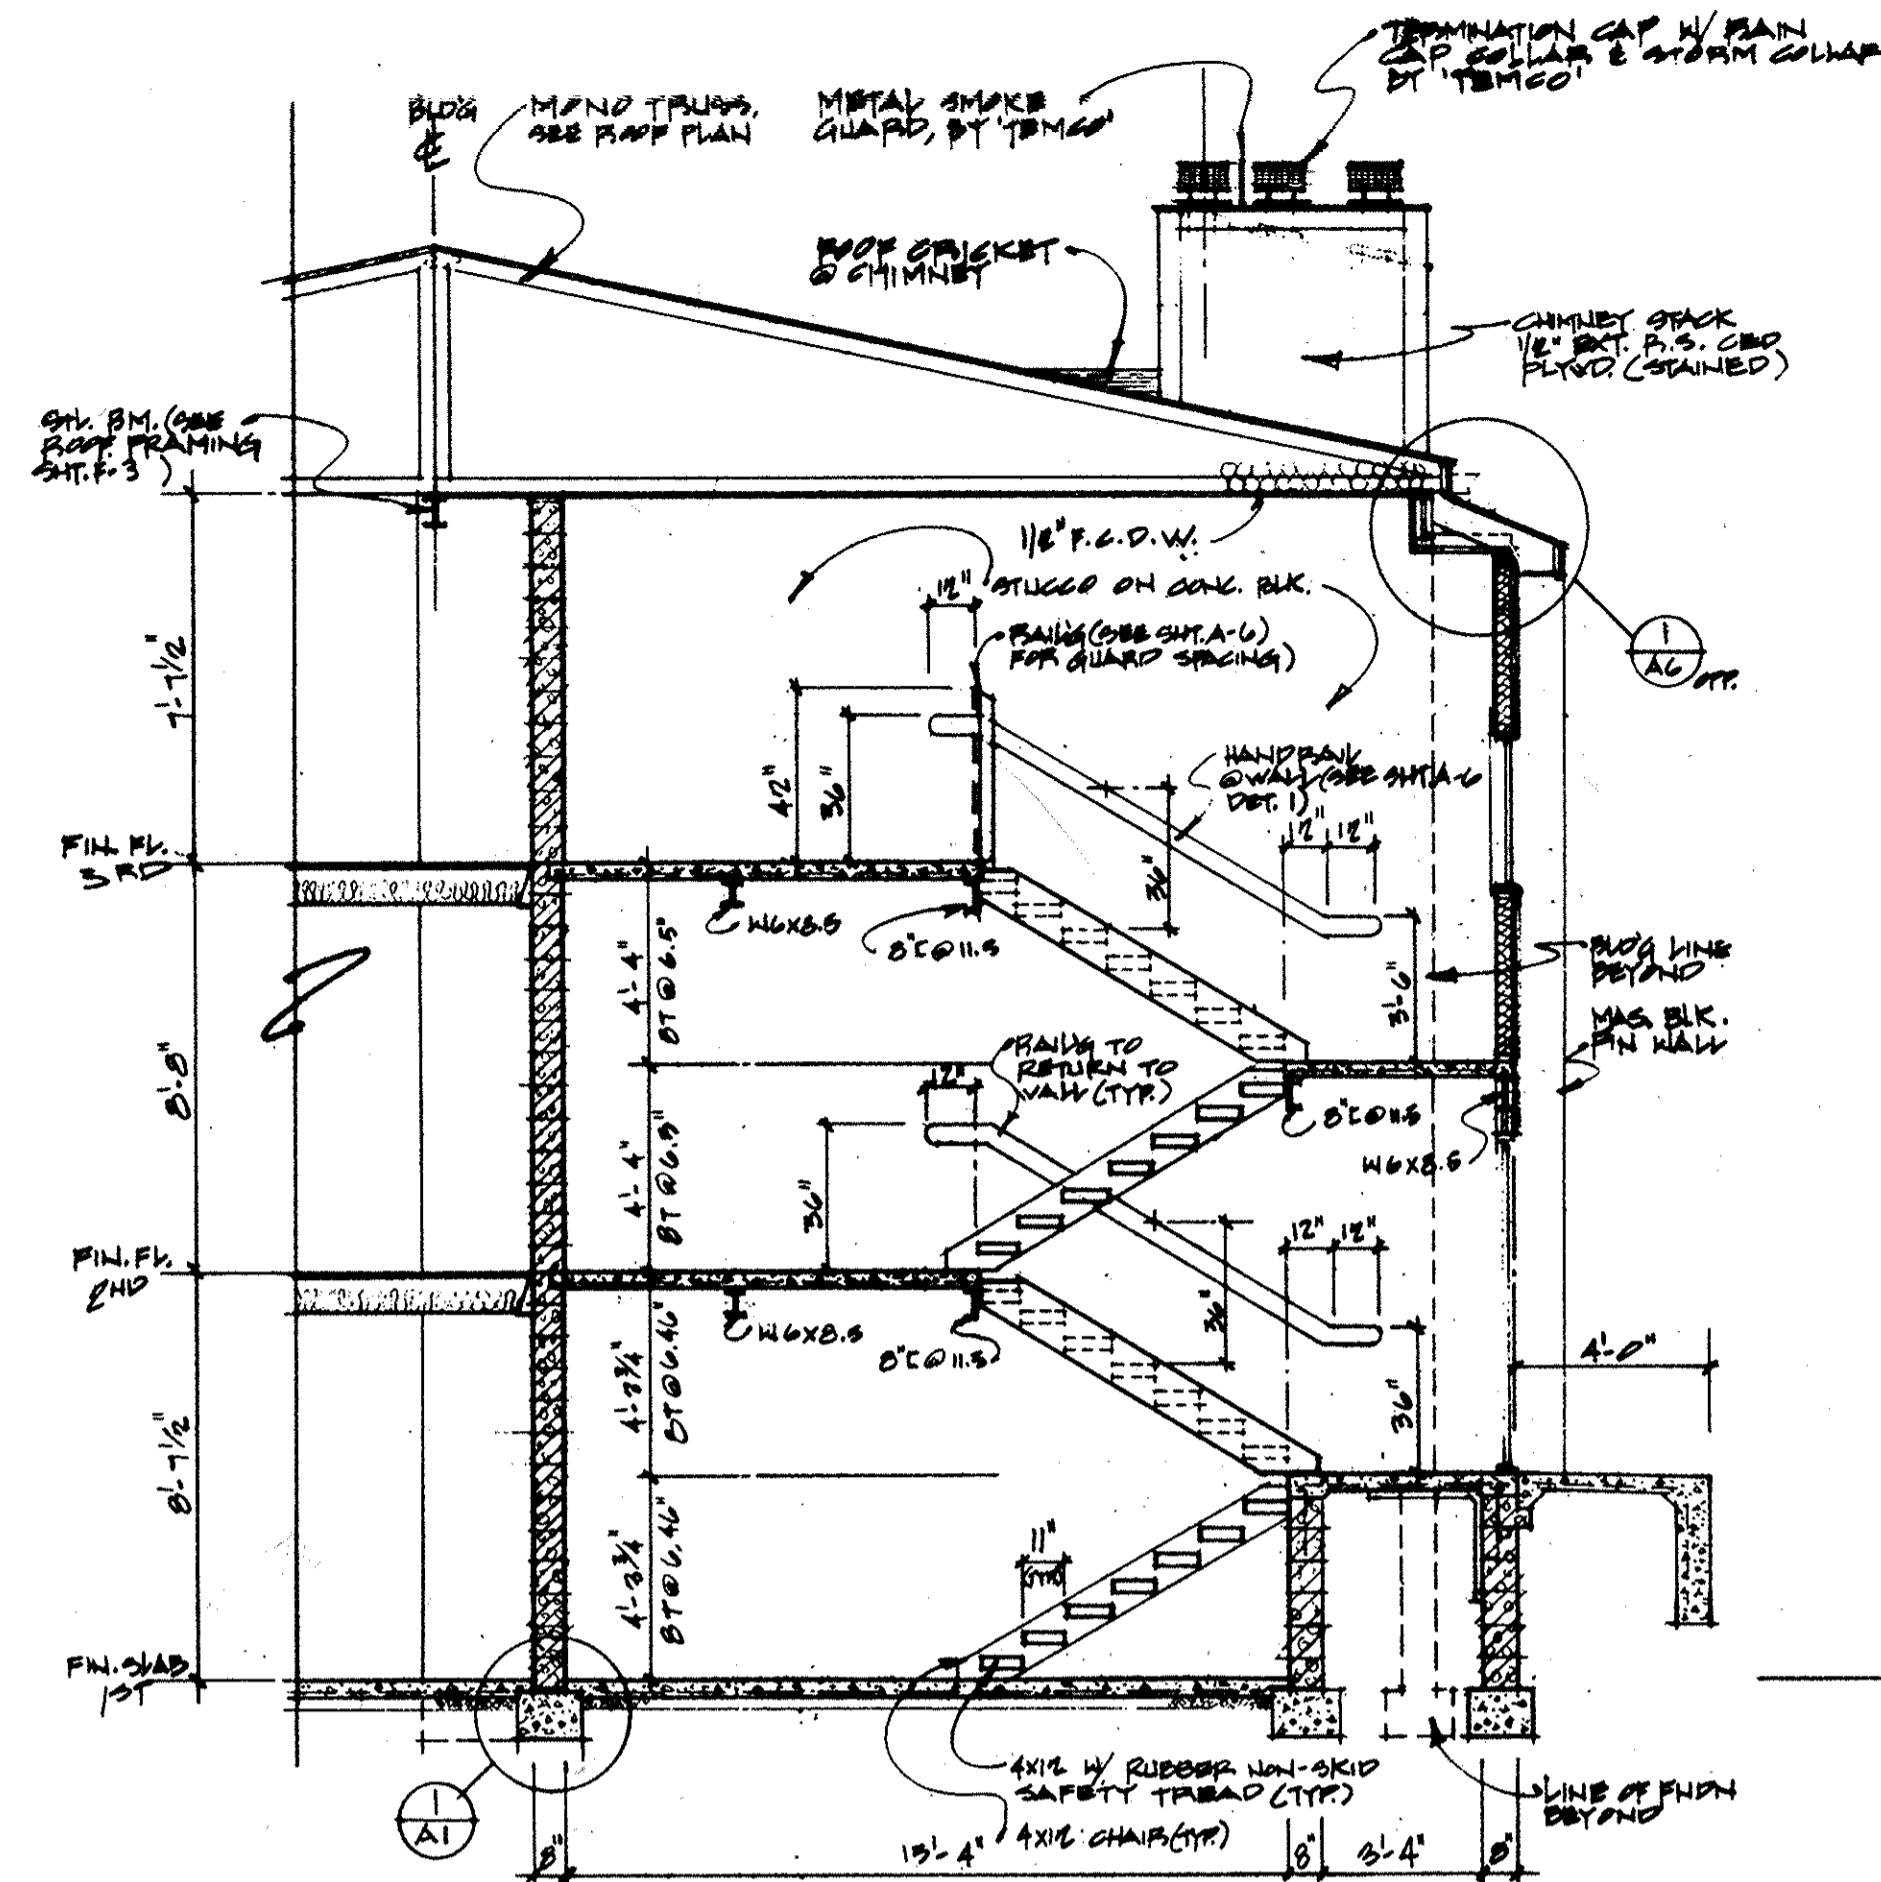


SECTION A-A @ ENTRANCE STAIR
1/4" = 1'-0"

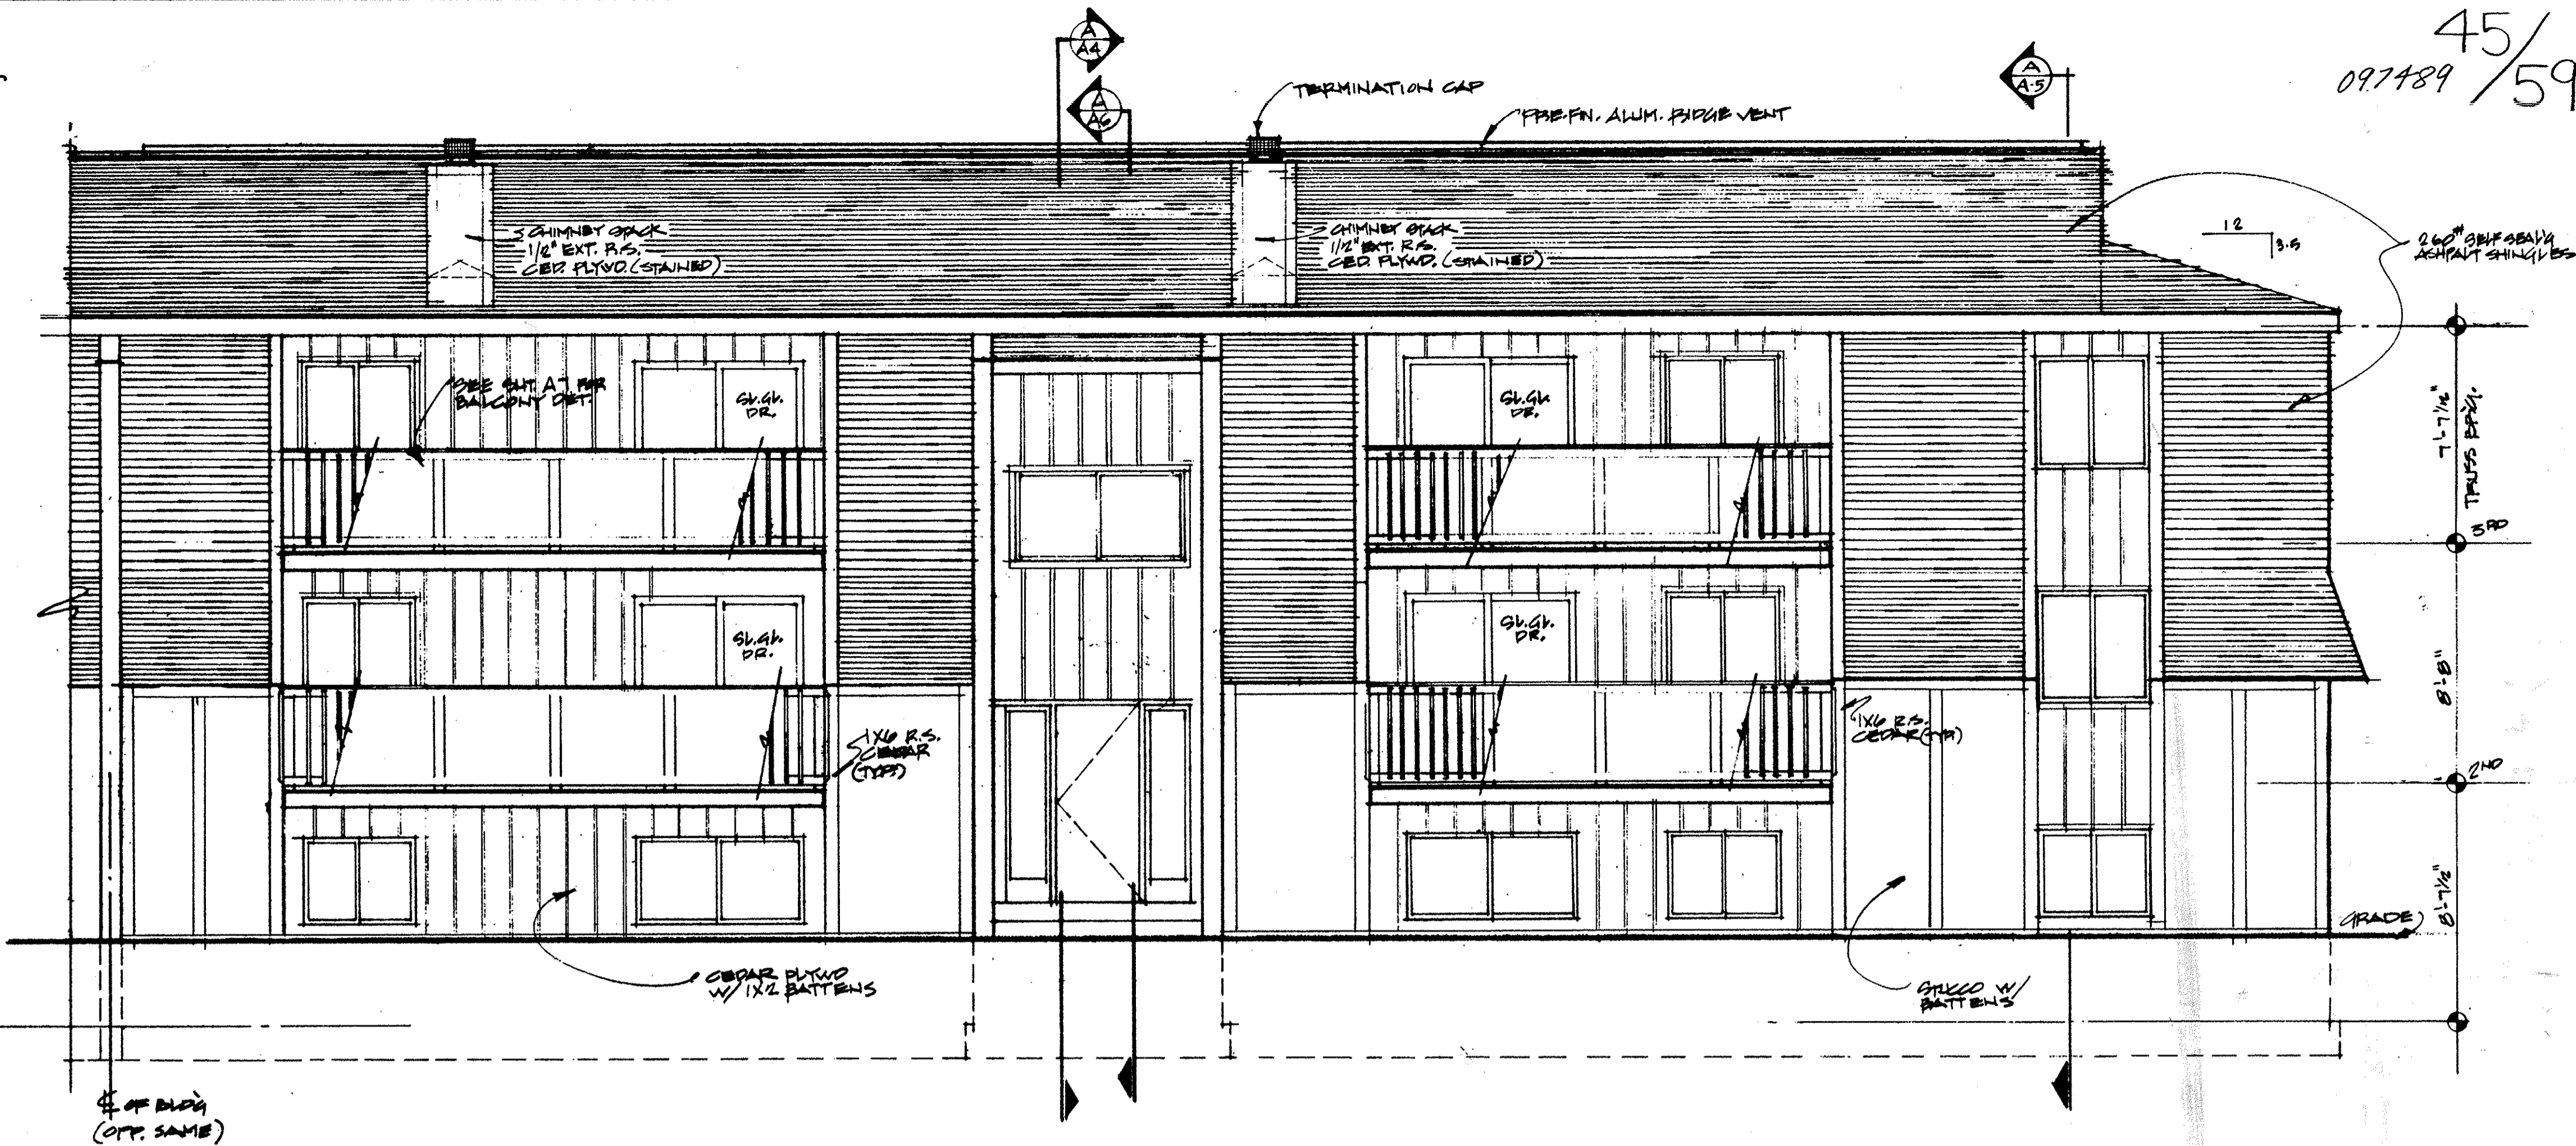

EAST ELEVATION (RIGHT SIDE)
1/4" = 1'-0"

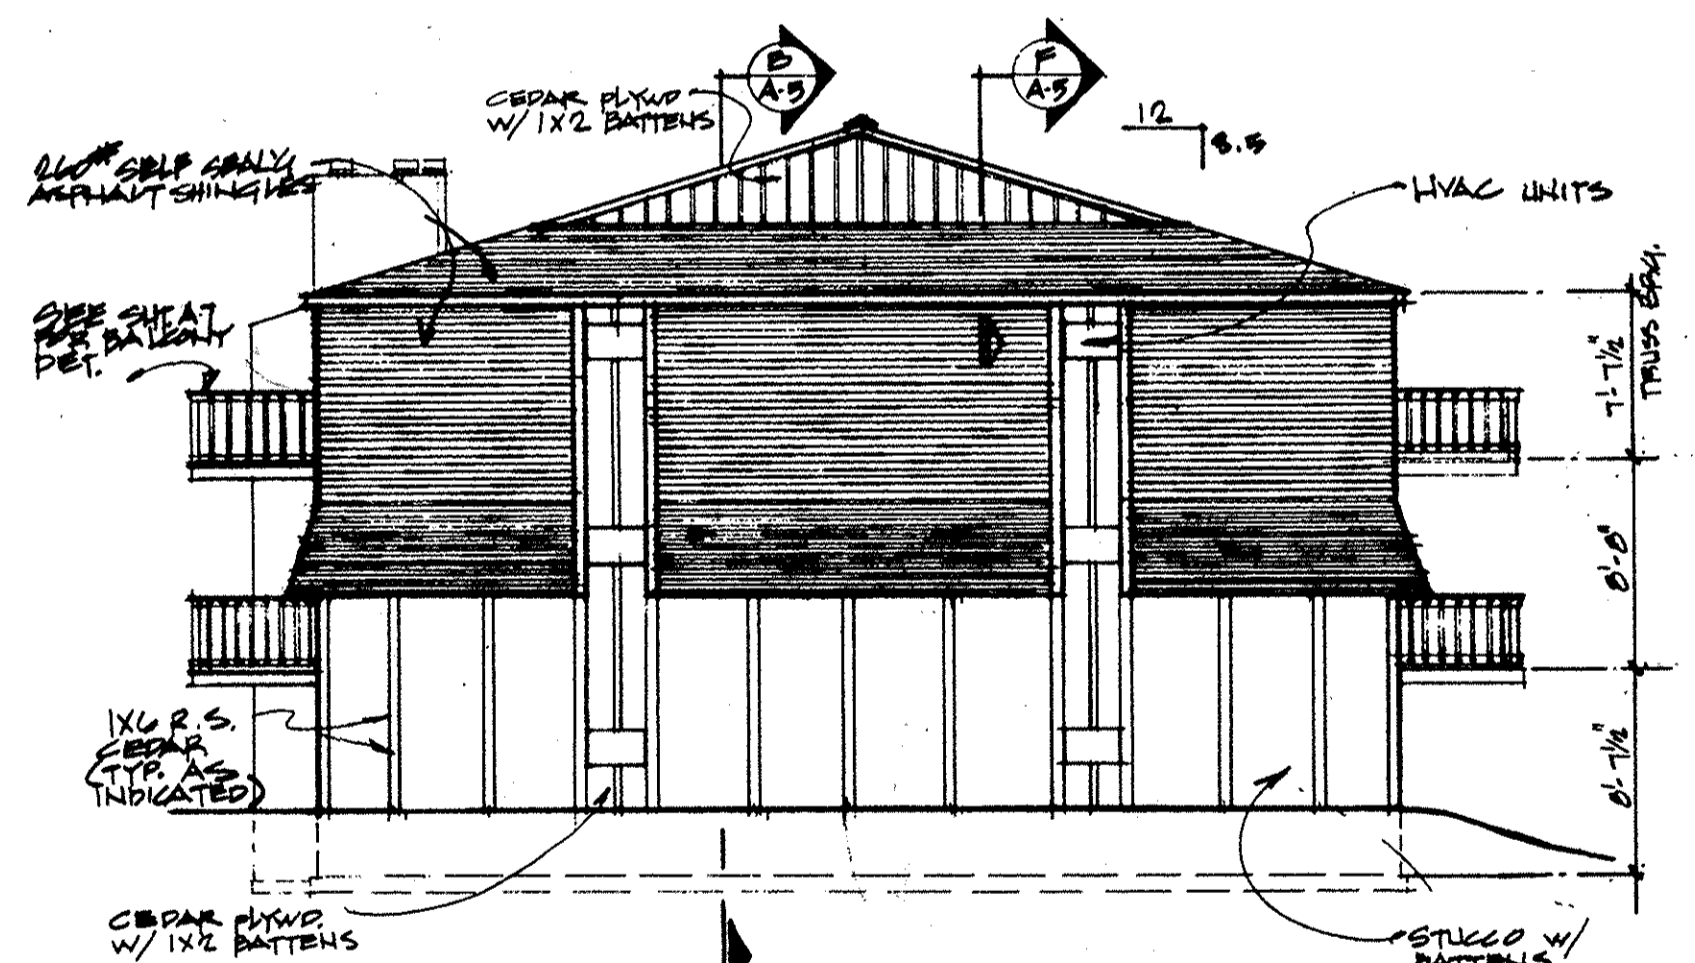


NORTH ELEVATION
1/8" = 1'-0"

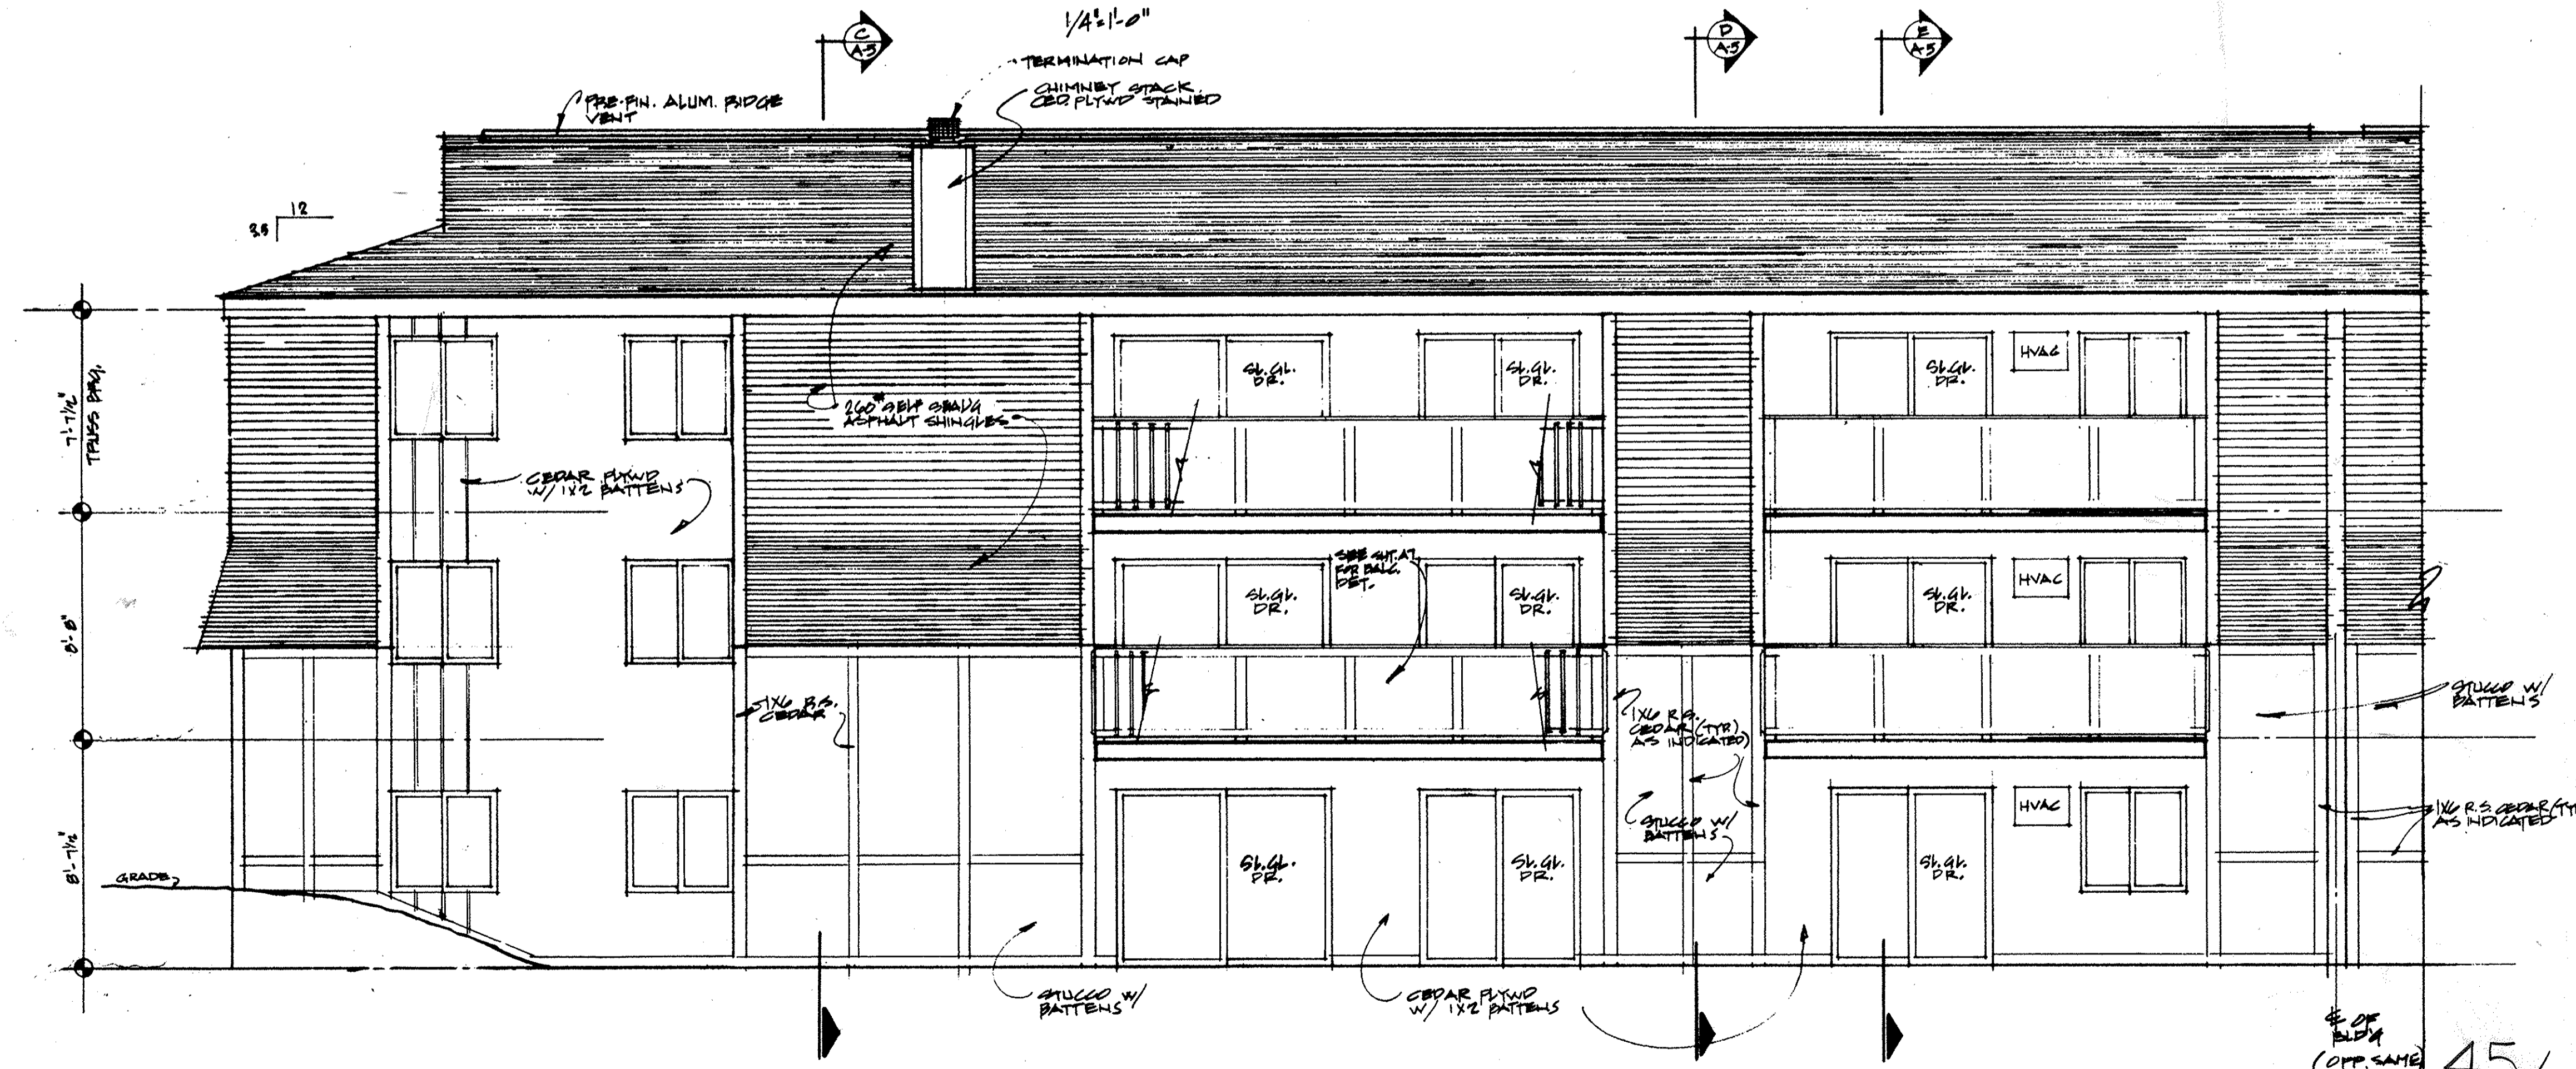

WEST ELEVATION
1/4" = 1'-0"

LORAIN COUNTY
TAX MAP DEPARTMENT
COPY

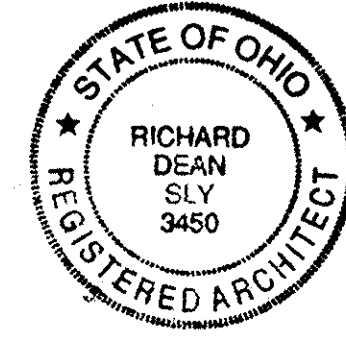

REVISIONS	JOB: HIDDEN CREEK	DATE: 8/15/99
	TITLE: ELEVATIONS / SECTION	SCALE: 1/4" = 1'-0"
	DRAWN BY: RICHARD SLY	CHECKED BY: [Signature]
	DATE: 8/15/99	SHEET: 5/5