


102071


102071

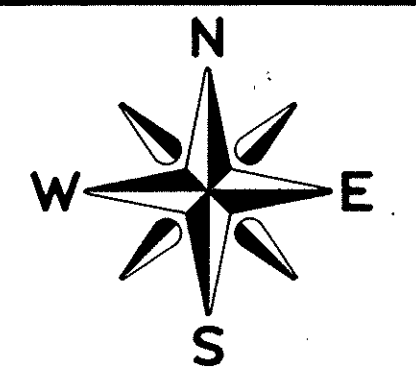

SCALE: 1" = 60'

BOUNTY WAY 60'


LOOKOUT COURT 60'

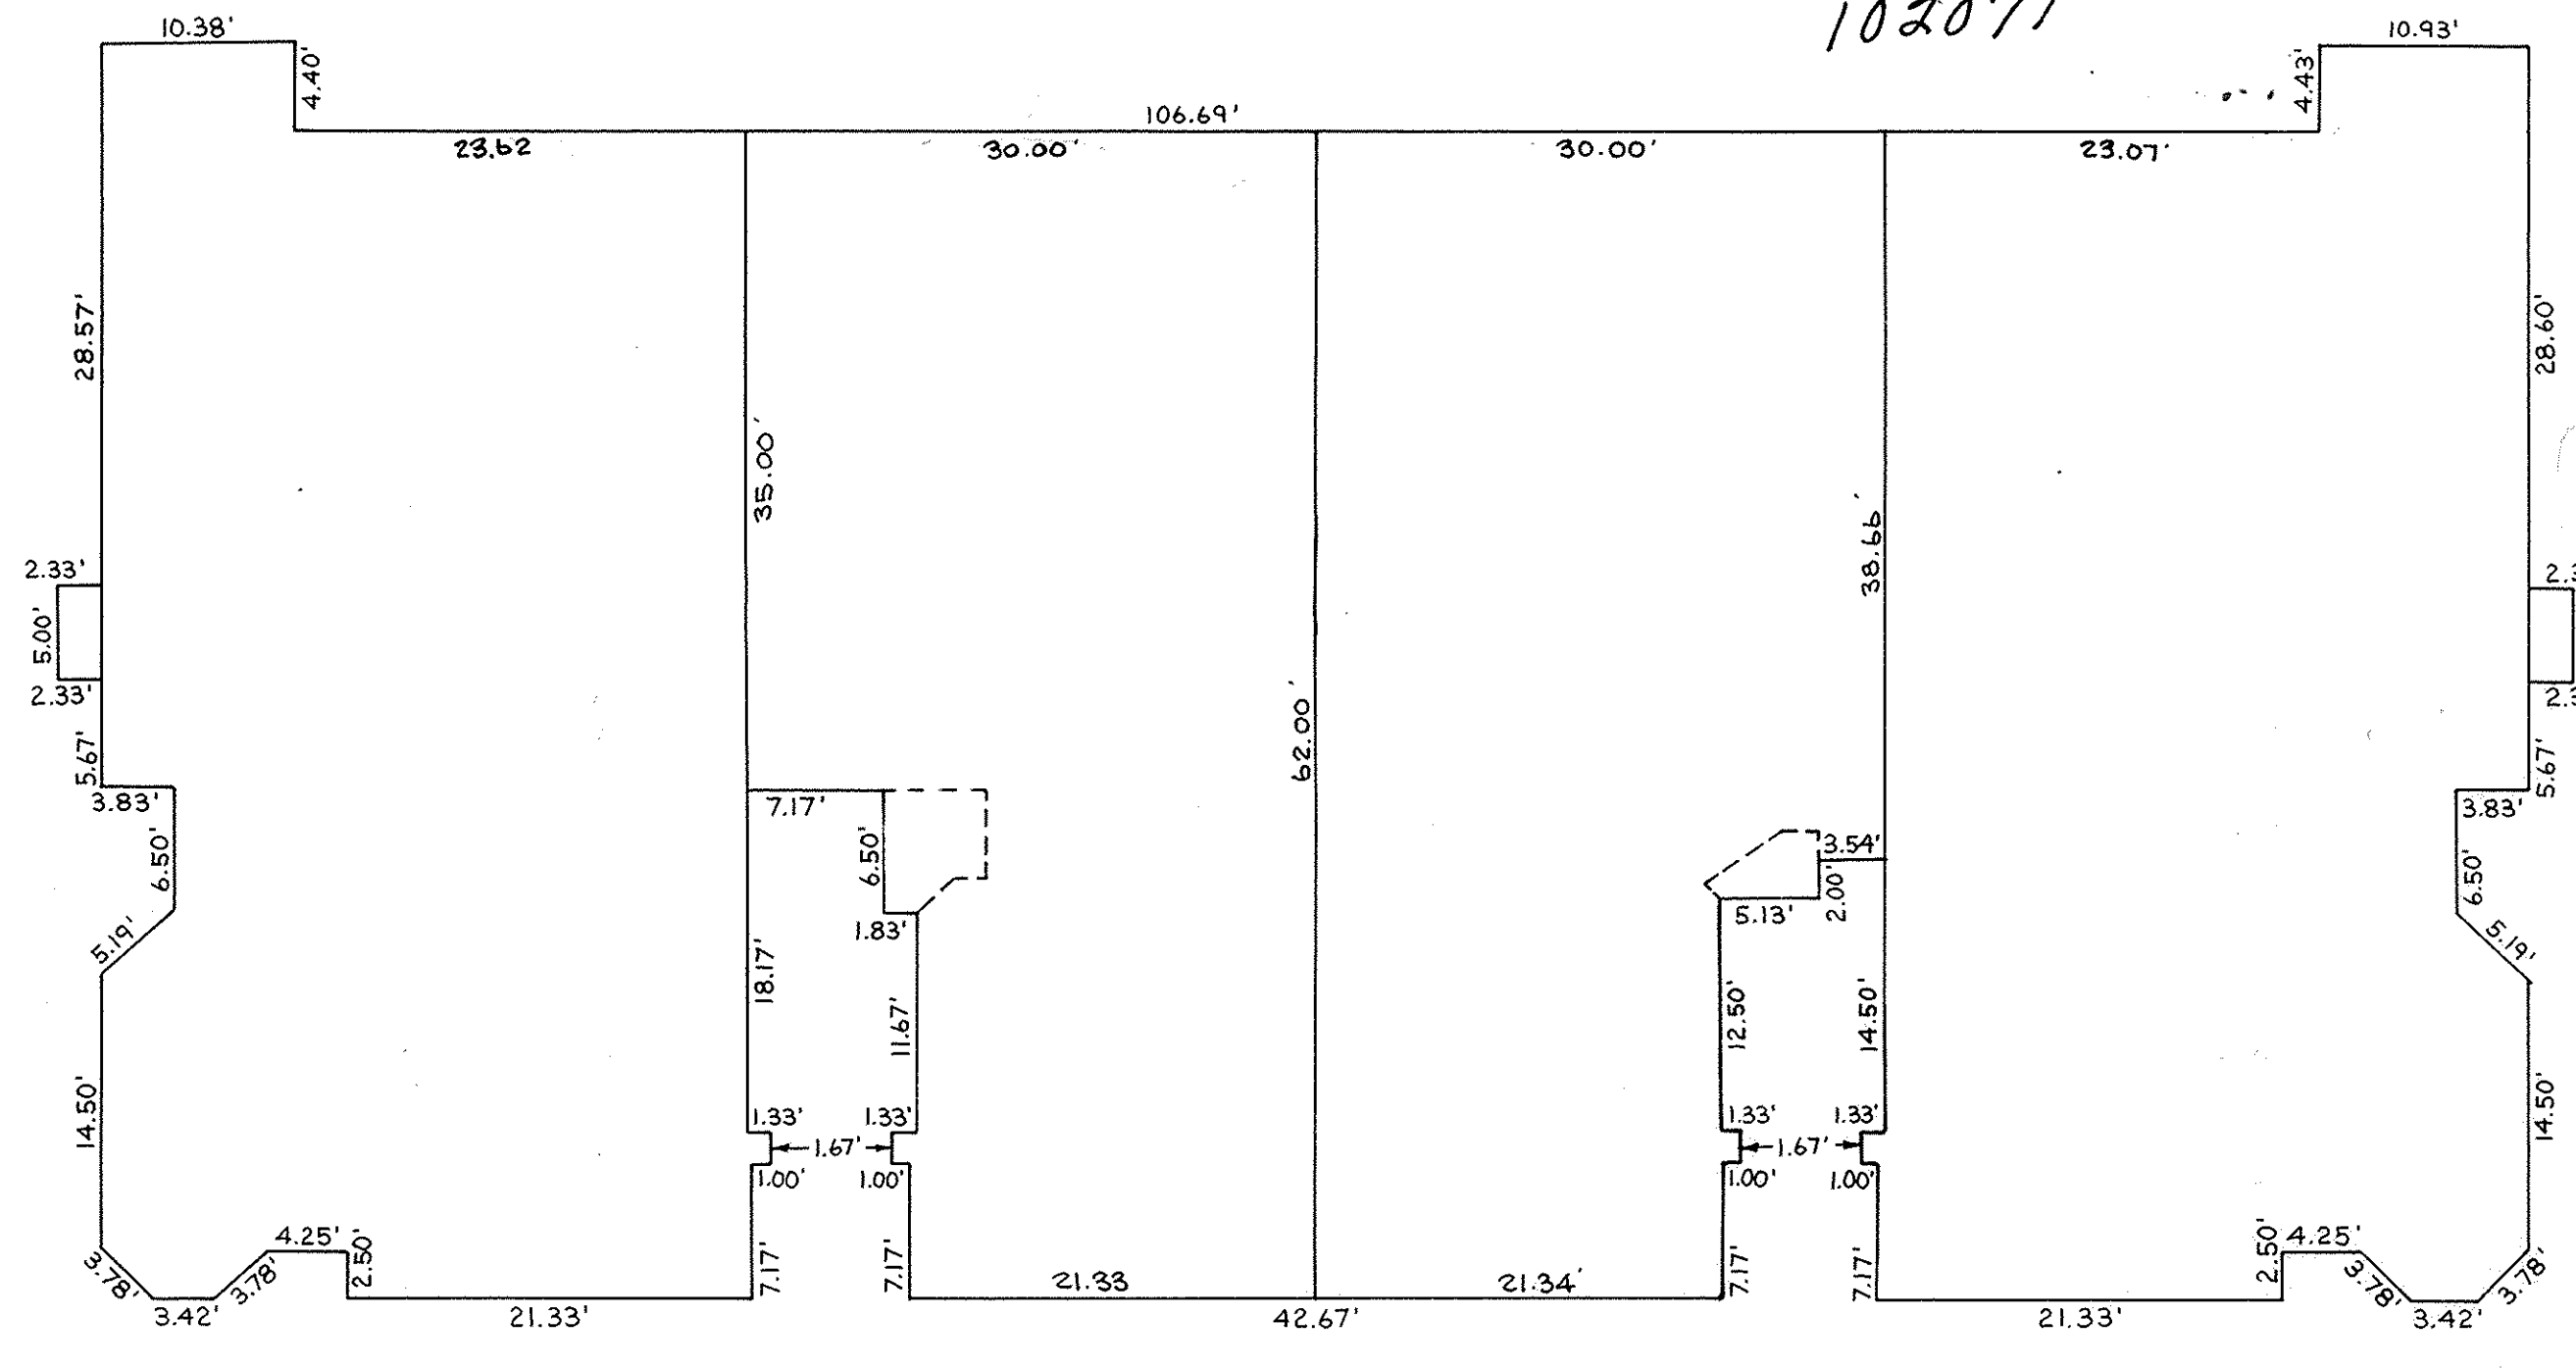

FOUNDATION PLAN SCALE: 1" = 10'

SHEET INDEX


| SHEET NO. | DESCRIPTION |
|-----------|--------------------------------|
| 1 | TITLE SHEET, SURVEY MAP, MISC. |
| 2 | FLOOR PLANS, ELEVATIONS |
| 3 | FLOOR PLANS |
| 4 | FLOOR PLANS |

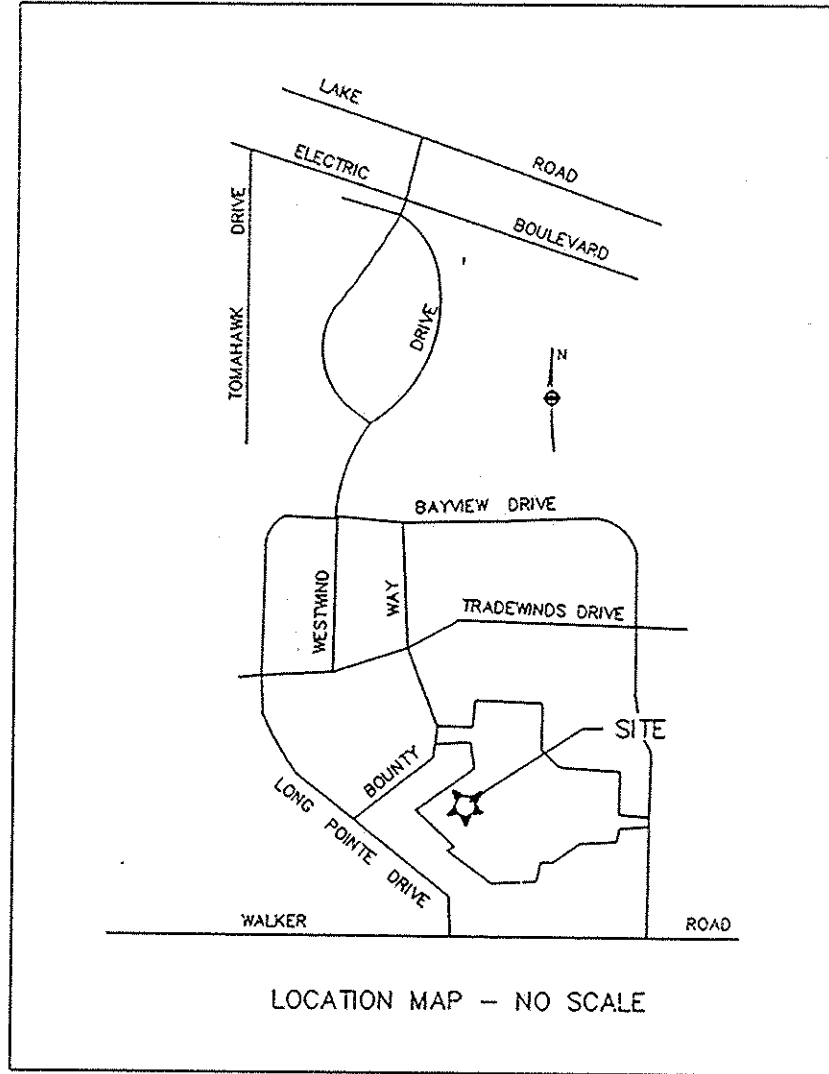

LOCATION MAP - NO SCALE


PERCENTAGE OF OWNERSHIP

| UNIT NO. | ADDRESS | SQUARE FEET | % OWNERSHIP |
|----------|----------------|-------------|-------------|
| 1 - 148 | 401 BOUNTY WAY | 1424 | 4.6859 |
| 2 - 149 | | 1703 | 5.6040 |
| 3 - 150 | | 1787 | 5.8804 |
| 4 - 151 | | 1424 | 4.6859 |
| 5 - 152 | | 1424 | 4.6859 |
| 6 - 153 | | 1910 | 6.2852 |
| 7 - 154 | | 1703 | 5.6040 |
| 8 - 155 | | 1424 | 4.6859 |
| 9 - 156 | | 1424 | 4.6859 |
| 10 - 157 | | 1703 | 5.6040 |
| 11 - 158 | | 1787 | 5.8804 |
| 12 - 159 | | 1424 | 4.6859 |
| 13 - 160 | | 1703 | 5.6040 |
| 14 - 161 | | 1787 | 5.8804 |
| 15 - 162 | | 1424 | 4.6859 |
| 16 - 144 | | 1424 | 4.6859 |
| 17 - 145 | | 1703 | 5.6040 |
| 18 - 146 | | 1787 | 5.8804 |
| 19 - 147 | | 1424 | 4.6859 |

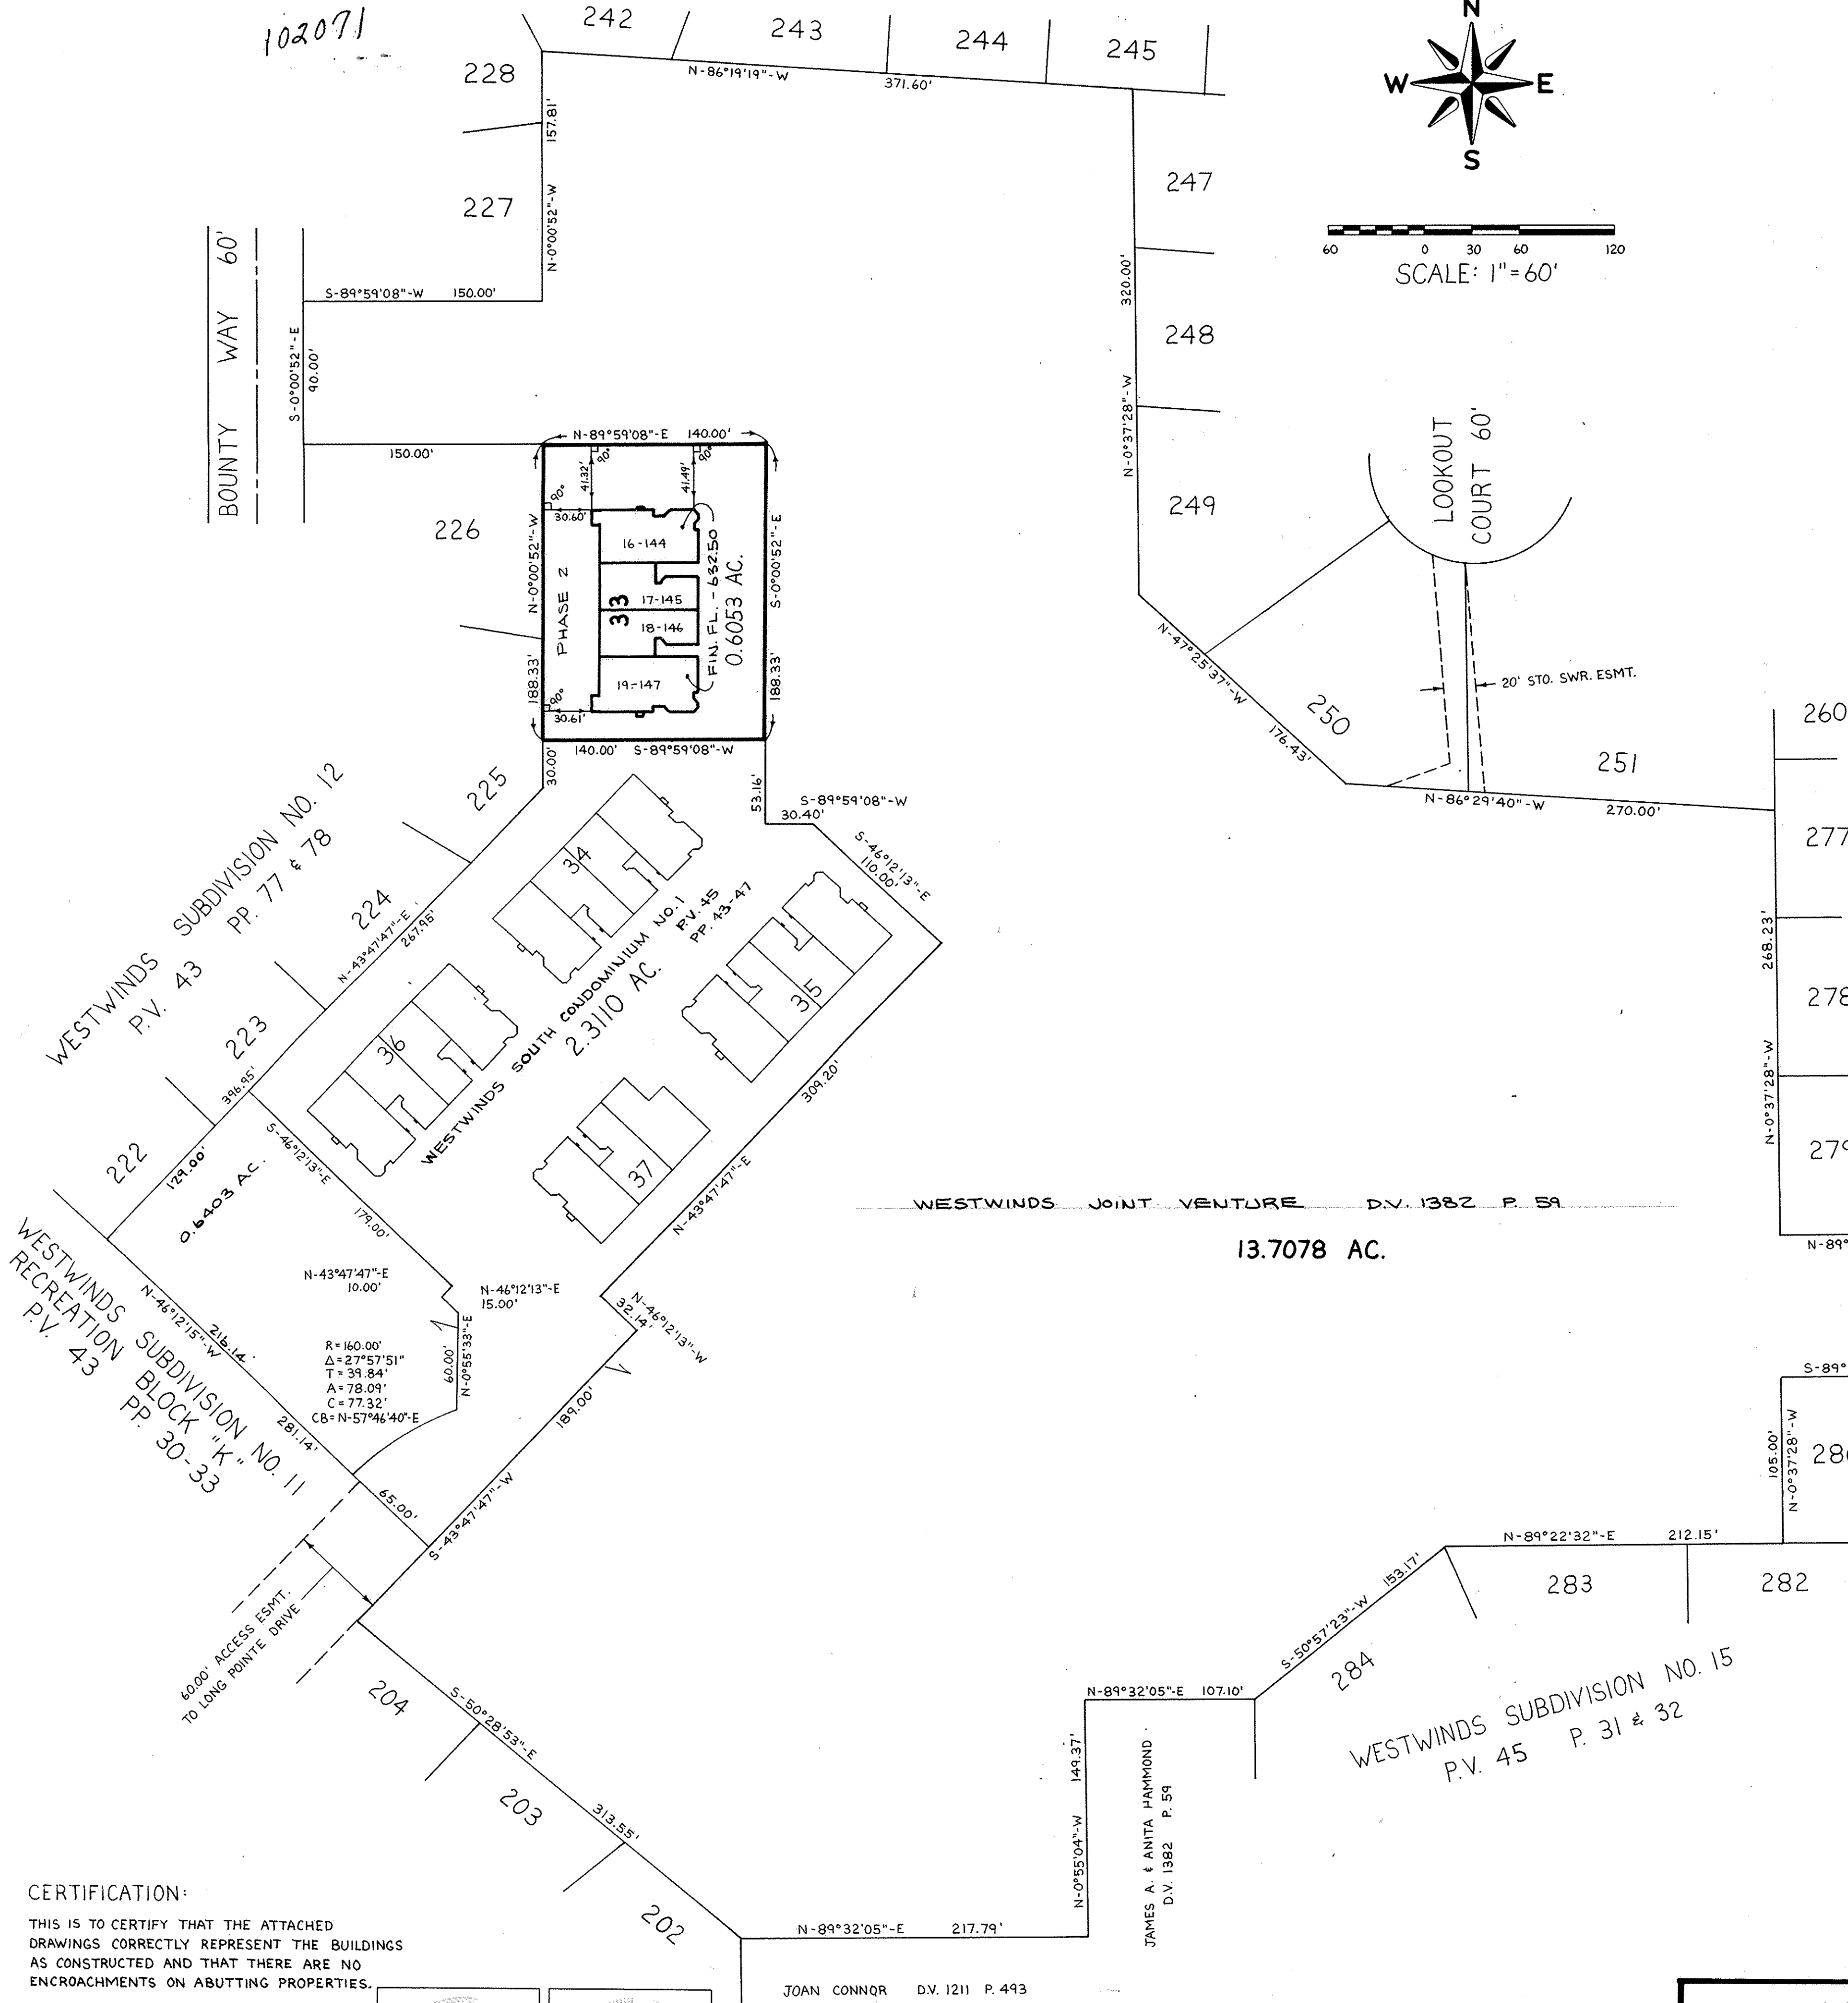

13.7078 AC.

CERTIFICATION:
THIS IS TO CERTIFY THAT THE ATTACHED DRAWINGS CORRECTLY REPRESENT THE BUILDINGS AS CONSTRUCTED AND THAT THERE ARE NO ENCROACHMENTS ON ADJUTING PROPERTIES.

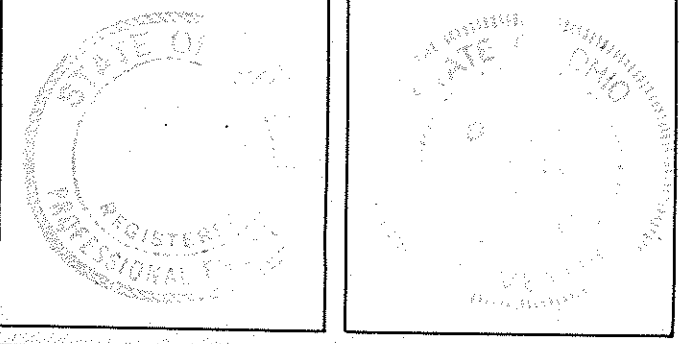

LORAIN COUNTY TAX MAP DEPARTMENT COPY

TRANSFERRED
IN COMPLIANCE WITH SEC. 319-202
OHIO REV. CODE
JUN 29 1990
JULIAN A. PIJOR
LORAIN COUNTY AUDITOR

Received for Record
JUN 29 1990
DOROTHY L. ESSEX
Lorain County Recorder
Box: L.C.T.

WESTWINDS SOUTH CONDOMINIUM NO. 1
FIRST AMMENDMENT · PHASE 2
PART OF AVON TOWNSHIP SECTION NO. 30
CITY OF AVON LAKE · COUNTY OF LORAIN · STATE OF OHIO

KS ASSOCIATES, INC.
ENGINEERS/SURVEYORS
424 Middle Avenue
P.O. Box 89
Elyria, Ohio 44036
Elyria (216) 322-6317 • Lorain (216) 244-5757




SHEET 1 OF 4
JOB NO.


102071

102071 45/67


UNIT 14-147 AS SHOWN
DIMENSIONS: (00.00)
UNIT 16-144 REVERSED
DIMENSIONS: (00.00)

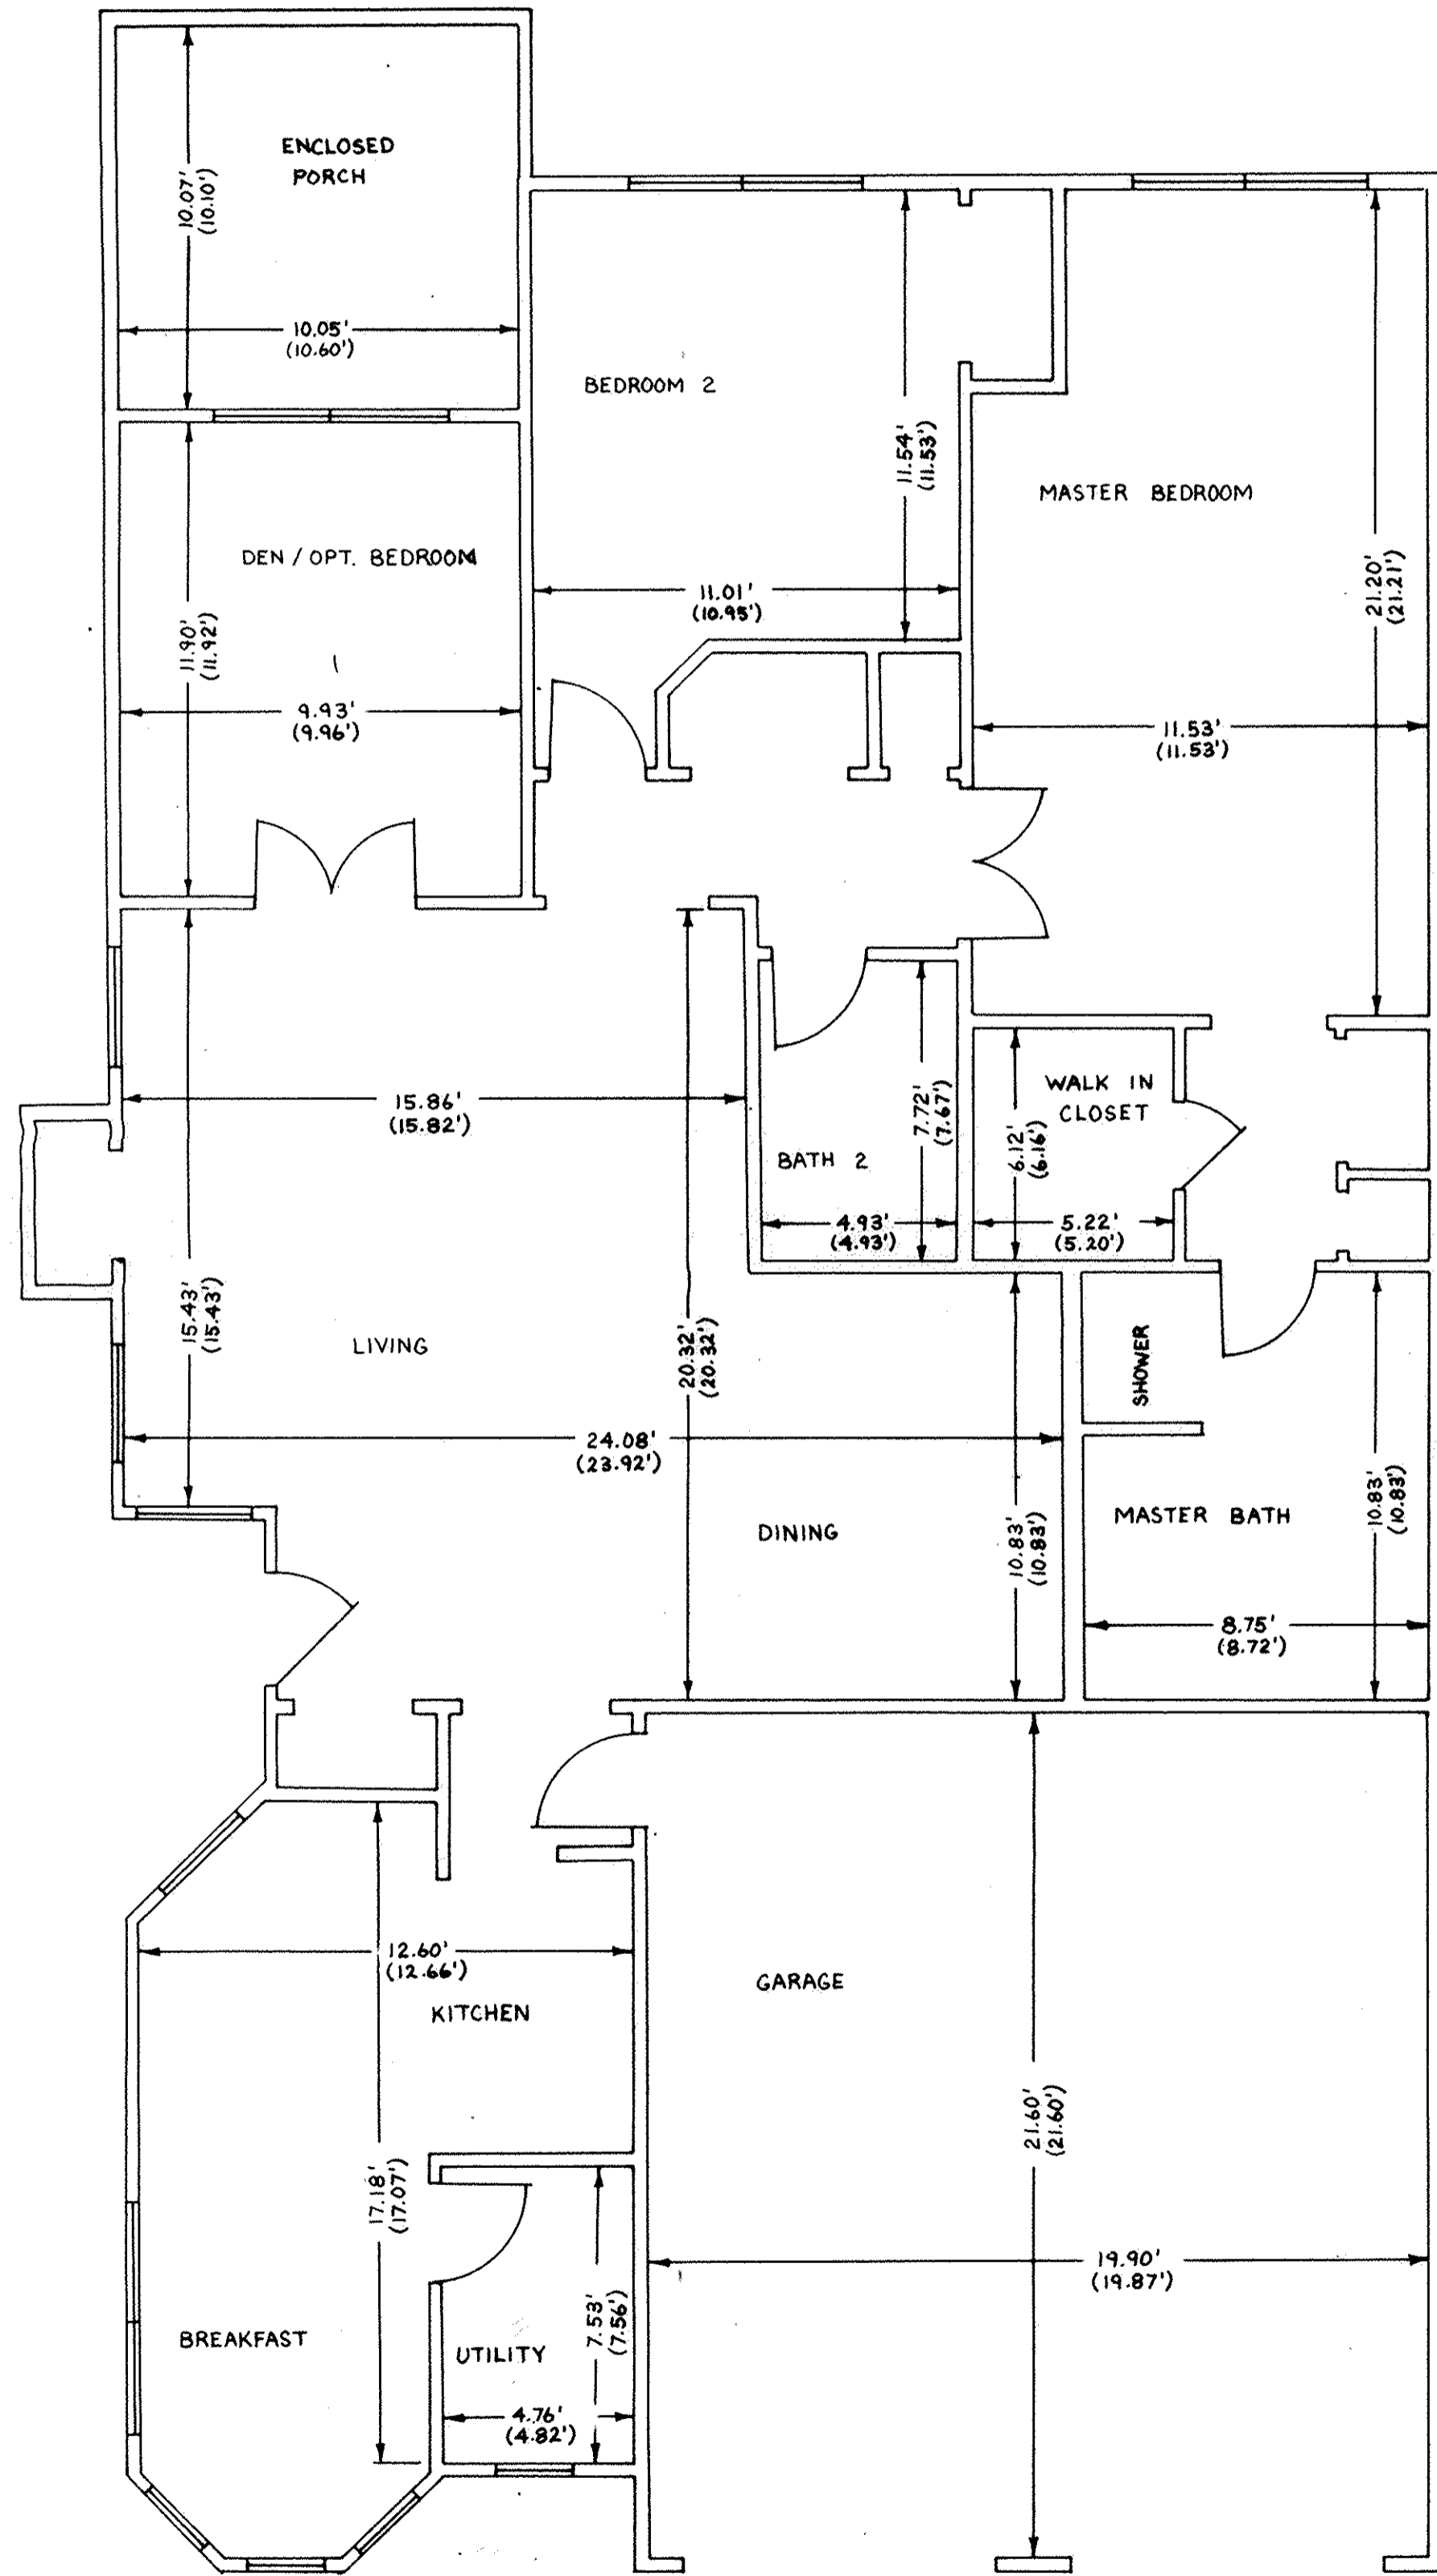

SCALE: 1/4" = 1'

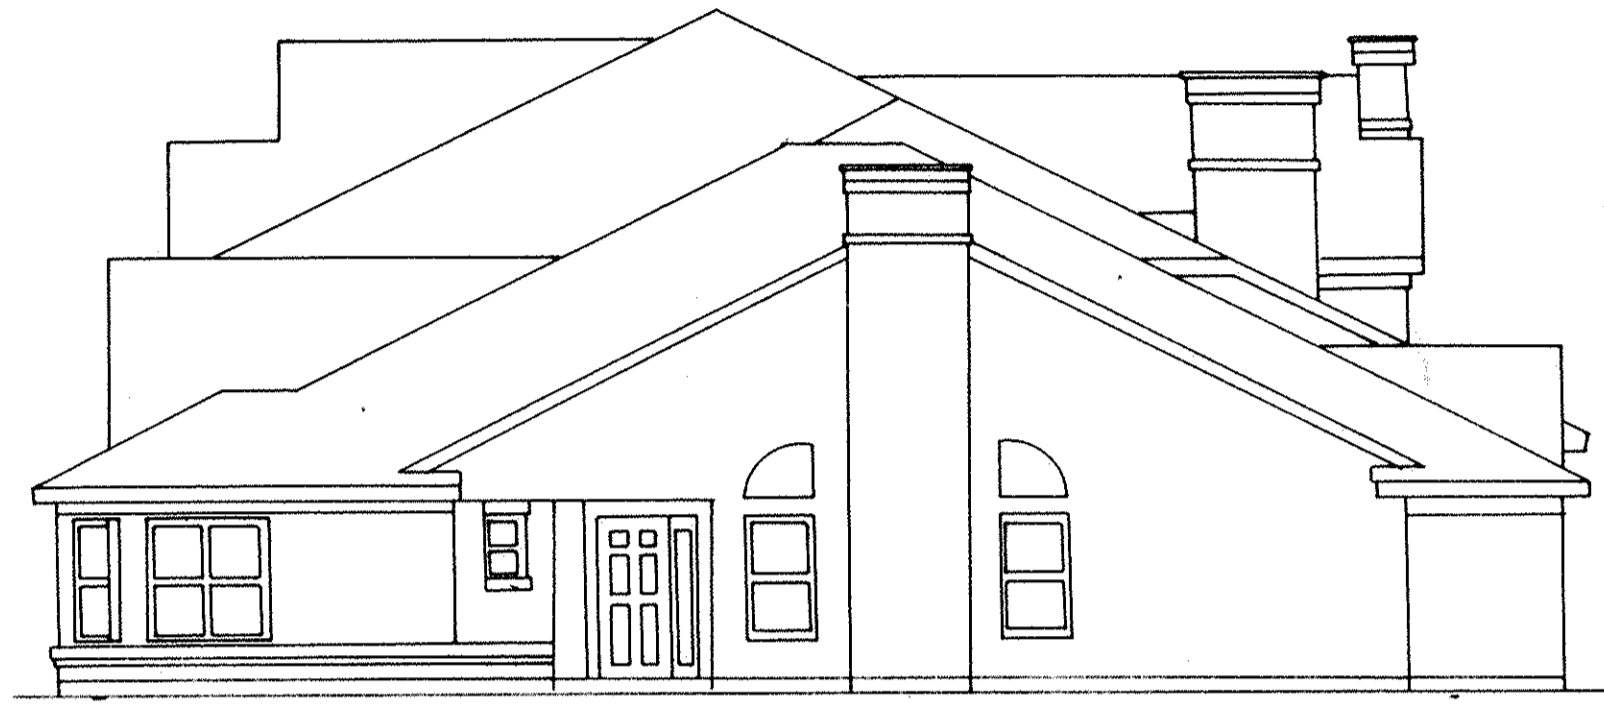

RIGHT SIDE ELEVATION

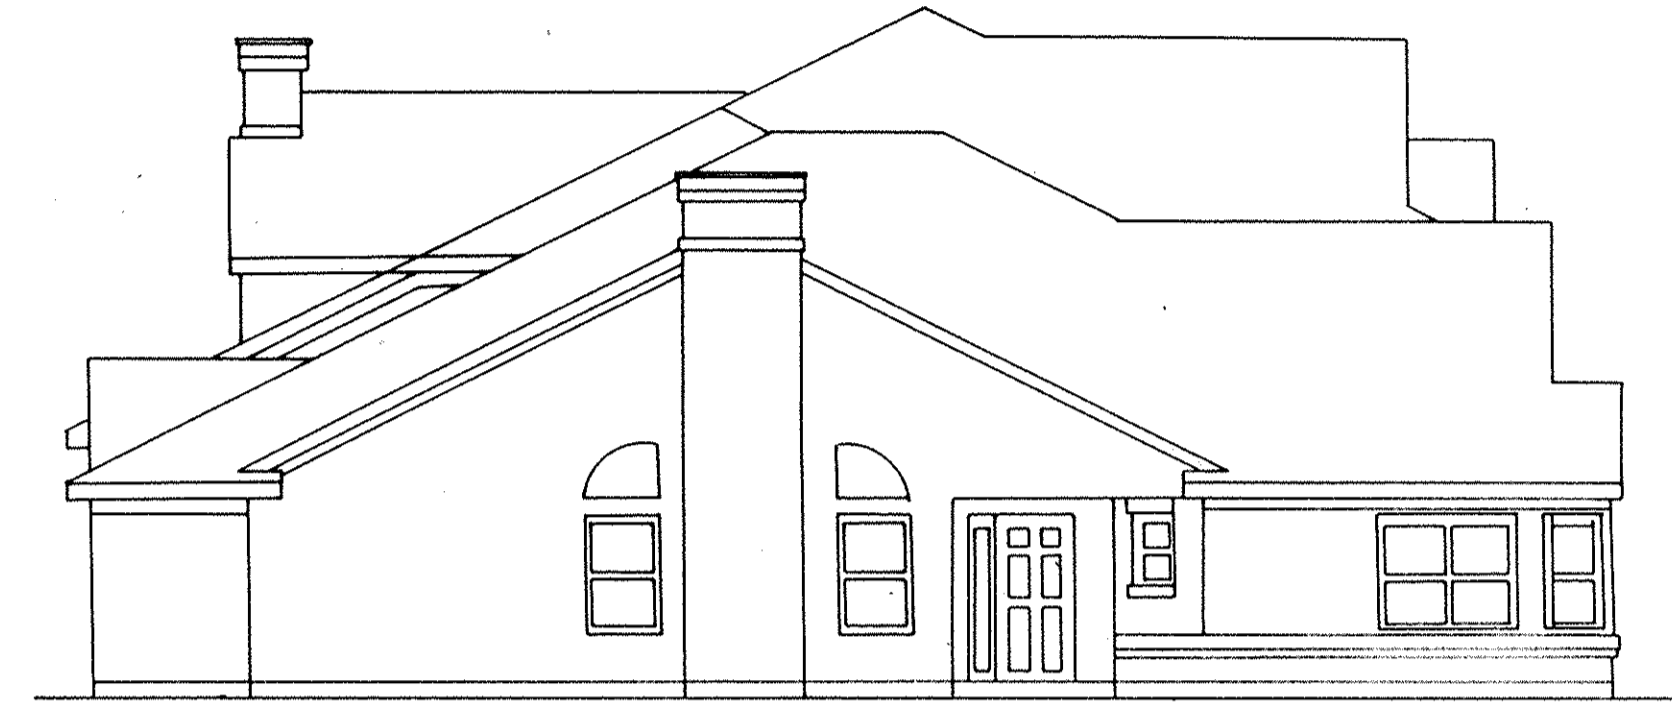

LEFT SIDE ELEVATION



FRONT ELEVATION




REAR ELEVATION

LORAIN COUNTY TAX
MAP DEPARTMENT COPY


45/67
SHEET 2 of 4

102071

102071 45/68

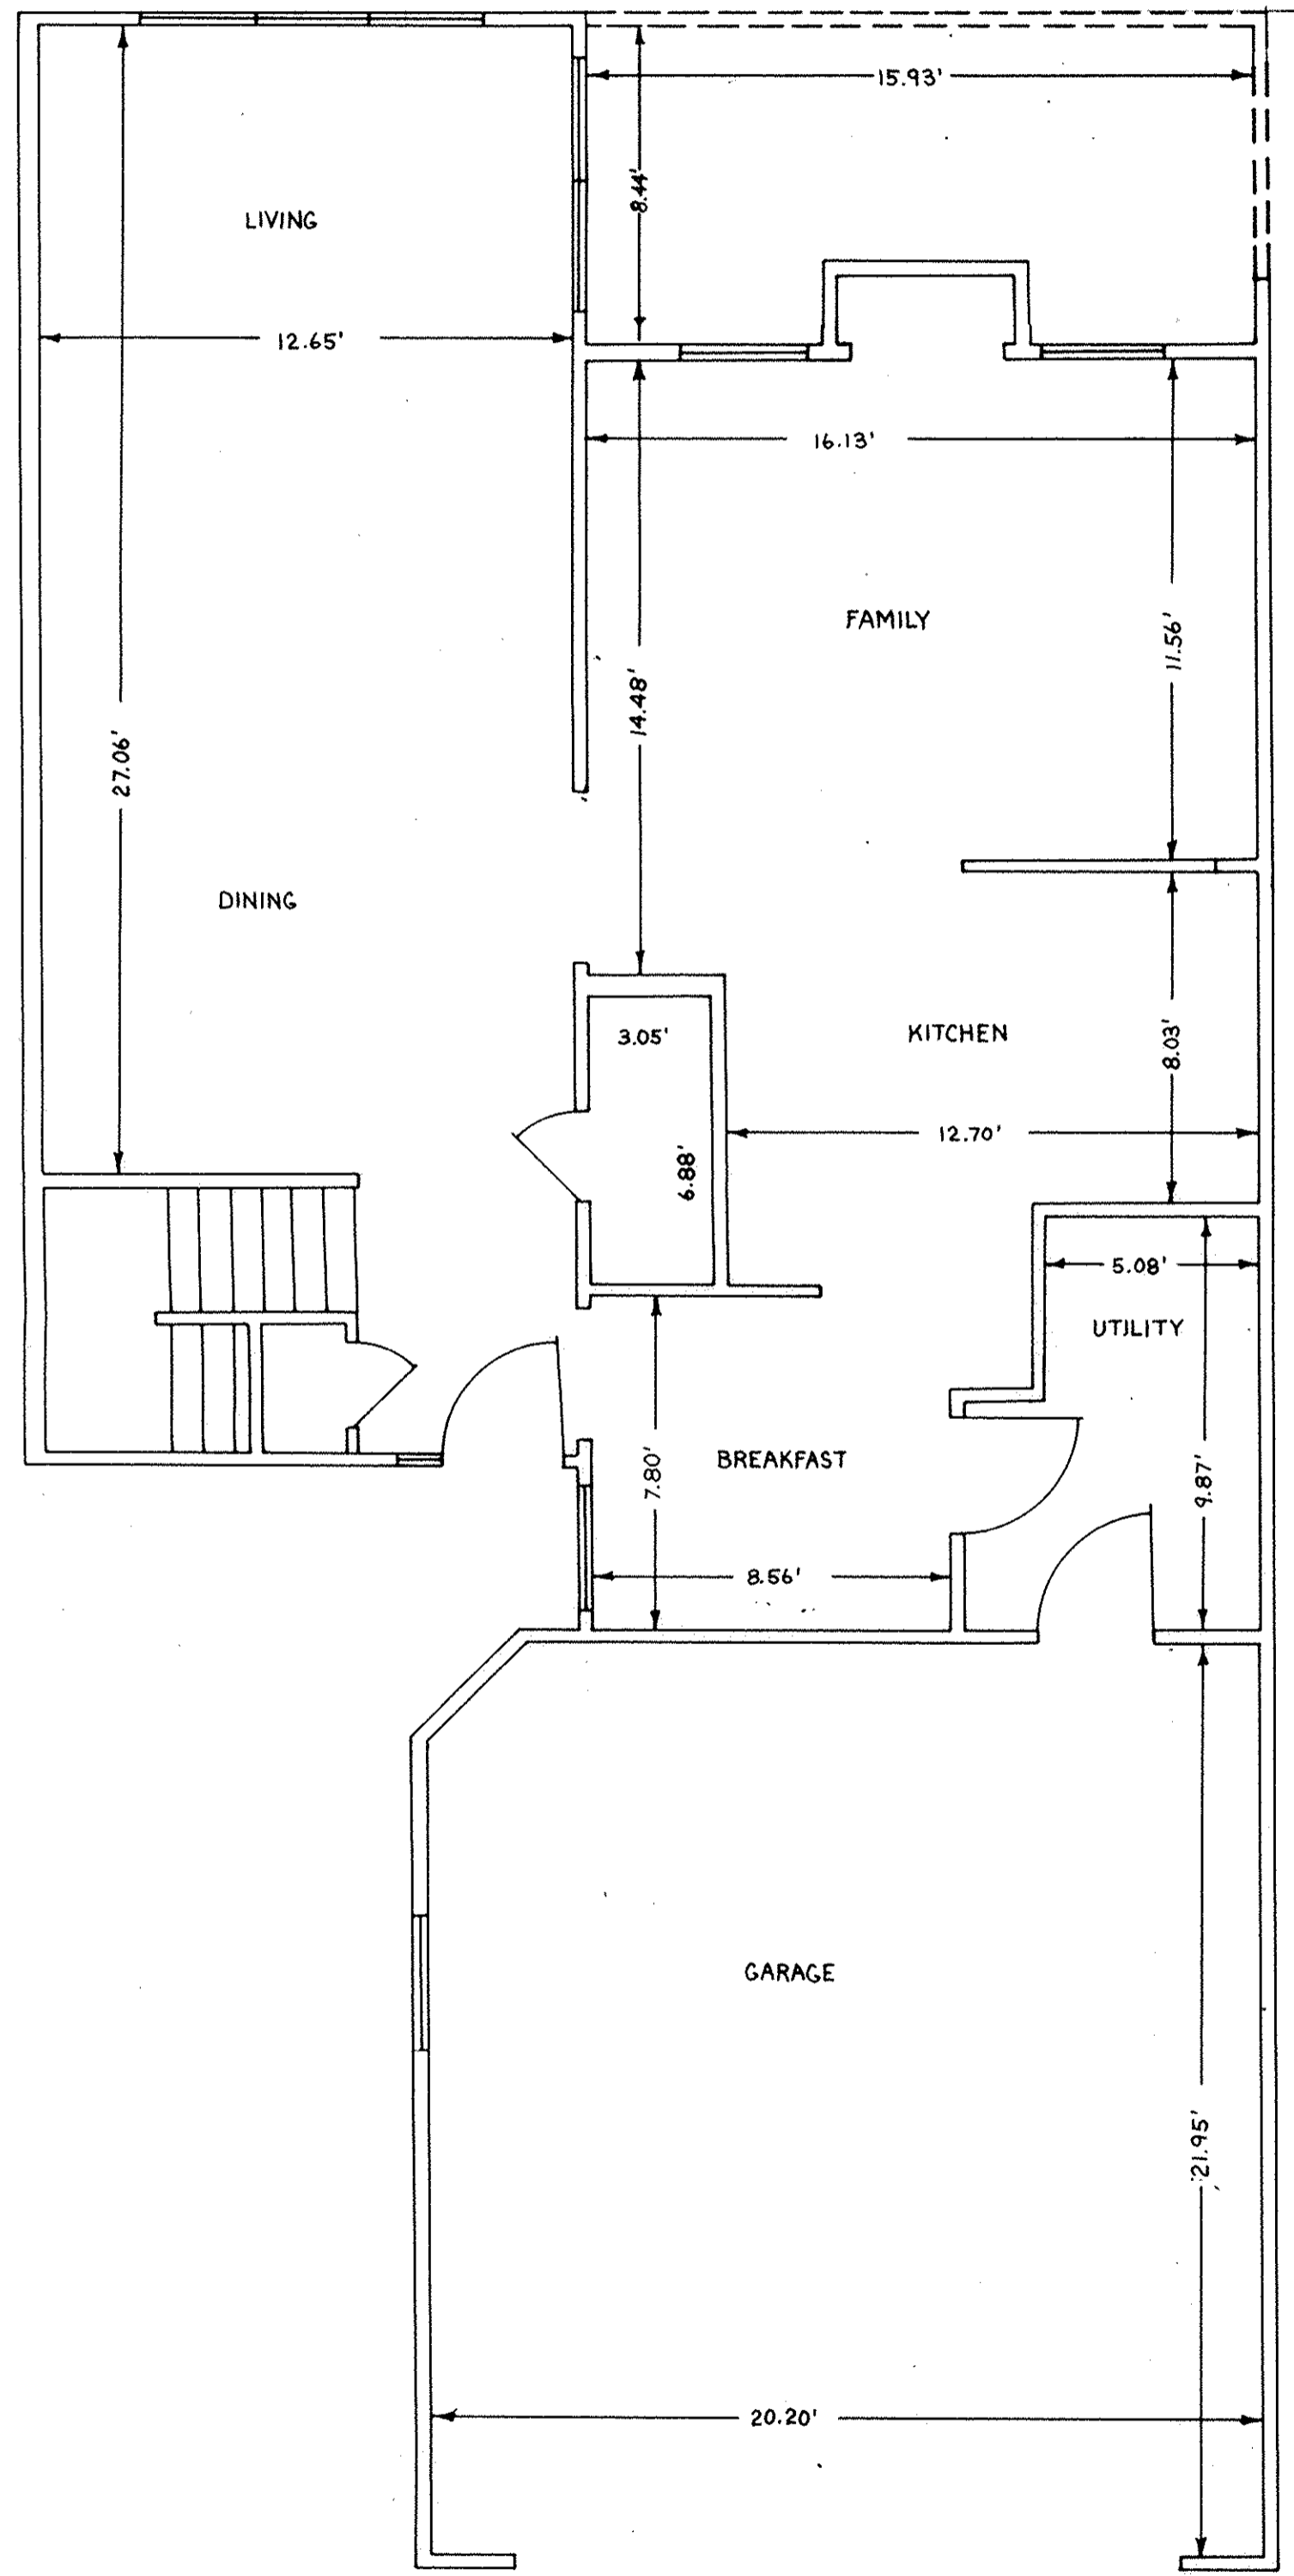

FIRST FLOOR PLAN
UNIT 18-146

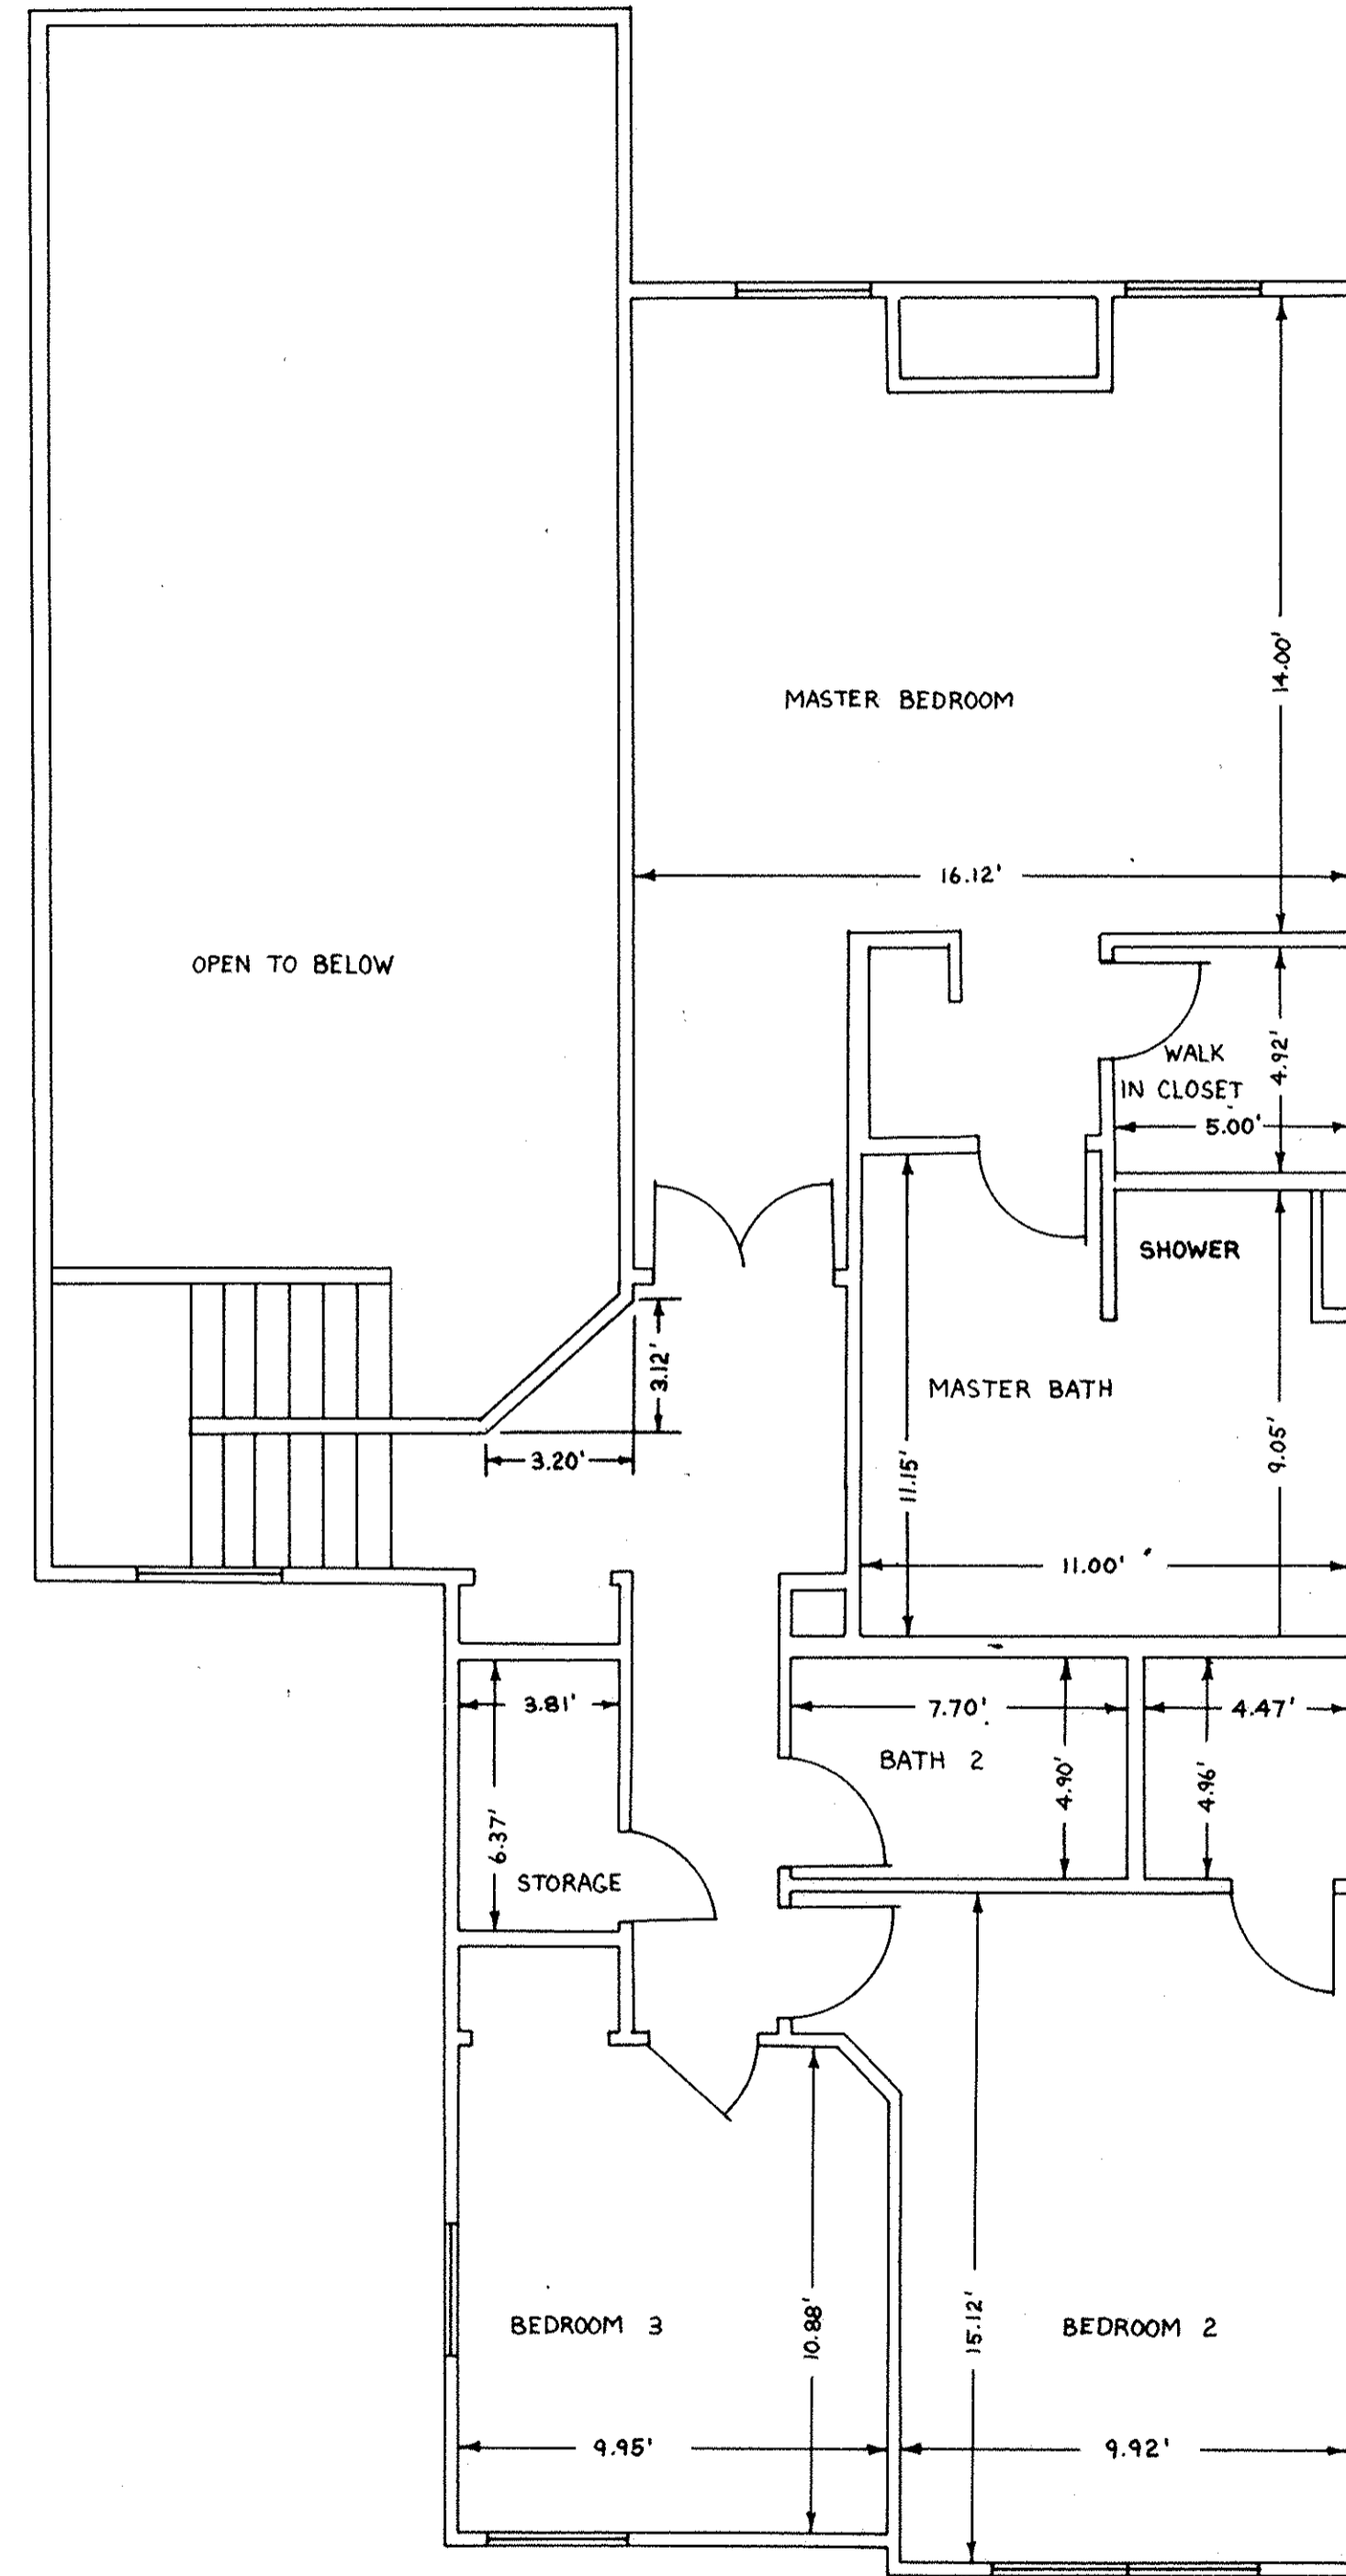

SECOND FLOOR PLAN
UNIT 18-146


SCALE: 1/4" = 1'

LORAIN COUNTY TAX
MAP DEPARTMENT COPY


45/68
SHEET 3 OF 4

102021

102071 45/69

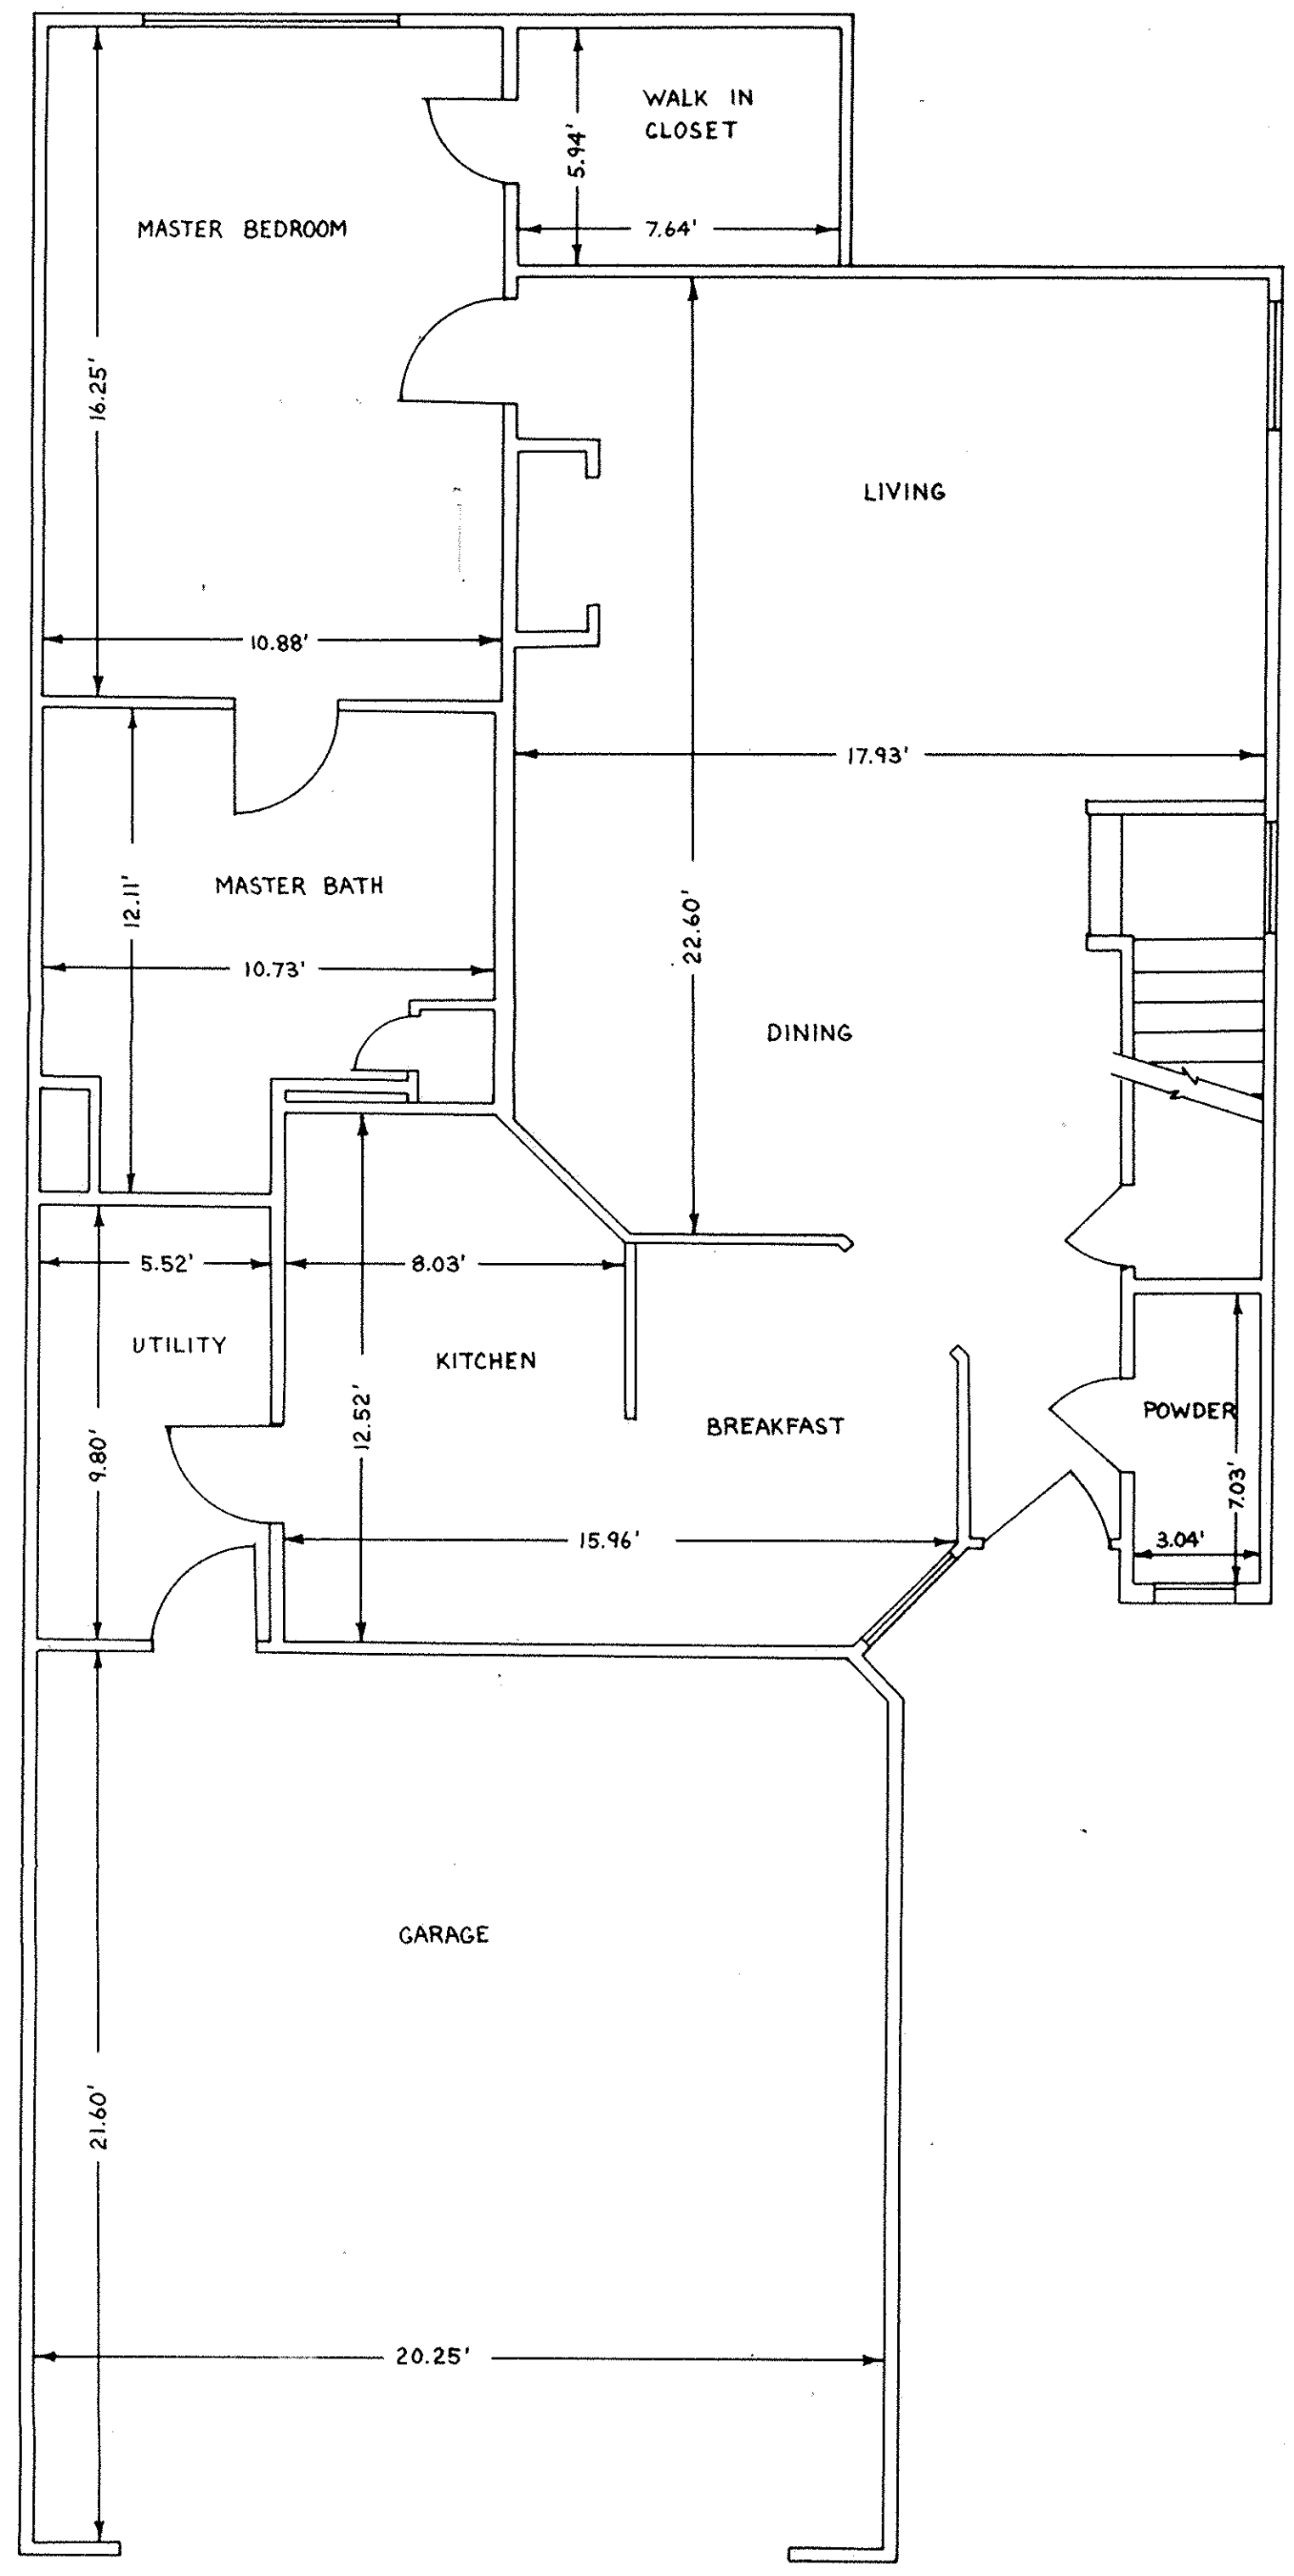

FIRST FLOOR PLAN
UNIT 17-145

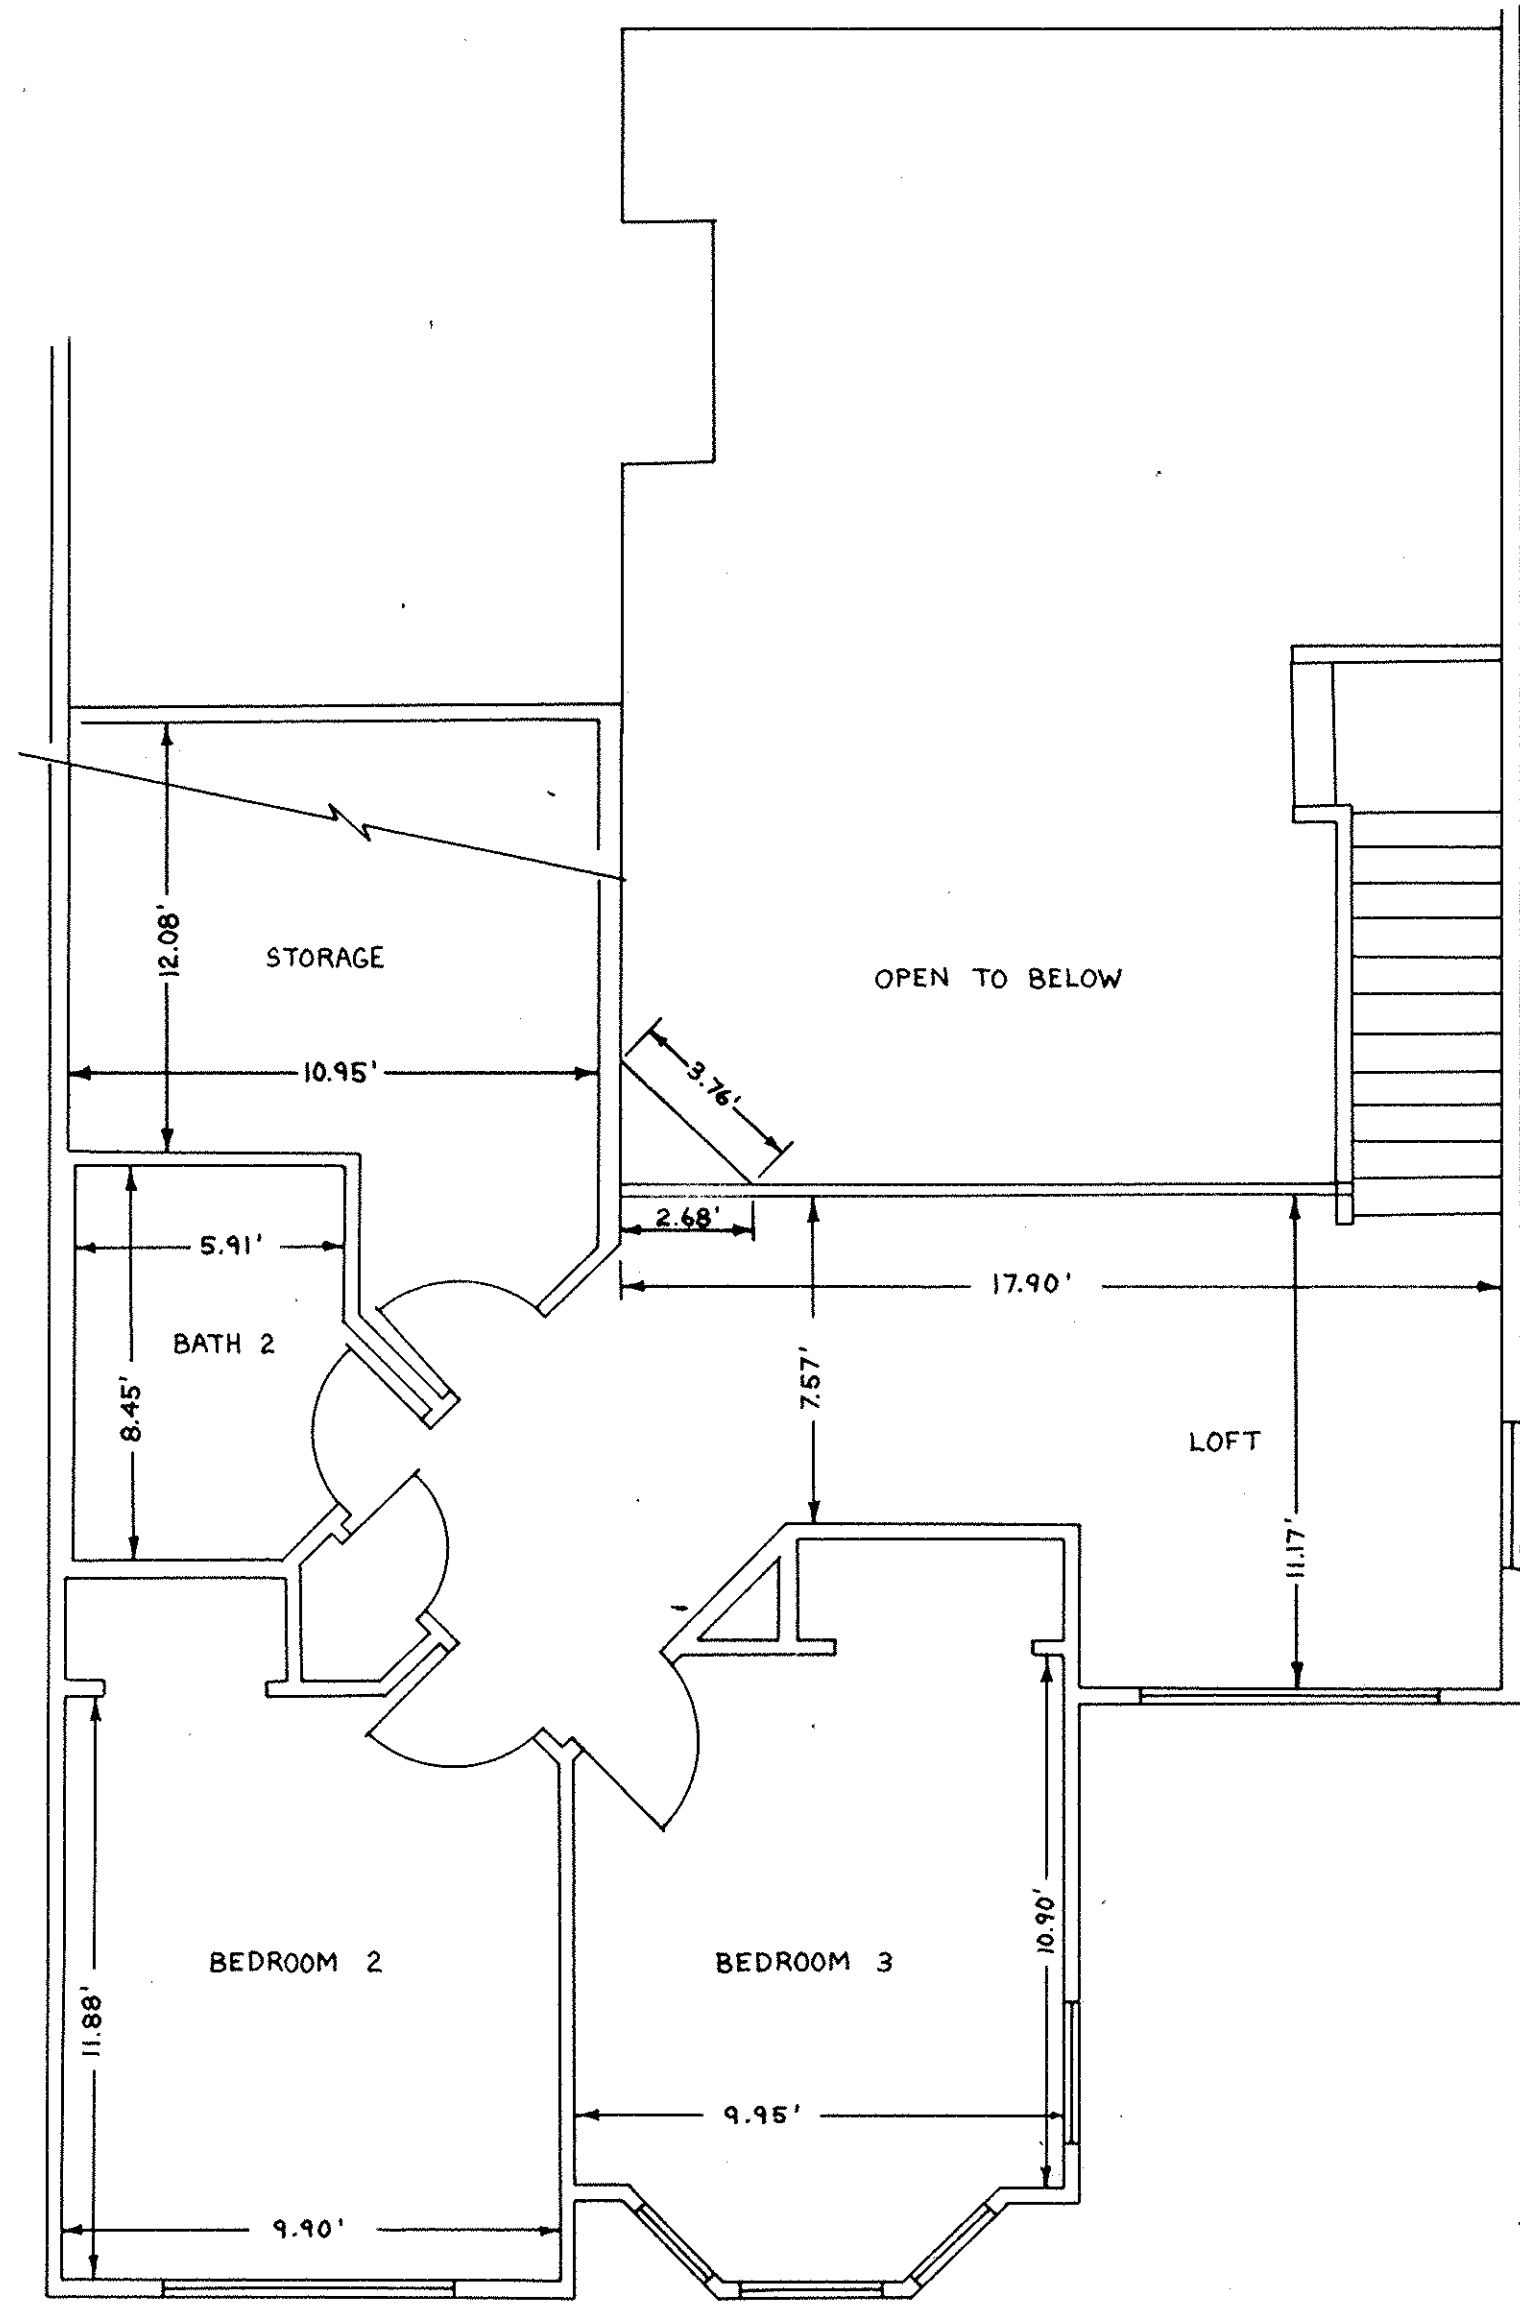

SECOND FLOOR PLAN
UNIT 17-145

SCALE: 1/4" = 1'

LORAIN COUNTY TAX
MAP DEPARTMENT COPY

45/69
SHEET 4 of 4