

Unit Numbers and Reestablished Percentages of Interest in Combined Common Areas and Facilities



Parcel No. 1:	Unit #	Square Feet	% of Combined Common Areas & Facilities	
Parcel No. 1-A:	1-148	1424	1.7504	
	2-149	1703	2.0934	
	3-150	1787	2.1966	
	4-151	1424	1.7504	
	5-152	1424	1.7504	
	6-153	1910	2.3478	
	7-154	1703	2.0934	
	8-155	1424	1.7504	
	9-156	1424	1.7504	
	10-157	1703	2.0934	
	11-158	1787	2.1966	
	12-159	1424	1.7504	
	13-160	1703	2.0934	
	14-161	1787	2.1966	
	15-162	1424	1.7504	
Parcel No. 1-B:	16-144	1424	1.7504	
	17-145	1703	2.0934	
	18-146	1787	2.1966	
	19-147	1424	1.7504	
	Parcel No. 1-C:	20-128	1424	1.7504
		21-129	1891	2.3245
		22-130	1703	2.0934
		23-131	1424	1.7504
		24-132	1424	1.7504
		25-133	1787	2.1966
		26-134	1703	2.0934
		27-135	1703	2.0934
		28-136	1787	2.1966
		29-137	1703	2.0934
		30-138	1424	1.7504
31-139		1787	2.1966	
32-140		1703	2.0934	
33-141		1703	2.0934	
34-142		1924	2.3650	
35-143	1424	1.7504		
Parcel No. 2:	36-163	1424	1.7504	
	37-164	1703	2.0934	
	38-165	1787	2.1966	
	39-166	1424	1.7504	
Parcel No. 1-C:	40-167	1424	1.7504	
	41-168	1787	2.1966	
	42-169	1703	2.0934	
	43-170	1703	2.0934	
	44-171	2029	2.4941	
	45-172	1424	1.7504	
	46-173	1424	1.7504	
	47-174	1787	2.1966	
	48-175	1703	2.0934	
	49-176	1703	2.0934	
	50-177	1424	1.7504	

WESTWINDS JOINT VENTURE  
9.2538 AC.  
D.V. 1382 P. 59

JAMES A. & ANITA HAMMOND  
D.V. 1022 P. 785

CERTIFICATION  
THIS IS TO CERTIFY THAT THE ATTACHED DRAWINGS CORRECTLY REPRESENT THE BUILDINGS AS CONSTRUCTED AND THAT THERE ARE NO ENCROACHMENTS ON ADJACENT PROPERTIES.

David L. Elwell  
DAVID L. ELWELL  
REG. SURVEYOR NO. 6333

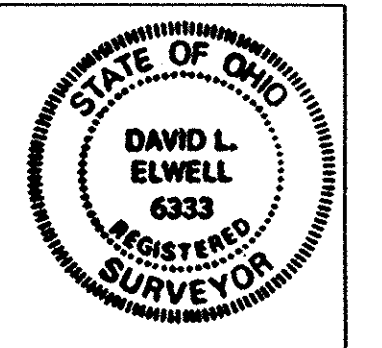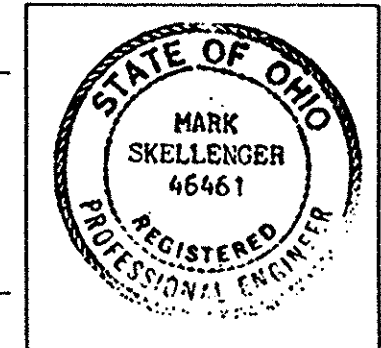

WESTWINDS SOUTH CONDOMINIUM NUMBER 1  
THIRD AMENDMENT PHASE 4  
PART OF AVON TOWNSHIP SECTION N° 30  
CITY OF AVON LAKE - COUNTY OF LORAIN - STATE OF OHIO

PREPARED BY:




Received for Record APR - 5 1991  
at 4:13 clock P. M. in RECORD  
VOL 47 DOROTHY L. ESSEX #216.00  
PAGE 22-26 Lorain County Recorder  
incl. Cor: Lorain County Title Co. f.m.

TRANSFERRED  
IN COMPLIANCE WITH SEC. 319.022  
OHIO REV. CODE  
APR 5 1991  
JULIAN A. PIJOR  
LORAIN COUNTY AUDITOR

LORAIN COUNTY TAX  
MAP DEPARTMENT COPY


UNIT 36-163 (REVERSED)  
 UNIT 39-166  
 UNIT 40-167 (REVERSED)  
 UNIT 45-172  
 UNIT 46-173  
 UNIT 50-177 (REVERSED)

SINGLE FLOOR PLAN  
 SCALE: 1/4" = 1'-0"

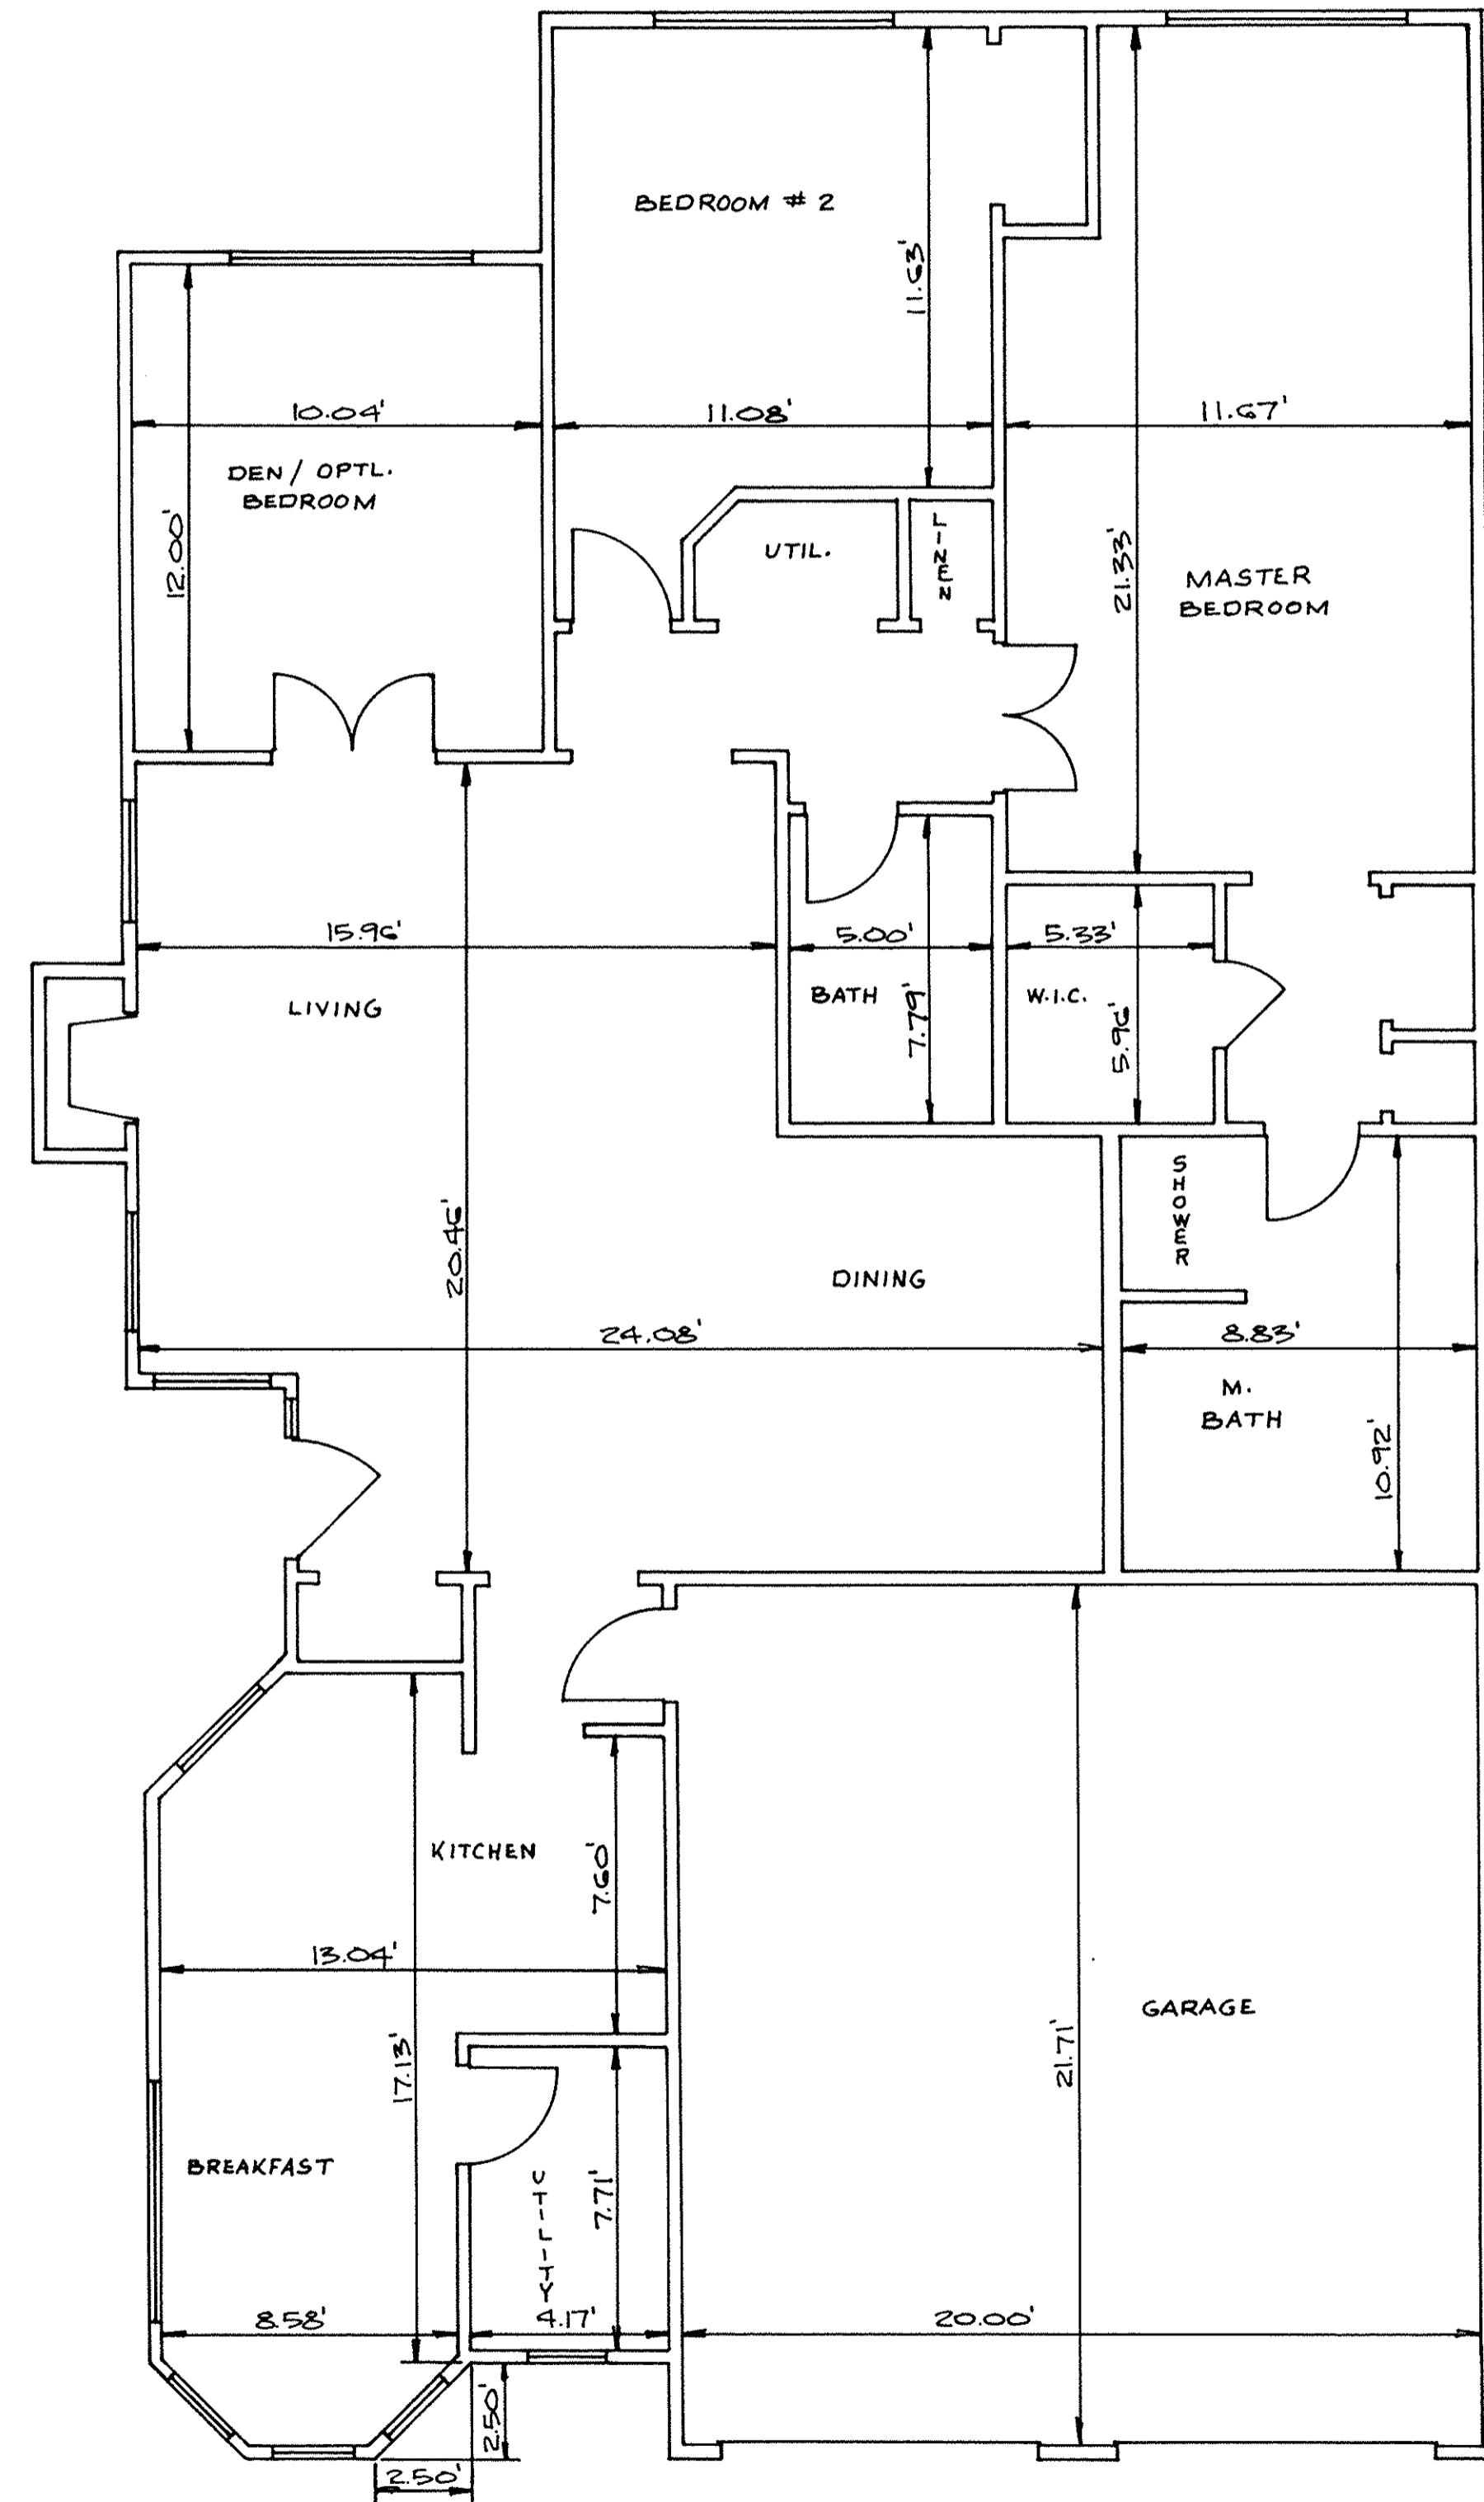



UNIT 44-171

FIRST FLOOR PLAN  
 SCALE: 1/4" = 1'-0"

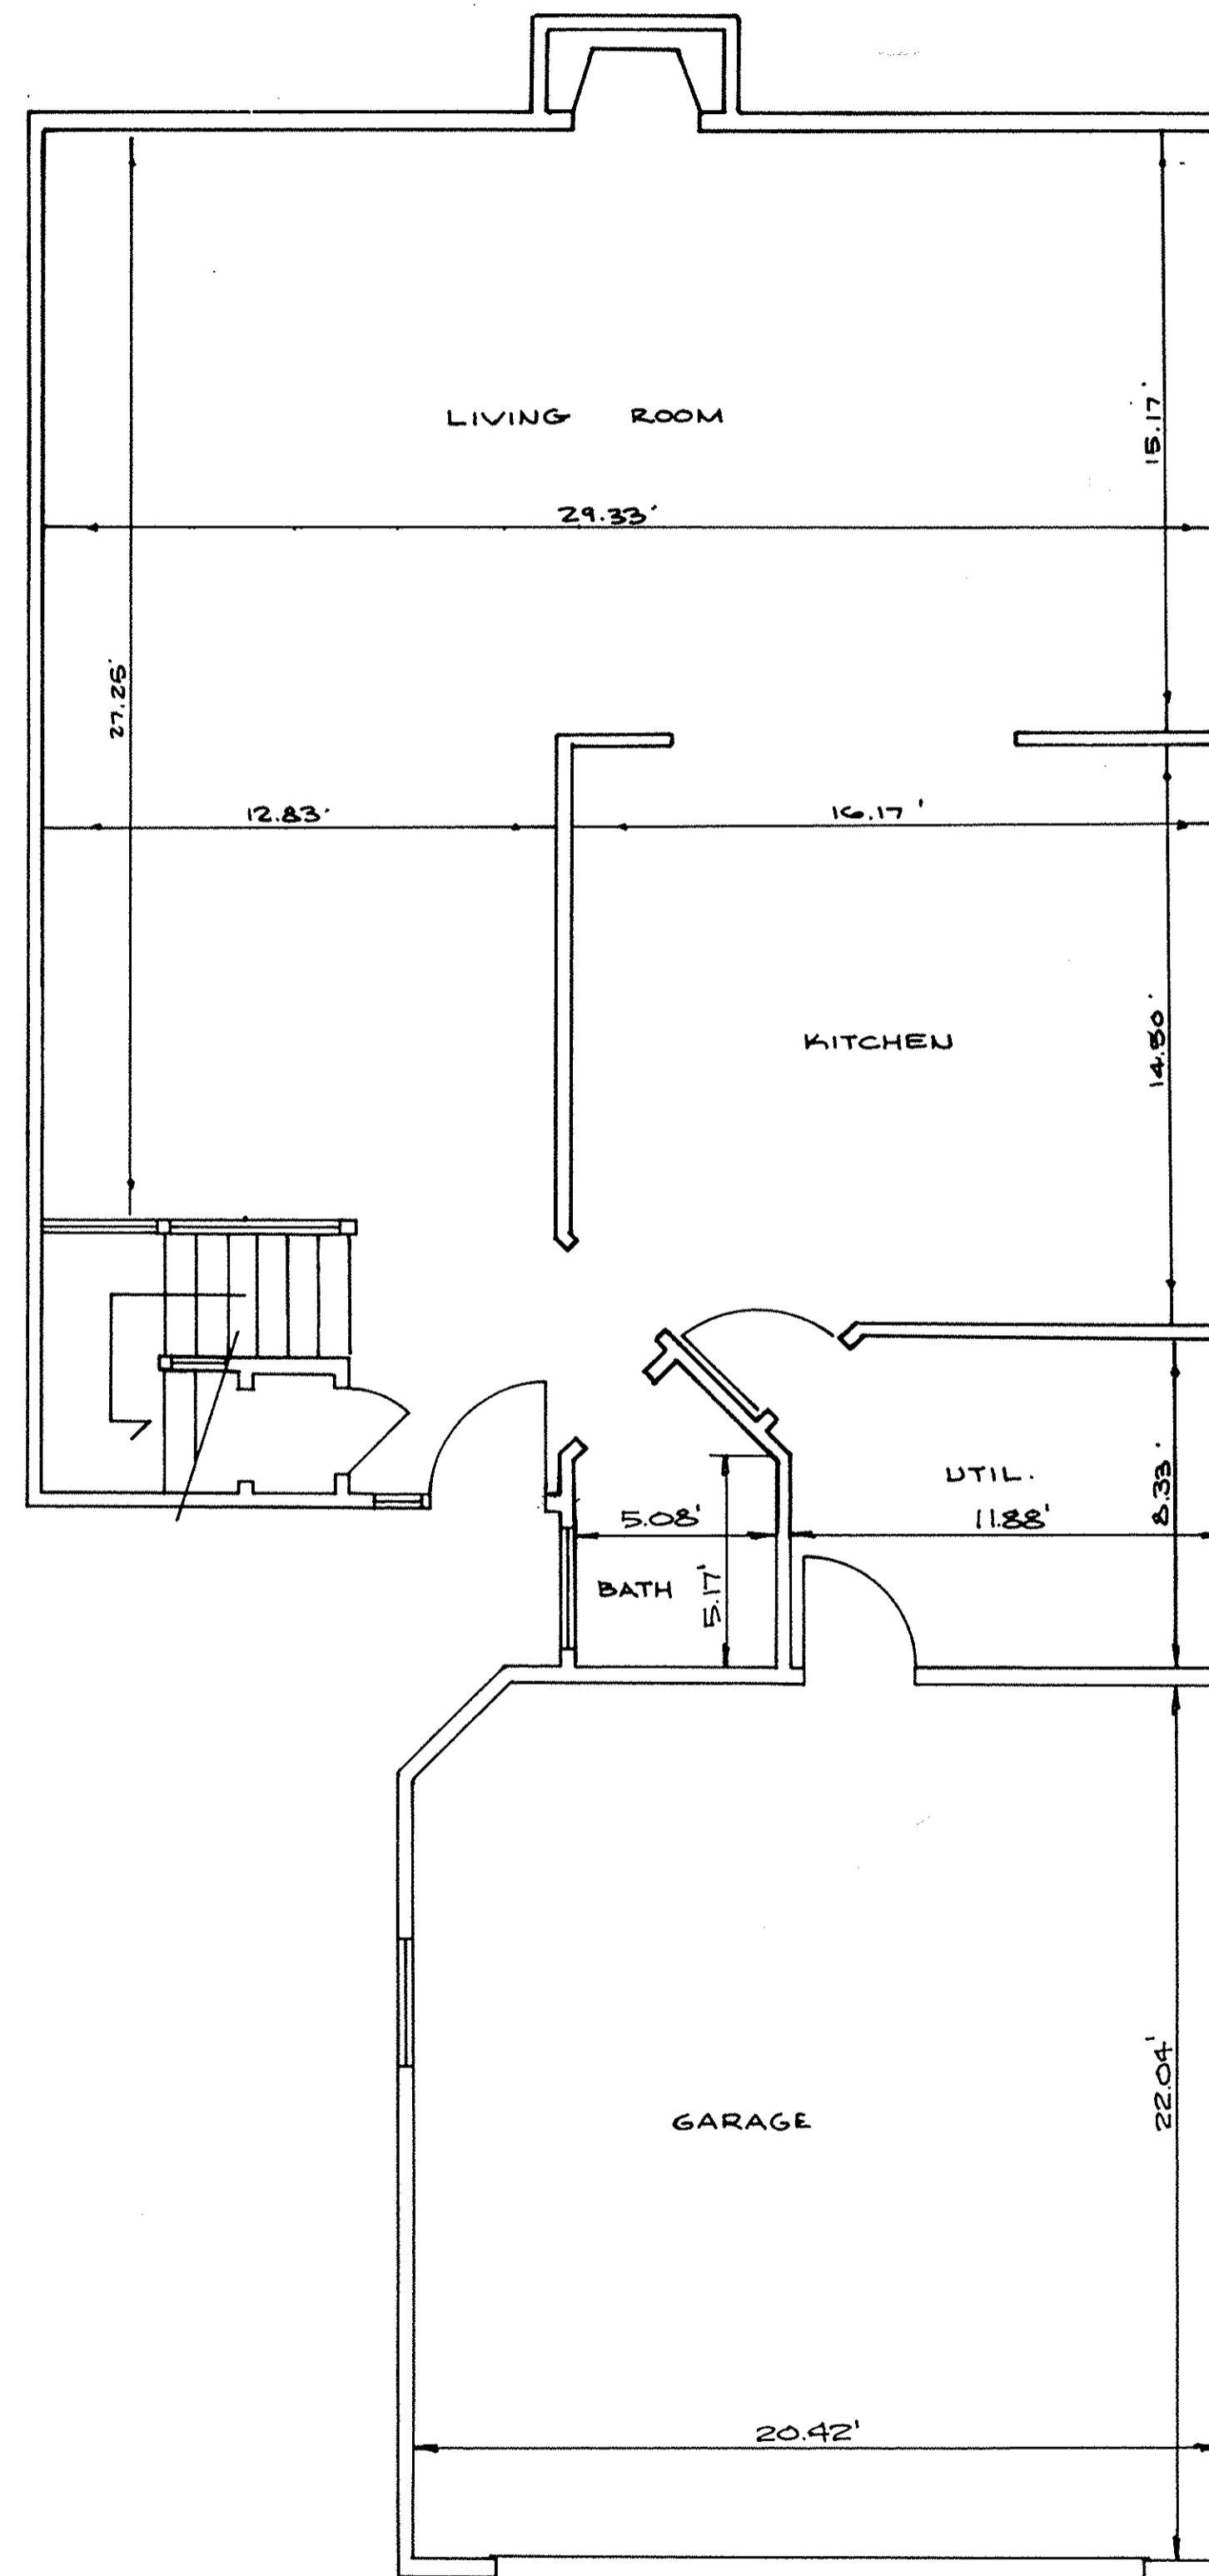


SECOND FLOOR PLAN  
 SCALE: 1/4" = 1'-0"

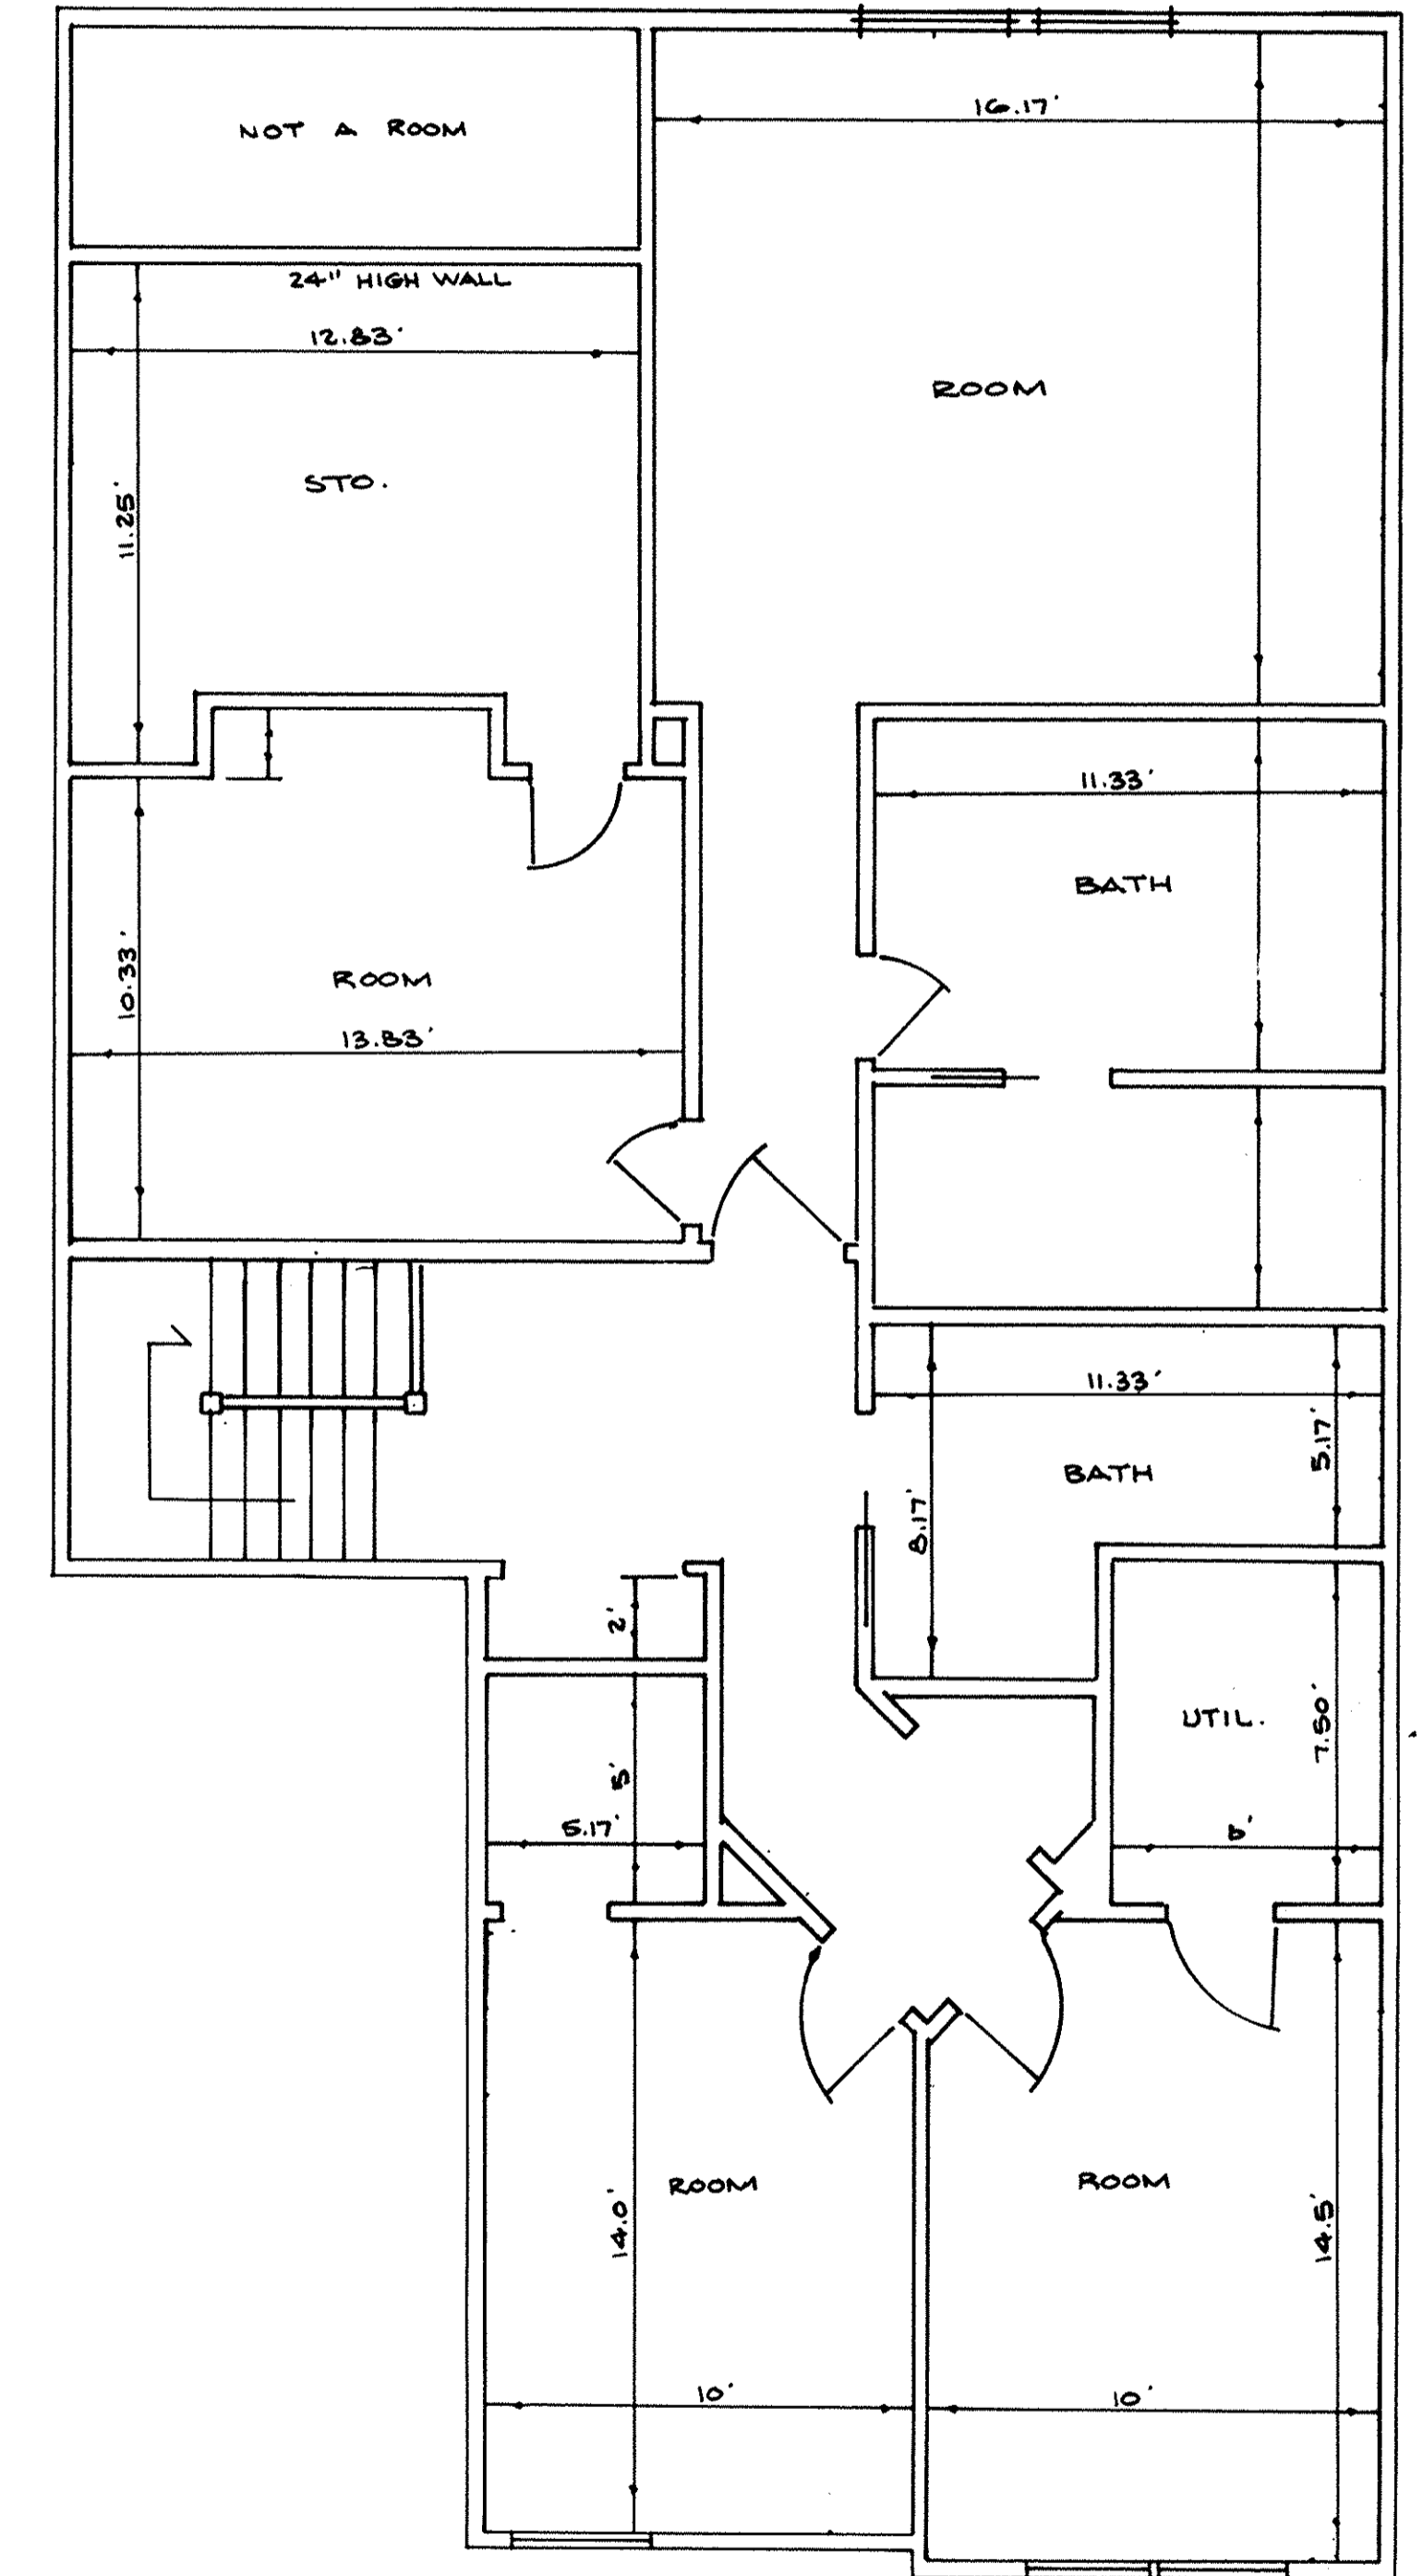

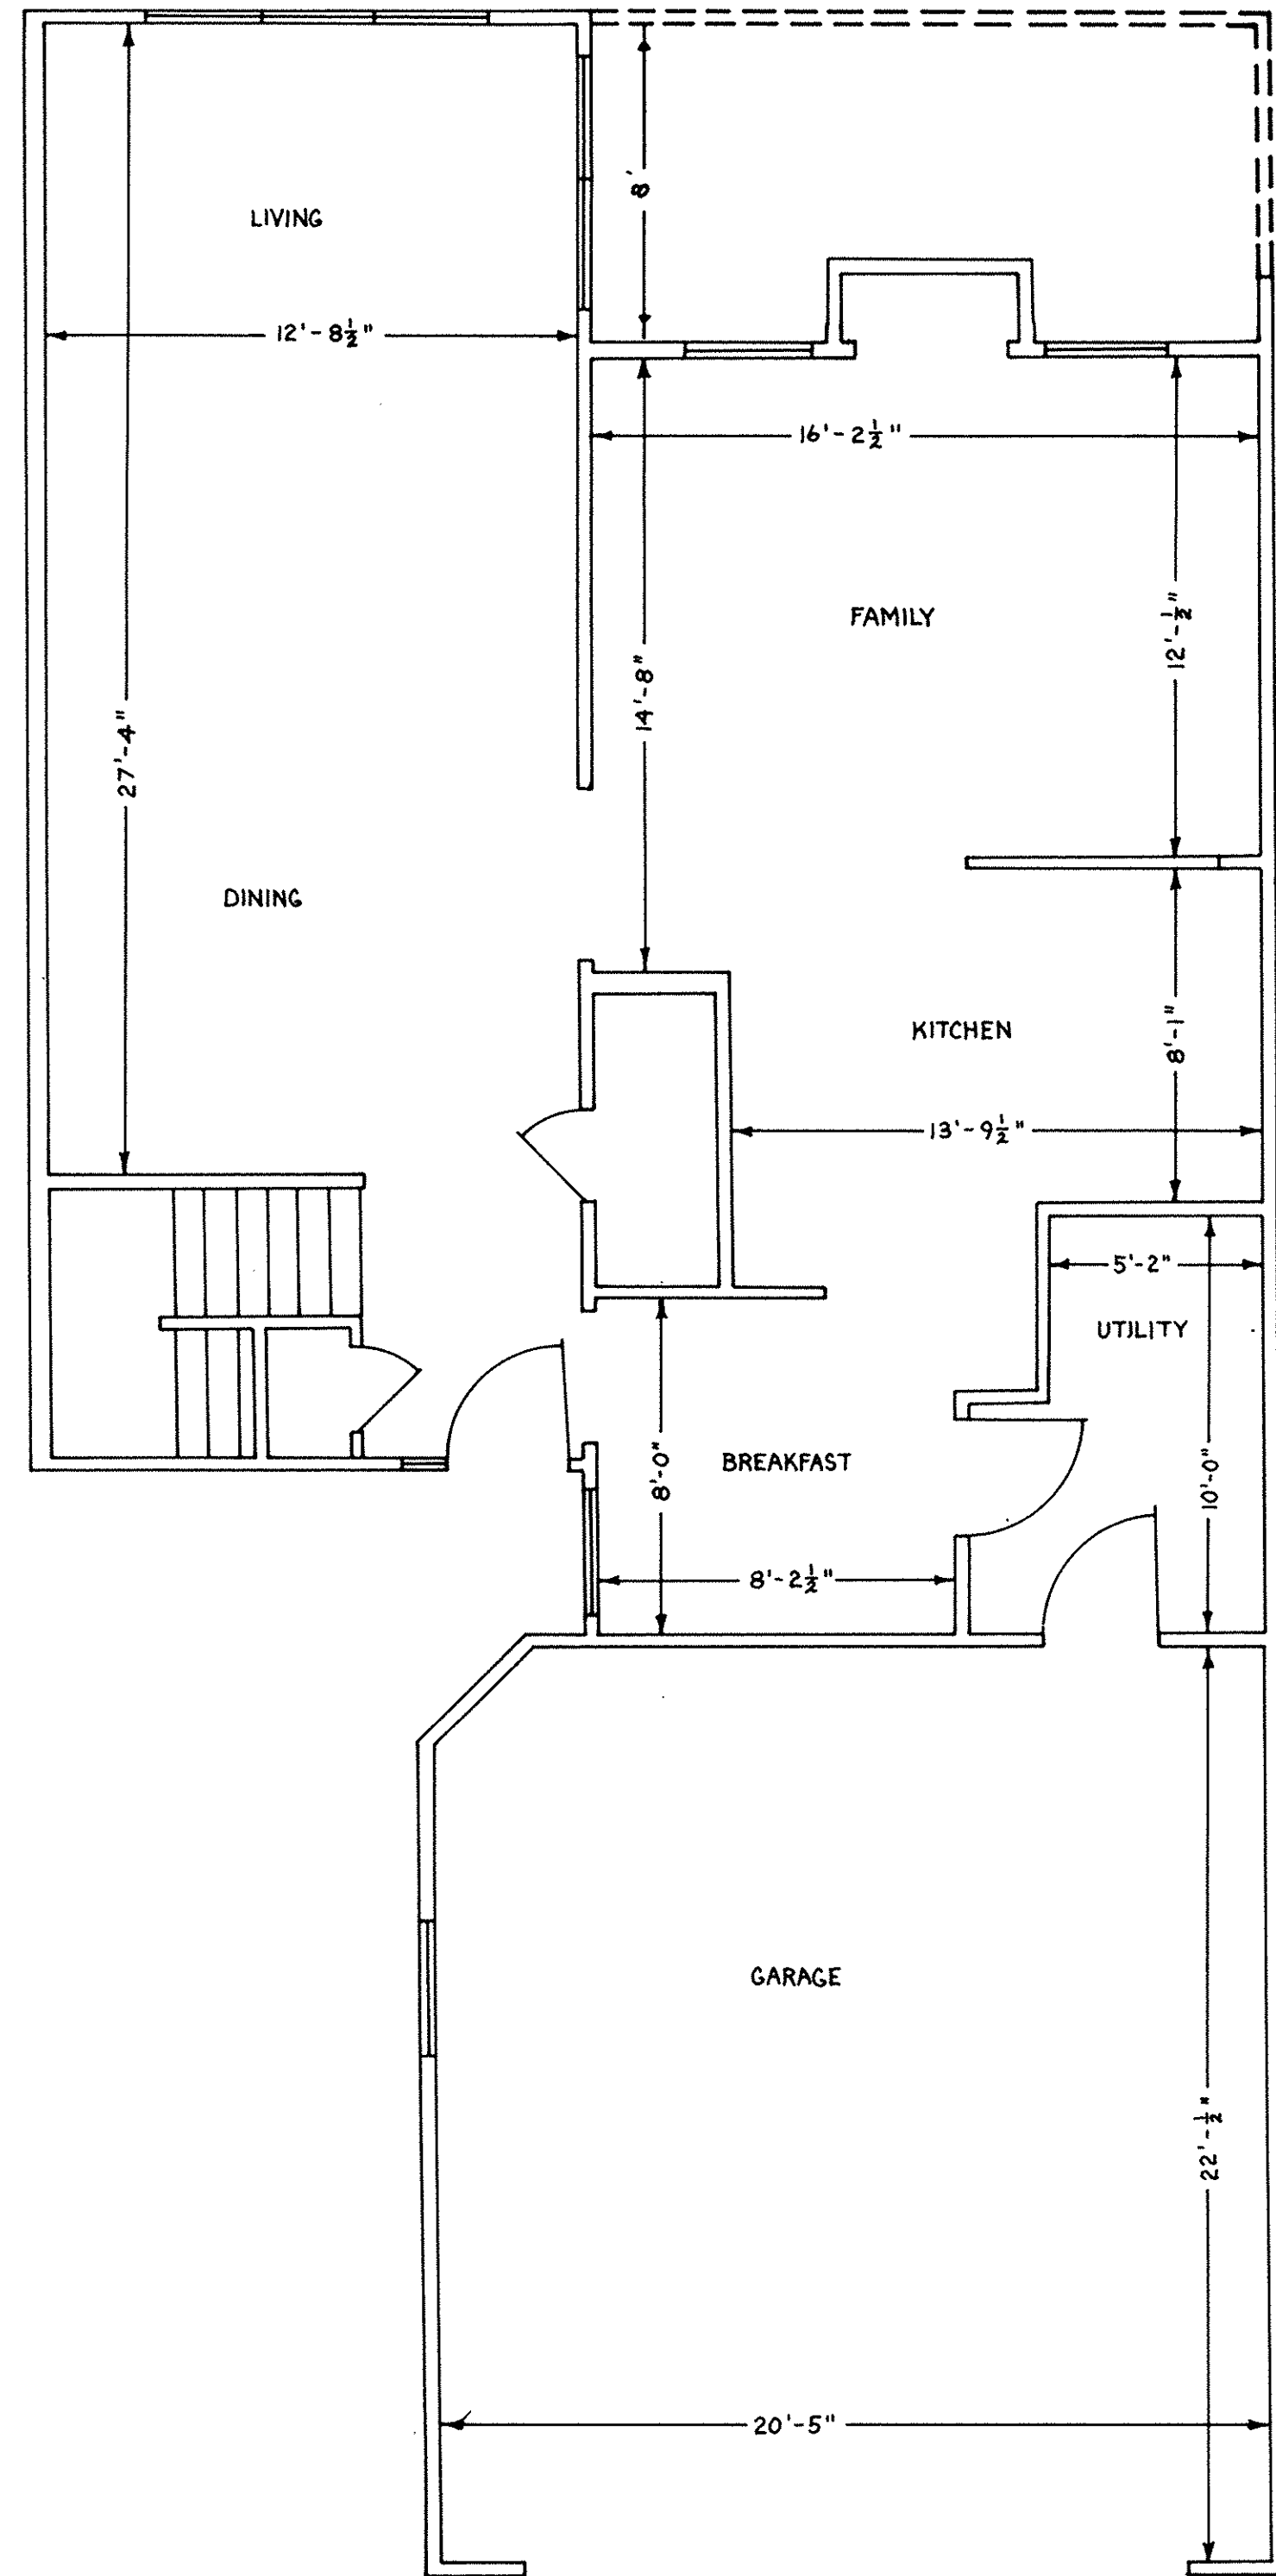

FIRST FLOOR PLAN

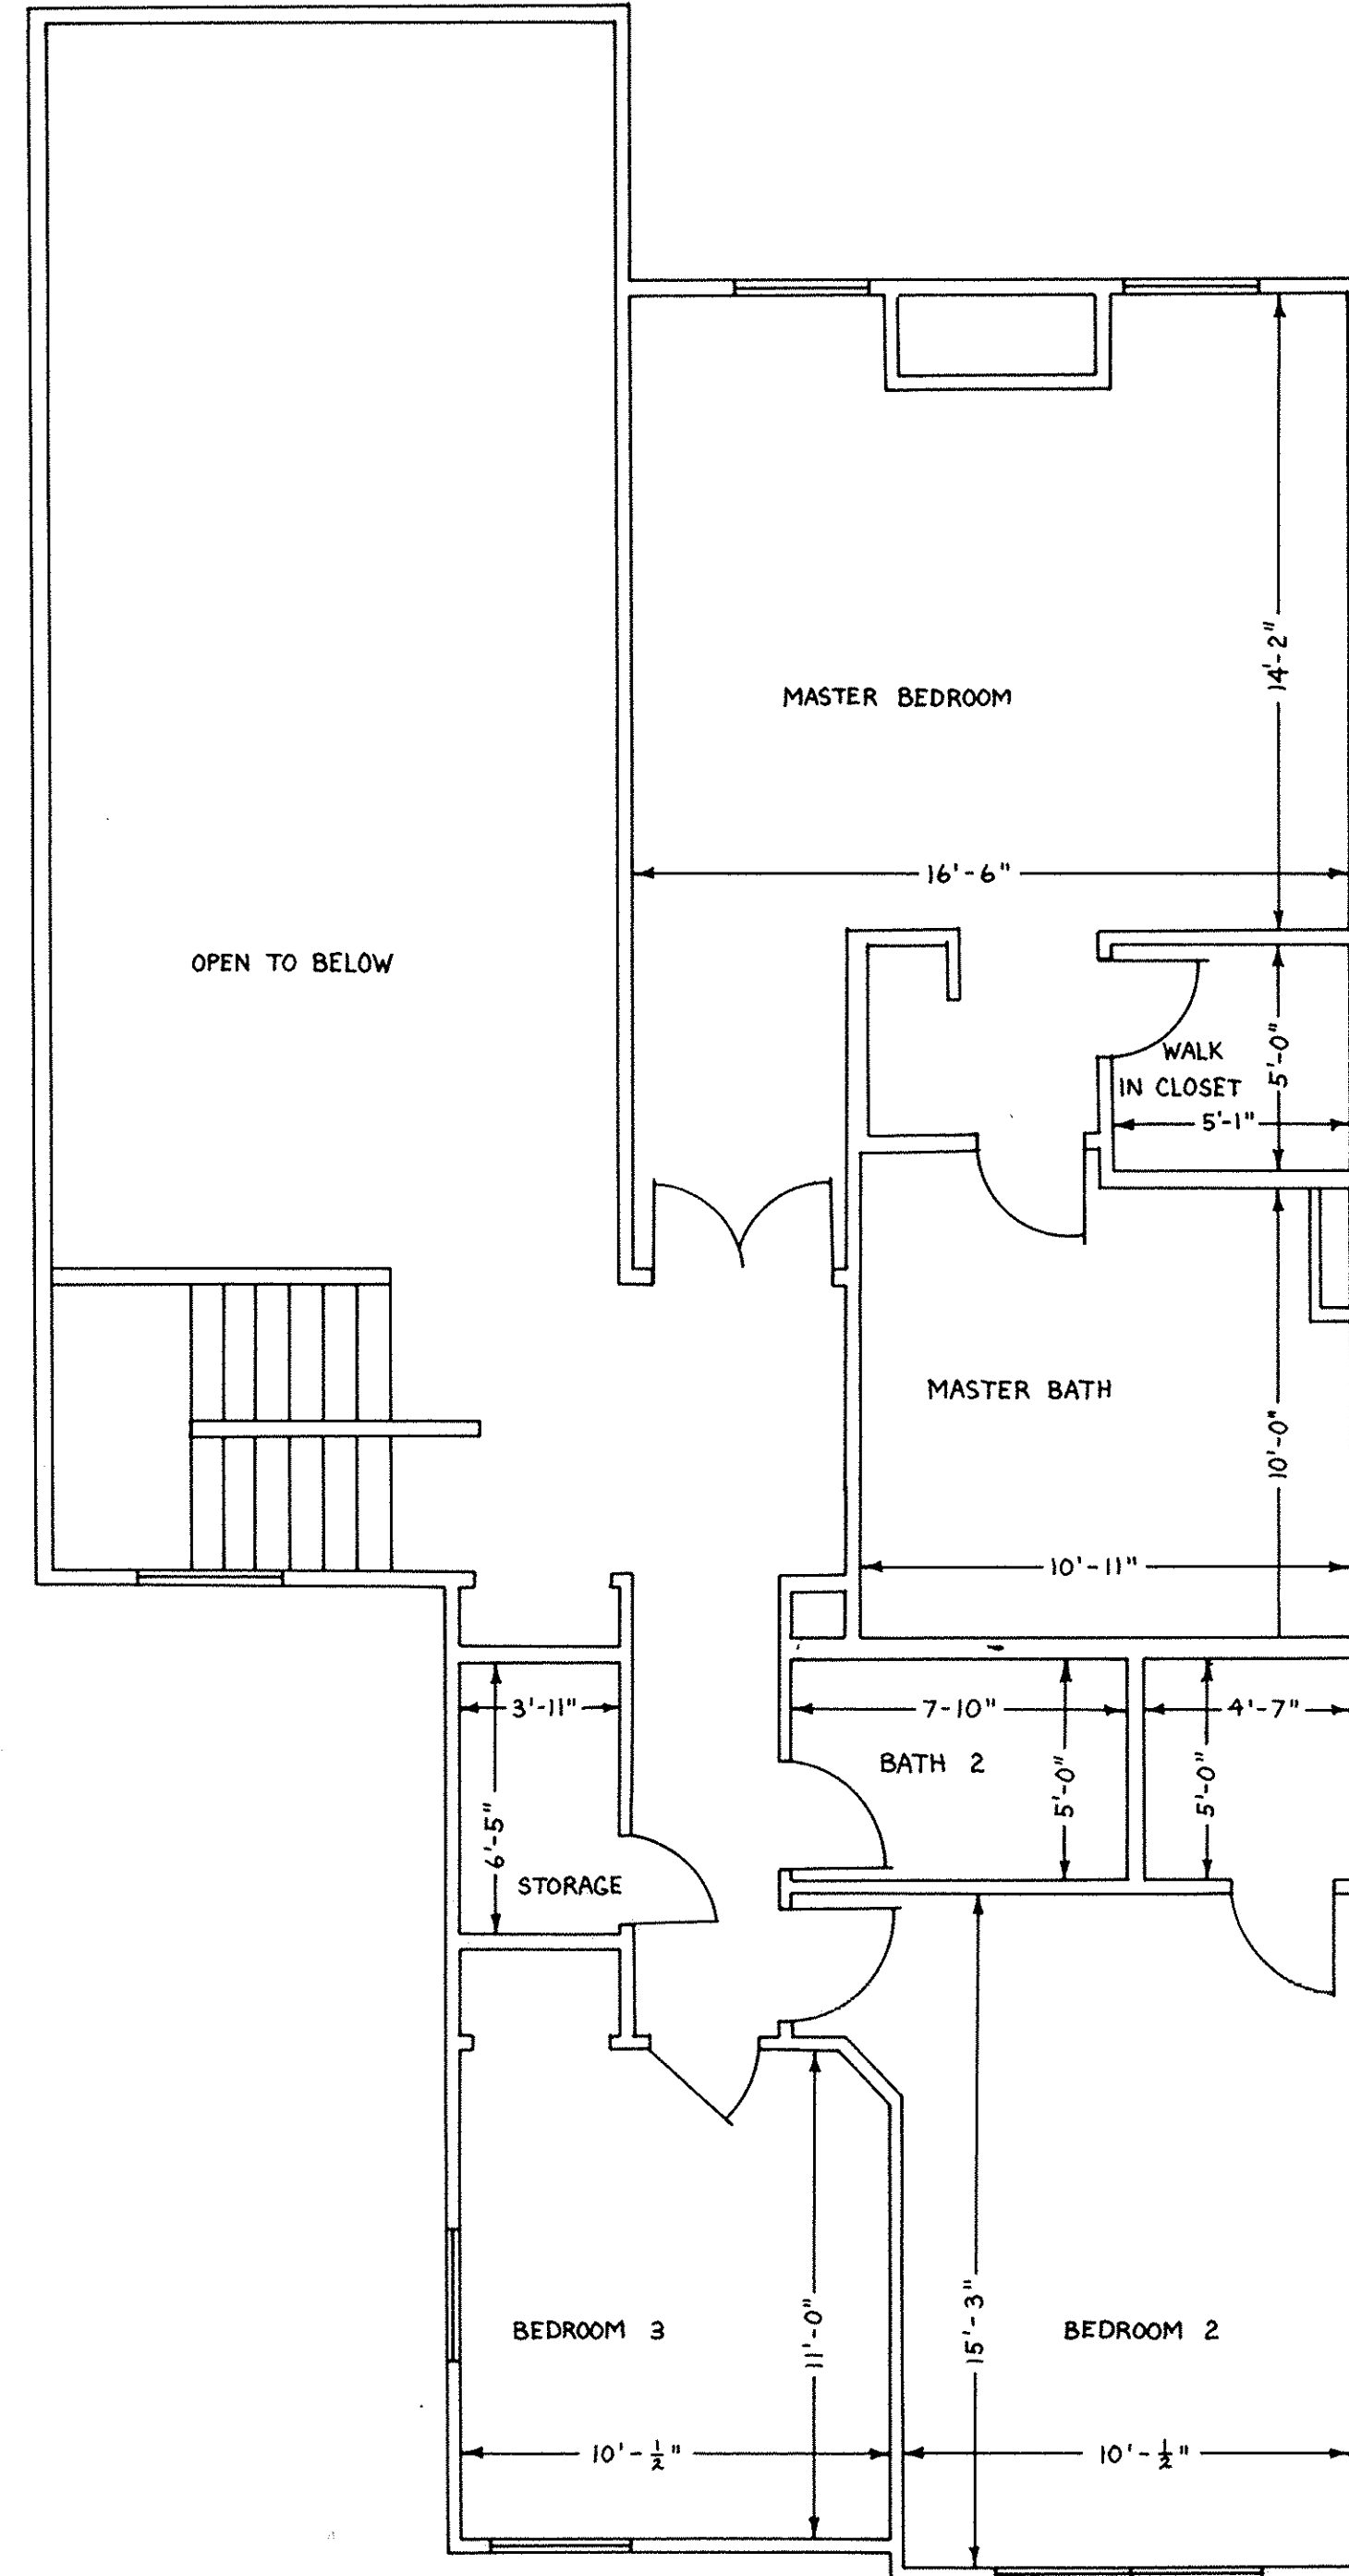


SECOND FLOOR PLAN

UNIT 38-165  
 UNIT 41-168 (REVERSED)  
 UNIT 47-174


SCALE: 1/4" = 1'


FIRST FLOOR PLAN  
SCALE: 1/4" = 1'-0"

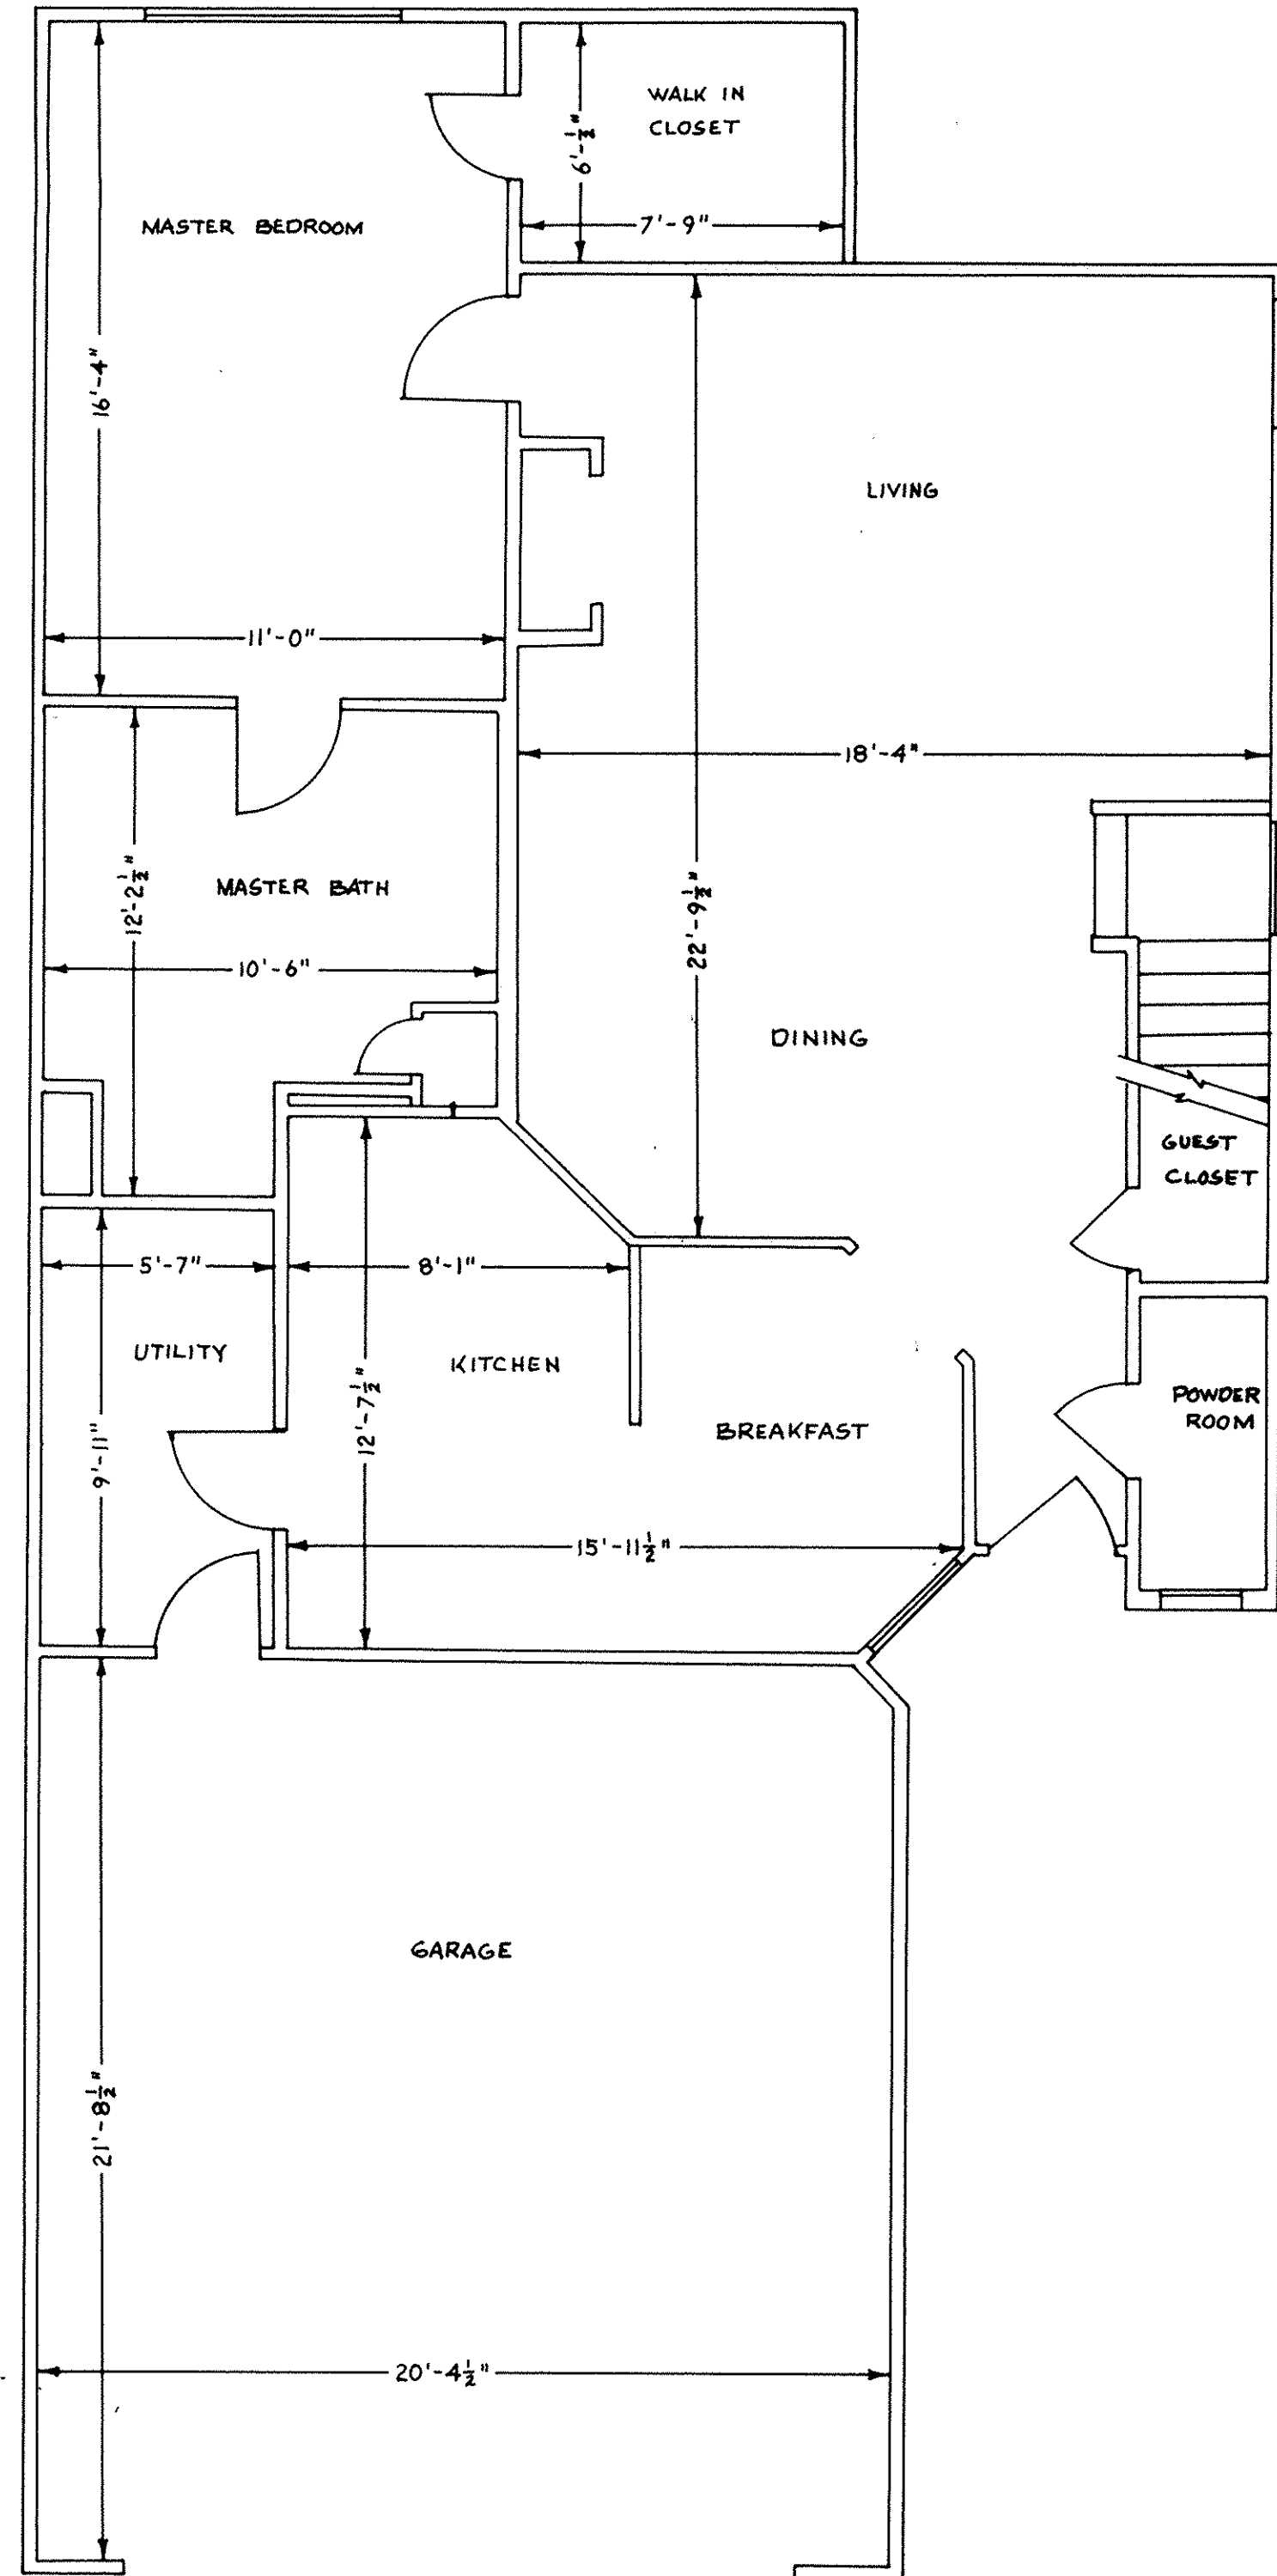


- UNIT 37-164
- UNIT 42-169 (REVERSED)
- UNIT 43-170
- UNIT 48-175
- UNIT 49-176

SECOND FLOOR PLAN  
SCALE: 1/4" = 1'-0"

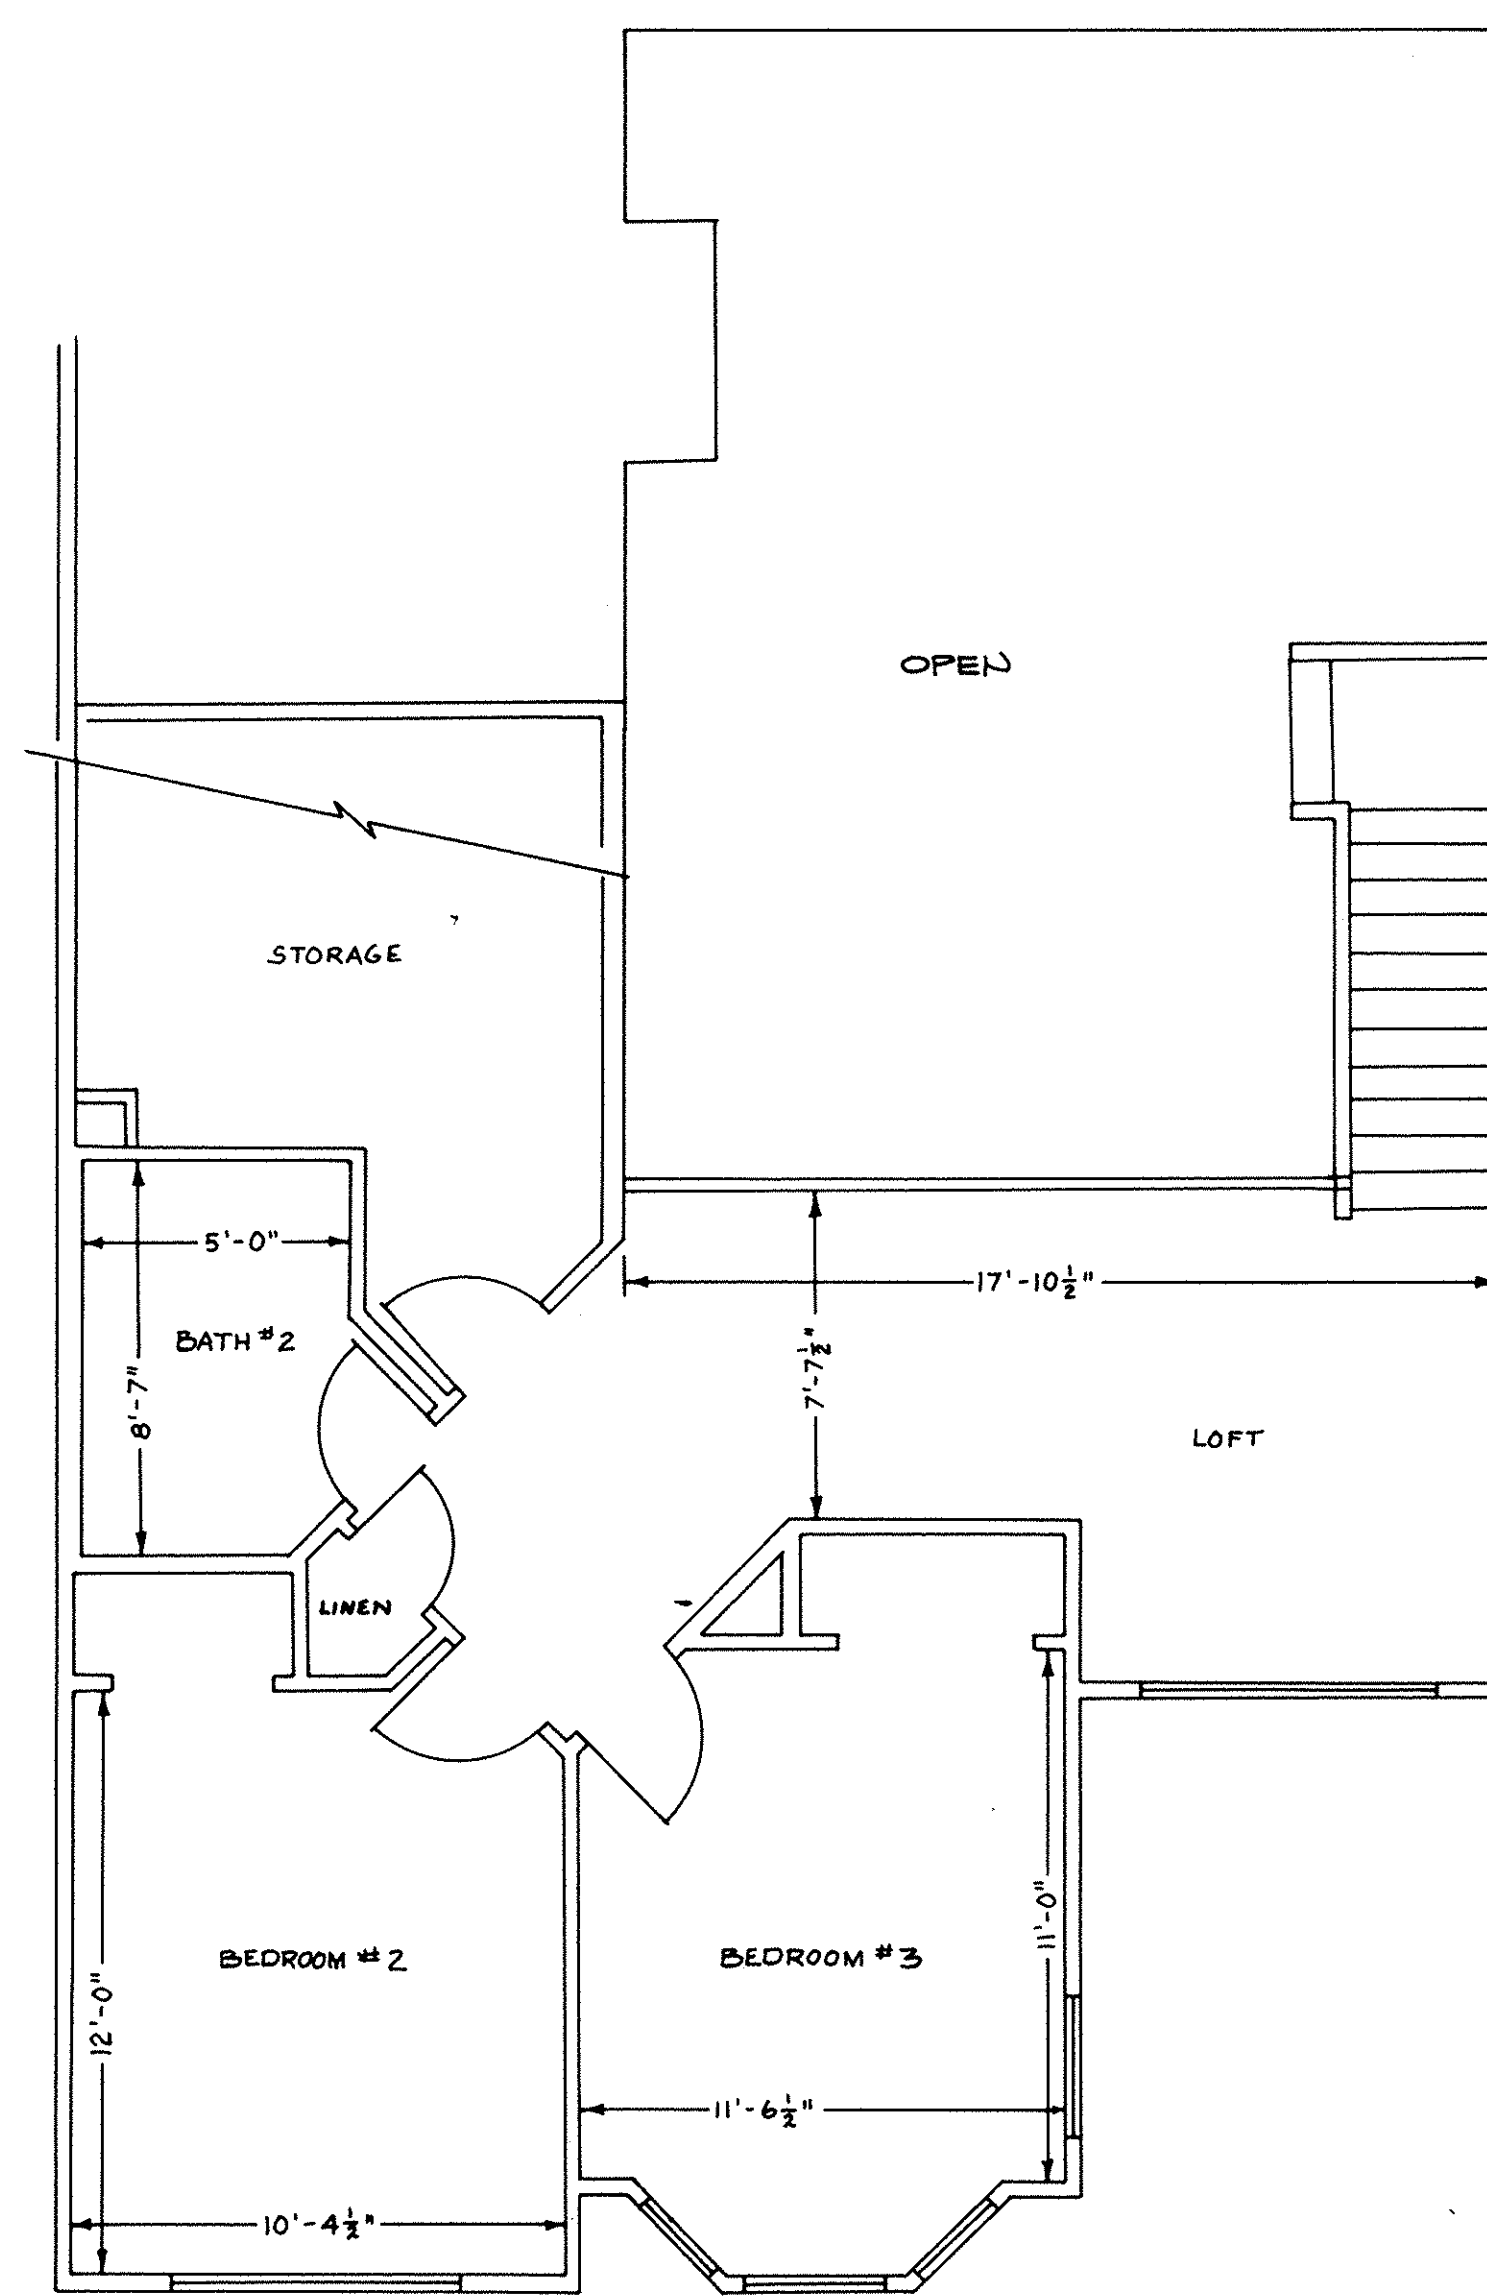

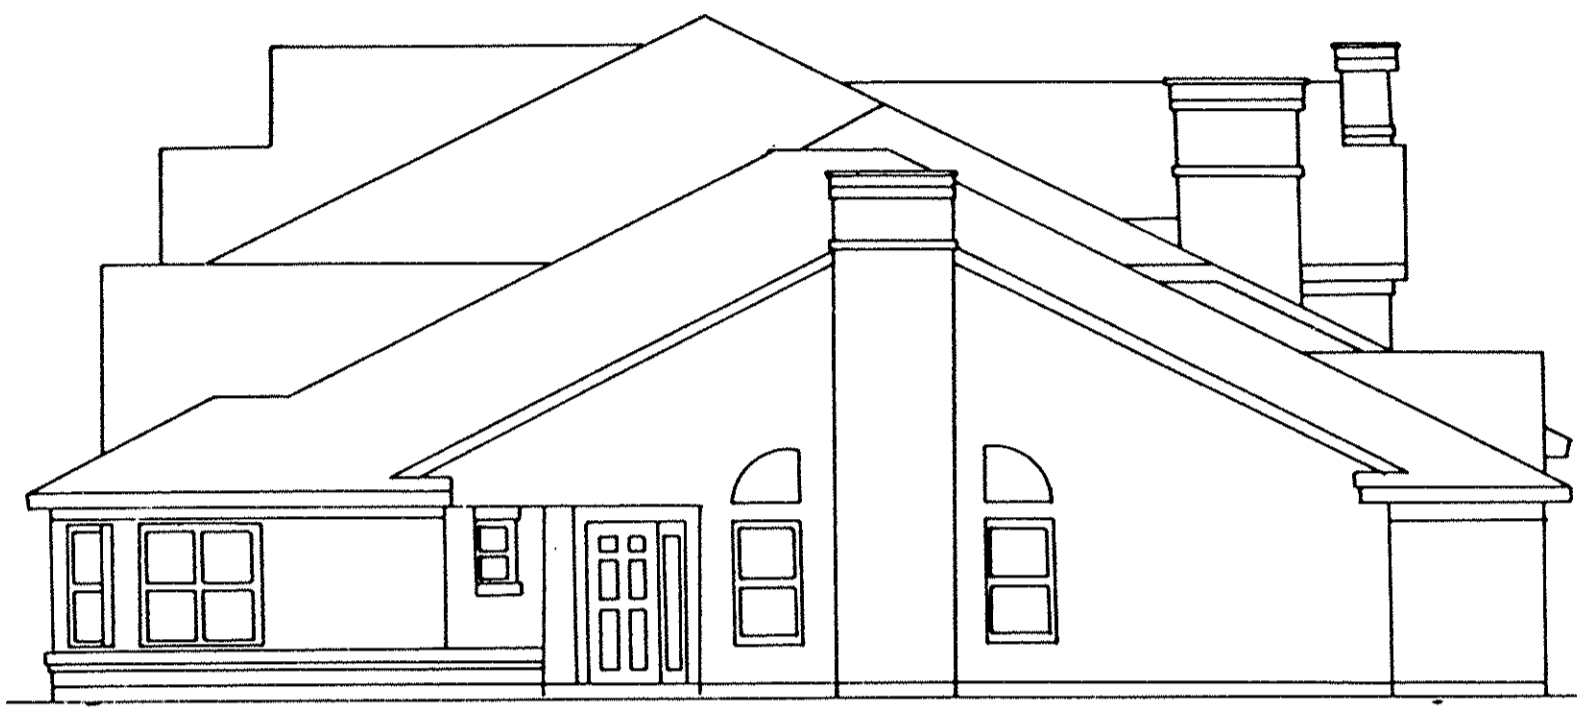

RIGHT SIDE ELEVATION

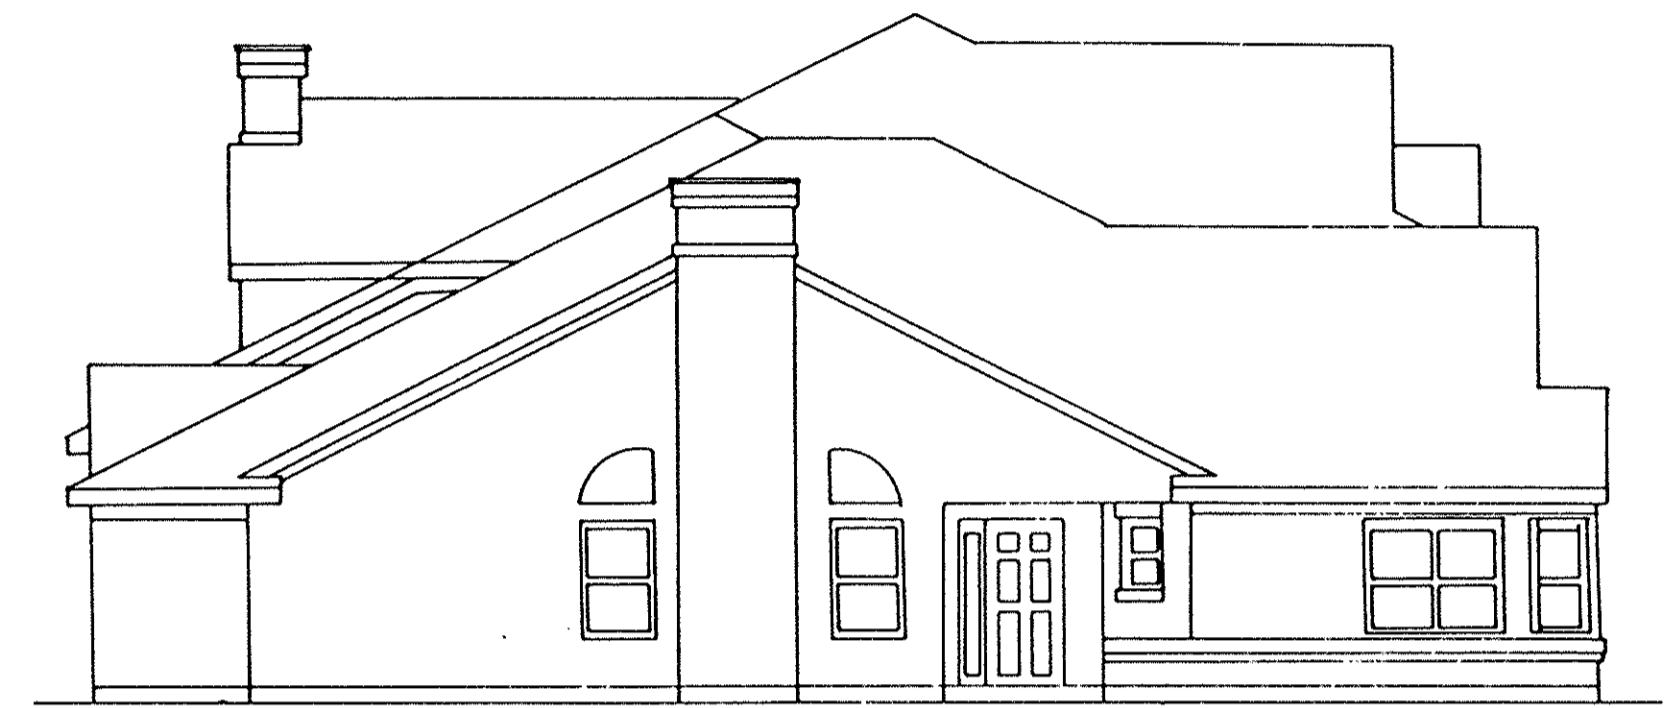

LEFT SIDE ELEVATION



FRONT ELEVATION



REAR ELEVATION