



FLOOR PLAN
1/32" = 1'-0"

| TABULATION OF UNIT AREAS | | | | |
|--------------------------|---------------------------|--|--|------------------------------|
| UNIT NUMBER | NET UNIT AREA SQUARE FEET | % OF UNIT FLOOR AREA TO TOTAL FLOOR AREA | APPORTIONED SQUARE FEET OF COMMON AREA TO UNIT | TOTAL UNIT AREA NET + COMMON |
| 1 | 1156.7 | 11.391 | 5181.4 | 6338.1 |
| 2 | 1156.7 | 11.391 | 5181.4 | 6338.1 |
| 3 | 1156.7 | 11.391 | 5181.4 | 6338.1 |
| 4 | 985.8 | 9.707 | 4415.4 | 5401.2 |
| 5 | 2593.7 | 25.542 | 11618.2 | 14211.9 |
| 6 | 1553.5 | 15.298 | 6958.6 | 8512.1 |
| 7 | 1551.6 | 15.280 | 6950.4 | 8502.0 |
| TOT | 10154.7 | 100.00 | 45486.9 | 55641.5 |

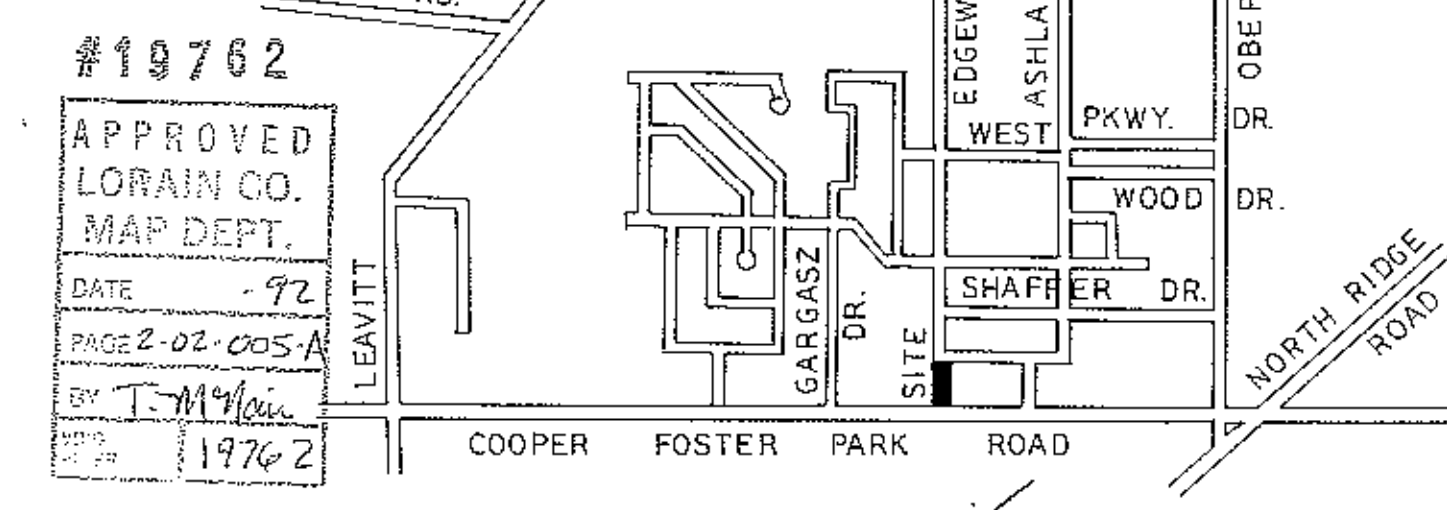

OUT OF 02-02-005-112-022 0.65 A.
 -023 + 0.63 A. 1.28 A.
 GOING INTO PLAT (55,641.54²) (-) 1.28 A.
 REMAINDER (NONE) 0.00 A.

#19762
 APPROVED
 LORAIN CO.
 MAP DEPT.
 DATE 72
 PAGE 2-02-005-A
 BY T.M.
 1976-2

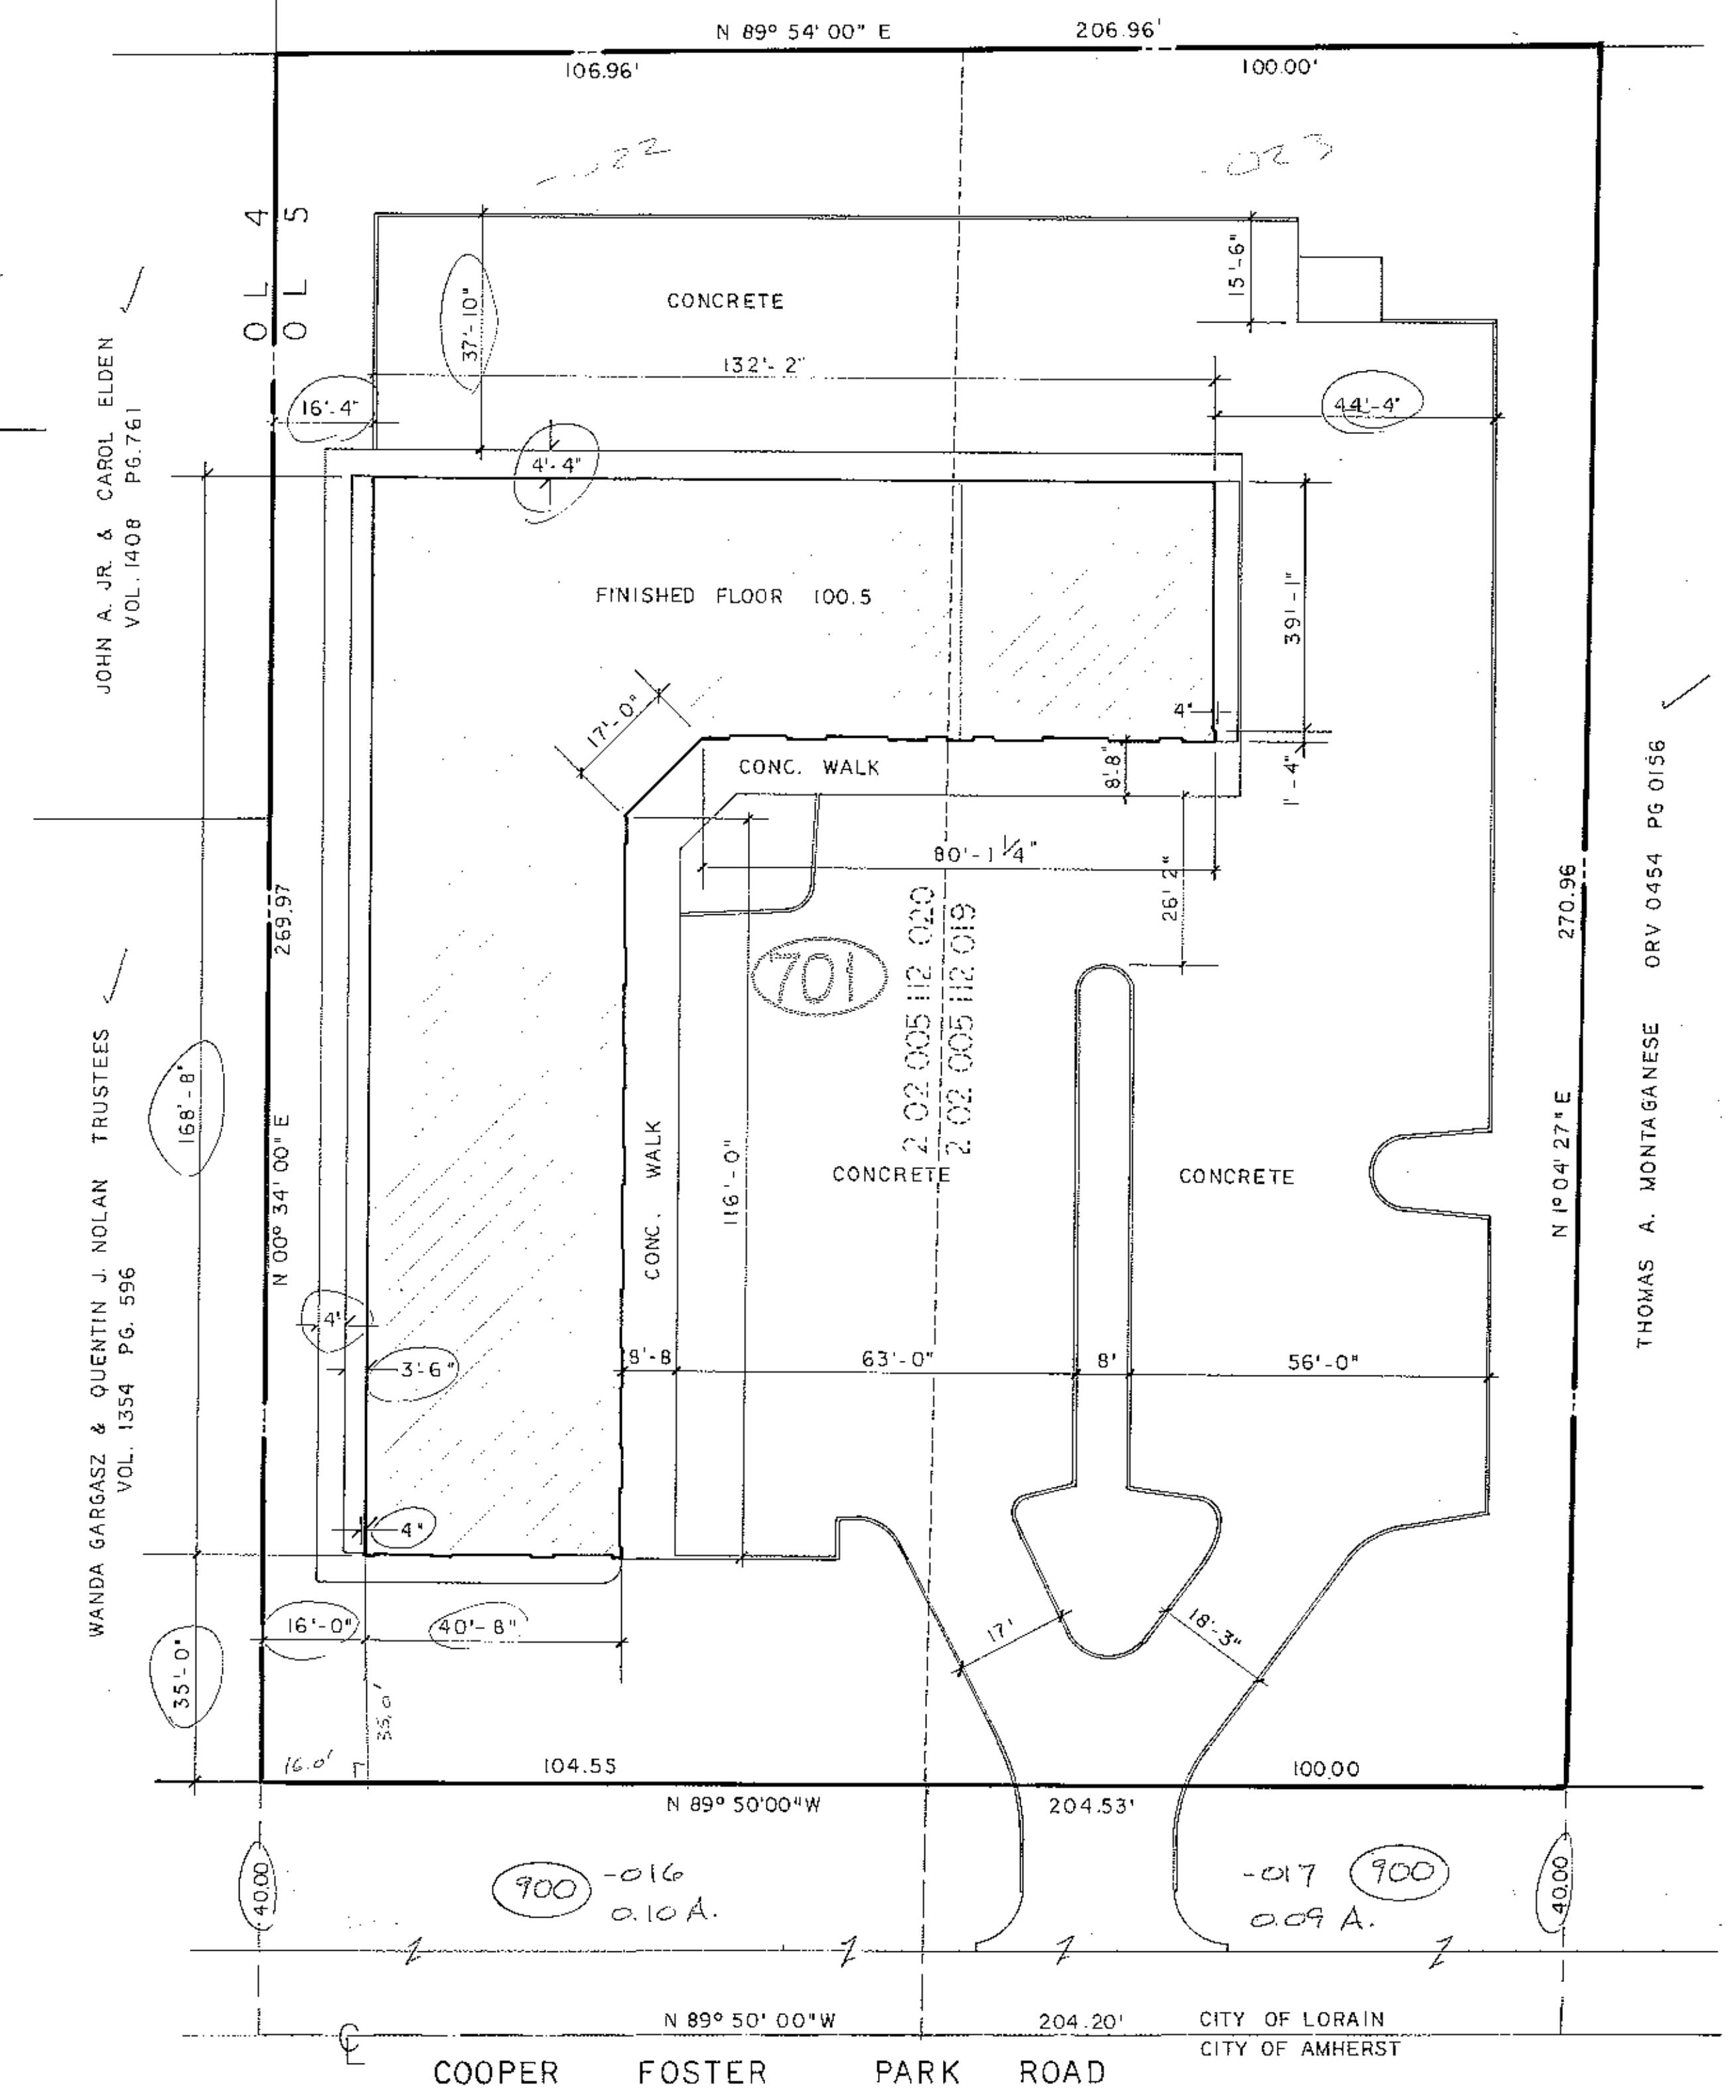




SITE PLAN
1" = 20'-0"

THIS IS TO CERTIFY THAT THE ATTACHED DRAWINGS CORRECTLY REPRESENTS THE BUILDING DIMENSIONS AS CONSTRUCTED AND THERE ARE NO ENCROACHMENTS ACROSS PROPERTY LINES


Norman R. Hura
 NORMAN R. HURA
 REGISTERED SURVEYOR

48/65+66

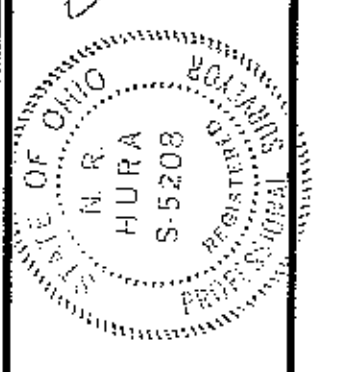


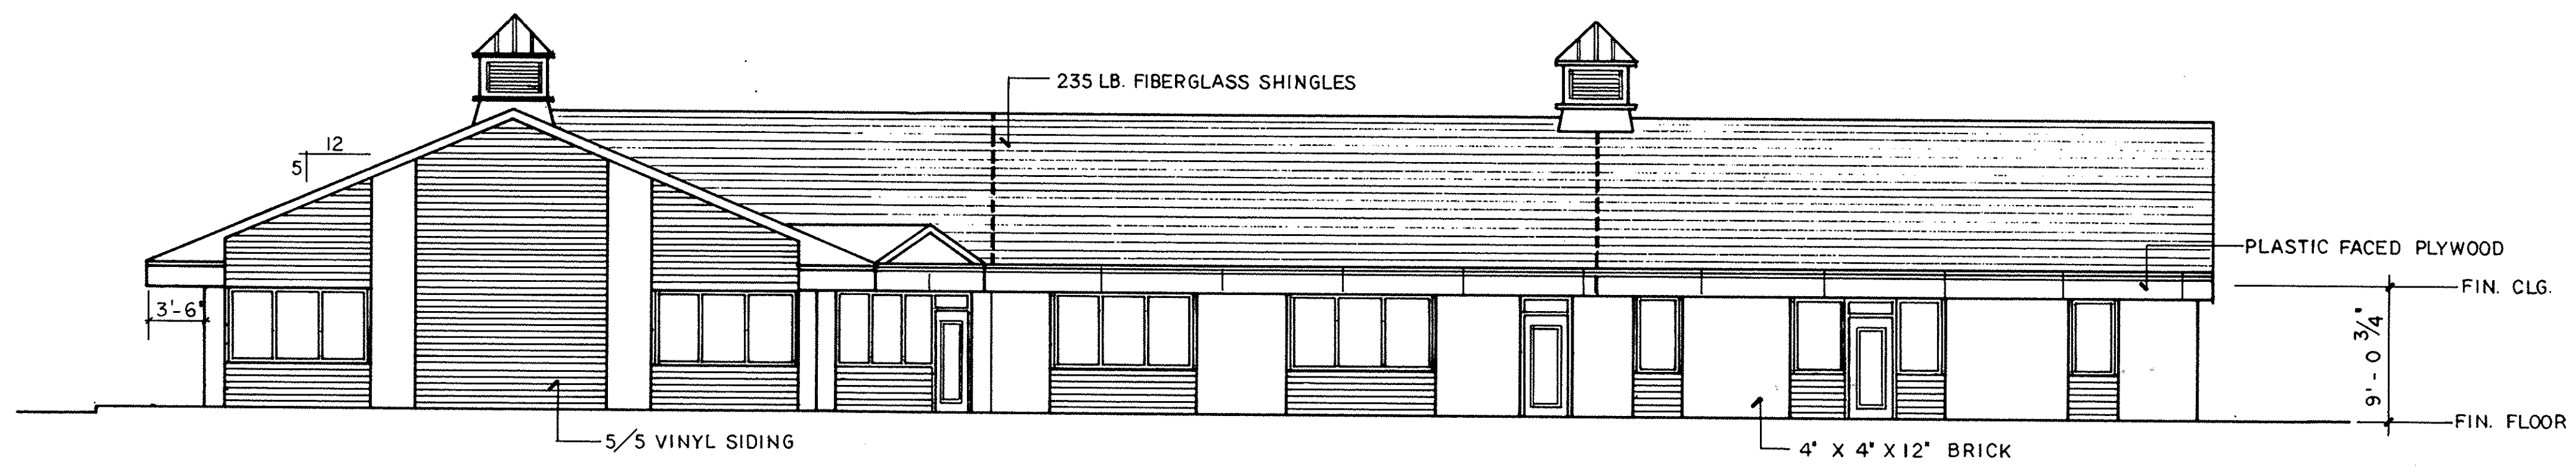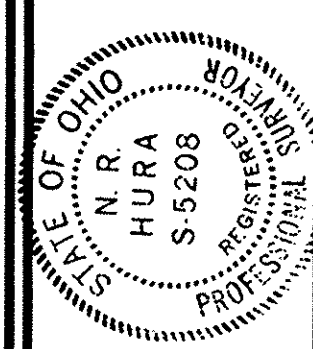


SOUTH ELEVATION
1/8" = 1'-0"

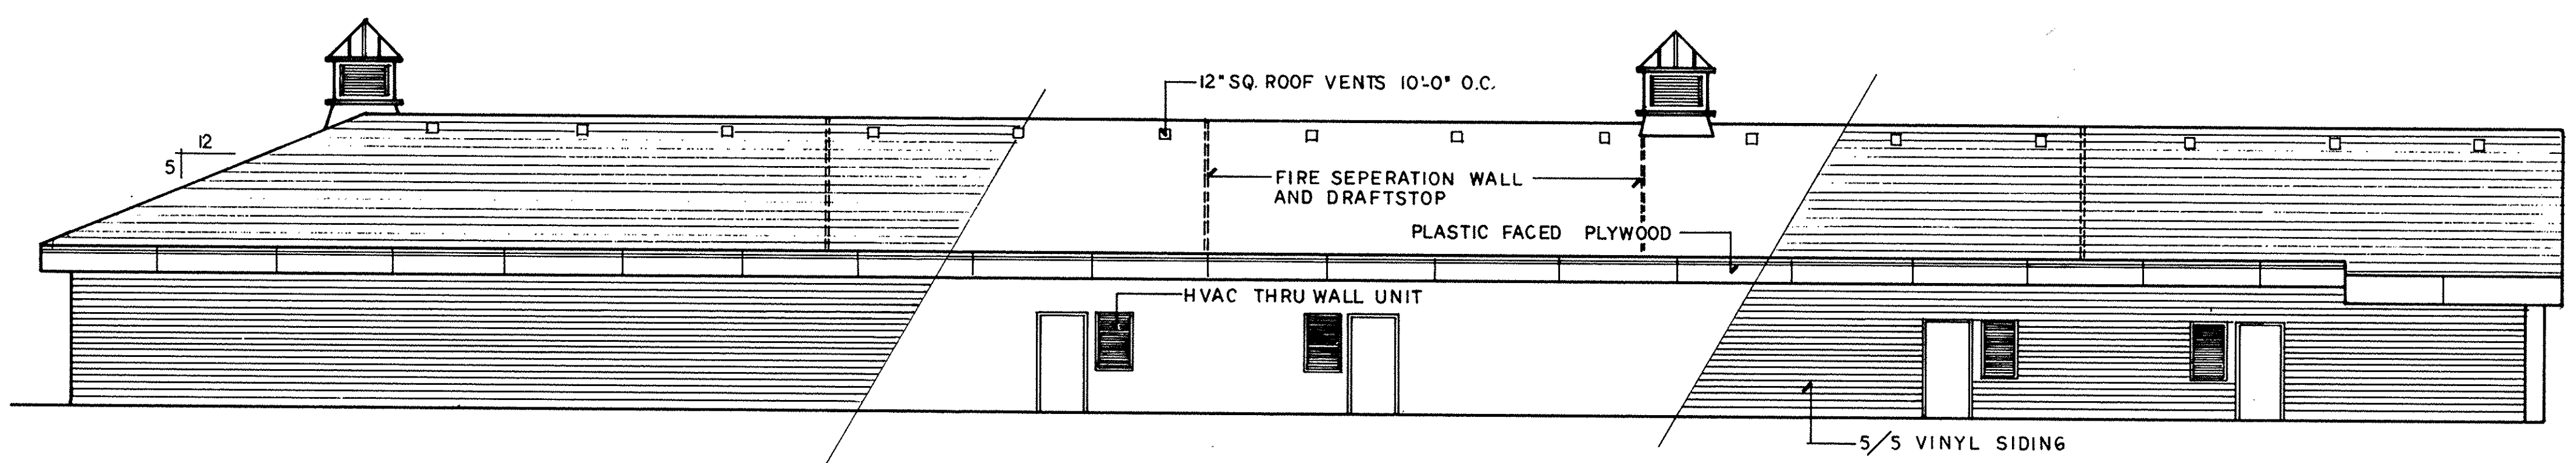

WEST ELEVATION
1/8" = 1'-0"

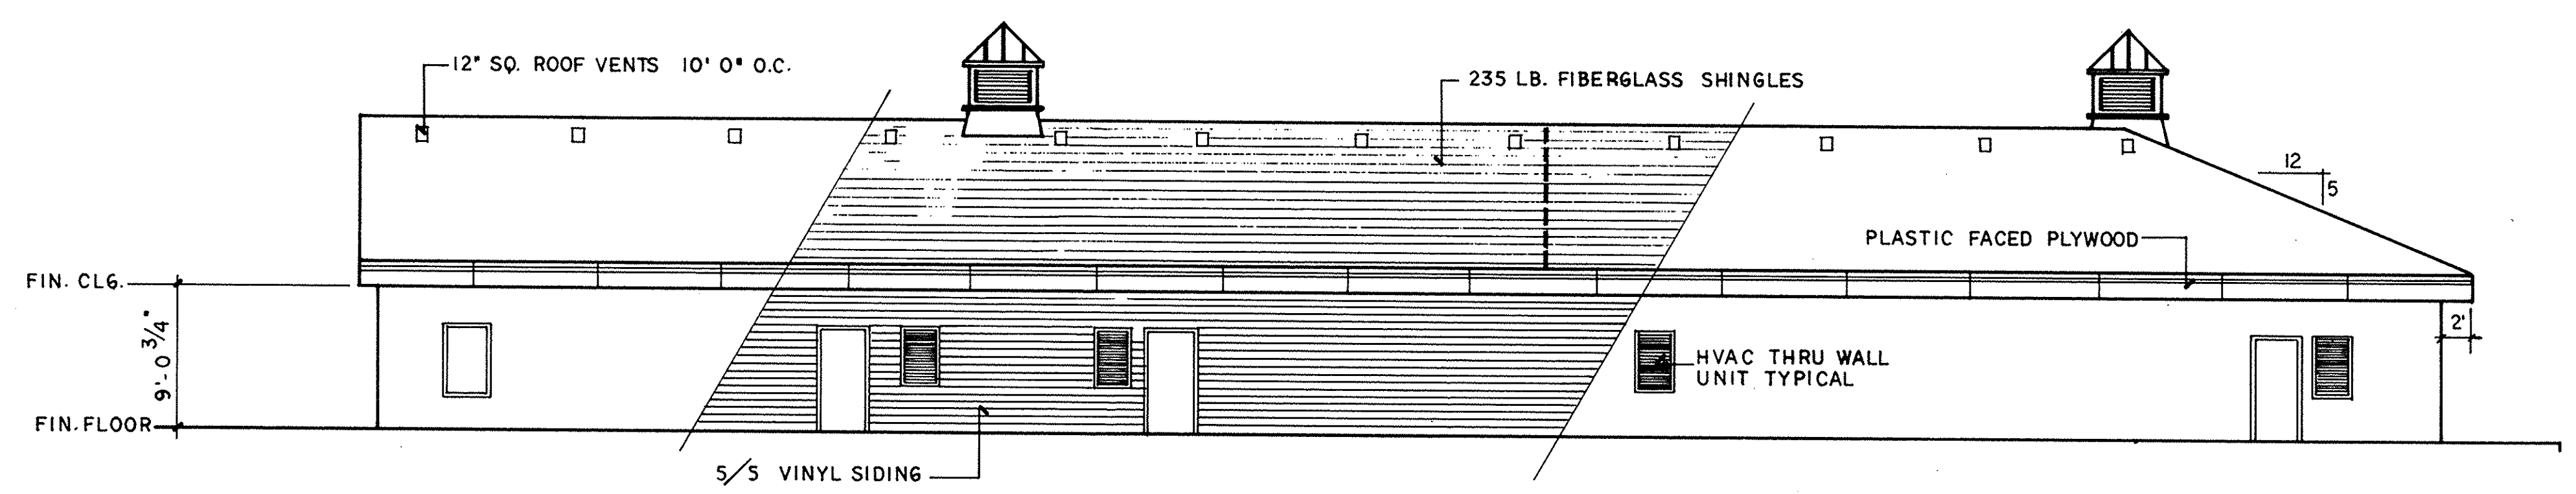

NORTH ELEVATION
1/8" = 1'-0"

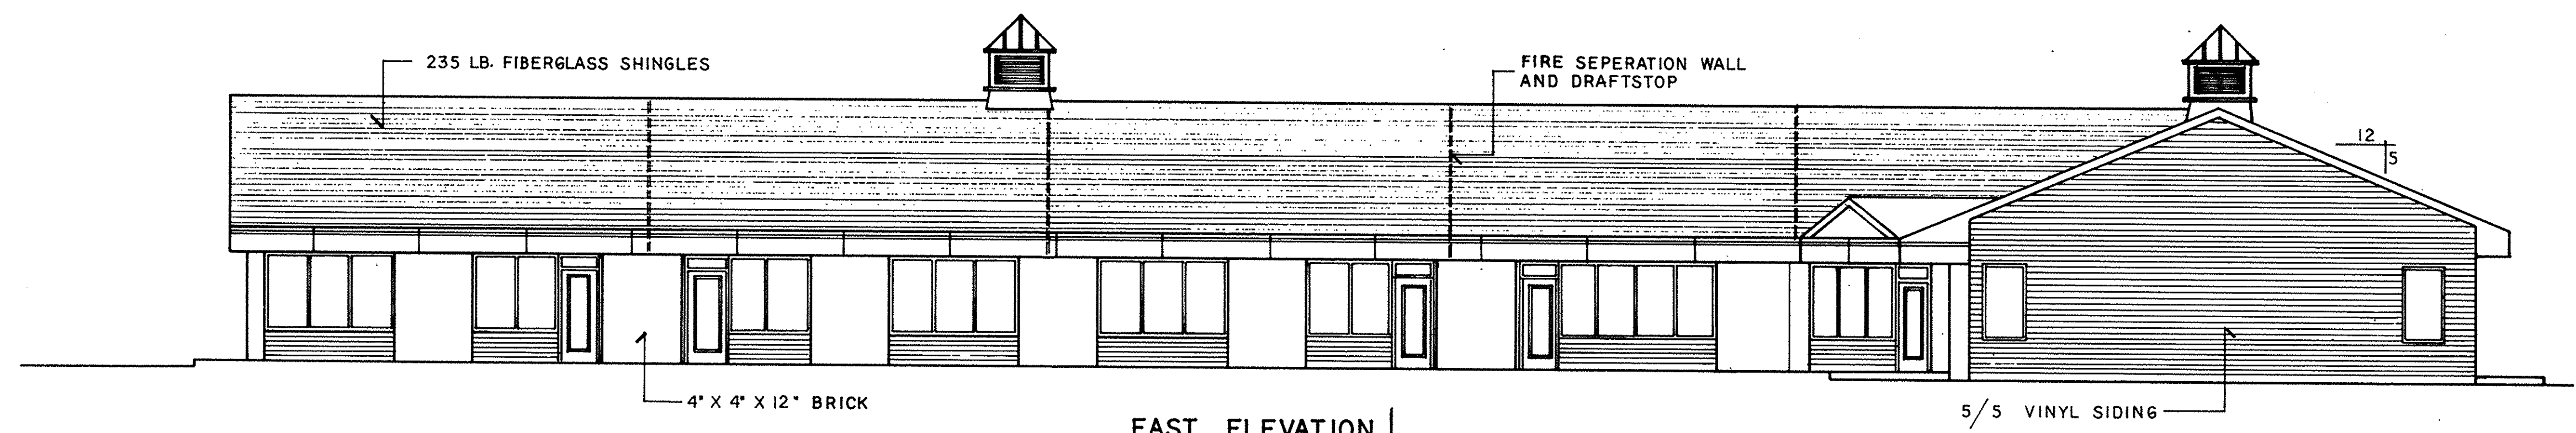

EAST ELEVATION
1/8" = 1'-0"