


BUILDING 41

UNIT	FIRST FL. ELEV.	SECOND FL. ELEV.
51-178	632.40	---
52-179	632.36	641.03
53-180	632.36	641.03
54-181	632.36	641.03
55-182	632.36	---

BUILDING 42

UNIT	FIRST FL. ELEV.	SECOND FL. ELEV.
56-183	632.42	---
57-184	632.40	641.07
58-185	632.40	641.07
59-186	632.44	641.11
60-187	632.40	641.07

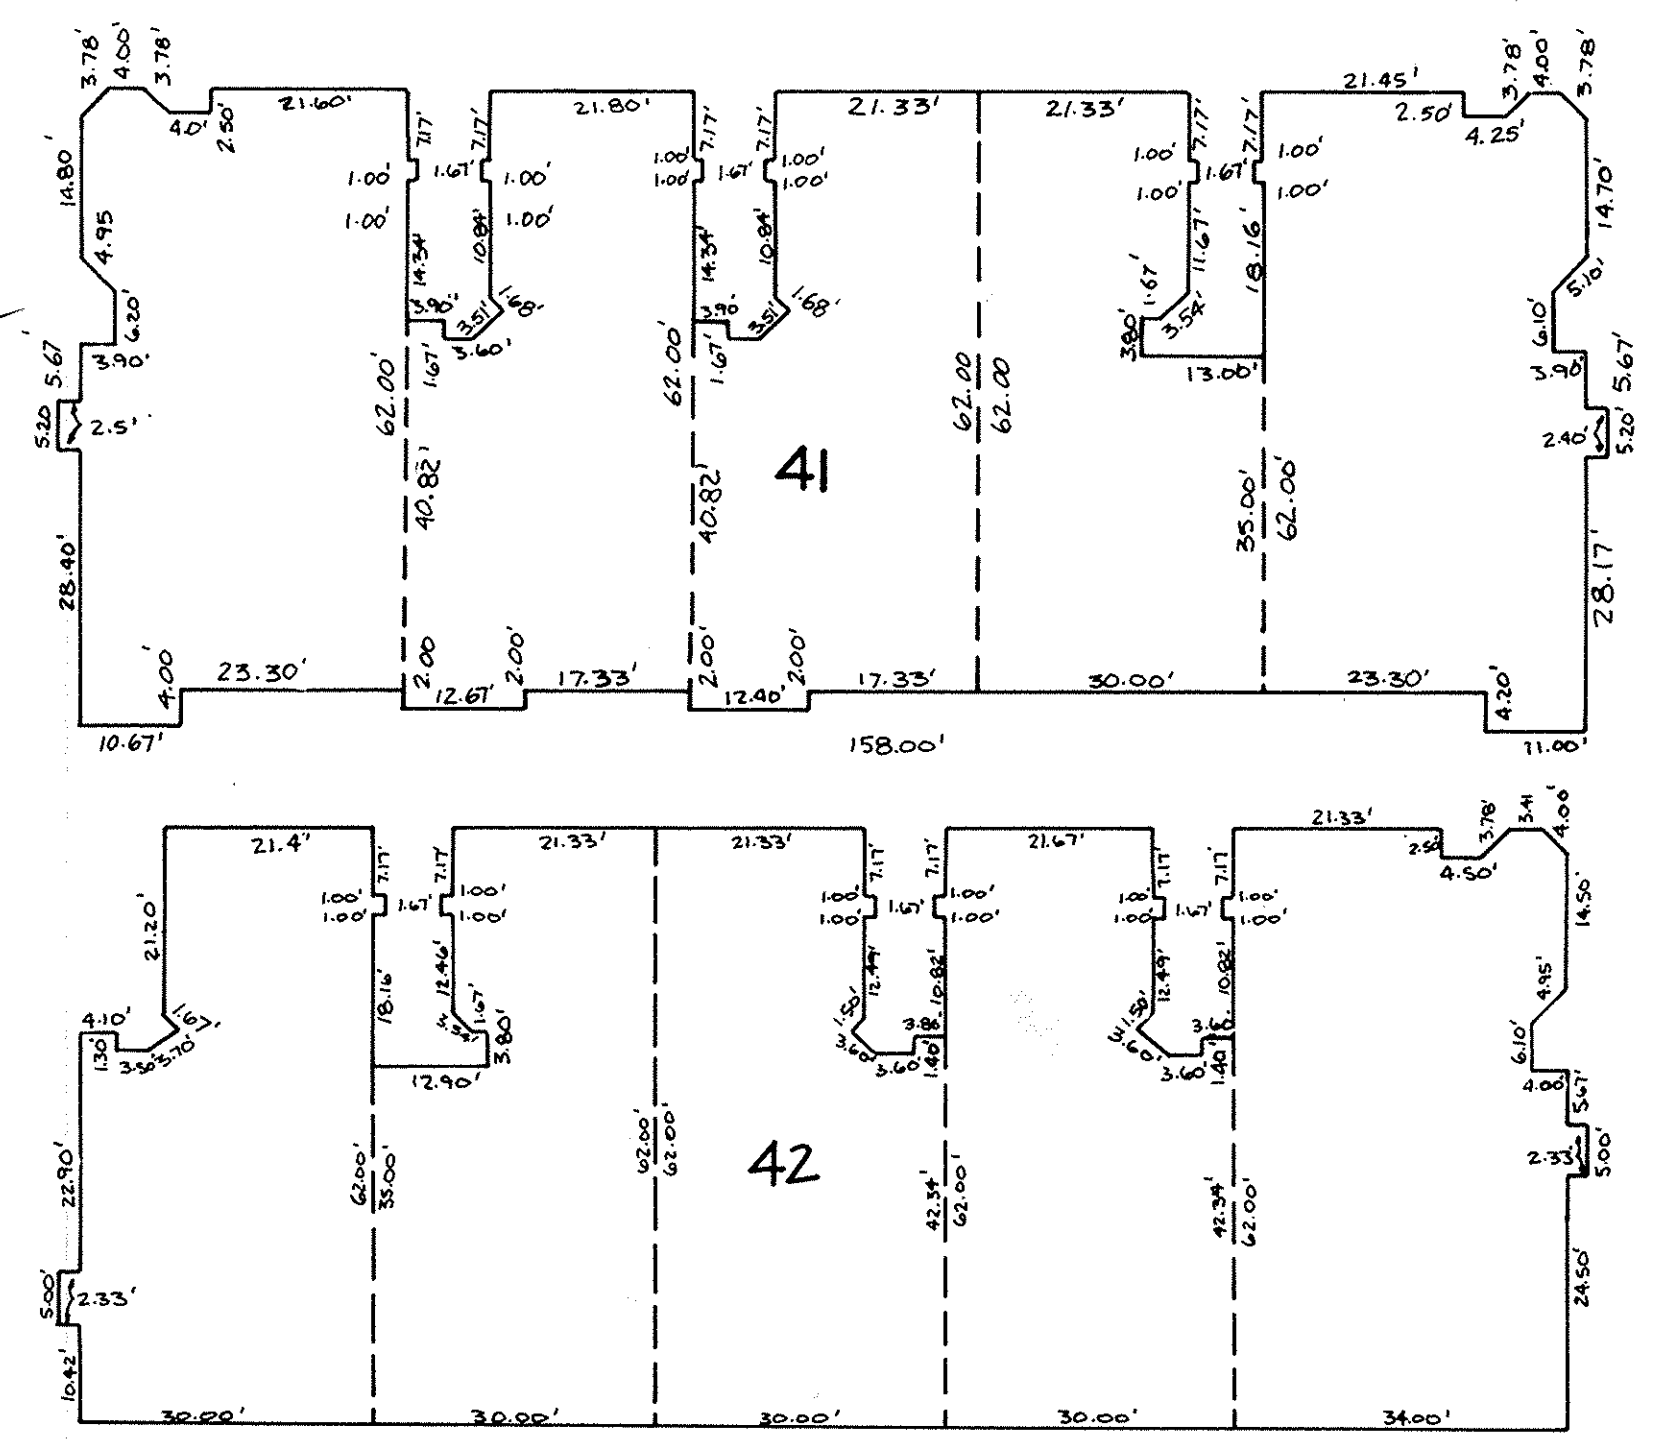

FOUNDATION PLAN
SCALE: 1" = 20'


Unit Numbers and Reestablished Percentages of Interest in Combined Common Areas & Facilities

Parcel No. 1:	Unit #	Square Feet	% of Combined Common Areas & Facilities	Parcel No. 2:	Unit #	Square Feet	% of Combined Common Areas & Facilities
Parcel No. 1:	1-148	1424	1.4573	Parcel No. 2:	36-163	1424	1.4573
	2-149	1703	1.7429		37-164	1703	1.7429
	3-150	1787	1.8288		38-165	1787	1.8288
	4-151	1424	1.4573		39-166	1424	1.4573
	5-152	1424	1.4573		Parcel No. 1-C:		
	6-153	1910	1.9547	Unit # 40-167 - 401 Bounty Way			
	7-154	1703	1.7429	41-168	1424	1.4573	
	8-155	1424	1.4573	42-169	1703	1.7429	
	9-156	1424	1.4573	43-170	1703	1.7429	
	10-157	1703	1.7429	44-171	2029	2.0765	
	11-158	1787	1.8288	45-172	1424	1.4573	
	12-159	1424	1.4573	46-173	1424	1.4573	
	13-160	1703	1.7429	47-174	1787	1.8288	
	14-161	1787	1.8288	48-175	1703	1.7429	
	15-162	1424	1.4573	49-176	1703	1.7429	
Parcel No. 1-A:			50-177	1424	1.4573		
Unit # 16-144 - 401 Bounty Way			Parcel No. 1-D:				
17-145			51-178	1424	1.4573		
18-146			52-179	1703	1.7429		
19-147			53-180	1703	1.7429		
Parcel No. 1-B:			54-181	1787	1.8288		
Unit # 20-128 - 401 Bounty Way			55-182	1424	1.4573		
21-129			56-183	1424	1.4573		
22-130			57-184	1703	1.7429		
23-131			58-185	1703	1.7429		
24-132			59-186	1787	1.8288		
25-133			60-187	1703	1.7429		
26-134			SHEET INDEX				
27-135			SHEET #	DESCRIPTION			
28-136			1	SURVEY MAP & MISC.			
29-137			2	FLOOR PLAN UNIT 52-179 & 53-180			
30-138			3	FLOOR PLAN UNIT 54-181			
31-139			4	FLOOR PLAN UNIT 51-178 & 55-182			
32-140			5	FLOOR PLAN UNIT 56-183			
33-141			6	FLOOR PLAN UNIT 57-184 & 58-185			
34-142			7	FLOOR PLAN UNIT 59-186			
35-143			8	FLOOR PLAN UNIT 60-187			
			9	EXTERIOR ELEVATIONS			

CERTIFICATION
THIS IS TO CERTIFY THAT THE ATTACHED DRAWINGS CORRECTLY REPRESENT THE BUILDINGS AS CONSTRUCTED AND THAT THERE ARE NO ENCROACHMENTS ON ABUTTING PROPERTIES.

David L. Elwell
DAVID L. ELWELL
REG. SURVEYOR NO. 6333

Mark Skelleneger
MARK SKELLENER
REG. ENGINEER NO. 46461

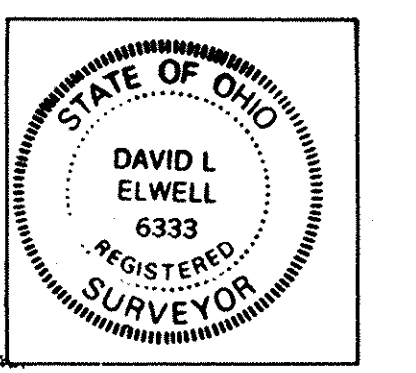


WESTWINDS SOUTH CONDOMINIUM No. 1
FOURTH AMENDMENT **PHASE 5**
PART OF AVON TOWNSHIP SECTION NUMBER 30
CITY OF AVON LAKE COUNTY OF LORAIN STATE OF OHIO

PREPARED BY:
TRANSFERRED
IN COMPLIANCE WITH SEC. 319.202
OHIO REV. CODE
JUL 8 1992
JULIAN A. PIJOR
LORAIN COUNTY AUDITOR




Received for RECORD JUL - 8 1992
at 2:41 clock P.M. in PLAT RECORD
VOL 49
PAGE 14
DOROTHY L. ESSEX
Lorain County Recorder
then 22 ncl
\$388.80 Box LTC SM
78-154-PHS

LORAIN COUNTY TAX
MAP DEPARTMENT COPY

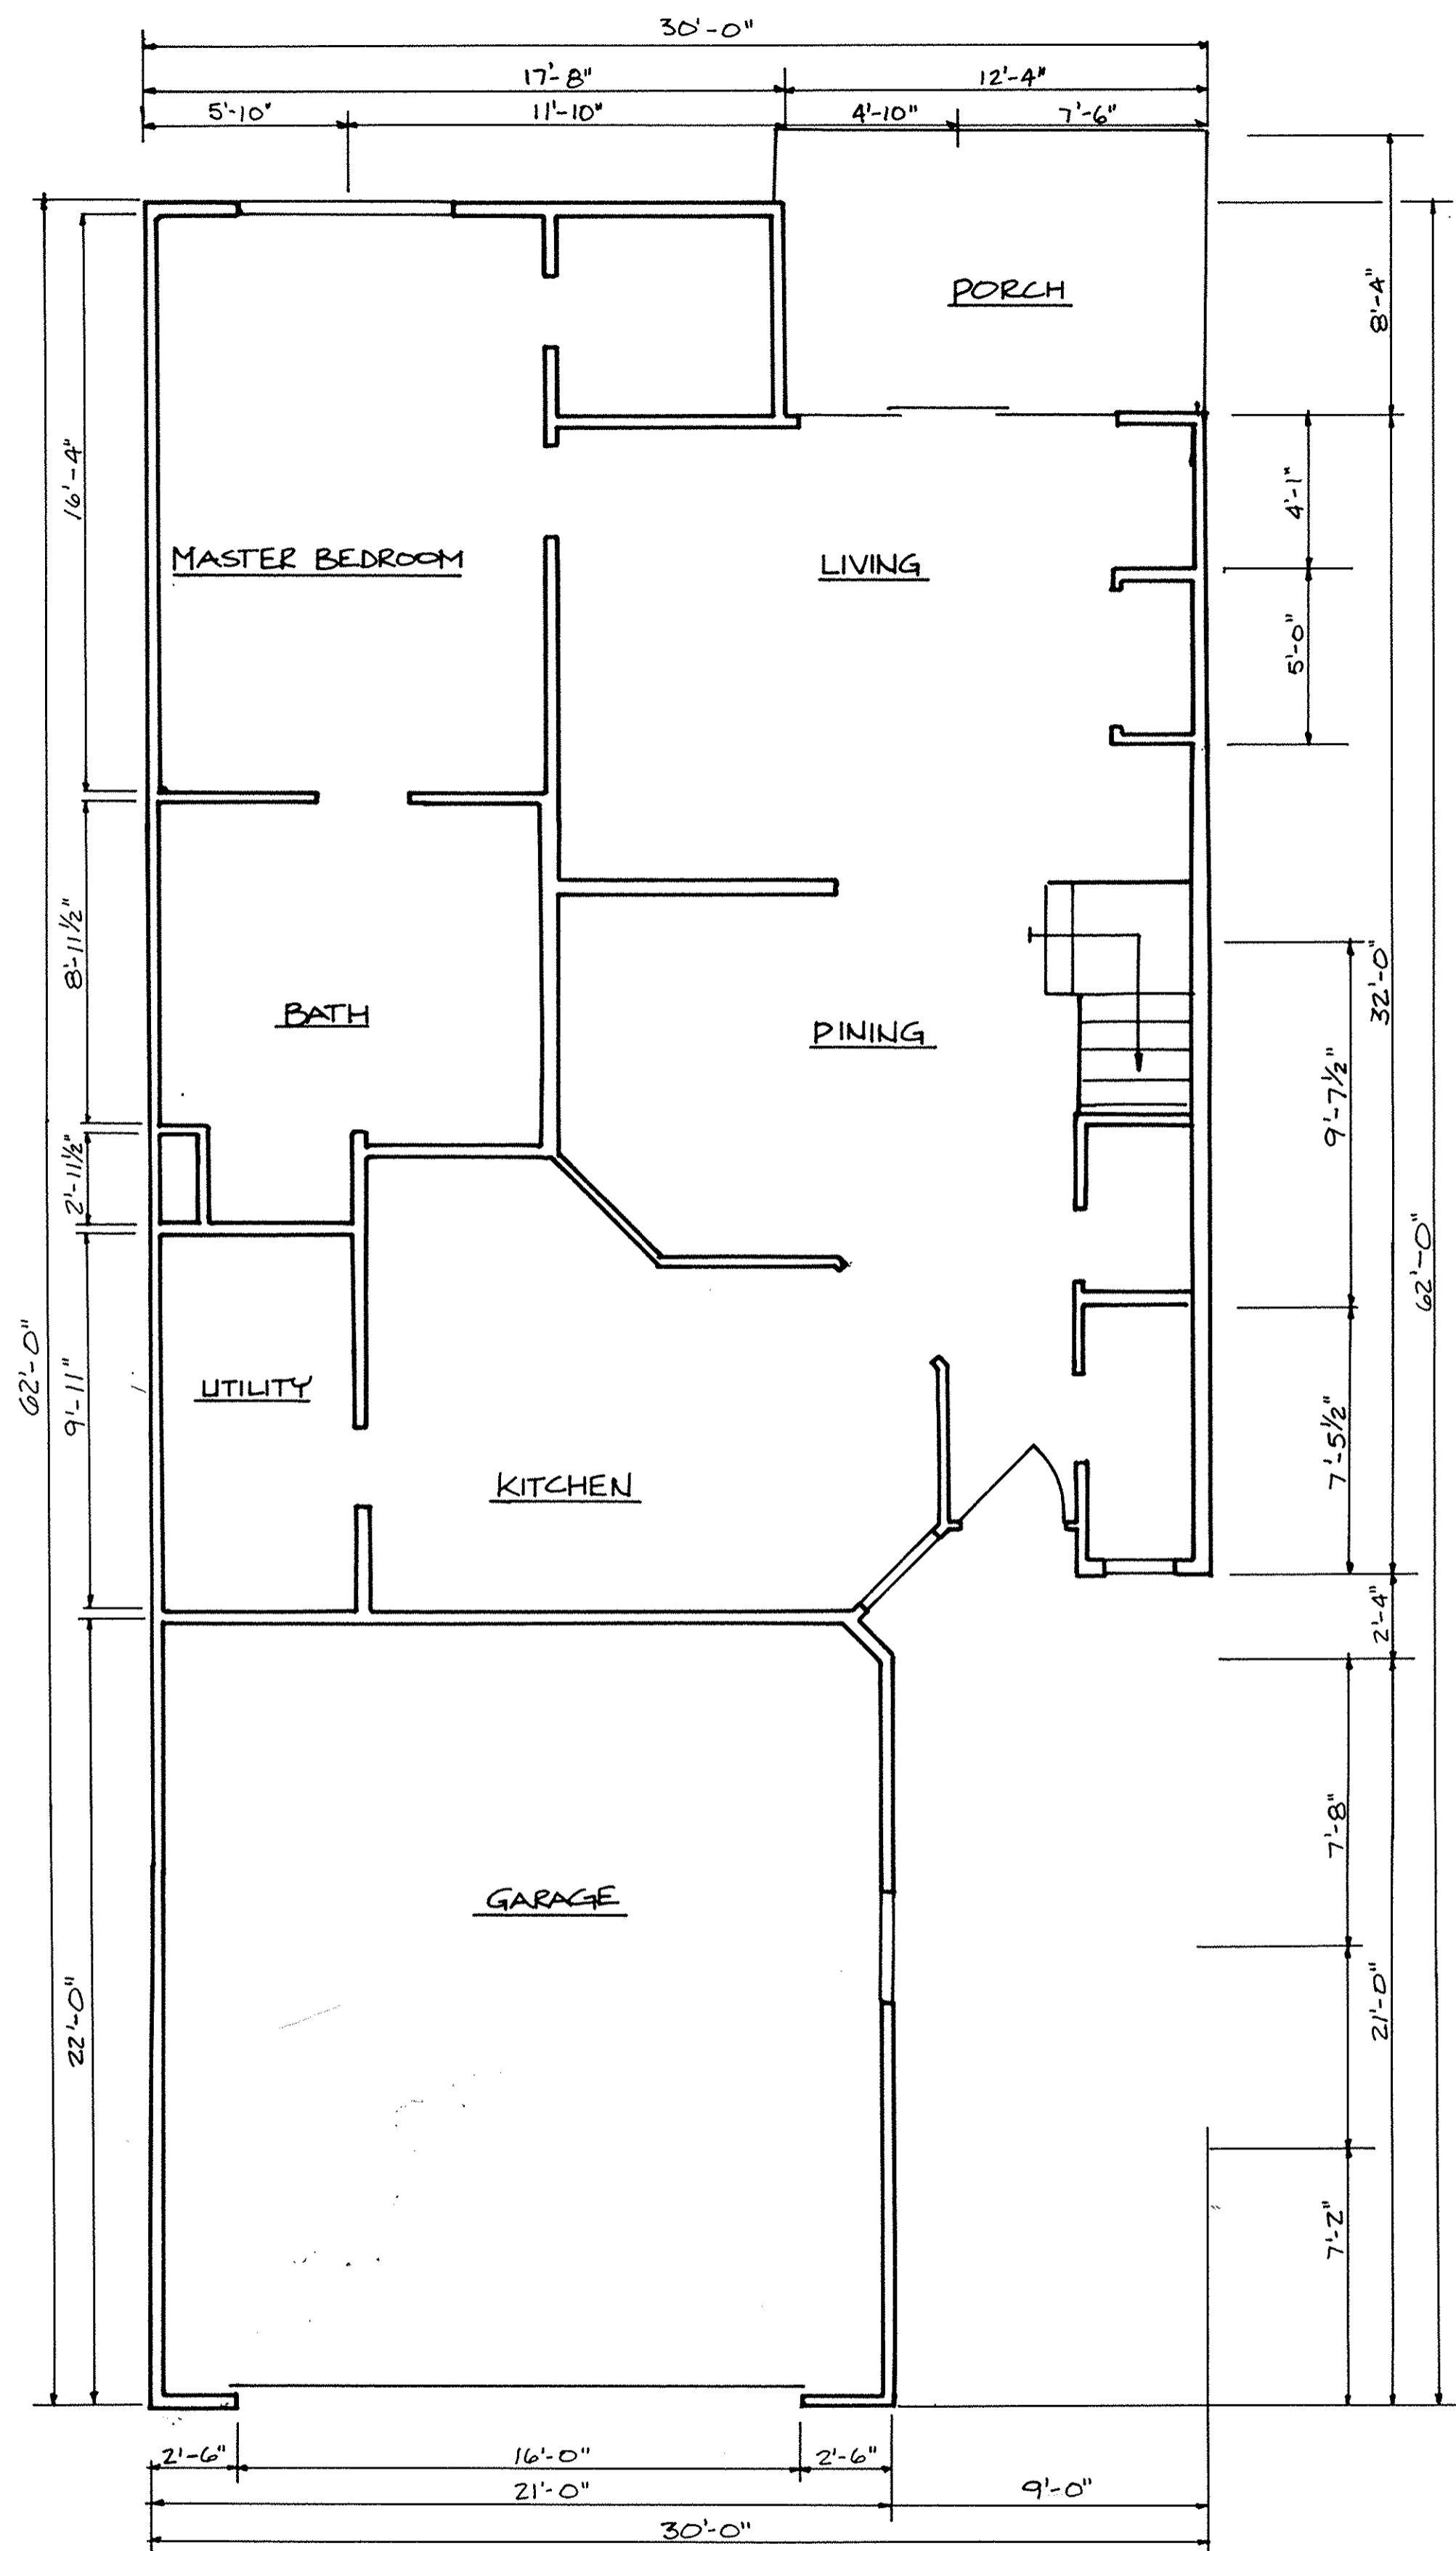

FIRST FLOOR PLAN - UNITS 52-179 & 53-180
 SCALE: 1/8" = 1'-0"

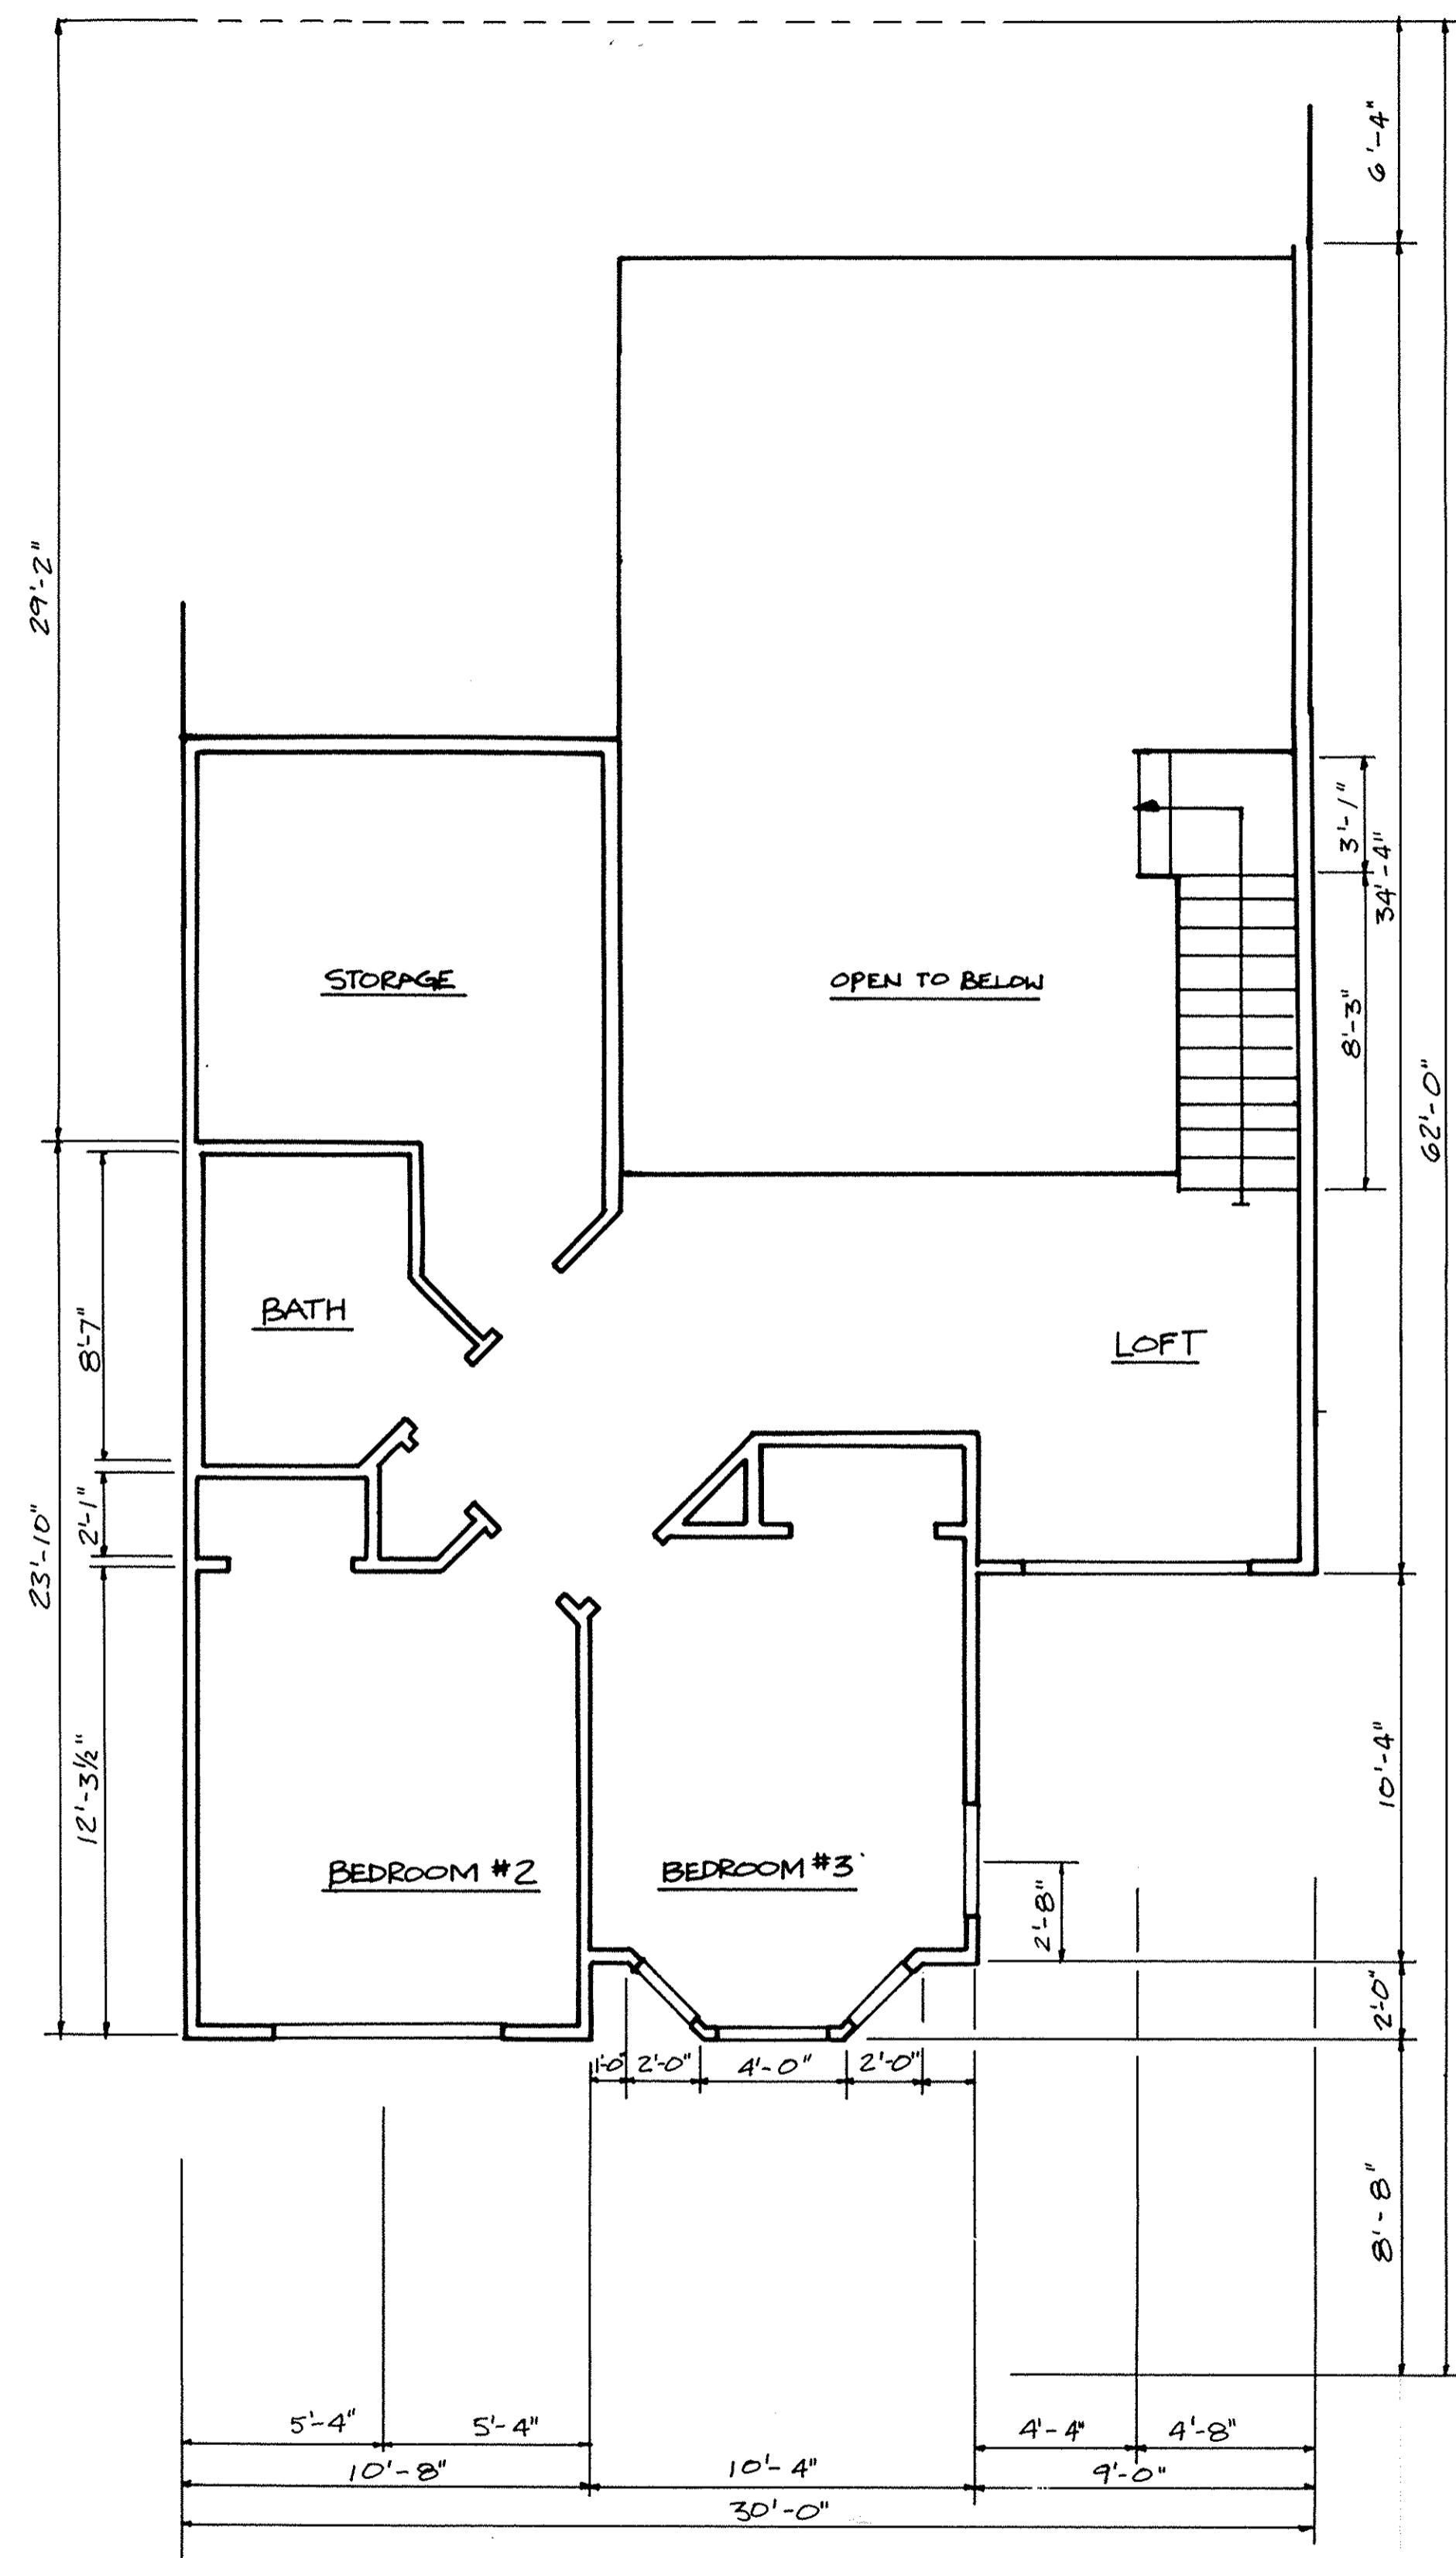


SECOND FLOOR PLAN - UNITS 52-179 & 53-180
 SCALE: 1/8" = 1'-0"


WESTWINDS SOUTH CONDOMINIUM No. 1
 FOURTH AMENDMENT PHASE 5
 FLOOR PLANS - UNITS 52-179 & 53-180

LORAIN COUNTY TAX
 MAP DEPARTMENT COPY

LORAIN COUNTY
 TAX MAP DEPARTMENT COPY

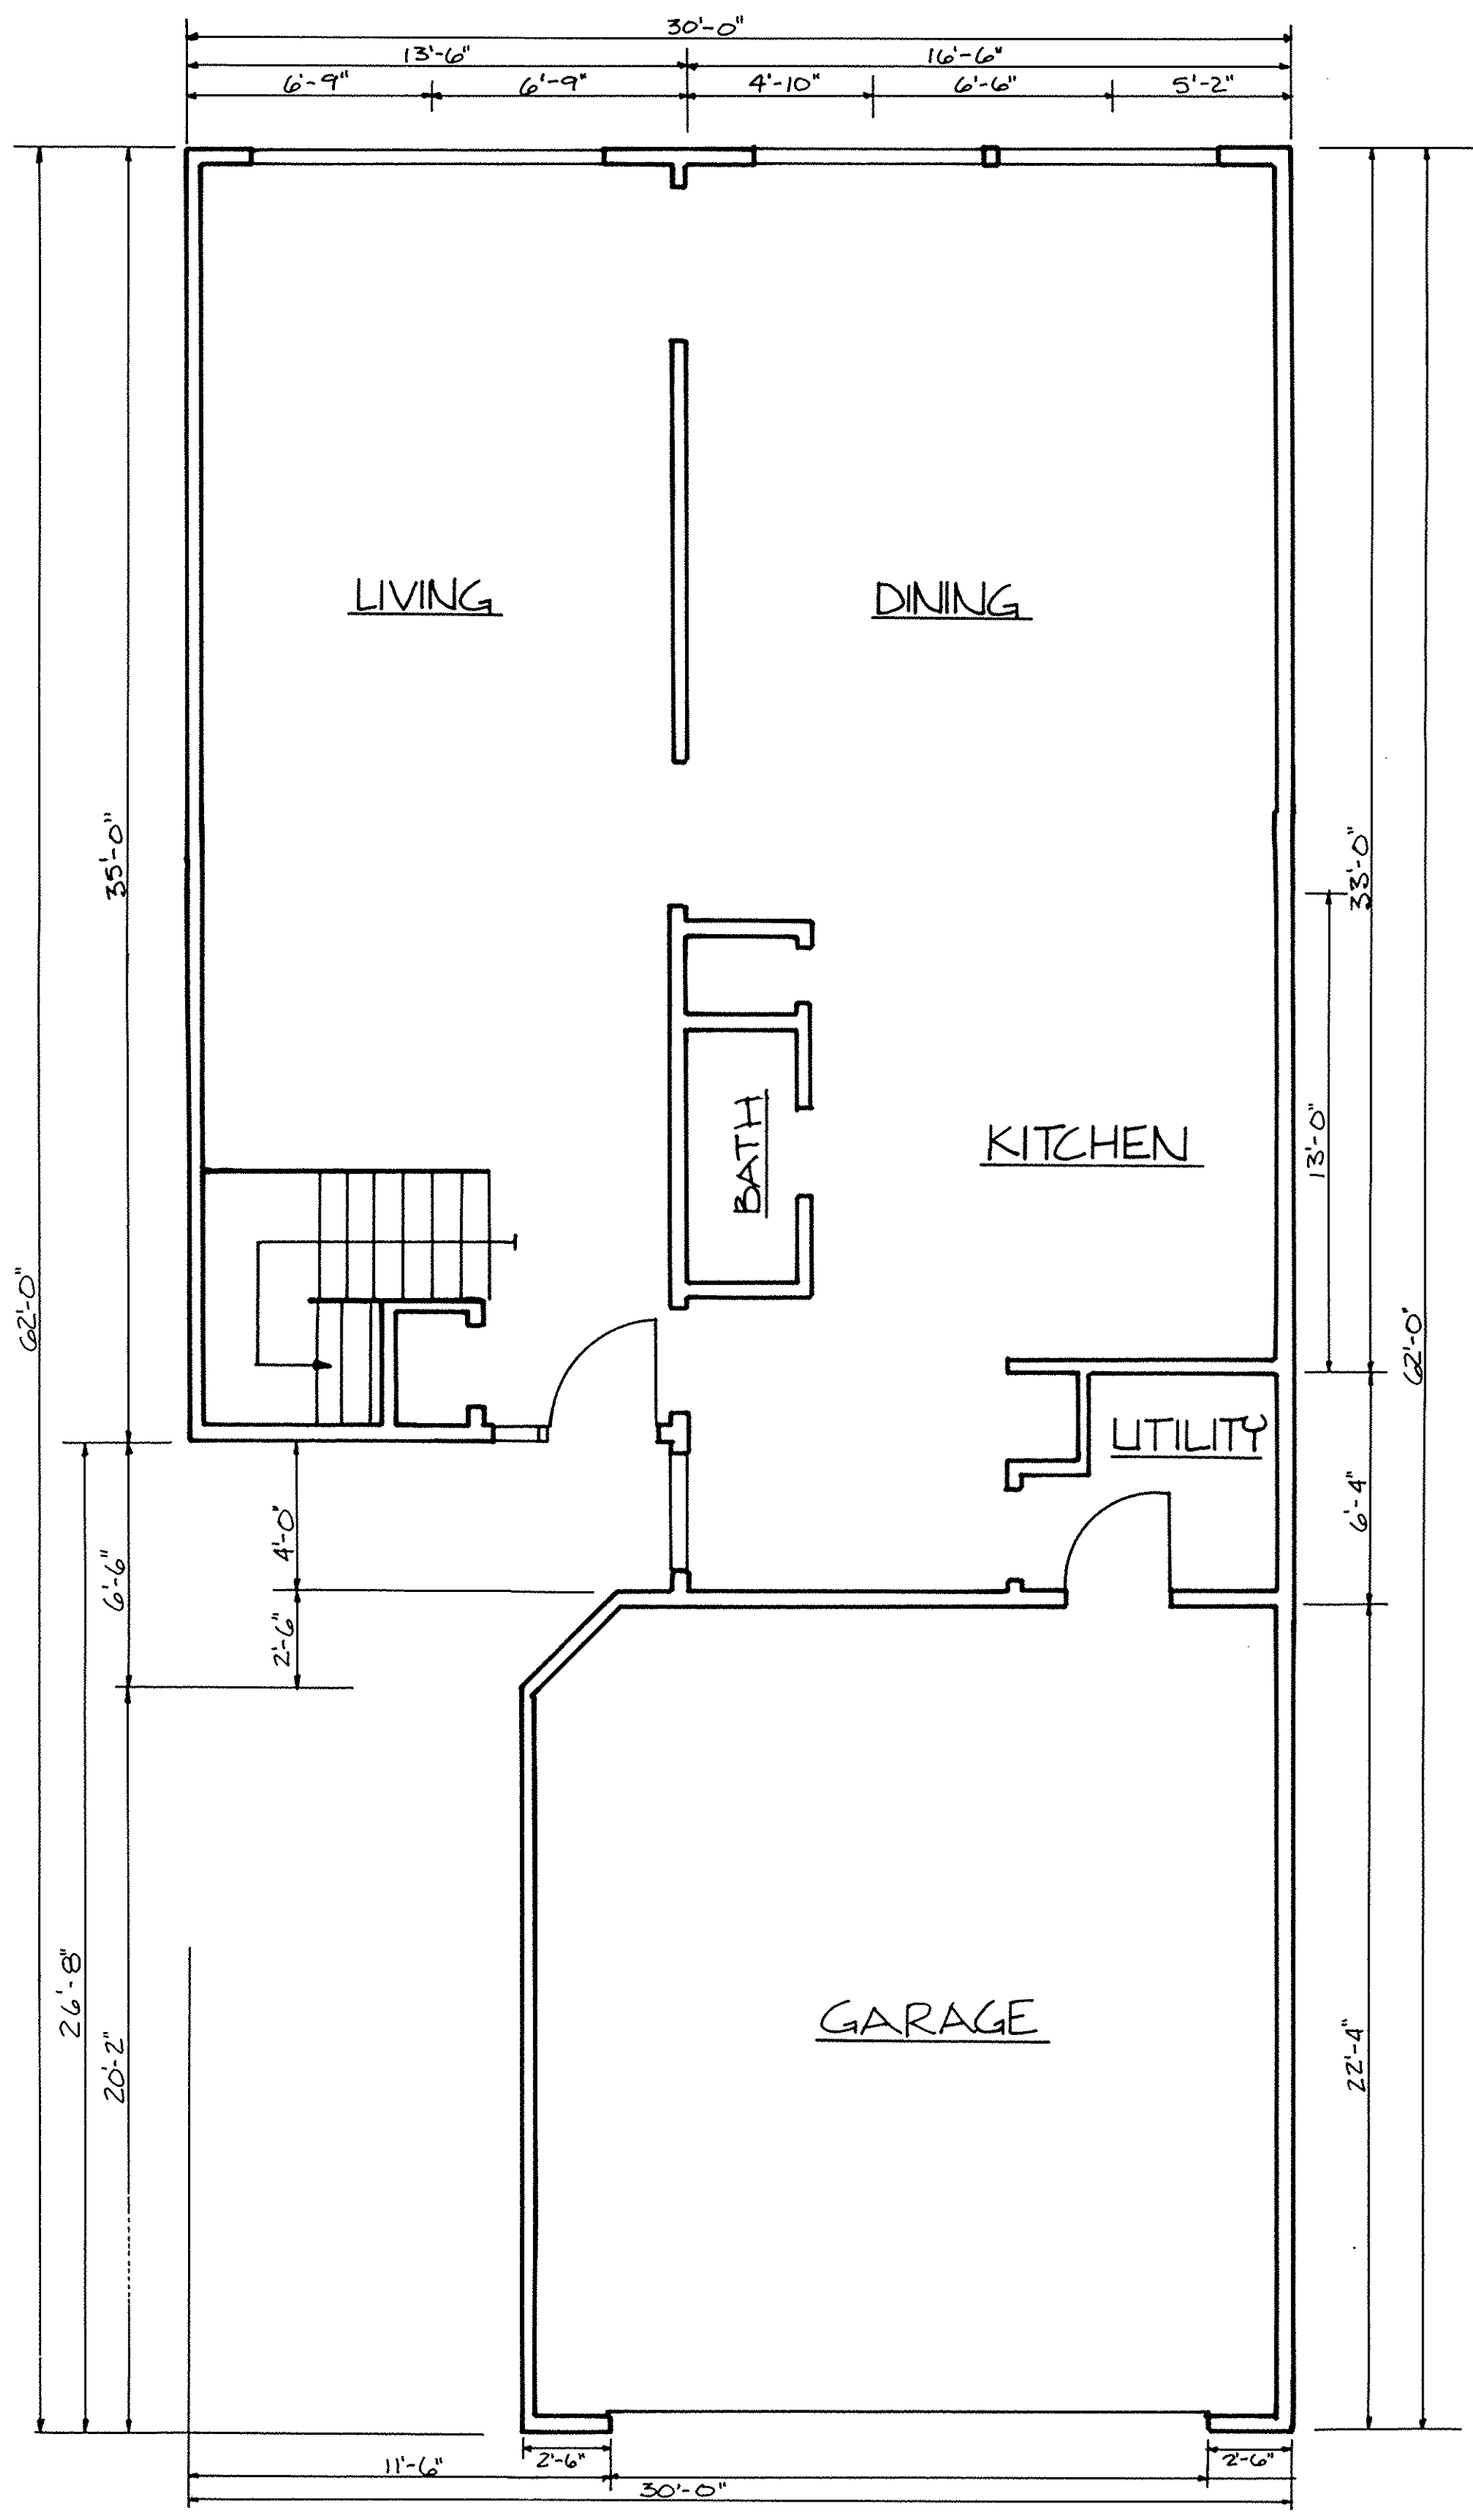

FIRST FLOOR PLAN - UNIT 54-181
SCALE: 1/4" = 1'-0"

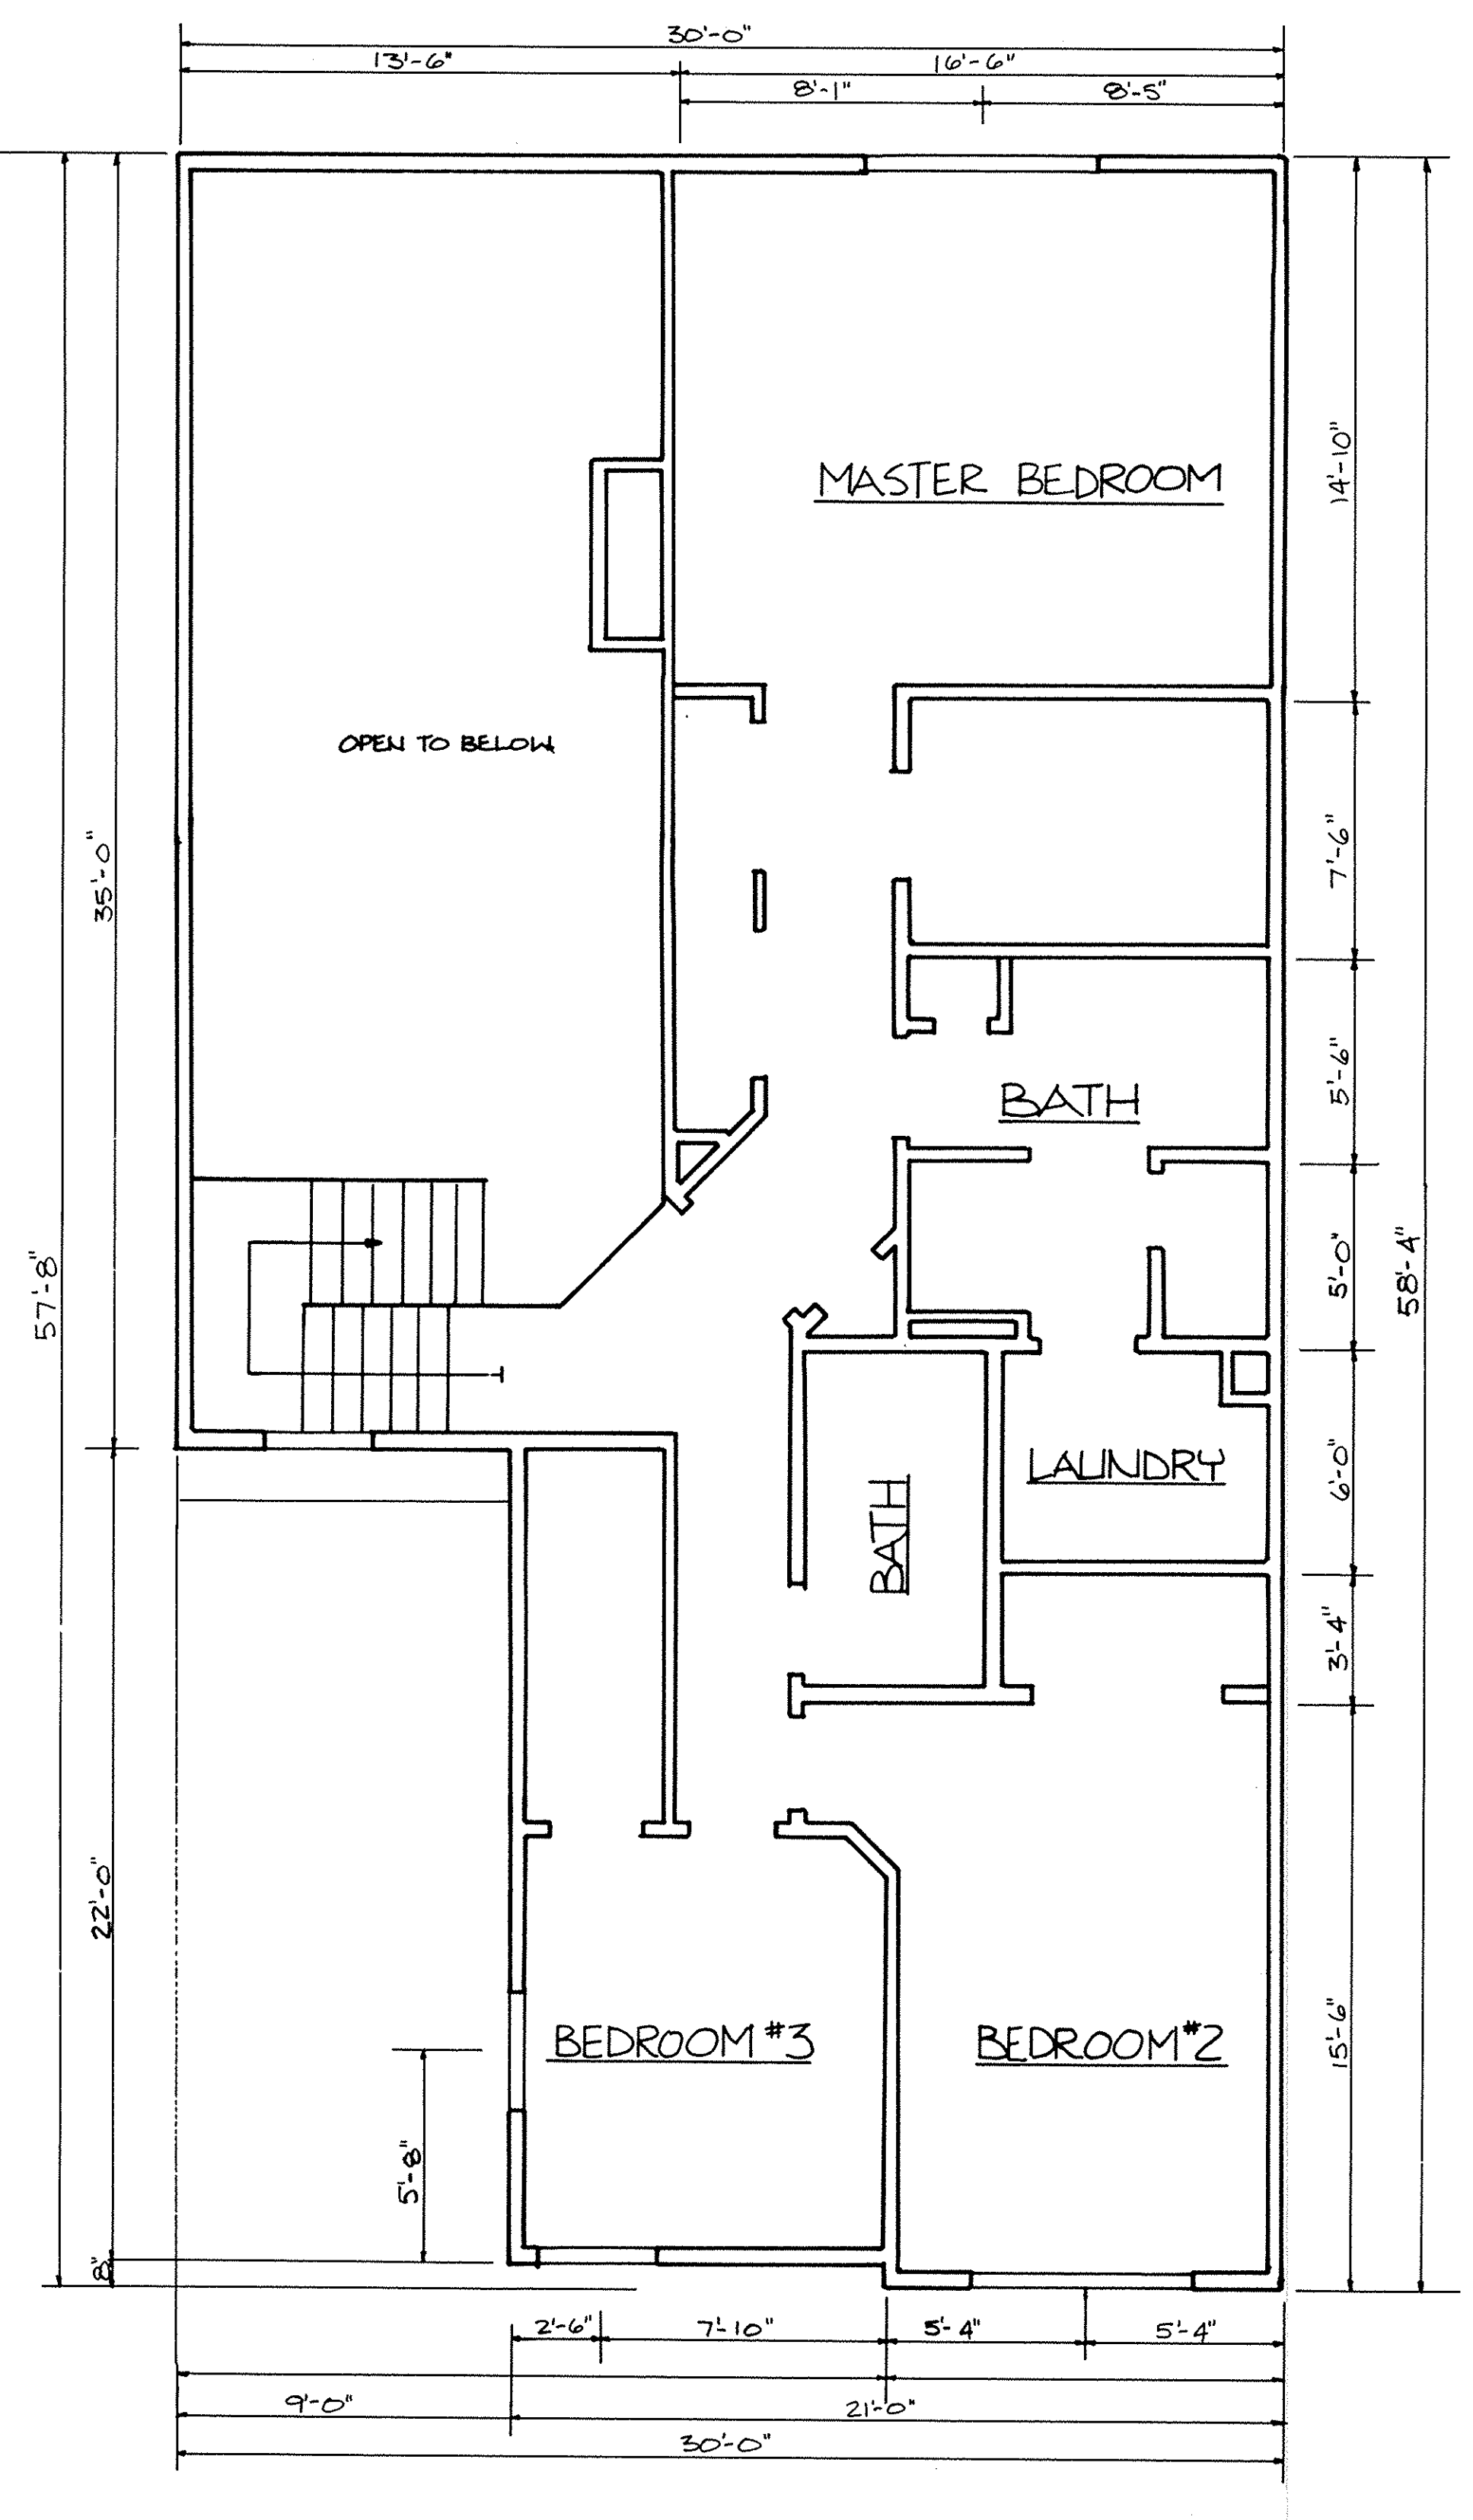


SECOND FLOOR PLAN - UNIT 54-181
SCALE: 1/4" = 1'-0"


WESTWINDS SOUTH CONDOMINIUM No.1
FOURTH AMENDMENT PHASE 5
FLOOR PLANS - UNIT 54-181

LORAIN COUNTY TAX
MAP DEPARTMENT COPY

3
9

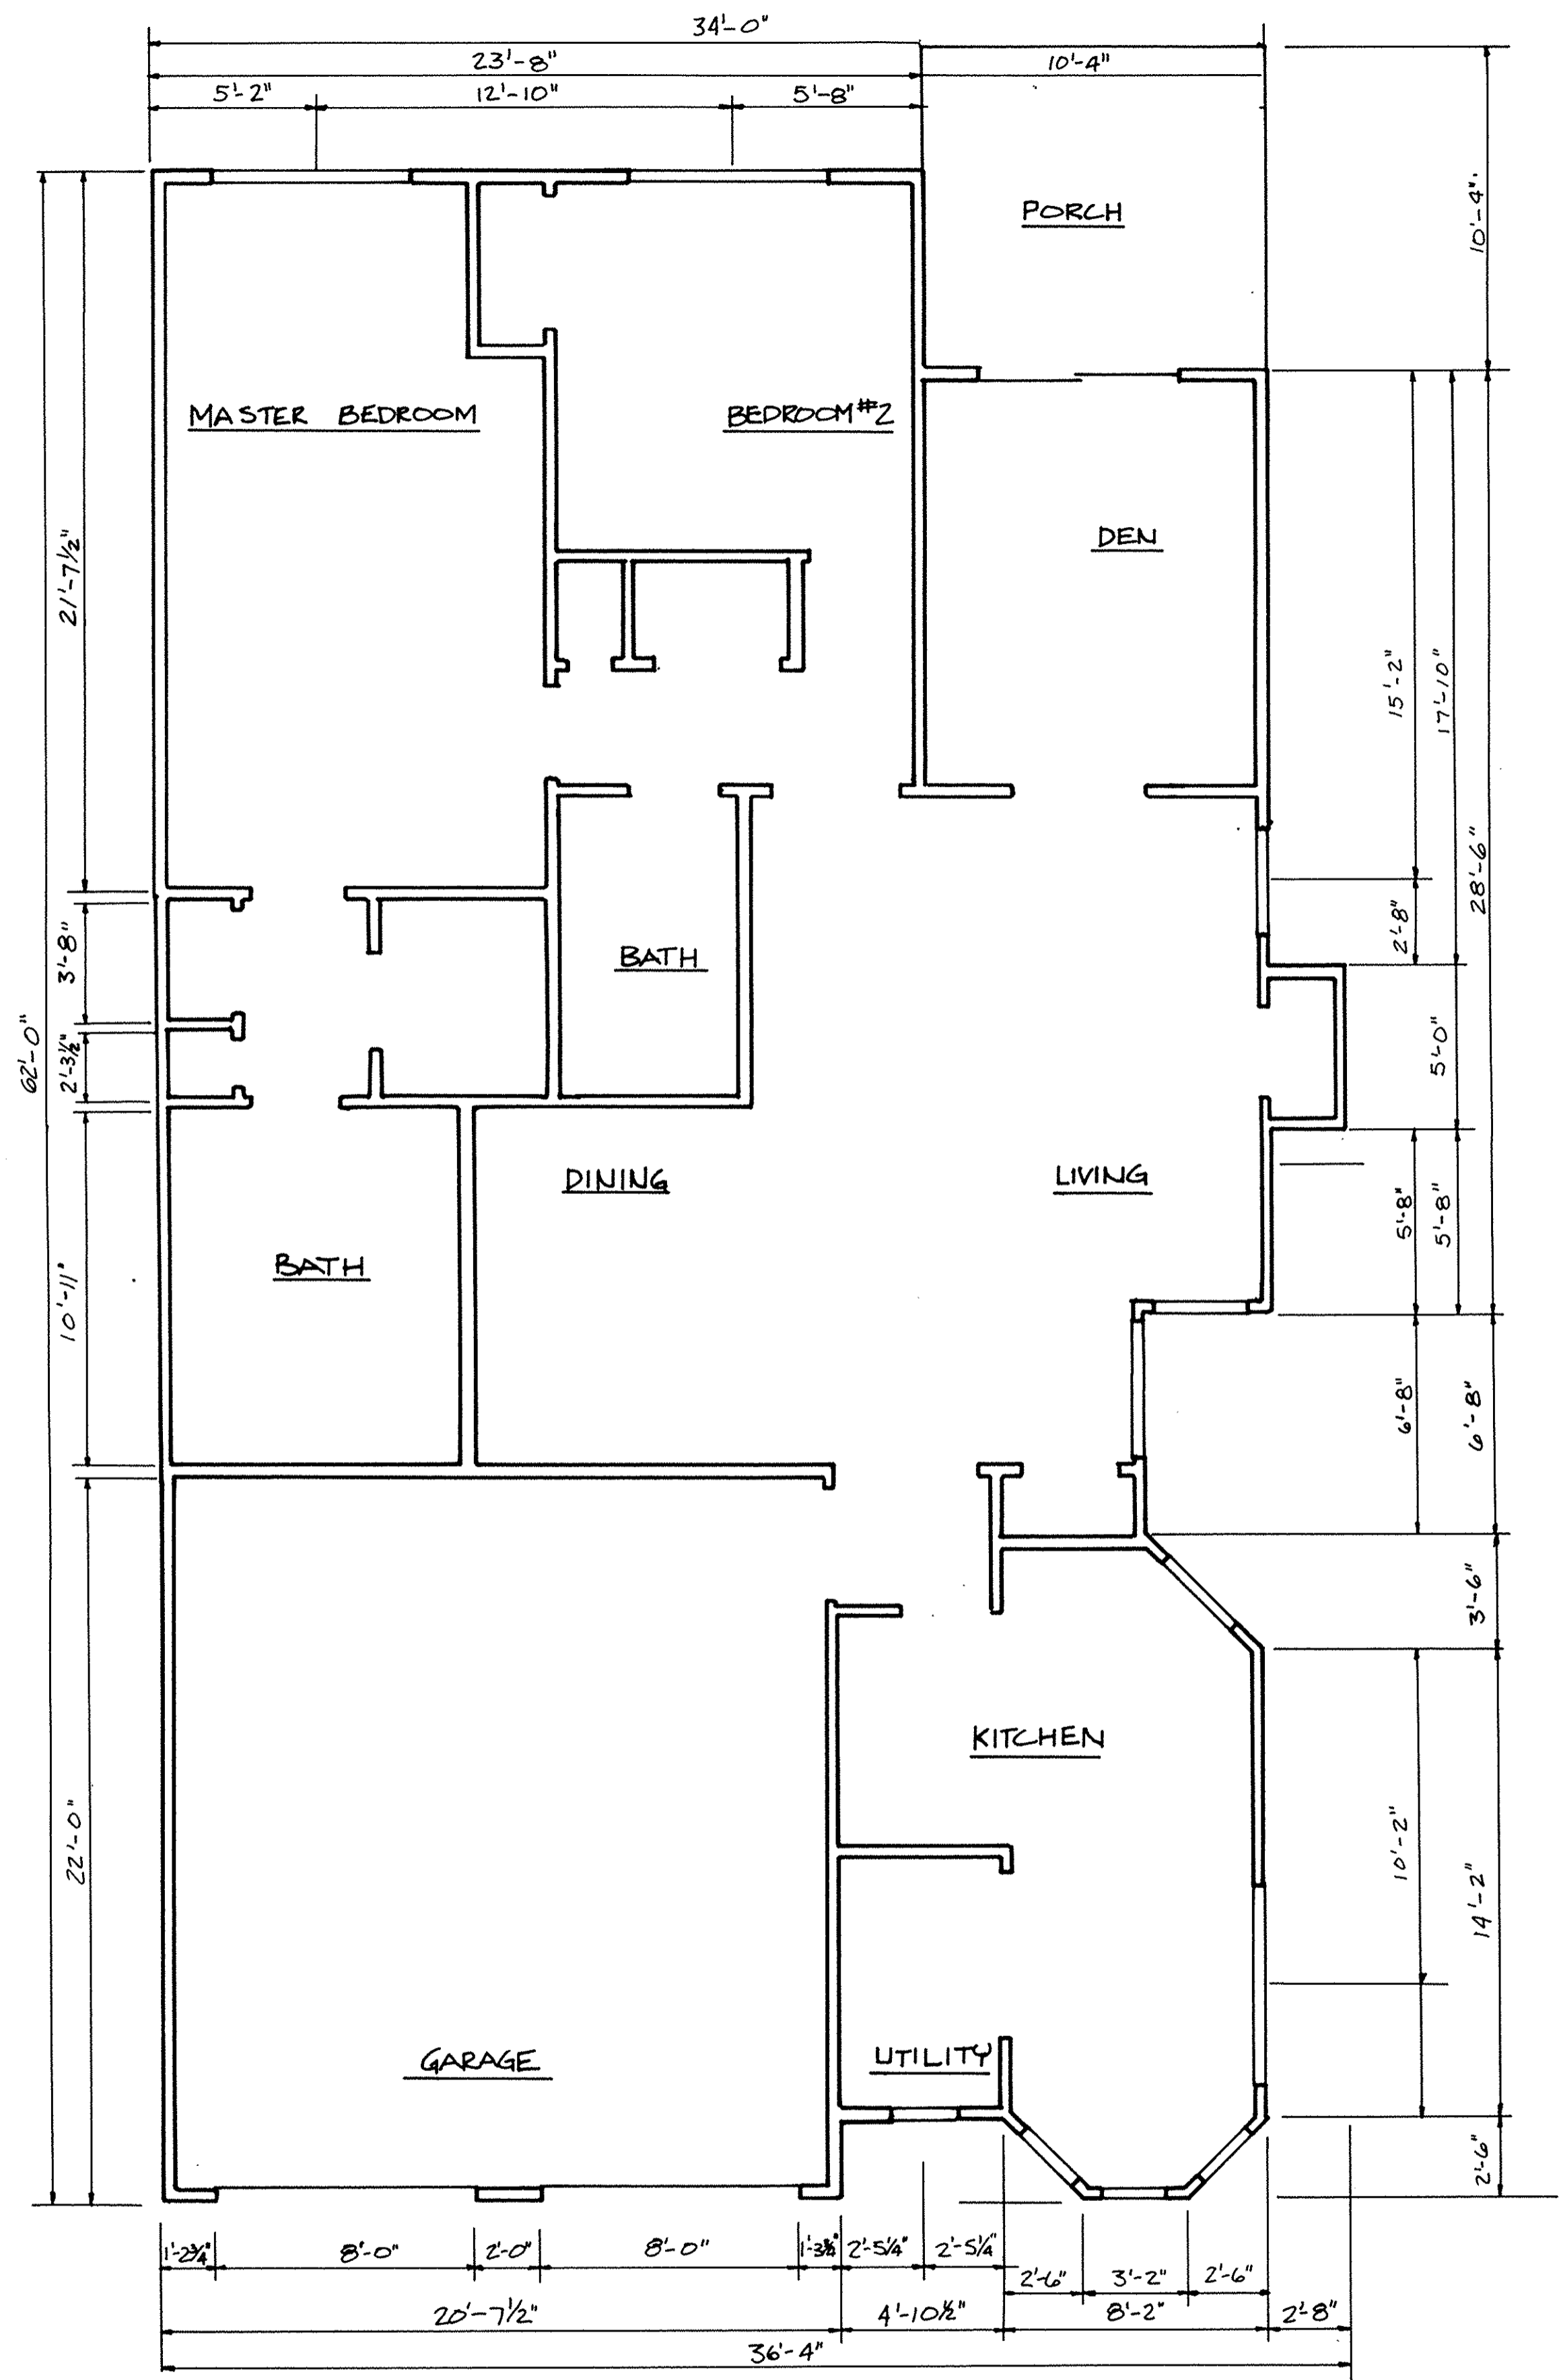

FLOOR PLAN - UNIT 51-178
SCALE: 1/4" = 1'-0"

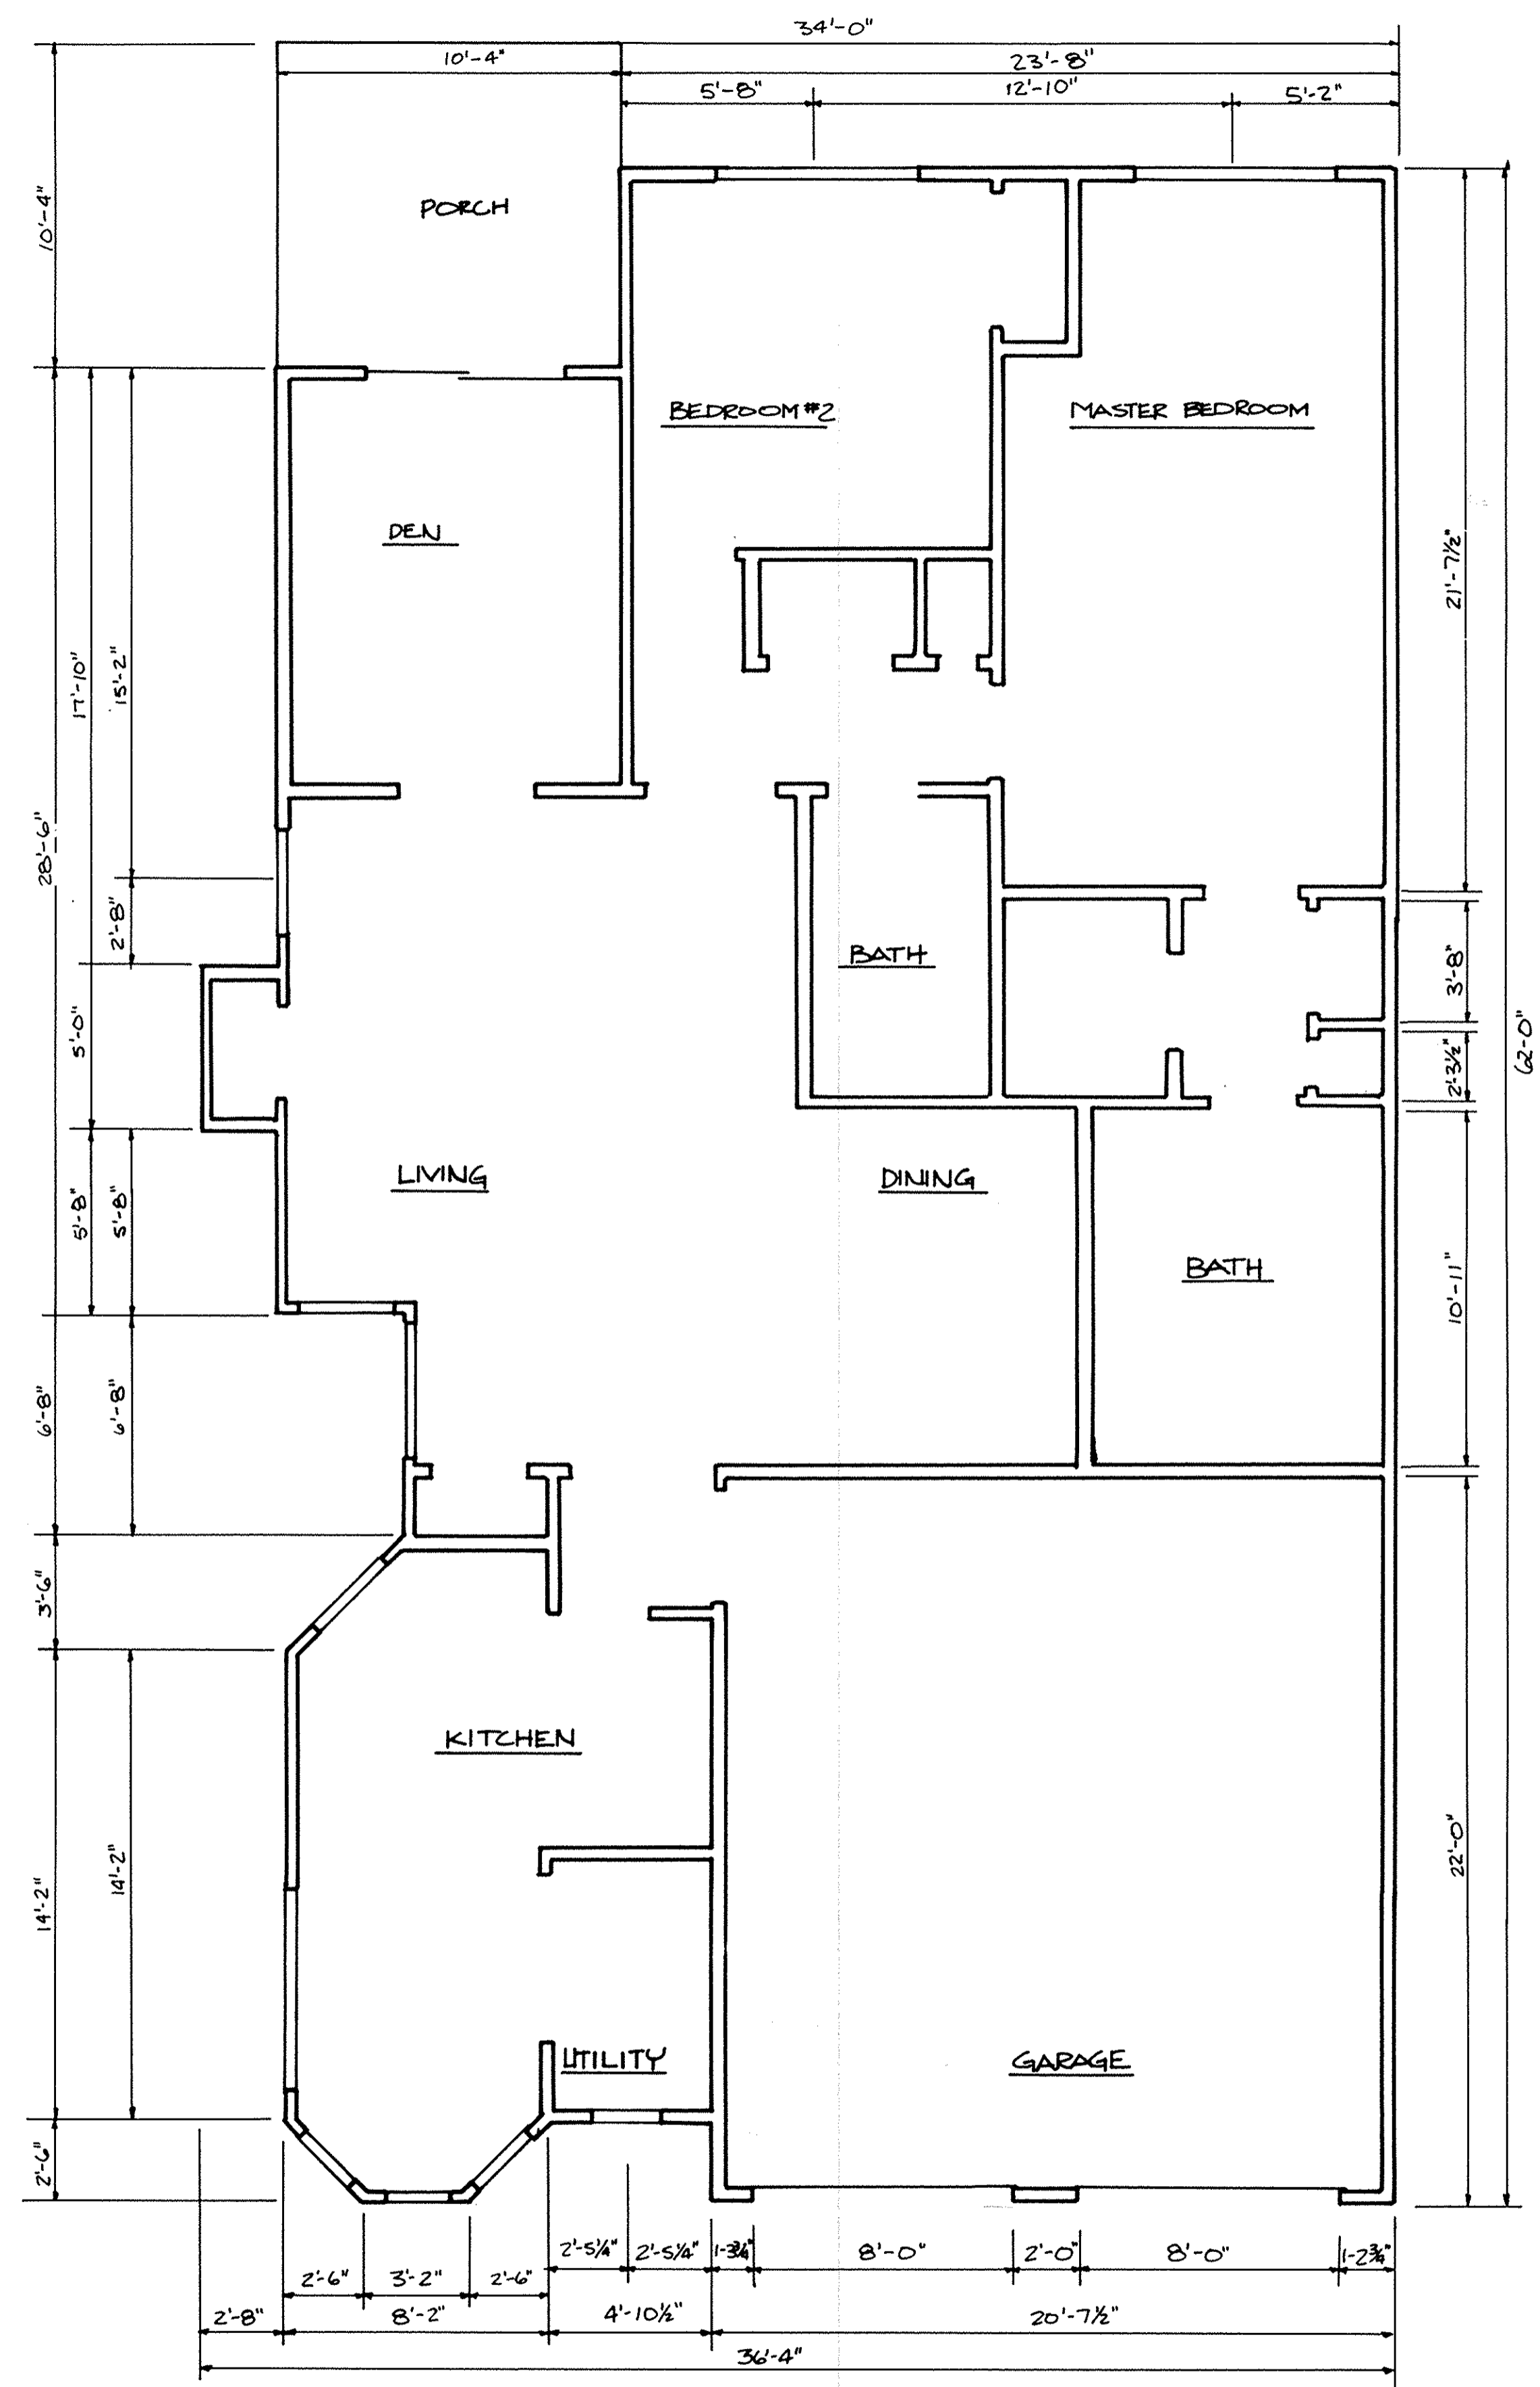


FLOOR PLAN - UNIT 55-182
SCALE: 1/4" = 1'-0"

WESTWINDS SOUTH CONDOMINIUM No. 1
FOURTH AMENDMENT PHASE 5

FLOOR PLANS - UNITS 51-178 & 55-182

LORAIN COUNTY TAX
MAP DEPARTMENT COPY

4
9

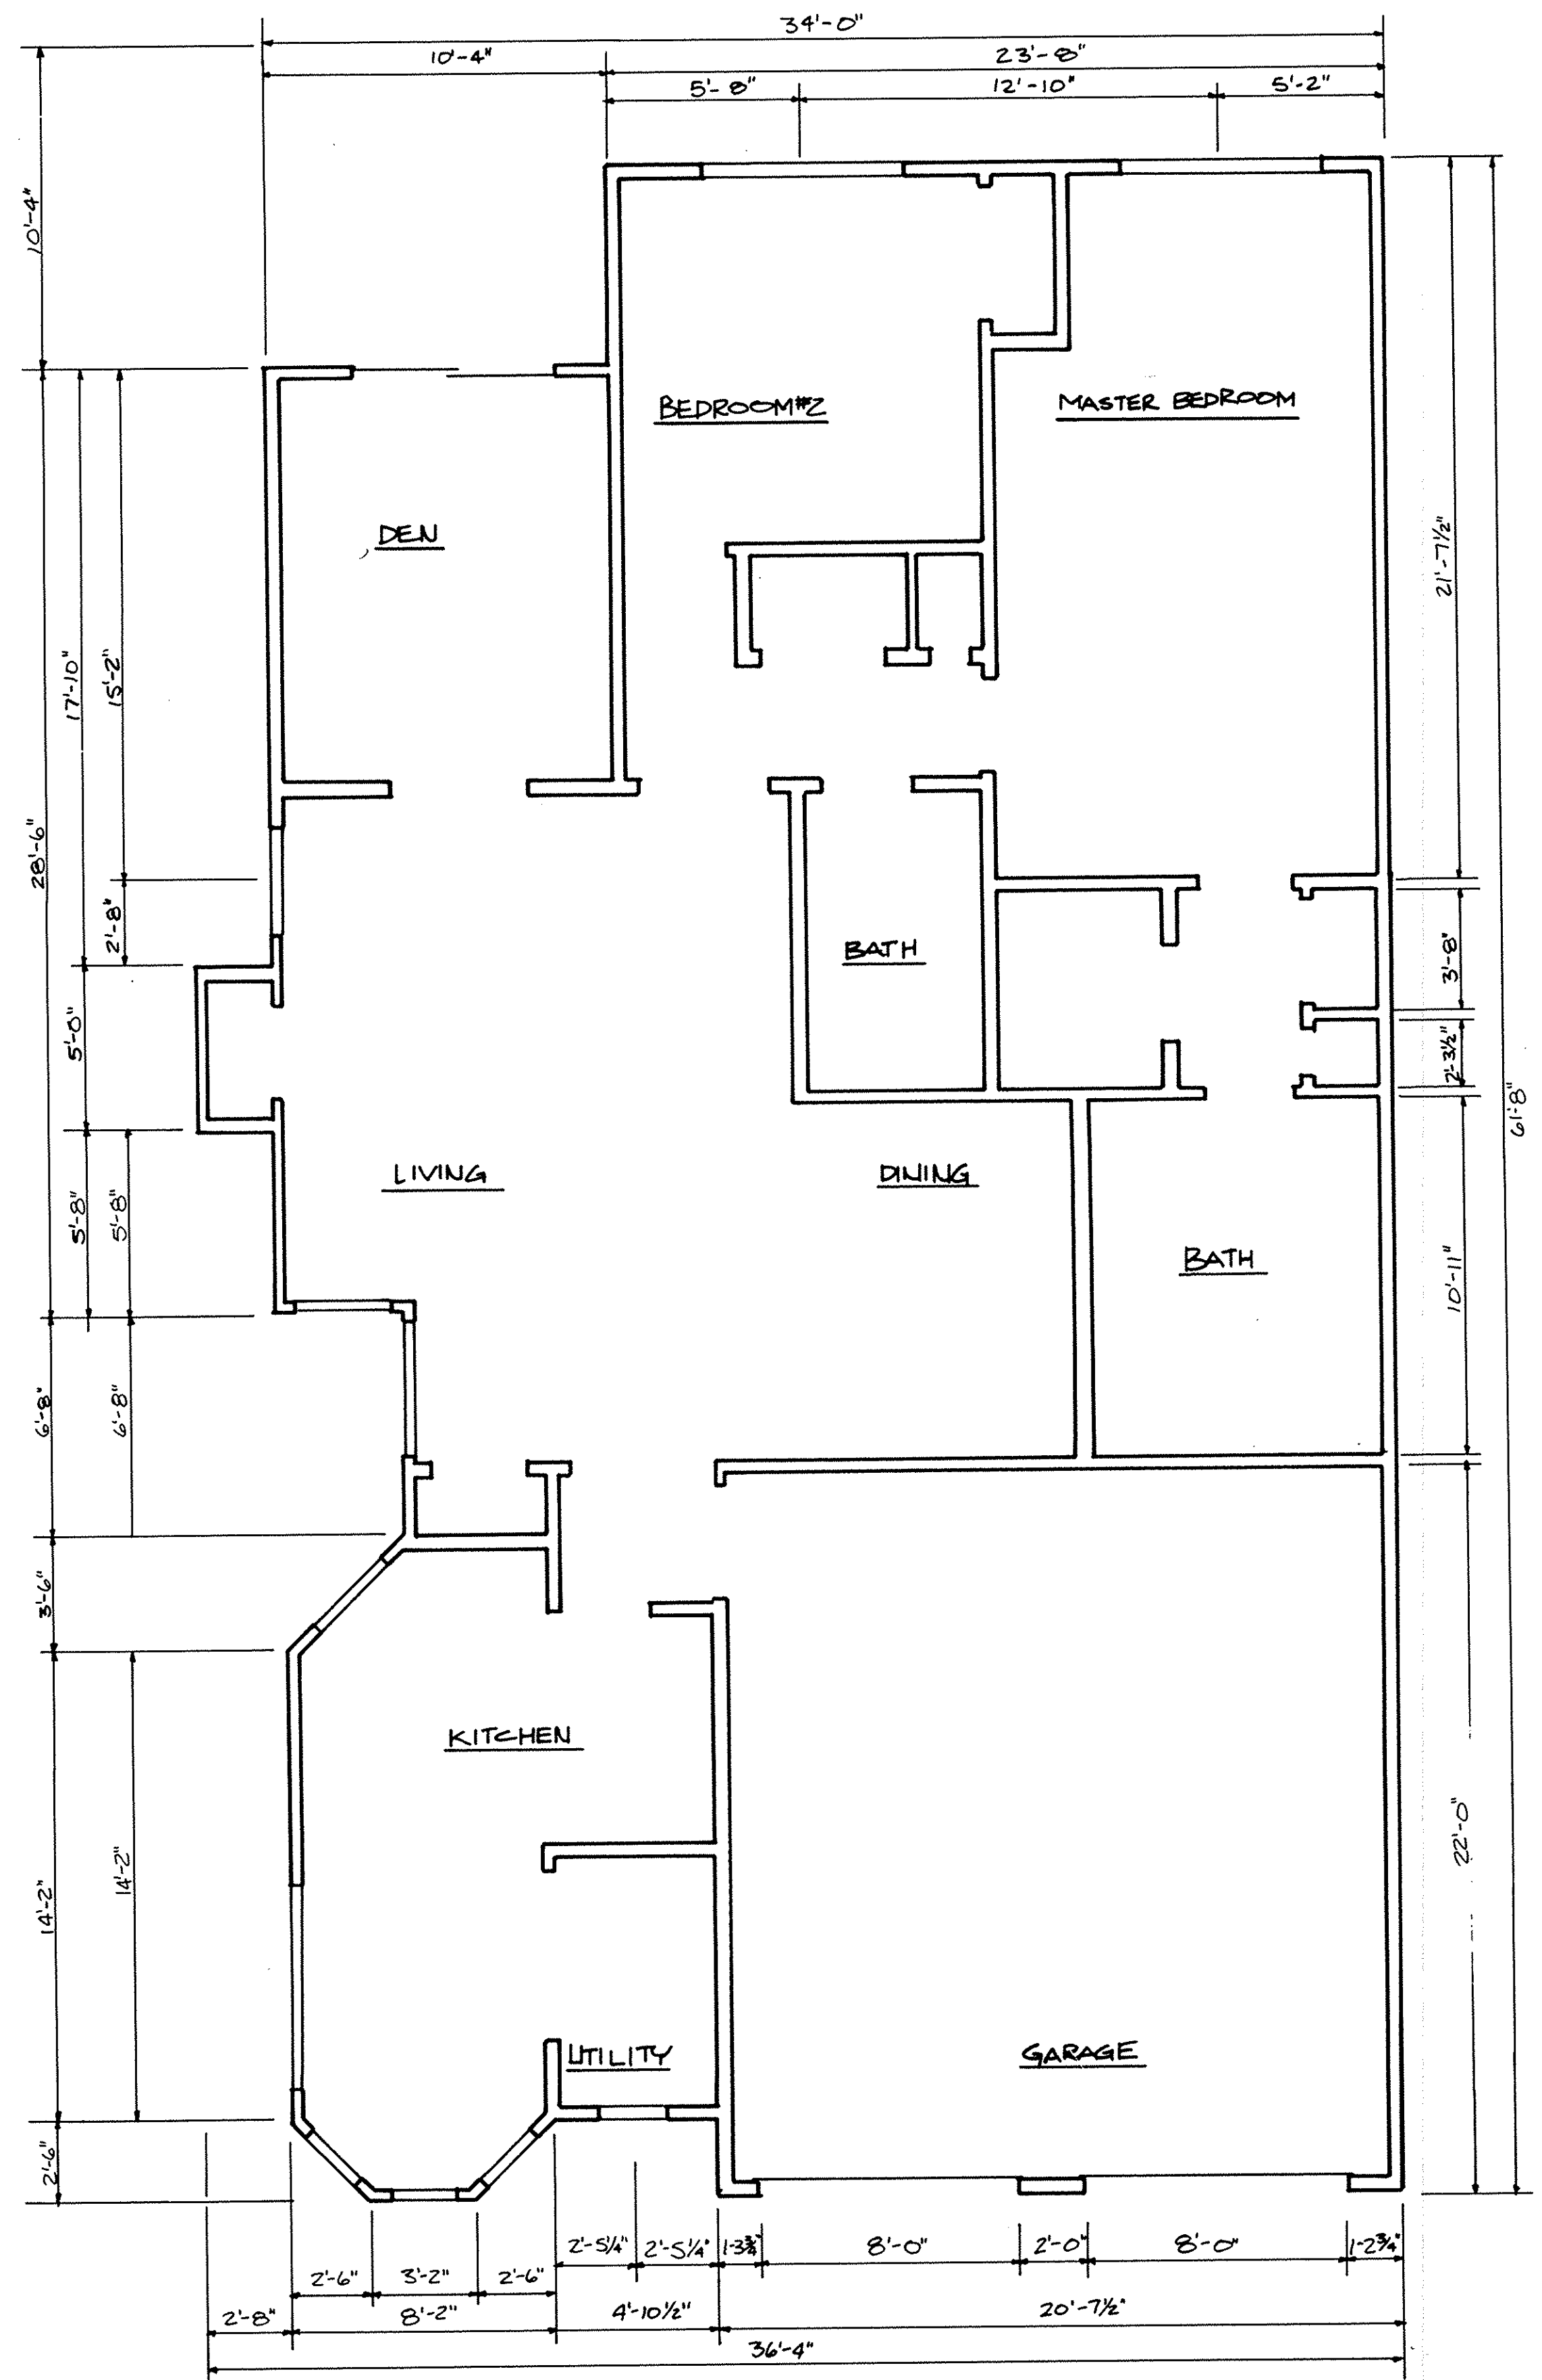


FLOOR PLAN - UNIT 56-183
 SCALE: 1/4" = 1'-0"


WESTWINDS SOUTH CONDOMINIUM No.1
 FOURTH AMENDMENT PHASE 5
 FLOOR PLAN - UNIT 56-183

LORAIN COUNTY TAX
 MAP DEPARTMENT COPY

5/9

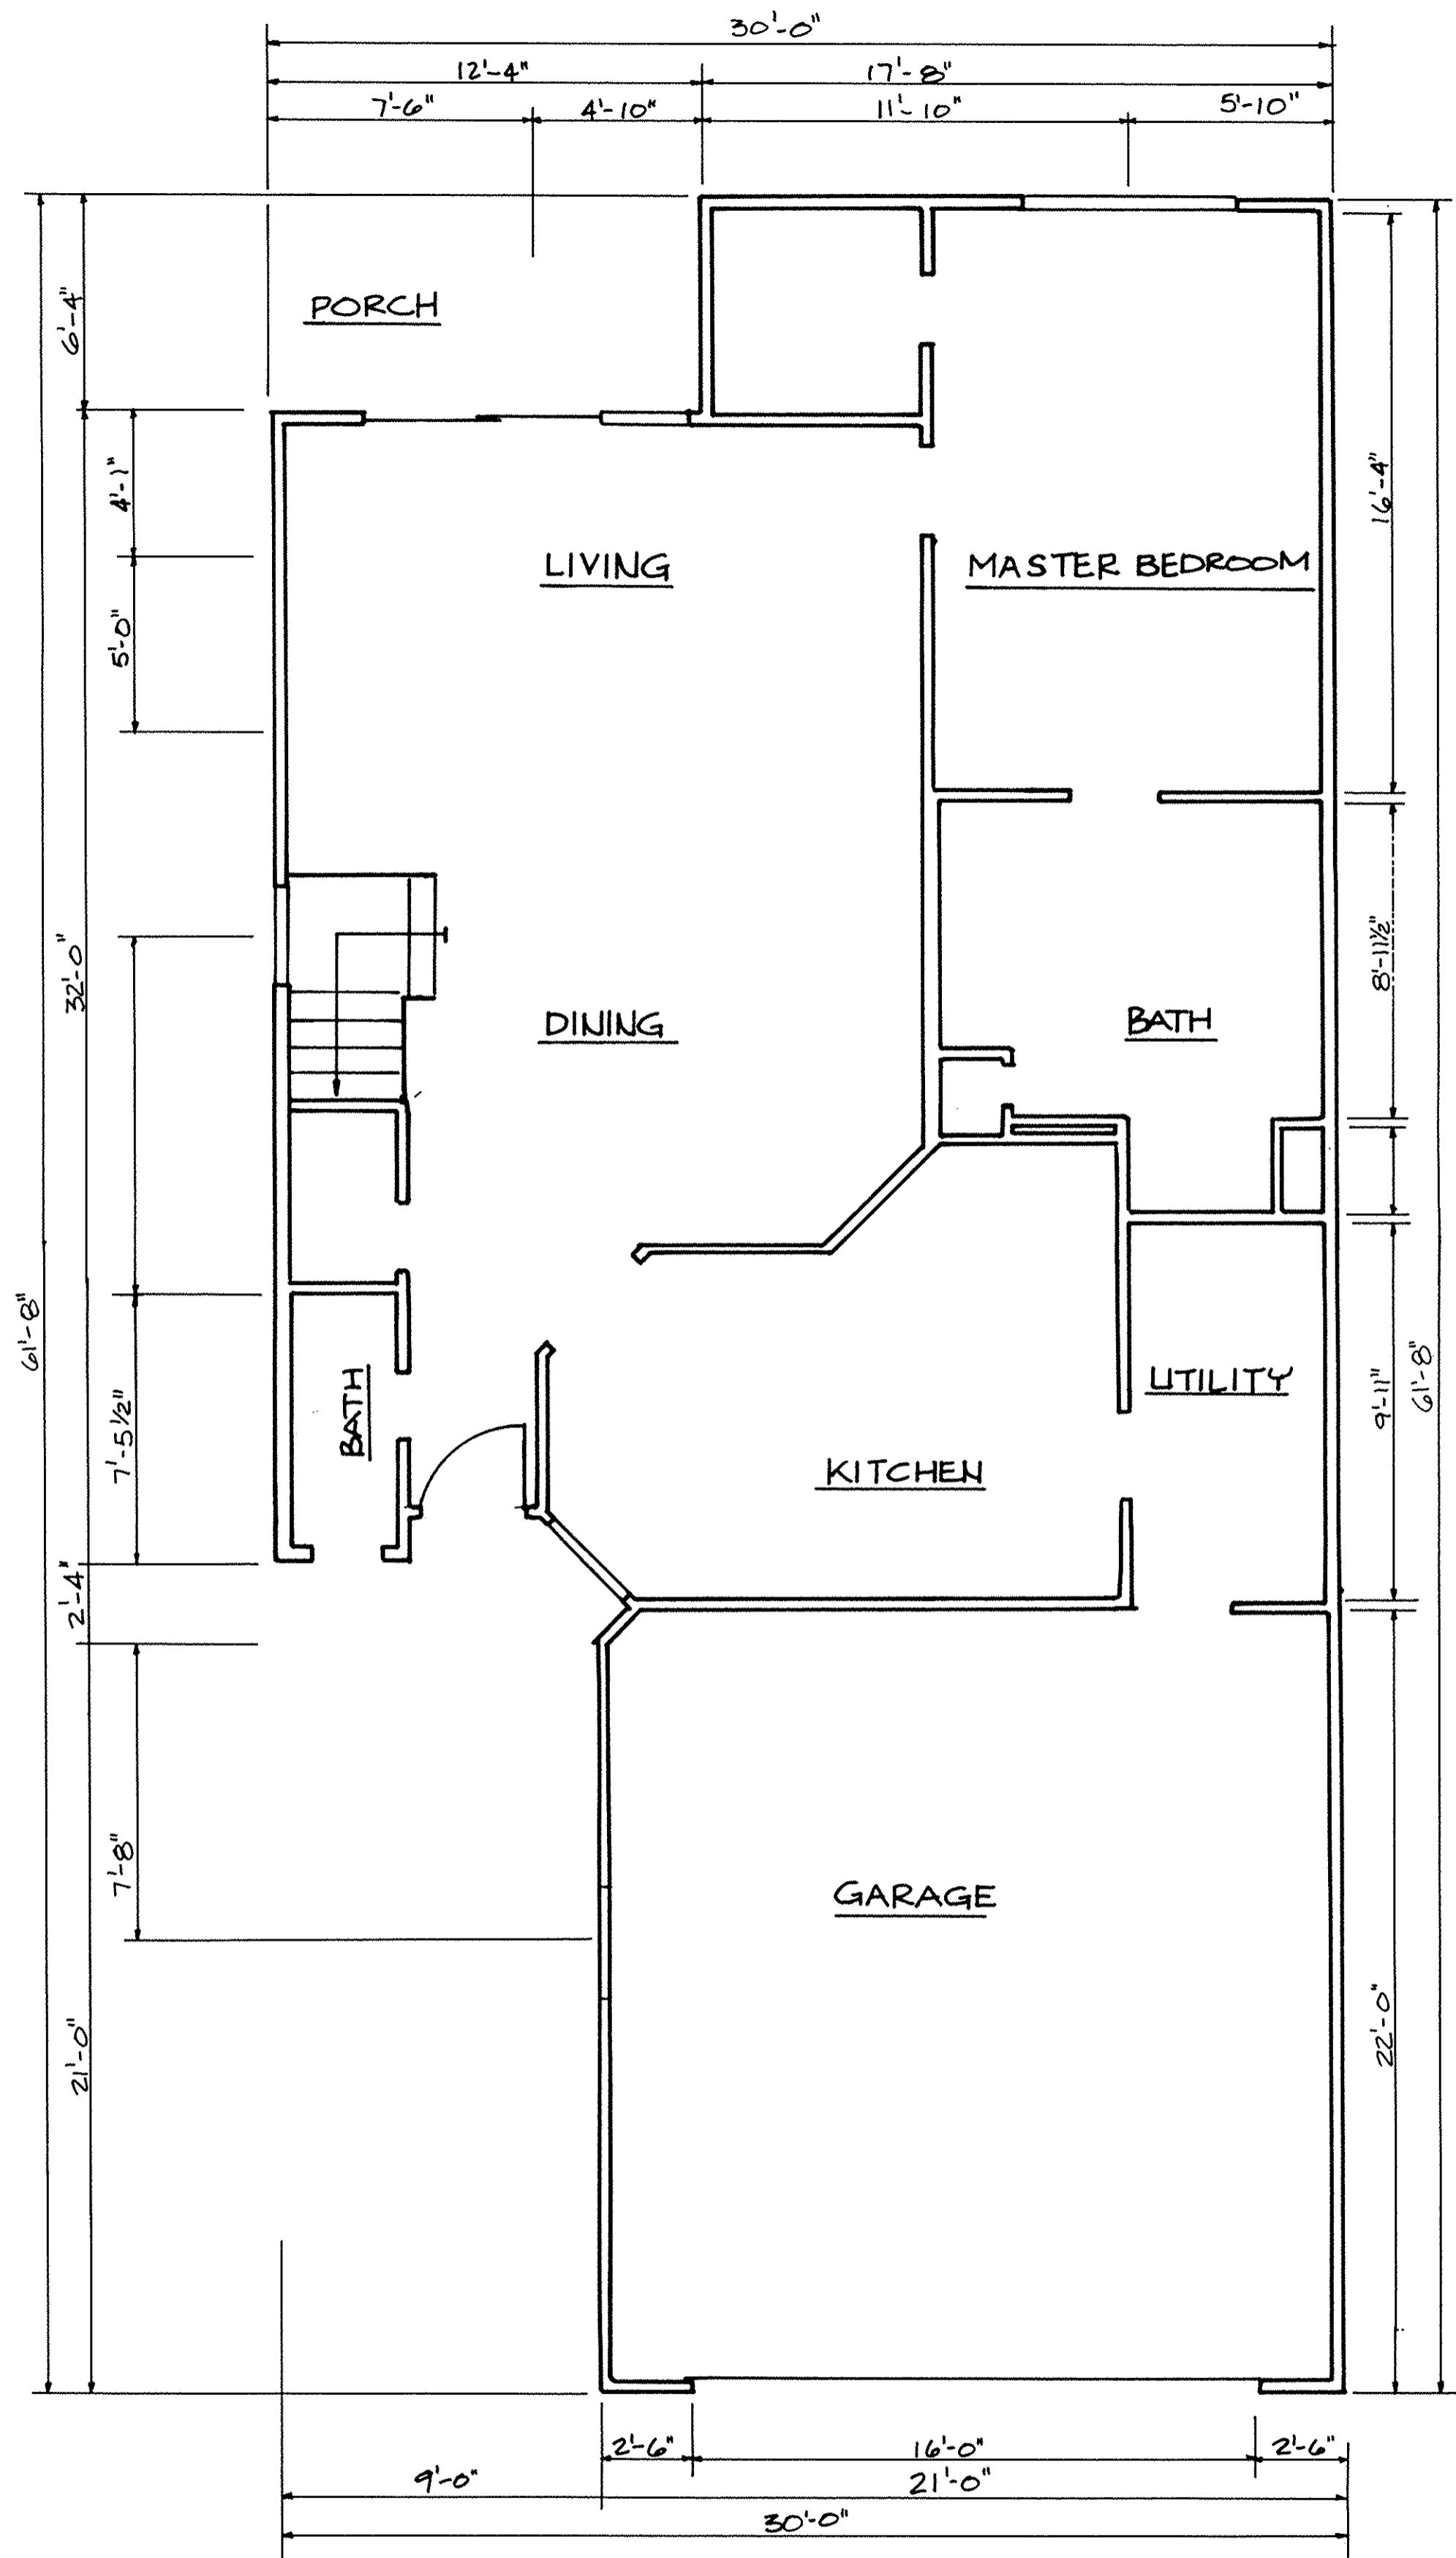


FIRST FLOOR PLAN-UNITS 57-184 & 58-185
SCALE: 1/4" = 1'-0"

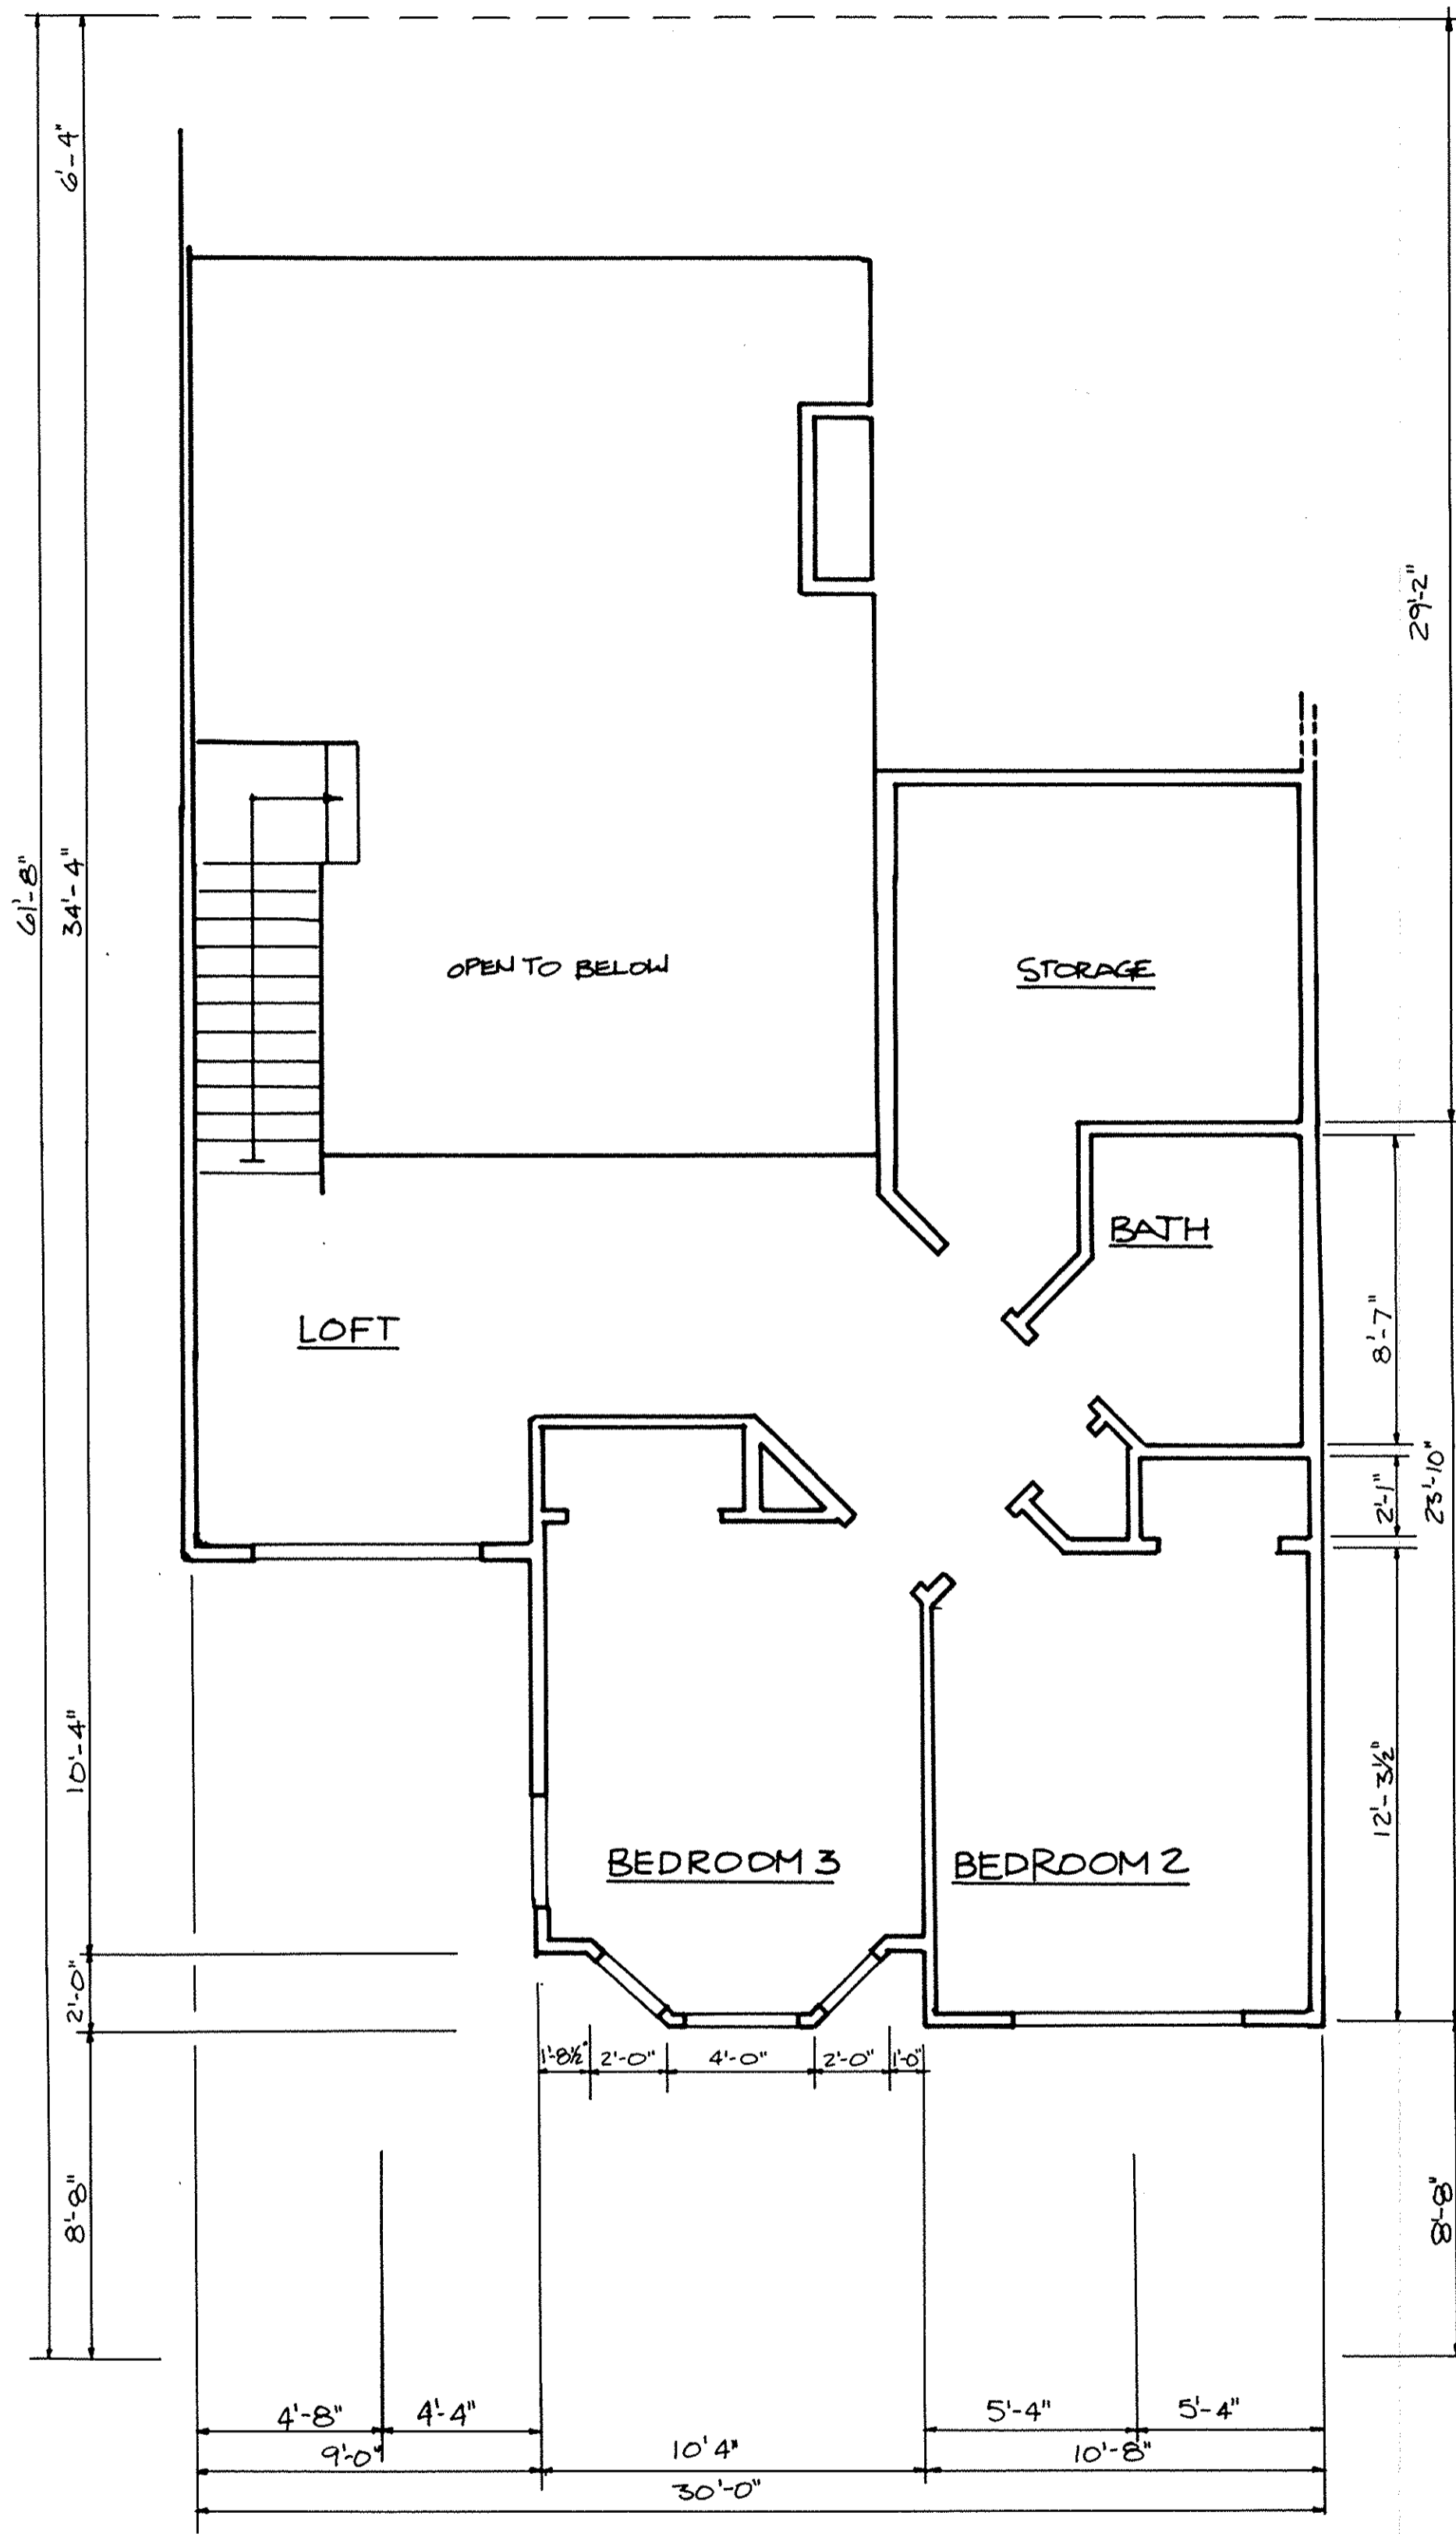


SECOND FLOOR PLAN-UNITS 57-184 & 58-185
SCALE: 1/4" = 1'-0"

WESTWINDS SOUTH CONDOMINIUM No. 1
FOURTH AMENDMENT PHASE 5
FLOOR PLANS-UNITS 57-184 & 58-185

LORAIN COUNTY TAX
MAP DEPARTMENT COPY

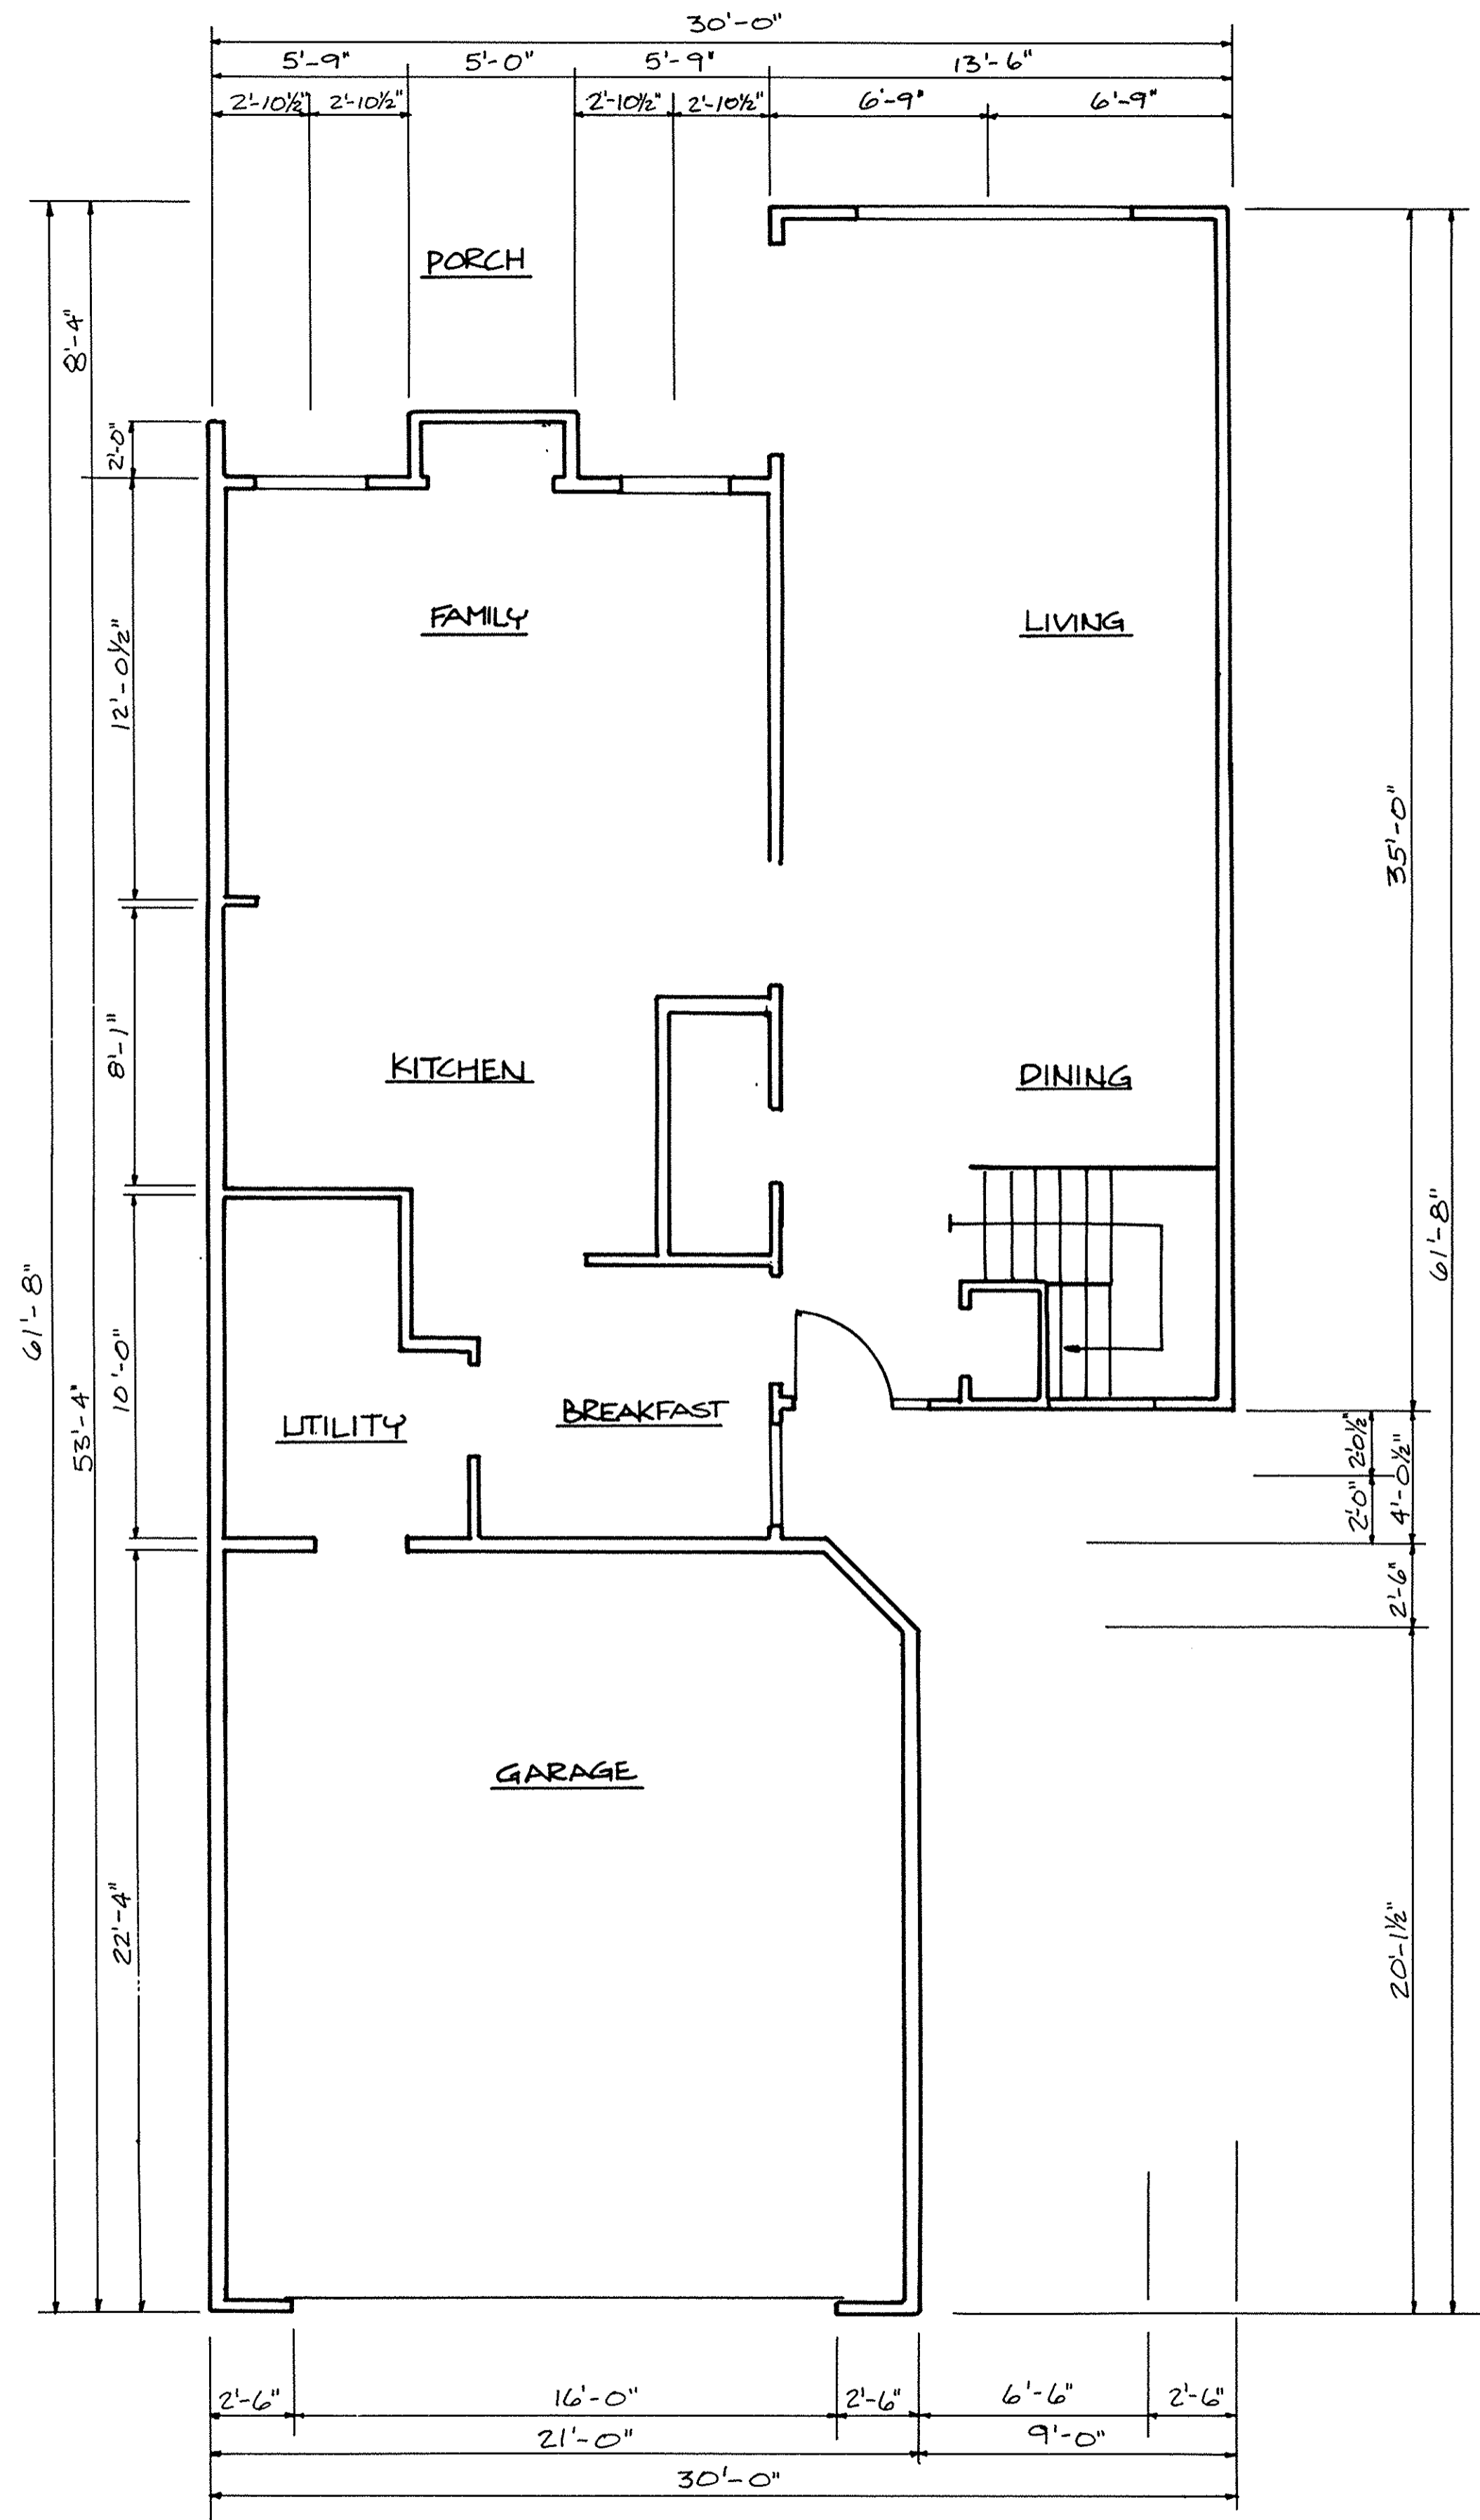


FIRST FLOOR PLAN - UNIT 59-186
SCALE: 1/4" = 1'-0"

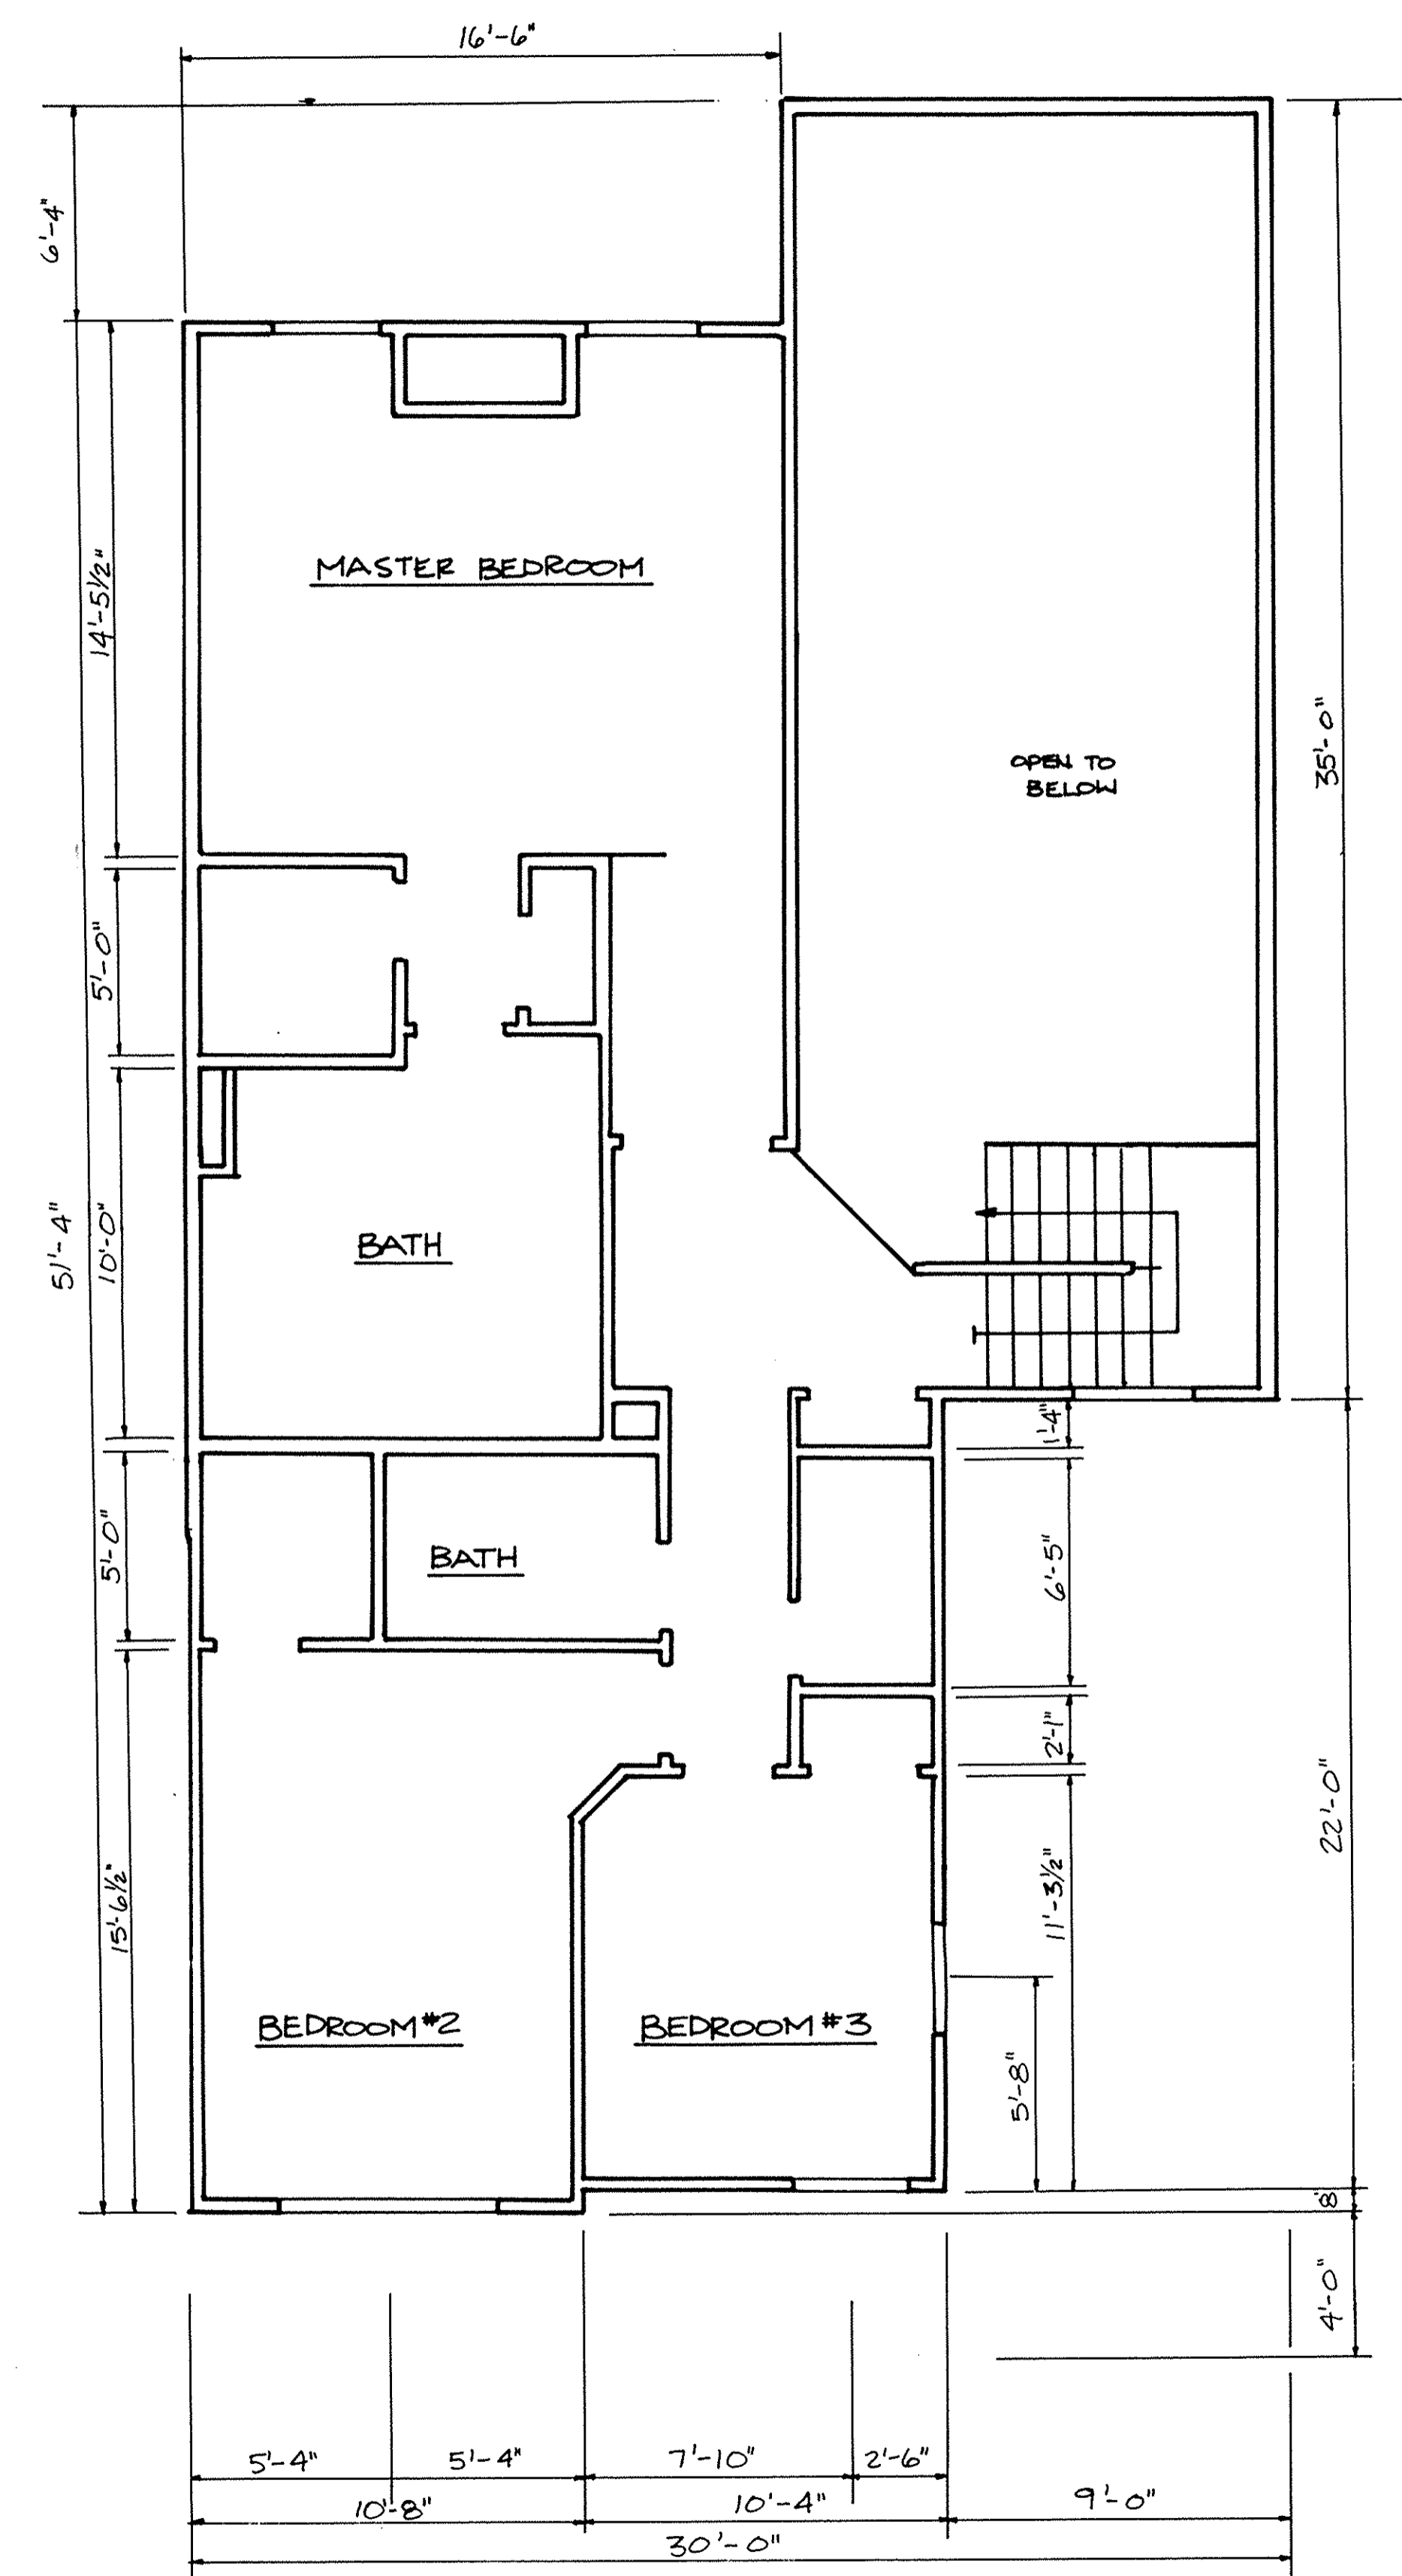


SECOND FLOOR PLAN - UNIT 59-186
SCALE: 1/4" = 1'-0"

WESTWINDS SOUTH CONDOMINIUM No. 1
FOURTH AMENDMENT PHASE 5
FLOOR PLANS - UNIT 59-186

LORAIN COUNTY TAX
MAP DEPARTMENT COPY

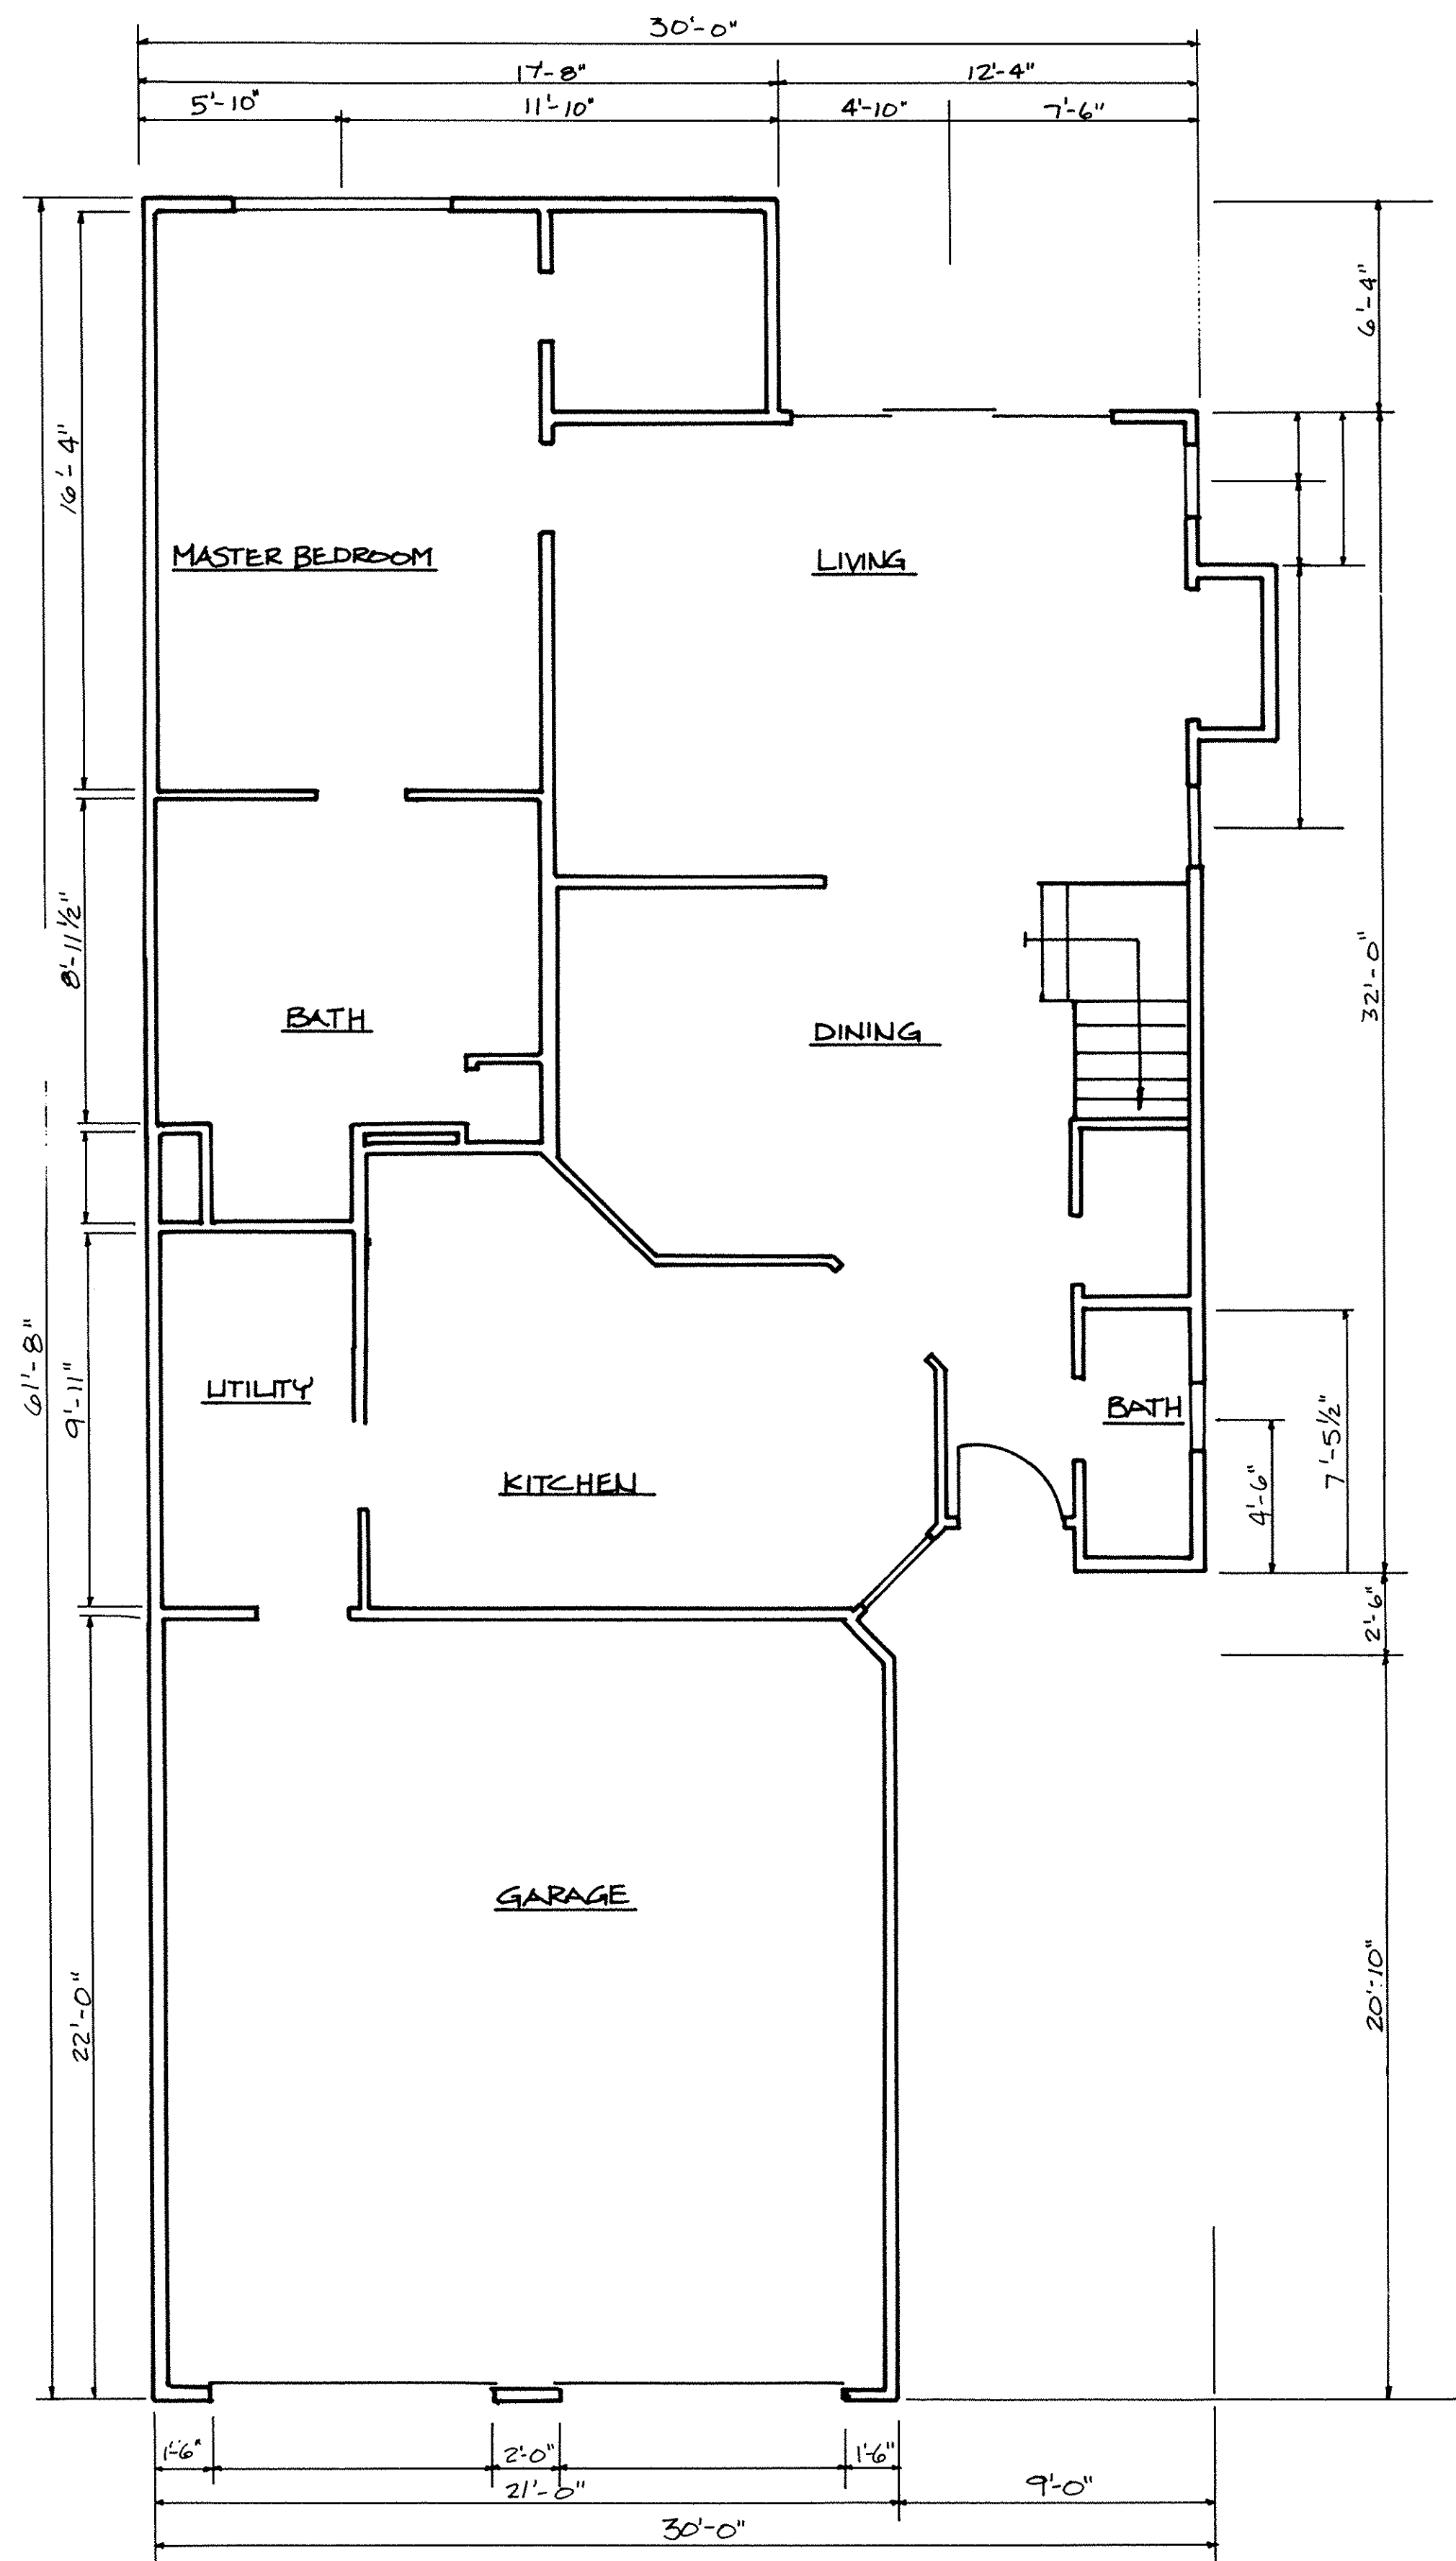

FIRST FLOOR PLAN - UNIT 60-187
SCALE: 1/4" = 1'-0"

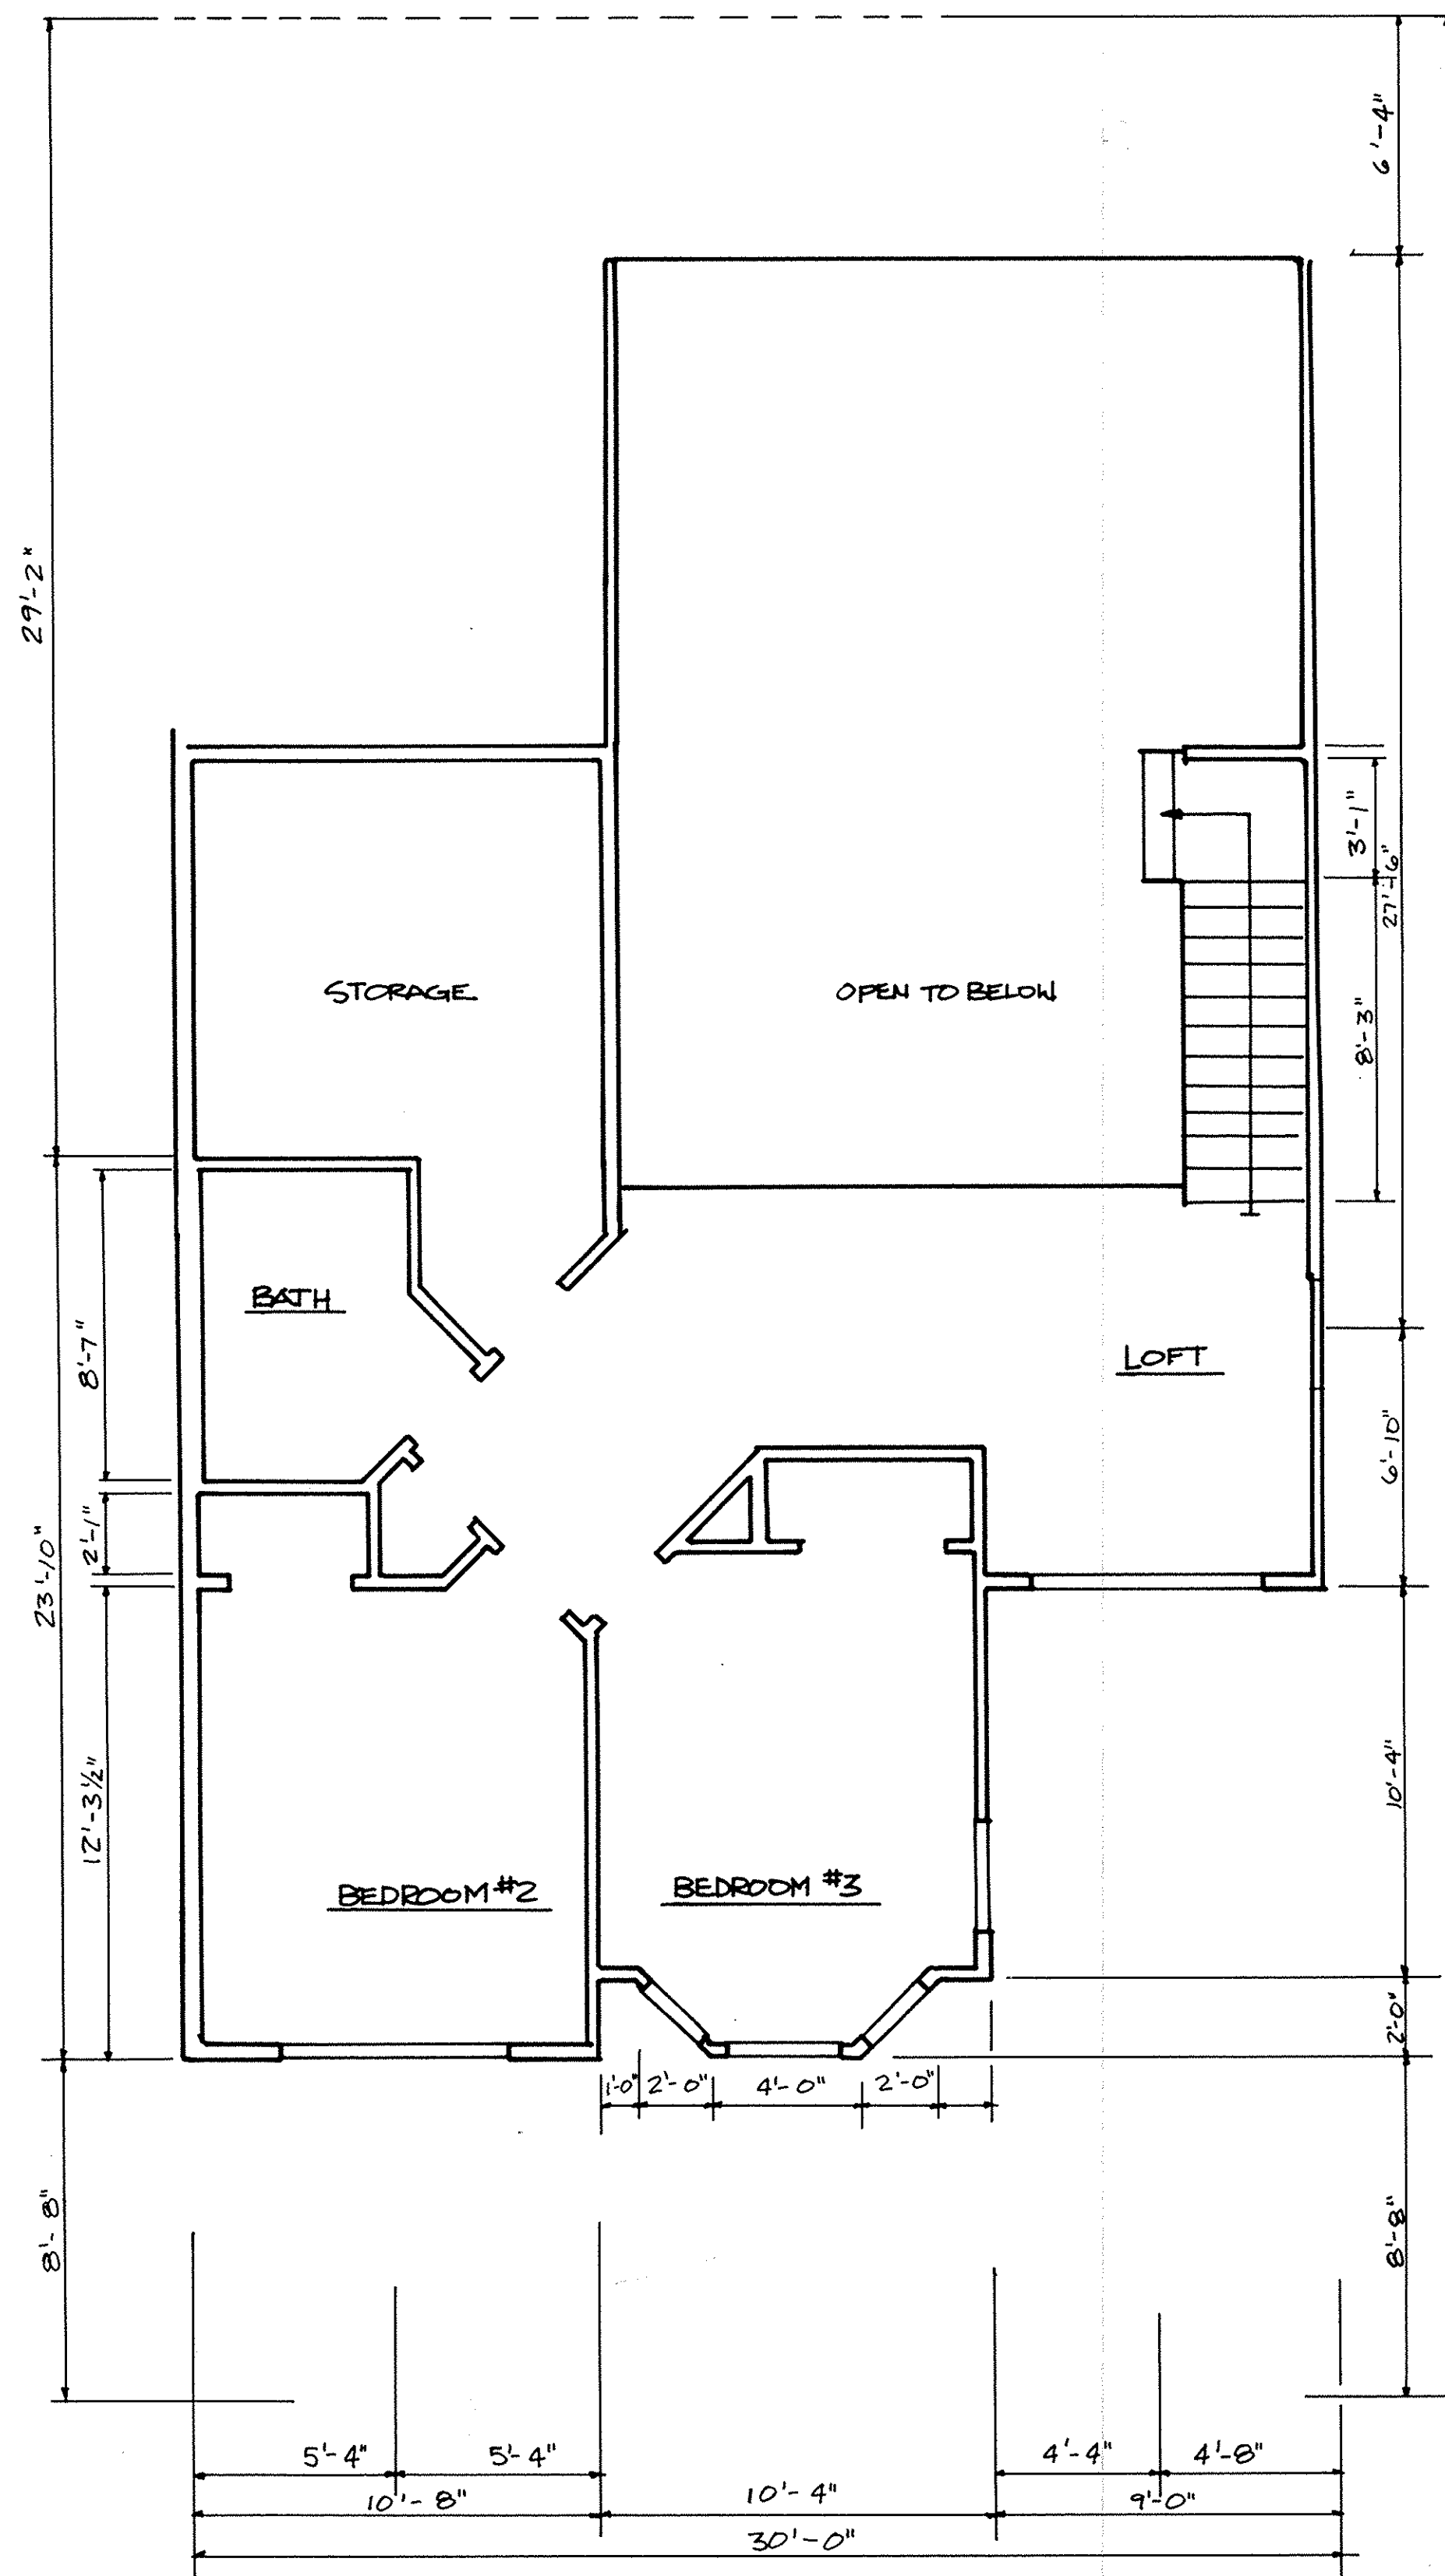

SECOND FLOOR PLAN - UNIT 60-187
SCALE: 1/4" = 1'-0"


WESTWINDS SOUTH CONDOMINIUM No. 1
FOURTH AMENDMENT PHASE 5
FLOOR PLANS - UNIT 60-187

LORAIN COUNTY TAX
MAP DEPARTMENT COPY

8/9



LEFT SIDE ELEVATION

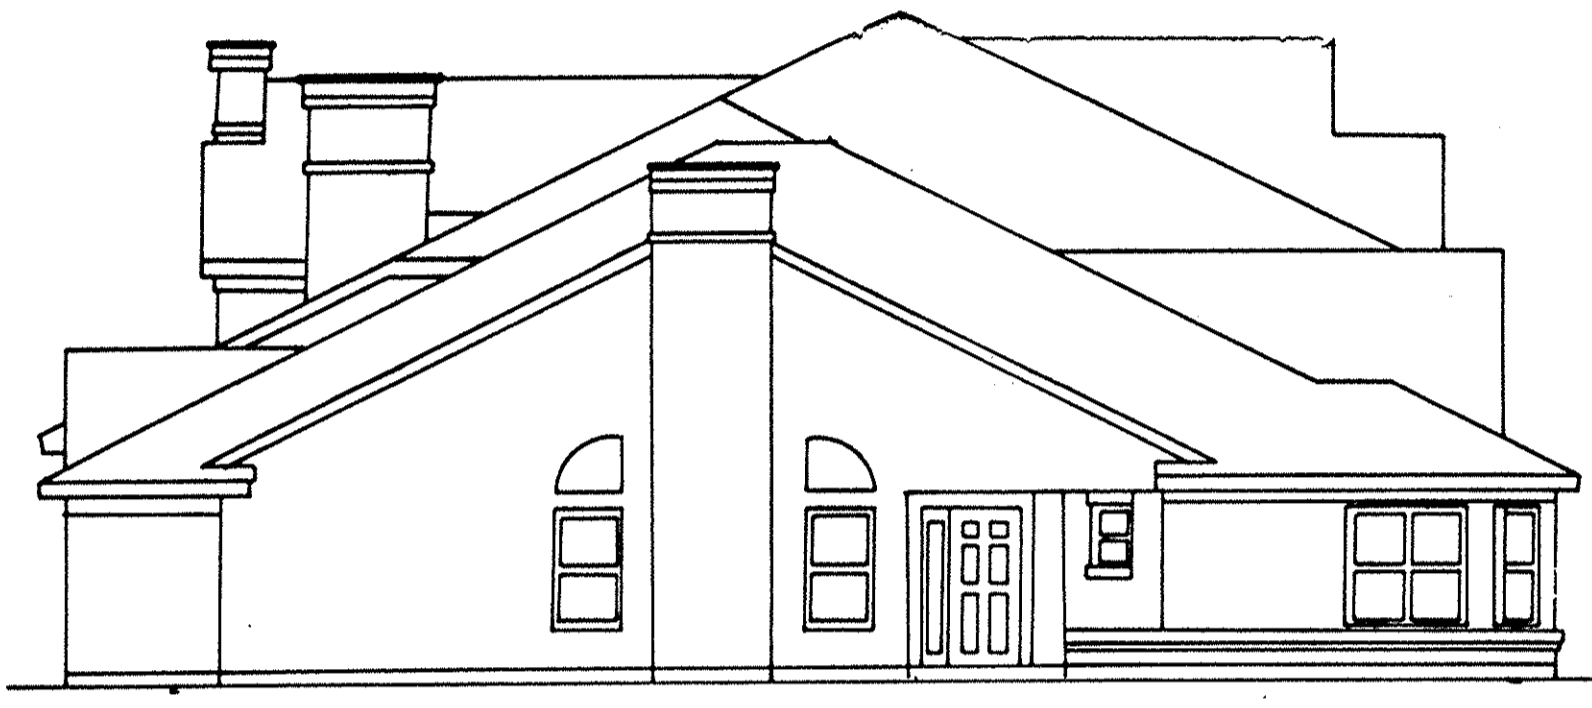

RIGHT SIDE ELEVATION



FRONT ELEVATION



REAR ELEVATION

WESTWINDS SOUTH CONDOMINIUM No.1
FOURTH AMENDMENT PHASE 5

EXTERIOR ELEVATIONS

LORAIN COUNTY TAX
MAP DEPARTMENT COPY

9/9

LORAIN COUNTY TAX MAP DEPARTMENT COPY