


#192434

#192434






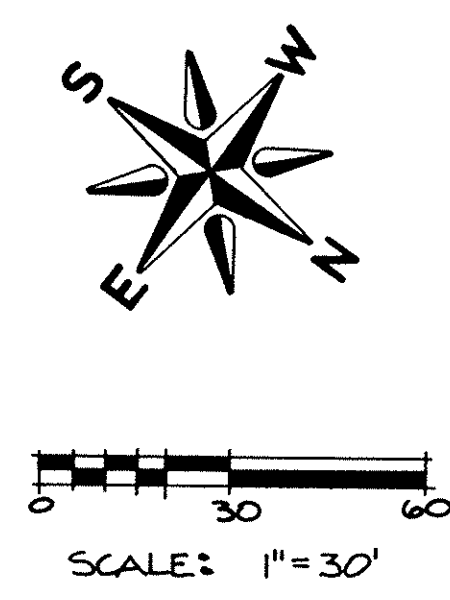


UNIT #	AREA (SF)	% OWNERSHIP
101	866	1.83
102	1198	2.53
103	1181	2.49
104	1181	2.49
105	1198	2.53
106	866	1.83
201	866	1.83
202	1198	2.53
203	1181	2.49
204	1181	2.49
205	1198	2.53
206	866	1.83
301	866	1.83
302	1198	2.53
303	1181	2.49
304	1181	2.49
305	1198	2.53
306	866	1.83
107	1175	2.48
108	1204	2.54
109	1175	2.48
207	855	1.81
208	1175	2.48
209	1173	2.47
210	1155	2.44
211	1175	2.48
212	855	1.81
307	855	1.81
308	1175	2.48
309	1173	2.47
310	1155	2.44
311	1175	2.48
312	855	1.81
110	1890	3.99
111	1890	3.99
112	1890	3.99
113	1890	3.99
114	1890	3.99
115	2093	4.42
TOTAL	47343	100.00

HIDDEN CREEK CONDOMINIUM PHASE 1 P.V. 45 P. 55-59


HIDDEN CREEK CONDOMINIUM PHASE 2 P.V. 48 P. 72-77

HIDDEN CREEK CONDOMINIUM PHASE 3

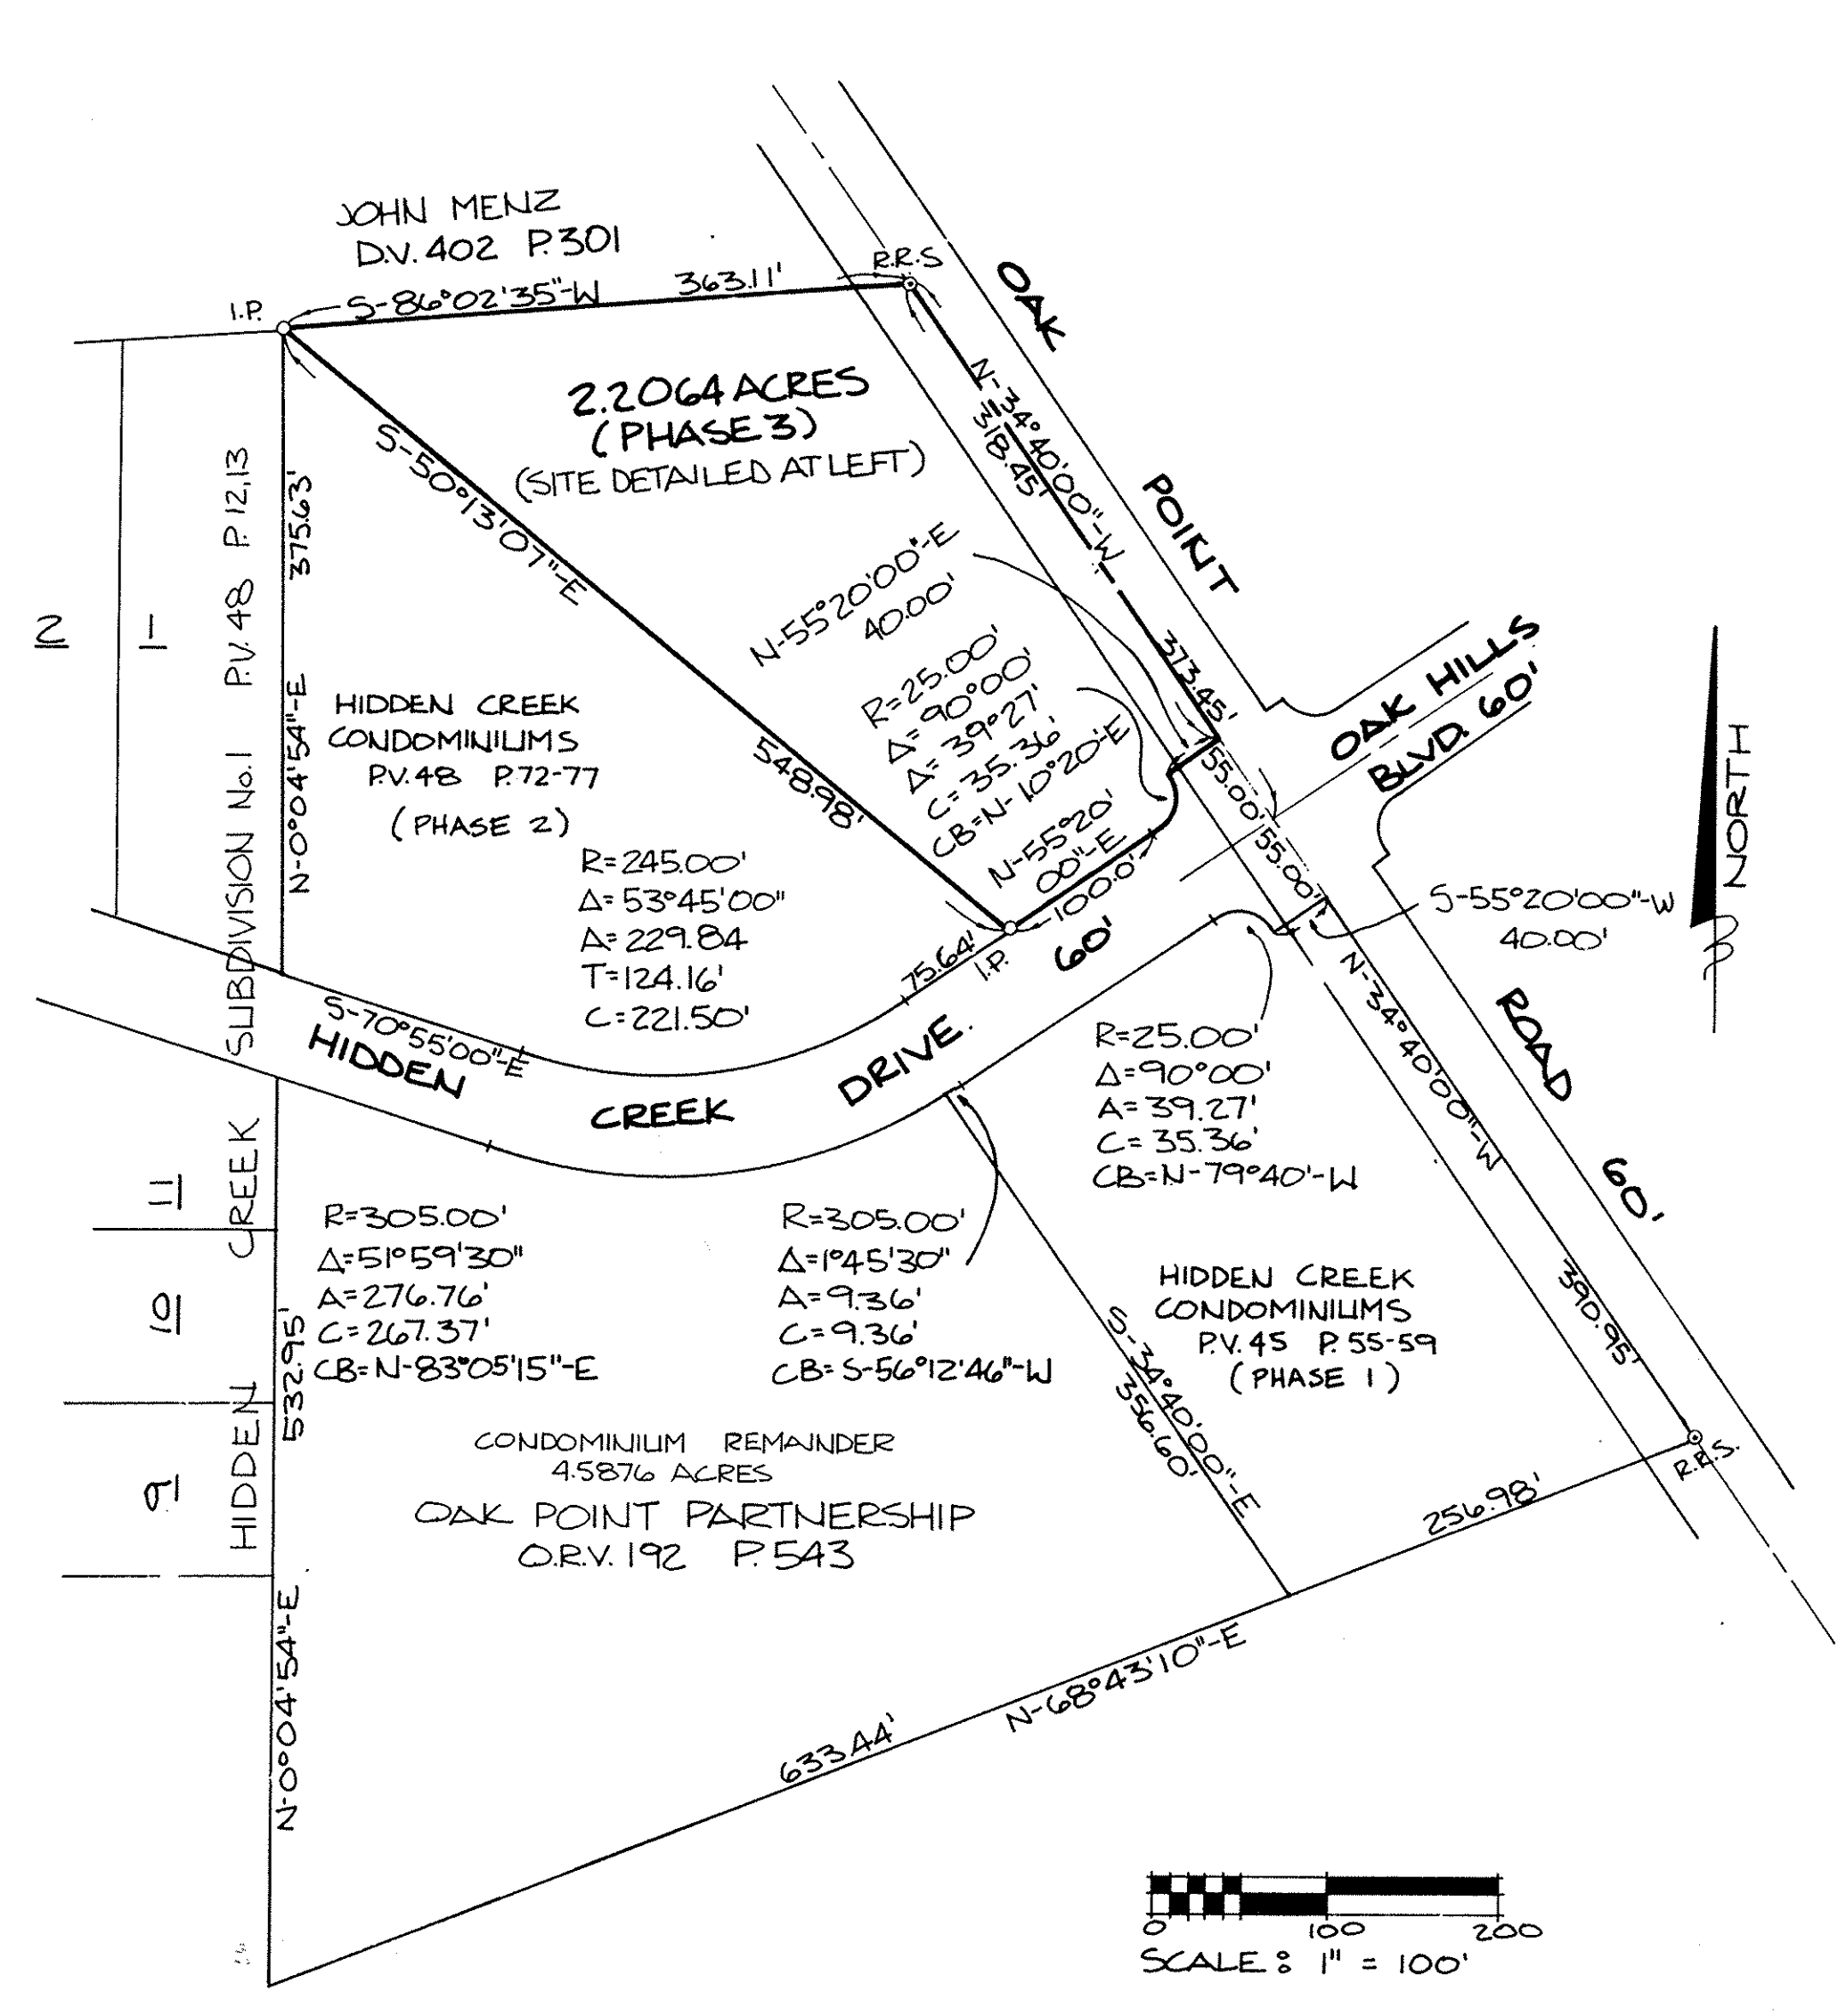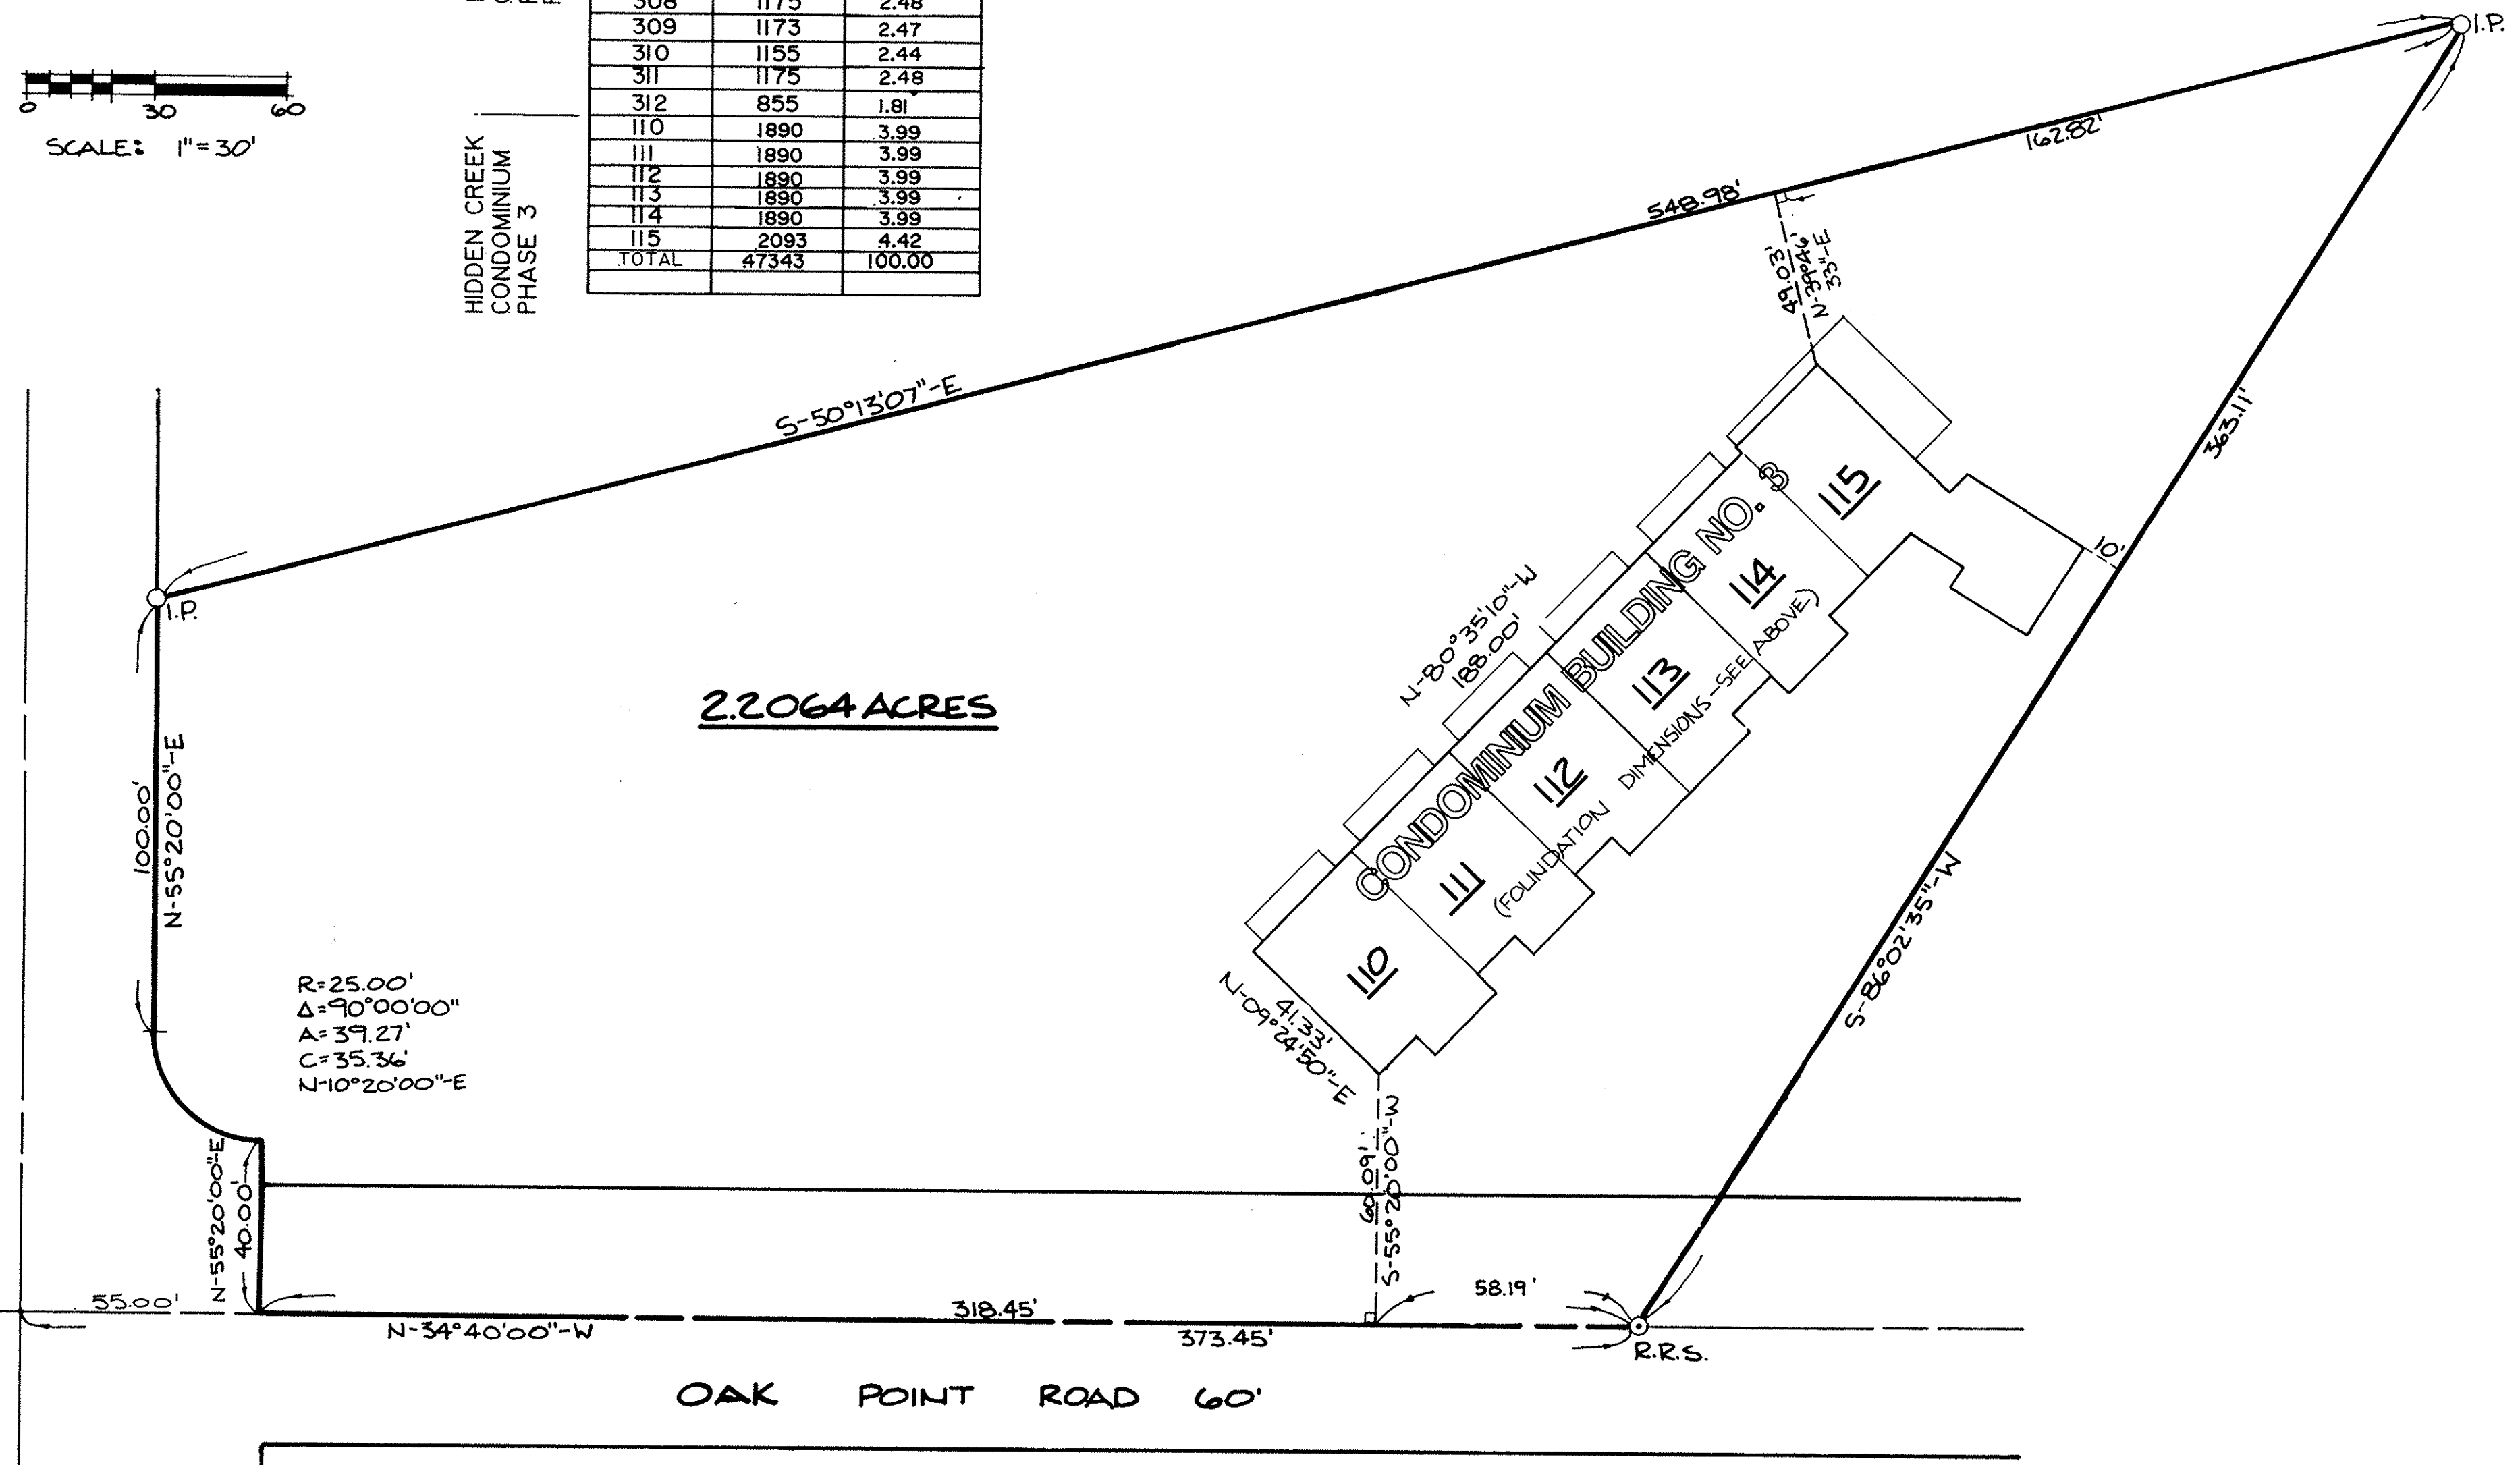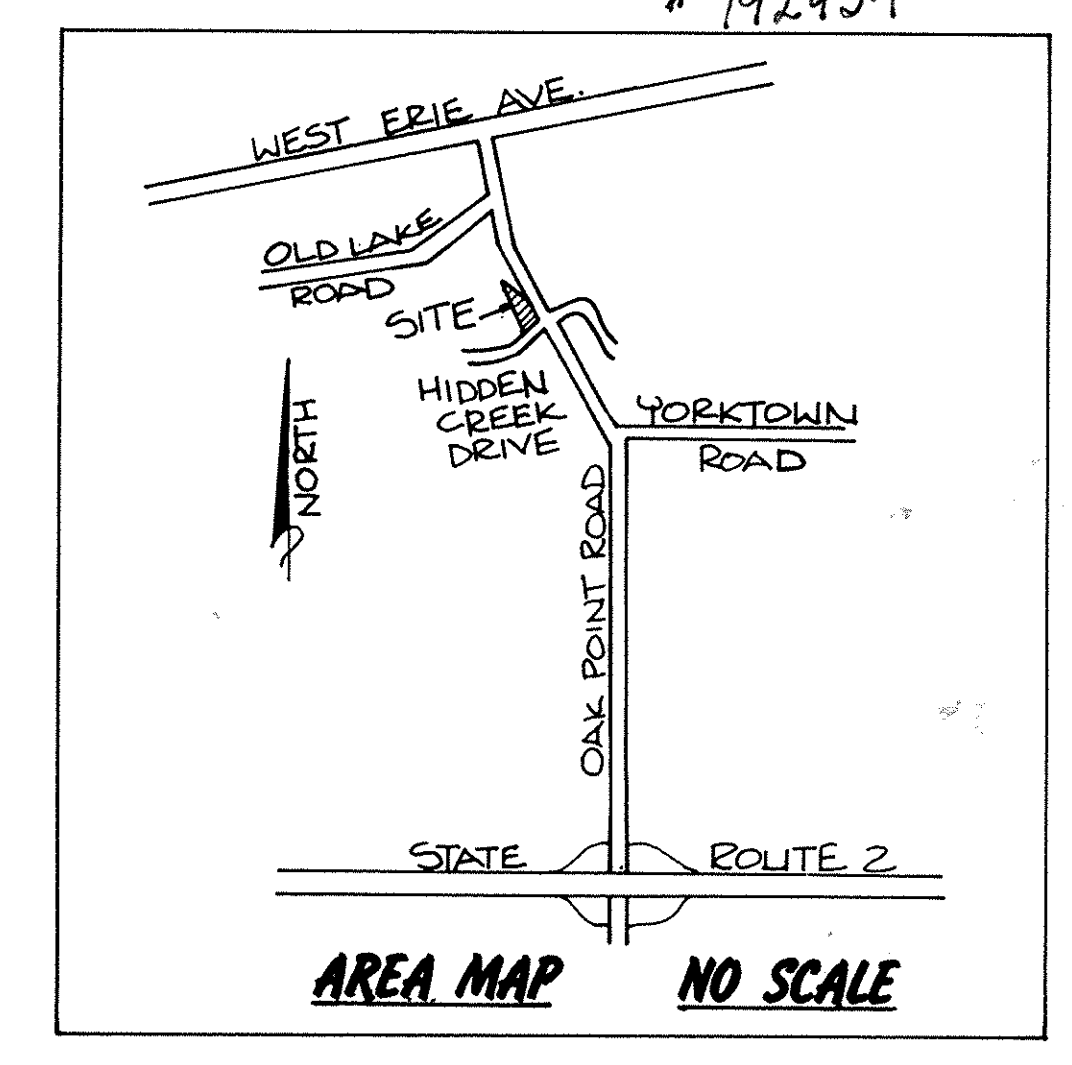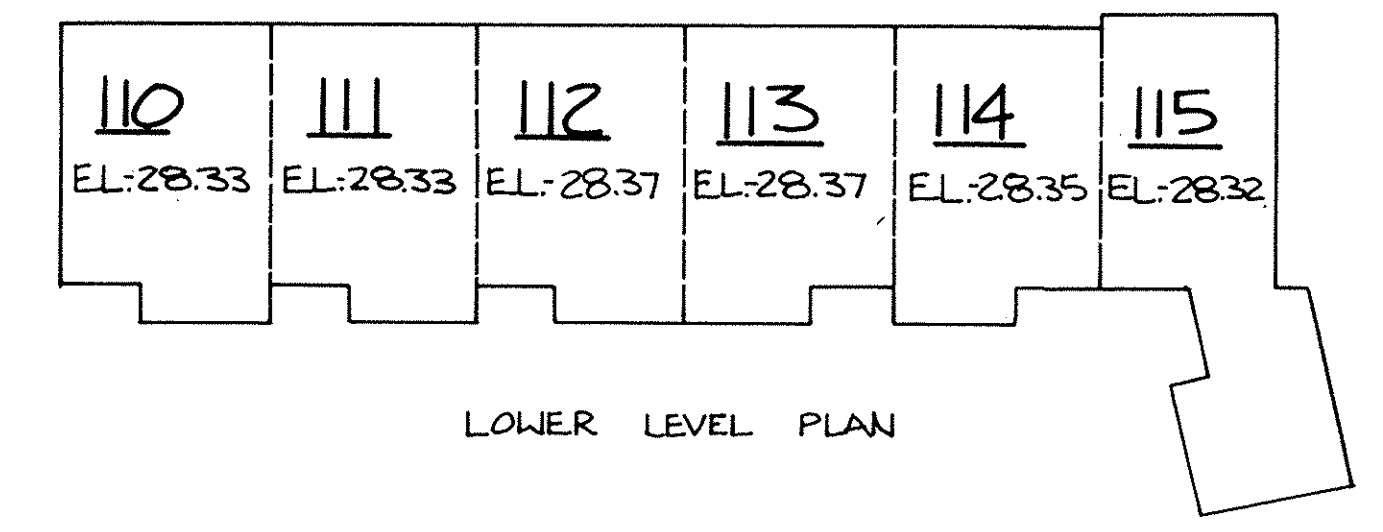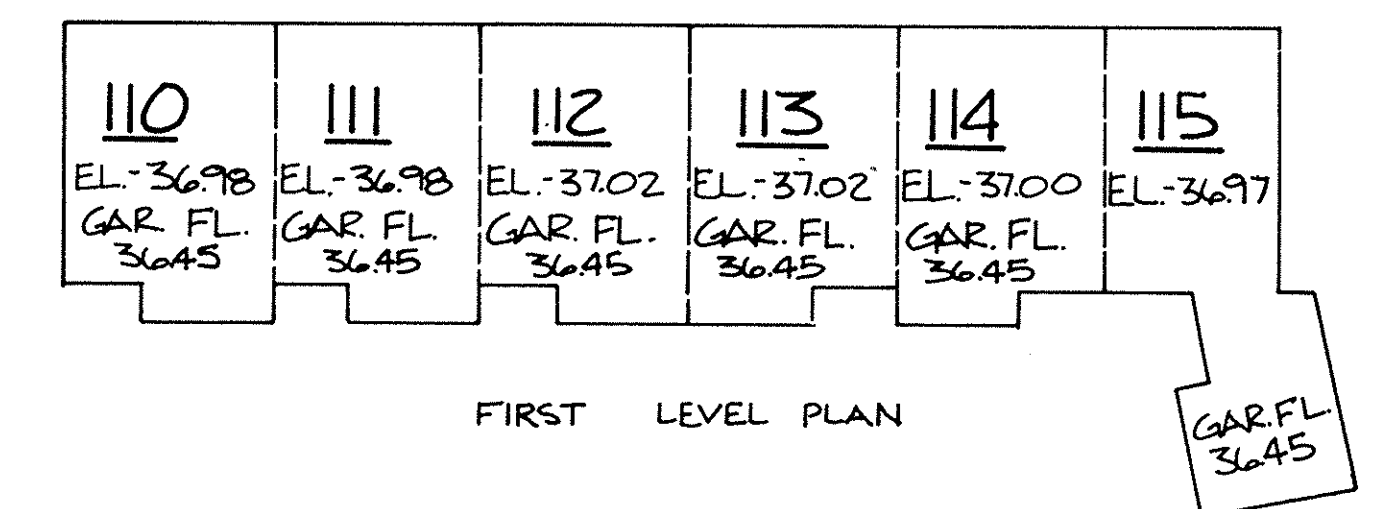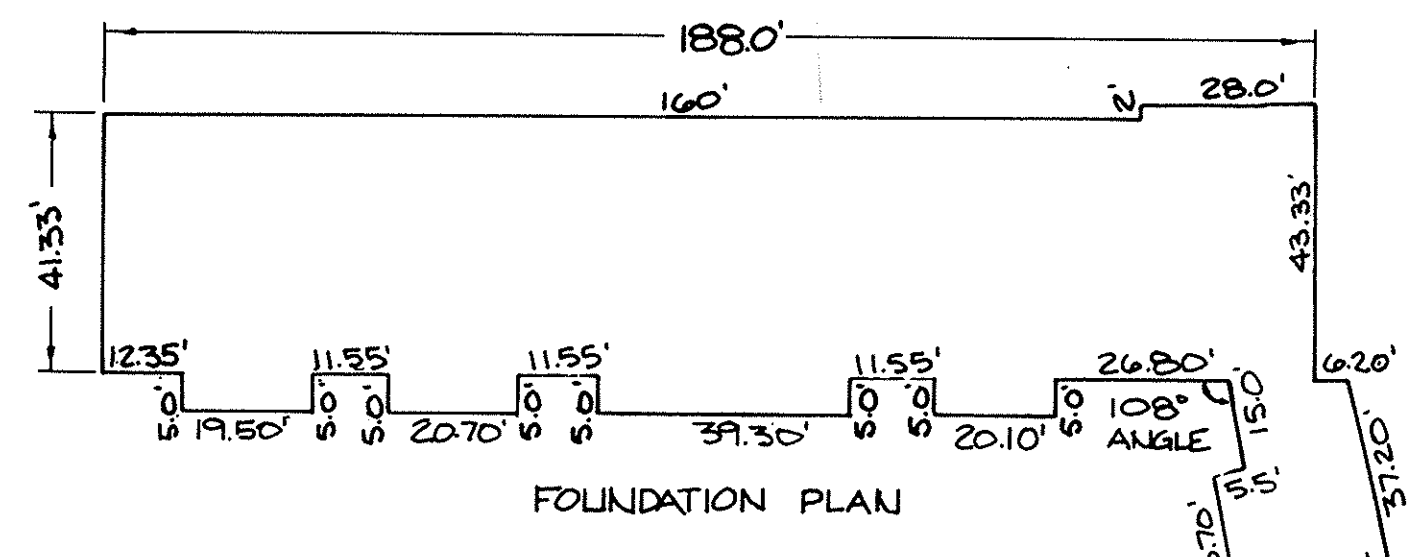


CERTIFICATION:
THIS IS TO CERTIFY THAT THE ATTACHED DRAWINGS CORRECTLY REPRESENT THE BUILDINGS AS CONSTRUCTED AND THAT THERE ARE NO ENCHROACHMENTS ON ADJUTING PROPERTIES.

David L. Elwell
DAVID L. ELWELL
REG. SURV. NO. 6333

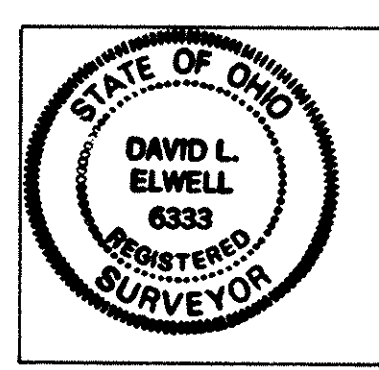

Mark Skelleneger
MARK SKELLENGER
REG. ENGINEER NO. 46461

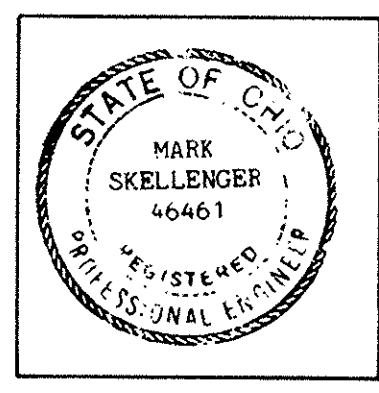

Received for Record AUG 13 1992
at 3:44 P.M. in P. 211 RECORDED
VOL. 49 DOROTHY L. ESSEX
PAGE 56- Lorain County Recorder
60 INCL
Box L.C.T.E. sm Deal 36.00
216.00

LORAIN COUNTY RECORDER

TRANSFERRED
IN COMPLIANCE WITH S.C.O. 219-222
OHIO REV. CODE
AUG 13 1992
JULIAN A. PUOR
LORAIN COUNTY AUDITOR

LORAIN COUNTY AUDITOR

SHEET INDEX	
SHEET NO.	DESCRIPTION
1	SURVEY MAP & MISC.
2	OVERALL BUILDING PLAN
3	FLOOR PLAN(UNITS 110-114)
4	FLOOR PLAN(UNIT 115)
5	EXTERIOR ELEVATIONS


HIDDEN CREEK CONDOMINIUMS PHASE 3
OF PART OF
BLACK RIVER TOWNSHIP ORIGINAL LOT 4 TRACT 3
CITY OF LORAIN COUNTY OF LORAIN STATE OF OHIO

LORAIN COUNTY TAX
MAP DEPARTMENT COPY




#192434

#192434

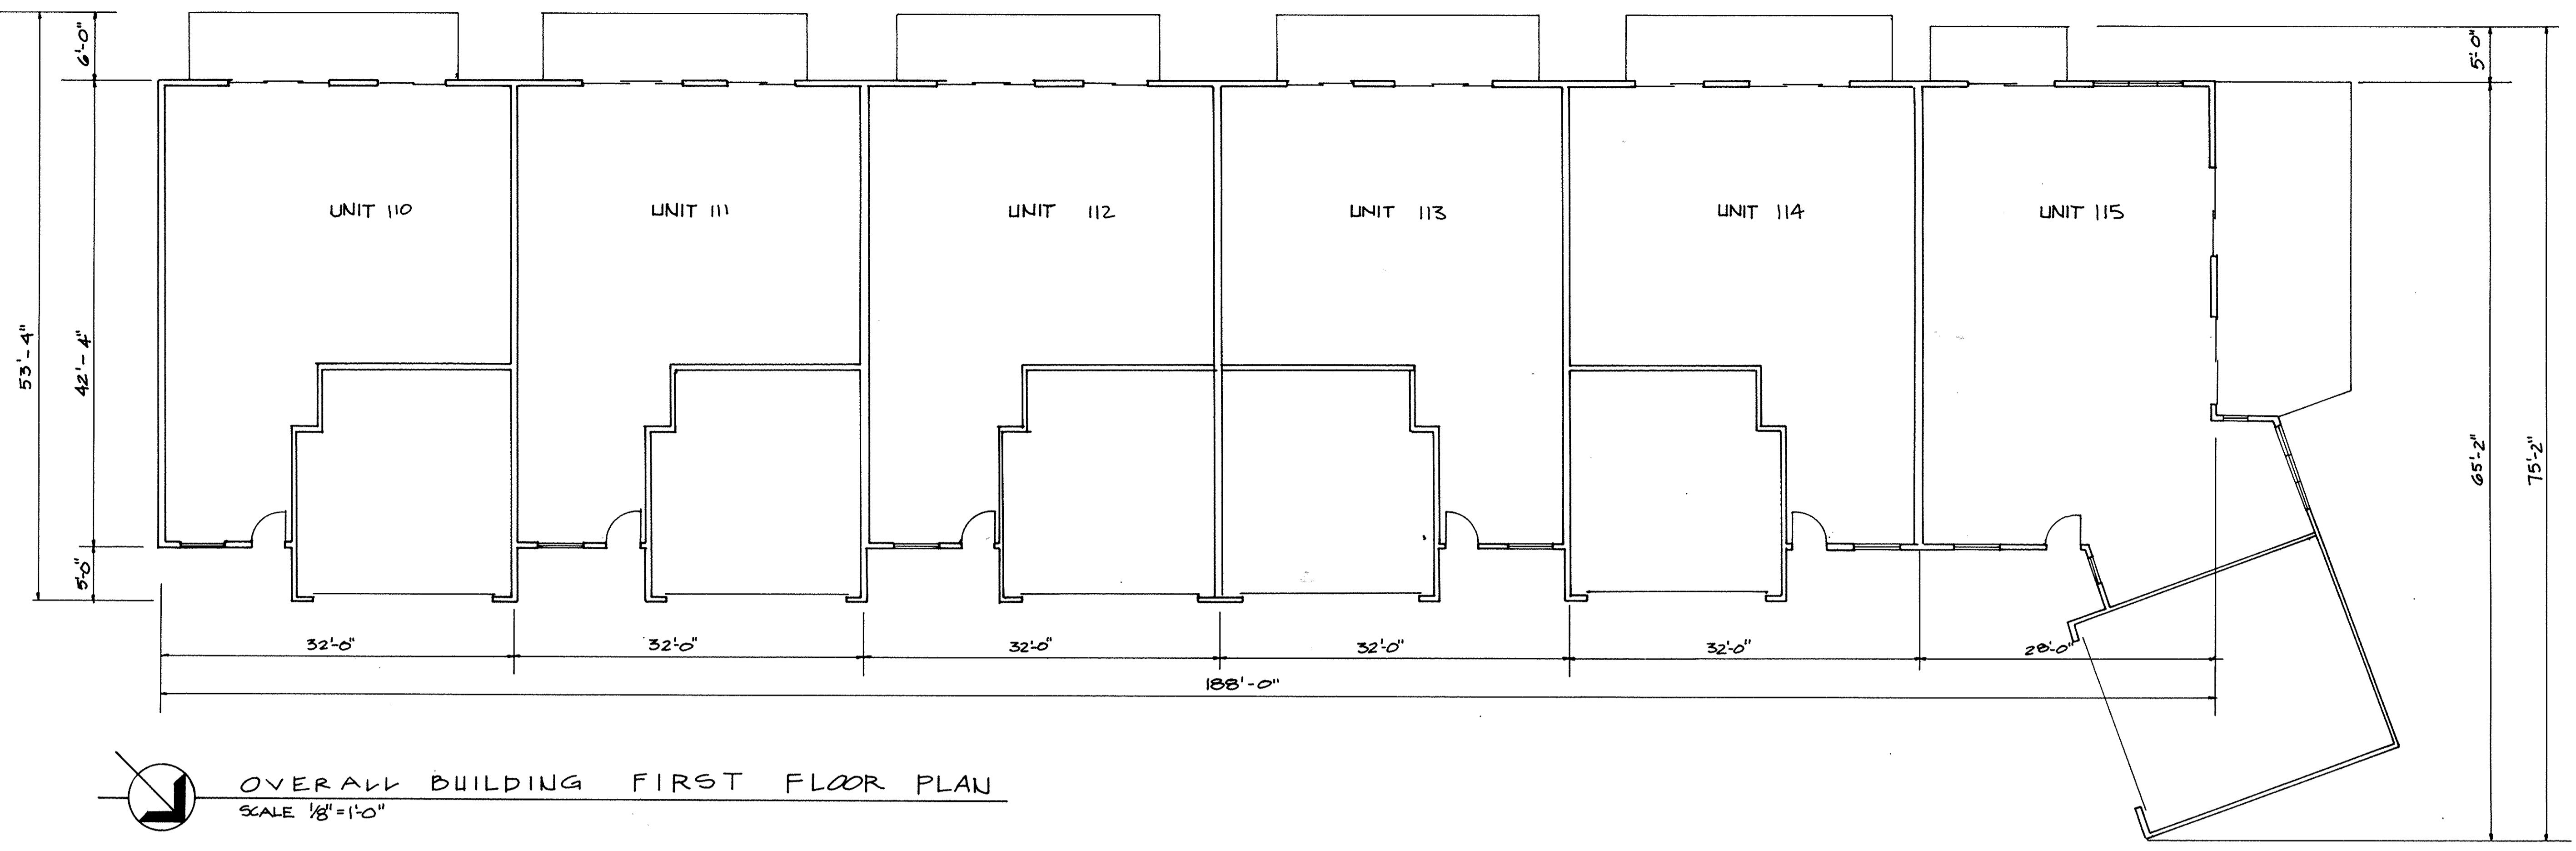

OVERALL BUILDING FIRST FLOOR PLAN
SCALE 1/8"=1'-0"

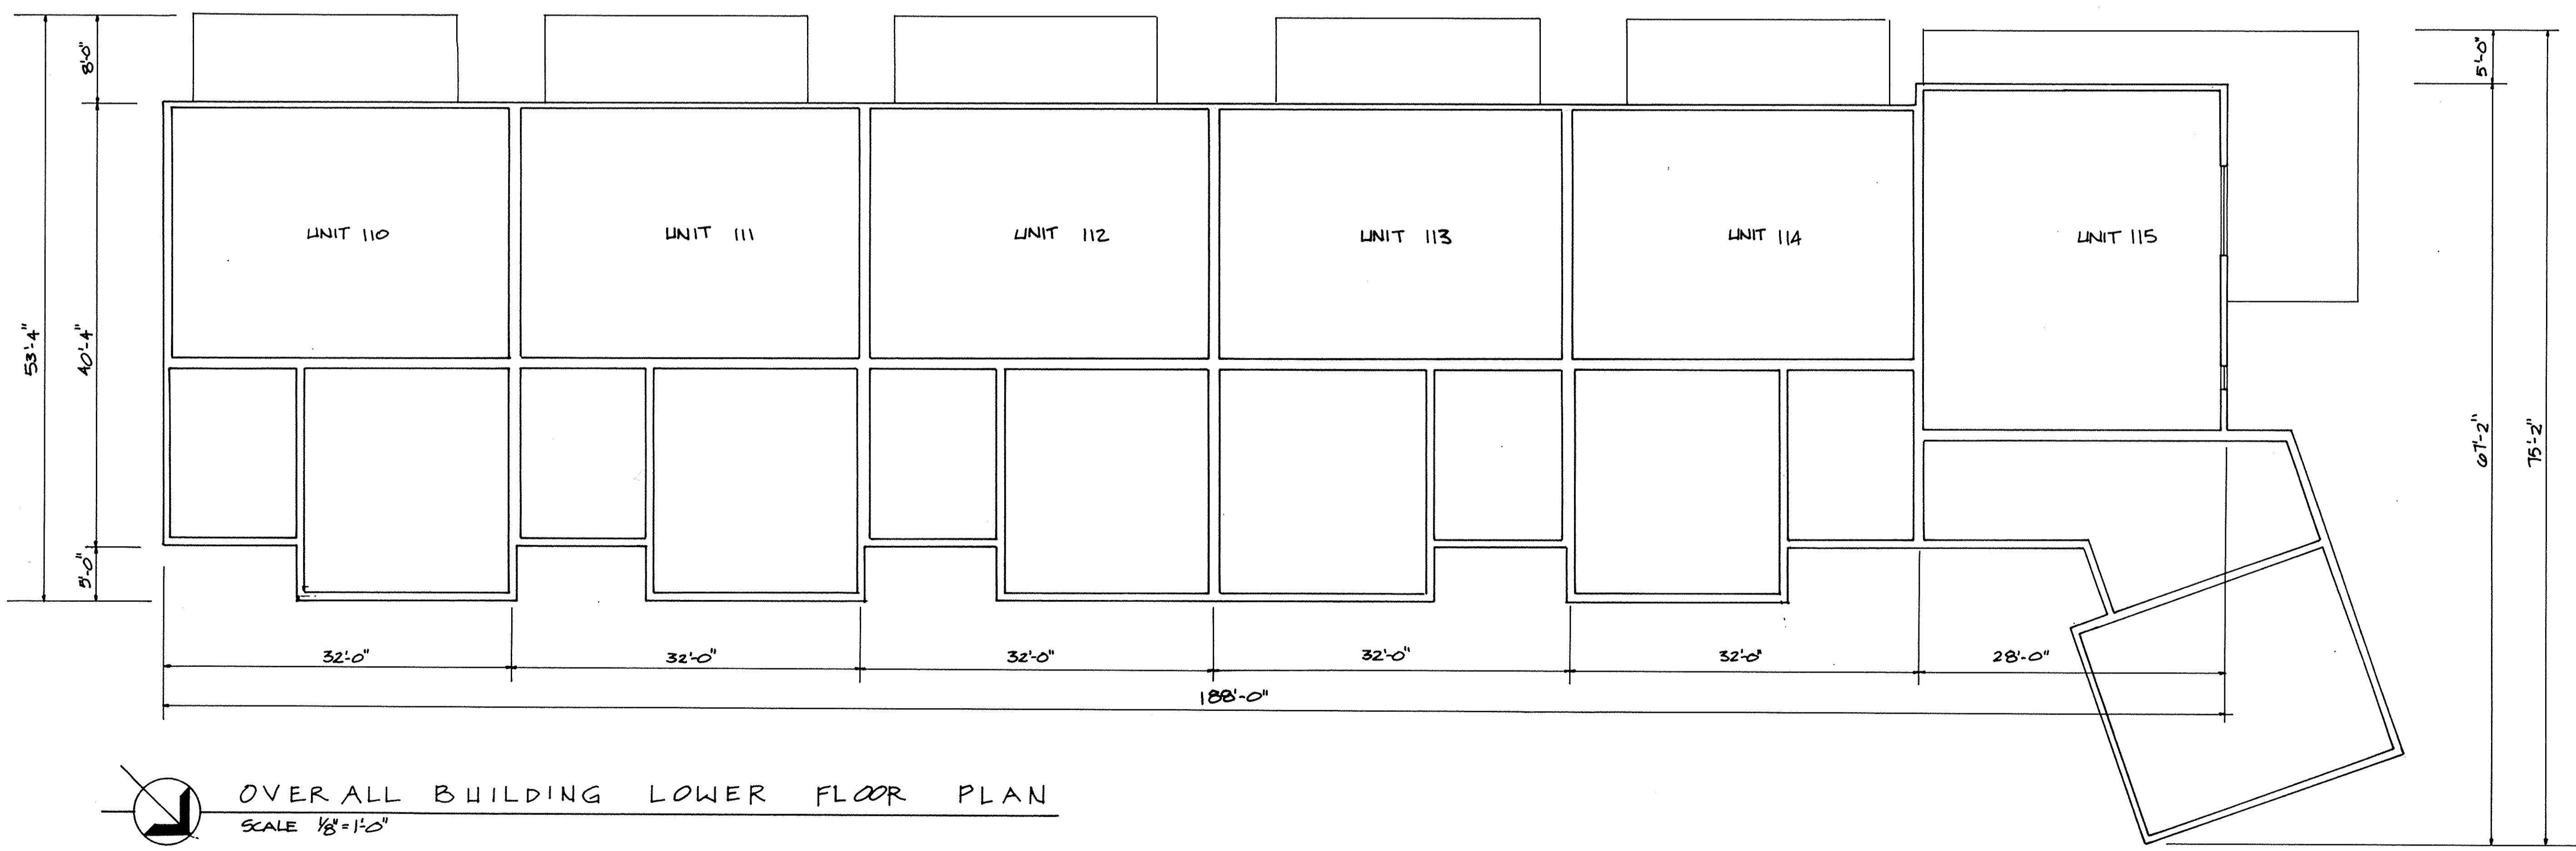

OVER ALL BUILDING LOWER FLOOR PLAN
SCALE 1/8"=1'-0"


HIDDEN CREEK CONDOMINIUMS PHASE 3
OVERALL BUILDING PLAN

LORAIN COUNTY TAX
MAP DEPARTMENT COPY


2/5

#192434

#192434

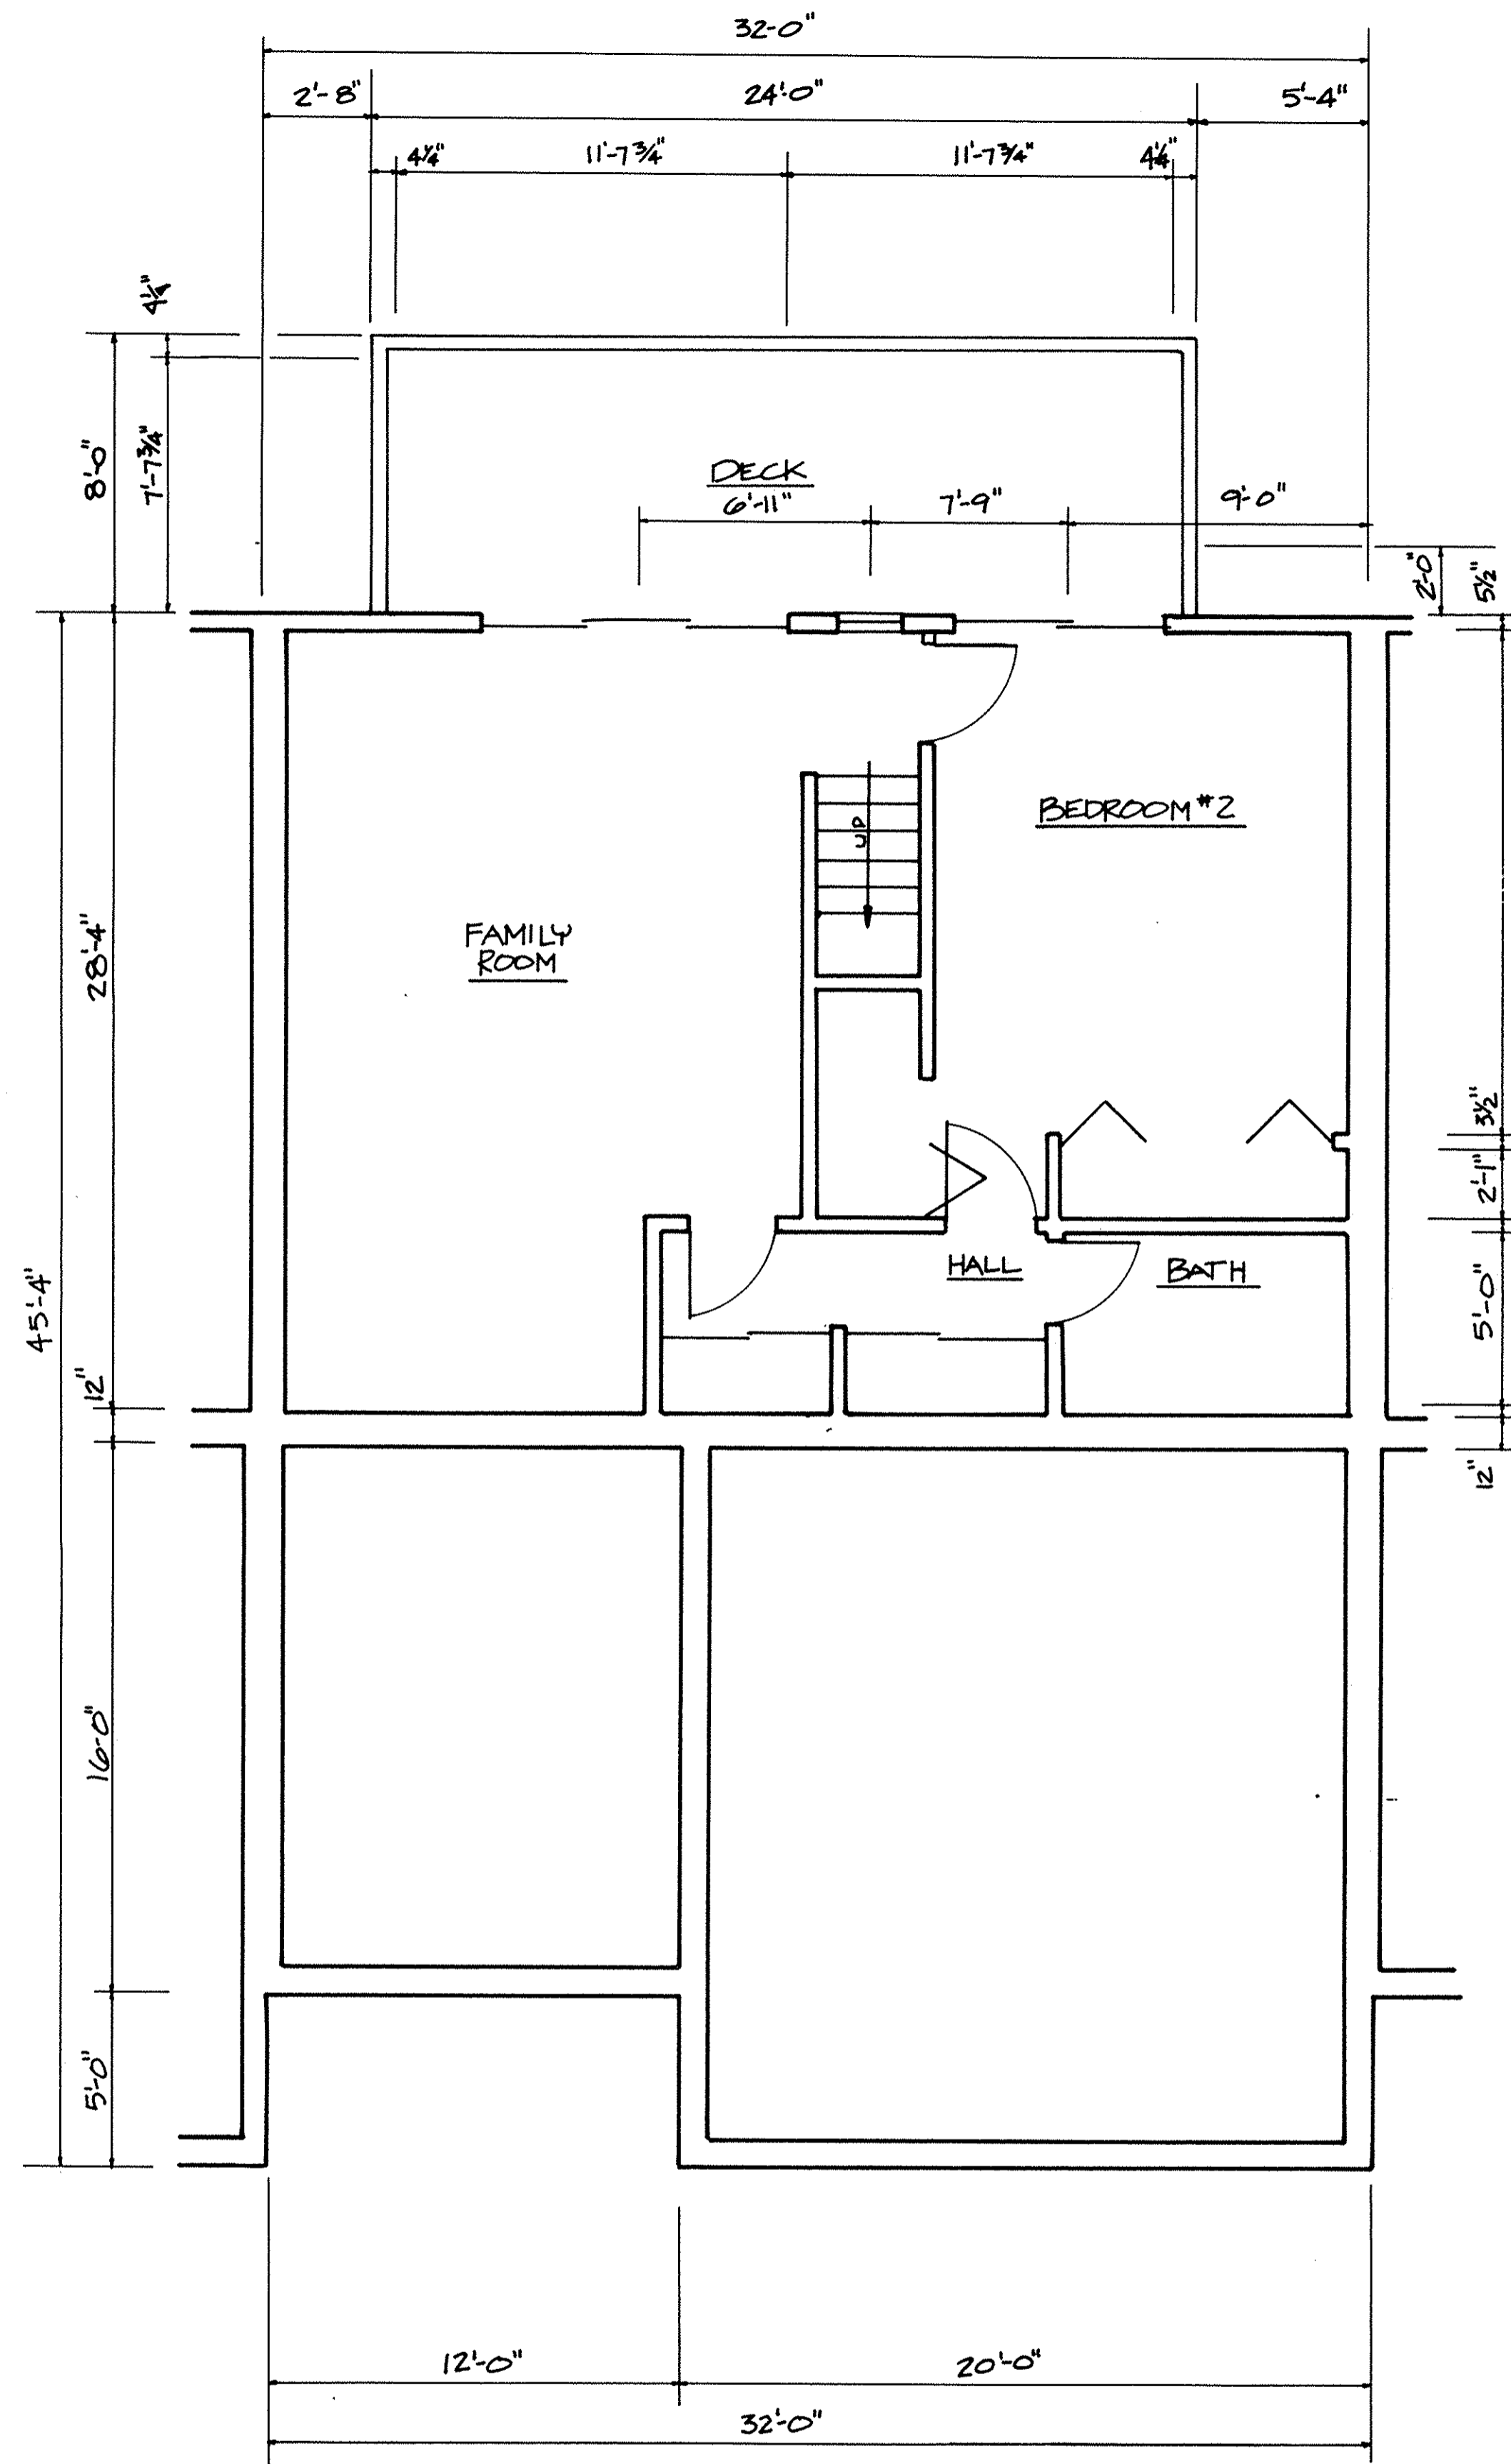

UNITS #110 THRU #114
 LOWER FLOOR PLAN
 SCALE 1/4"=1'-0"

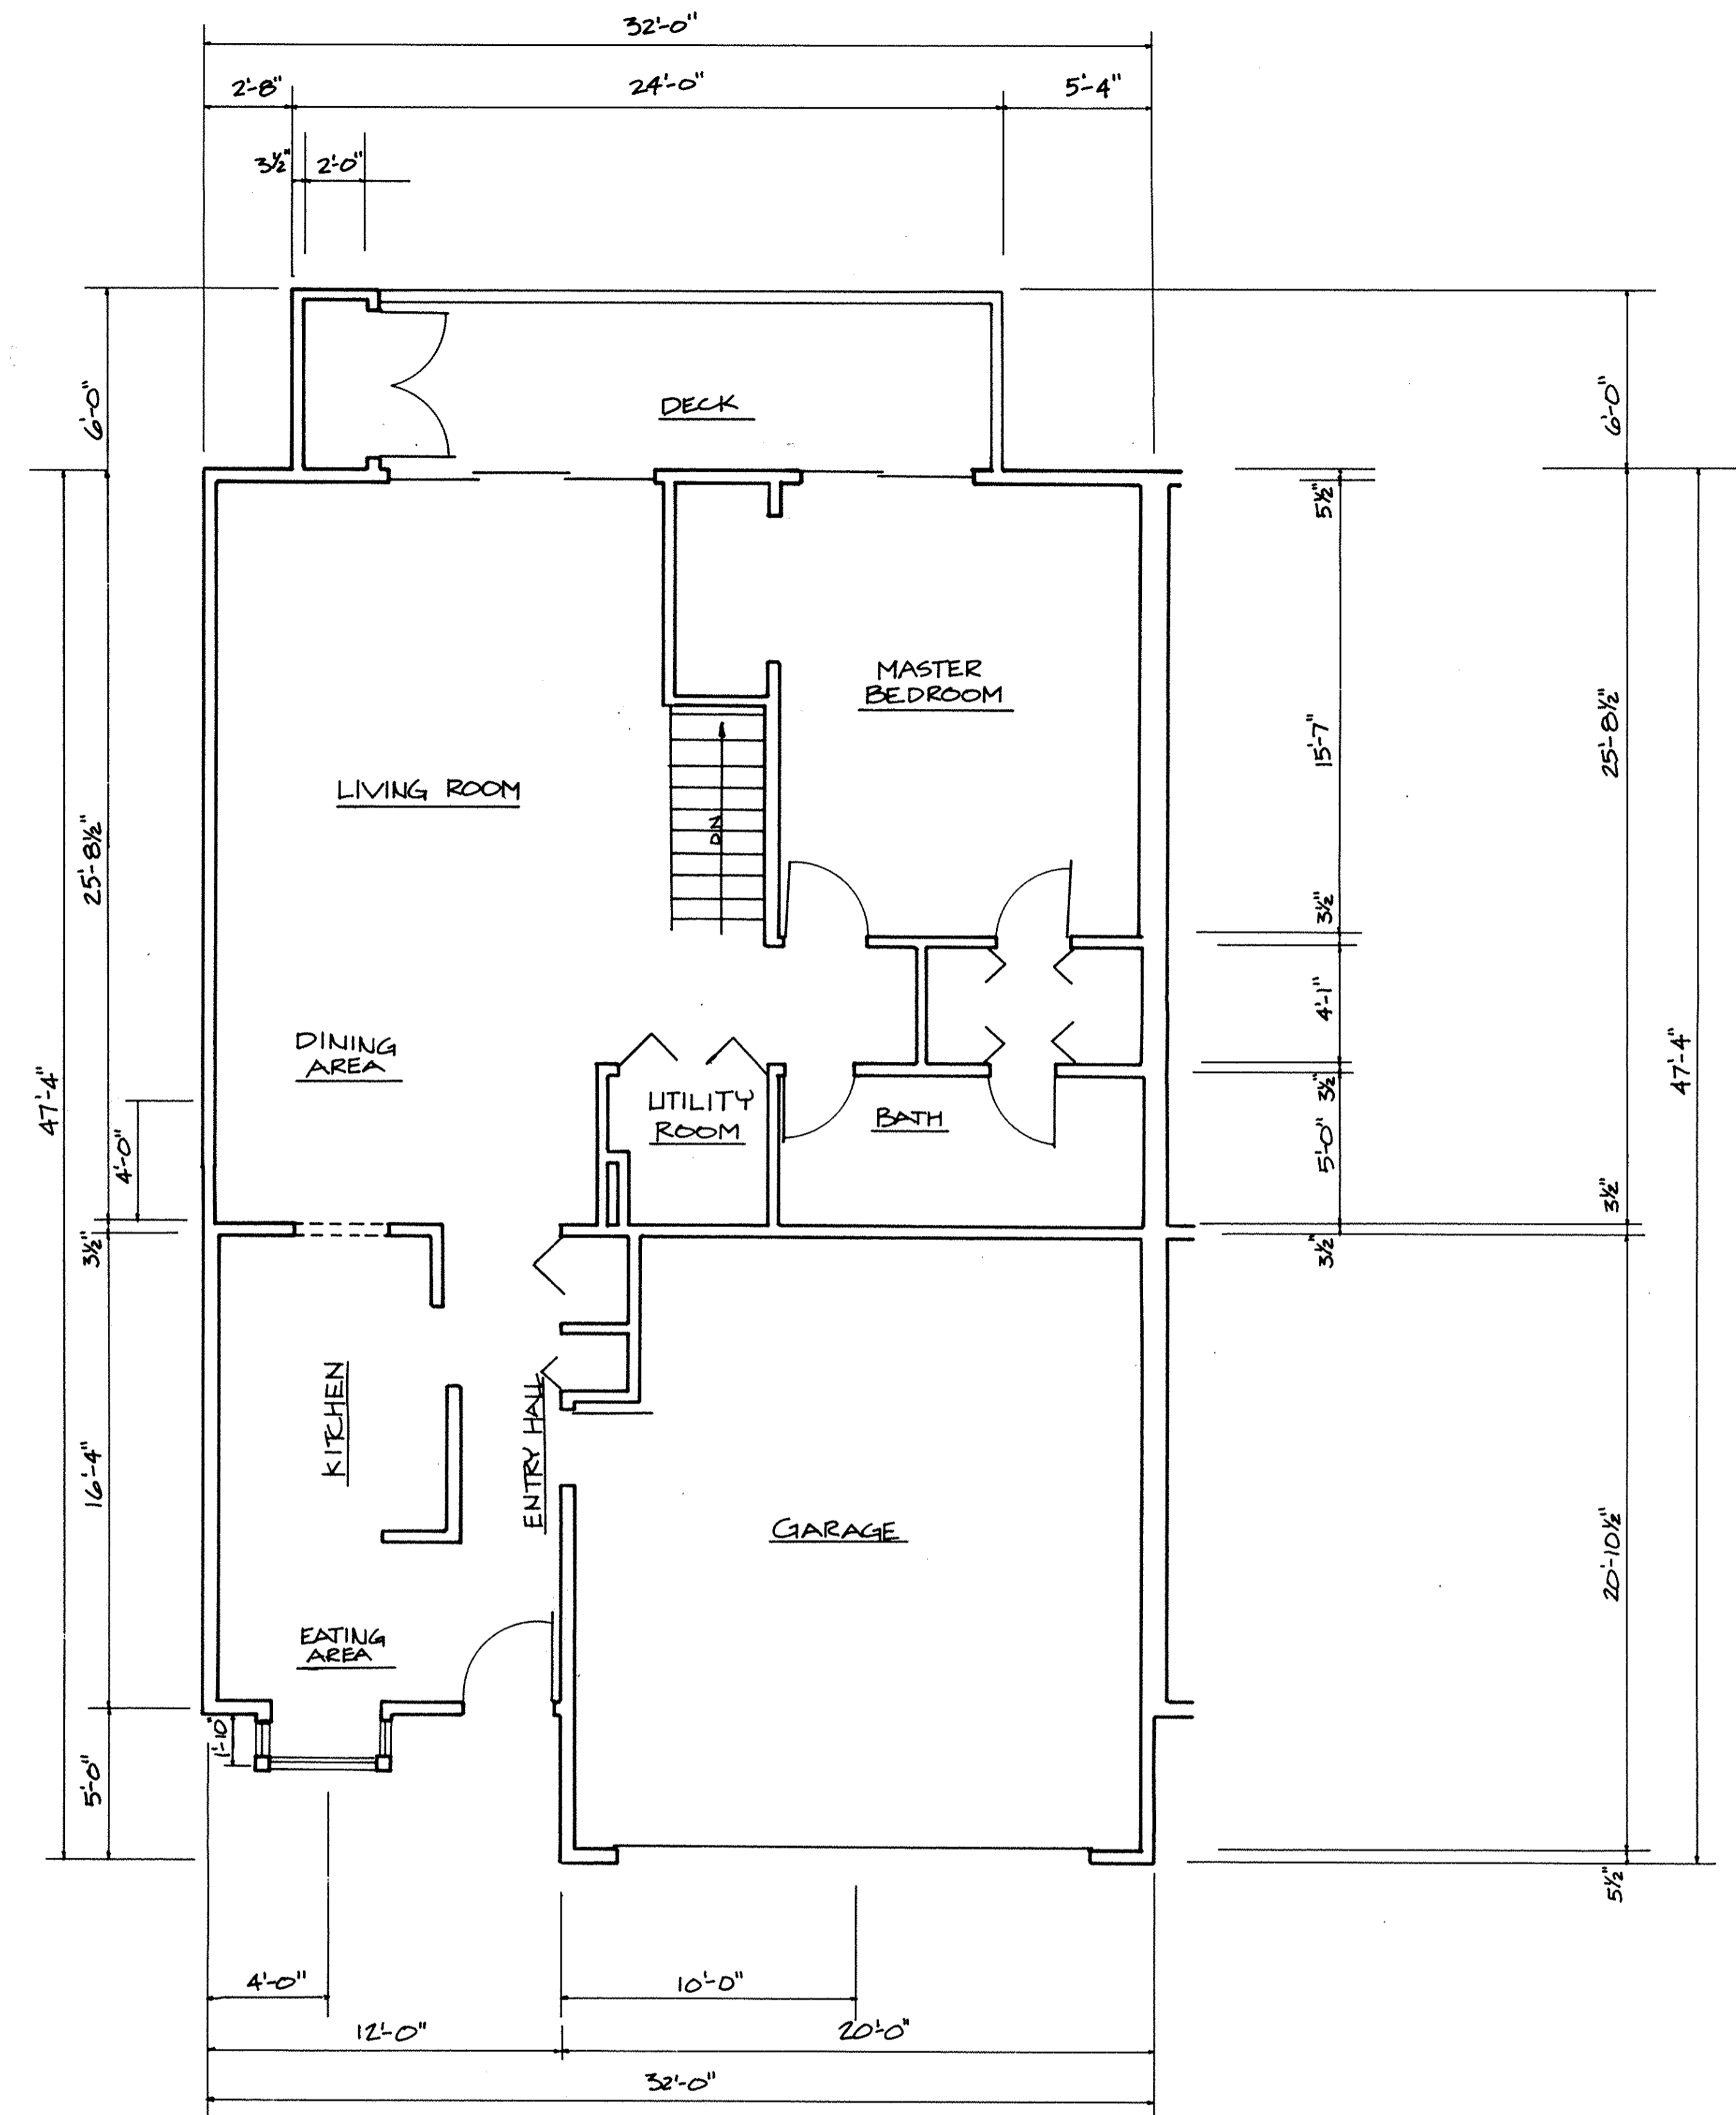


UNITS #110 THRU #114
 FIRST FLOOR PLAN
 SCALE 1/4"=1'-0"

HIDDEN CREEK CONDOMINIUMS PHASE 3
 FLOOR PLANS - UNITS 110 THRU 114


LORAIN COUNTY TAX
 MAP DEPARTMENT COPY

#192434

#192434

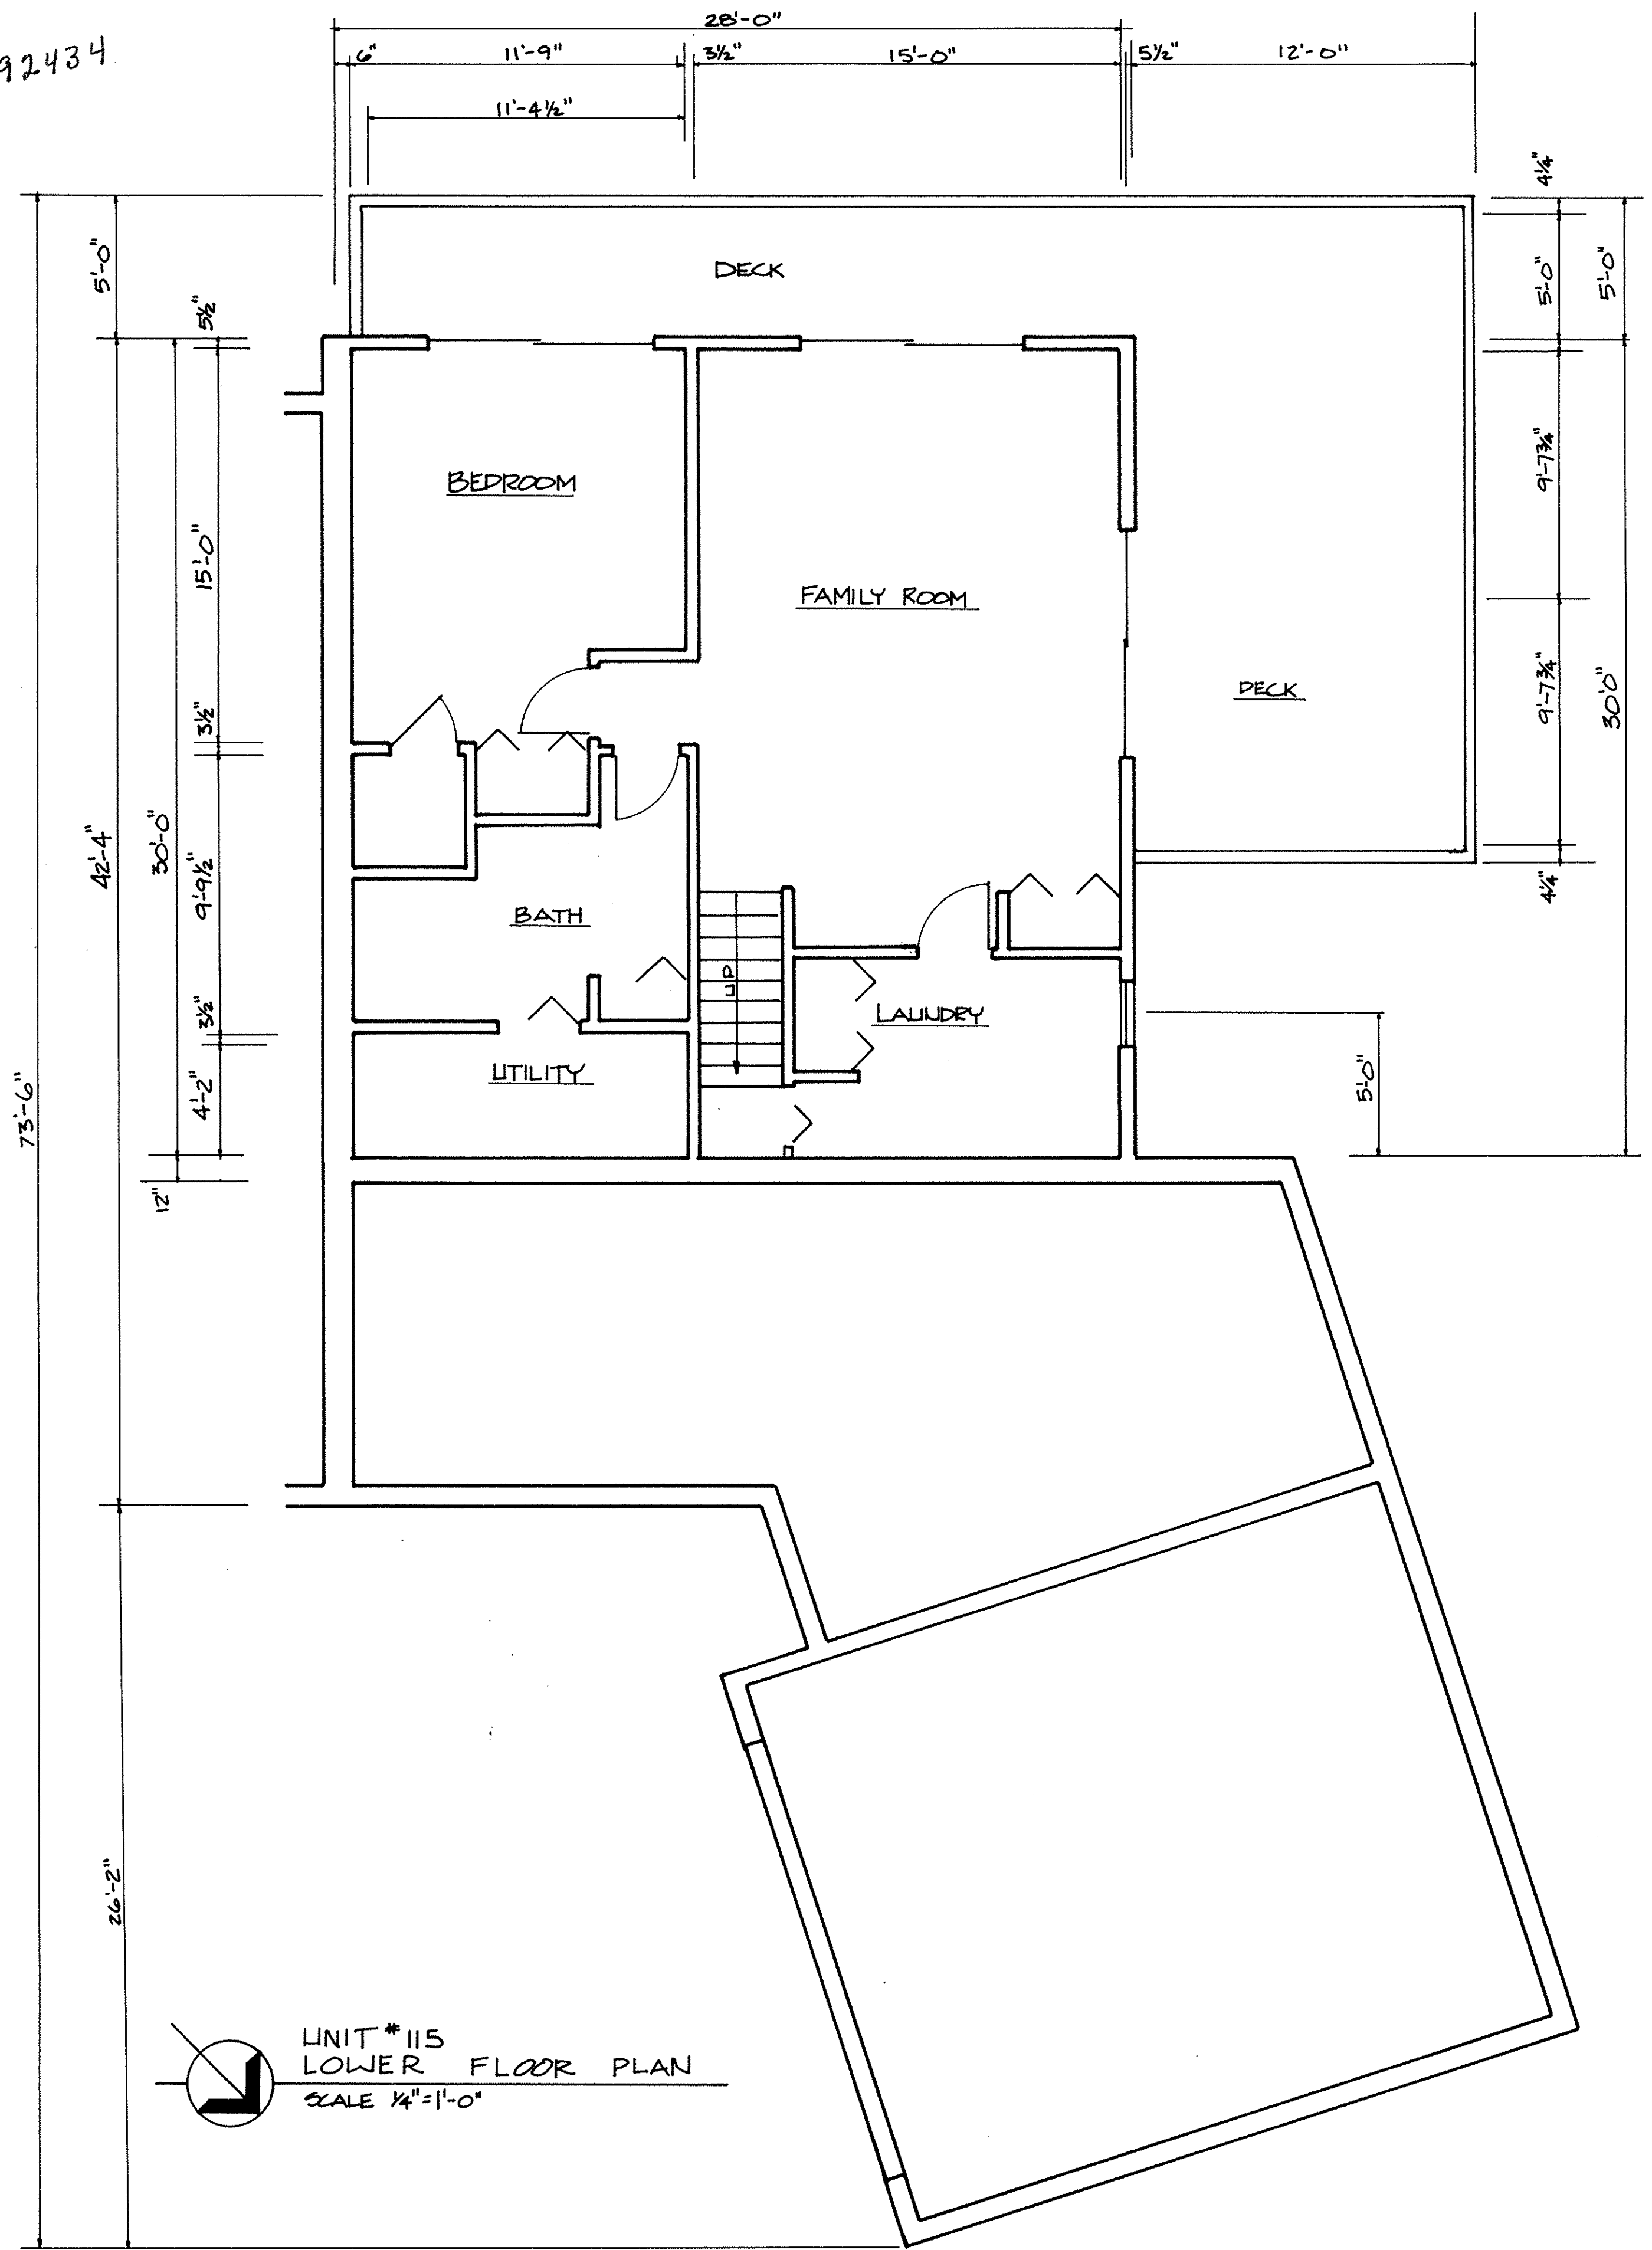

UNIT #115
LOWER FLOOR PLAN
SCALE 1/4"=1'-0"

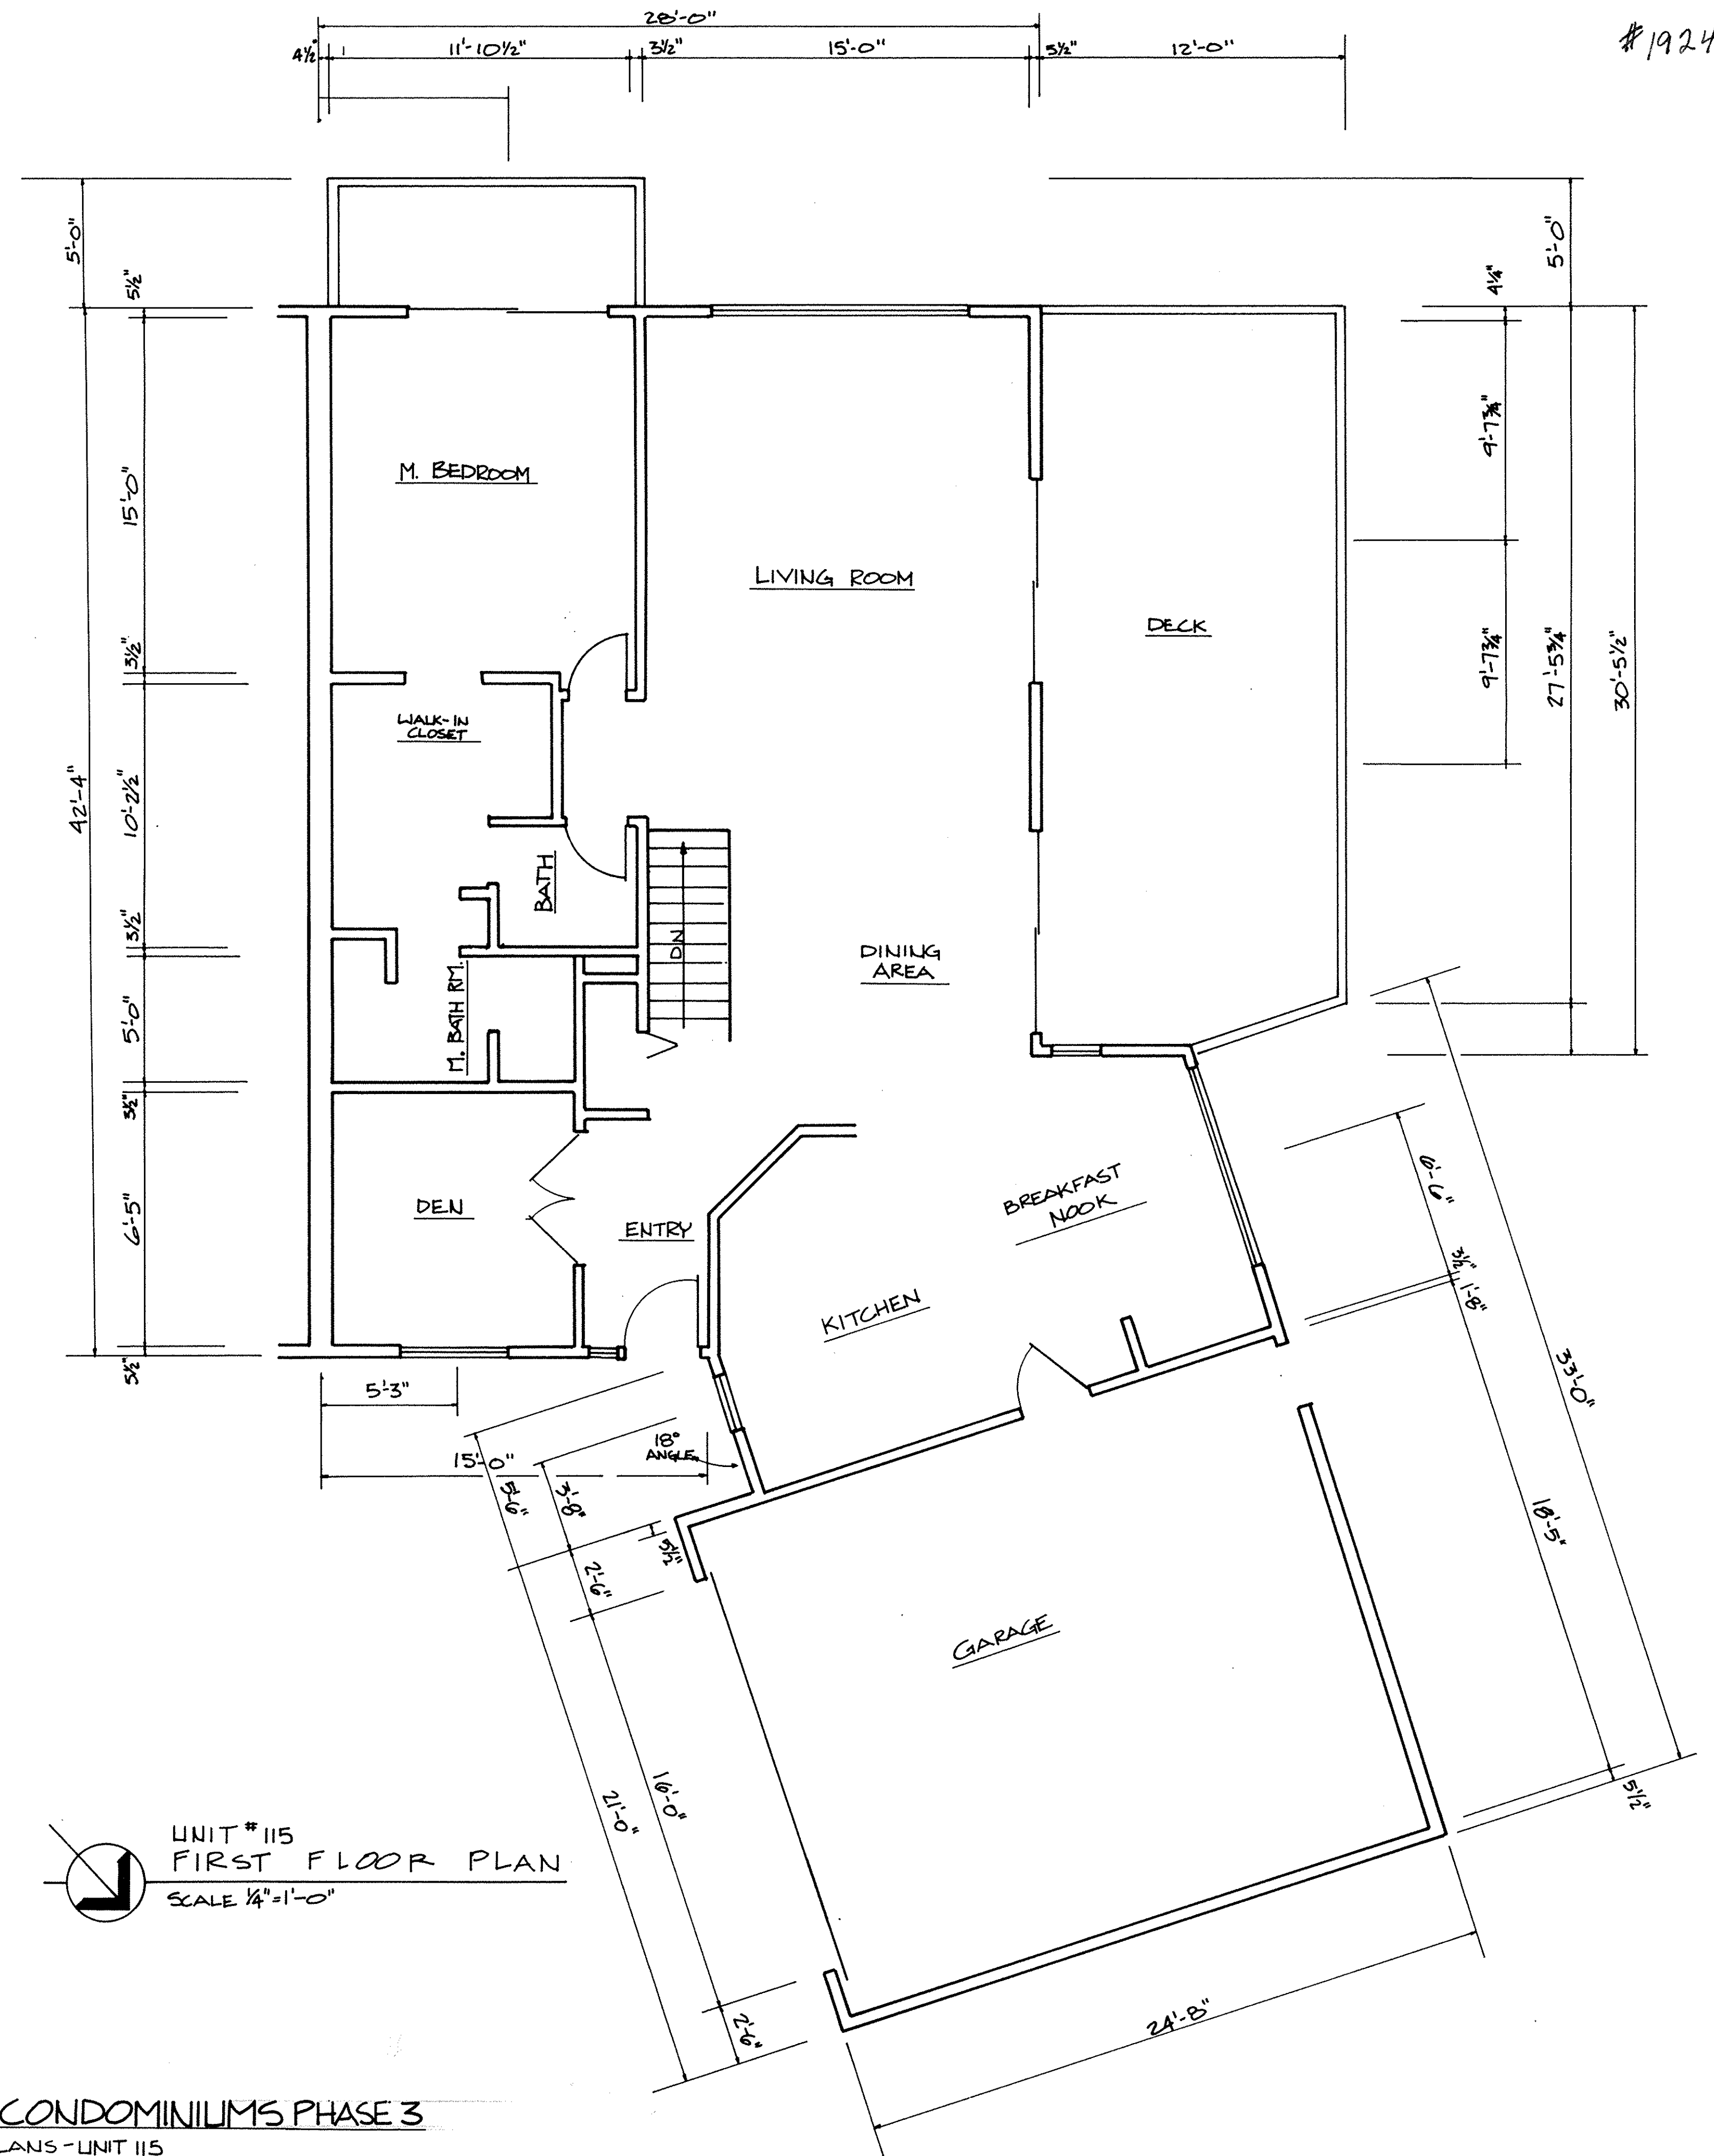


UNIT #115
FIRST FLOOR PLAN
SCALE 1/4"=1'-0"

HIDDEN CREEK CONDOMINIUMS PHASE 3
FLOOR PLANS - UNIT 115

LORAIN COUNTY TAX
MAP DEPARTMENT COPY


#192434

#192434

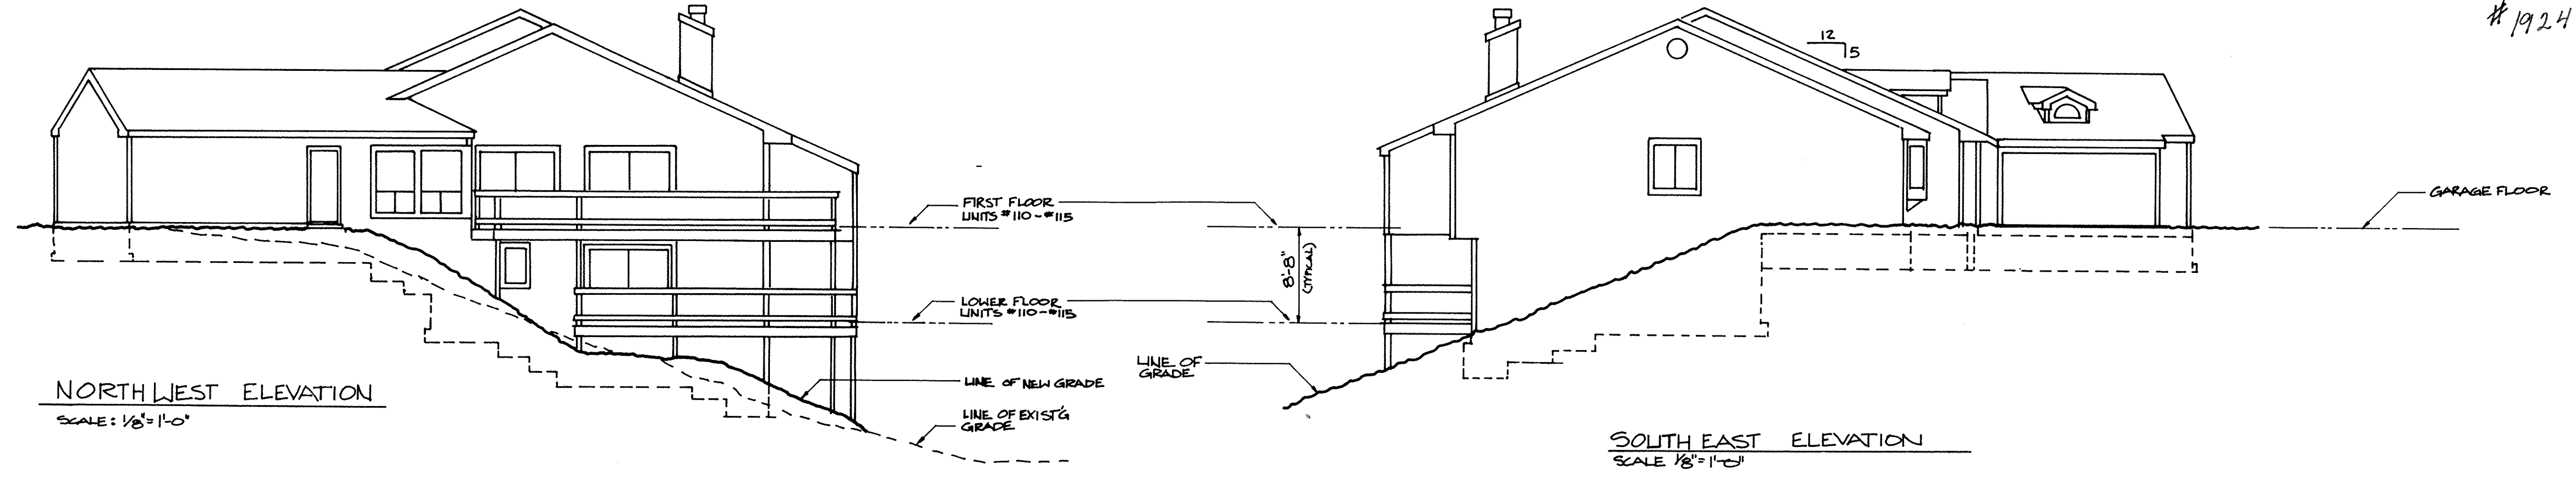


NORTH WEST ELEVATION
SCALE: 1/8" = 1'-0"

SOUTH EAST ELEVATION
SCALE 1/8" = 1'-0"

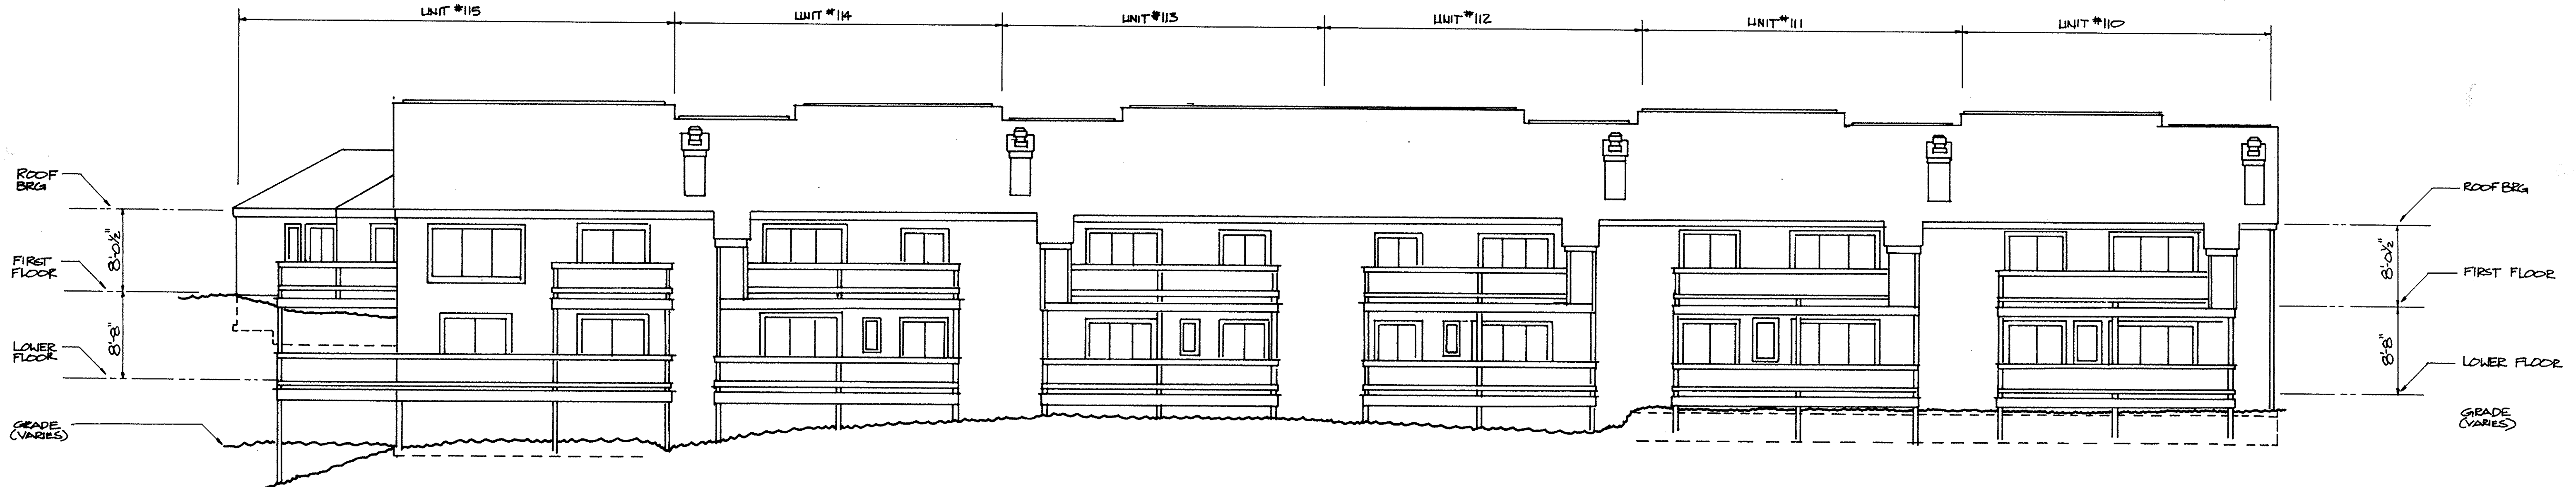

NORTHEAST ELEVATION
SCALE 1/8" = 1'-0"

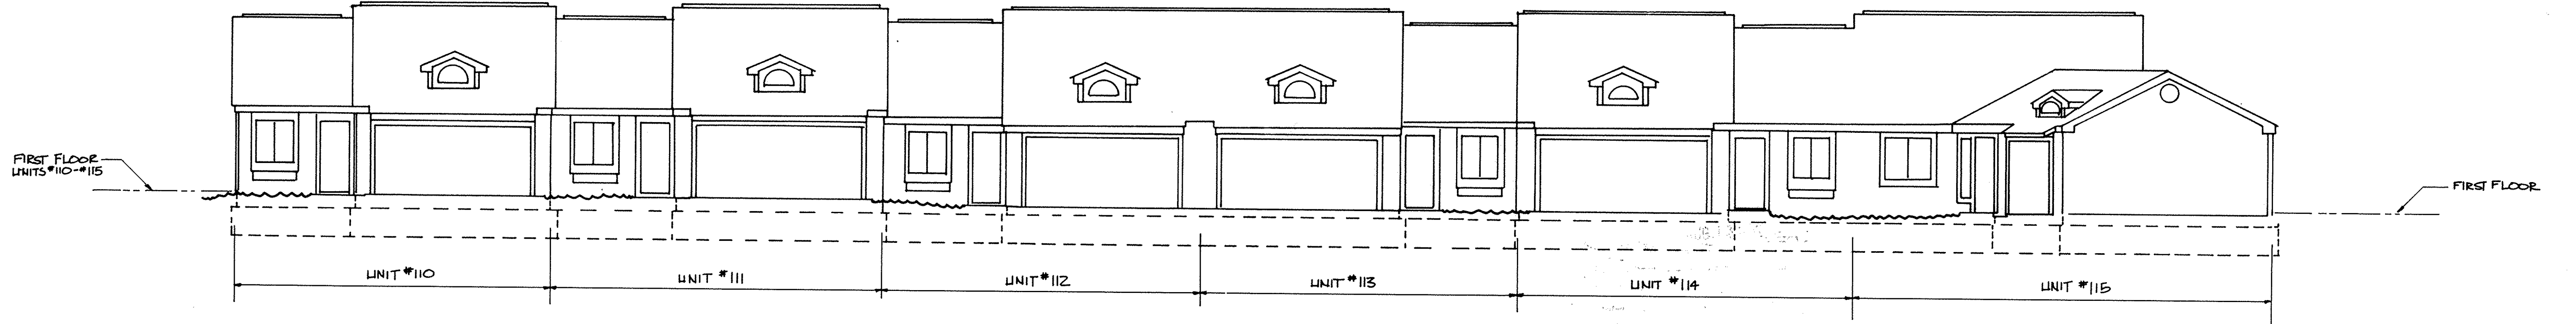

SOUTH WEST ELEVATION
SCALE 1/8" = 1'-0"

HIDDEN CREEK CONDOMINIUMS PHASE 3
EXTERIOR ELEVATIONS

LORAIN COUNTY TAX
MAP DEPARTMENT COPY

5/5