




209270

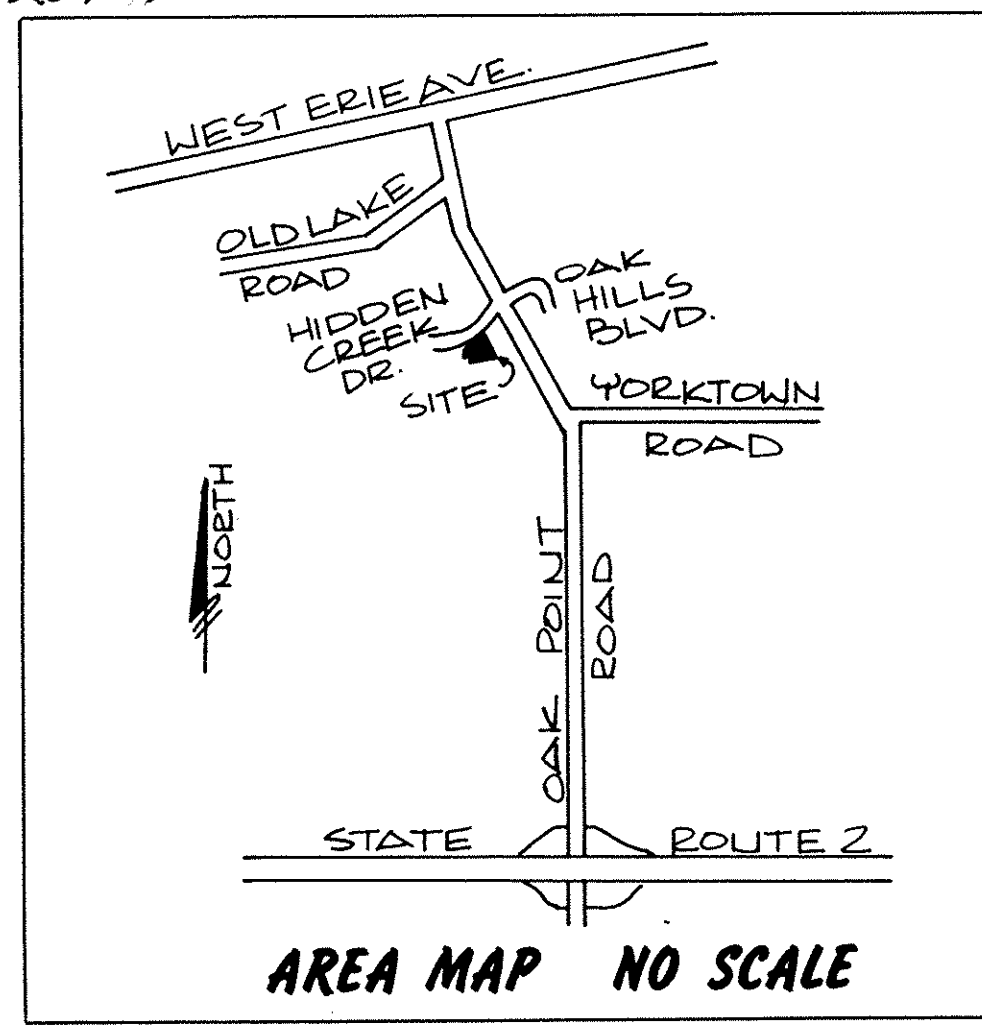


AREA MAP NO SCALE

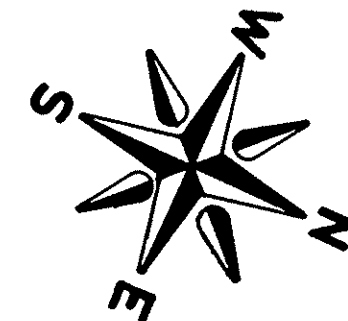


SCALE: 1" = 30'

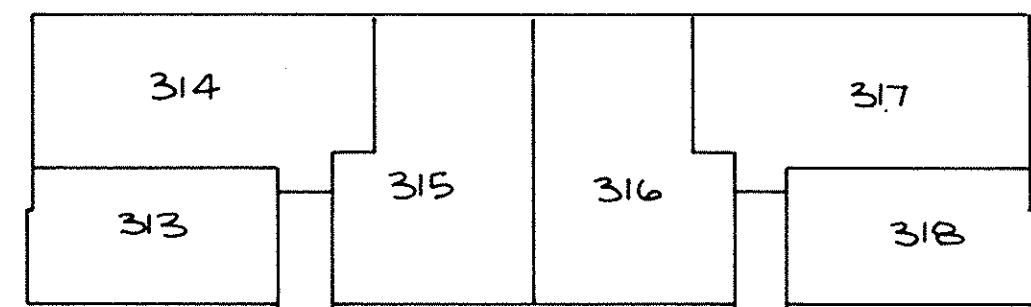


THIRD LEVEL PLAN ELEV. 41.21

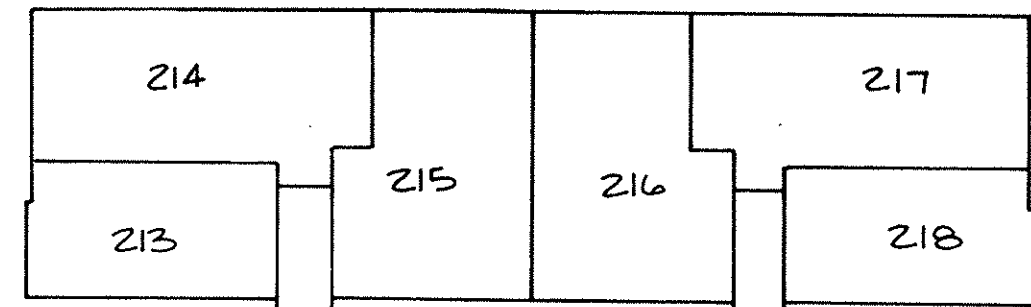


SECOND LEVEL PLAN ELEV. 32.54

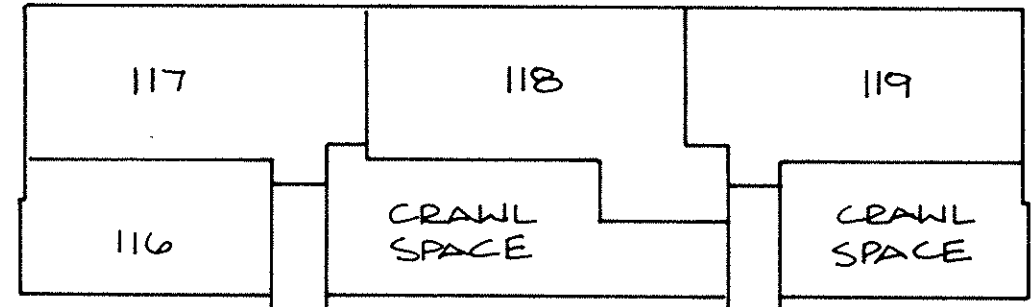

FIRST LEVEL PLAN ELEV. 23.87

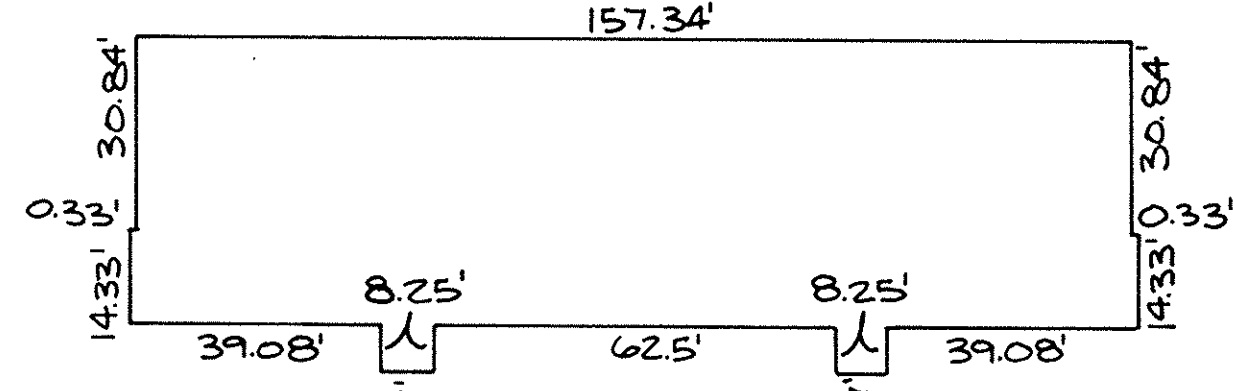

FOUNDATION PLAN

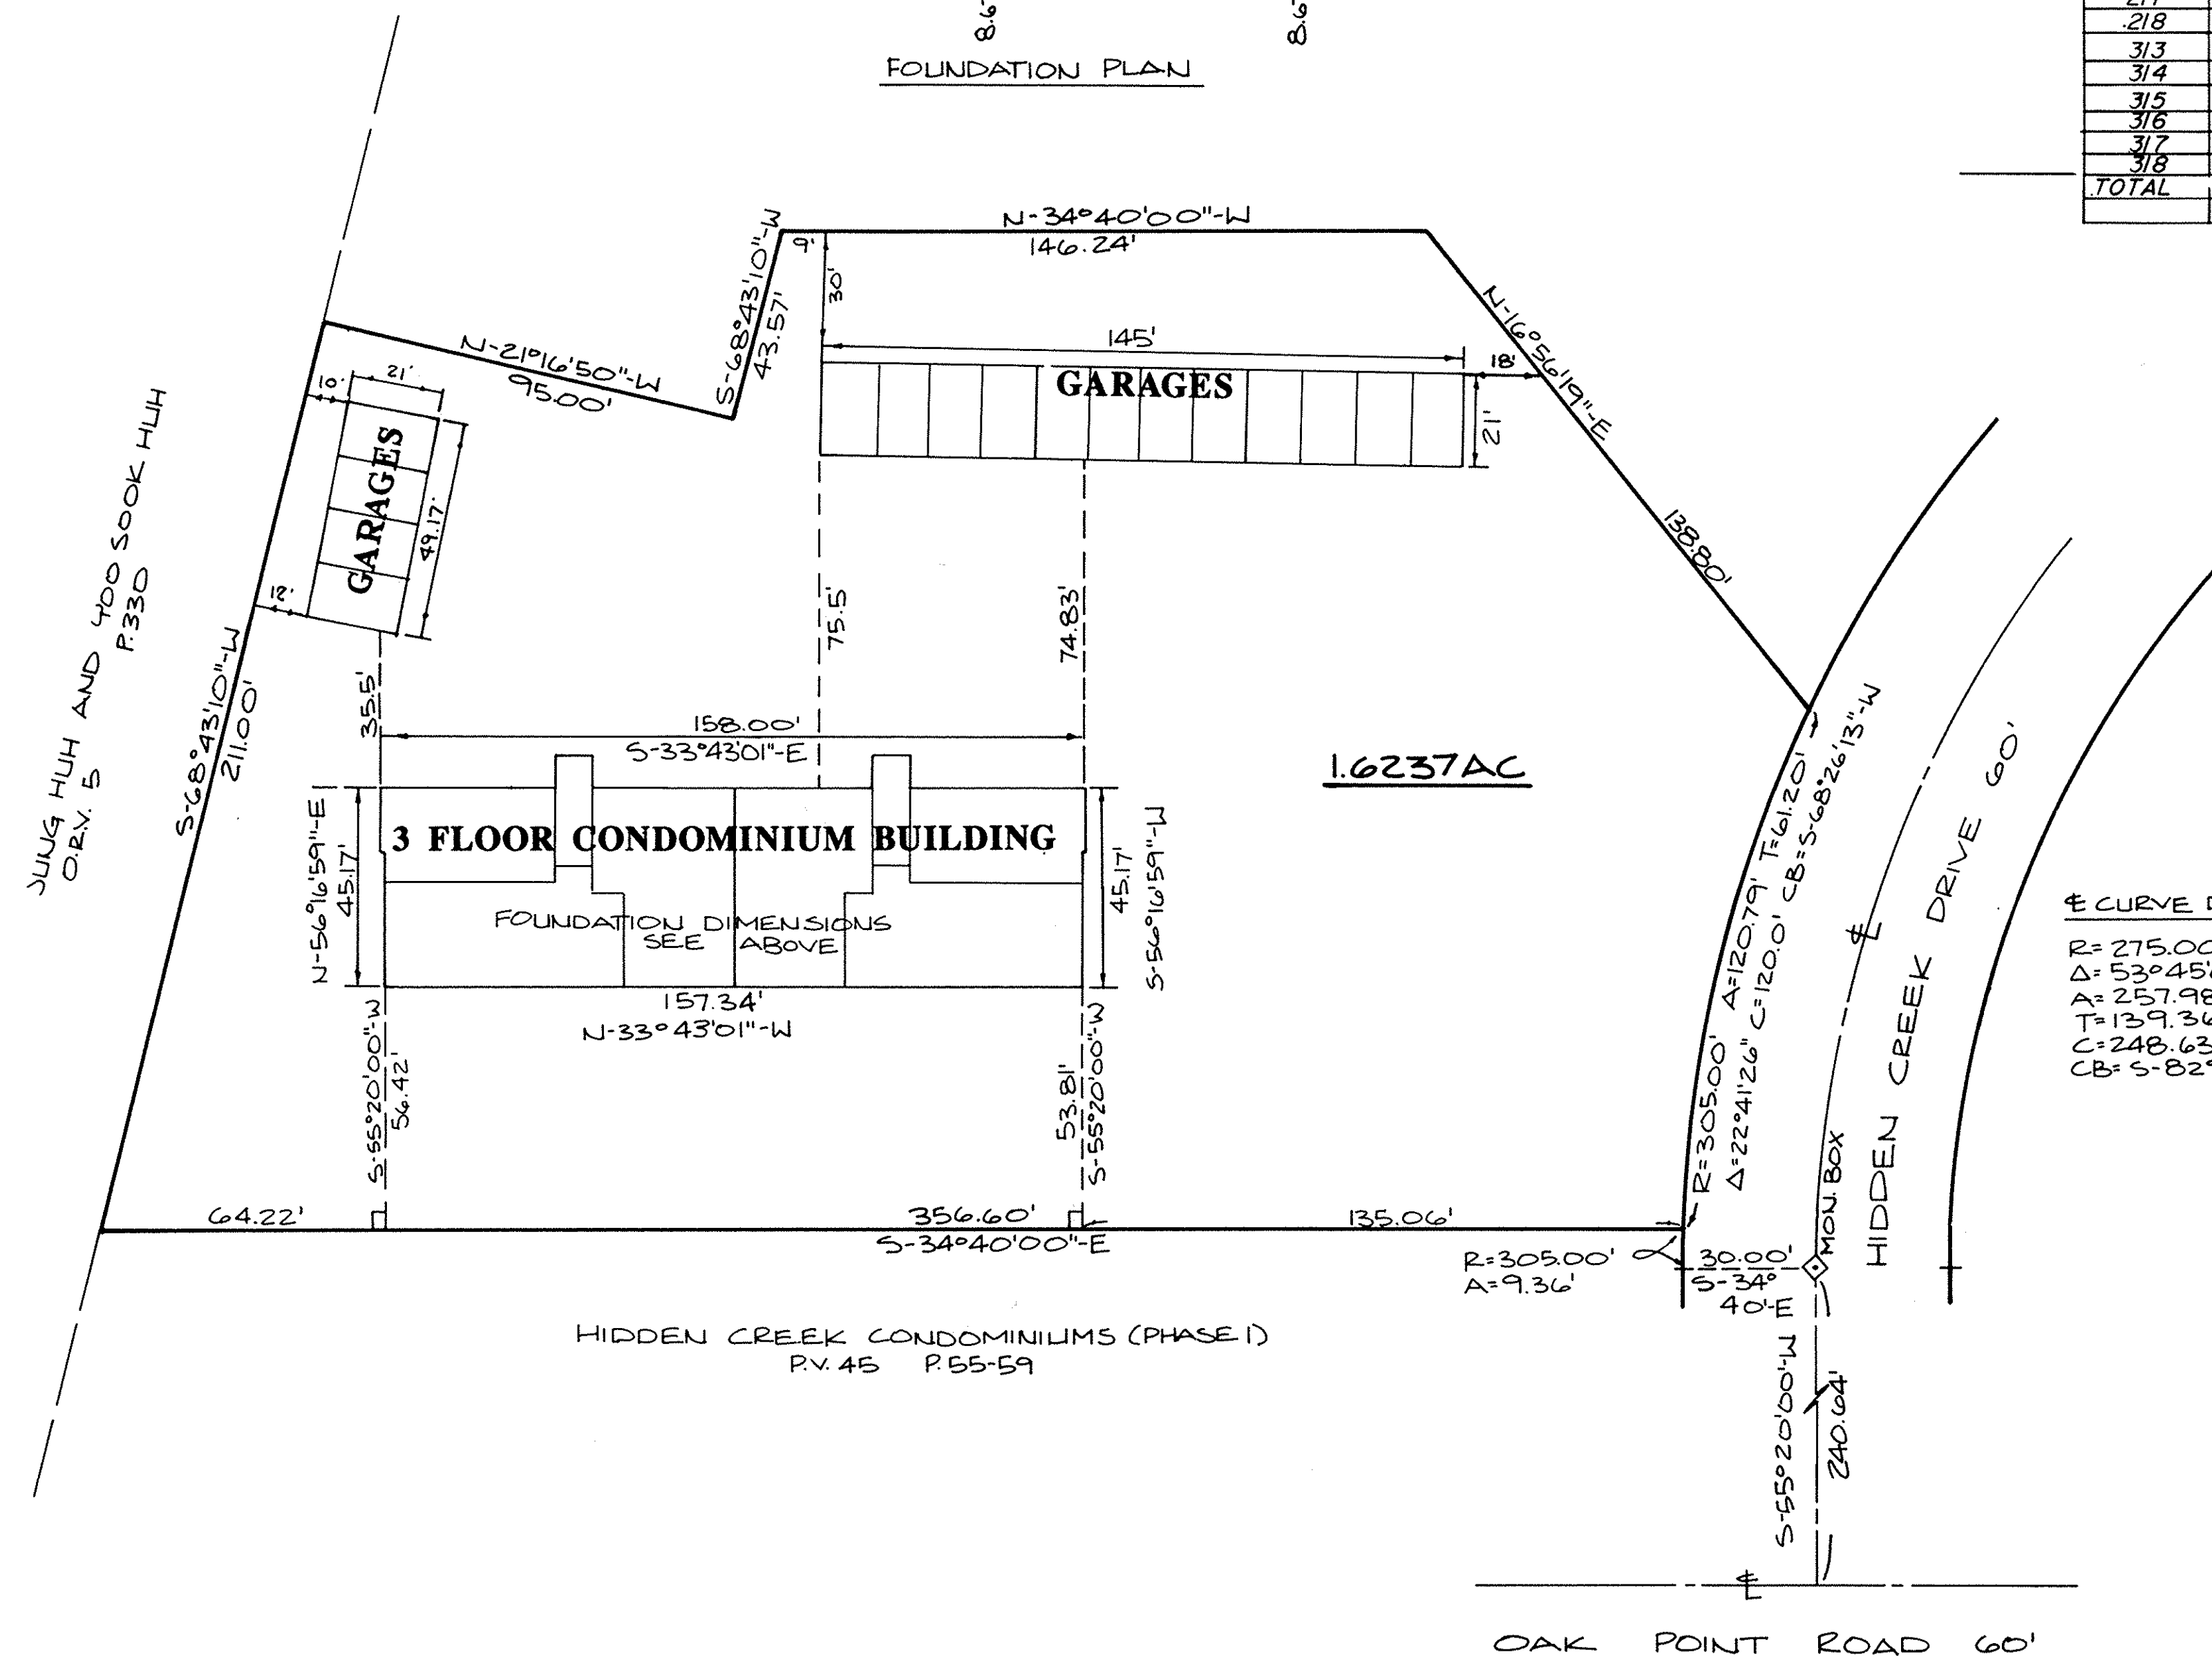

HIDDEN CREEK CONDOMINIUMS (PHASE 1)
P.V. 45 P. 55-59

§ CURVE DATA
R=275.00'
Δ=53°45'00"
A=257.98'
T=127.36'
C=248.63'
CB=5-82°12'30"-W

SHEET INDEX	
SHEET NO.	DESCRIPTION
1 OF 3	SURVEY MAP & MISC.
2 OF 3	FLOOR PLANS
3 OF 3	EXTERIOR ELEVATIONS

UNIT	AREA	% OWNER
101	866	1.34
102	1198	1.85
103	1181	1.83
104	1181	1.83
105	1198	1.85
106	866	1.34
201	866	1.34
202	1198	1.85
203	1181	1.83
204	1181	1.83
205	1198	1.85
206	866	1.34
301	866	1.34
302	1198	1.85
303	1181	1.83
304	1181	1.83
305	1198	1.85
306	866	1.34
107	1175	1.82
108	1204	1.86
109	1175	1.82
207	855	1.32
208	1175	1.82
209	1173	1.81
210	1155	1.79
211	1175	1.82
212	855	1.32
307	855	1.32
308	1175	1.82
309	1173	1.81
310	1155	1.79
311	1175	1.82
312	855	1.32
110	1890	2.93
111	1890	2.93
112	1890	2.93
113	1890	2.93
114	1890	2.93
115	2093	3.24
116	858	1.33
117	1174	1.82
118	1213	1.88
119	1174	1.82
213	858	1.33
214	1174	1.82
215	1175	1.82
216	1175	1.82
217	1174	1.82
218	858	1.33
313	858	1.33
314	1174	1.82
315	1175	1.82
316	1174	1.82
317	1174	1.82
318	858	1.33
TOTAL	64590	100.00

HIDDEN CREEK CONDOMINIUM PHASE 1
P.V. 45 P. 55-59

HIDDEN CREEK CONDOMINIUM PHASE 2
P.V. 48 P. 72-77



HIDDEN CREEK CONDOMINIUM PHASE 3
P.V. 49 P. 52-60

HIDDEN CREEK CONDOMINIUM PHASE 4




CERTIFICATION:
THIS IS TO CERTIFY THAT THE ATTACHED DRAWINGS CORRECTLY REPRESENT THE BUILDINGS AS CONSTRUCTED AND THAT THERE ARE NO ENCROACHMENTS ON ABUTTING PROPERTIES.

DAVID L. ELWELL
REG. SURVEYOR NO. 6333

MARK SKELLENGER
REG. ENGINEER NO. 46461

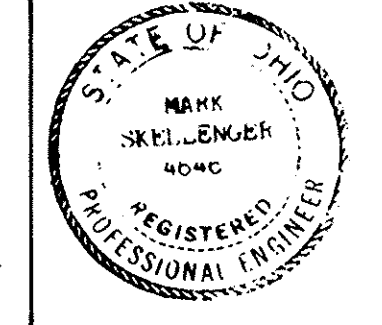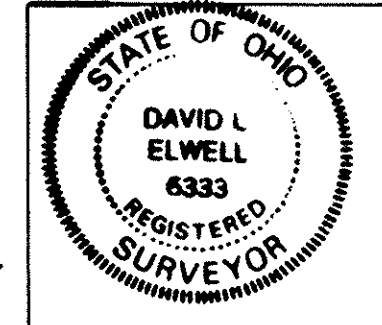

DEC 16 1992
4:01 P. 16.17
18 # 129.00

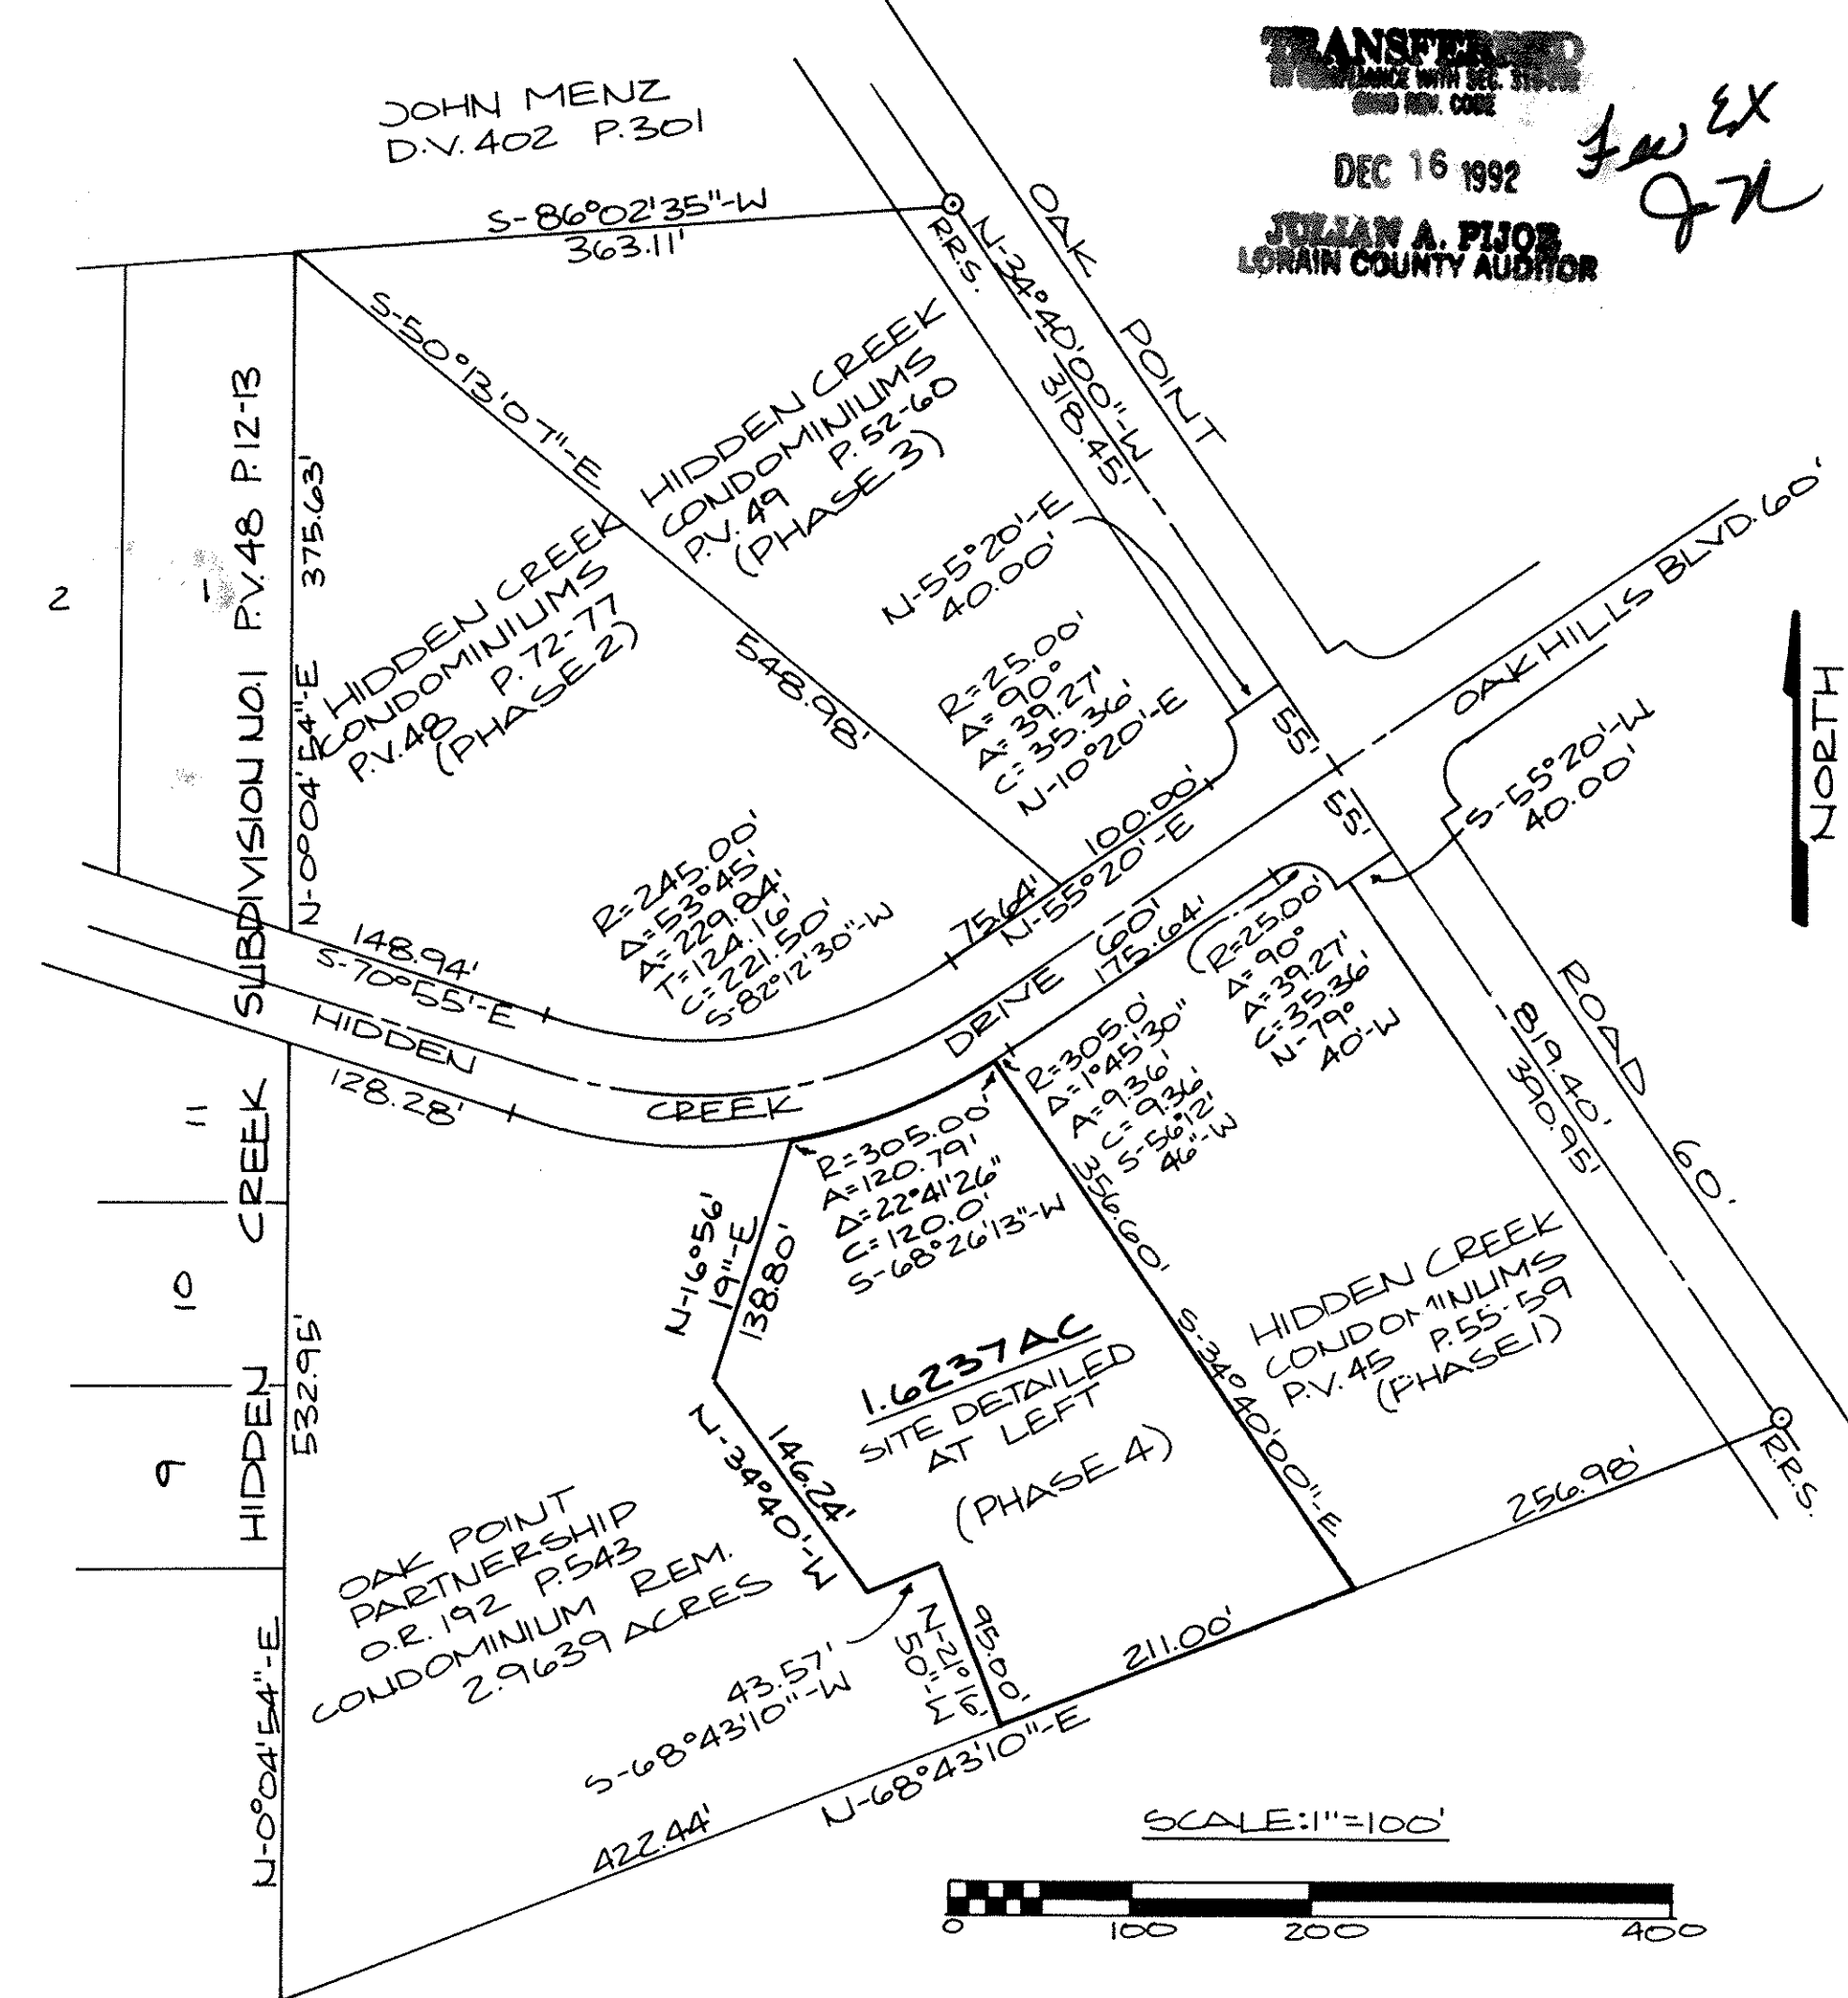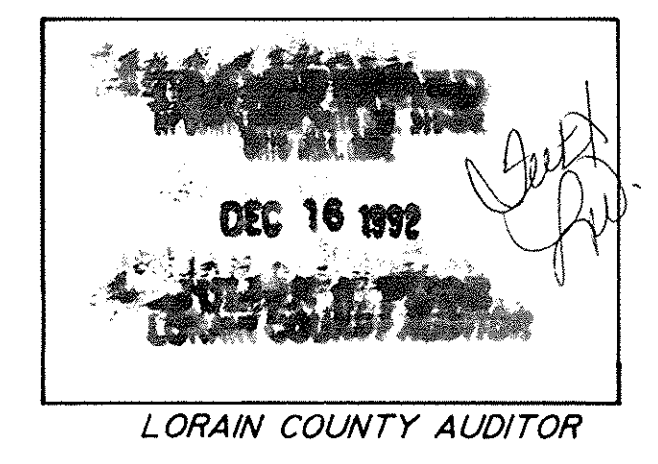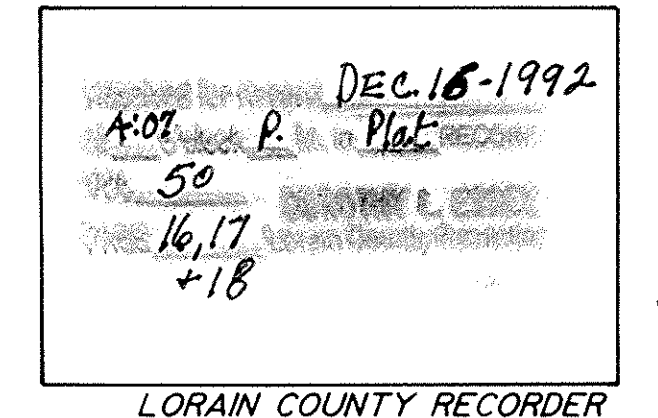

HIDDEN CREEK CONDOMINIUMS PHASE 4
OF PART OF
BLACK RIVER TOWNSHIP ORIGINAL LOT NO. 4 TRACT NO. 3
CITY OF LORAIN COUNTY OF LORAIN STATE OF OHIO


KS ASSOCIATES INC.
ENGINEERS SURVEYORS

LORAIN COUNTY TAX
MAP DEPARTMENT COPY

Box: Lorain County Title Co.
L.M.

209270

209270

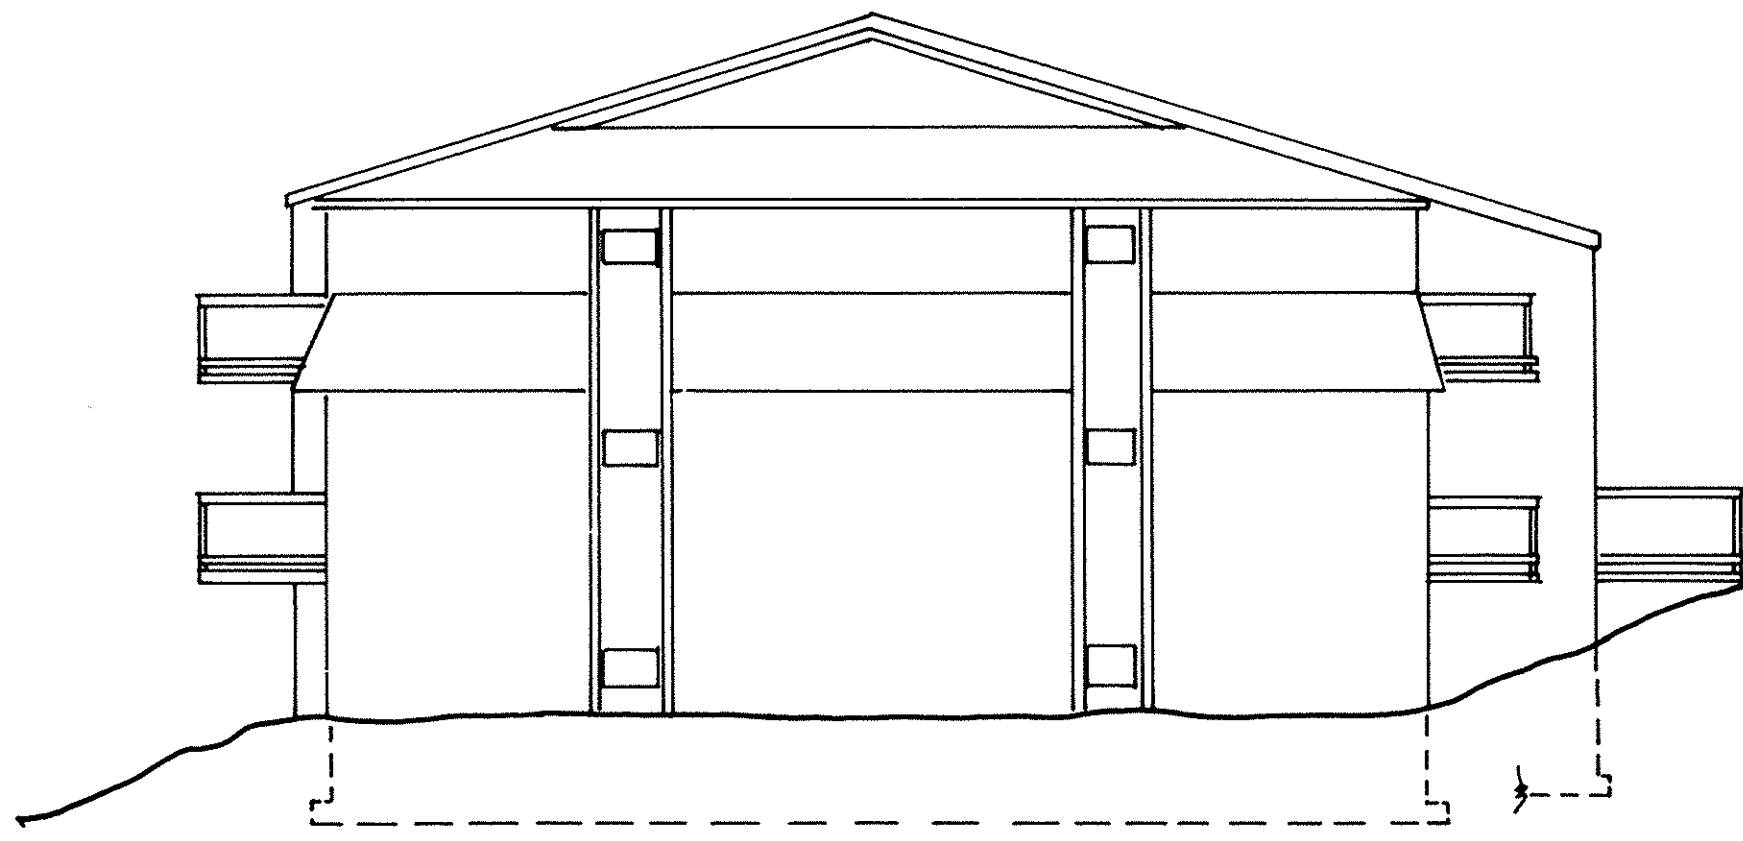

NORTH ELEVATION
SCALE: 1/8" = 1'-0"



WEST ELEVATION
SCALE: 1/4" = 1'-0"



EAST ELEVATION
SCALE: 1/4" = 1'-0"

HIDDEN CREEK CONDOMINIUMS PHASE 4
EXTERIOR ELEVATIONS

LORAIN COUNTY TAX
MAP DEPARTMENT COPY

TAX MAP DEPT.

89 - 252 P4

3 OF 3

50/18