

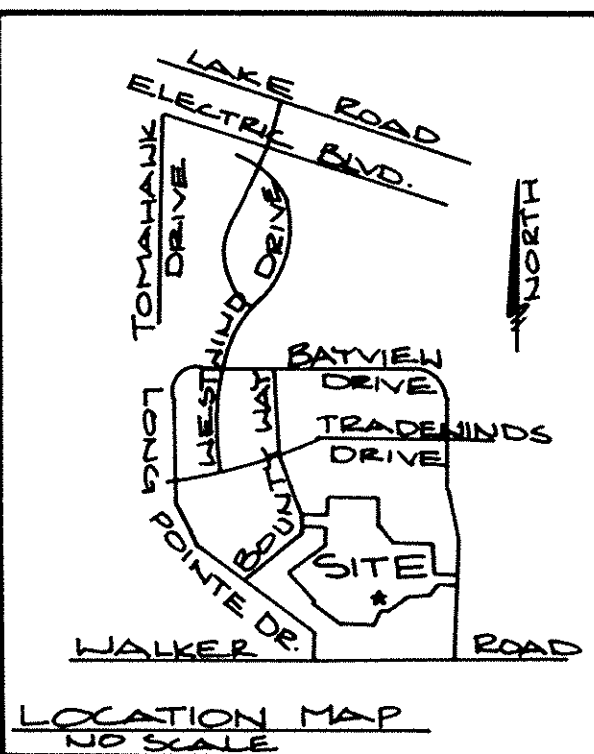


215015

215015

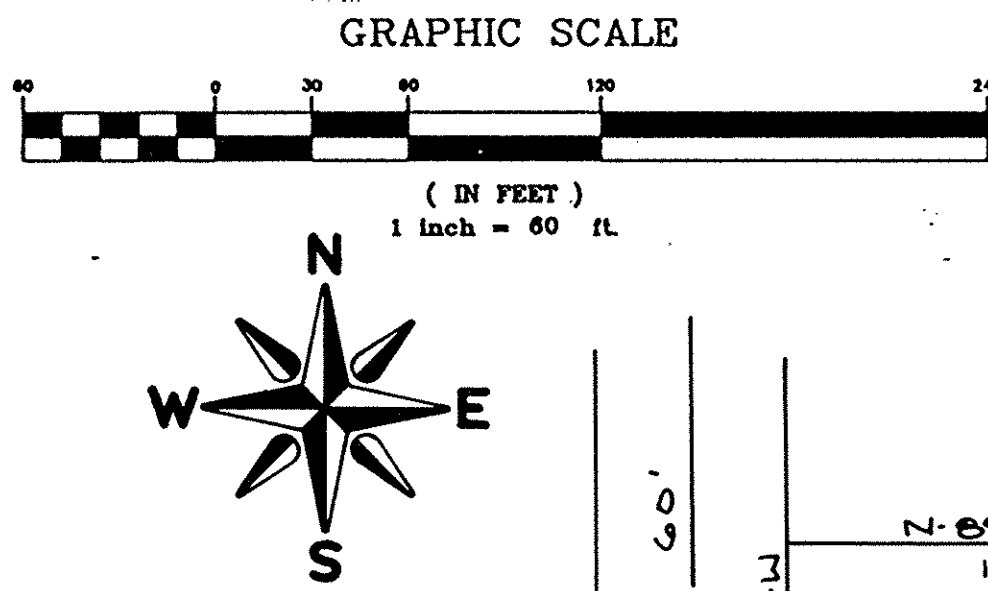

BUILDING 43		
UNIT	FIRST FL. ELEV.	SECOND FL. ELEV.
61-188	632.40	640.50
62-189	632.50	640.50
63-190	632.46	640.46
64-191	632.40	-----

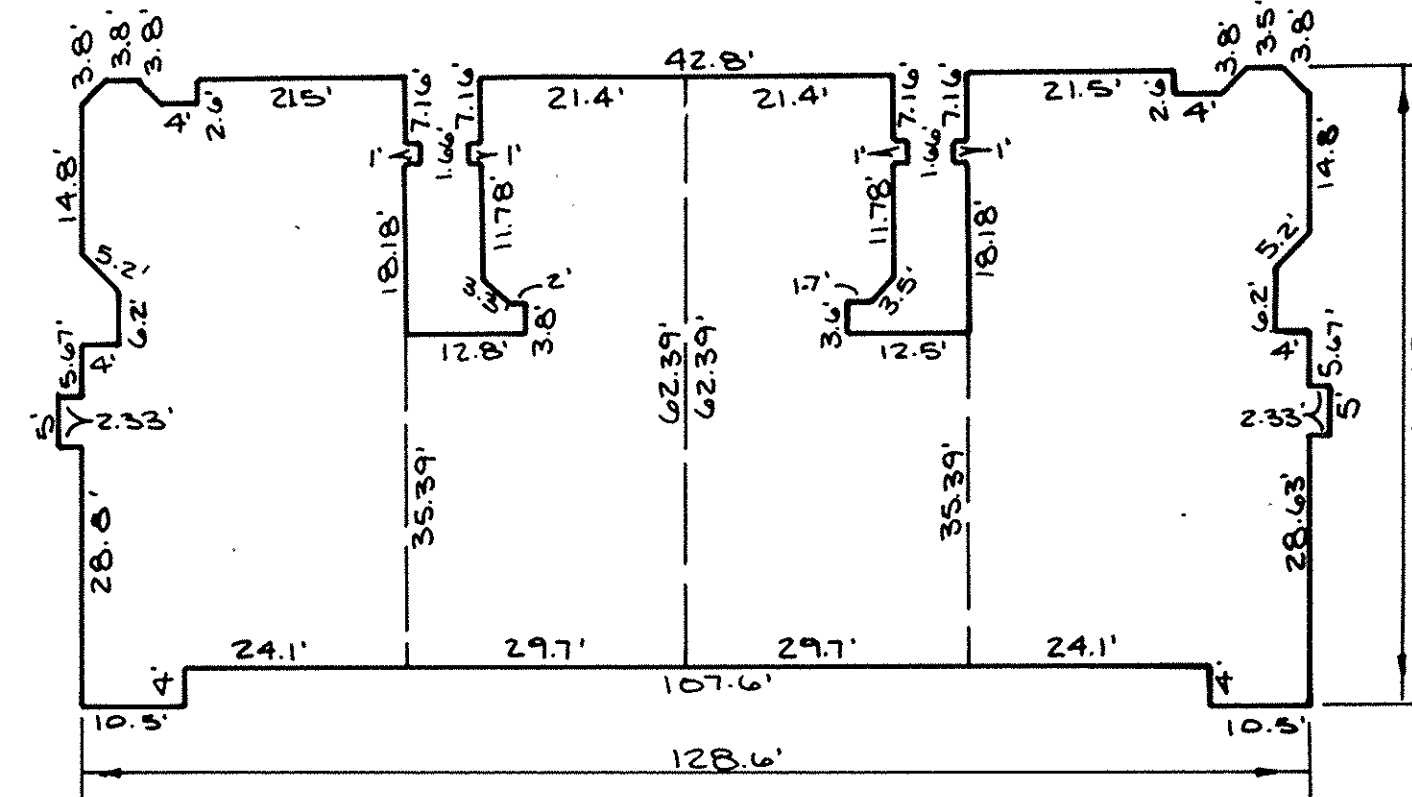

Unit Numbers and Reestablished Percentages of Interest in Combined Common Areas and Facilities

Parcel No. 1:	Square Feet	% of Combined Common Areas & Facilities
Unit # 1-148 - 401 Bounty Way	1424	1.3658
2-149 " " "	1703	1.6335
3-150 " " "	1787	1.7140
4-151 " " "	1424	1.3658
5-152 " " "	1424	1.3658
6-153 " " "	1910	1.8320
7-154 " " "	1703	1.6335
8-155 " " "	1424	1.3658
9-156 " " "	1424	1.3658
10-157 " " "	1703	1.6335
11-158 " " "	1787	1.7140
12-159 " " "	1424	1.3658
13-160 " " "	1703	1.6335
14-161 " " "	1787	1.7140
15-162 " " "	1424	1.3658
Parcel No. 1-A:		
Unit # 16-144 - 401 Bounty Way	1424	1.3658
17-145 " " "	1703	1.6335
18-146 " " "	1787	1.7140
19-147 " " "	1424	1.3658
Parcel No. 1-B:		
Unit # 20-128 - 401 Bounty Way	1424	1.3658
21-129 " " "	1891	1.8139
22-130 " " "	1703	1.6335
23-131 " " "	1424	1.3658
24-132 " " "	1424	1.3658
25-133 " " "	1787	1.7140
26-134 " " "	1703	1.6335
27-135 " " "	1703	1.6335
28-136 " " "	1787	1.7140
29-137 " " "	1703	1.6335
30-138 " " "	1424	1.3658
31-139 " " "	1787	1.7140
32-140 " " "	1703	1.6335
33-141 " " "	1703	1.6335
34-142 " " "	1924	1.8455
35-143 " " "	1424	1.3658
Parcel No. 2:		
Unit # 36-163 - 401 Bounty Way	1424	1.3658
37-164 " " "	1703	1.6335
38-165 " " "	1787	1.7140
39-166 " " "	1424	1.3658
Parcel No. 1-C:		
Unit # 40-167 - 401 Bounty Way	1424	1.3658
41-168 " " "	1787	1.7140
42-169 " " "	1703	1.6335
43-170 " " "	1703	1.6335
44-171 " " "	2029	1.9462
45-172 " " "	1424	1.3658
46-173 " " "	1424	1.3658
47-174 " " "	1787	1.7140
48-175 " " "	1703	1.6335
49-176 " " "	1703	1.6335
50-177 " " "	1424	1.3658
Parcel No. 1-D:		
Unit # 51-178 - 401 Bounty Way	1424	1.3658
52-179 " " "	1703	1.6335
53-180 " " "	1703	1.6335
54-181 " " "	1787	1.7140
55-182 " " "	1424	1.3658
56-183 " " "	1424	1.3658
57-184 " " "	1703	1.6335
58-185 " " "	1703	1.6335
59-186 " " "	1787	1.7140
60-187 " " "	1703	1.6335
Parcel No. 1-E:		
Unit # 61-188 - 401 Bounty Way	1424	1.3658
62-189 " " "	1787	1.7140
63-190 " " "	1910	1.8320
64-191 " " "	1424	1.3658

SHEET INDEX	
SHEET #	DESCRIPTION
1	SURVEY MAP & MISC.
2	FLOOR PLAN UNIT 61-188 & 64-191
3	FLOOR PLAN UNIT 62-189
4	FLOOR PLAN UNIT 63-190
5	EXTERIOR ELEVATIONS

TRANSFERRED  
IN COMPLIANCE WITH SEC. 519-202  
OHIO REV. CODE  
JAN 29 1993  
JULIAN A. PIJOR  
LORAIN COUNTY AUDITOR

Received for Record JAN 29 1993  
at 2:50 o'clock P.M. in PLATBOORD  
VOL 50 MARY ANN JACOBSON  
29-33  
Lorain County Auditor

Br: RCTE - 2m  
\$216.00

**WESTWINDS SOUTH CONDOMINIUM NO.1  
FIFTH AMENDMENT  
PHASE 6**


PART OF AVON TOWNSHIP SECTION NO. 30  
CITY OF AVON LAKE • COUNTY OF LORAIN • STATE OF OHIO

**LORAIN COUNTY TAX  
MAP DEPARTMENT COPY**

CERTIFICATION  
THIS IS TO CERTIFY THAT THE ATTACHED DRAWINGS CORRECTLY REPRESENT THE BUILDINGS AS CONSTRUCTED AND THAT THERE ARE NO ENCROACHMENTS ON ABUTTING PROPERTIES.


David L. Elwell  
DAVID L. ELWELL  
REG. SURVEYOR NO. 6333

Mark Skellenger  
MARK SKELLENGER  
REG. ENGINEER NO. 46461

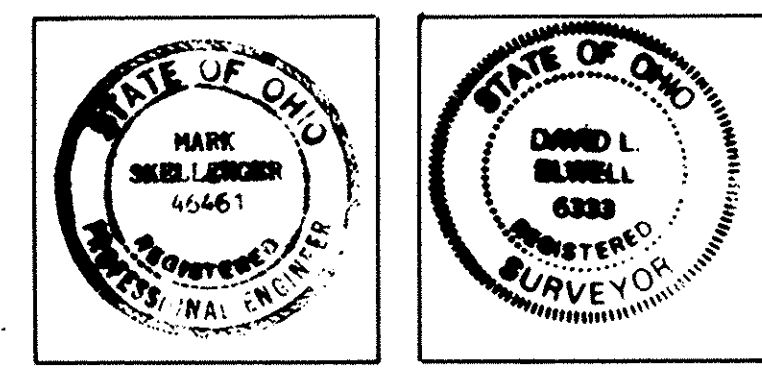


**KS ASSOCIATES INC.**  
ENGINEERS SURVEYORS  
424 MIDDLE AVENUE  
P.O. BOX 89  
ELYRIA OHIO 44036

\* - CORRECTIONS PER  
CERTIFICATE OF CORRECTION  
RECORDED IN O.R.V. 1226 P.706

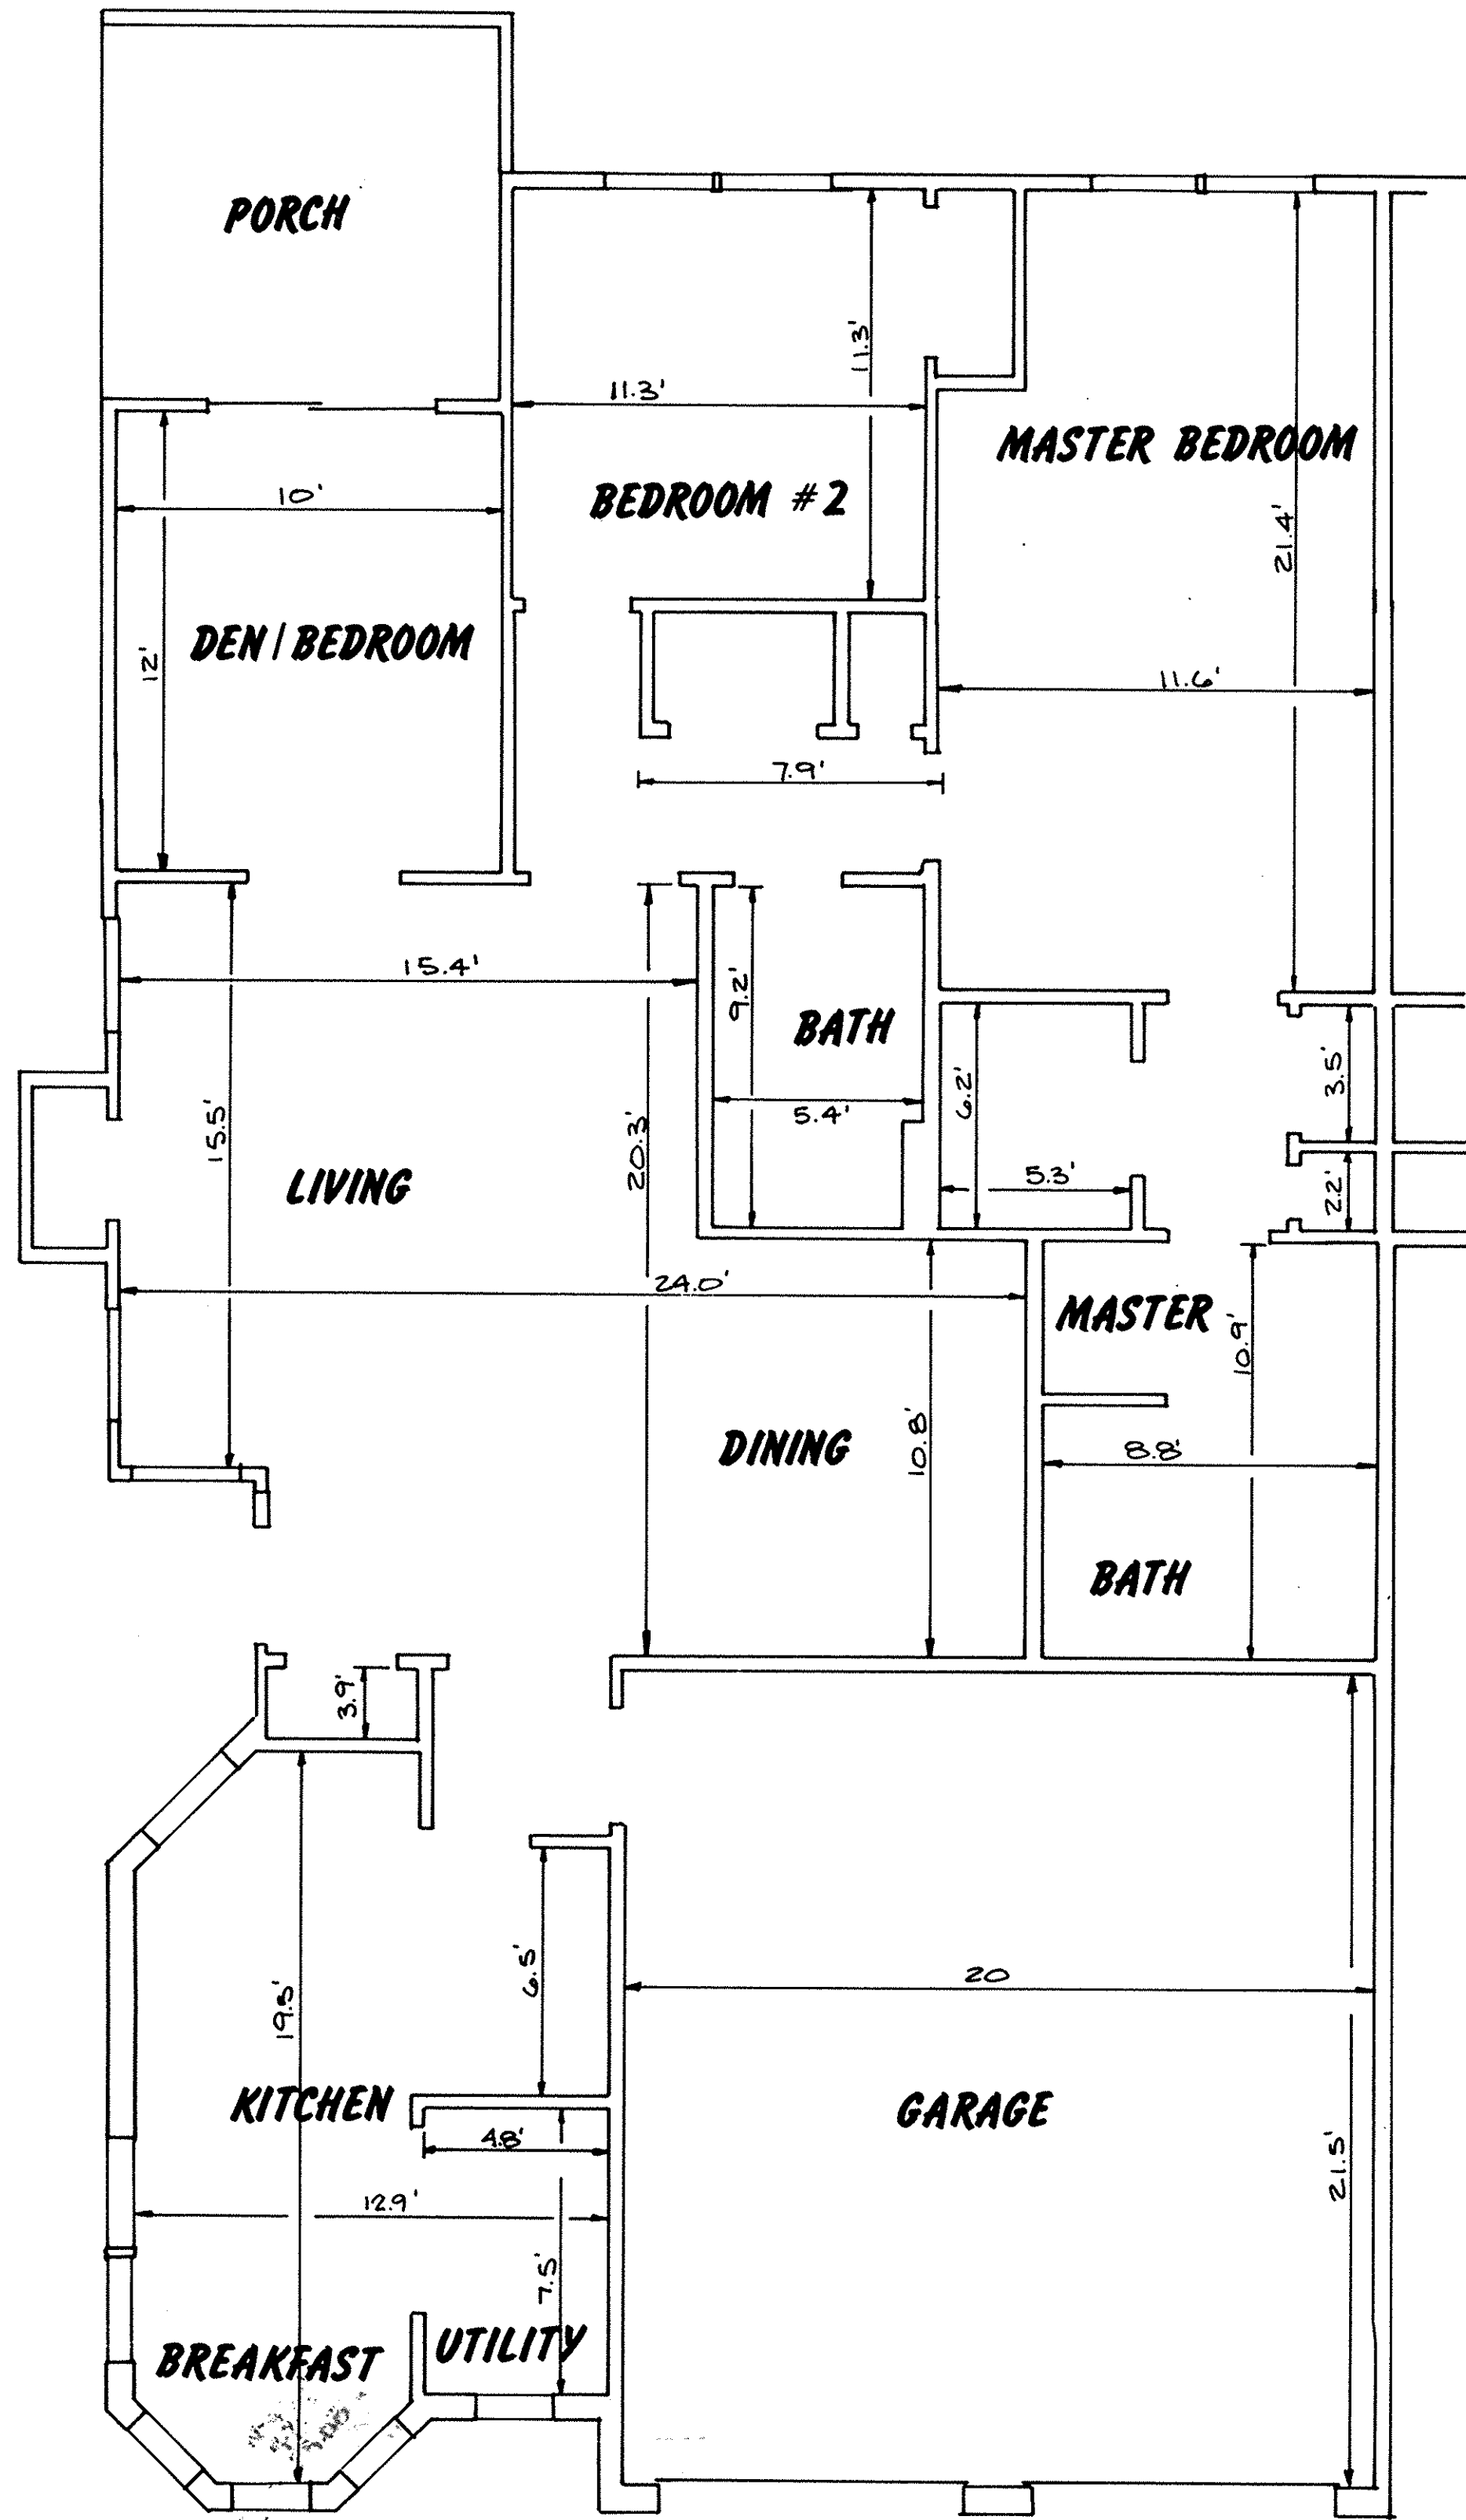

FLOOR PLAN - UNIT 64-191  
SCALE: 1/4" = 1'-0"

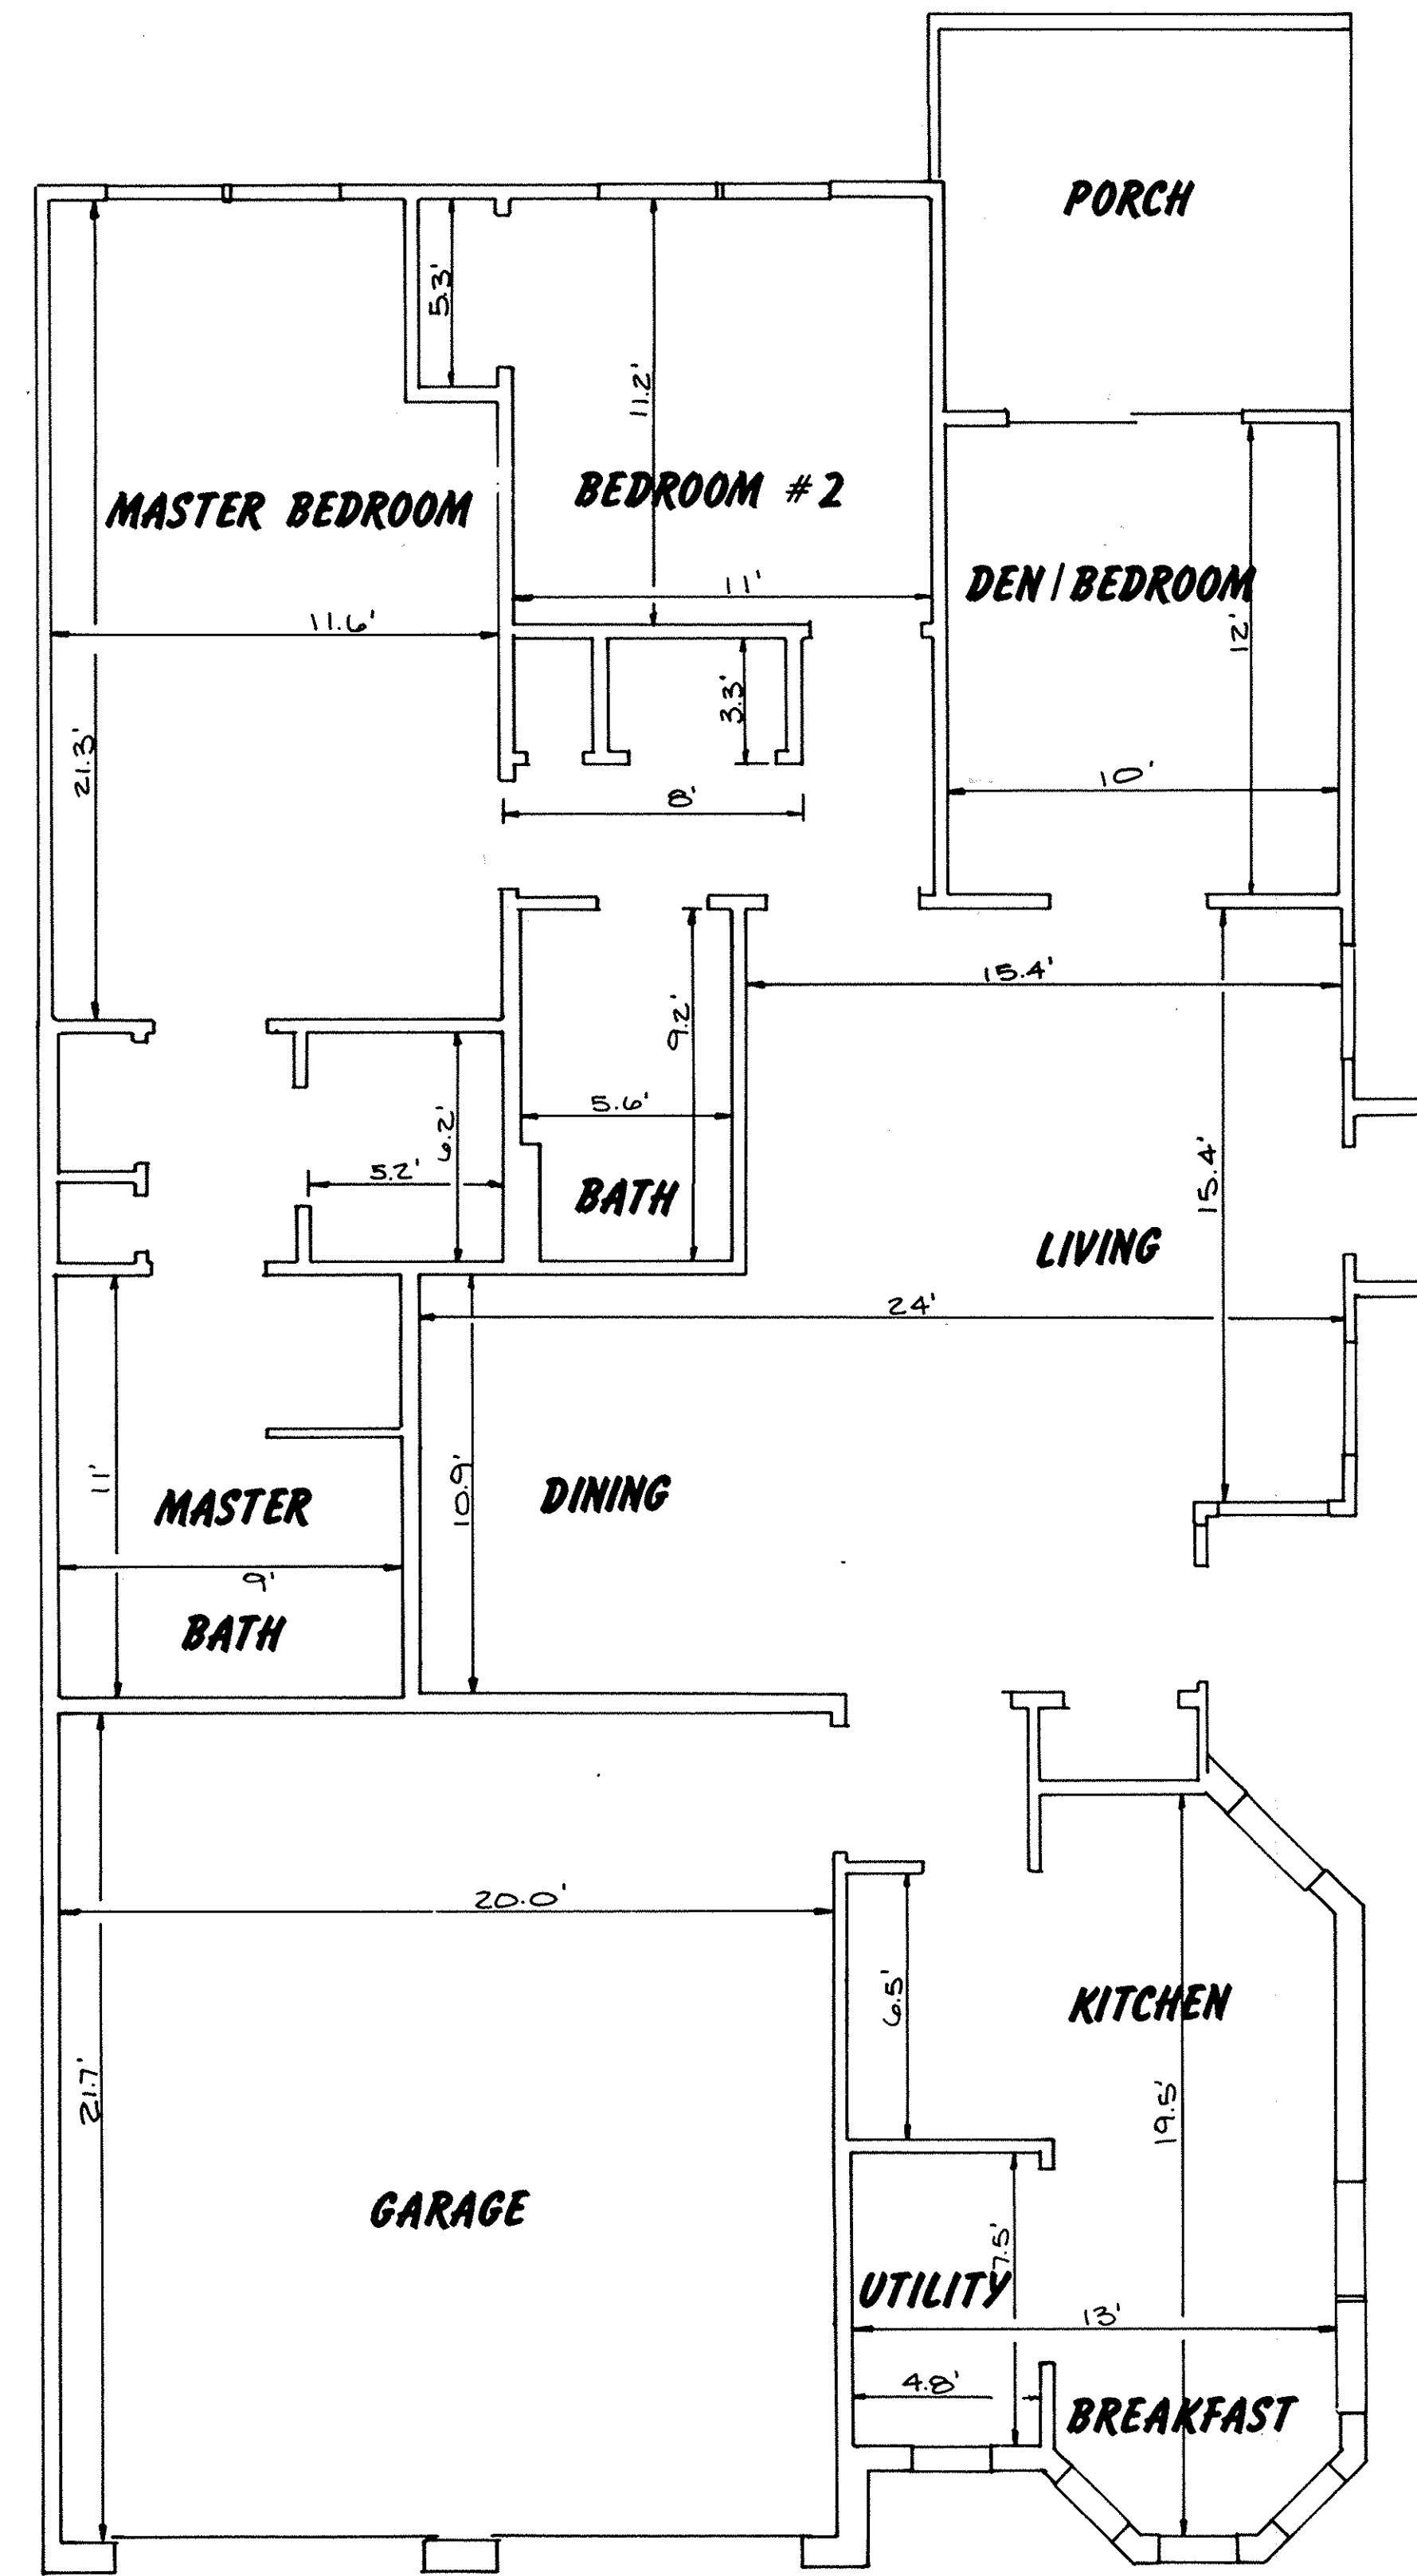


FLOOR PLAN - UNIT 64-188  
SCALE: 1/4" = 1'-0"


WESTWINDS SOUTH CONDOMINIUM NO.1  
FIFTH AMENDMENT FLOOR PLANS PHASE 6

LORAIN COUNTY TAX  
MAP DEPARTMENT COPY

TAX MAP DEPT. COPY

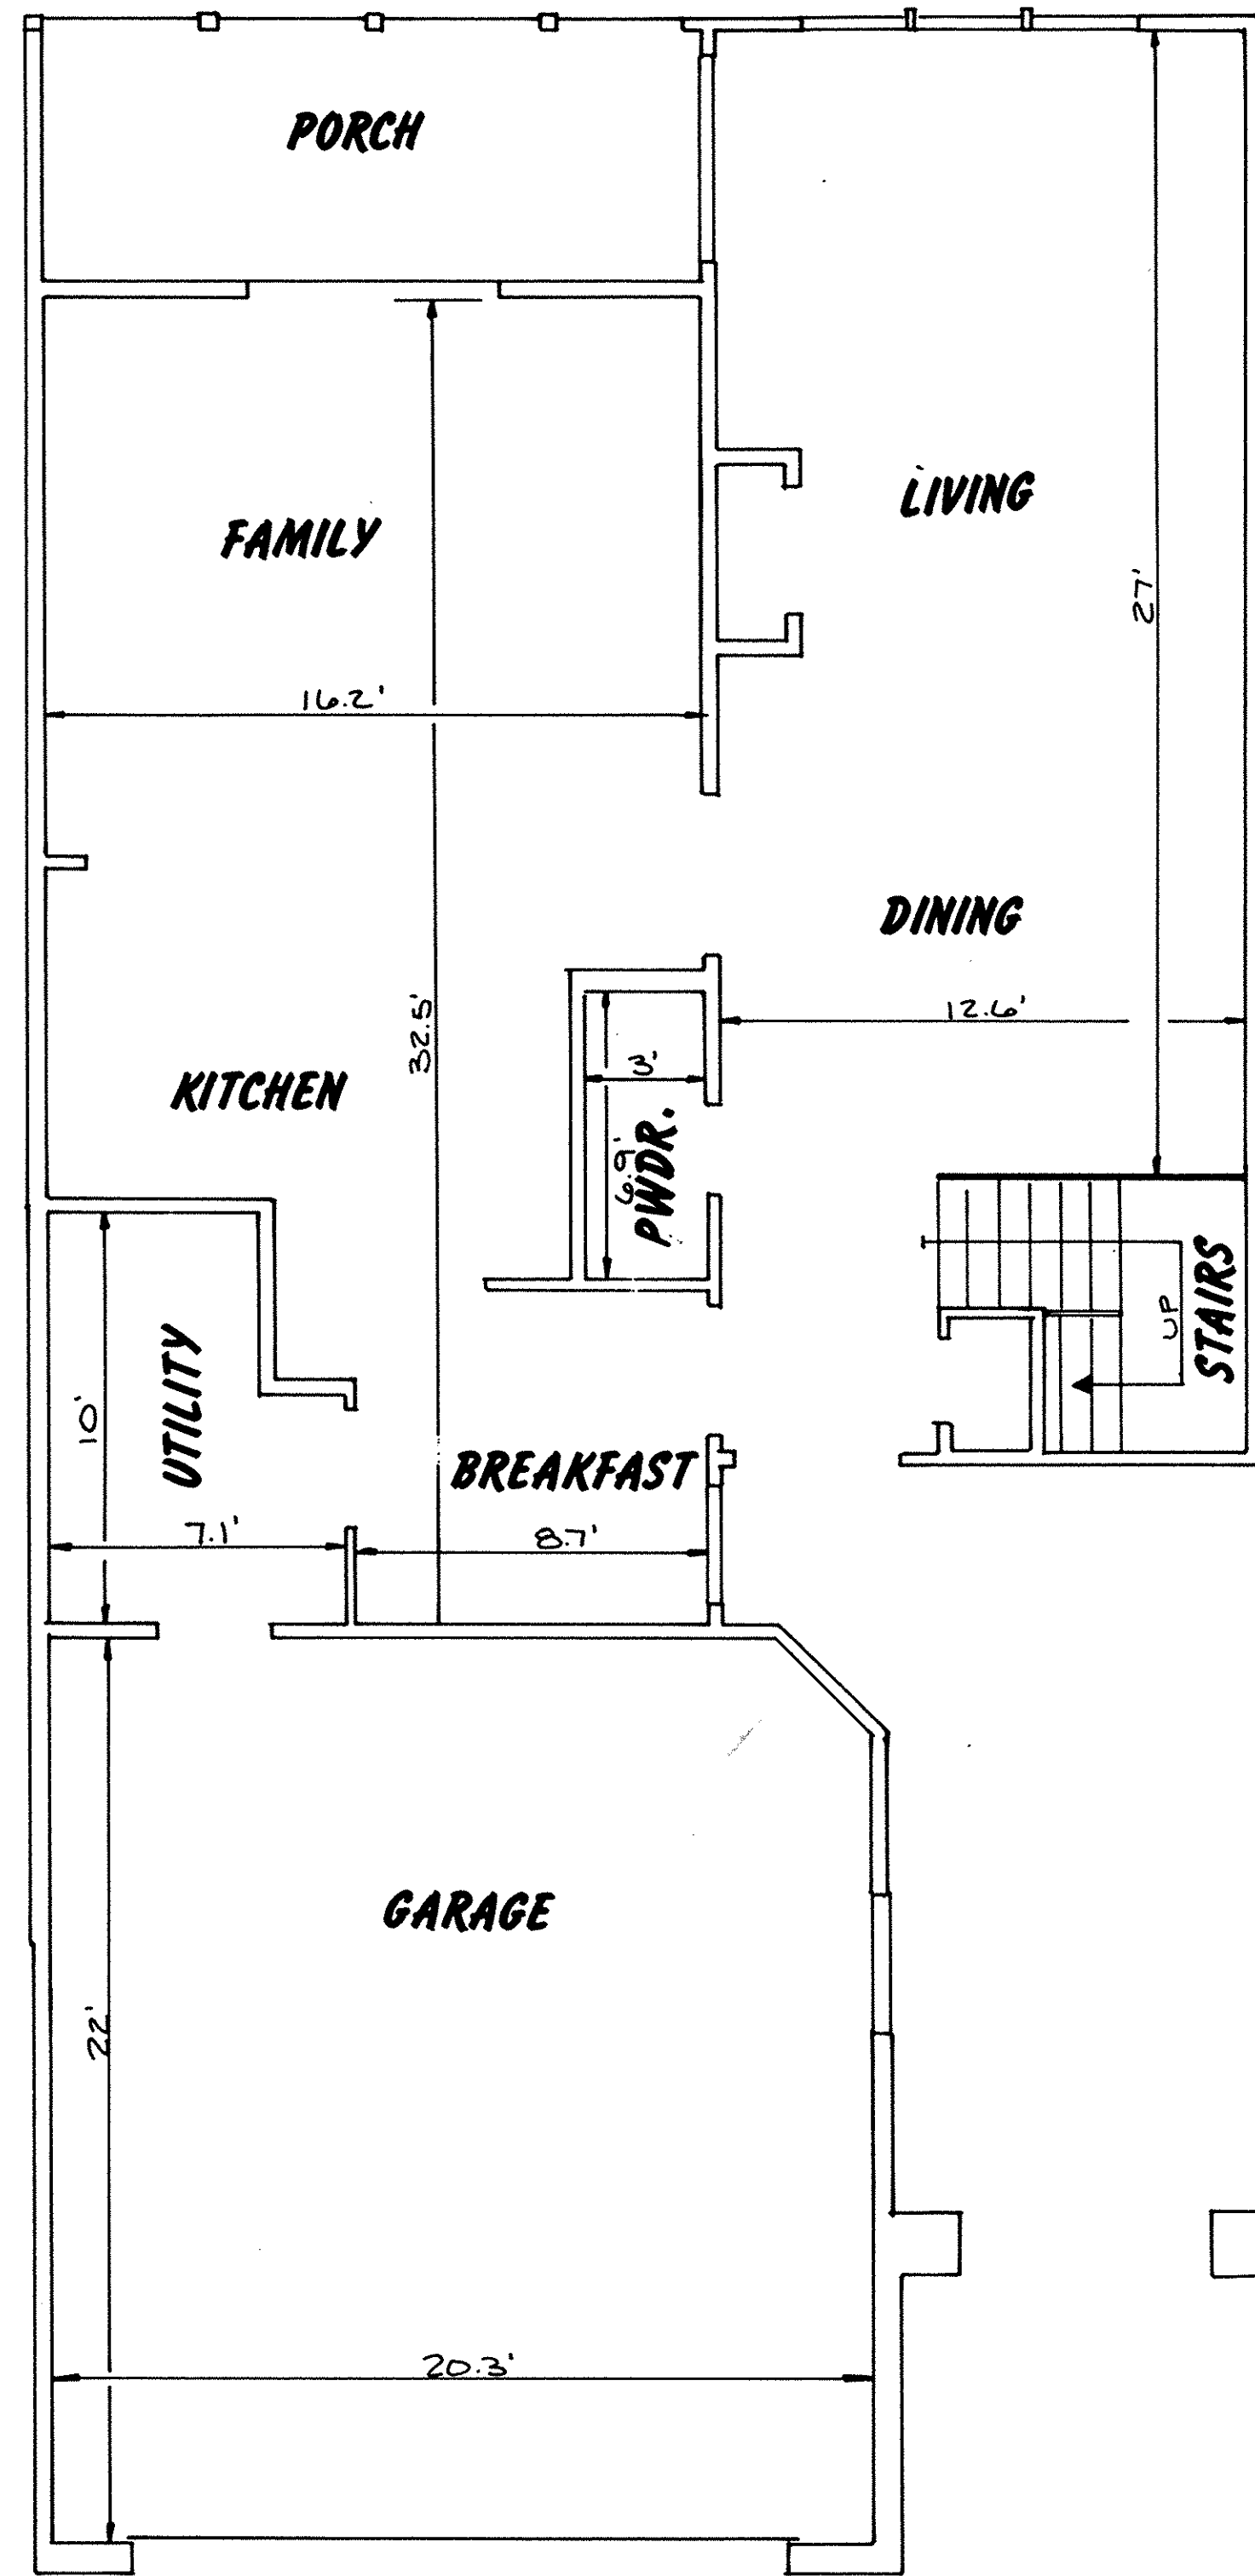

FIRST FLOOR PLAN—UNIT 62-189  
SCALE: 1/4" = 1'-0"

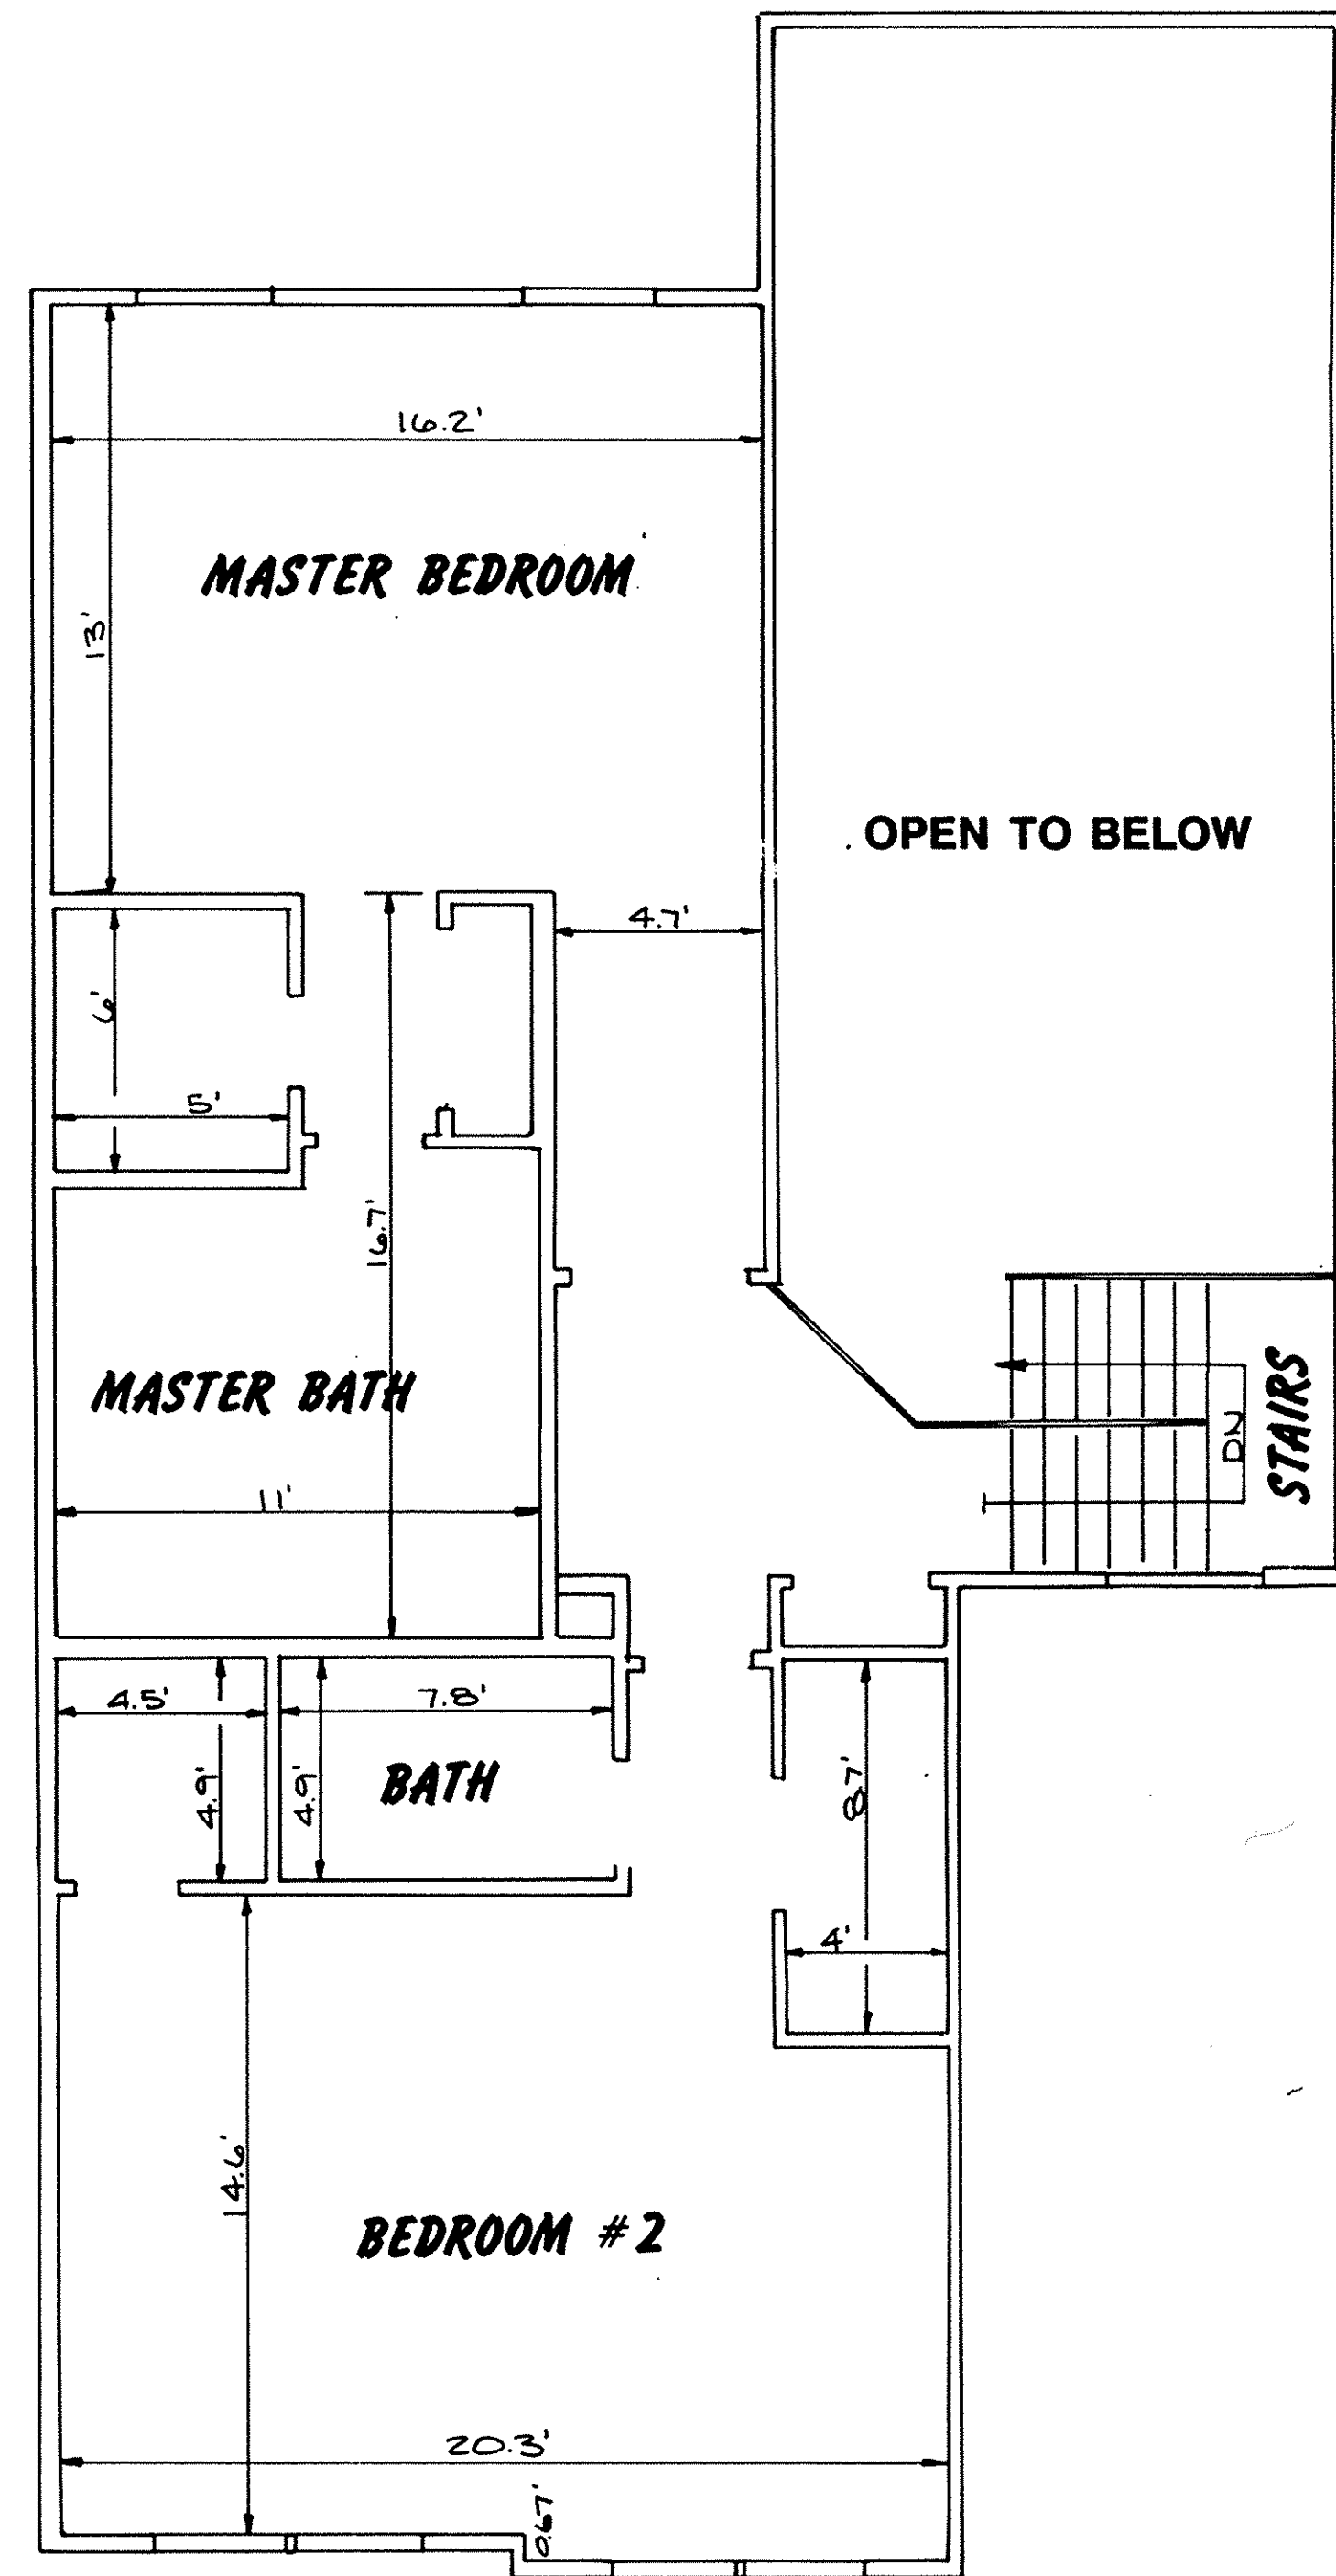


SECOND FLOOR PLAN—UNIT 62-189  
SCALE: 1/4" = 1'-0"


WESTWINDS SOUTH CONDOMINIUM NO.1  
FIFTH AMENDMENT FLOOR PLANS PHASE 6

LORAIN COUNTY TAX  
MAP DEPARTMENT COPY

TAX MAP DEPT. COPY

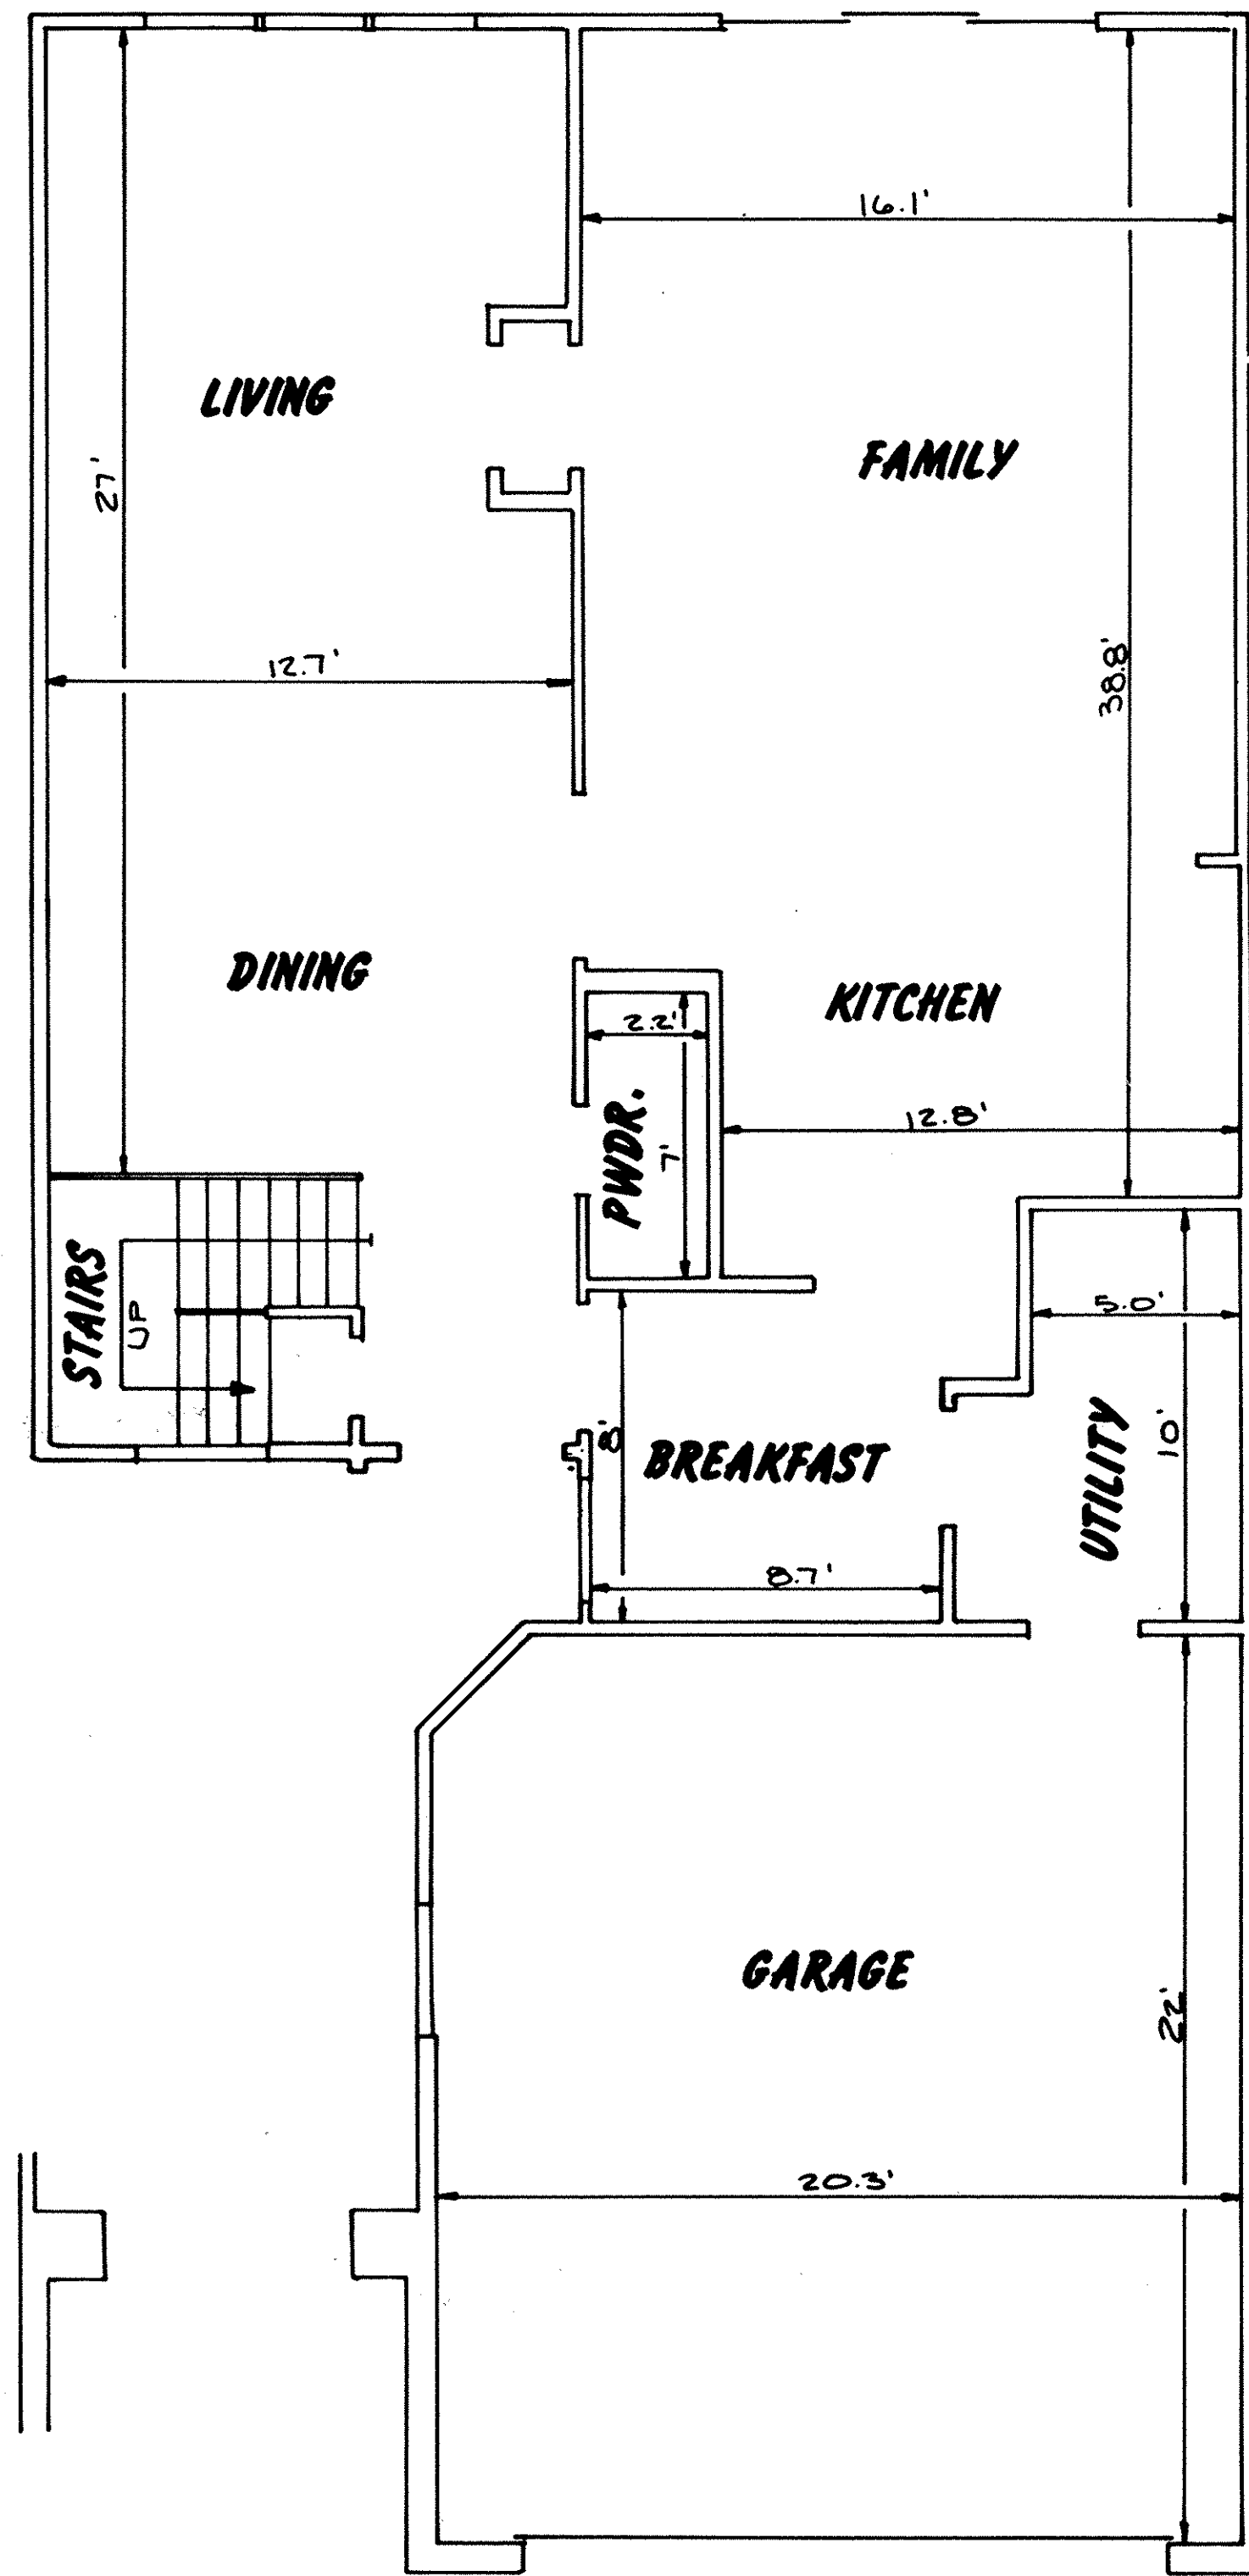

FIRST FLOOR PLAN - UNIT 63-190  
SCALE: 1/4" = 1'-0"

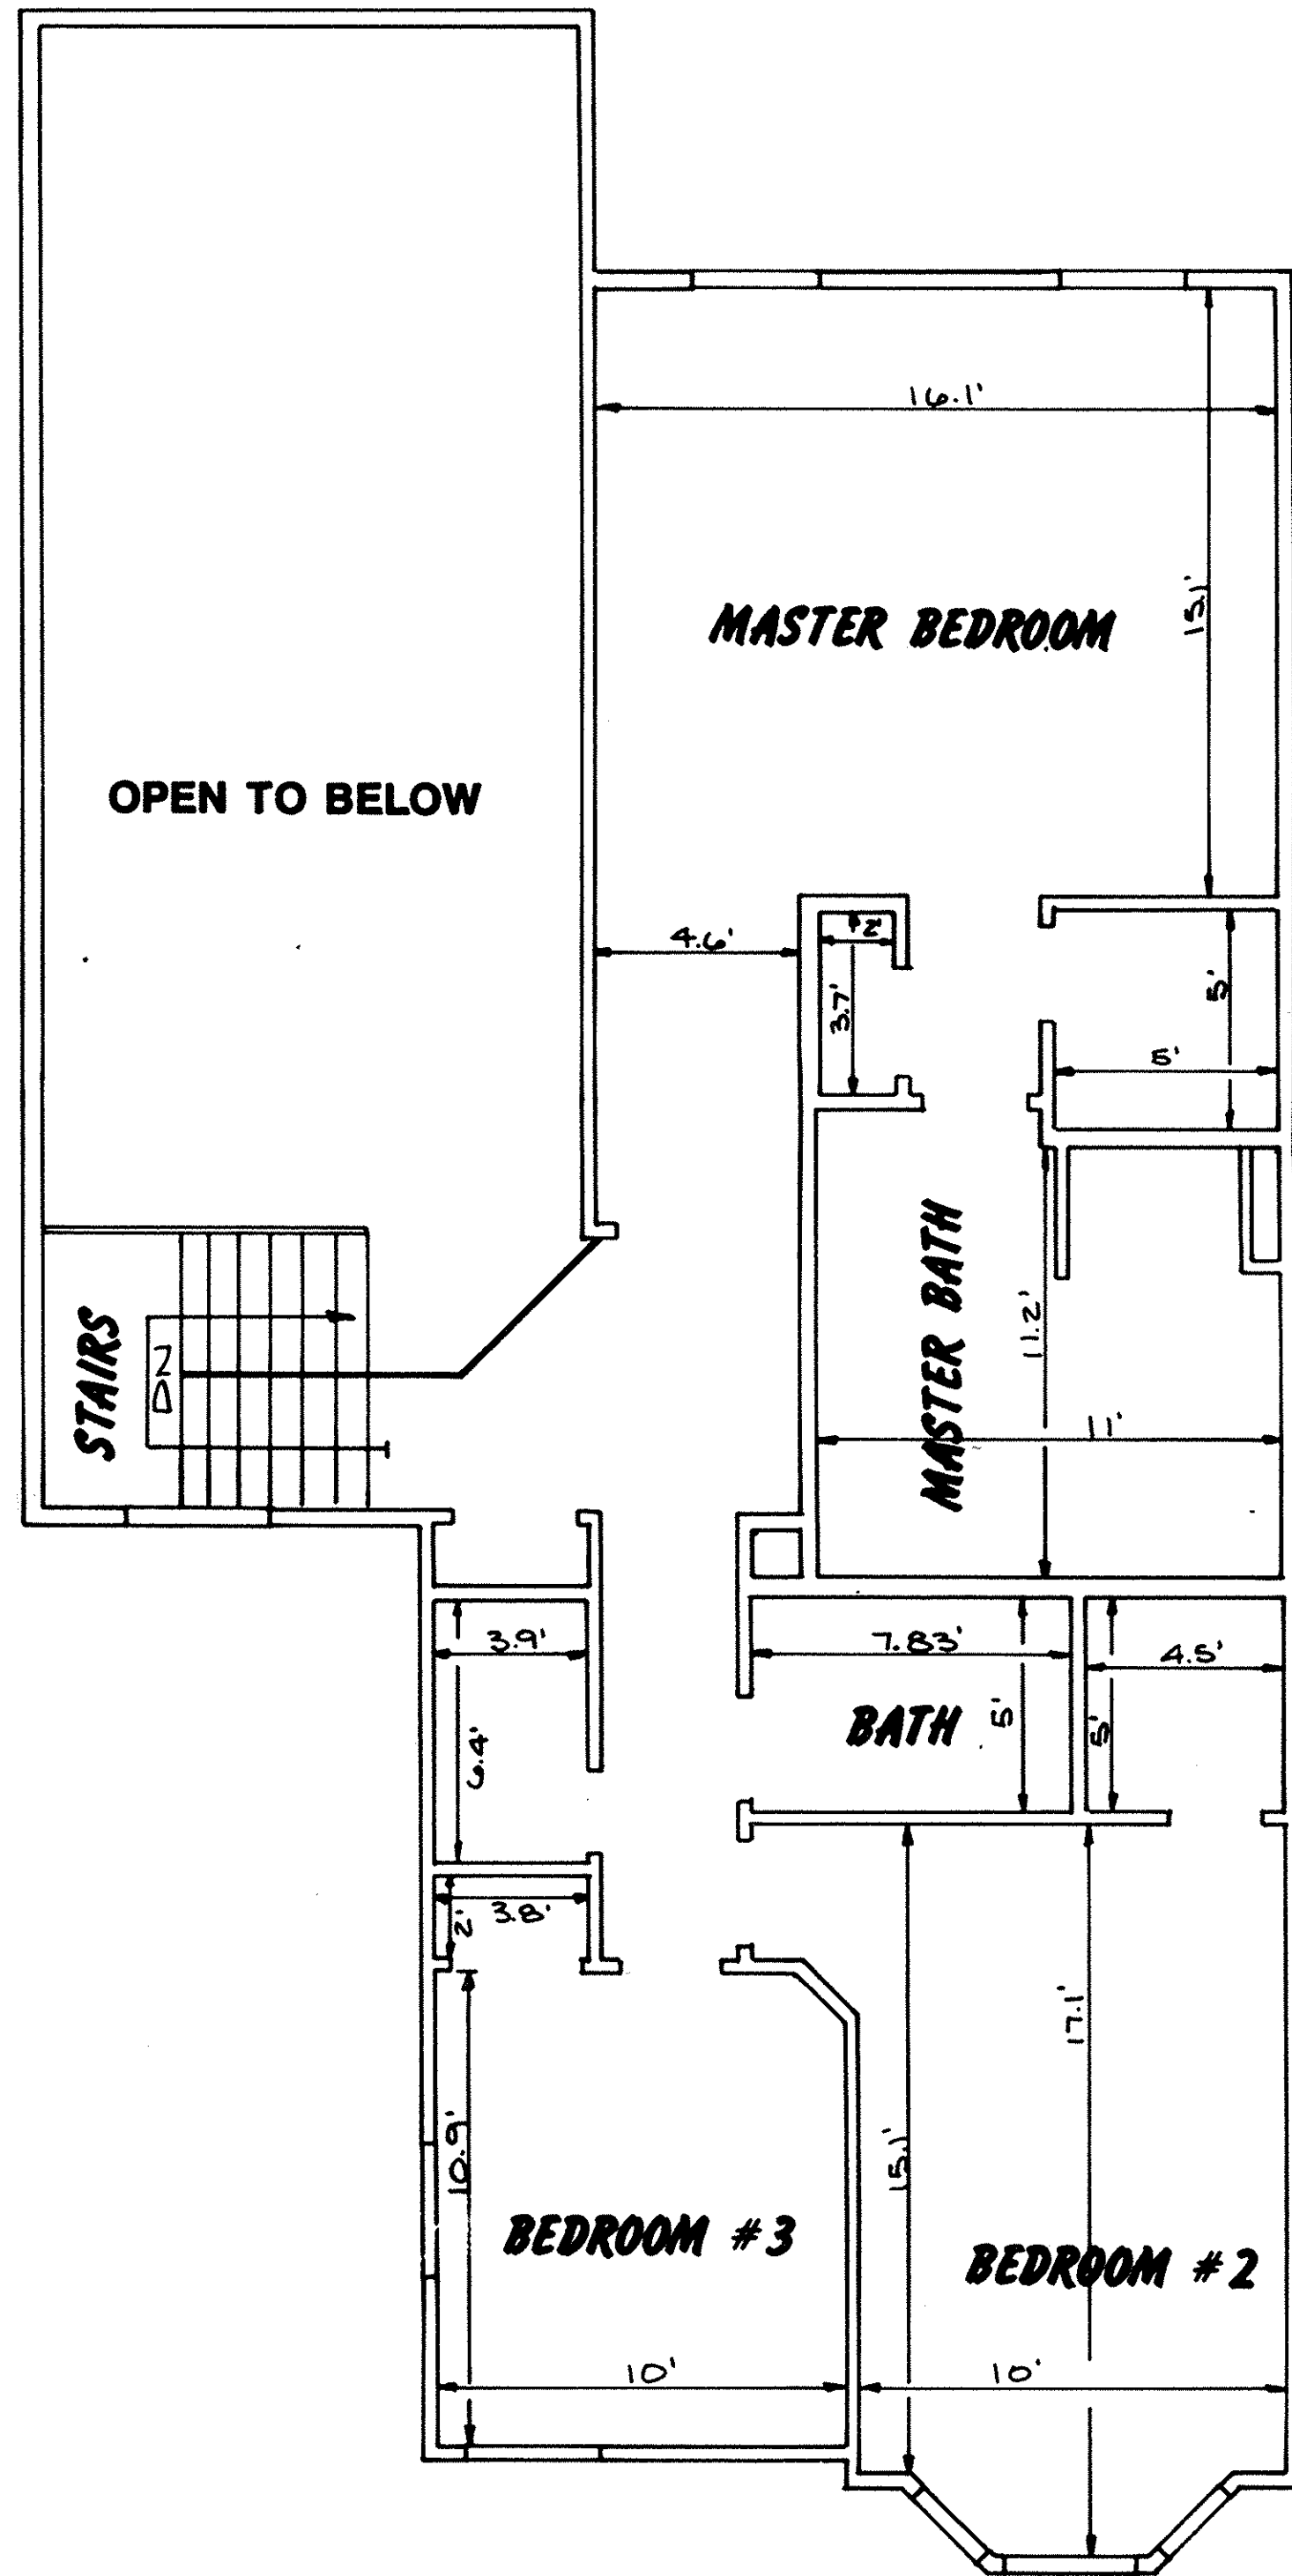


SECOND FLOOR PLAN - UNIT 63-190  
SCALE: 1/4" = 1'-0"


WESTWINDS SOUTH CONDOMINIUM NO.1  
FIFTH AMENDMENT PHASE 6  
FLOOR PLANS

LORAIN COUNTY TAX  
MAP DEPARTMENT COPY

TAX MAP DEPT. COPY

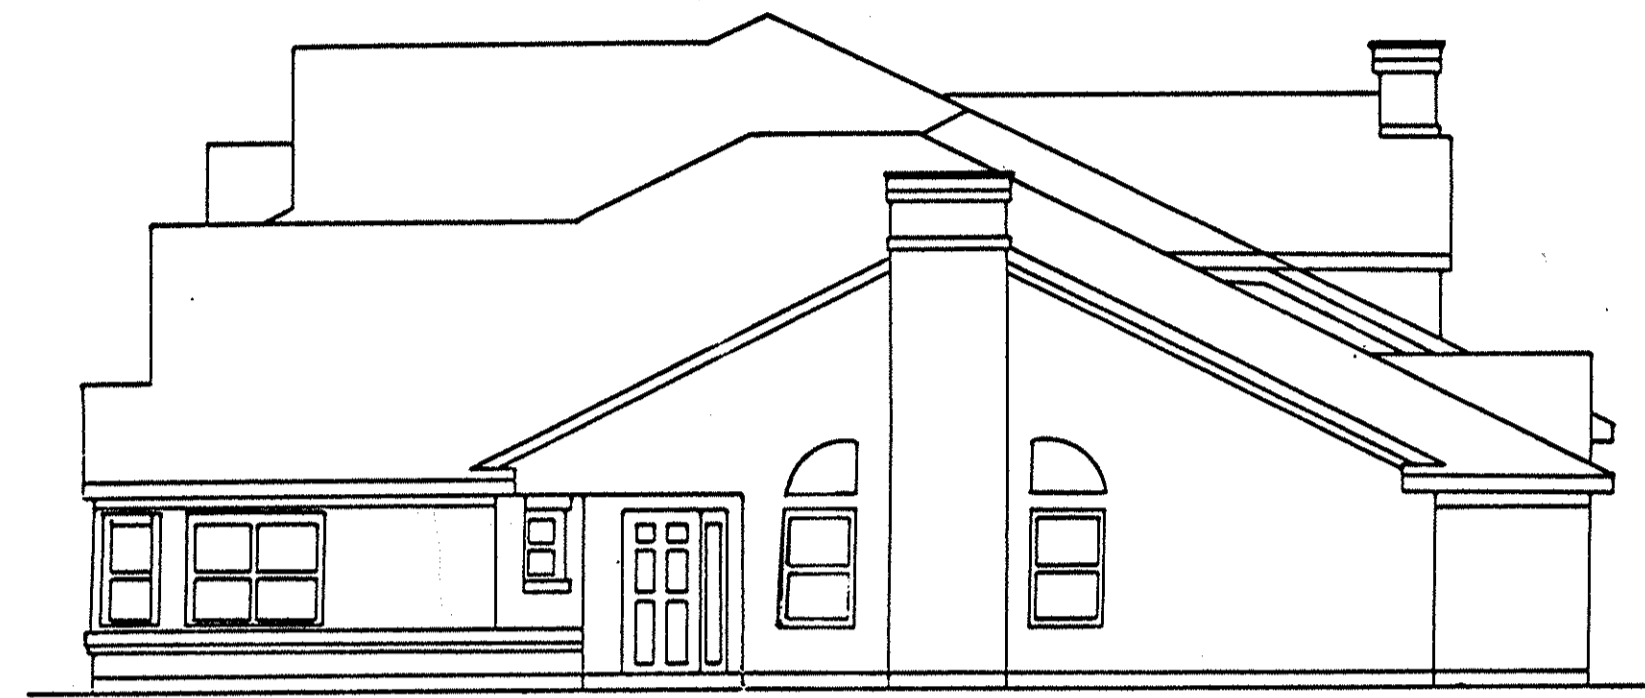

RIGHT SIDE ELEVATION

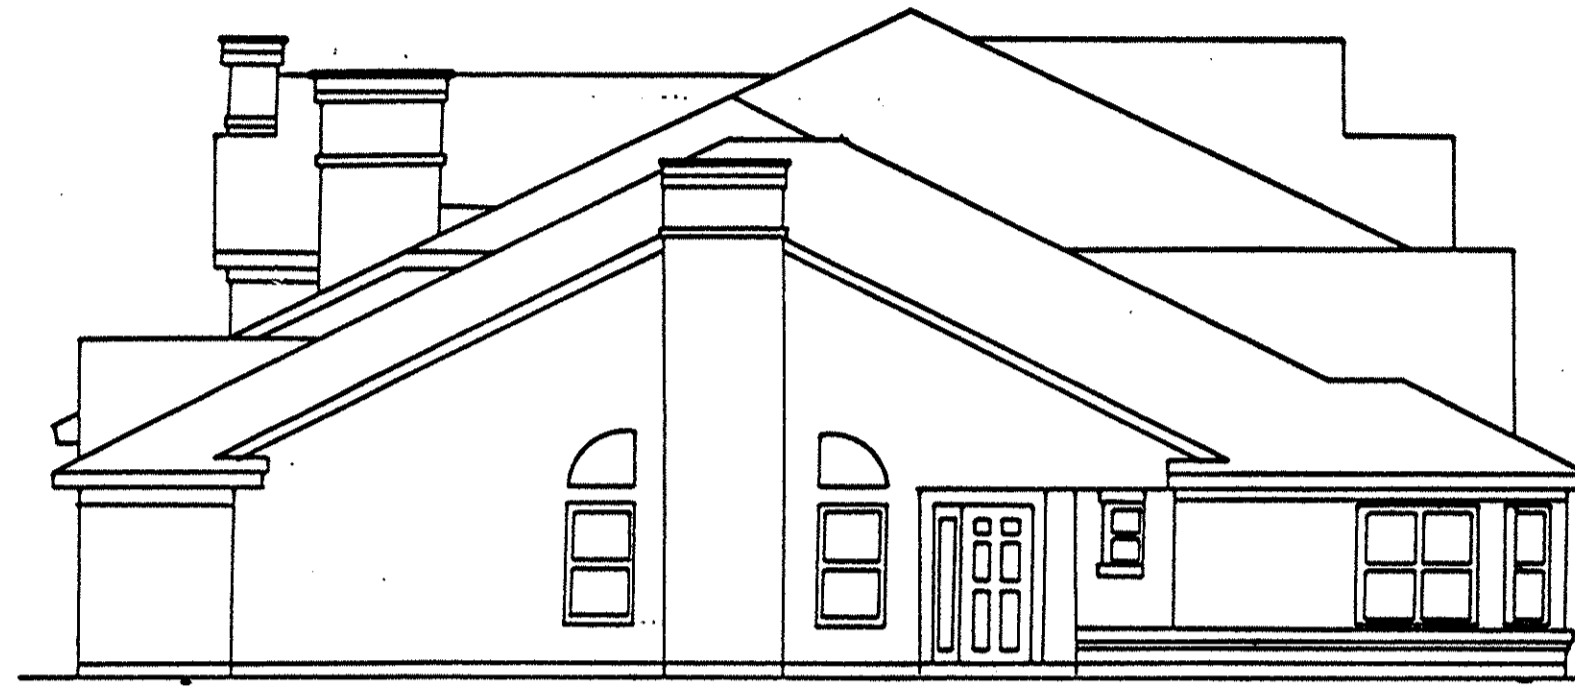

LEFT SIDE ELEVATION



FRONT ELEVATION



REAR ELEVATION

WESTWINDS SOUTH CONDOMINIUM NO.1.  
 FIFTH AMENDMENT PHASE 6  
 EXTERIOR ELEVATIONS

**LORAIN COUNTY TAX  
 MAP DEPARTMENT COPY**

TAX MAP DEPT. COPY