


R.L.R. CONSTRUCTION INC.
05-00-026-101-014
0.59 AC.
O.R. 259 P.12



05-00-026-101-092
R.L.R. CONSTRUCTION INC.
O.R. 259 P.4

05-00-025-101-099
R.L.R. CONSTRUCTION INC.
O.R. 259 P.4

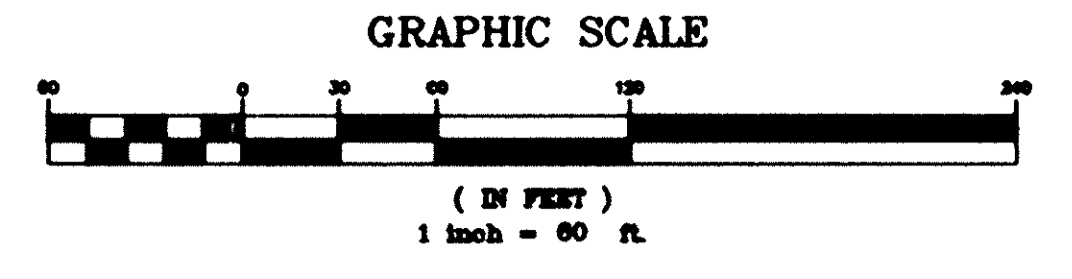


SHEET INDEX

SHT. NO	DESCRIPTION
1 OF 4	SURVEY MAP, FOUNDATION PLAN & MISC.
2 OF 4	FIRST FLOOR PLAN
3 OF 4	SECOND FLOOR PLAN
4 OF 4	EXTERIOR ELEVATIONS

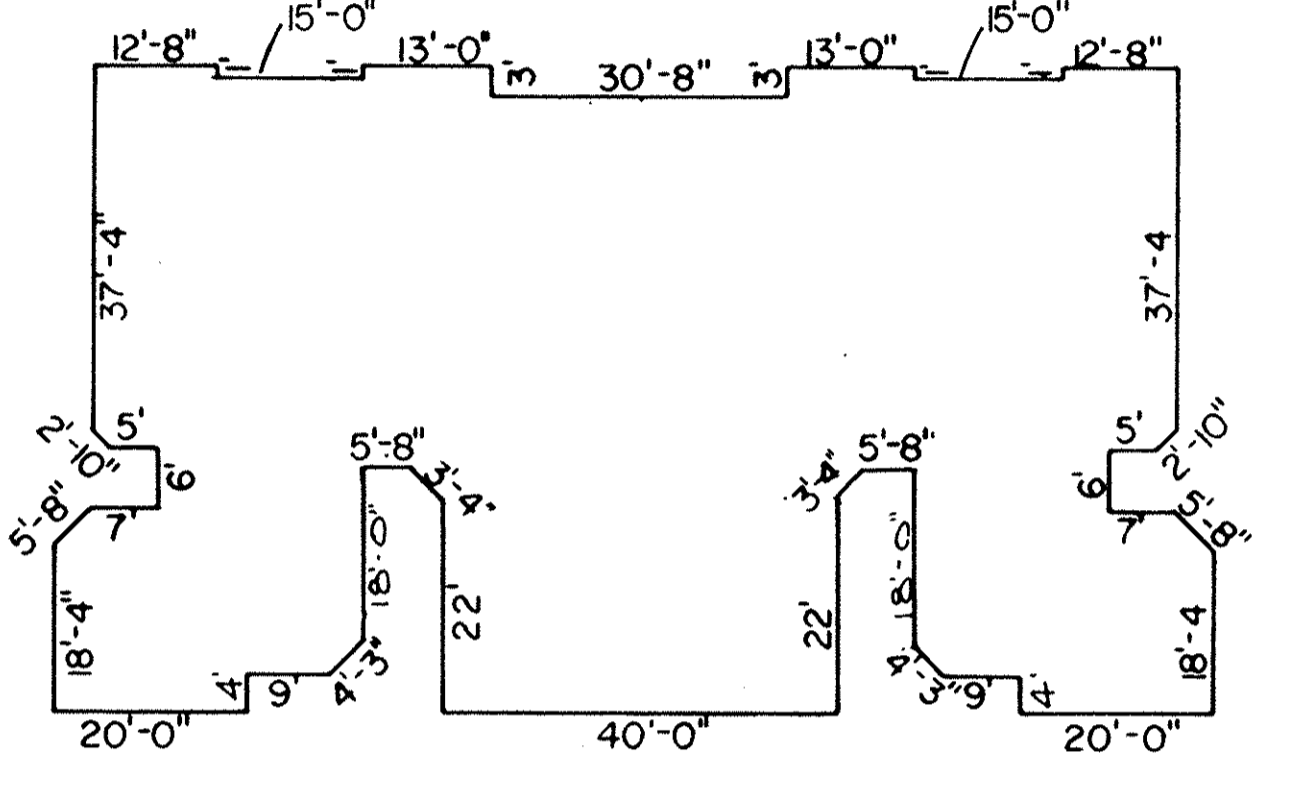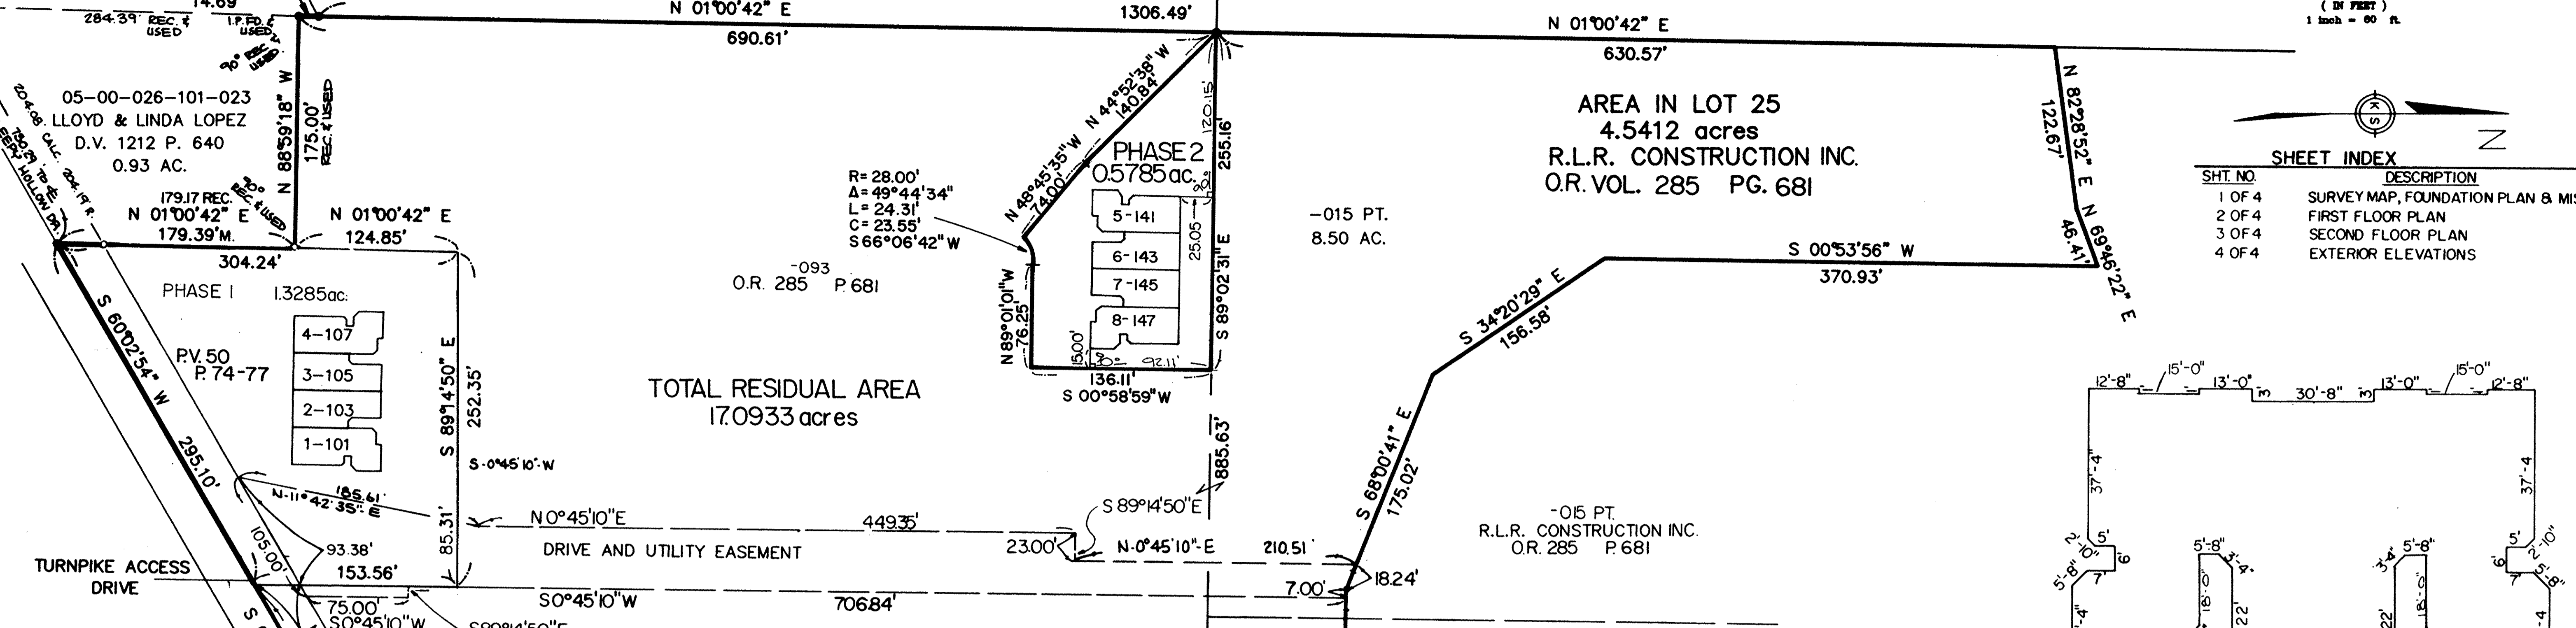

FOUNDATION PLAN
SCALE: 1" = 20"

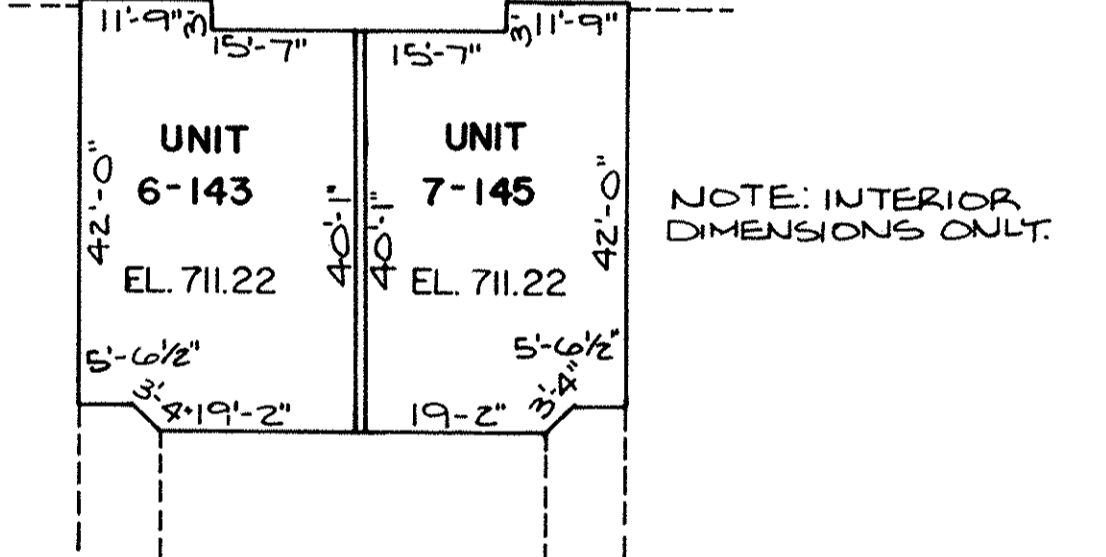


BASEMENT PLAN
SCALE: 1" = 20"

OWNERSHIP TABLE

UNIT NO.	SQ. FT.	ELEV. 1ST FL.	% OWNERSHIP
1-101	1388	723.40	9.51
2-103	1626	723.40	11.15
3-105	1769	723.40	12.13
4-107	1388	723.40	9.51
5-141	1388	719.38	9.51
6-143	2751	719.38	18.85
7-145	2894	719.38	19.83
8-147	1388	719.38	9.51
	14592		100.00

LORAIN COUNTY TAX
MAP DEPARTMENT COPY

- LEGEND**
- IRON PIN FOUND
 - IRON PIN SET
 - MON. BOX SET

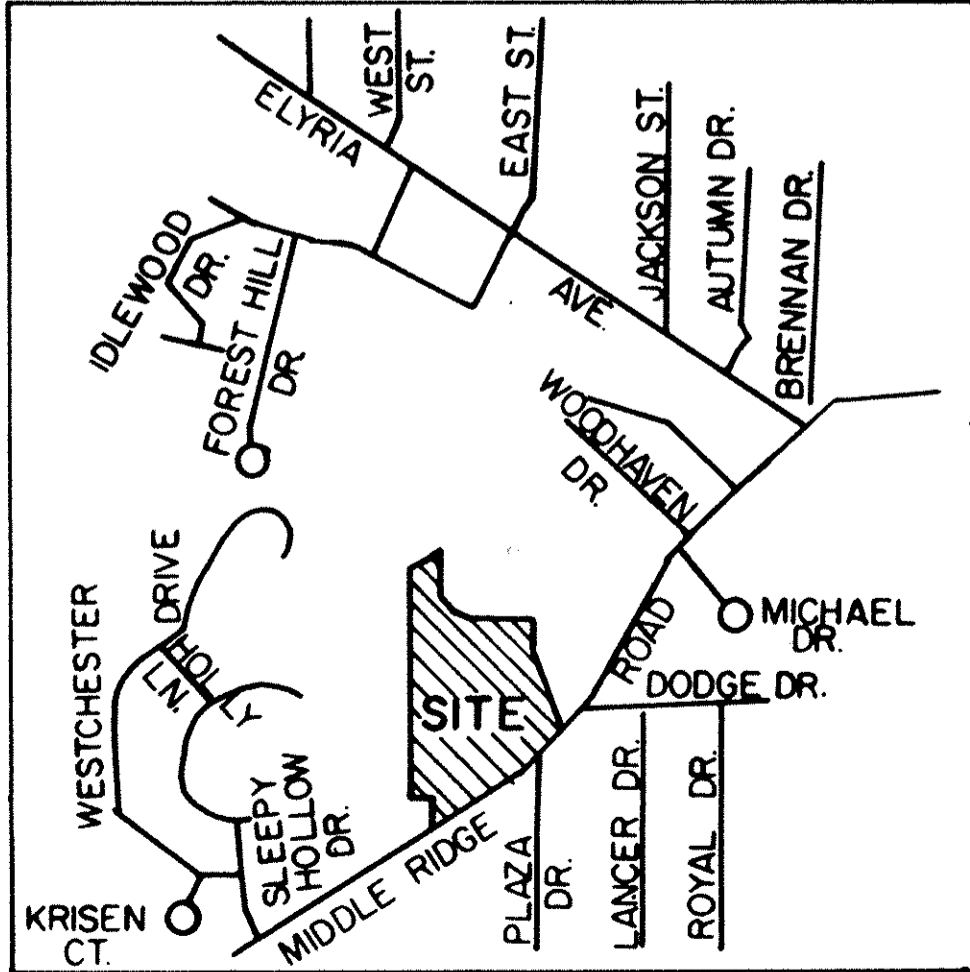

AREA MAP NO SCALE

Δ = 09°23'43"
R = 1352.97' REC & USED
T = 111.18'
L = 221.86' REC & USED
C = 221.81'
N 50°03'54" E


REVISIONS

NO.	DATE	DESCRIPTION

CERTIFICATION
THIS IS TO CERTIFY THAT THE ATTACHED DRAWINGS CORRECTLY REPRESENT THE BUILDINGS AS CONSTRUCTED AND THAT THERE ARE NO ENCROACHMENTS ON ADJUTING PROPERTIES.

David L. Elwell
DAVID L. ELWELL
REG. SURVEYOR NO. 6333

Lynn S. Miggins
LYNN S. MIGGINS
REG. ENGINEER NO. 46837

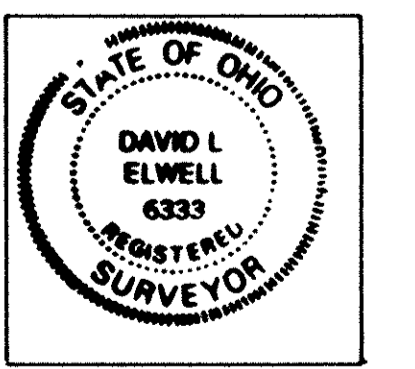


Received for Record AUG 6 - 1993
at 2:40 P.M. in RECORD
VOL. 51 MARY ANN JAMISON
PAGE 23 Lorain County Recorder
B44LCTC 172.80
LM 240 Dec 196.80

TRANSFERRED
IN COMPLIANCE WITH SEC. 319-202
OHIO REV. CODE
AUG 6 1993
JULIAN A. PIJOR
LORAIN COUNTY AUDITOR

THE ENGLISH LAKES CONDOMINIUMS
PHASE 2
PART OF AMHERST TWP. O.L. 25 & 26
CITY OF AMHERST*COUNTY OF LORAIN*STATE OF OHIO

KS ASSOCIATES, INC.
ENGINEERS/SURVEYORS
424 Middle Avenue
P.O. Box 89
Elyria, Ohio 44038
ELYRIA (216) 322-6317 * LORAIN (216) 244-5757


ENGINEERS/SURVEYORS
KS ASSOCIATES INCORPORATED
SHEET 1 OF 4
JOB NO. 89224-cp2

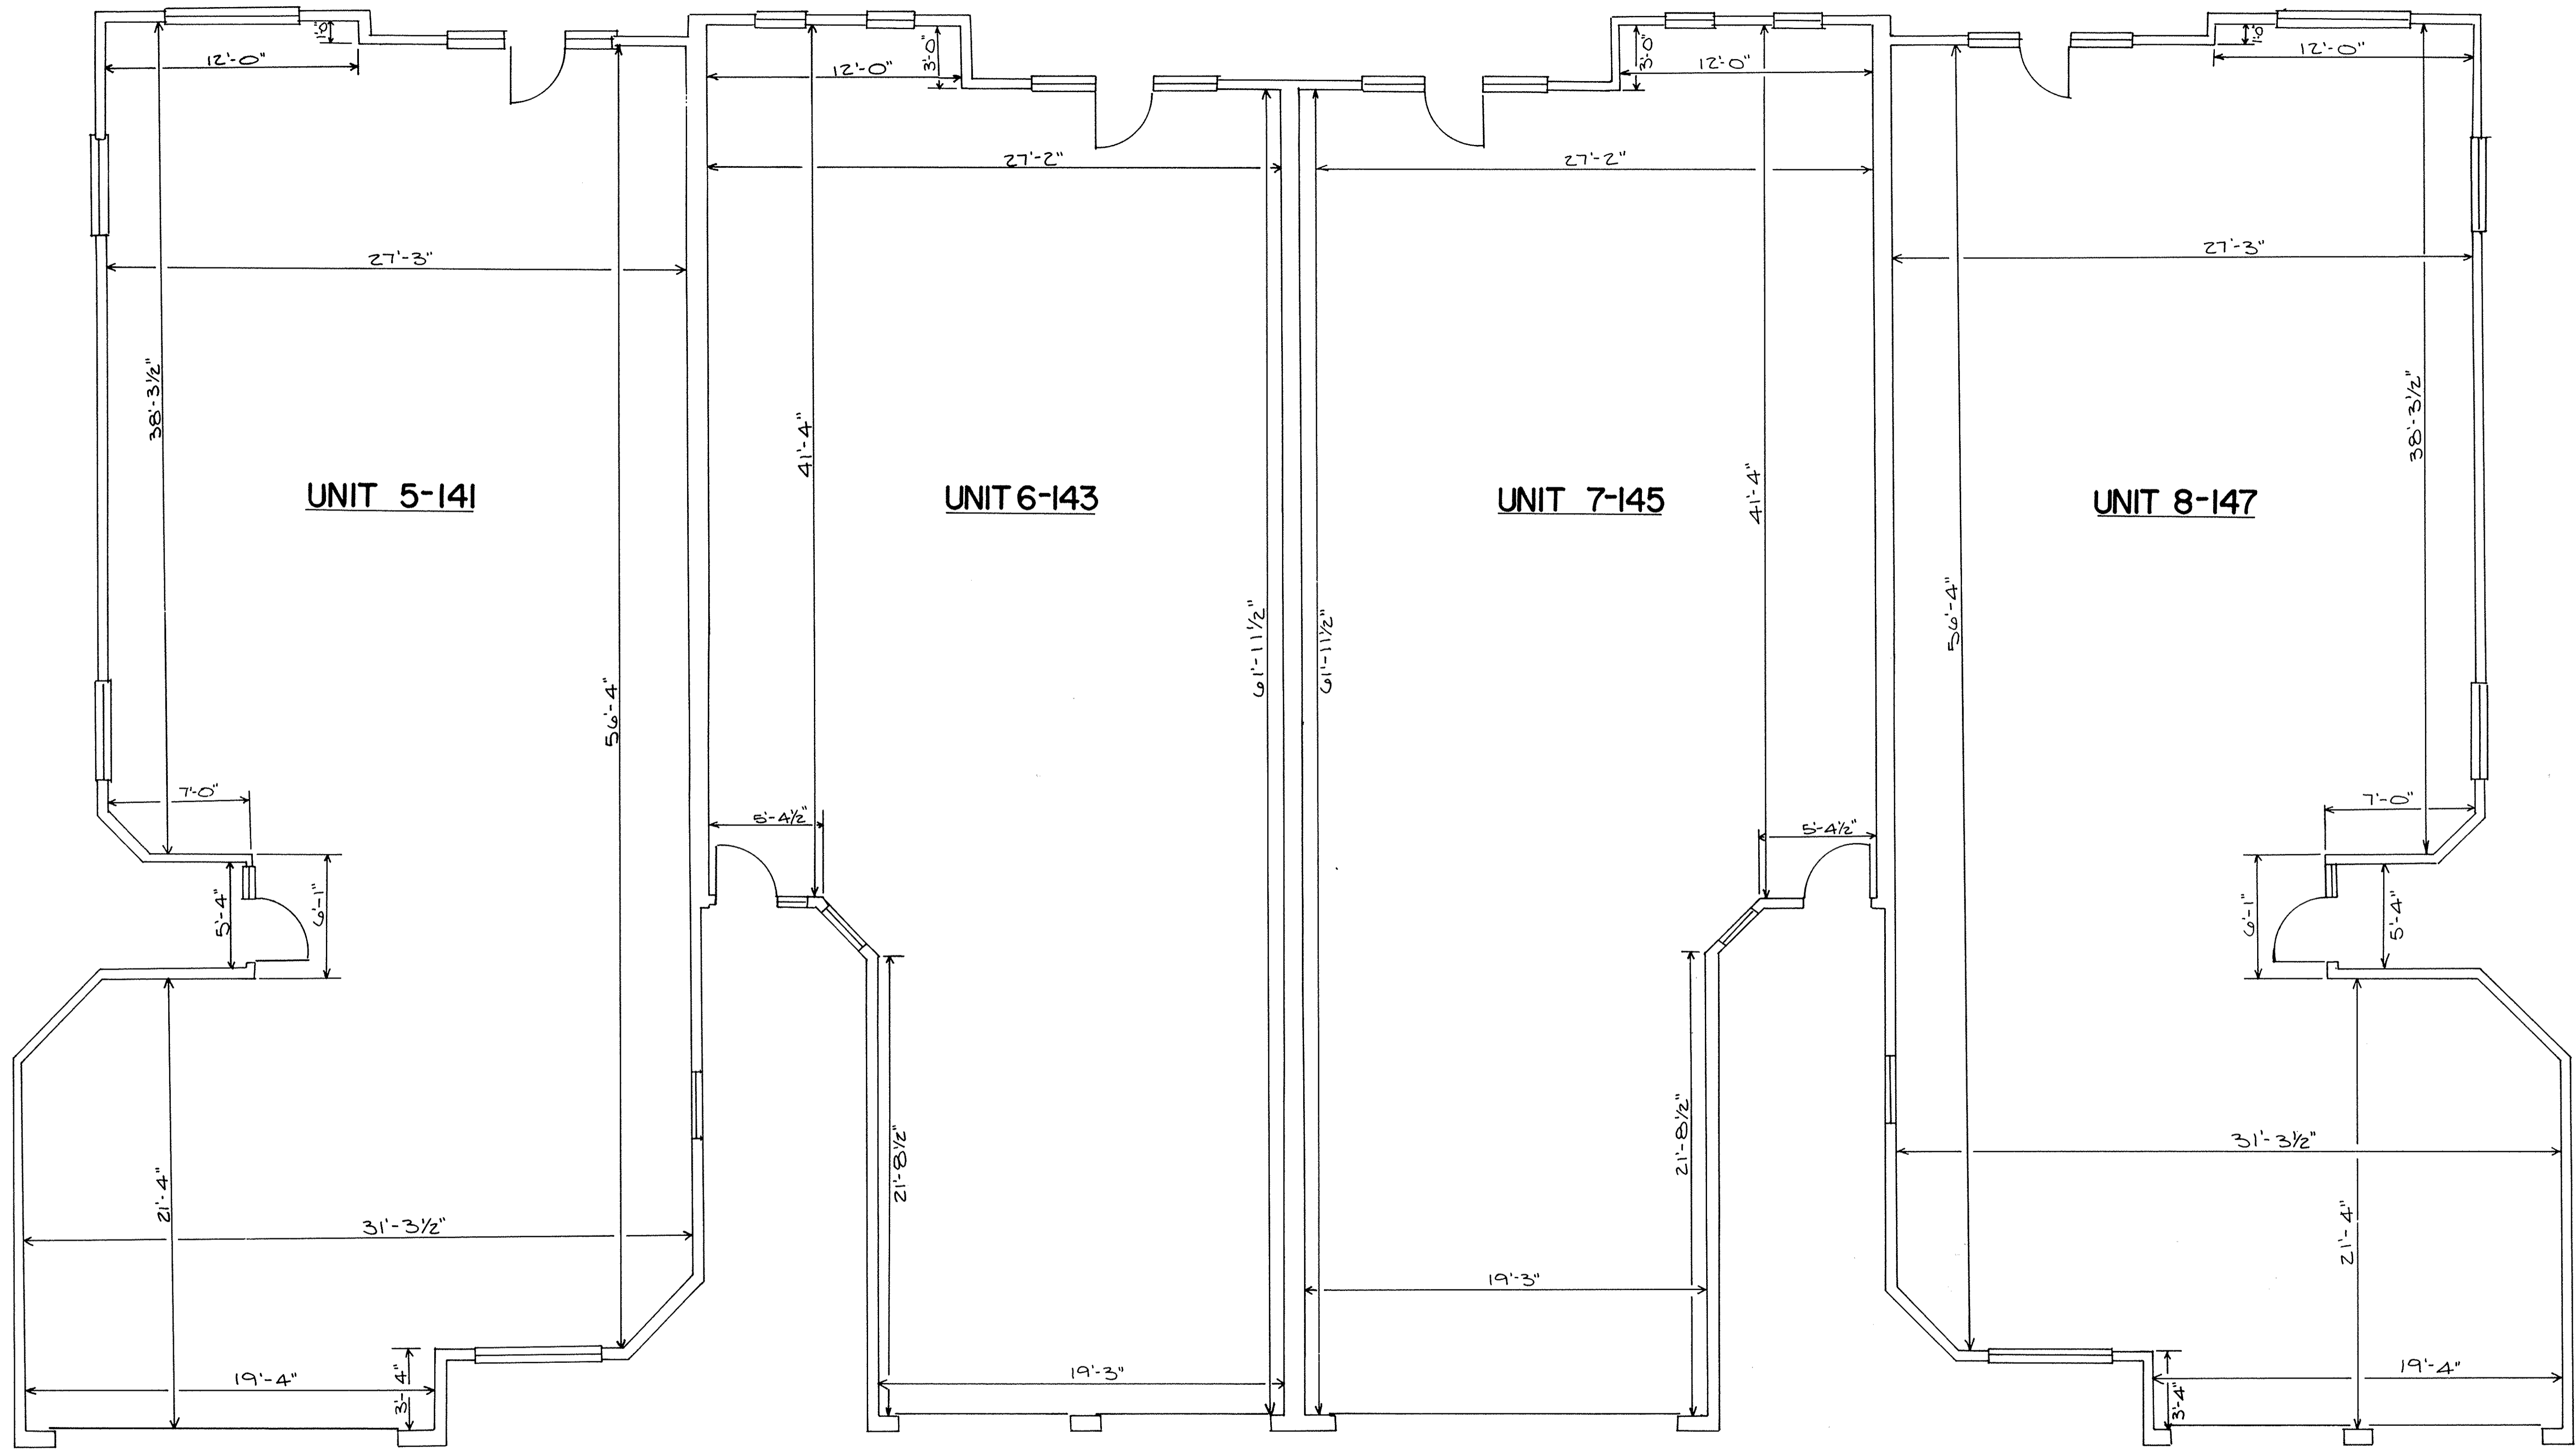

FIRST FLOOR PLAN
 SCALE: 1/4"=1'-0"

ENGLISH LAKES CONDOMINIUMS PHASE 2
 FIRST FLOOR PLAN

LORAIN COUNTY TAX
MAP DEPARTMENT COPY

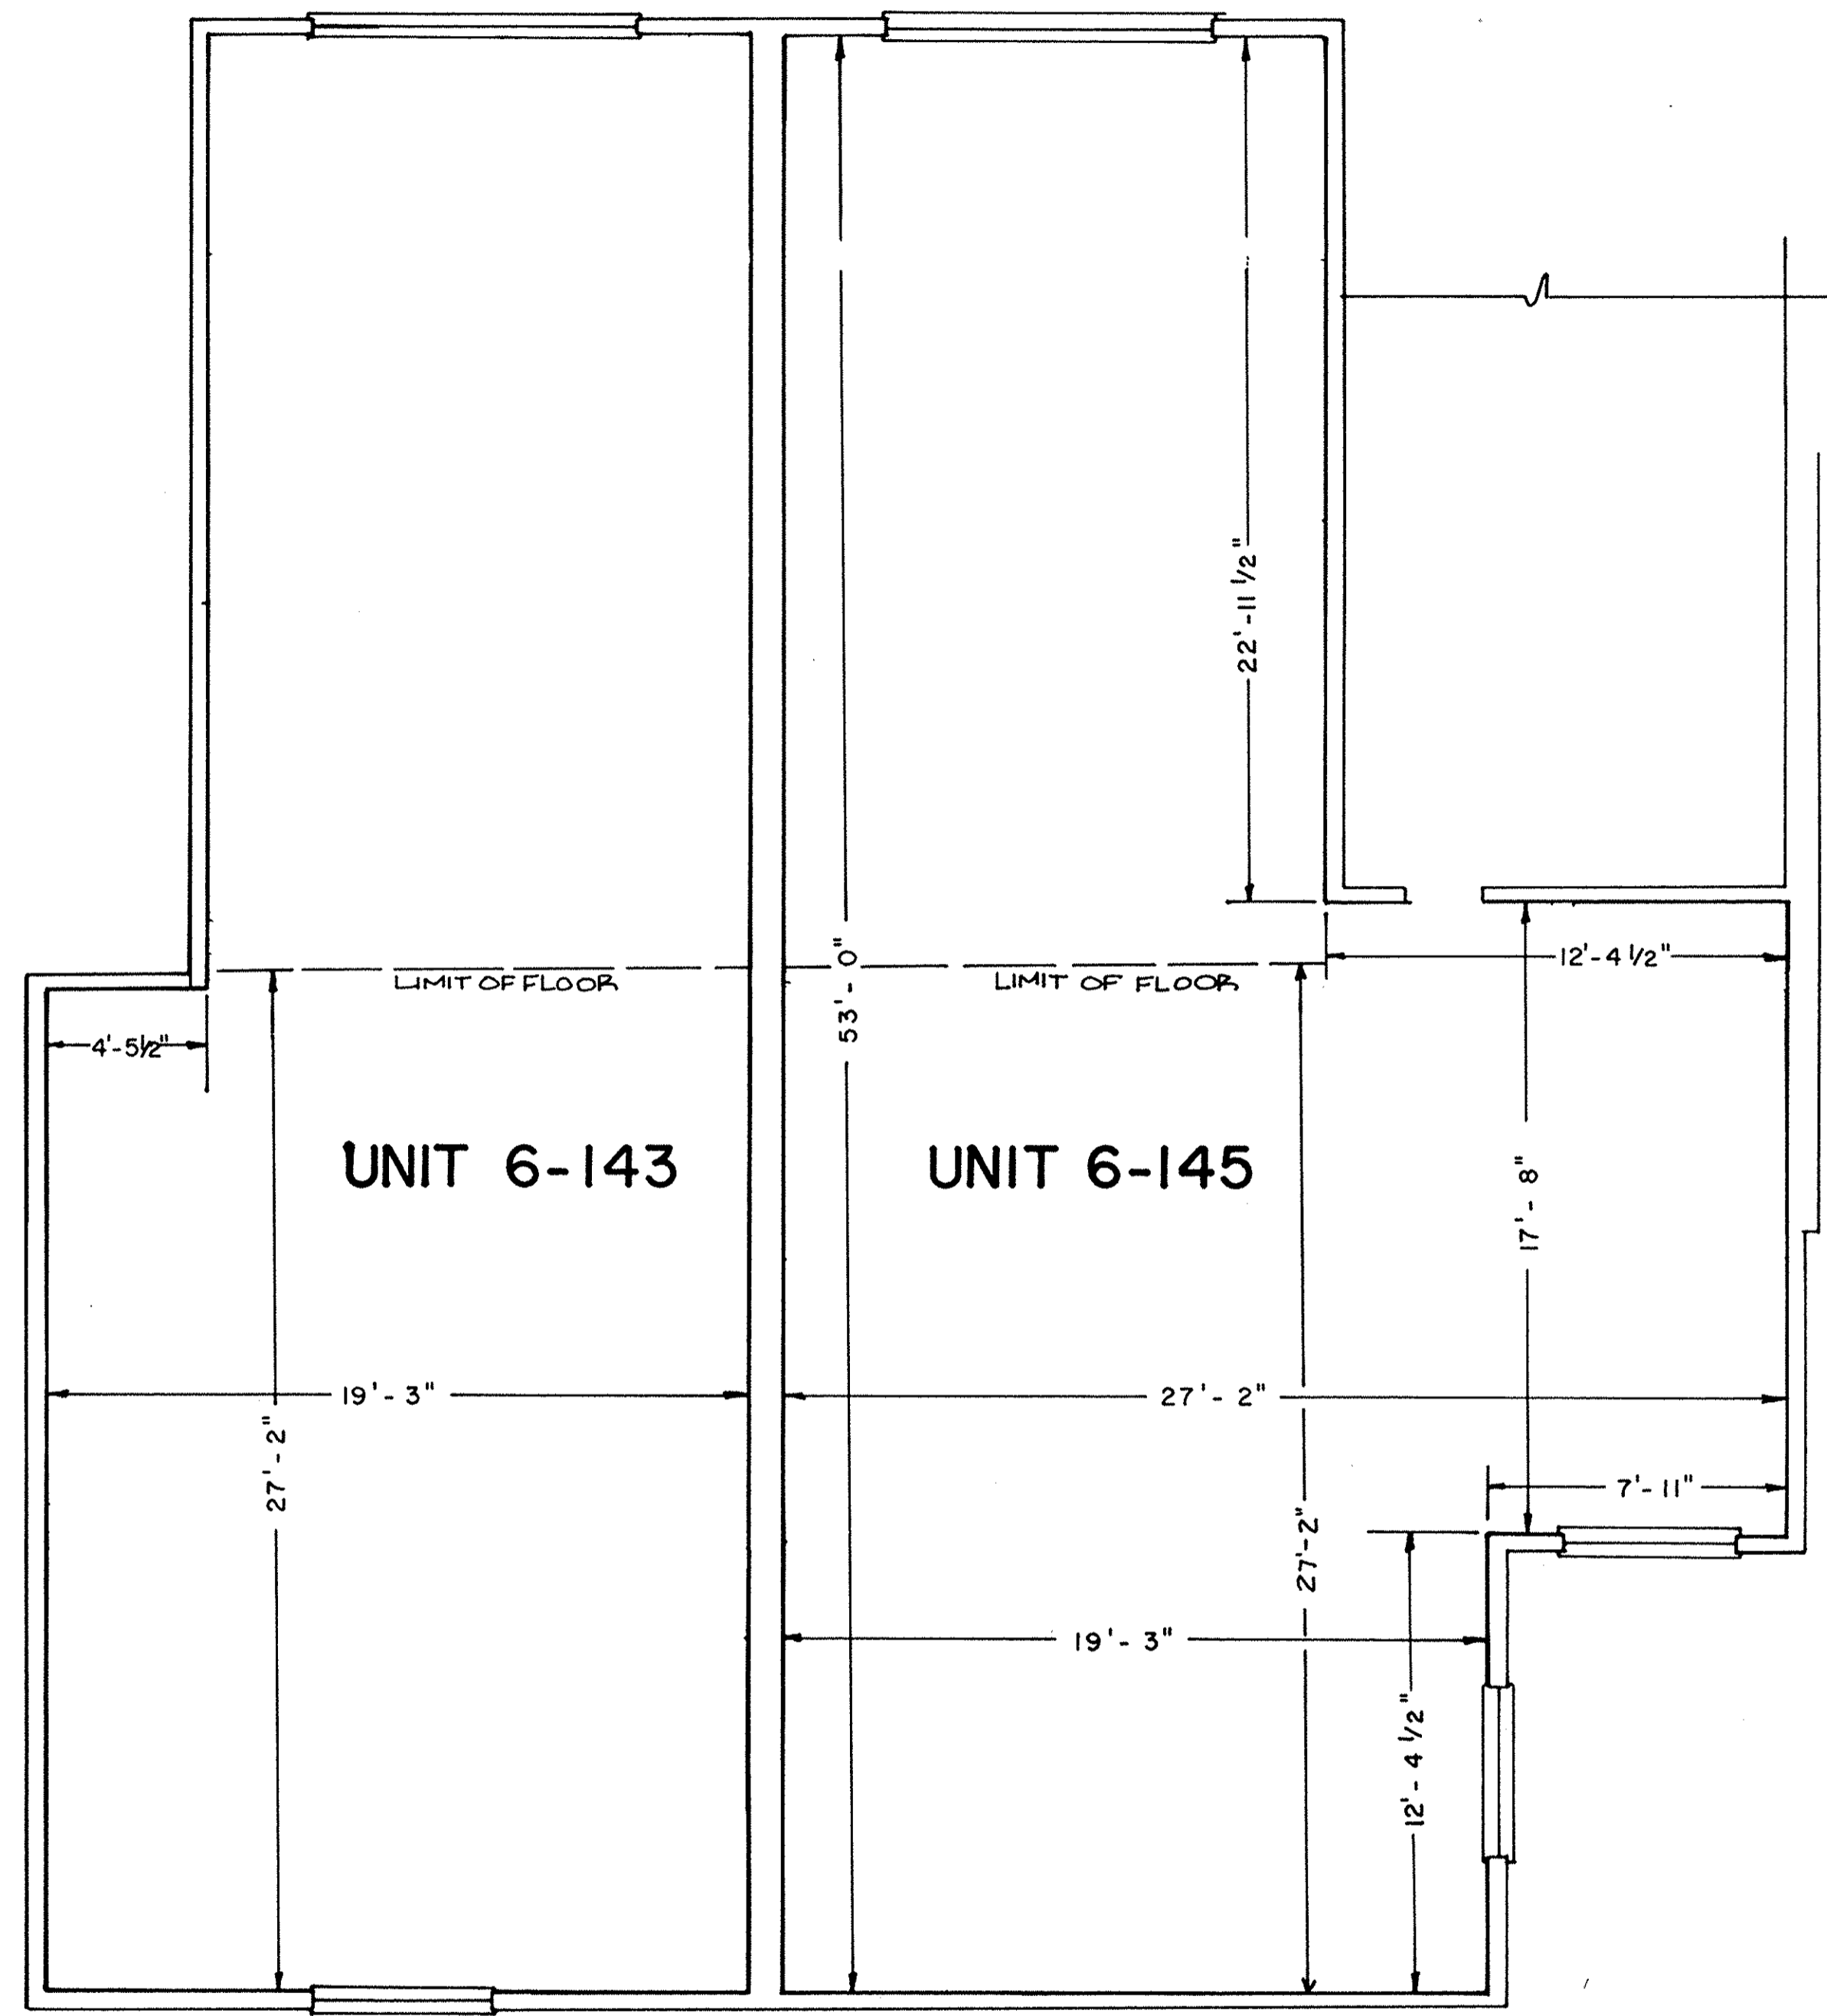

SECOND FLOOR PLAN


SCALE: 1/4" = 1'-0"

ENGLISH LAKES CONDOMINIUMS PHASE 2
SECOND FLOOR PLAN


LORAIN COUNTY TAX
MAP DEPARTMENT COPY



FRONT ELEVATION

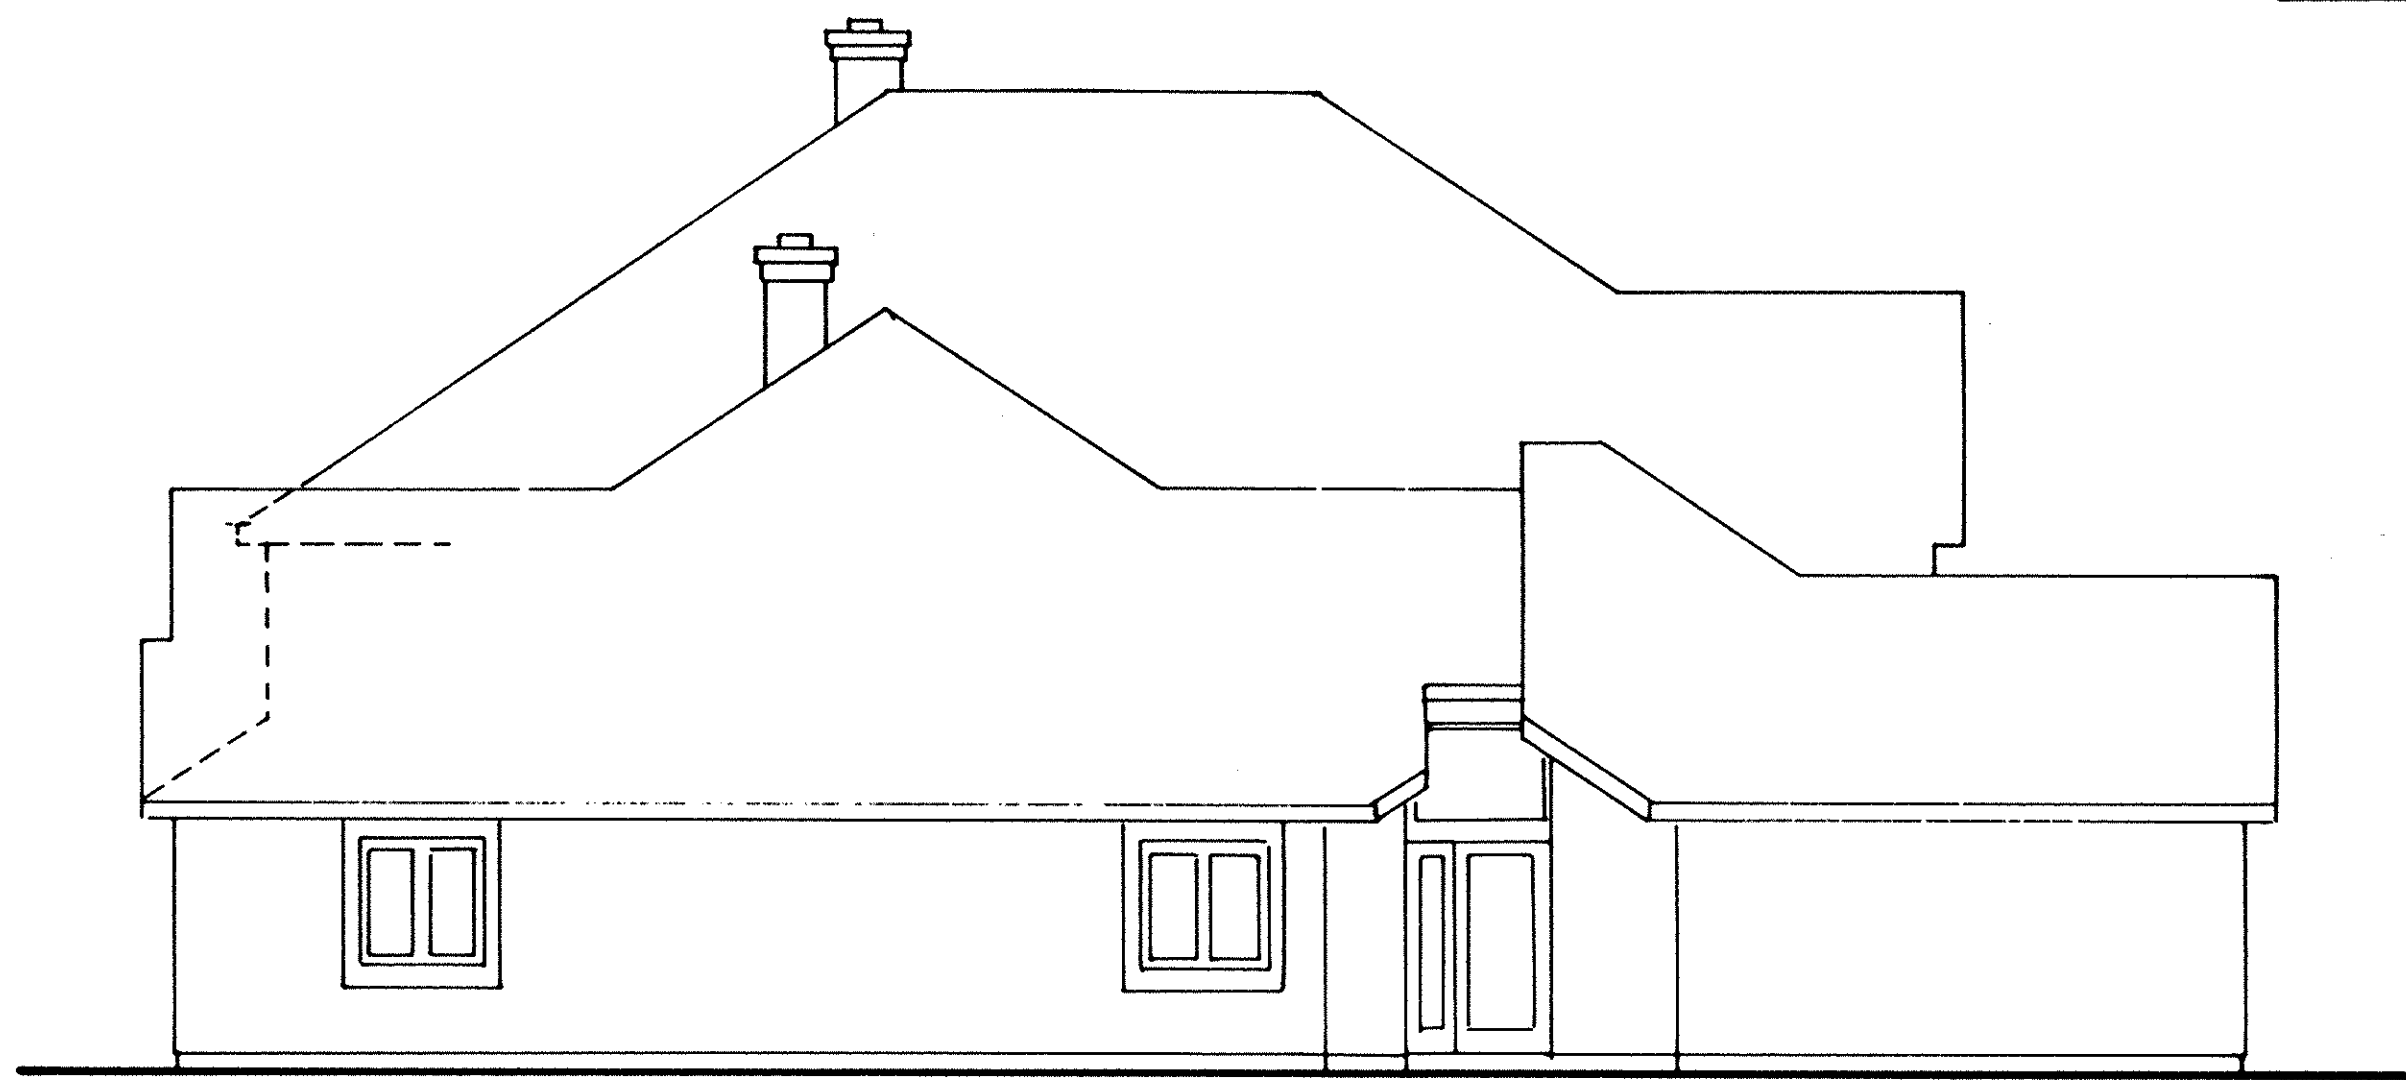

LEFT SIDE ELEVATION

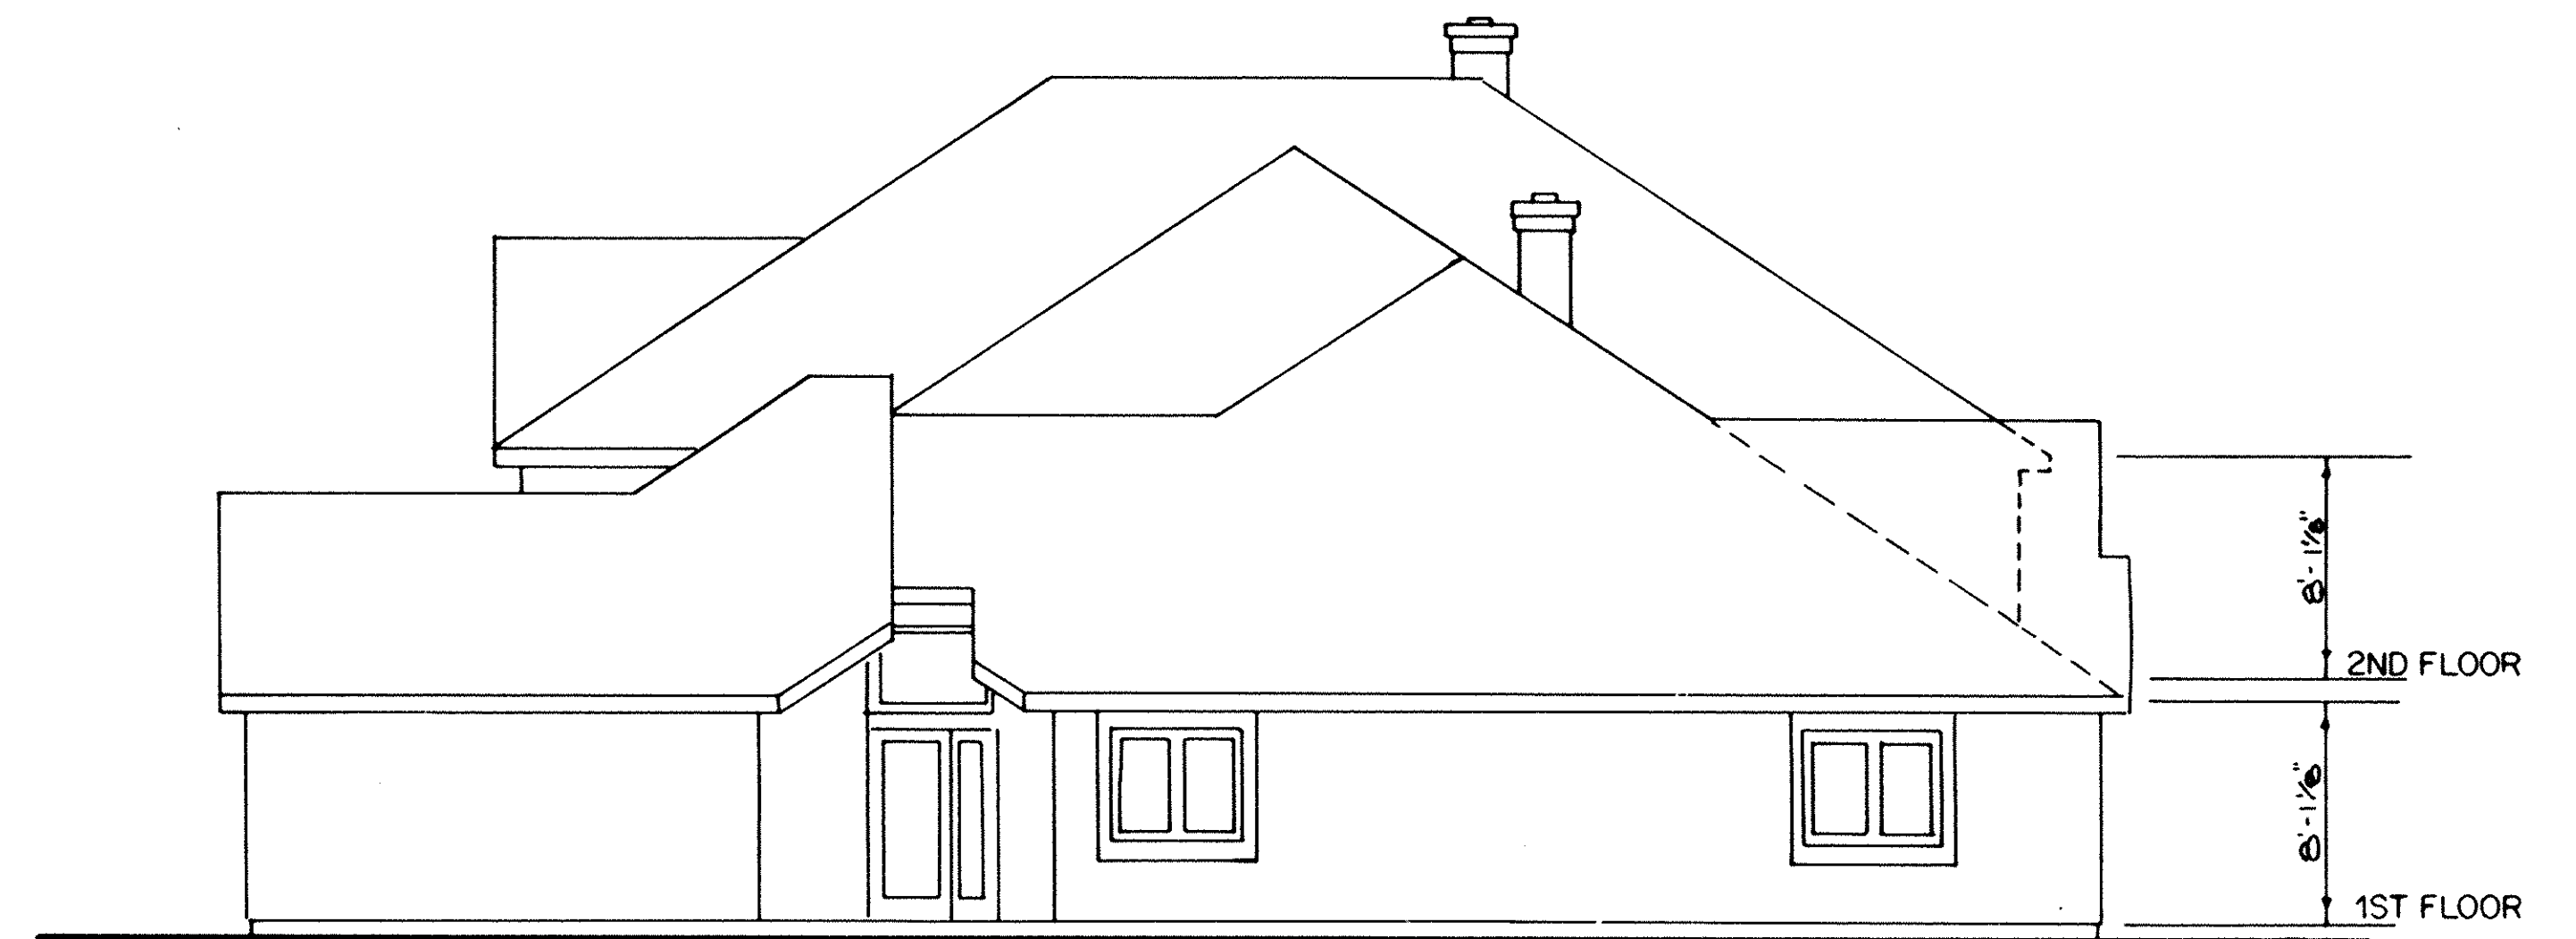

RIGHT SIDE ELEVATION



REAR ELEVATION

ENGLISH LAKES CONDOMINIUMS PHASE 2
EXTERIOR ELEVATIONS

LORAIN COUNTY TAX
MAP DEPARTMENT COPY