

R=130.00'  
A=204.15'  
C=183.81'  
Δ=89°58'28"  
S=46°01'58"E

R=100.00'  
A=157.04'  
C=141.40'  
Δ=89°58'28"  
S=46°01'58"E

R=105.00'  
A=92.71'  
C=89.73'  
Δ=50°35'18"  
S=26°20'23"E

R=255.00'  
A=160.91'  
C=158.26'  
Δ=36°09'22"  
N=72°51'37"E

P=230.96'  
A=64.83'  
C=64.63'  
Δ=10°05'00"  
S=43°55'24"E

R=135.00'  
A=119.86'  
C=119.84'  
Δ=87°25'46"  
S=5°15'37"E


R=135.00'  
A=119.86'  
C=119.84'  
Δ=87°25'46"  
S=5°15'37"E

-067  
LORAIN COUNTY MEDICAL SOCIETY  
FOUNDATION INC.  
O.R.V. 385 P.638

-077  
LORAIN COUNTY MEDICAL SOCIETY  
FOUNDATION INC.  
O.R.V. 655 P.716

-068  
HIGHLAND DEVELOPMENT CO.  
O.R.V. 353 P.444

-081  
THT CORPORATION  
O.R.V. 293 P.862

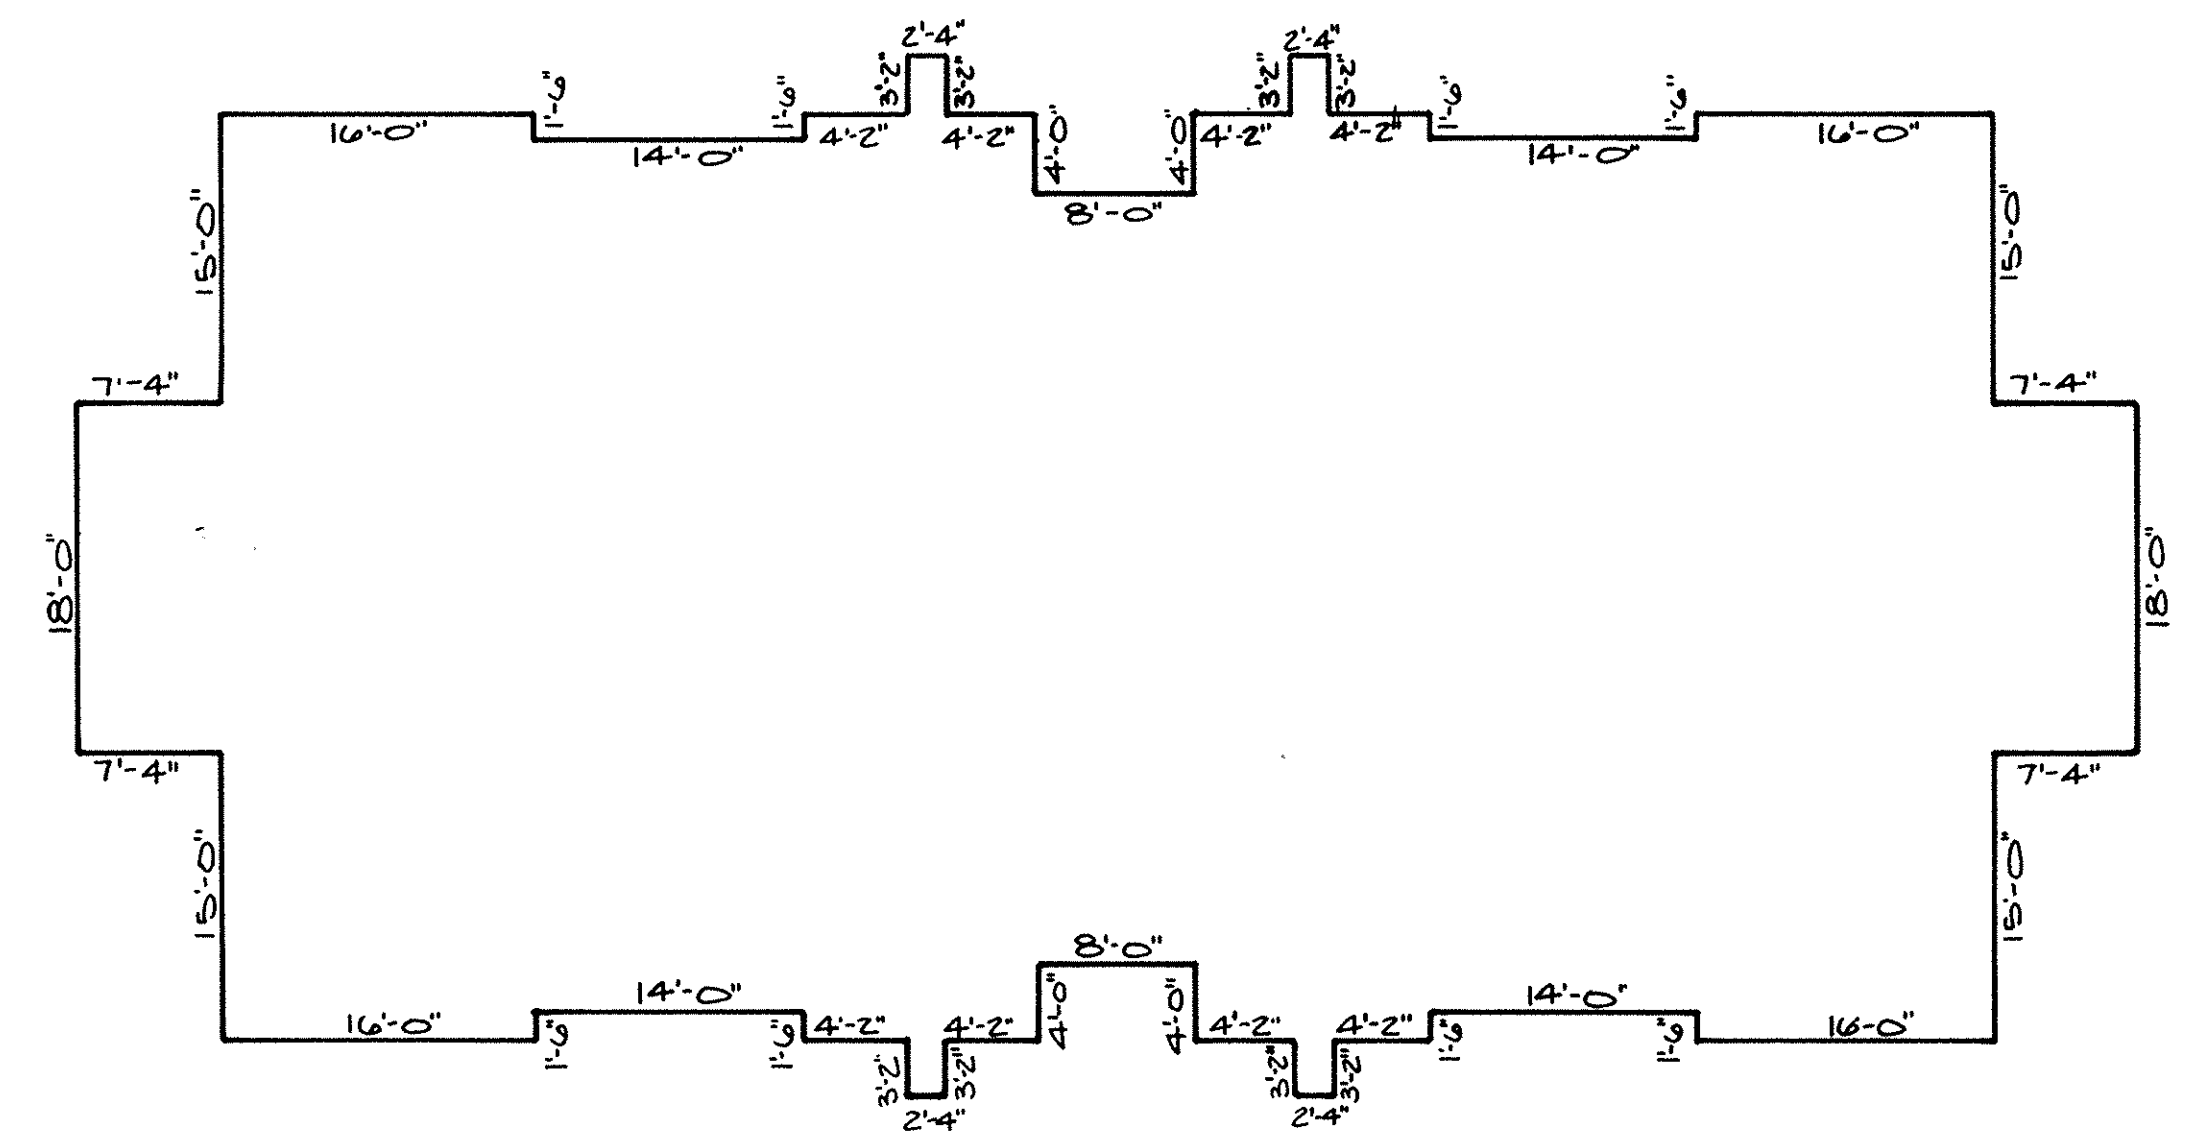

UNIT #	SQ. FT.	% OF OWNERSHIP
1	1374	25.00
2	1374	25.00
3	1374	25.00
4	1374	25.00
TOTAL	5496	100.00

SHEET NO.	DESCRIPTION
1	SURVEY MAP, FOUNDATION PLAN, AREA MAP & MISC.
2	EXTERIOR ELEVATIONS & FLOOR PLANS

UNIT	FIRST FLR. ELEV.	SECOND FLR. ELEV.
1	686.60	697.27
2	686.60	697.27
3	686.60	697.27
4	686.60	697.27


**NORTH COLLEGE COMMONS CONDOMINIUMS PHASE NO. 1**

BEING PART OF  
SHEFFIELD TOWNSHIP ORIGINAL LOT NO. 1  
VILLAGE OF SHEFFIELD COUNTY OF LORAIN STATE OF OHIO

**CERTIFICATION**  
THIS IS TO CERTIFY THAT THE ATTACHED DRAWINGS CORRECTLY REPRESENT THE BUILDINGS AS CONSTRUCTED AND THAT THERE ARE NO ENCROACHMENT ON ADJUTING PROPERTIES.

DAVID L. ELWELL  
REG. SURVEYOR NO. 6333

LYNN S. MIGINNS  
REG. ENGINEER NO. 46837

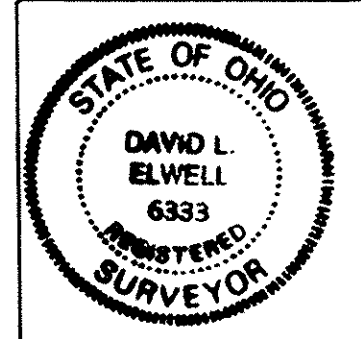


**LORAIN COUNTY TAX  
MAP DEPARTMENT COPY**


PREPARED BY:  
**KS ASSOCIATES INC.**  
ENGINEERS SURVEYORS  
06-28-93  
REV. 07-29-93 ADDING PARCEL OWNERSHIPS

Received for Record, AUG 6 1993  
at 2:00 clock M. 10247 RECORD  
VOL. 51 MARY ANN JAMISON  
PAGE 226 Lorain County Recorder  
Boyle Co. 84.40  
L.M. Dec. 35200


TRANSFERRED  
IN COMPLIANCE WITH SEC. 319.202  
OHIO REV. CODE  
AUG 6 1993  
JULIAN A. PIJOR  
LORAIN COUNTY AUDITOR

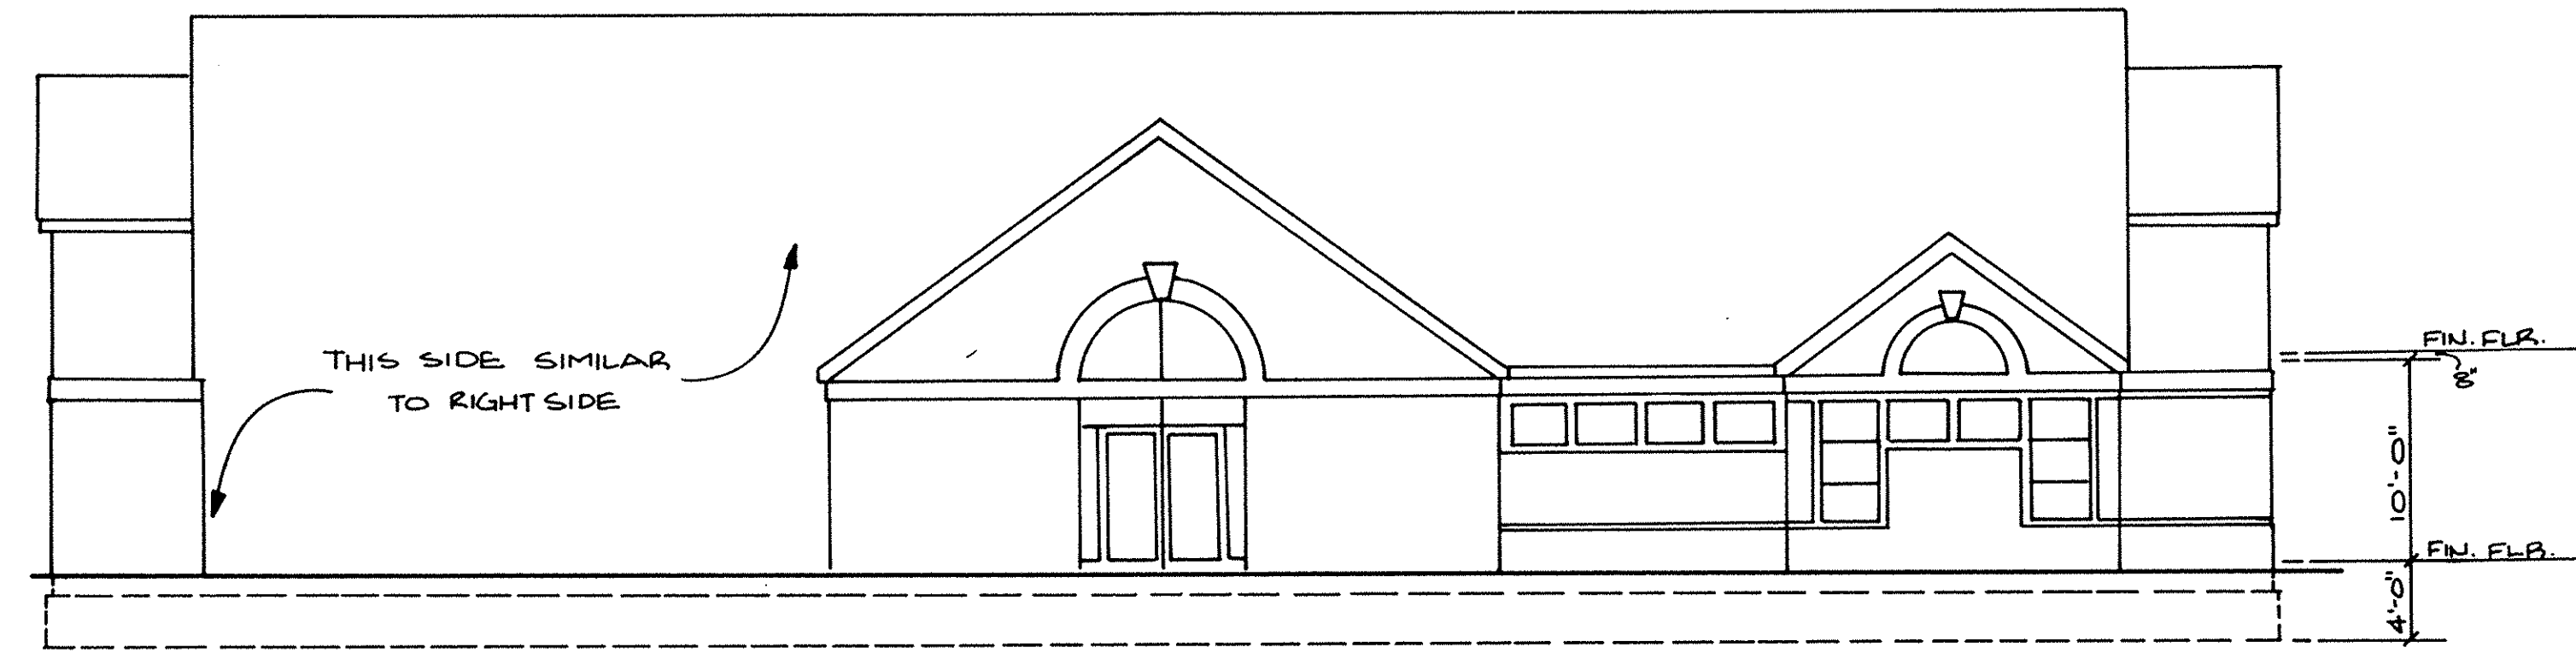


**FRONT ELEVATION**  
SCALE: 1/8"=1'-0"

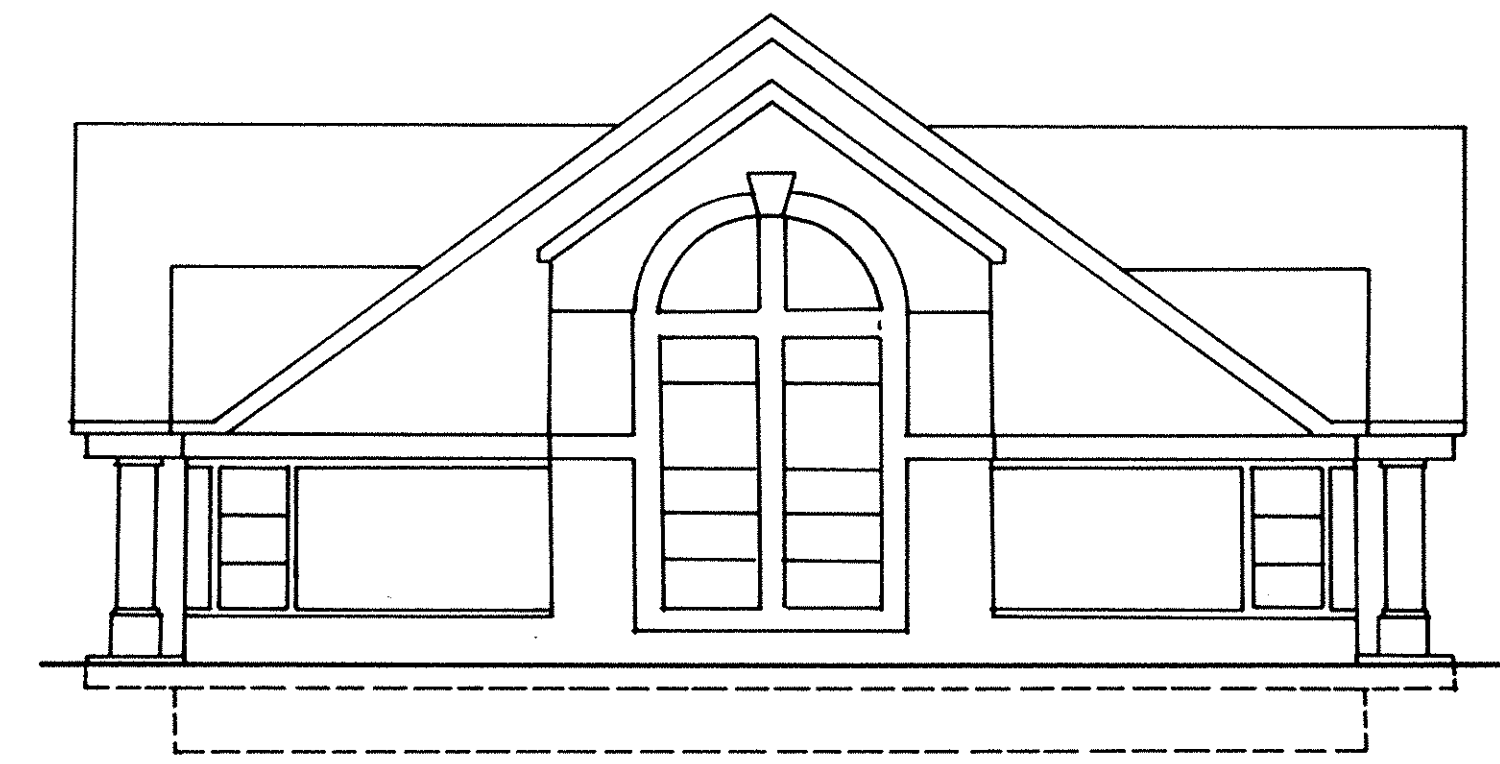

**SIDE ELEVATION**  
SCALE: 1/8"=1'-0"

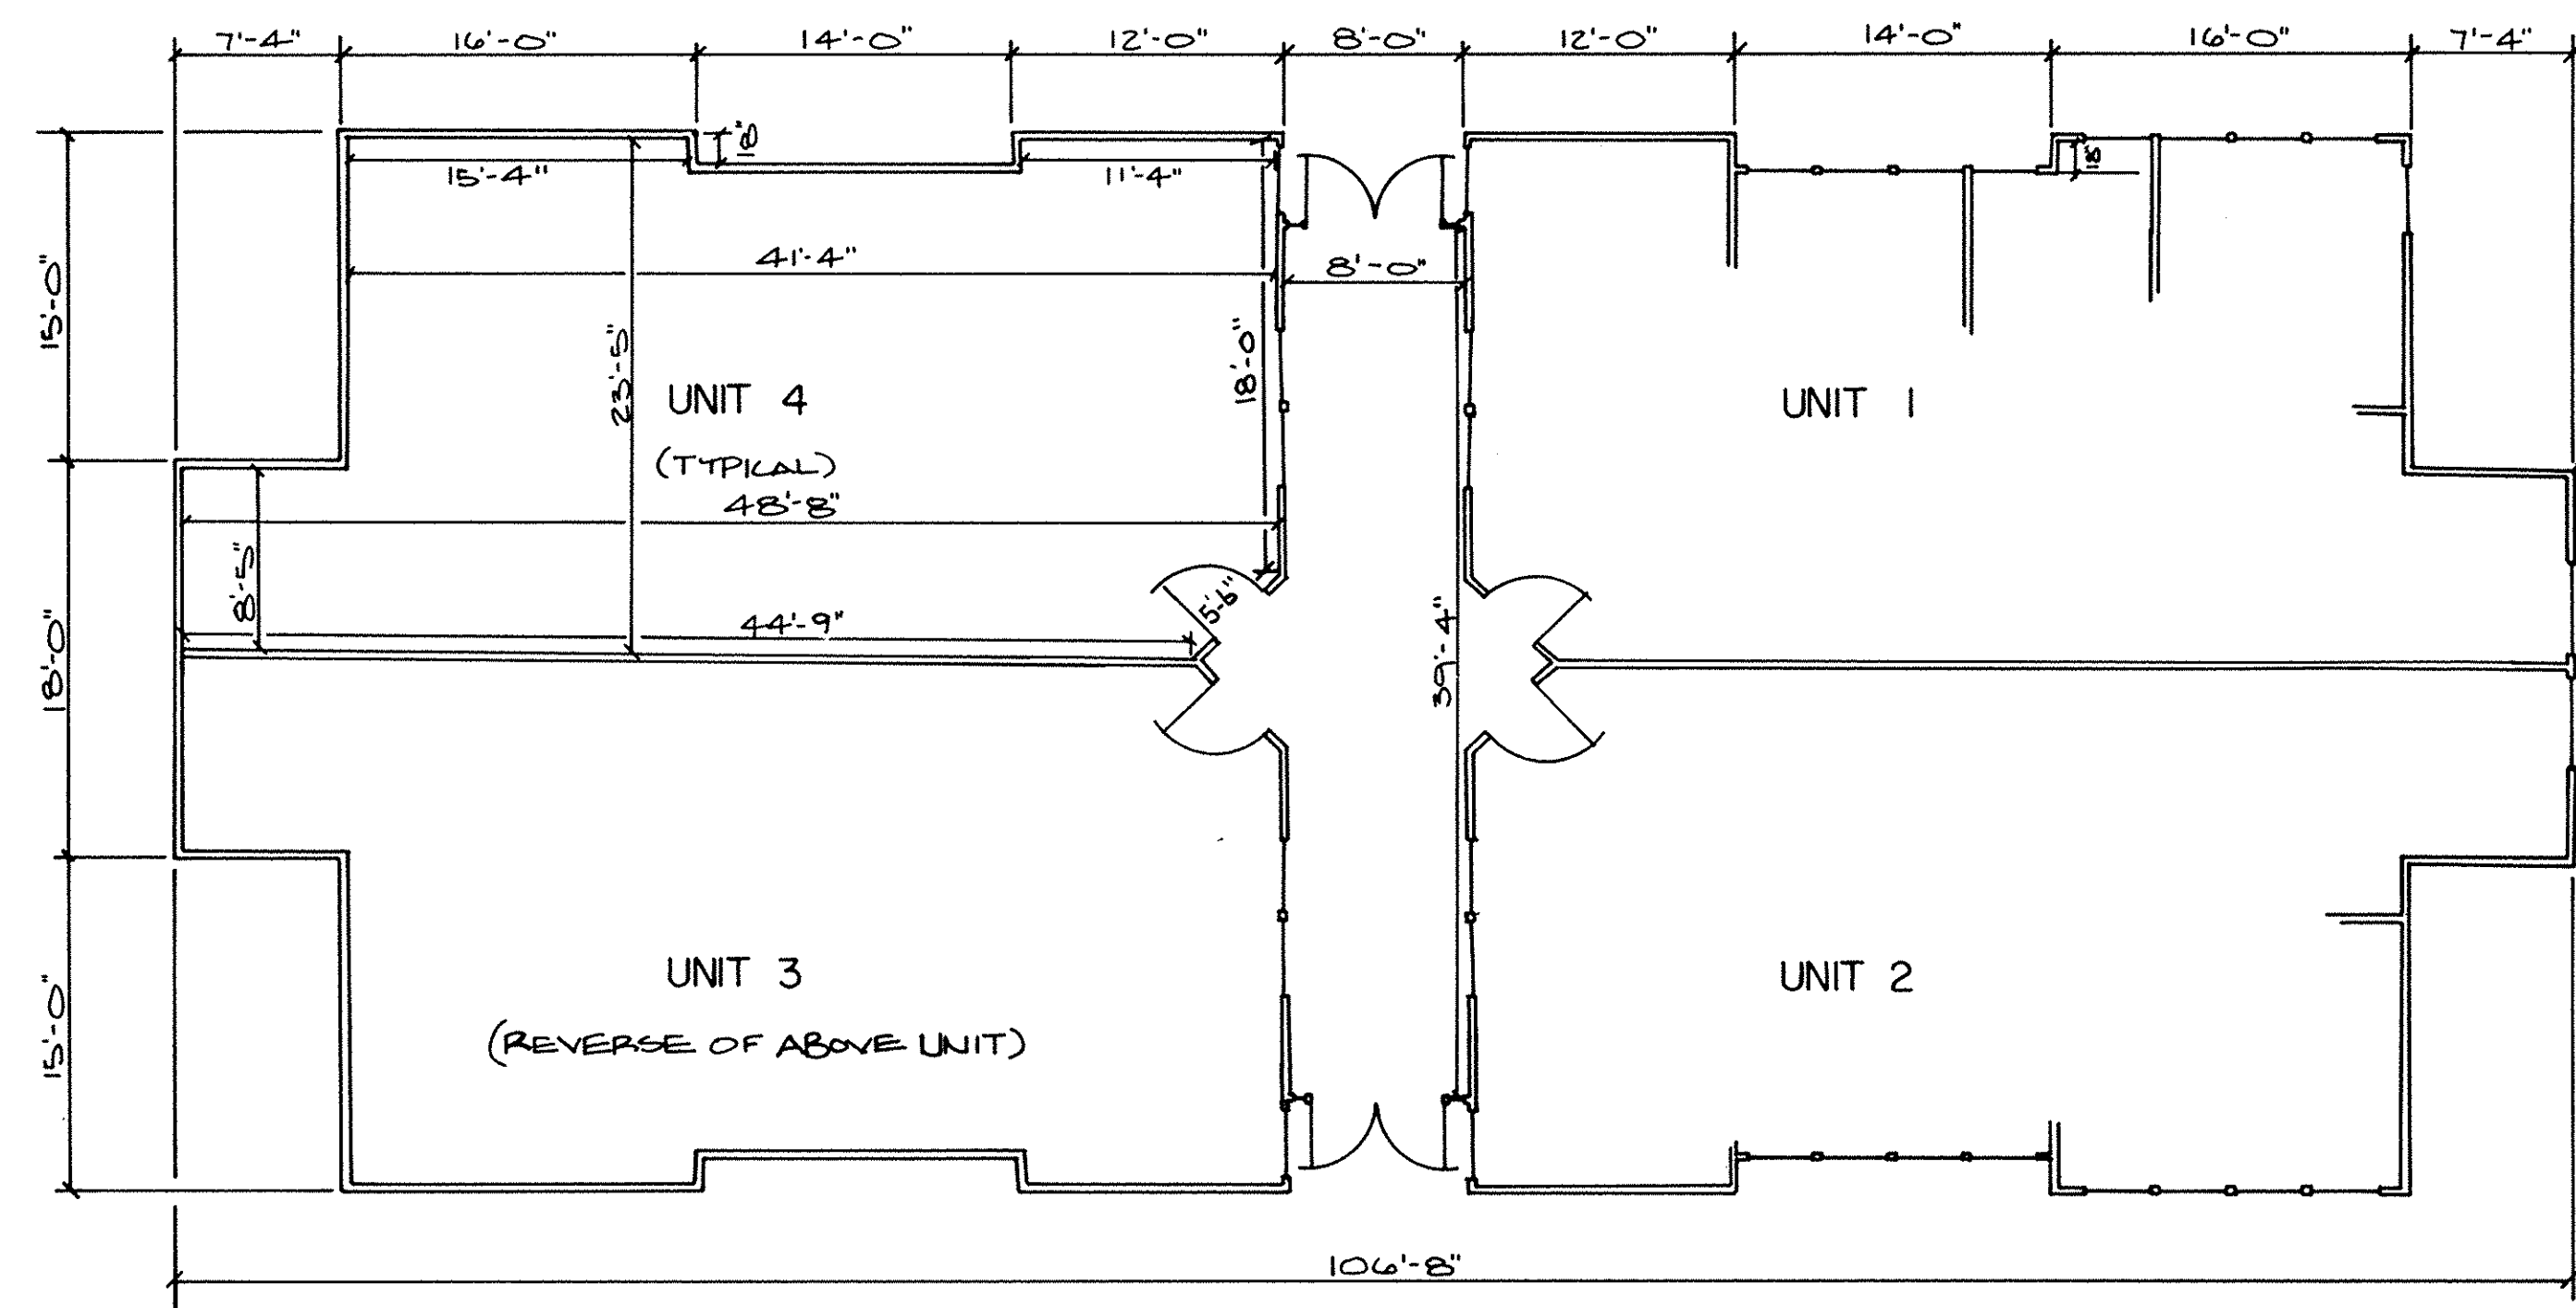

**FIRST FLOOR PLAN**  
SCALE: 1/8"=1'-0"

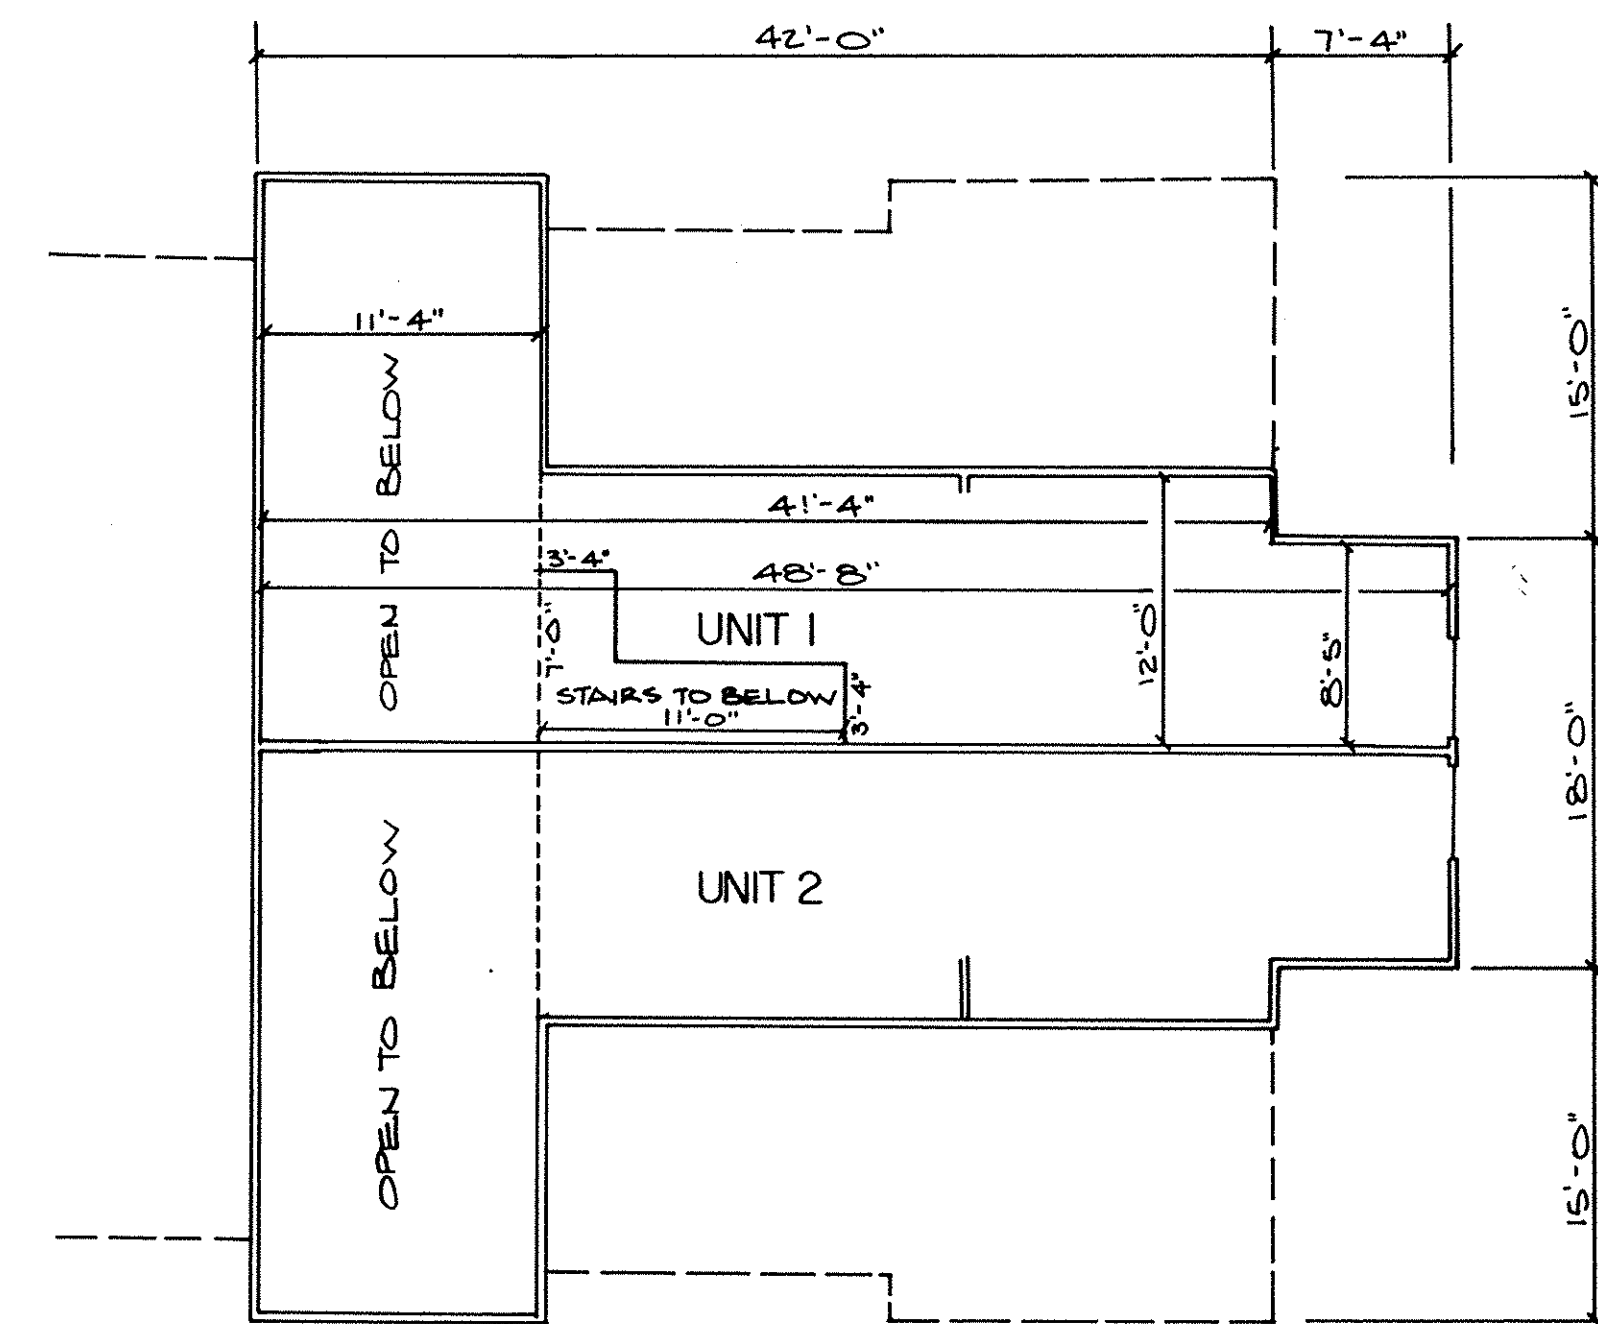

NOTE: UNITS 3 AND 4 ARE REVERSED.

**SECOND FLOOR PLAN**  
SCALE: 1/8"=1'-0"

**NORTH COLLEGE COMMONS CONDOMINIUMS PHASE NO.1**

PREPARED BY: [unclear]  
 CHECKED BY: [unclear]  
 DATE: [unclear]

**LORAIN COUNTY TAX  
MAP DEPARTMENT COPY**