


R.L.R. CONSTRUCTION INC  
05-00-026-101-014  
0.59 AC.  
O.R. 259 P.12


05-00-026-101-092  
R.L.R. CONSTRUCTION INC.  
O.R. 259 P. 4

05-00-025-101-099  
R.L.R. CONSTRUCTION INC.  
O.R. 259 P.4

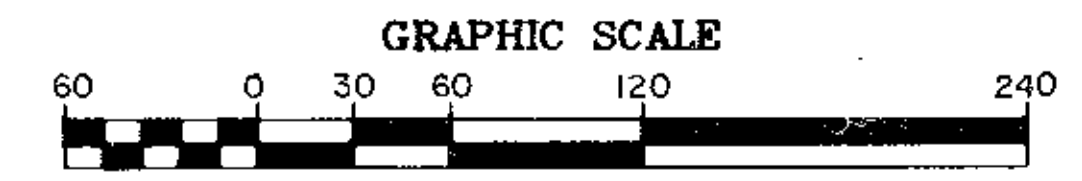


**SHEET INDEX**

SHT. NO	DESCRIPTION
1 OF 4	SURVEY MAP, FOUNDATION PLAN & MISC.
2 OF 4	FIRST FLOOR PLAN
3 OF 4	SECOND FLOOR PLAN
4 OF 4	EXTERIOR ELEVATIONS

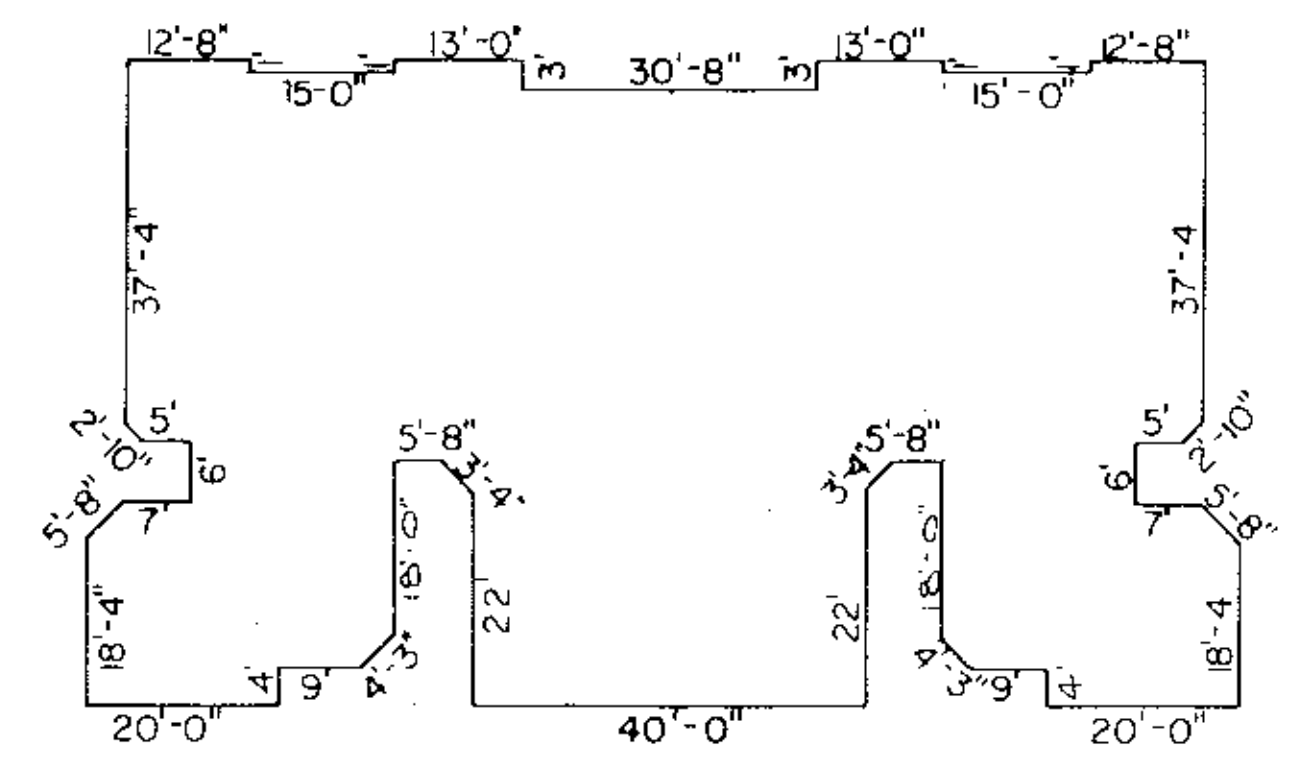

**OWNERSHIP TABLE**

UNIT NO.	SQ. FT.	ELEV. 1ST FL.	% OWNERSHIP
1-101	1388	723.40	7.497
2-103	1626	723.40	8.783
3-105	1769	723.40	9.555
4-107	1388	723.40	7.497
5-141	1388	719.38	7.497
6-143	1626	719.38	8.783
7-145	1769	719.38	9.555
8-147	1388	719.38	7.497
9-151	1388	719.53	7.497
10-153	1626	719.53	8.783
11-155	1769	719.53	9.555
12-157	1388	719.53	7.497
	18513		100.00

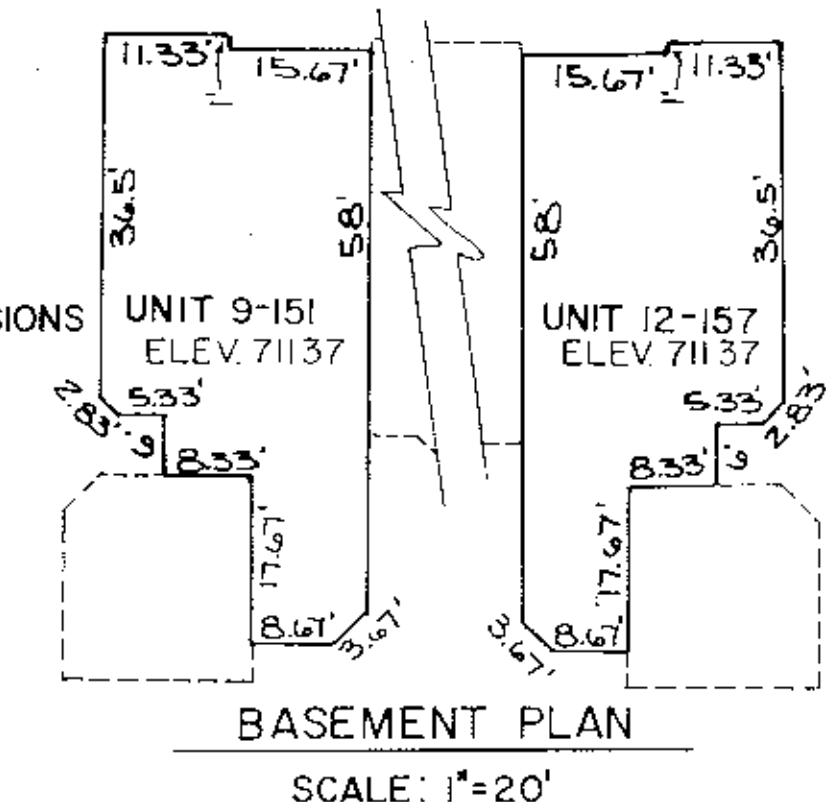


TOTAL RESIDUAL AREA  
16.6502 acres

AREA IN LOT 26  
12.1090 acres  
R.L.R. CONSTRUCTION INC.  
O.R. VOL. 285 PG. 679

AREA IN LOT 25  
4.5412 acres  
R.L.R. CONSTRUCTION INC.  
O.R. VOL. 285 PG. 681

- LEGEND**
- IRON PIN FOUND
  - IRON PIN SET
  - MON. BOX SET

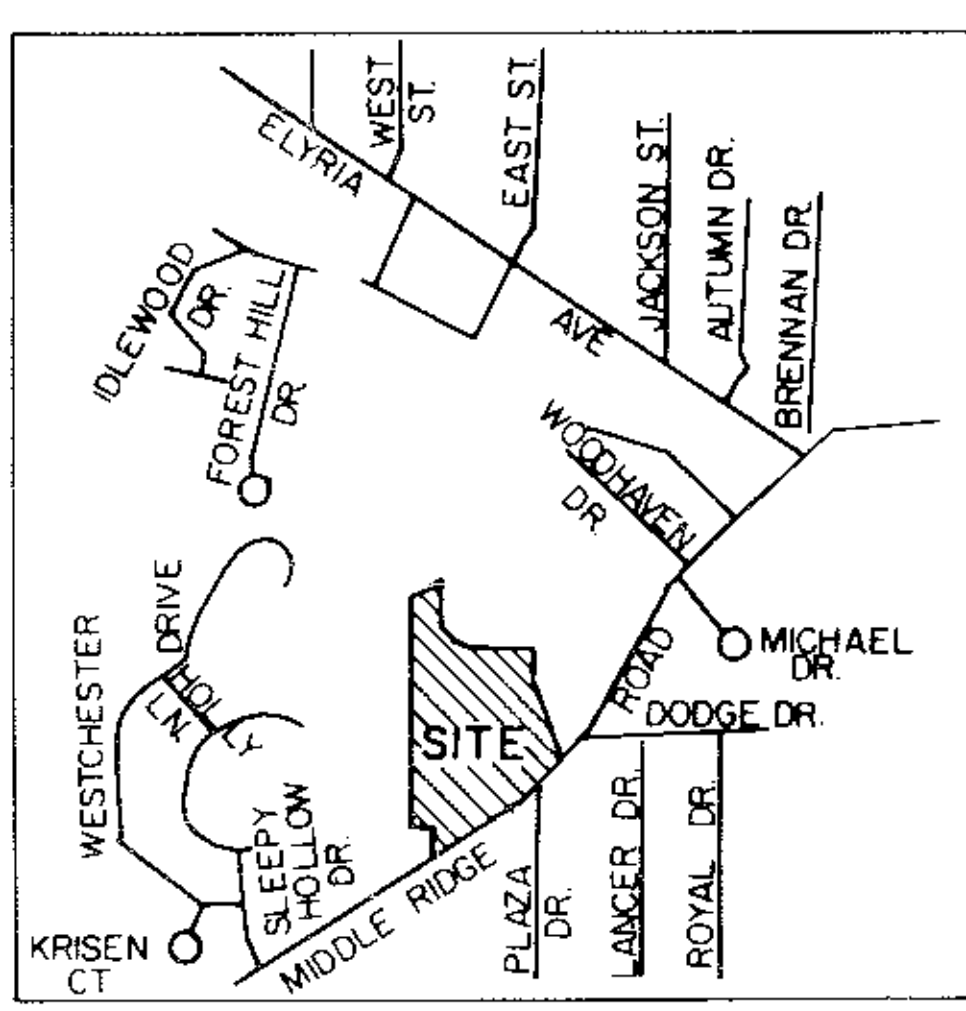

Δ = 09°23'43"  
R = 1352.97' REC & USED  
T = 111.18'  
L = 221.86' REC & USED  
C = 221.61'  
N 50°03'54" E




**REVISIONS**

NO.	DATE	DESCRIPTION

**CERTIFICATION**  
THIS IS TO CERTIFY THAT THE ATTACHED DRAWINGS CORRECTLY REPRESENT THE BUILDINGS AS CONSTRUCTED AND THAT THERE ARE NO ENCROACHMENTS ON ABUTTING PROPERTIES.

David L. Elwell  
DAVID L. ELWELL  
REG. SURVEYOR NO. 6333

Lynn S. Miggins  
LYNN S. MIGGINS  
REG. ENGINEER NO. 48837

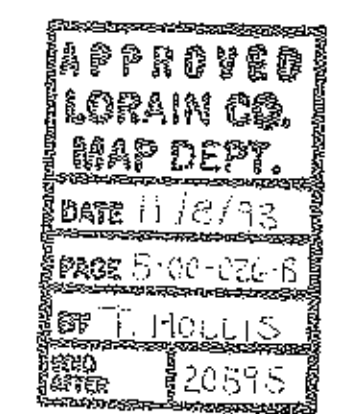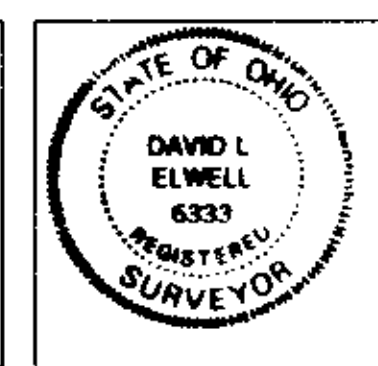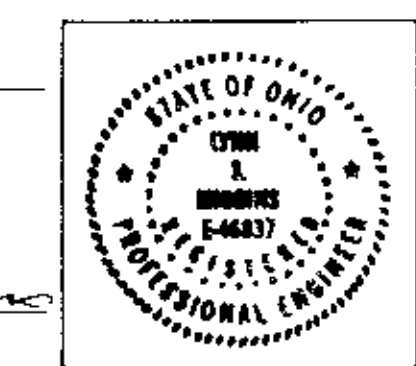


**LORAIN COUNTY TAX MAP DEPARTMENT COPY**

**THE ENGLISH LAKES CONDOMINIUMS PHASE 3**  
PART OF AMHERST TWP. O.L. 25 & 26  
CITY OF AMHERST\*COUNTY OF LORAIN\*STATE OF OHIO

**KS ASSOCIATES, INC.**  
ENGINEERS/SURVEYORS  
424 Middle Avenue  
P.O. Box 88  
Elyria, Ohio 44038  
ELYRIA (216) 322-6317 • LORAIN (216) 244-5757



SHEET 1 OF 4  
JOB NO. 89224-CP3

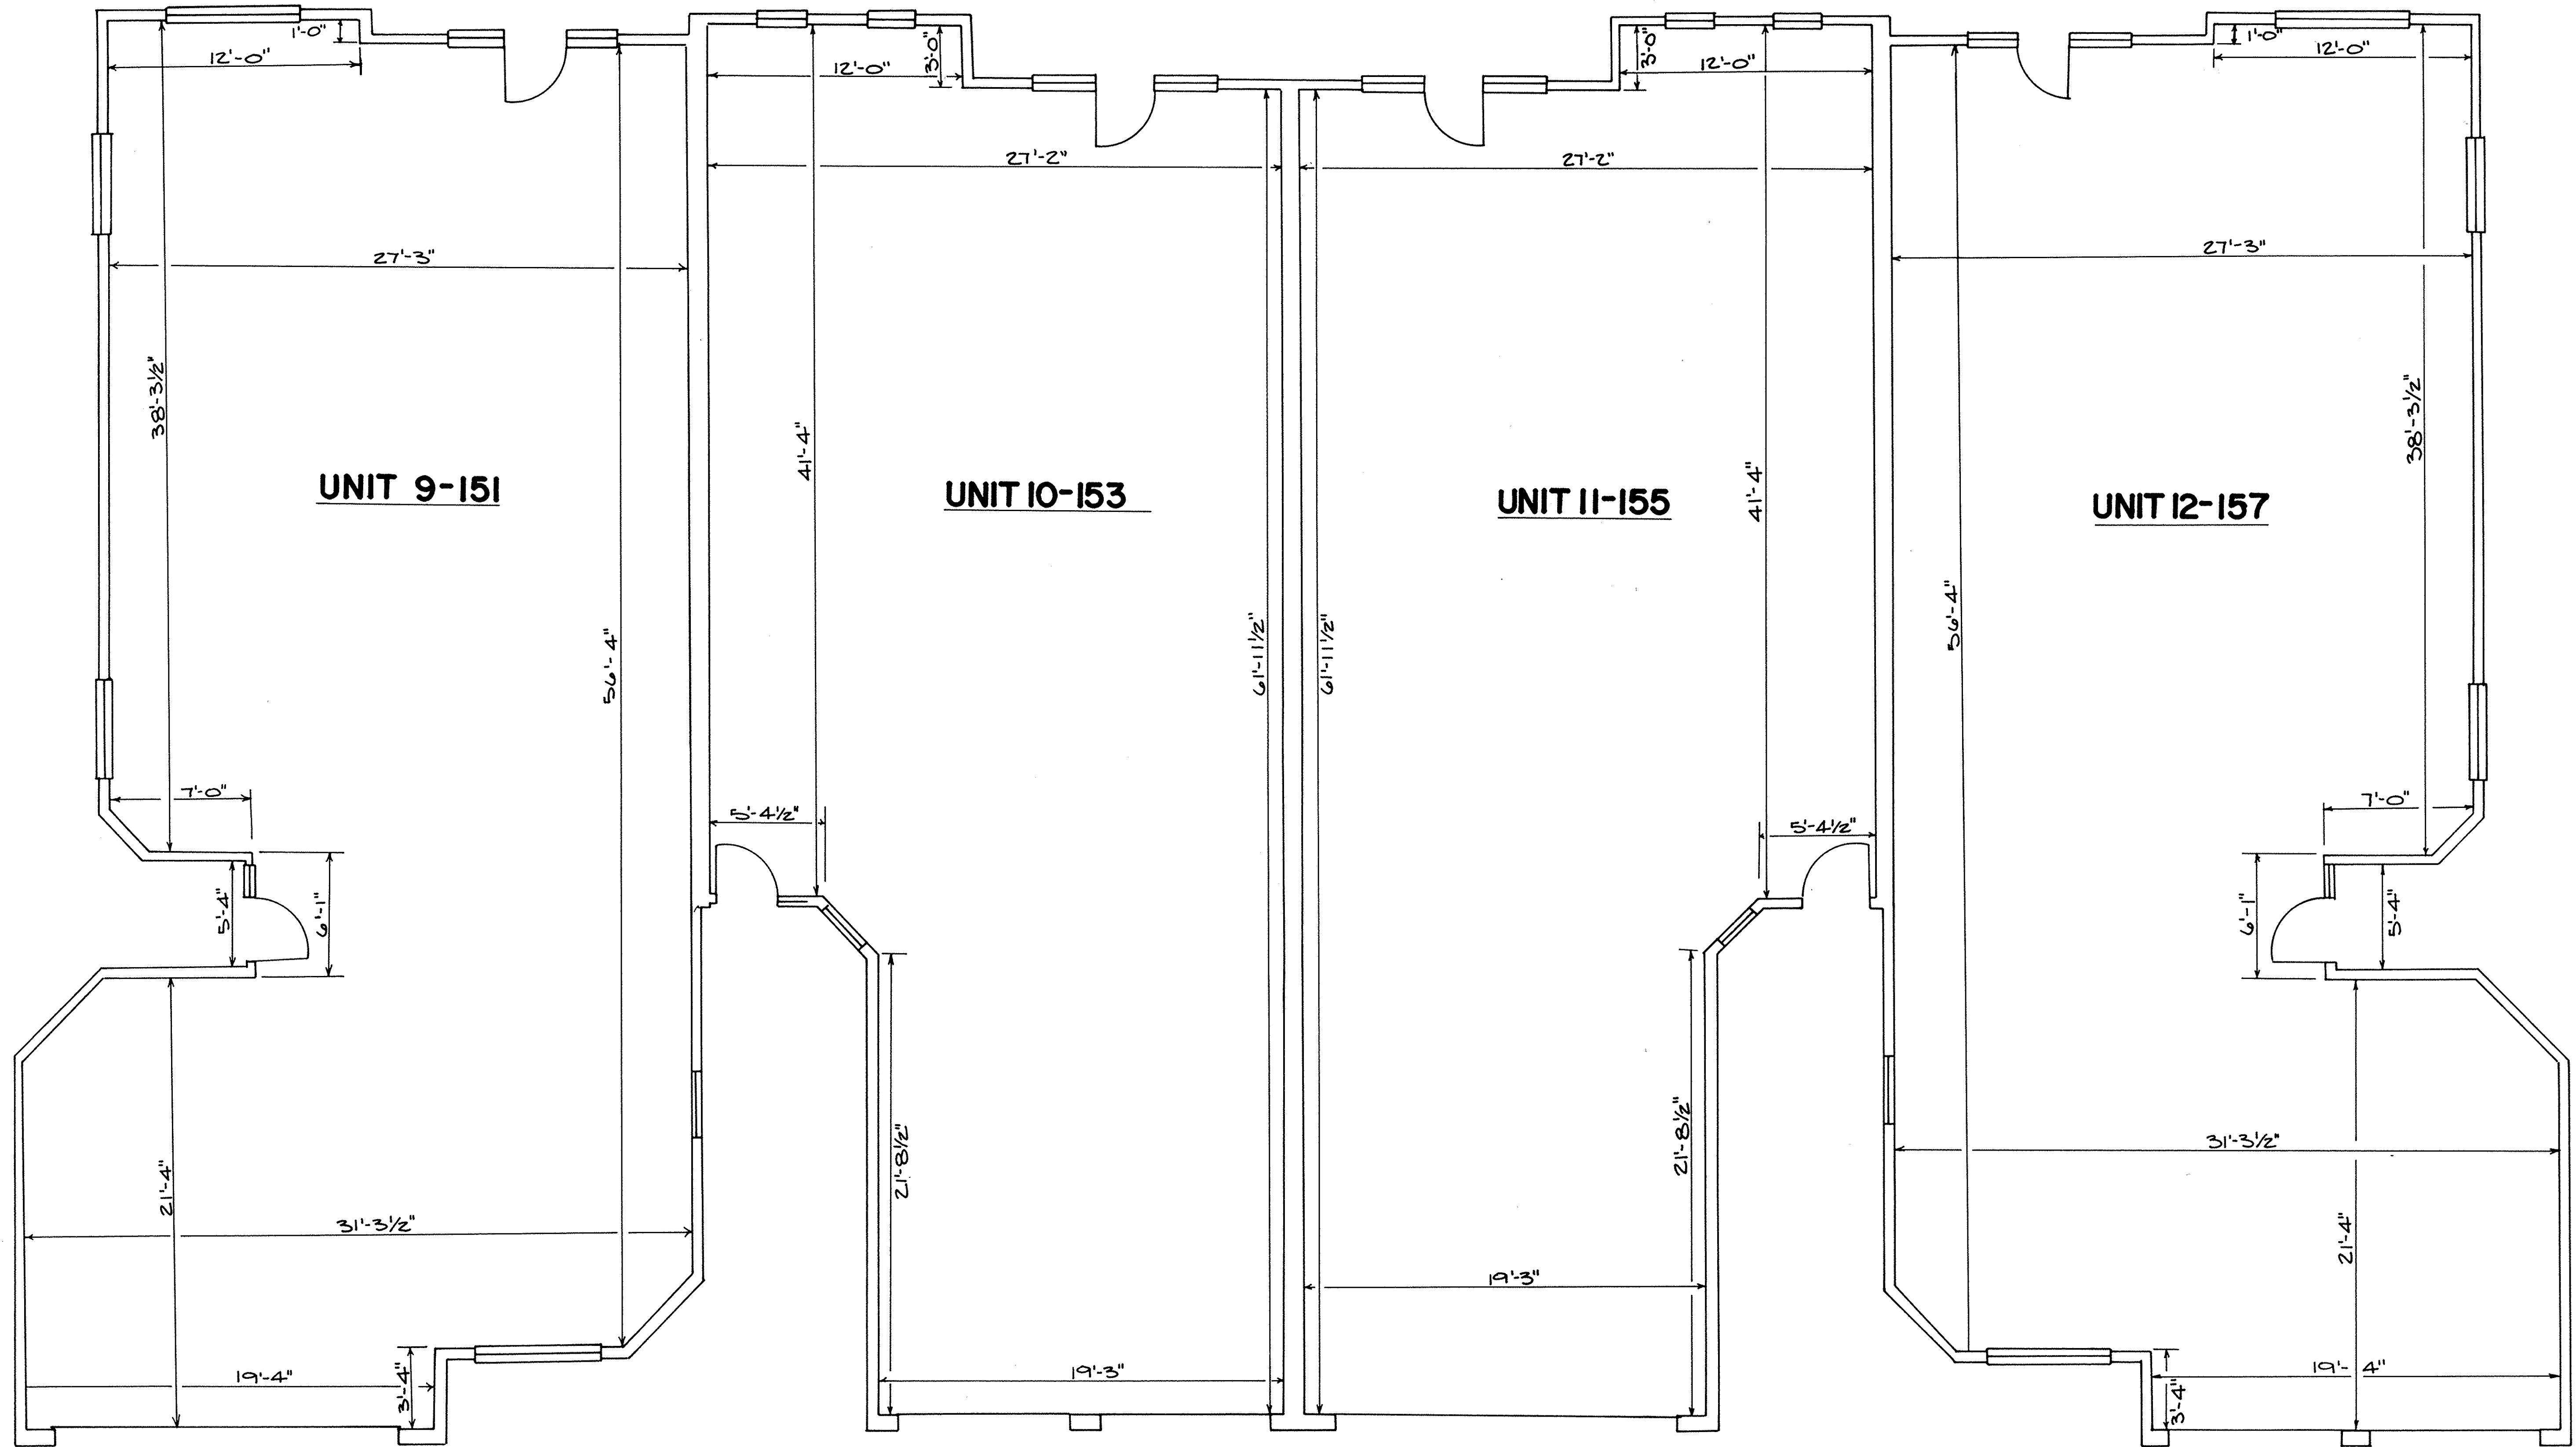

**FIRST FLOOR PLAN**  
 SCALE: 1/4"=1'-0"


**ENGLISH LAKES CONDOMINIUMS PHASE 3**

LORAIN COUNTY TAX  
 MAP DEPARTMENT COPY

259110

259110

52/11

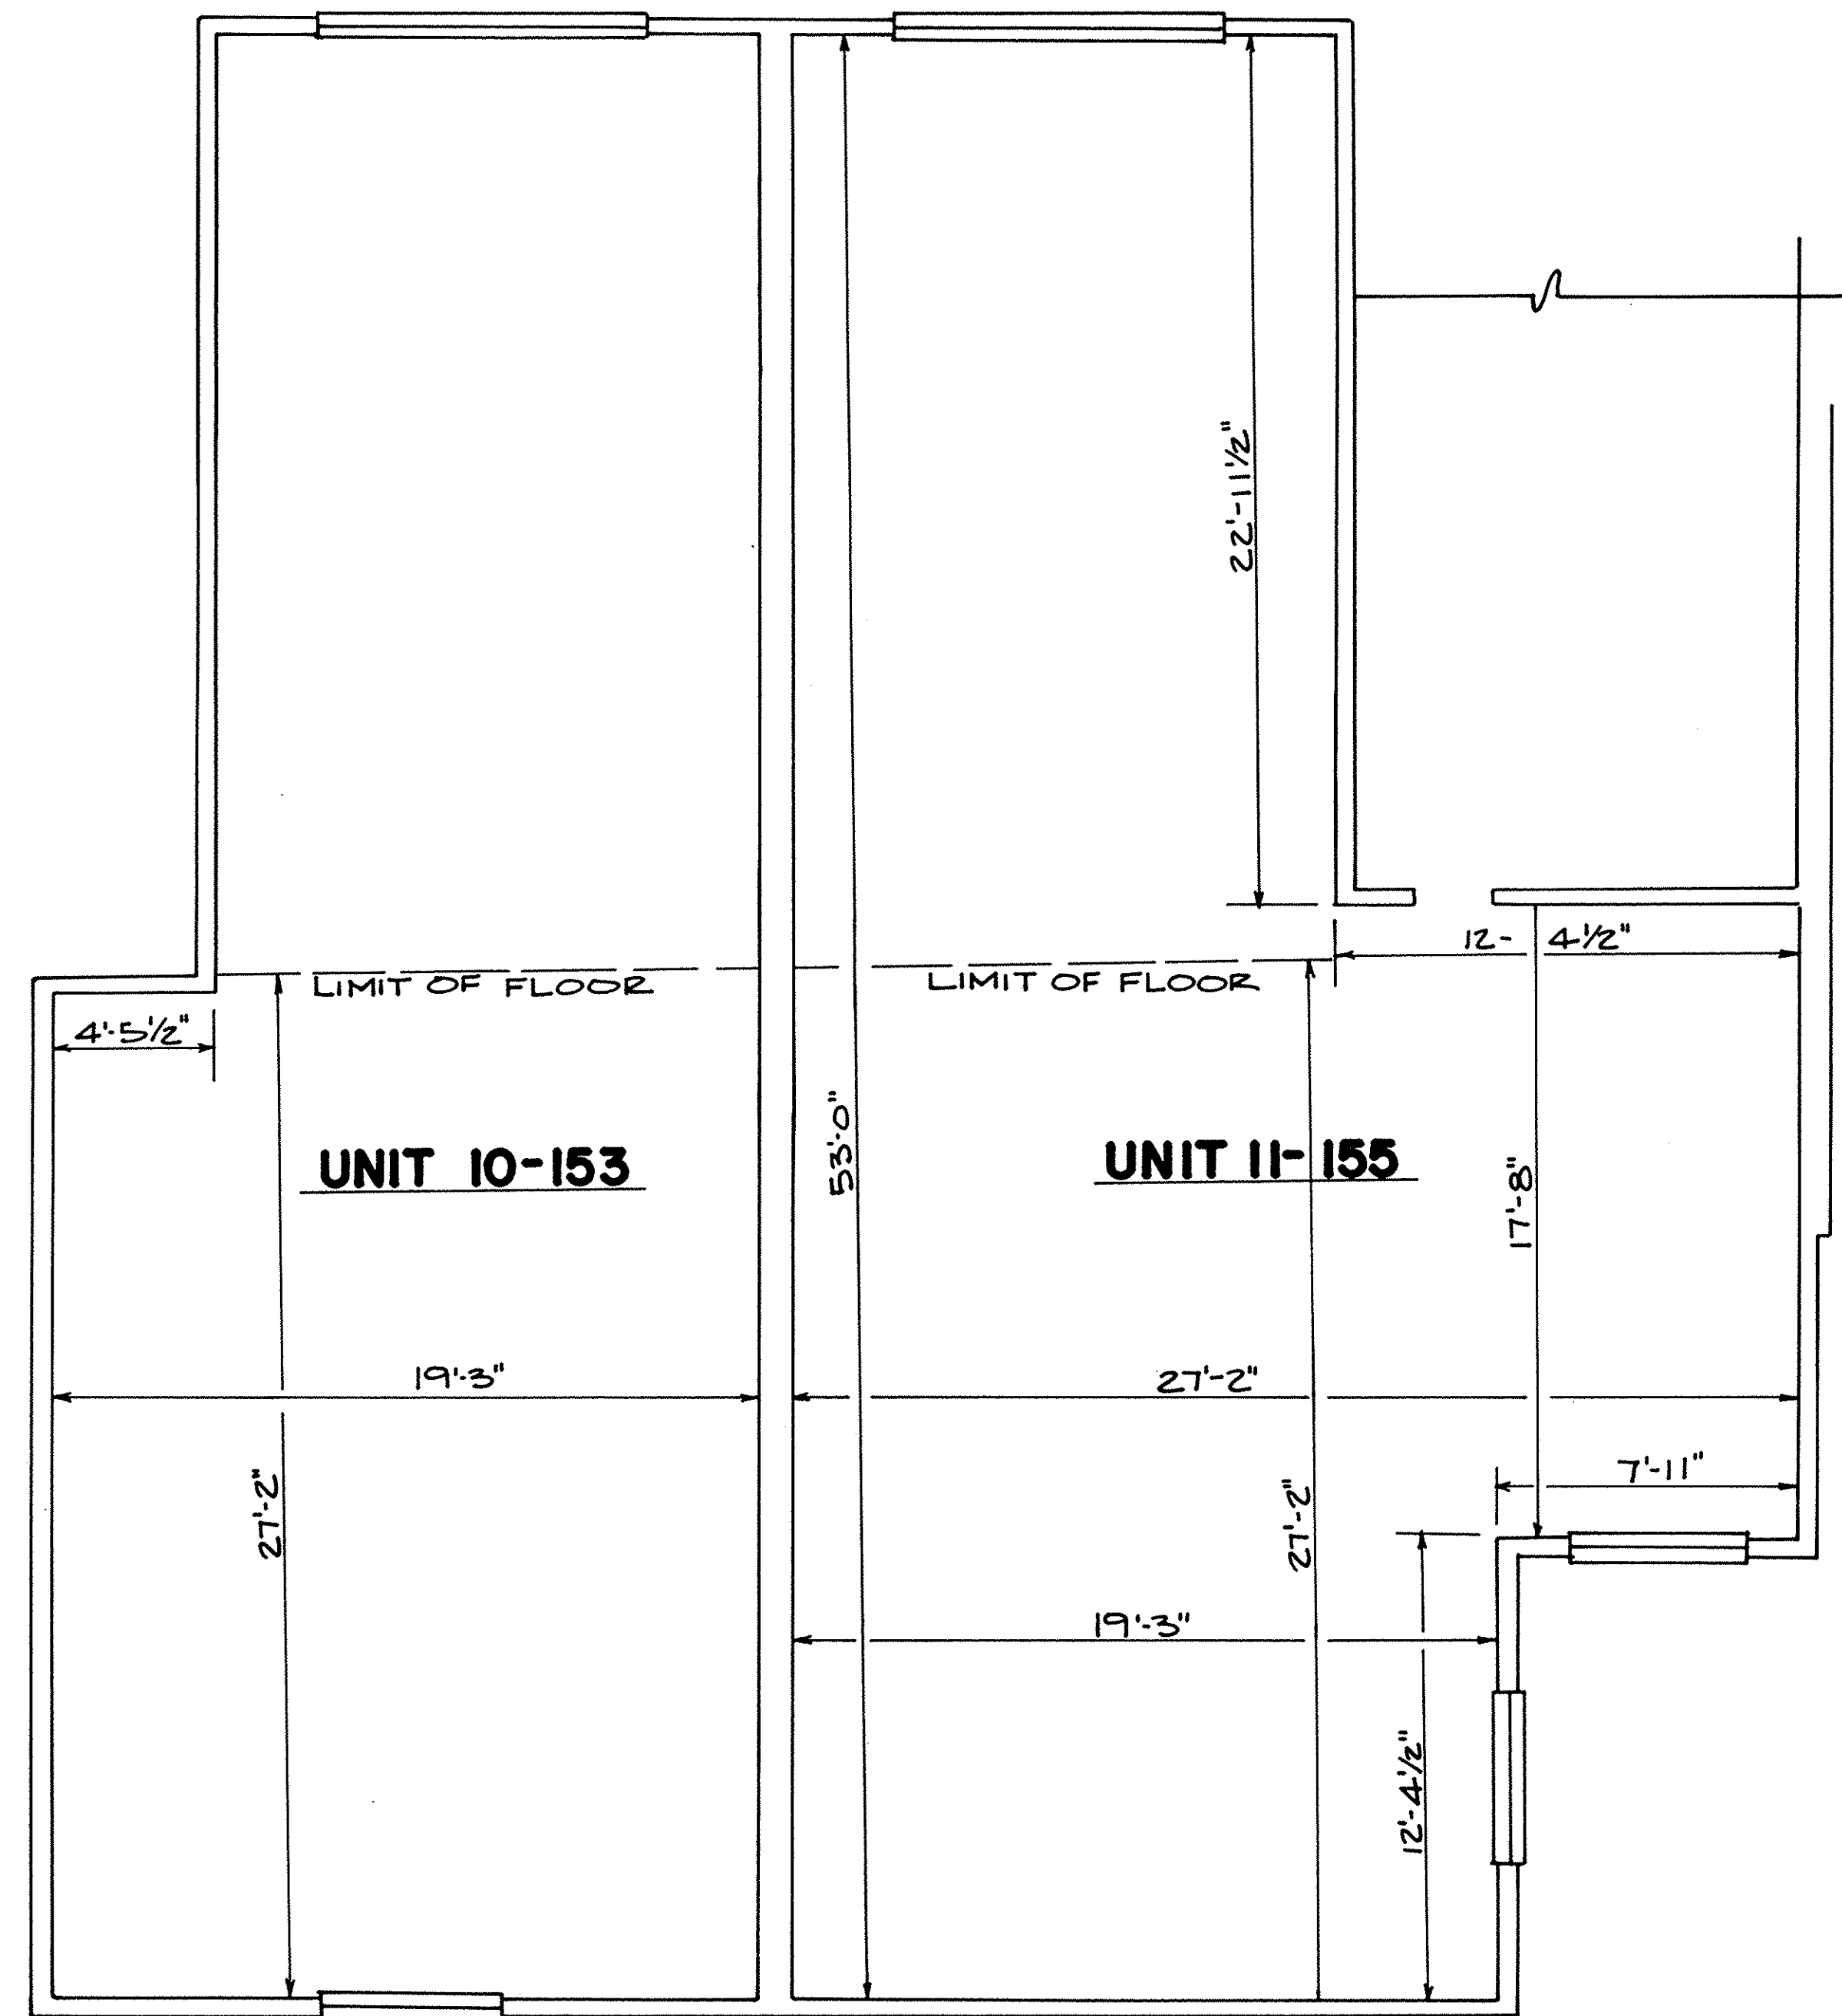

**SECOND FLOOR PLAN**

SCALE: 1/4" = 1'-0"

ENGLISH LAKES CONDOMINIUMS PHASE 3

LORAIN COUNTY TAX  
MAP DEPARTMENT COPY


52/11

259110


259110



FRONT ELEVATION

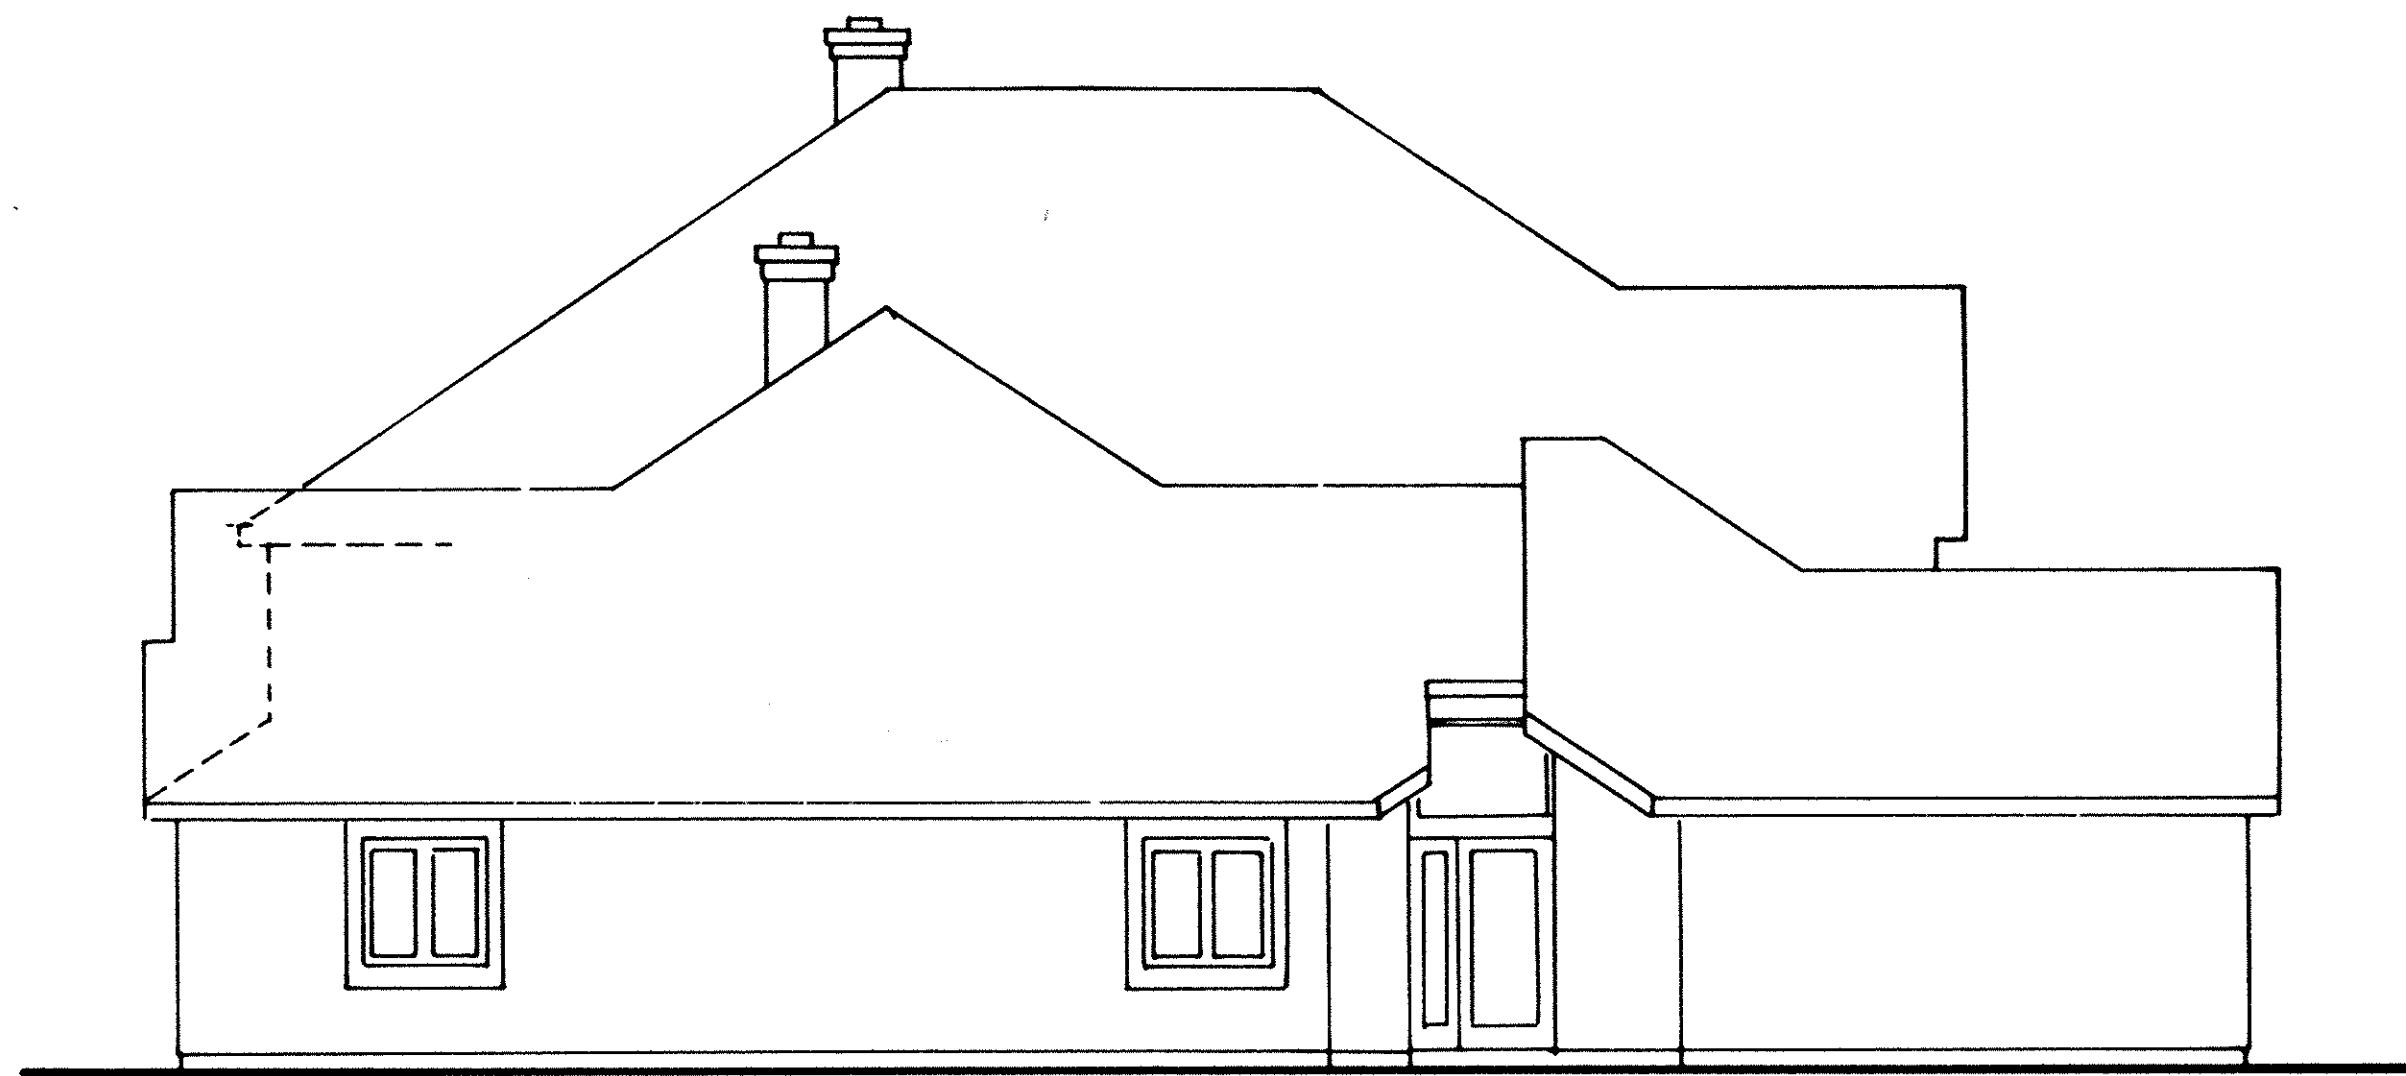

LEFT SIDE ELEVATION

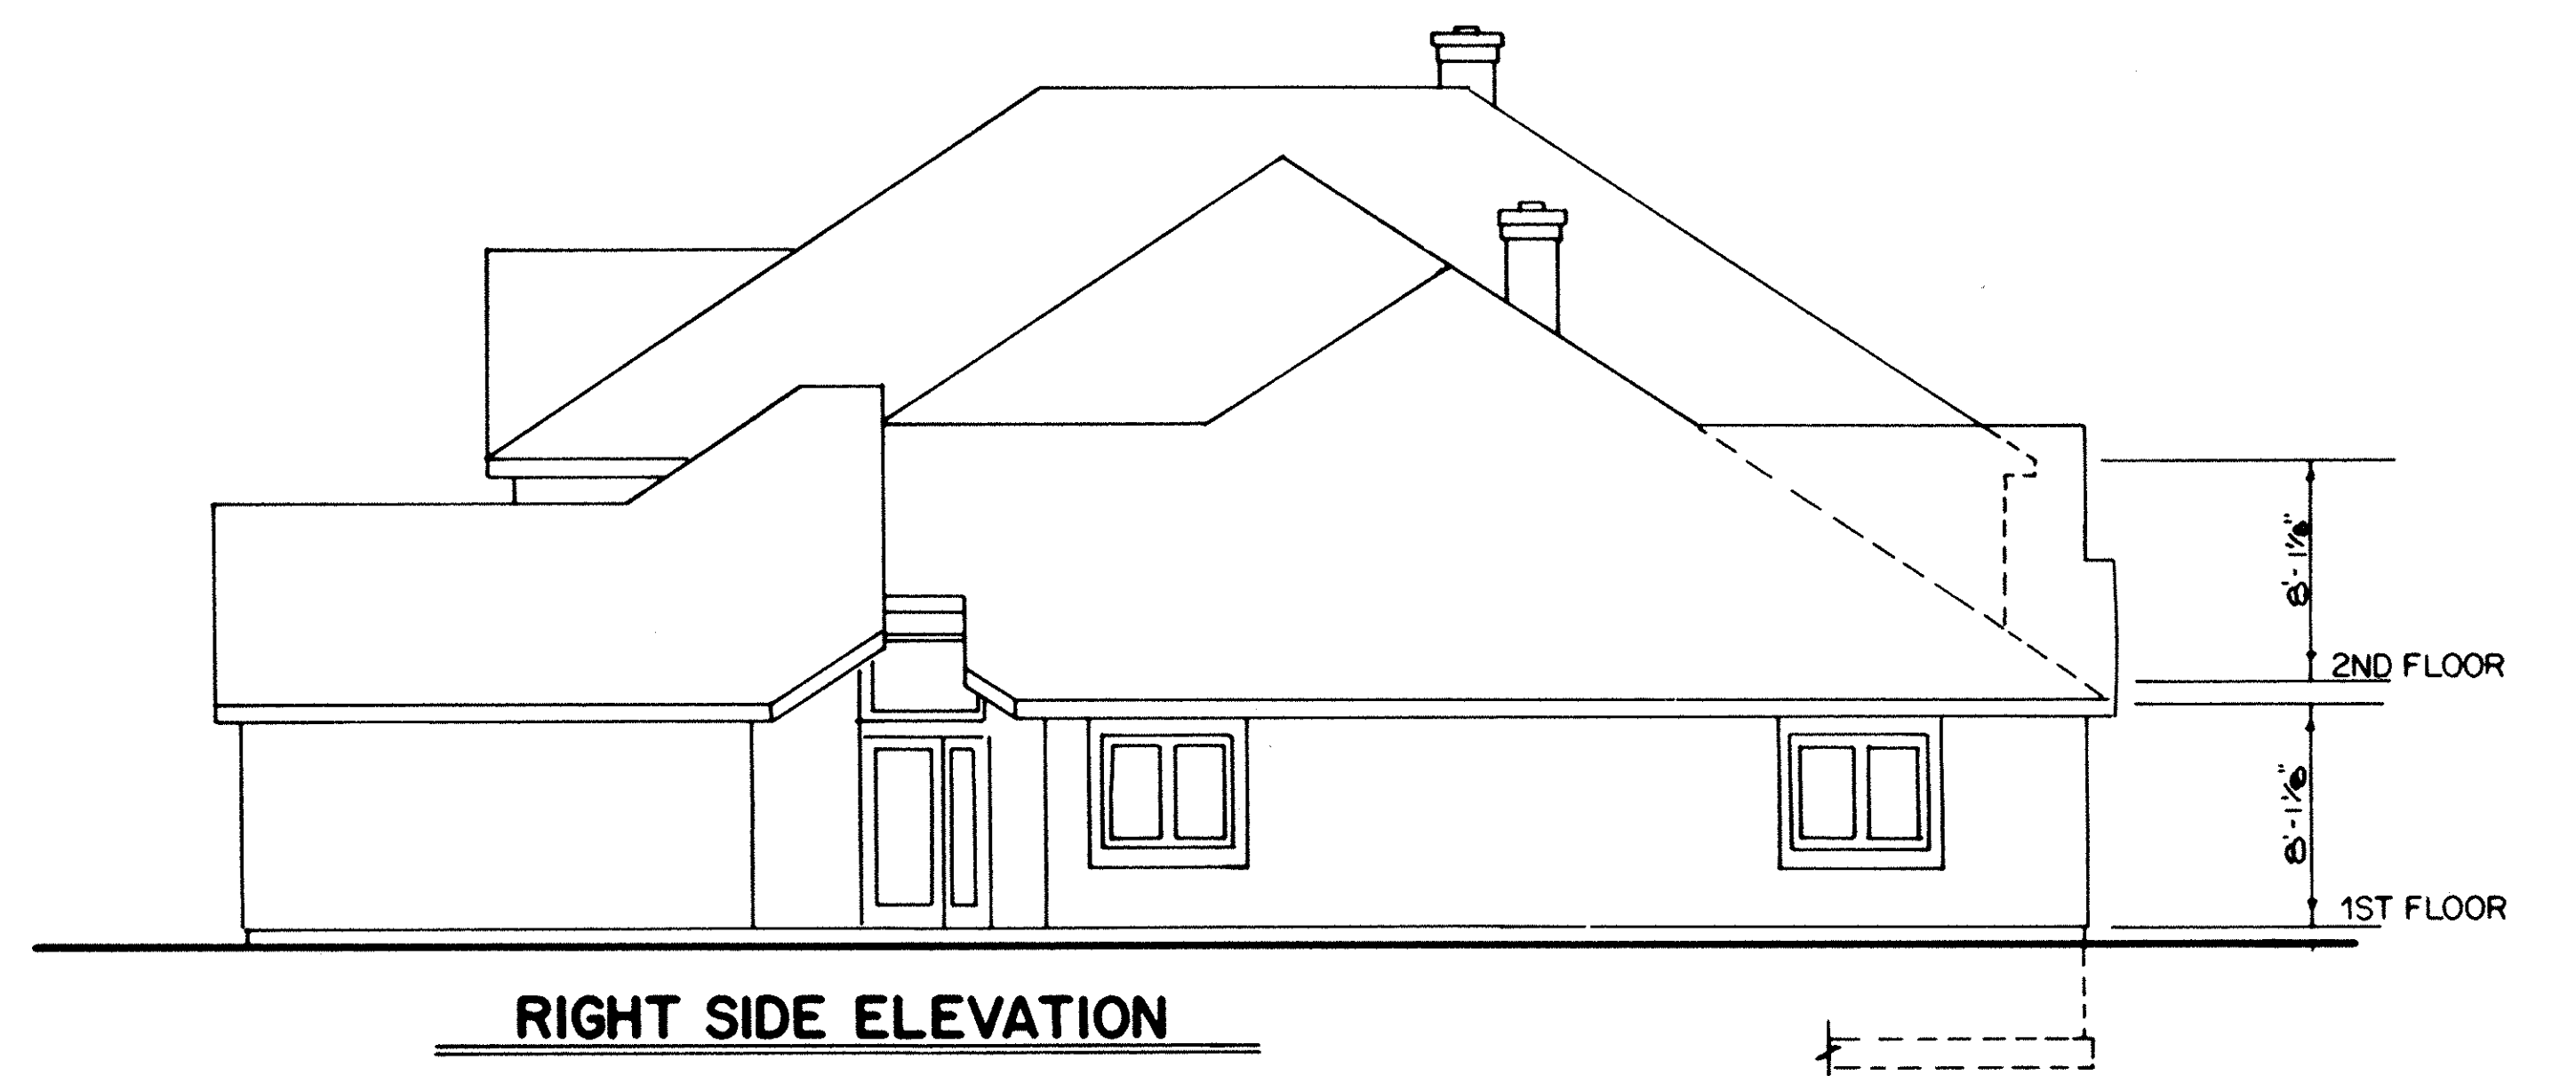

RIGHT SIDE ELEVATION



REAR ELEVATION

ENGLISH LAKES CONDOMINIUMS PHASE 3  
EXTERIOR ELEVATIONS

LORAIN COUNTY TAX  
MAP DEPARTMENT COPY