

CERTIFICATION


THIS IS TO CERTIFY THAT THE ATTACHED DRAWINGS CORRECTLY REPRESENT THE BUILDINGS AS CONSTRUCTED AND THAT THERE ARE NO ENCROACHMENTS ON ADJACENT PROPERTIES.

David L. Elwell
DAVID L. ELWELL
REG. SURVEYOR NO. 6333
LORAIN COUNTY RECORDER

Lynn S. Miggins
LYNN S. MIGGINS
REG. ENGINEER NO. 46837
LORAIN COUNTY AUDITOR


DALE YOST CONSTRUCTION COMPANY
O.R.V. 774 PG. 901
3.9149 AC.
REMAINDER

OUT OF	10-00-005-101-537	4.98 A.
INTO PLAT		-1.07 A.
REMAINDER	10-00-005-101-544	3.91 A.

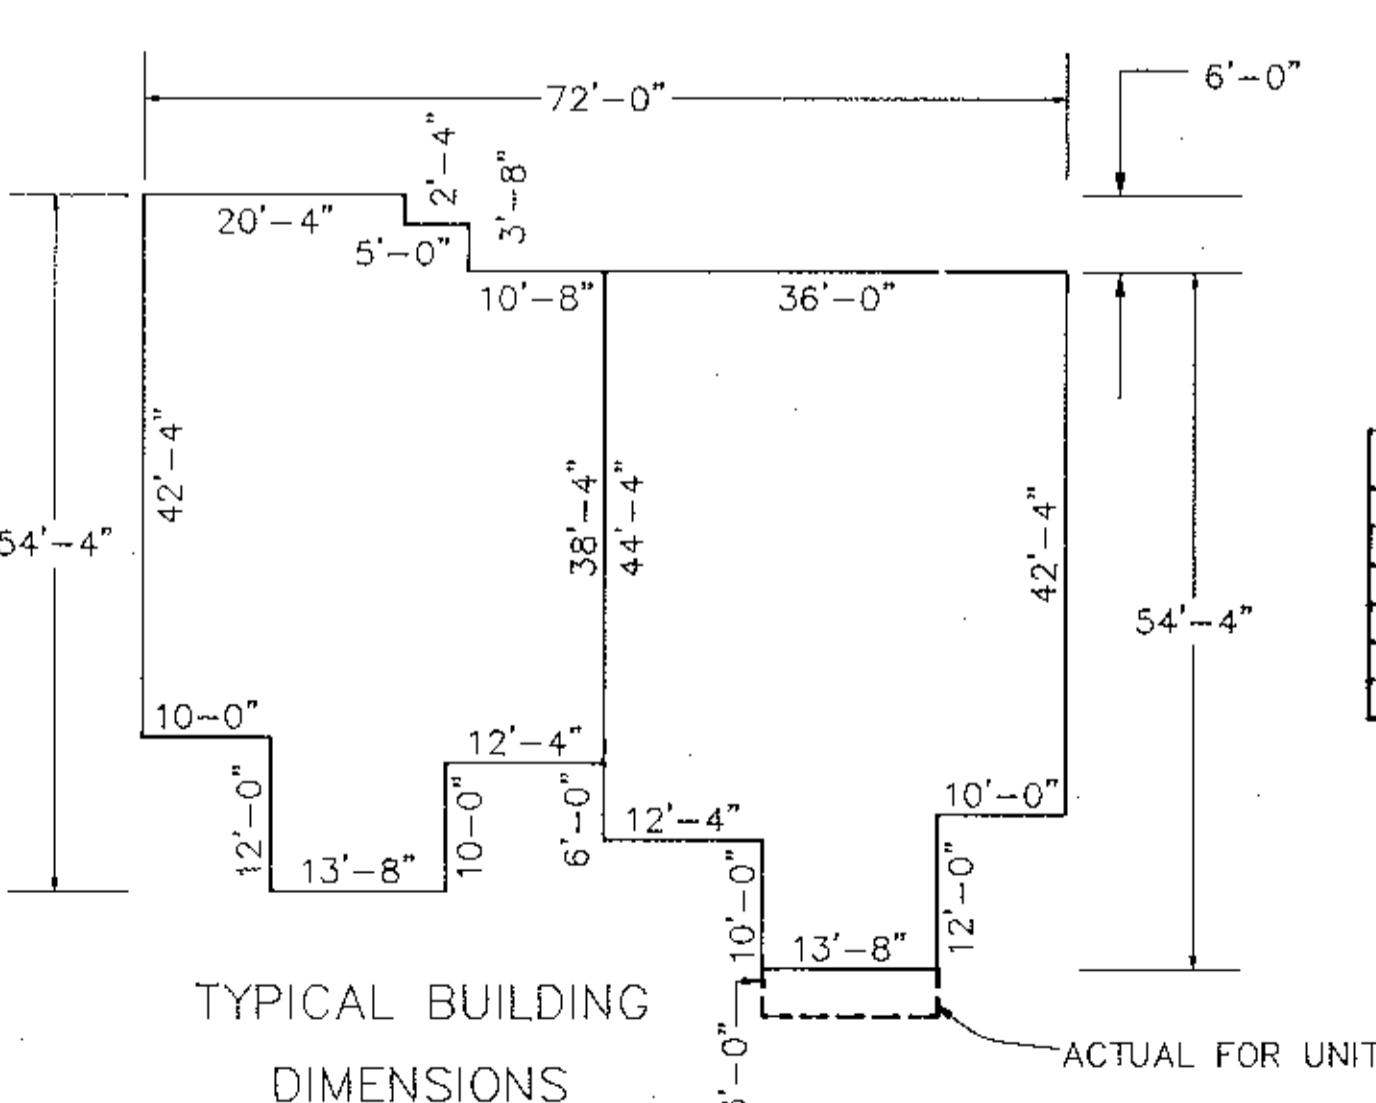

APPROVED
LORAIN CO.
MAP DEPT.
DATE 12-21-93
PAGE 10-00-005-1
BY T. HOLLIS
VOID AFTER 20622

UNIT	AREA	% OWNER
1	1717 SF	16.599
2	1738 SF	16.802
3	1738 SF	16.802
4	1717 SF	16.599
5	1717 SF	16.599
6	1717 SF	16.599

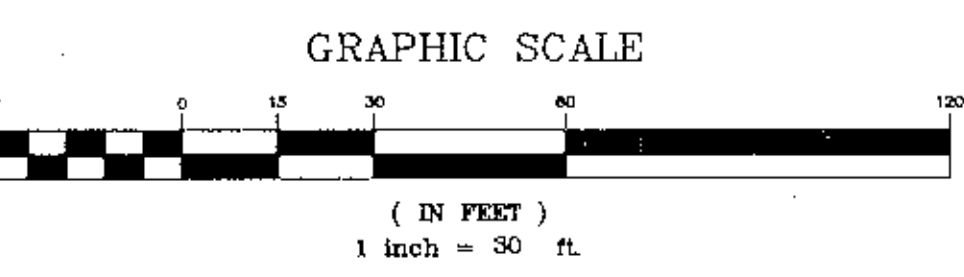

DATE	BY	REVISIONS
10-21-93	JEC	
	DLH	
	193	
DWG. NAME: 92813 SURV MAP		

VILLAS AT HIGHLAND PARK
CONDOMINIUMS PHASE 1
PART OF CARLISLE TOWNSHIP SECTION 5
CITY OF ELYRIA * COUNTY OF LORAIN * STATE OF OHIO


KS ASSOCIATES, INC.
ENGINEERS/SURVEYORS
484 Middle Avenue
P.O. Box 89
Elyria, Ohio 44036
ELYRIA (216) 322-6317 * LORAIN (216) 244-5757



SHEET 1 OF 3
JOB NO. 92-614


#266 718

#266 718

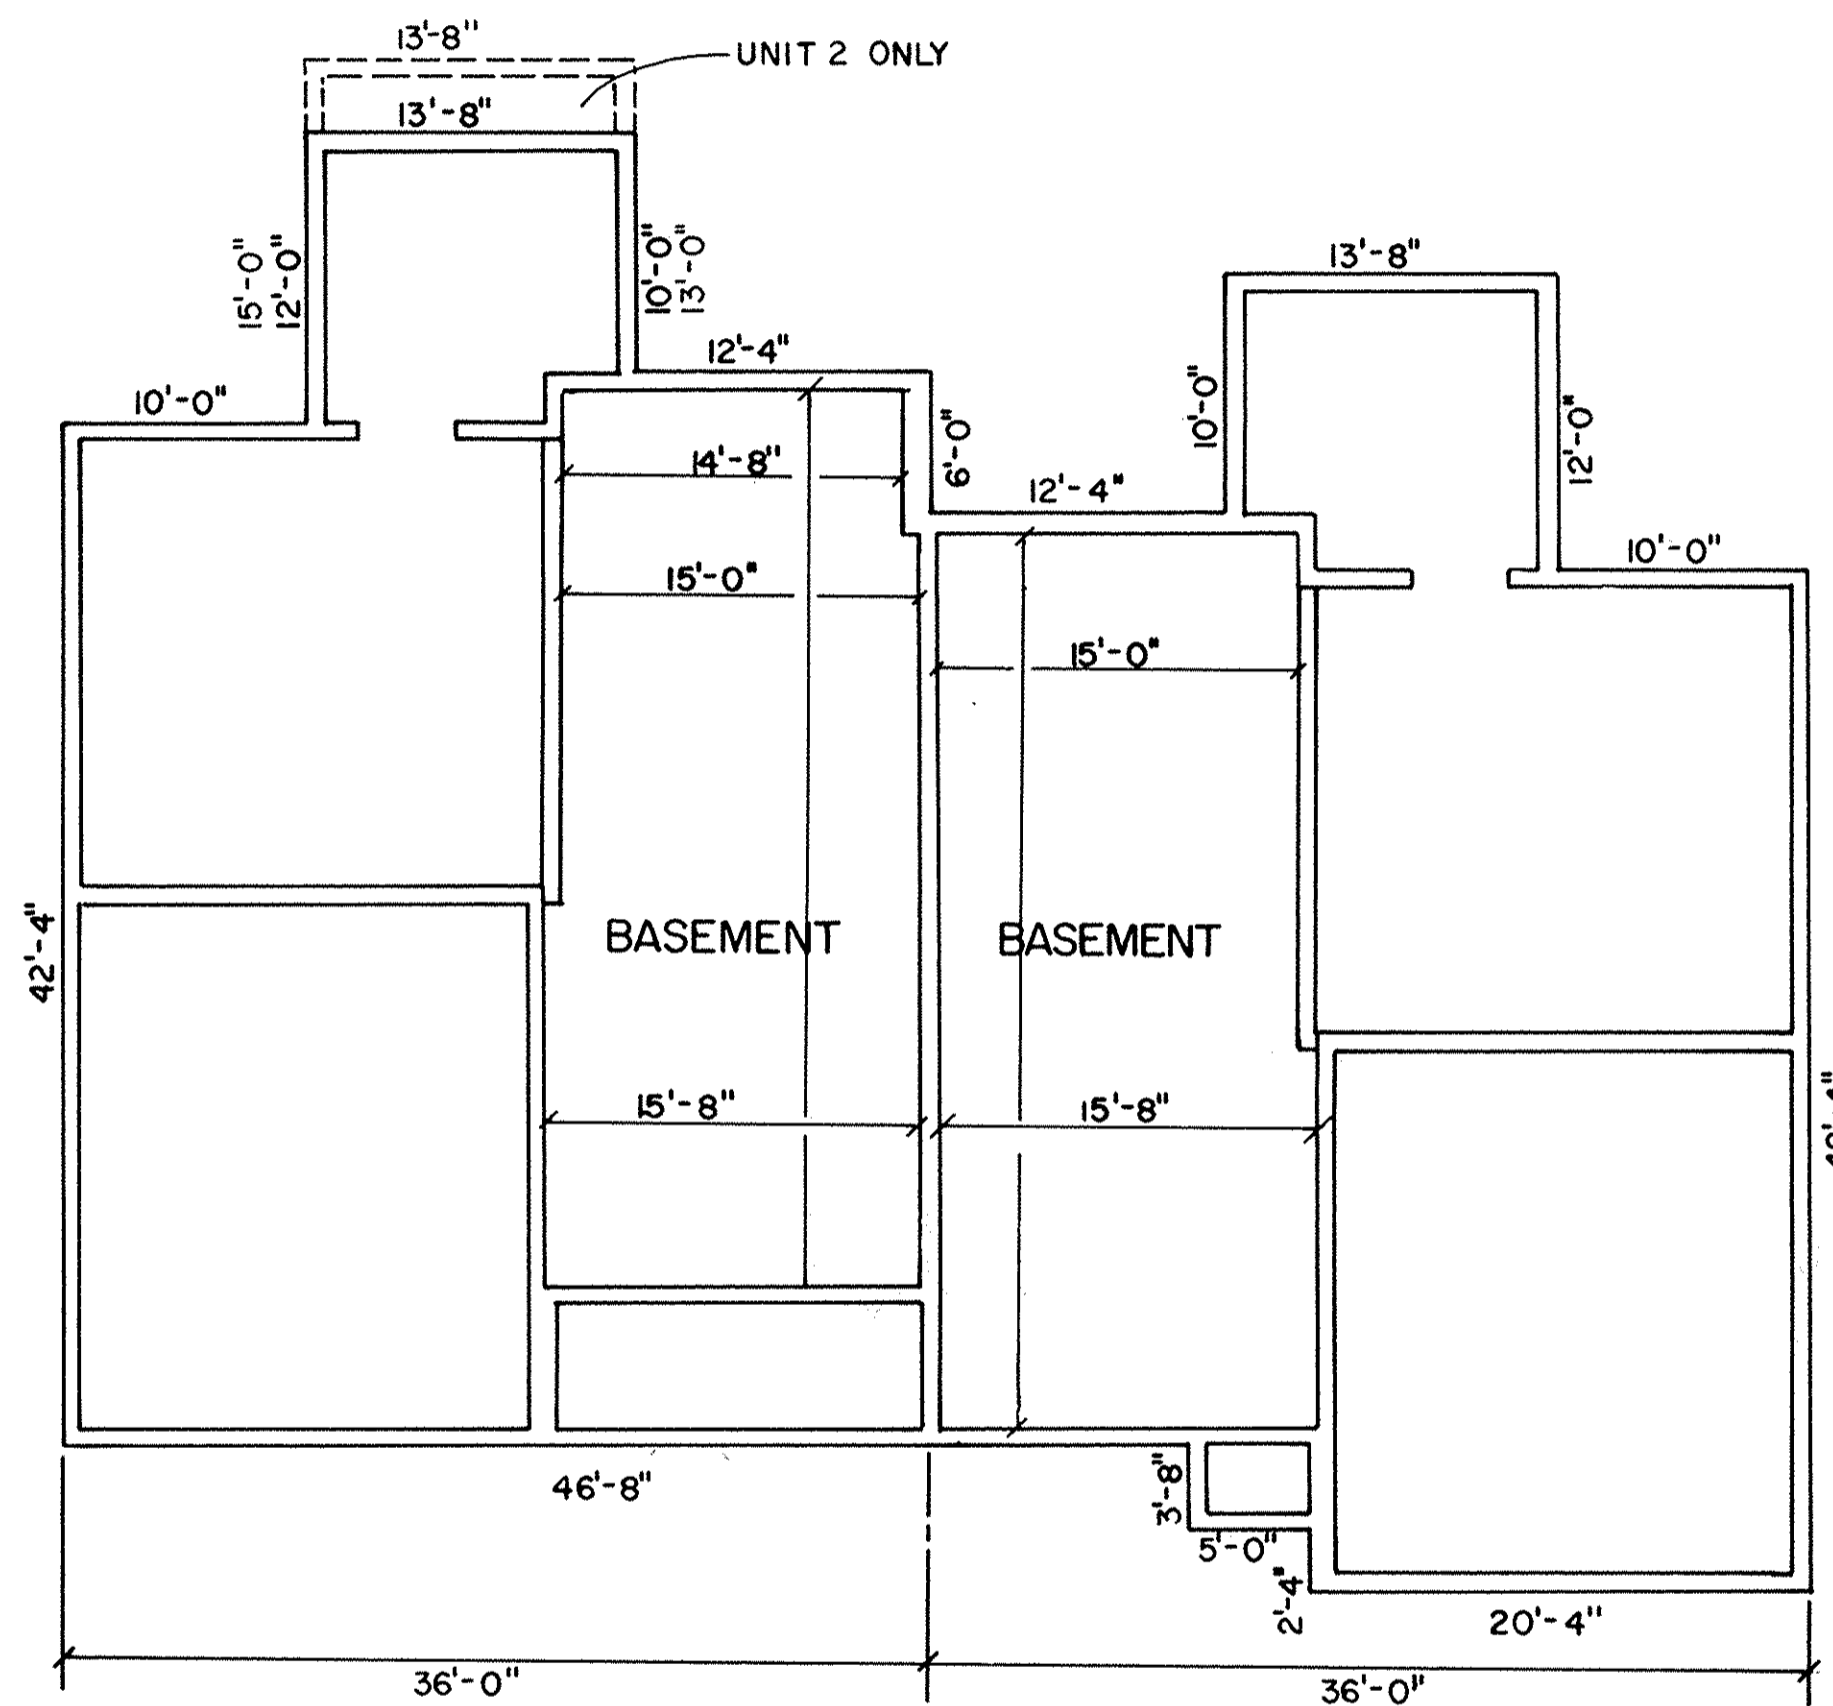


FOUNDATION PLAN
SCALE: 1/8" = 1'-0"

TYPICAL UNITS: 1,2,5 & 6
REVERSED UNITS: 3 & 4

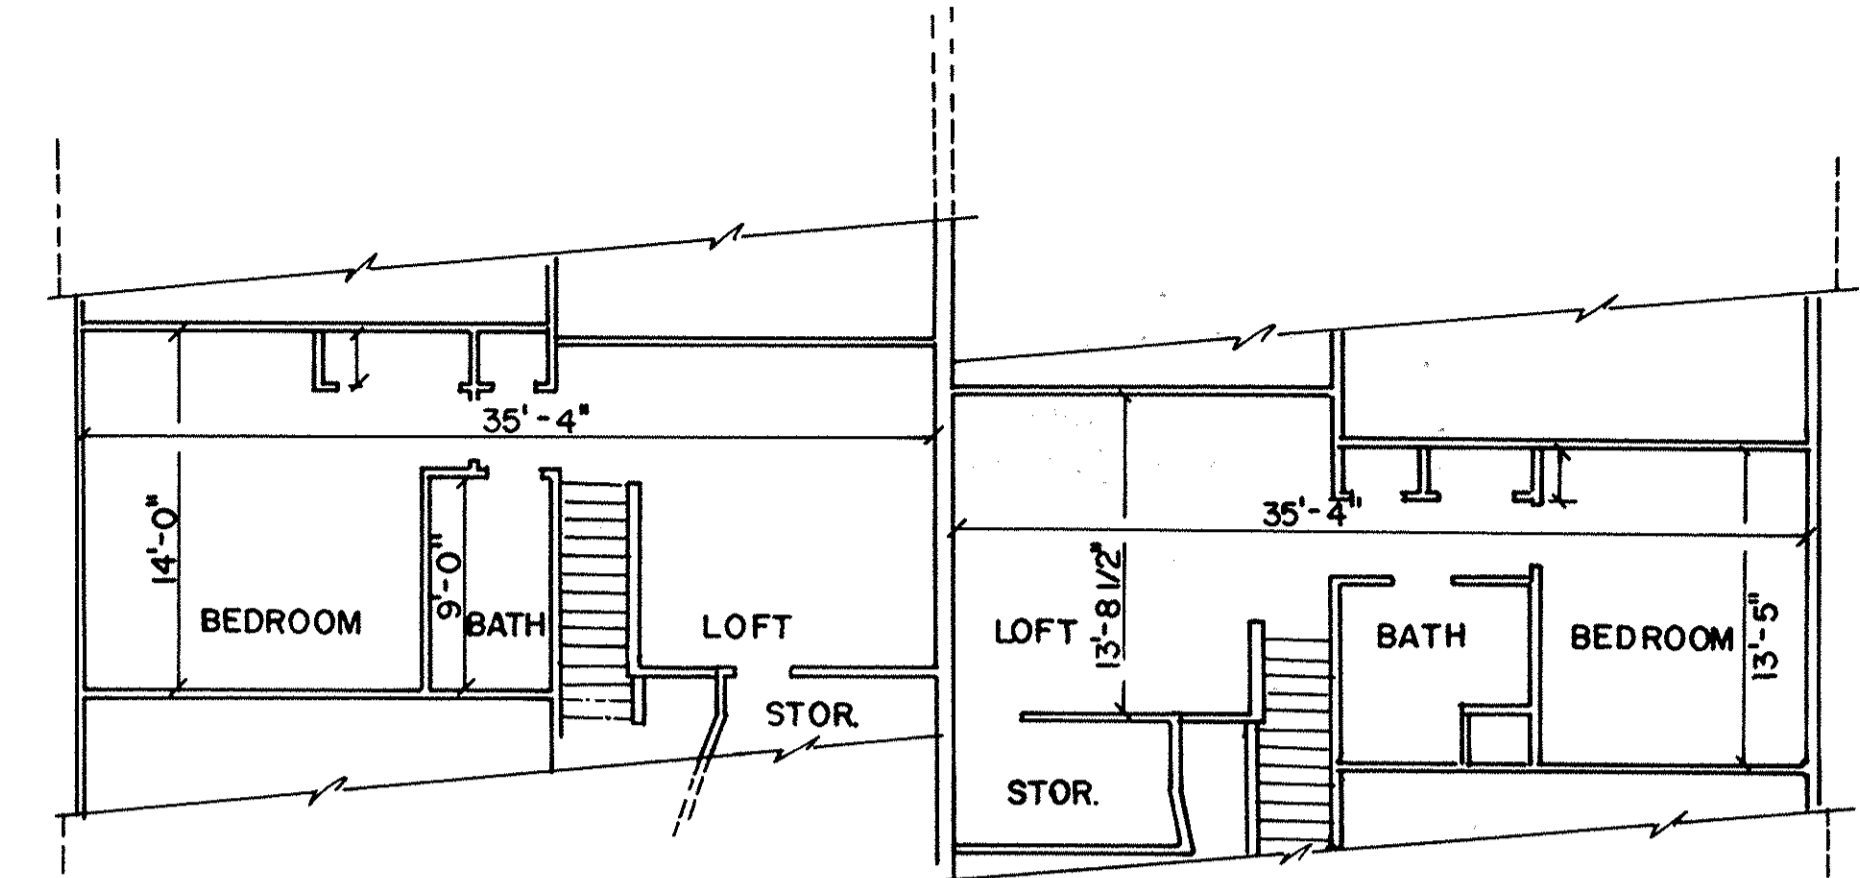

SECOND FLOOR PLAN
SCALE: 1/8" = 1'-0"

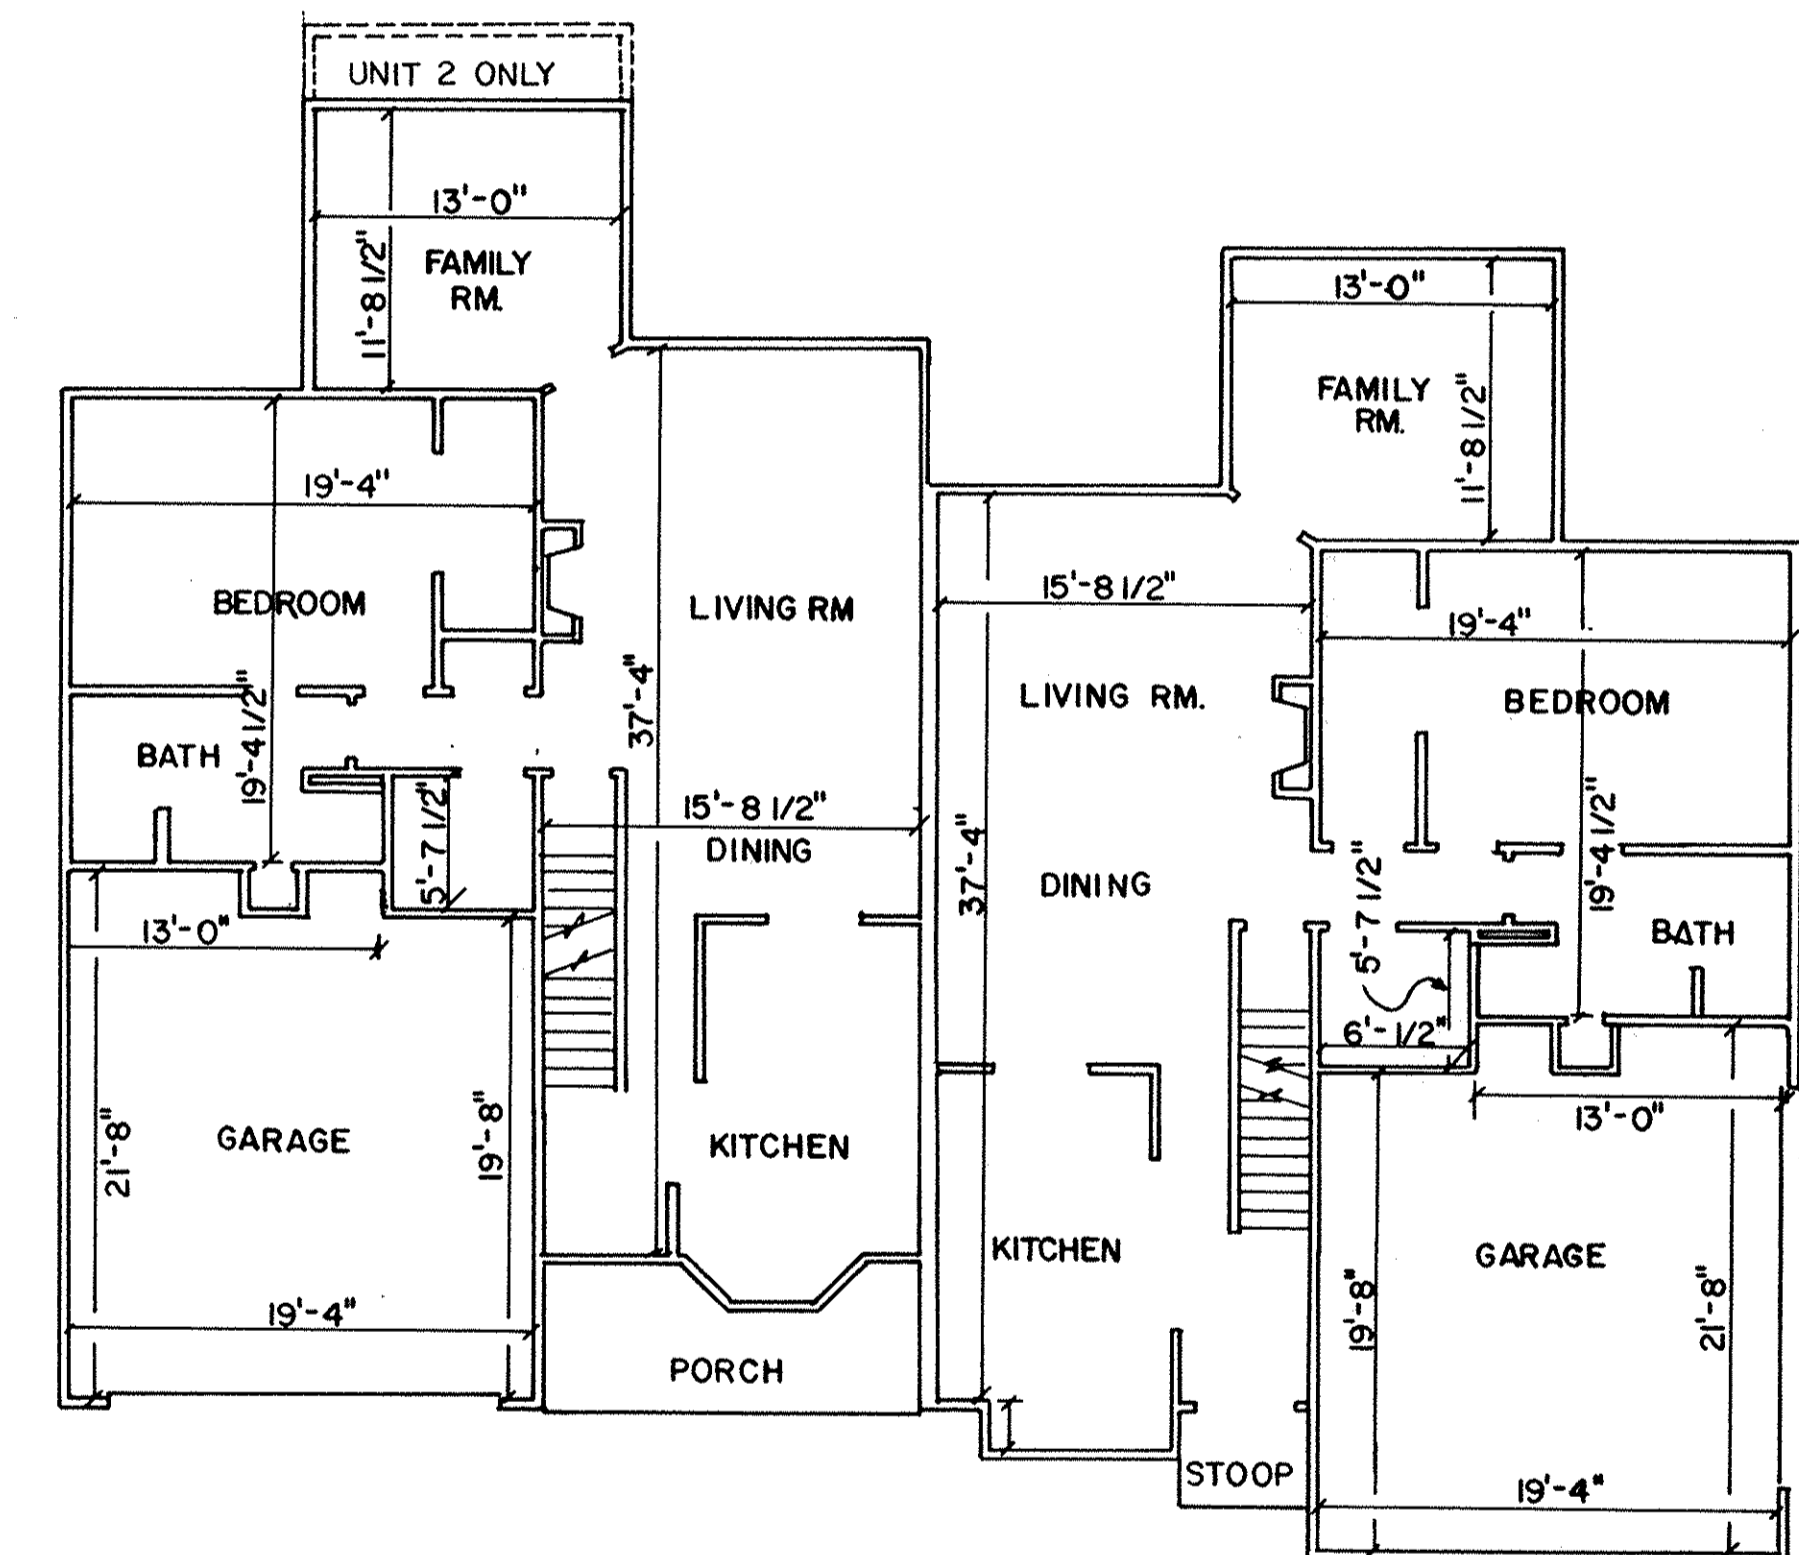

FIRST FLOOR PLAN
SCALE: 1/8" = 1'-0"

VILLAS AT HIGHLAND PARK PHASE I
FOUNDATION PLAN
FLOOR PLANS


LORAIN COUNTY TAX
MAP DEPARTMENT COPY

#266718


#266718




FRONT ELEVATION

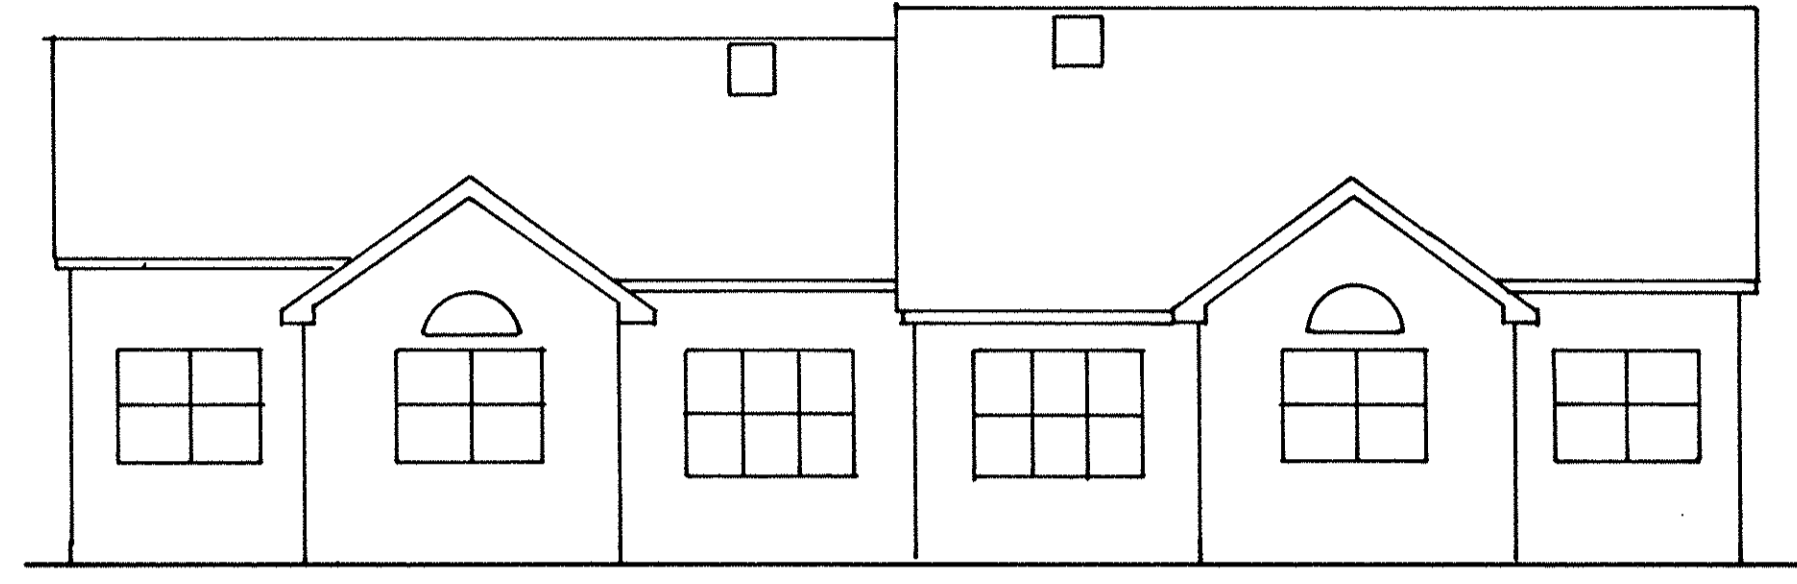

REAR ELEVATION

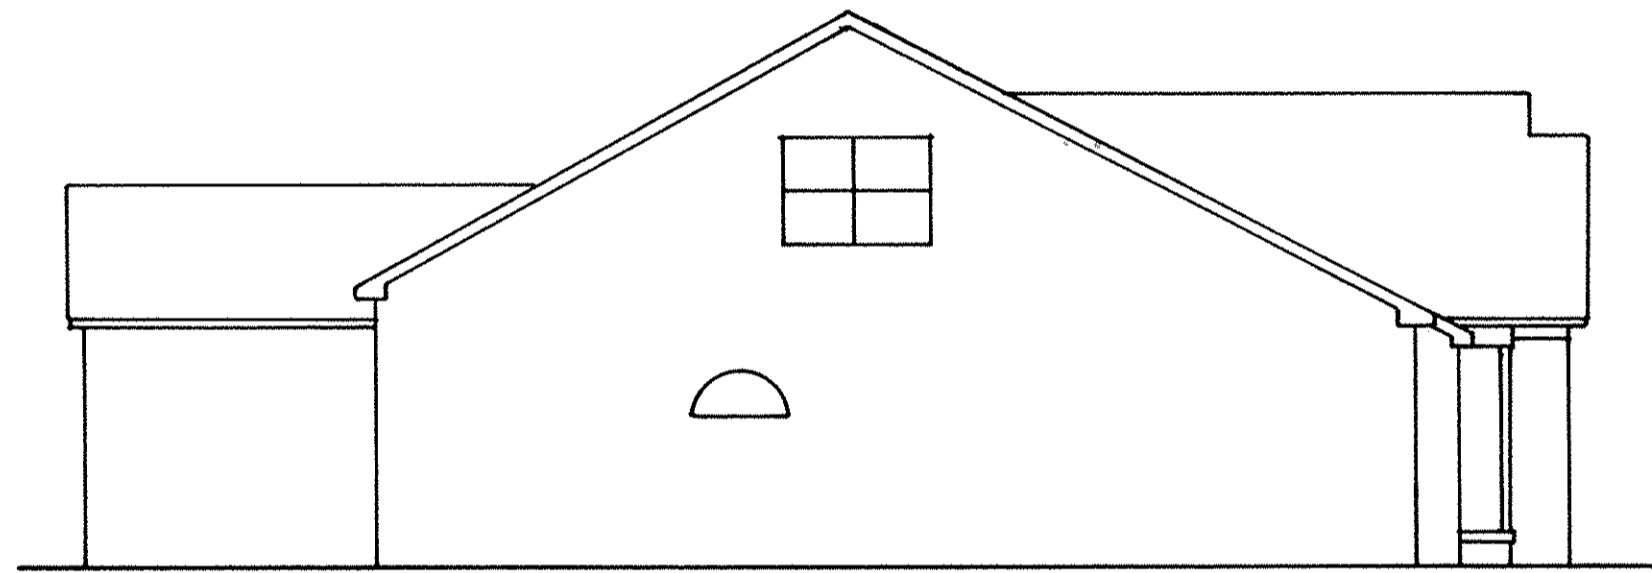

LEFT SIDE ELEVATION

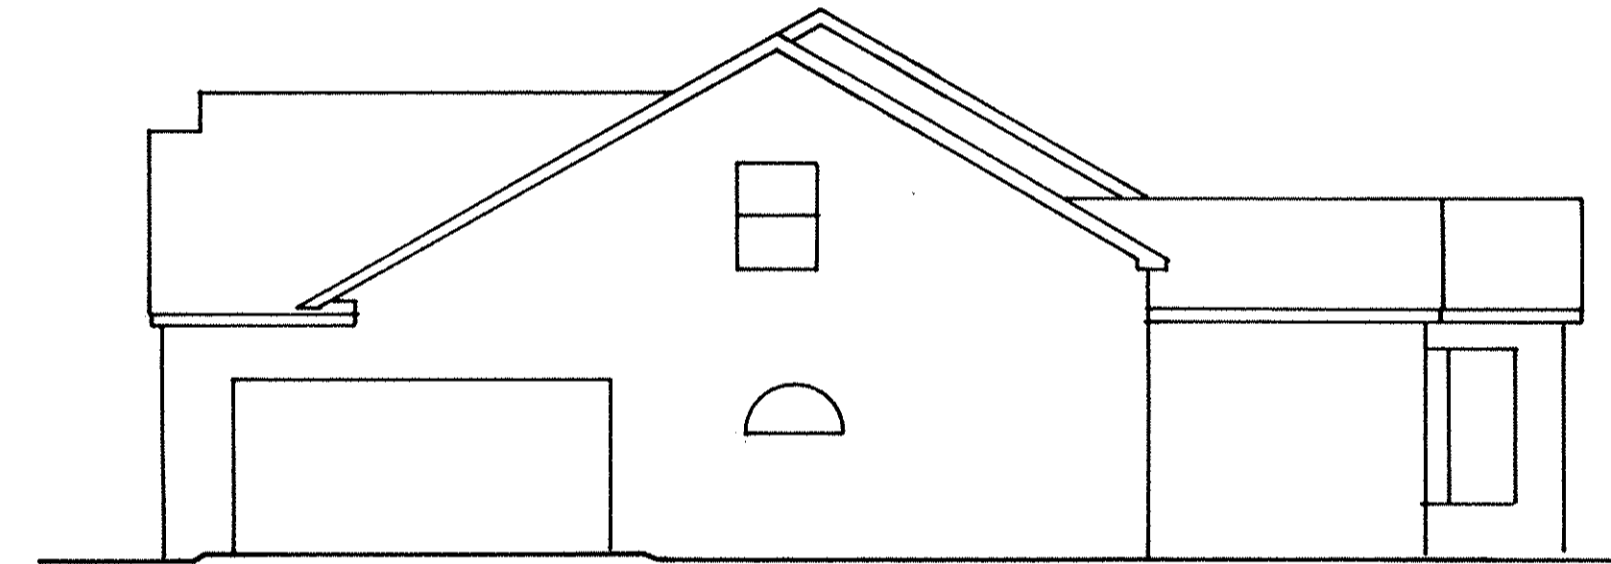

RIGHT SIDE ELEVATION

VILLAS AT HIGHLAND PARK PHASE I
EXTERIOR ELEVATIONS

LORAIN COUNTY TAX
MAP DEPARTMENT COPY