

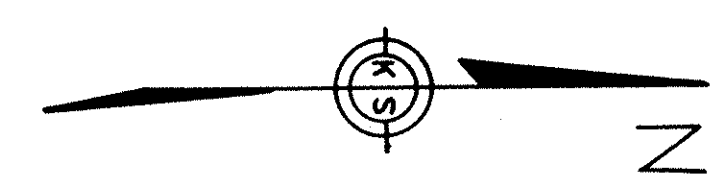


277254

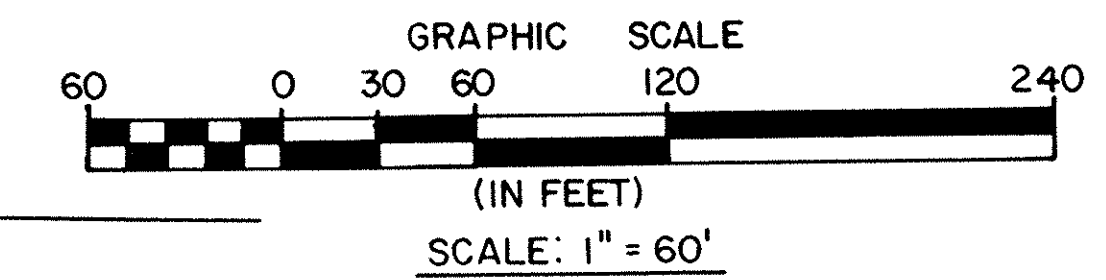

CURVE TABLE					
CURVE	RADIUS	DELTA	LENGTH	CHORD	BEARING
C-1	28.00'	49°44'34"	24.31'	23.55'	S 66°06'42" W
C-2	28.00'	40°13'43"	19.66'	19.26'	S 21°07'34" W
C-3	28.00'	89°58'17"	43.97'	39.59'	S 45°59'50" W

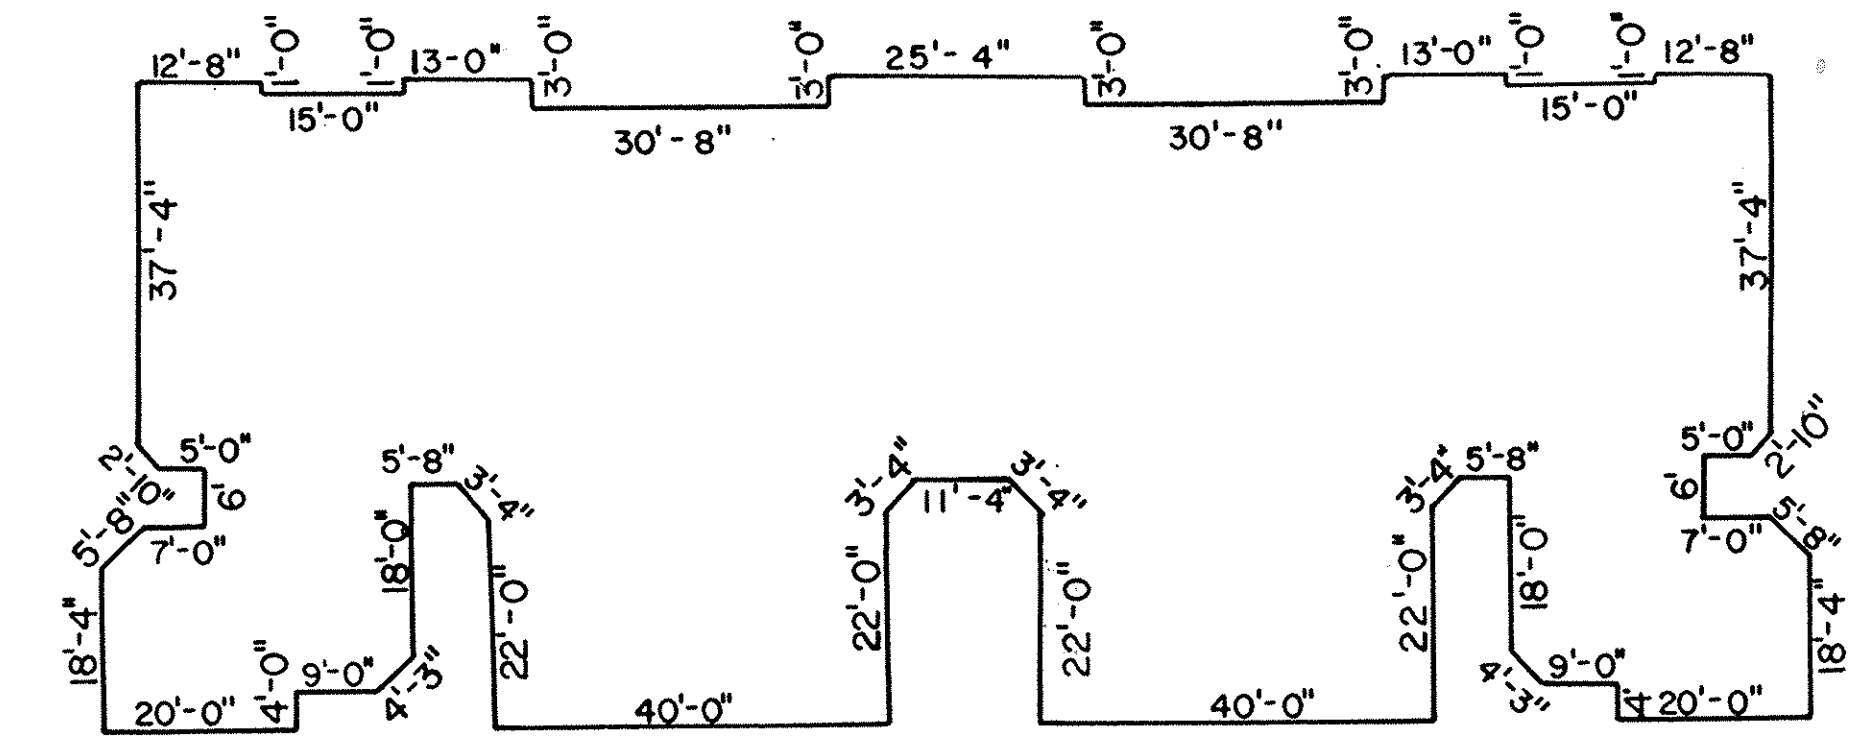

FOUNDATION PLAN SCALE: 1\"/>

OWNERSHIP TABLE			
UNIT NO.	SQ. FT.	ELEV. IST FL.	% OWNERSHIP
1-101	1388	723.40	4.0048
2-103	1626	723.40	4.6916
3-105	1769	723.40	5.1042
4-107	1388	723.40	4.0048
5-141	1388	719.38	4.0048
6-143	1626	719.38	4.6916
7-145	1769	719.38	5.1042
8-147	1388	719.38	4.0048
9-151	1388	719.53	4.0048
10-153	1626	719.53	4.6916
11-155	1769	719.53	5.1042
12-157	1388	719.53	4.0048
13-109	1388	722.30	4.0048
14-111	1626	722.30	4.6916
15-113	1769	722.30	5.1042
16-114	1388	722.30	4.0048
17-129	1388	720.10	4.0048
18-131	1626	720.10	4.6916
19-133	2177	720.10	6.2814
20-135	1769	720.10	5.1042
21-137	1626	720.10	4.6916
22-139	1388	720.10	4.0048
TOTAL	34,658		100.0000



NOTE: AREA OF BASEMENTS ARE NOT USED IN DETERMINING CONDOMINIUM OWNERSHIP.

Received for Records FEB 18 1994
at 2:50 clock P.M. in PLAT RECORD
VOL. 52 MARY ANN JAMISON
PAGES 54, 55 + 56 inc
Box: LCT (L.M.)

TRANSFERRED IN COMPLIANCE WITH SEC. 319-202 OHIO REV. CODE
FEB 18 1994
JULIAN A. PIJOR
LORAIN COUNTY AUDITOR

CERTIFICATION
THIS IS TO CERTIFY THAT THE ATTACHED DRAWINGS CORRECTLY REPRESENT THE BUILDINGS AS CONSTRUCTED AND THAT THERE ARE NO ENCROACHMENTS ON ADJACENT PROPERTIES.

David L. Elwell
DAVID L. ELWELL
REG. SURVEYOR NO. 6333
Lynn S. Miggins
LYNN S. MIGGINS
REG. ENGINEER NO. 46837

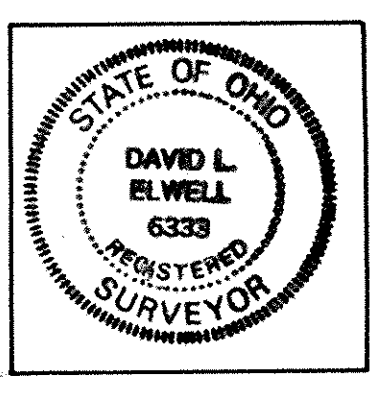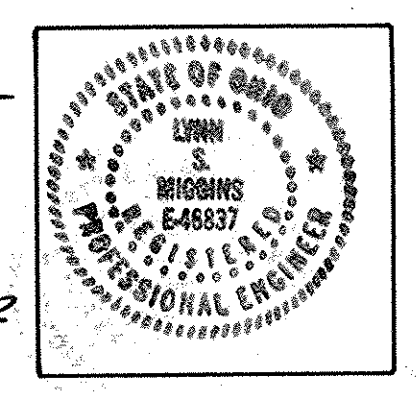


NO.	DESCRIPTION	DATE

THE ENGLISH LAKES CONDOMINIUMS
PHASE 5
PART OF AMHERST TWP. O.L. 25 & 26
CITY OF AMHERST • COUNTY OF LORAIN • STATE OF OHIO

KS ASSOCIATES, INC.
ENGINEERS/SURVEYORS
424 Middle Avenue
P.O. Box 89
Elyria, Ohio 44036
Elyria (216) 322-6317 • Lorain (216) 244-5757

ENGINEERS/SURVEYORS
INCORPORATED


SHEET 1 OF 3
JOB NO. 89224-CP5

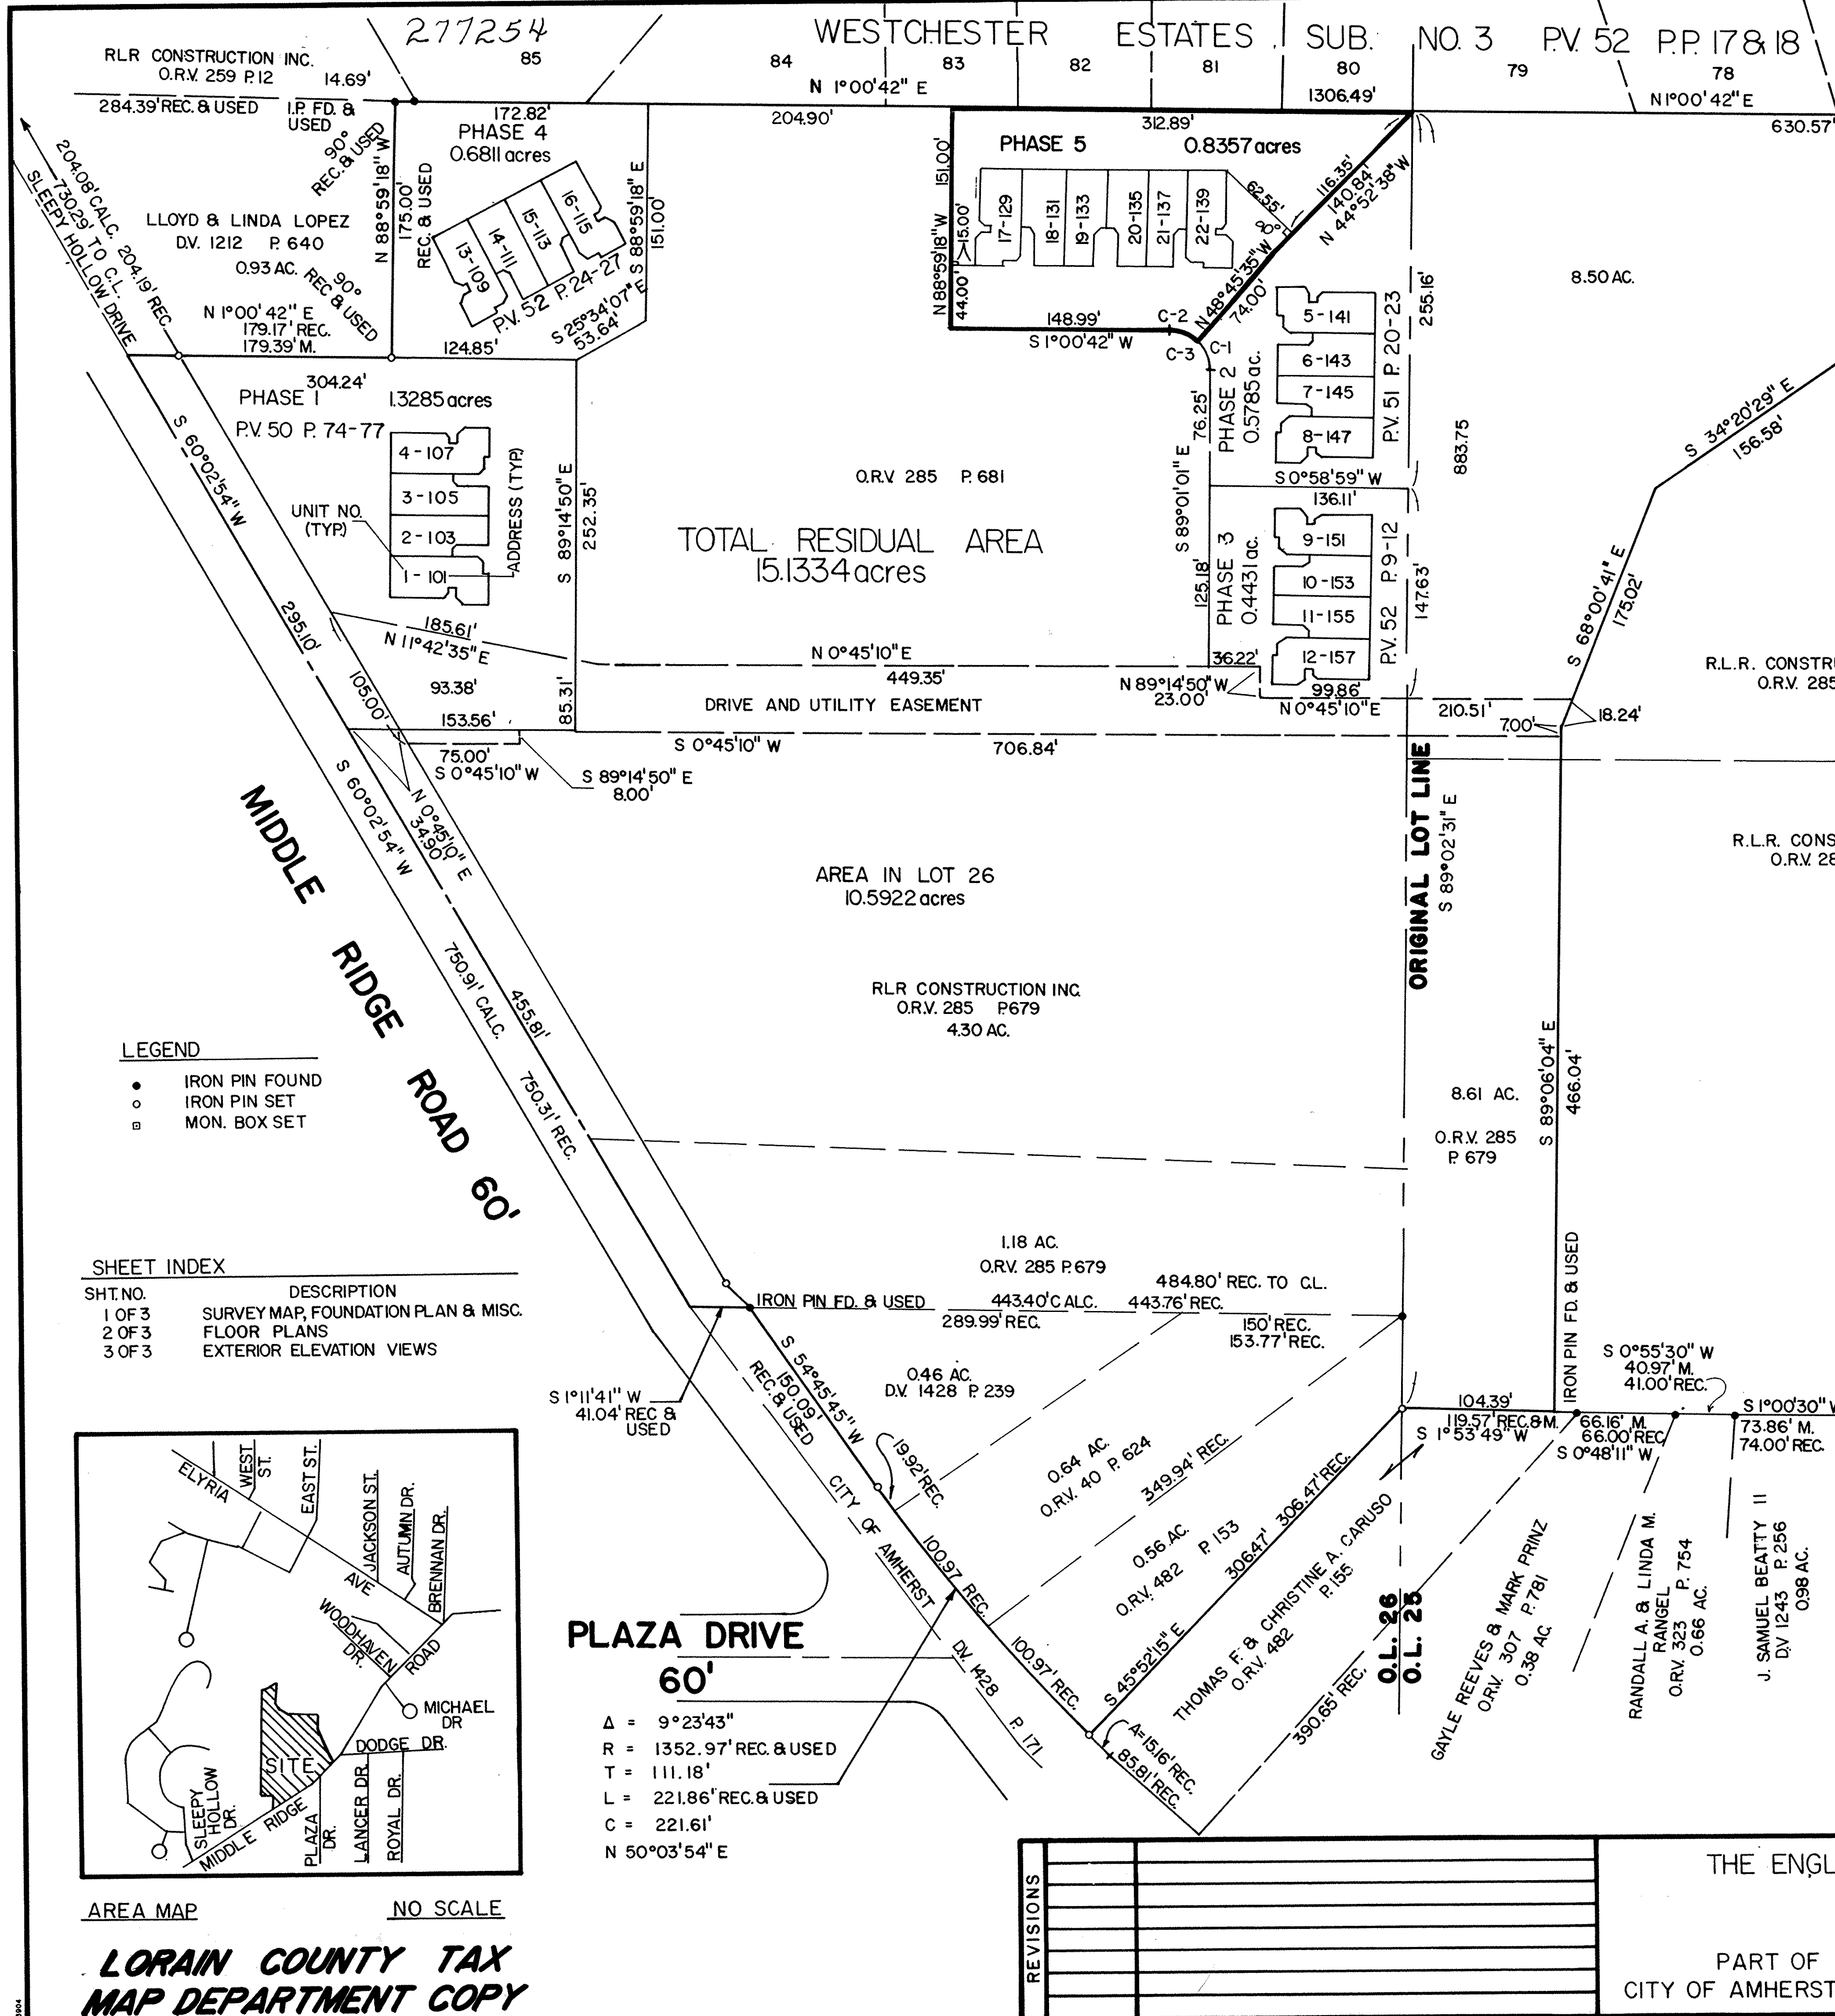


- LEGEND
- IRON PIN FOUND
 - IRON PIN SET
 - MON. BOX SET

SHEET INDEX


SHT. NO.	DESCRIPTION
1 OF 3	SURVEY MAP, FOUNDATION PLAN & MISC.
2 OF 3	FLOOR PLANS
3 OF 3	EXTERIOR ELEVATION VIEWS

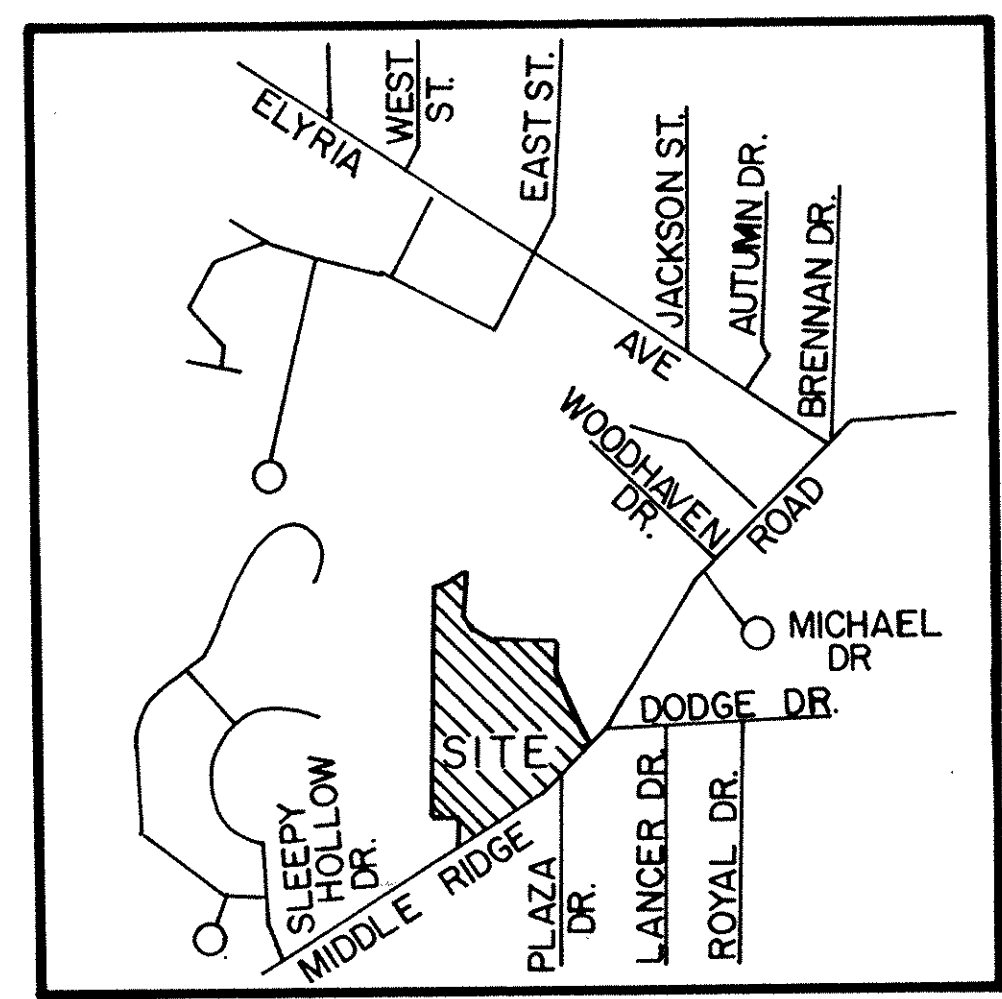


AREA MAP NO SCALE
LORAIN COUNTY TAX MAP DEPARTMENT COPY

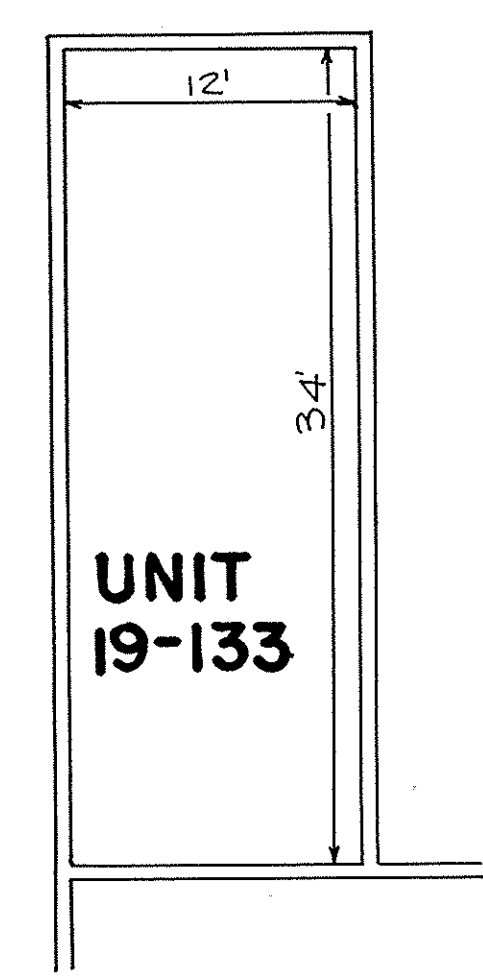

THIRD FLOOR PLAN
SCALE: 1/8" = 1'-0"

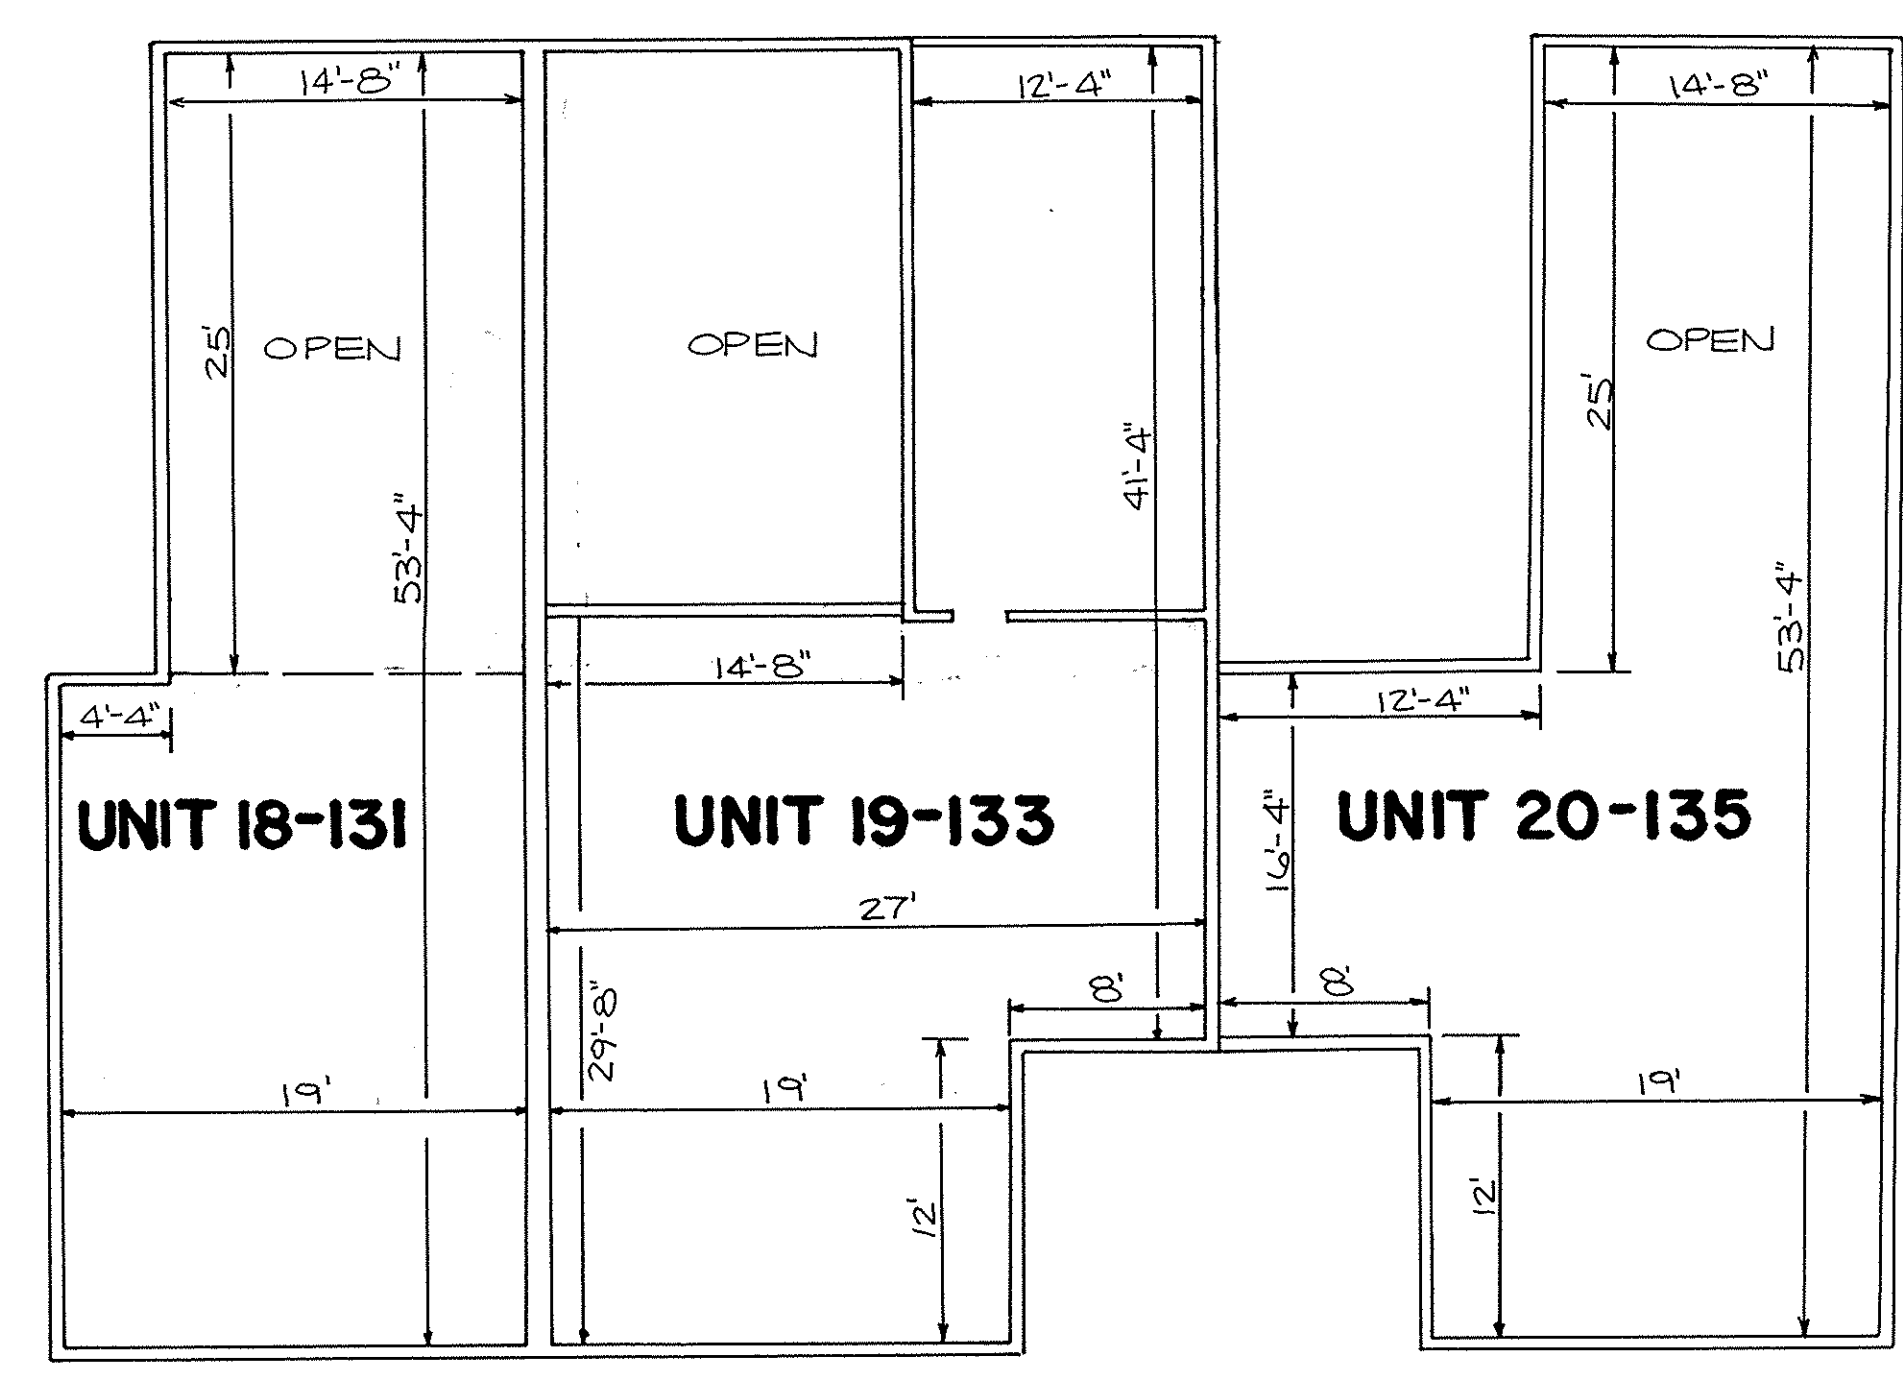

SECOND FLOOR PLAN
SCALE: 1/8" = 1'-0"

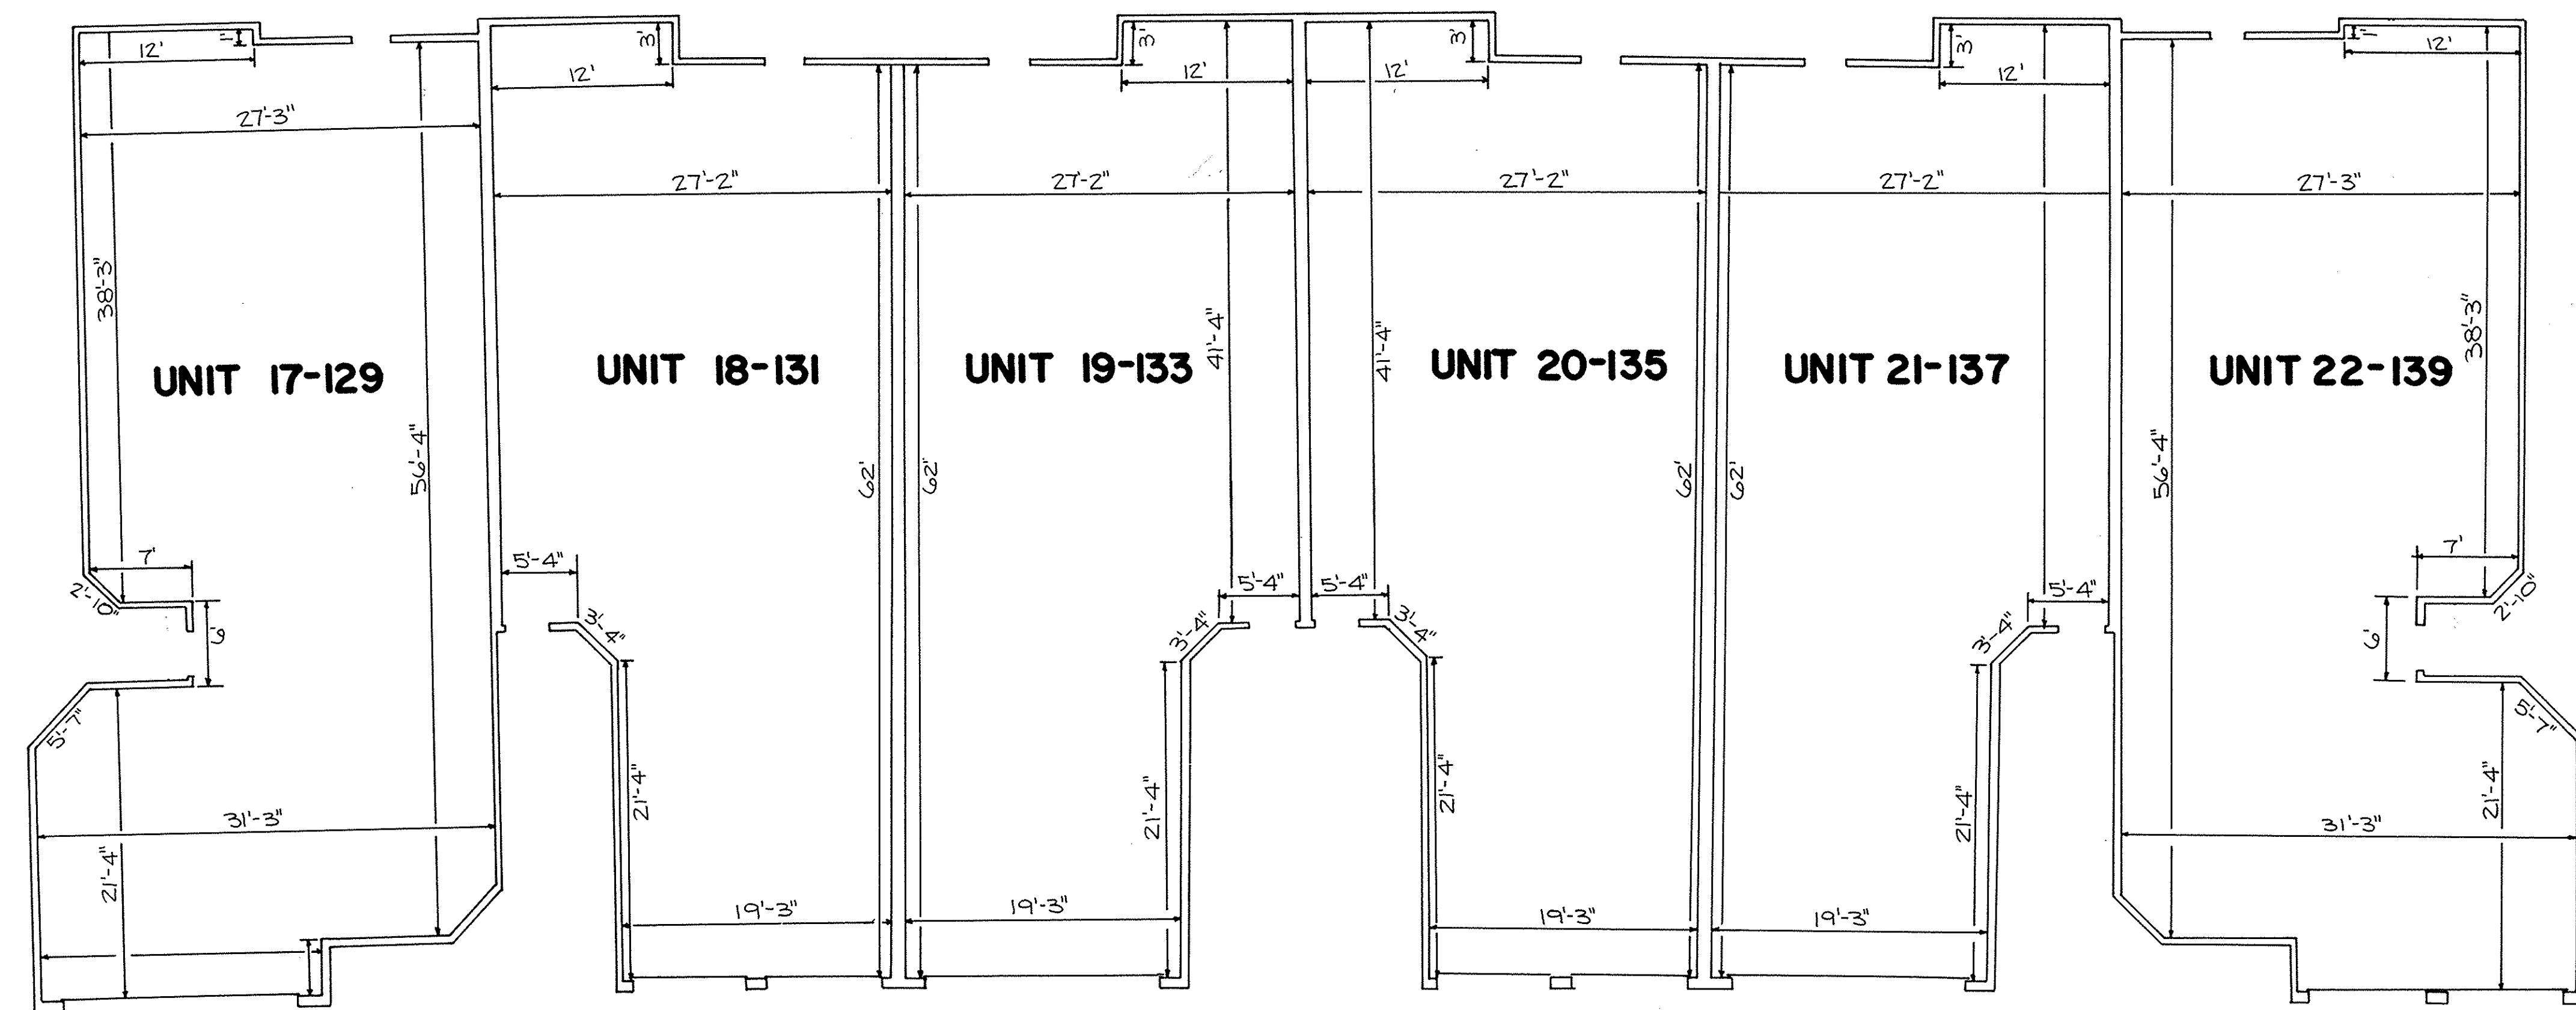

FIRST FLOOR PLAN
SCALE: 1/8" = 1'-0"

LORAIN COUNTY TAX
MAP DEPARTMENT COPY

REVISIONS		





THE ENGLISH LAKES CONDOMINIUMS
PHASE 5

FLOOR PLANS


KS ASSOCIATES, INC.
ENGINEERS/SURVEYORS
424 Middle Avenue
P.O. Box 89
Elyria, Ohio 44036
Elyria (216) 322-6317 • Lorain (216) 244-5757



SHEET
2 OF
3
JOB NO.
89-224-CP5

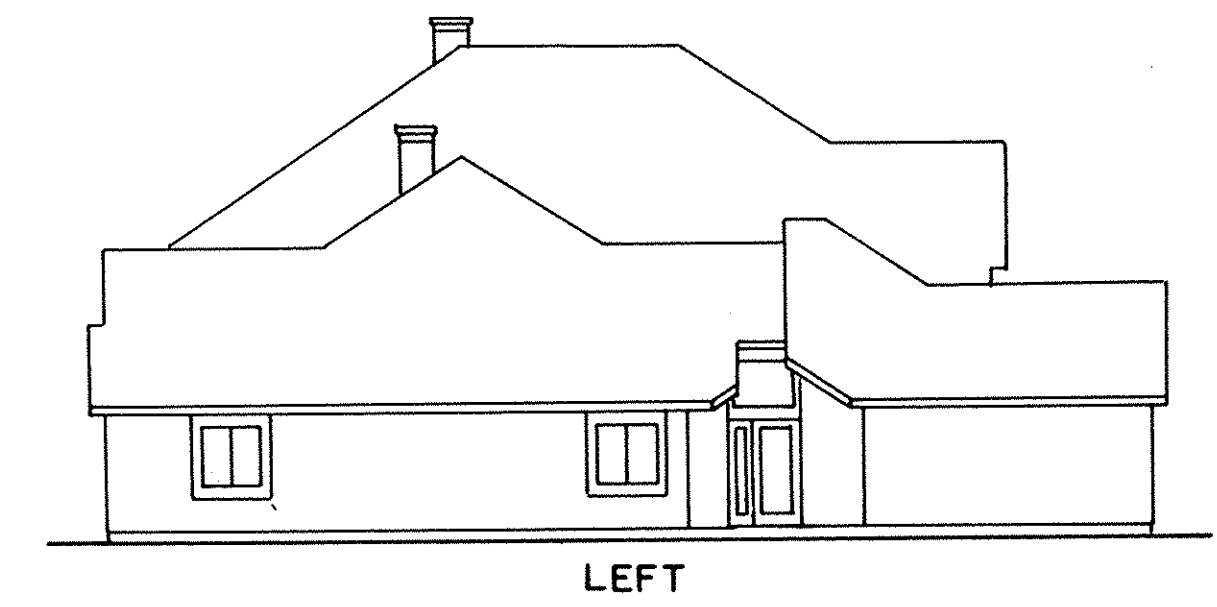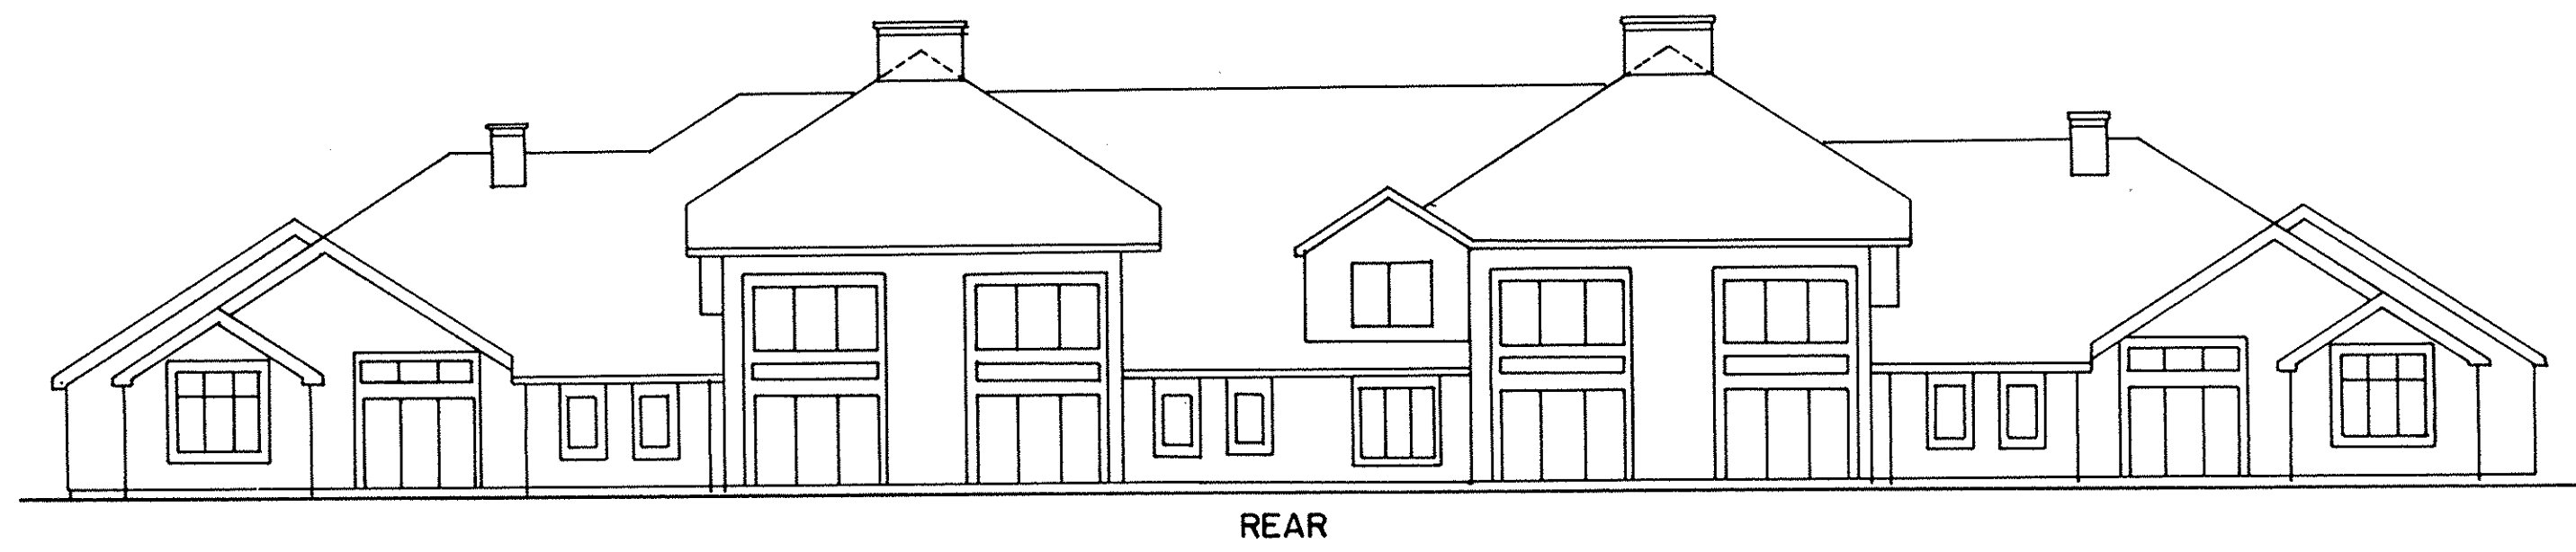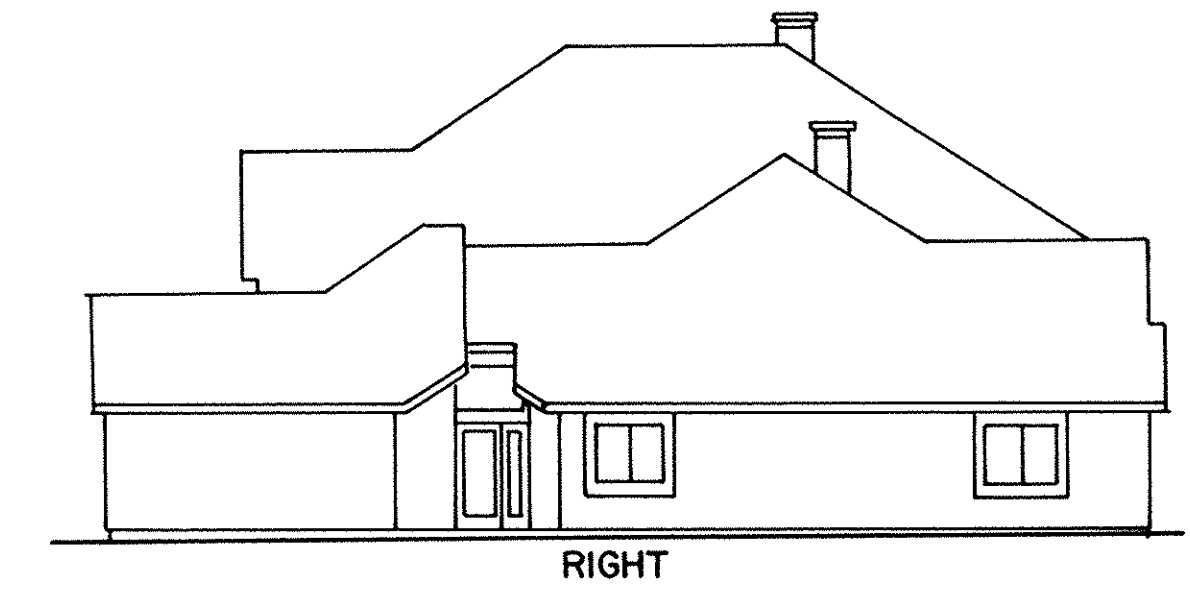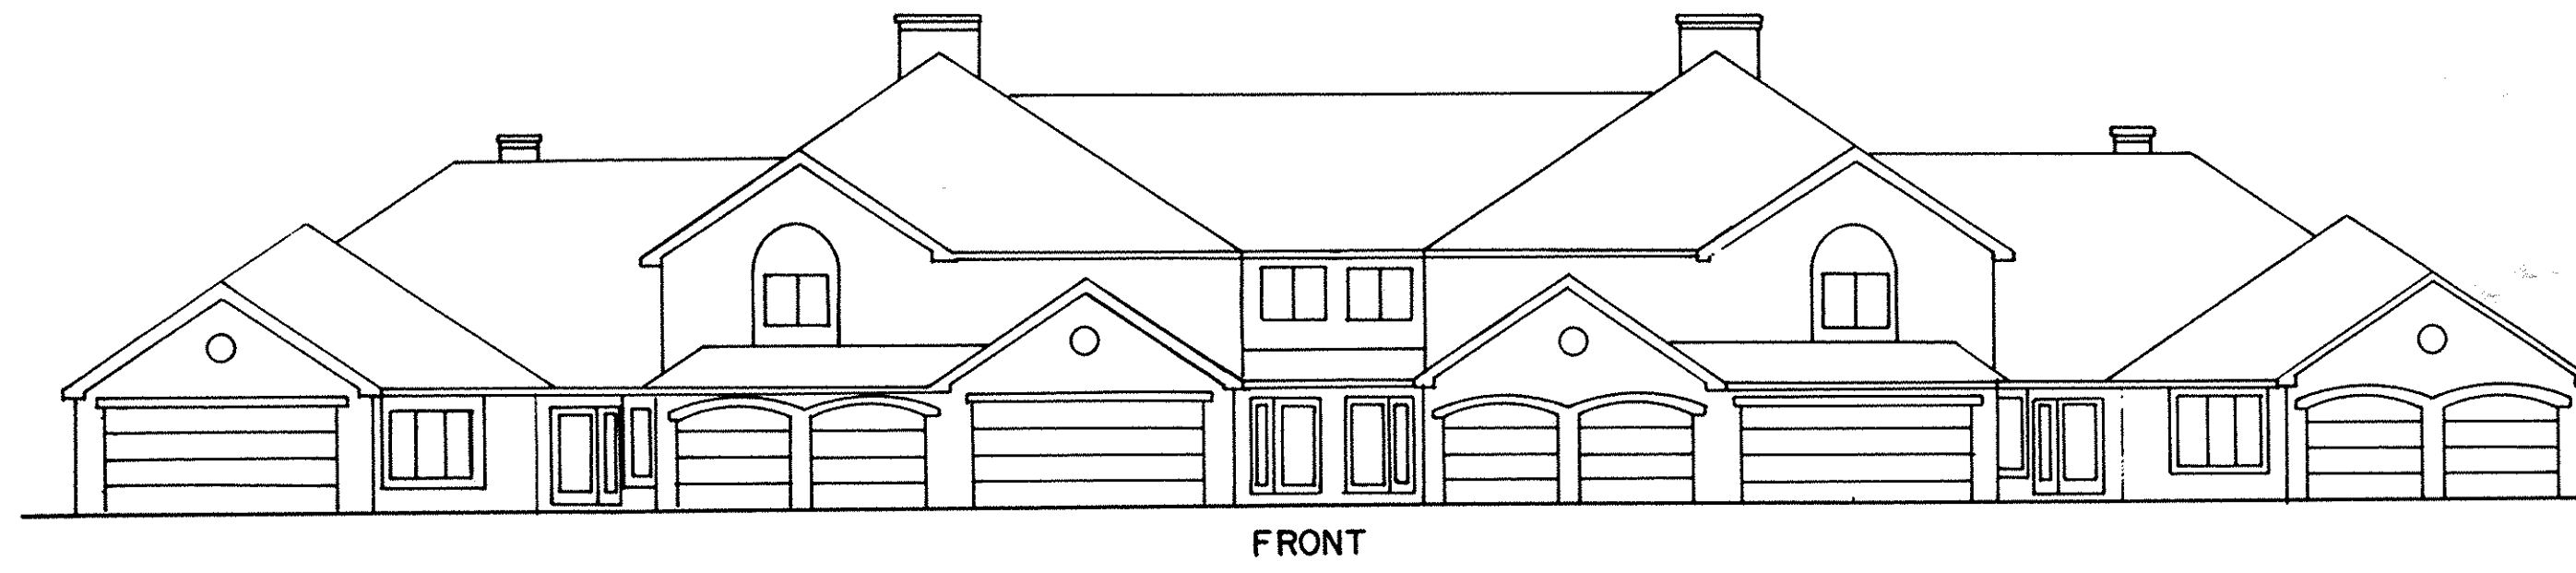

APPROVED BY: MARY ANN JAMISON
 DATE: 11/13/03
 TITLE: COUNTY RECORDER

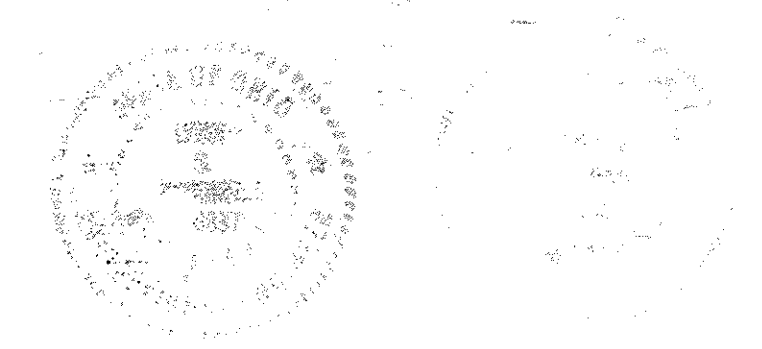

LORAIN COUNTY TAX
 MAP DEPARTMENT COPY

REVISIONS		

THE ENGLISH LAKES CONDOMINIUMS
 PHASE 5

EXTERIOR ELEVATIONS

KS ASSOCIATES, INC.
 ENGINEERS/SURVEYORS
 424 Middle Avenue
 P.O. Box 89
 Elyria, Ohio 44036
 Elyria (216) 322-6317 • Lorain (216) 244-5757



SHEET
 3 OF
 3
 JOB NO.
 89-224-CP