

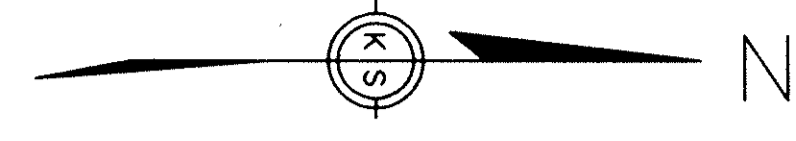


302013

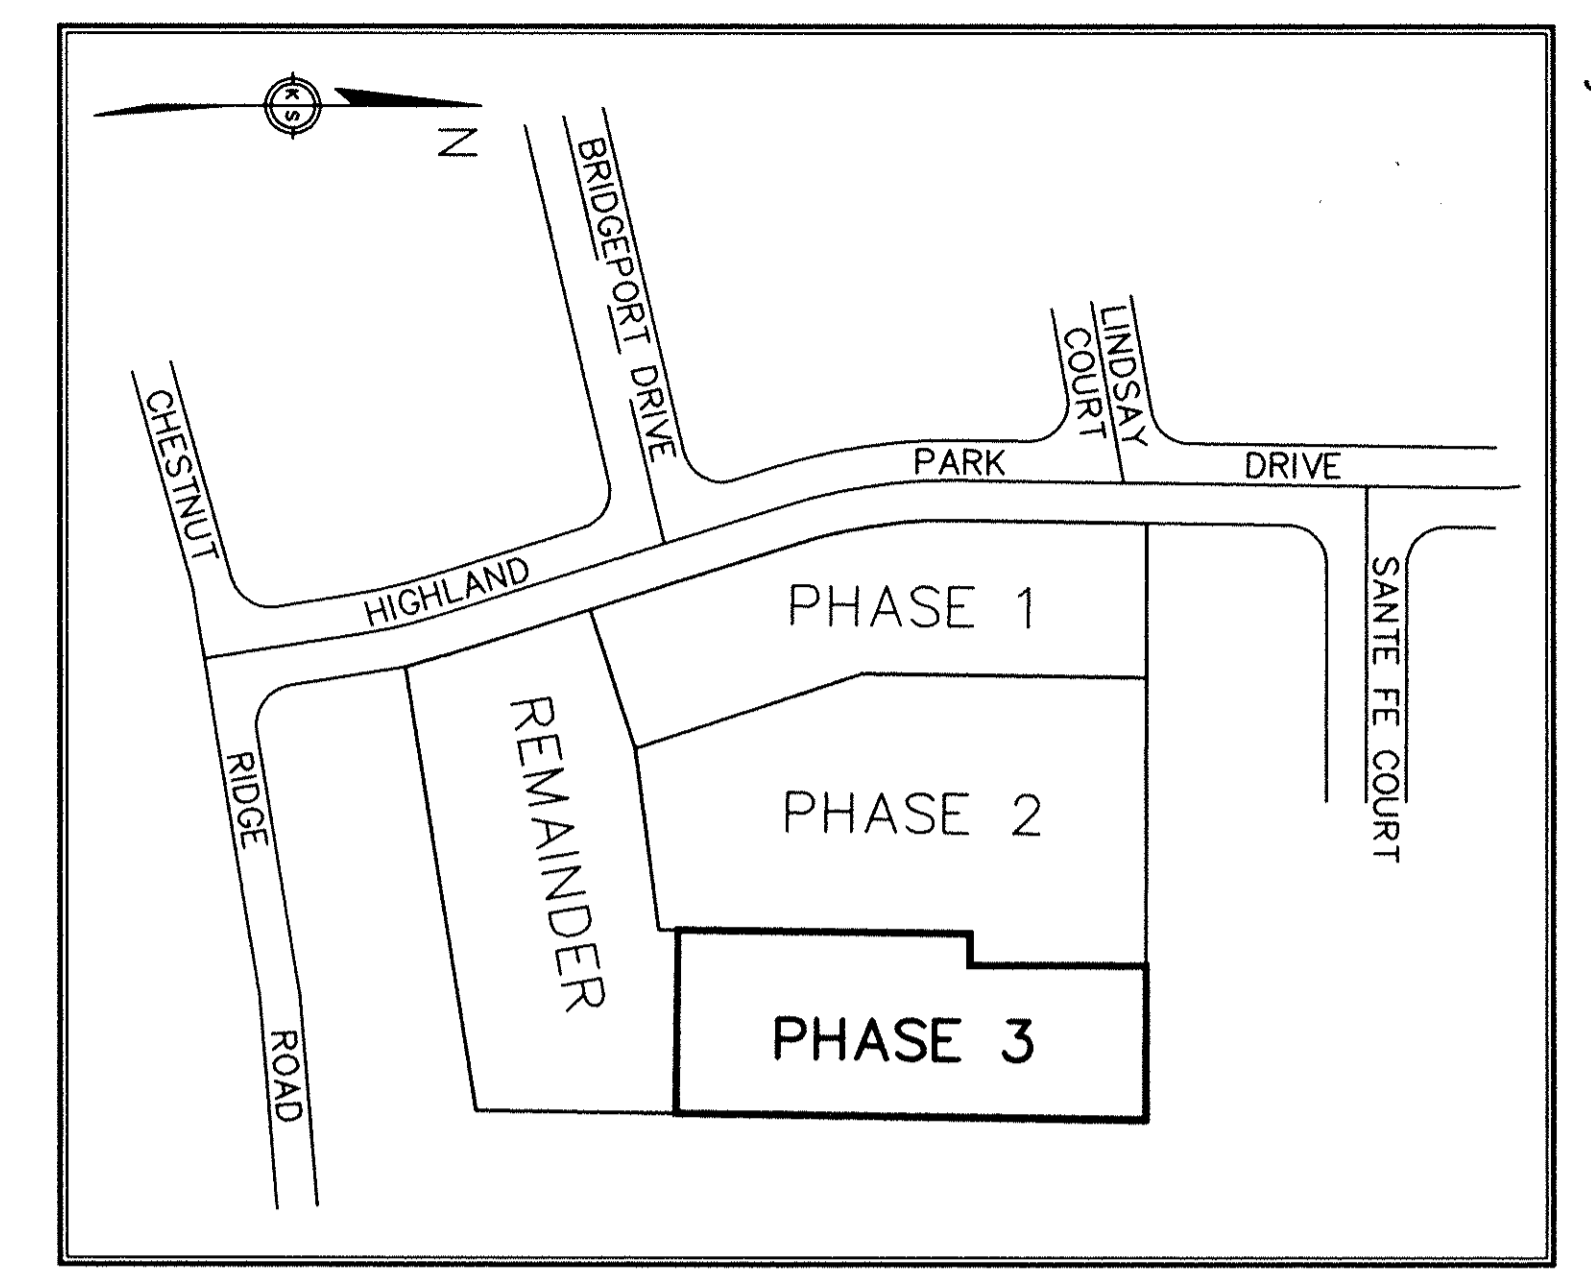

UNIVERSITY OAKS SUBDIVISION NO. 8
P.V. 51 PG. 32

LINDSAY COURT 60'

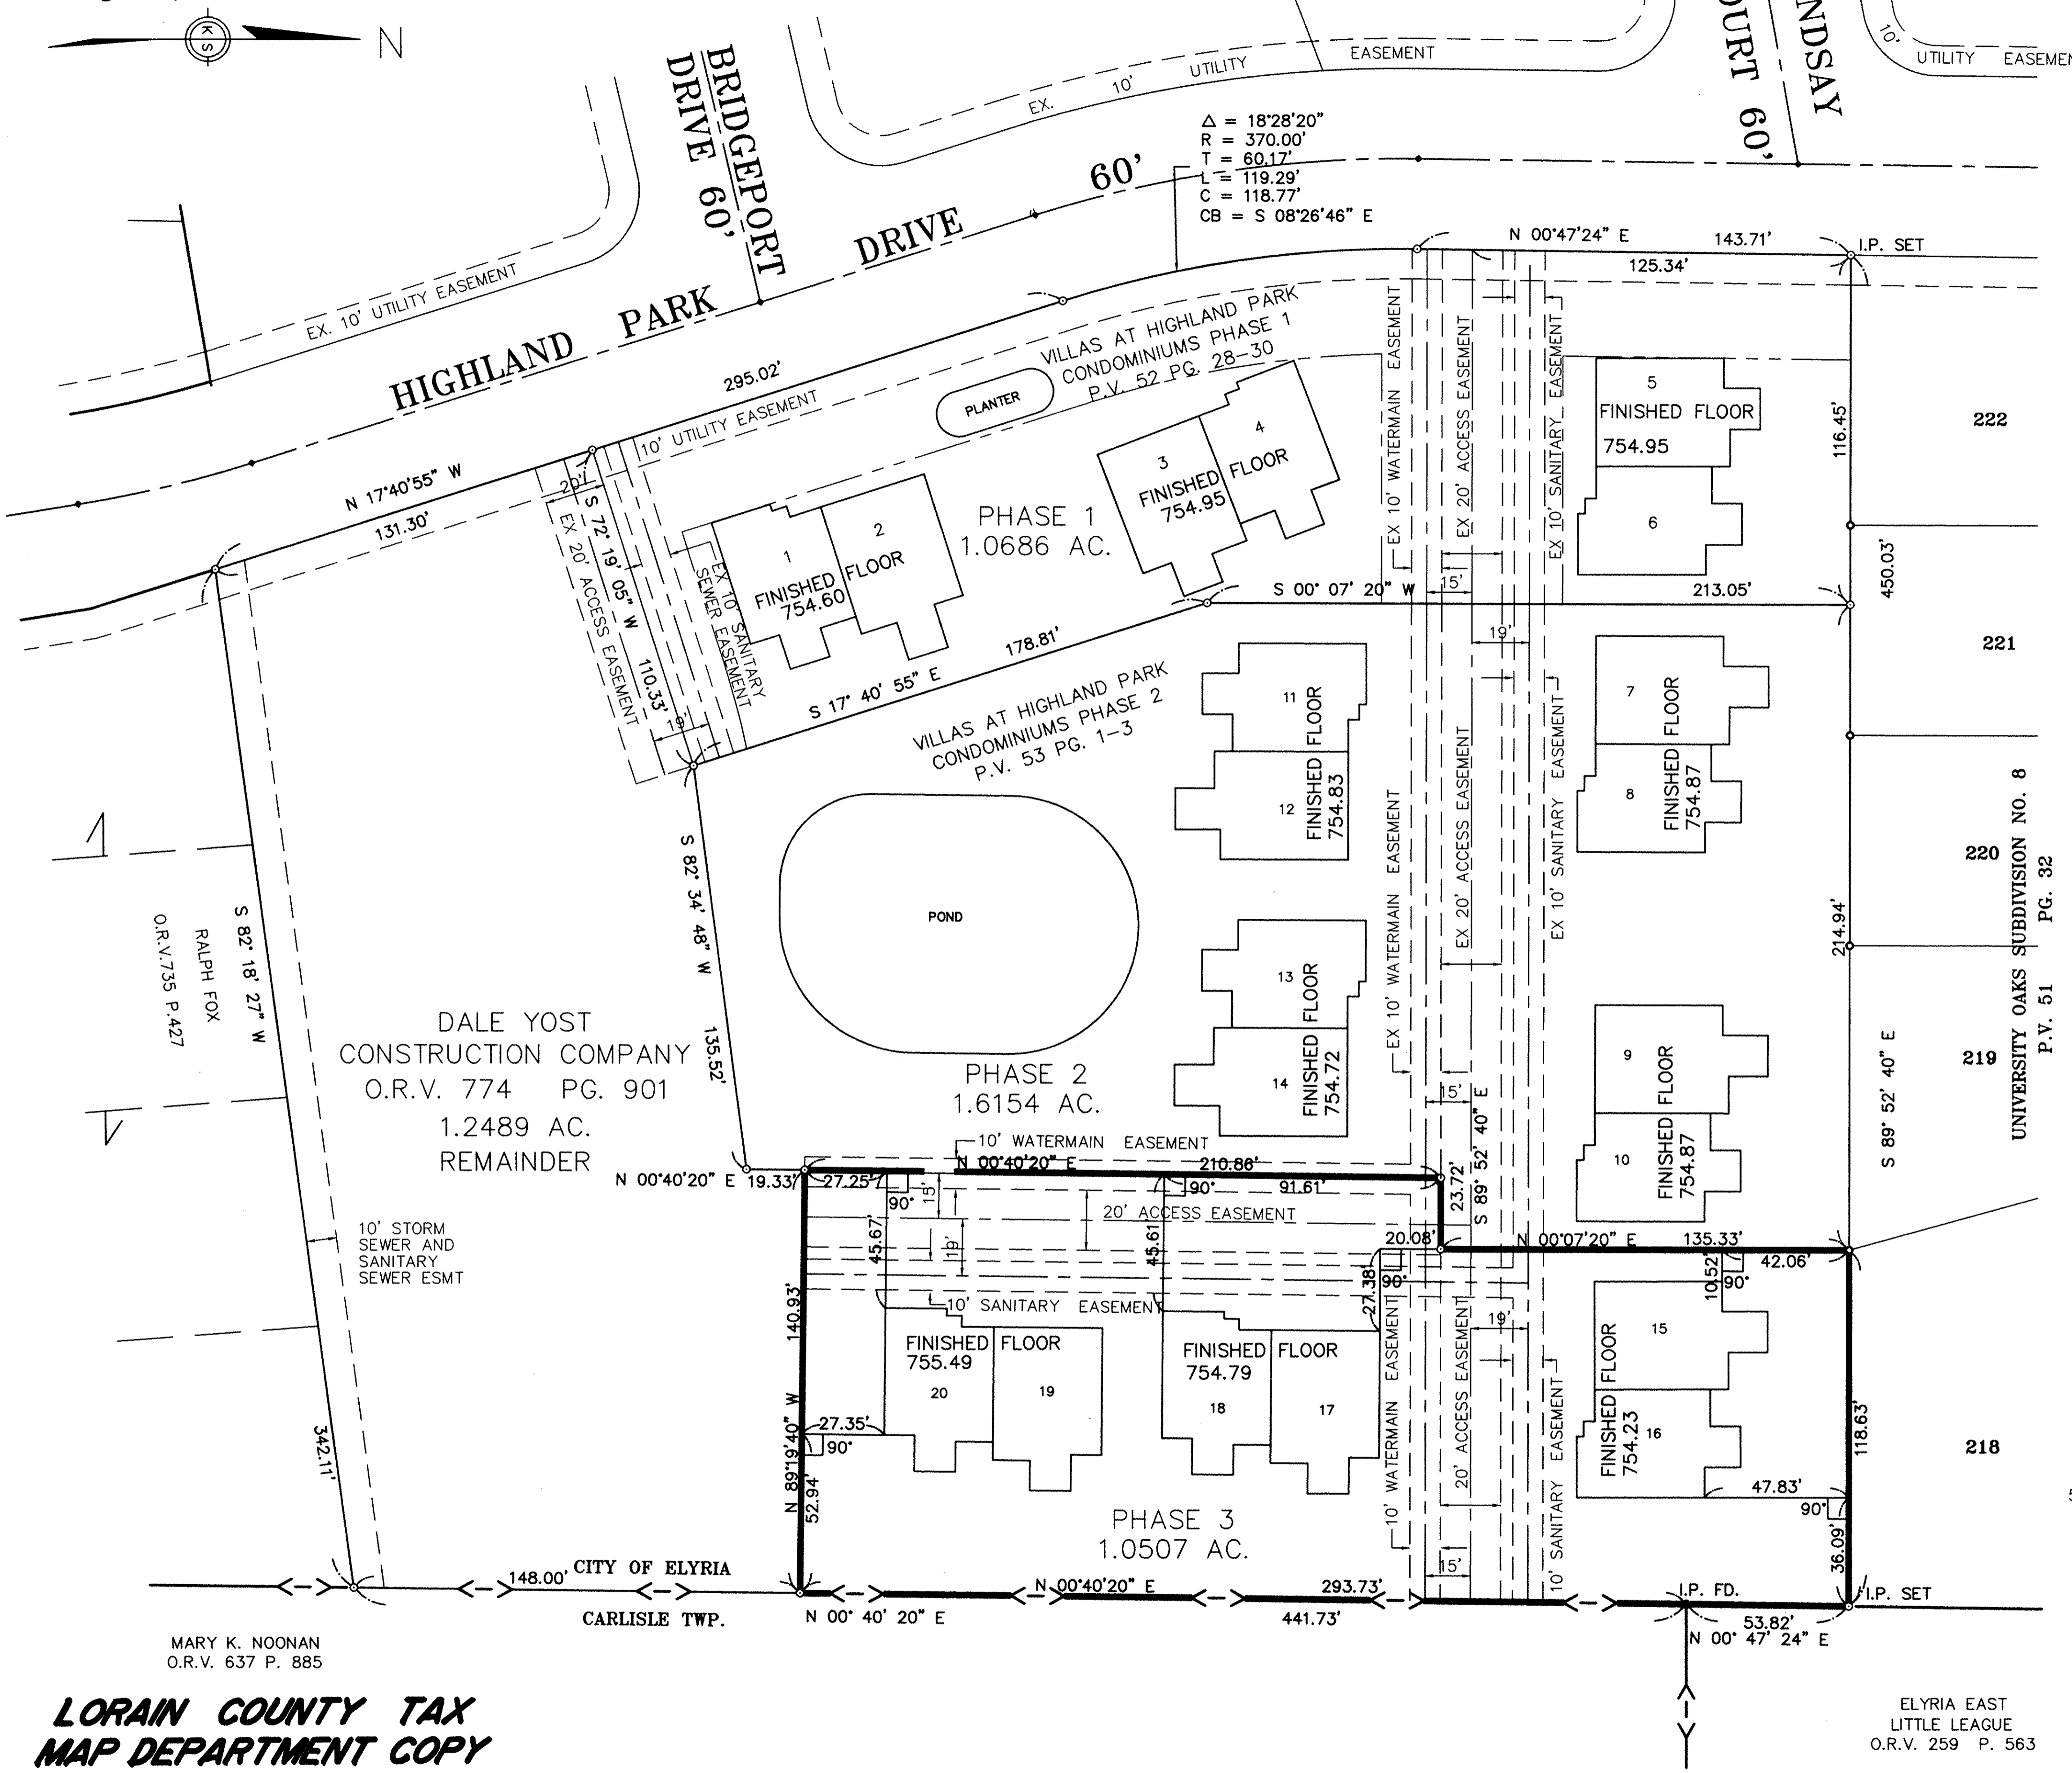

AREA MAP - NO SCALE

302013

CERTIFICATION

THIS IS TO CERTIFY THAT THE ATTACHED DRAWINGS CORRECTLY REPRESENT THE BUILDINGS AS CONSTRUCTED AND THAT THERE ARE NO ENCROACHMENTS ON ADJACENT PROPERTIES.

David L. Elwell
DAVID L. ELWELL
REG. SURVEYOR NO. 6333



Lynn S. Miggins
LYNN S. MIGGINS
REG. ENGINEER NO. 46837



Received for Recording JUL 8 1994
VOL 63 MARY ANN JAMISON
PAGE 5 Lorain County Recorder
27-29 inc. 129⁶⁰ MR
LORAIN COUNTY RECORDER BOX: L.C.T.


TRANSFERRED IN COMPLIANCE WITH SEC. 319-202 OHIO REV. CODE
JUL 8 1994
JULIAN A. PIJOR
LORAIN COUNTY AUDITOR

DALE YOST CONSTRUCTION COMPANY
O.R.V. 774 PG. 901
1.2489 AC.
REMAINDER

RALPH FOX
O.R.V. 735 P. 427

MARY K. NOONAN
O.R.V. 637 P. 885


LORAIN COUNTY TAX MAP DEPARTMENT COPY

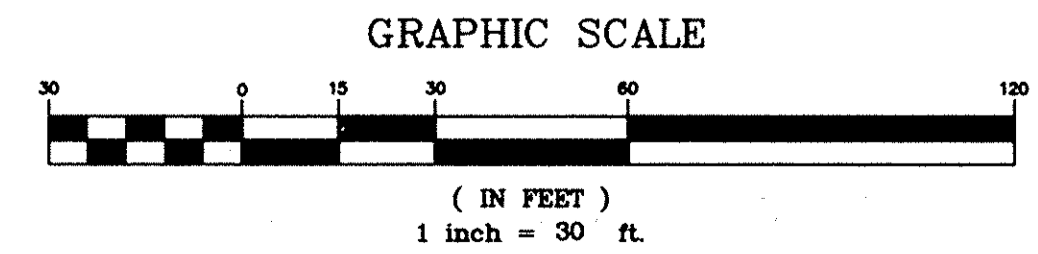


DATE:	6-23-94
DRAWN BY:	JEC/KYS/MJC
CH'D BY:	DLH
F.B.:	183
DWG. NAME:	82814 SURV MAP

VILLAS AT HIGHLAND PARK
CONDOMINIUMS PHASE 3
PART OF CARLISLE TOWNSHIP SECTION 5
CITY OF ELYRIA * COUNTY OF LORAIN * STATE OF OHIO

KS ASSOCIATES, INC.
ENGINEERS/SURVEYORS
424 Middle Avenue
P.O. Box 89
Elyria, Ohio 44036
ELYRIA (216) 322-6317 * LORAIN (216) 244-5757

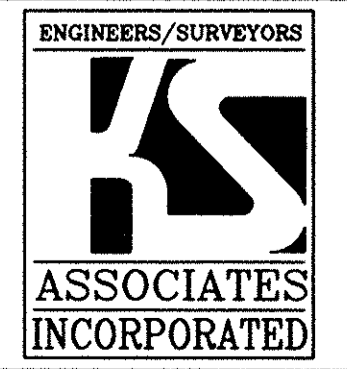


SHEET 1 OF 3
JOB NO. 92-614CP3

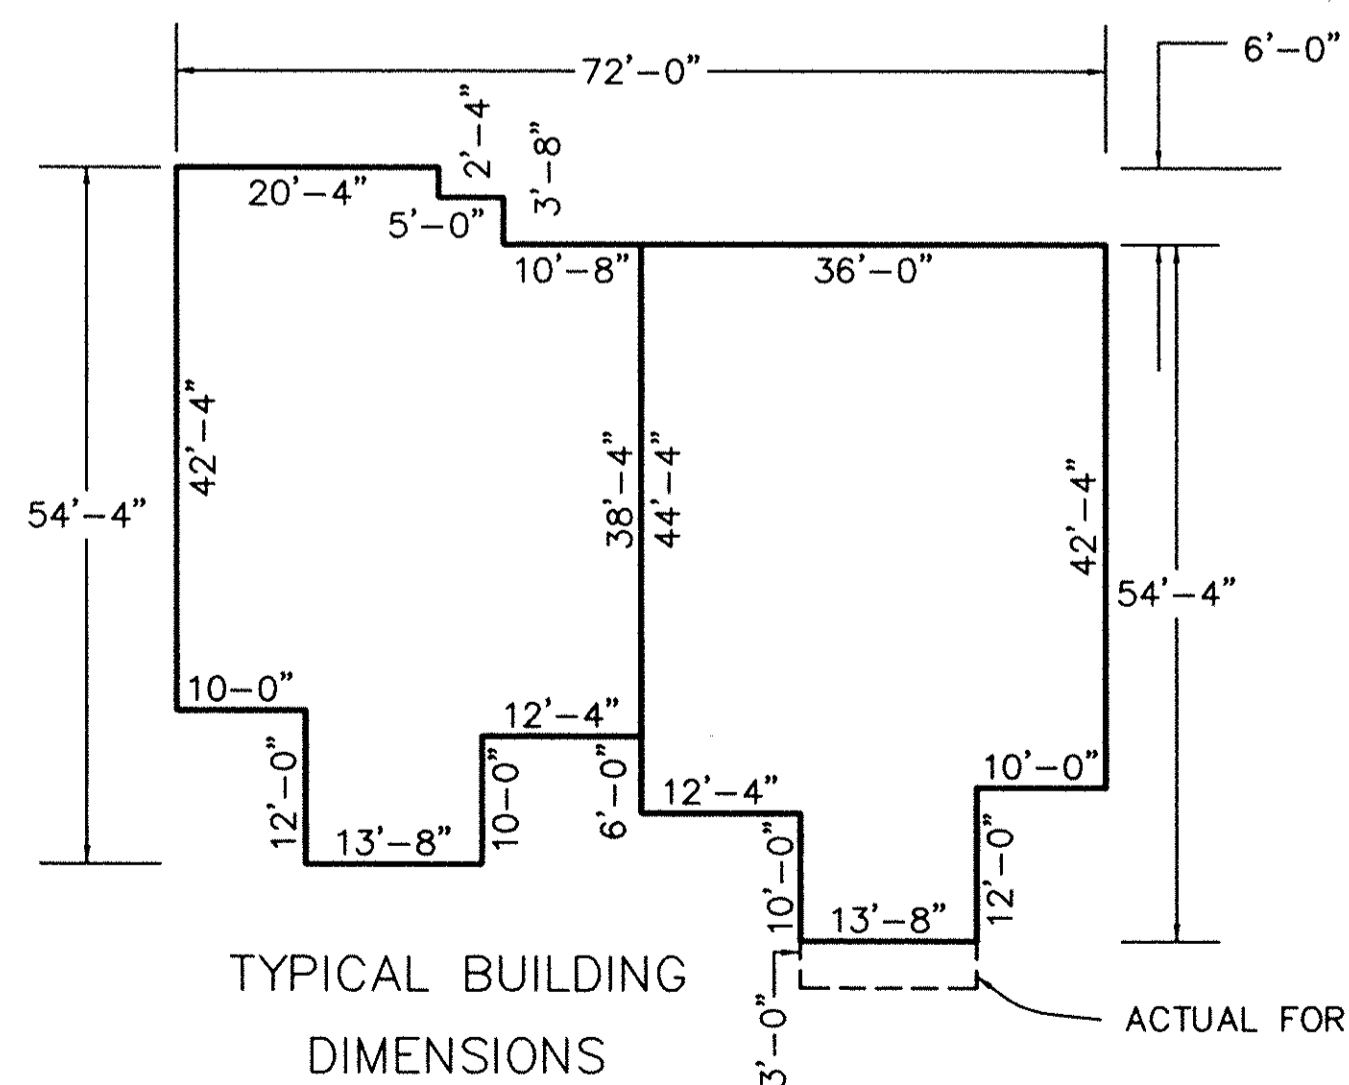

UNIT	SF AREA	% OWNER
1	1717	4.9786
2	1738	5.0395
3	1738	5.0395
4	1717	4.9786
5	1717	4.9786
6	1717	4.9786
7	1738	5.0395
8	1717	4.9786
9	1738	5.0395
10	1717	4.9786
11	1717	4.9786
12	1738	5.0395
13	1717	4.9786
14	1738	5.0395
15	1738	5.0395
16	1717	4.9786
17	1717	4.9786
18	1717	4.9786
19	1717	4.9786
20	1717	4.9786


302013

302013

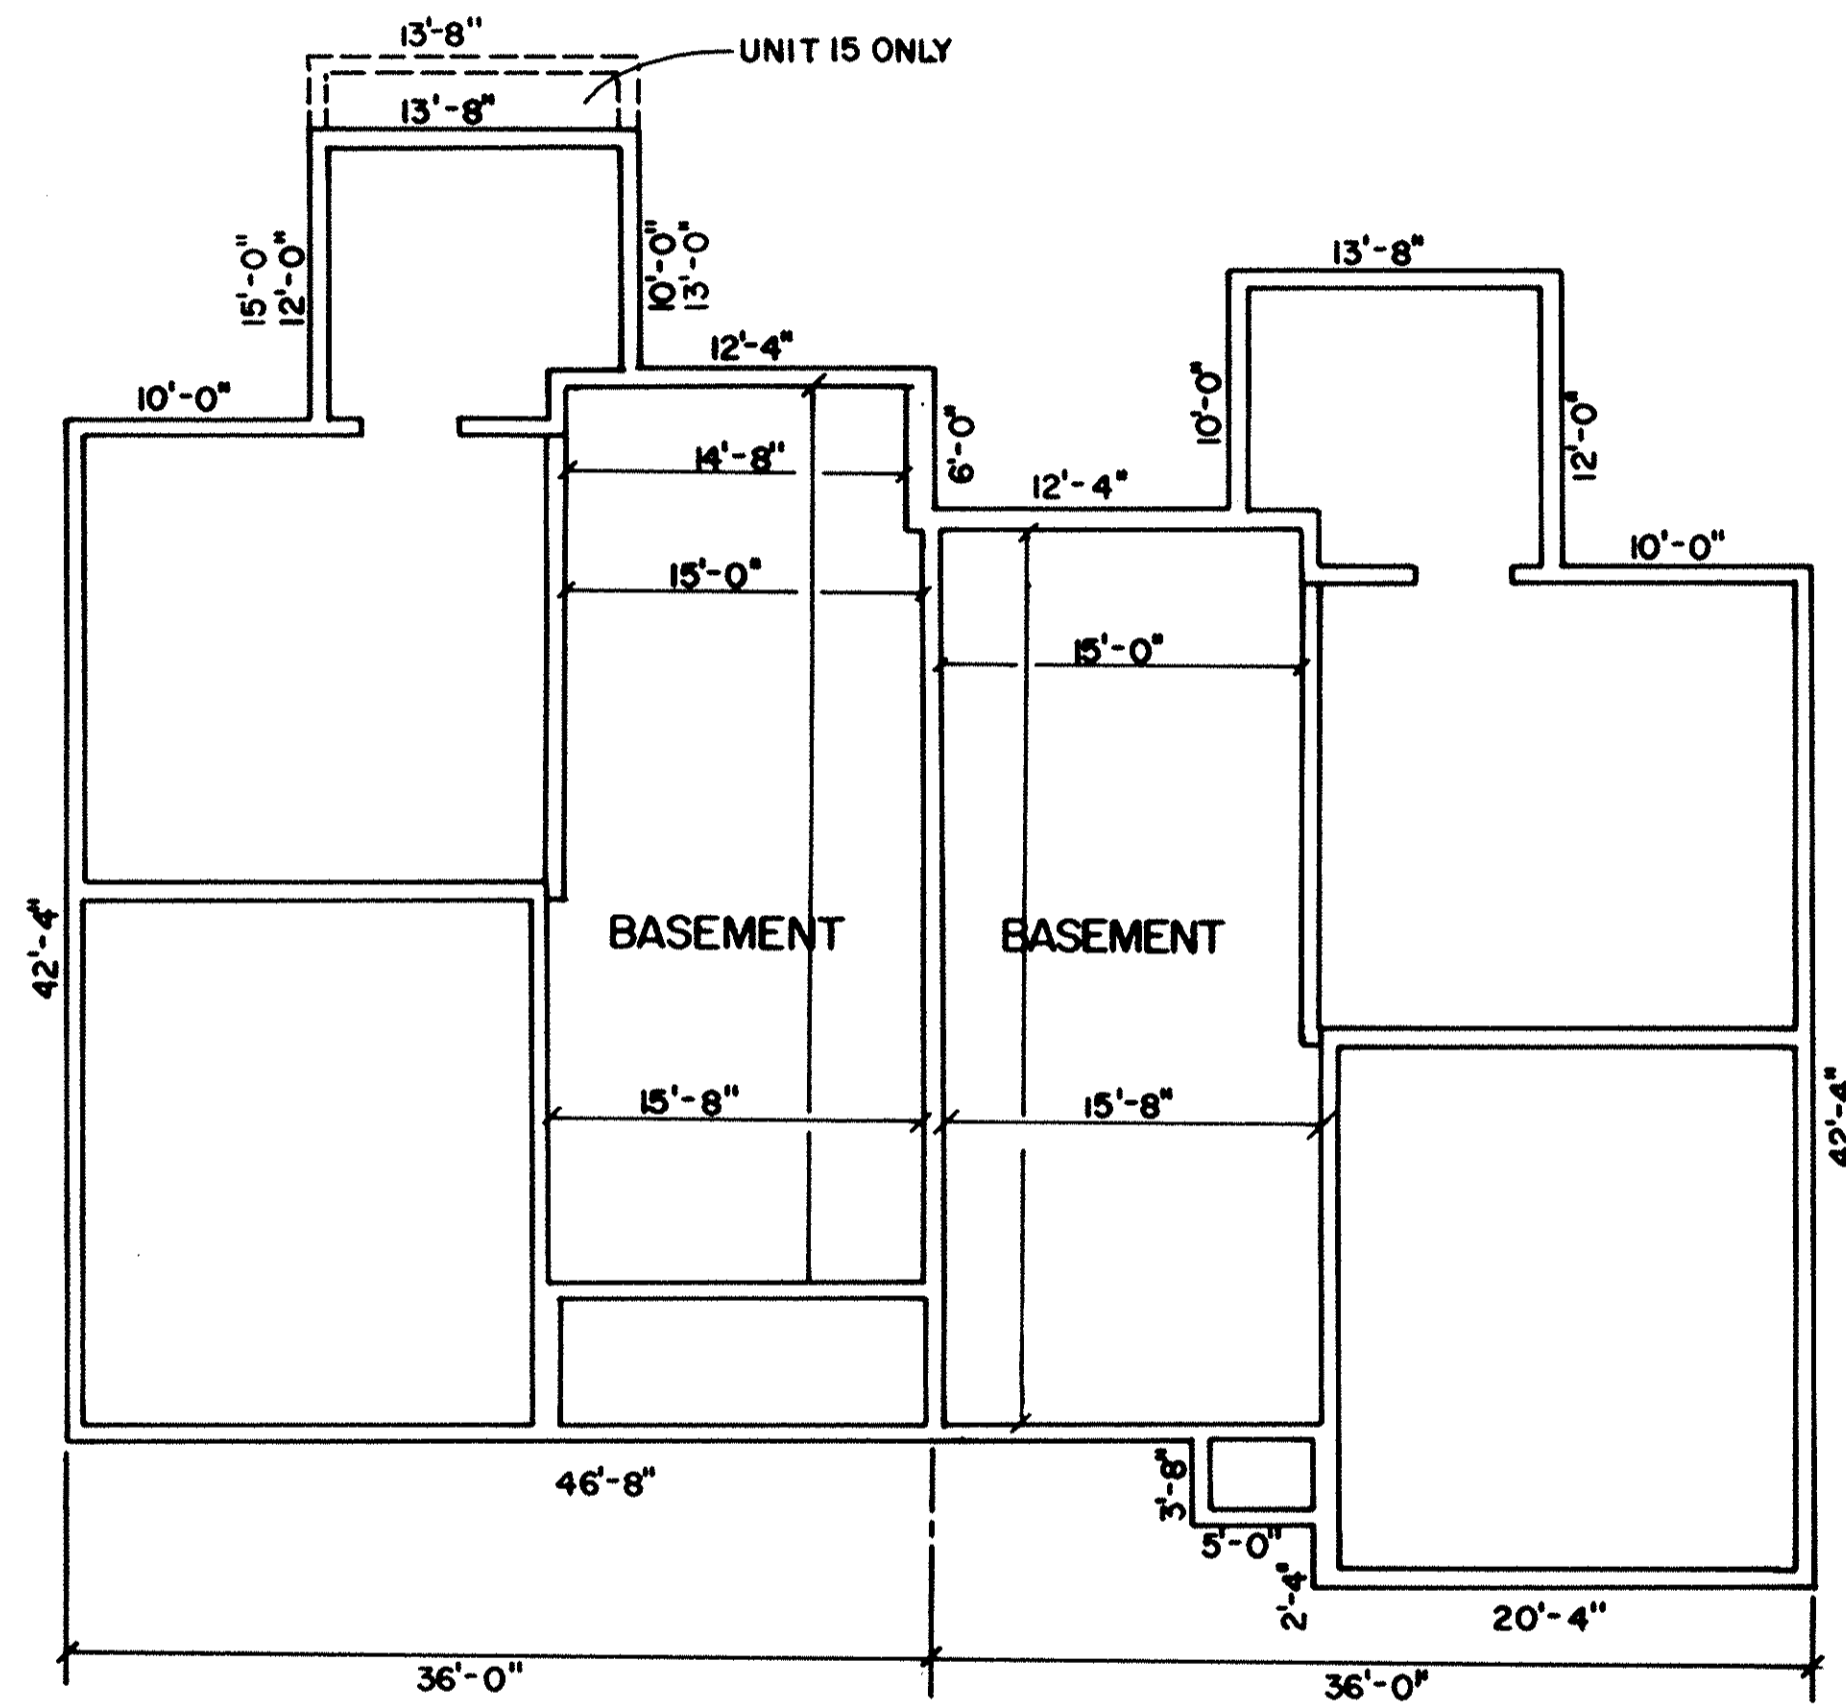


FOUNDATION PLAN
SCALE: 1/8" = 1'-0"

TYPICAL UNITS: 15,16,17,18,19 & 20

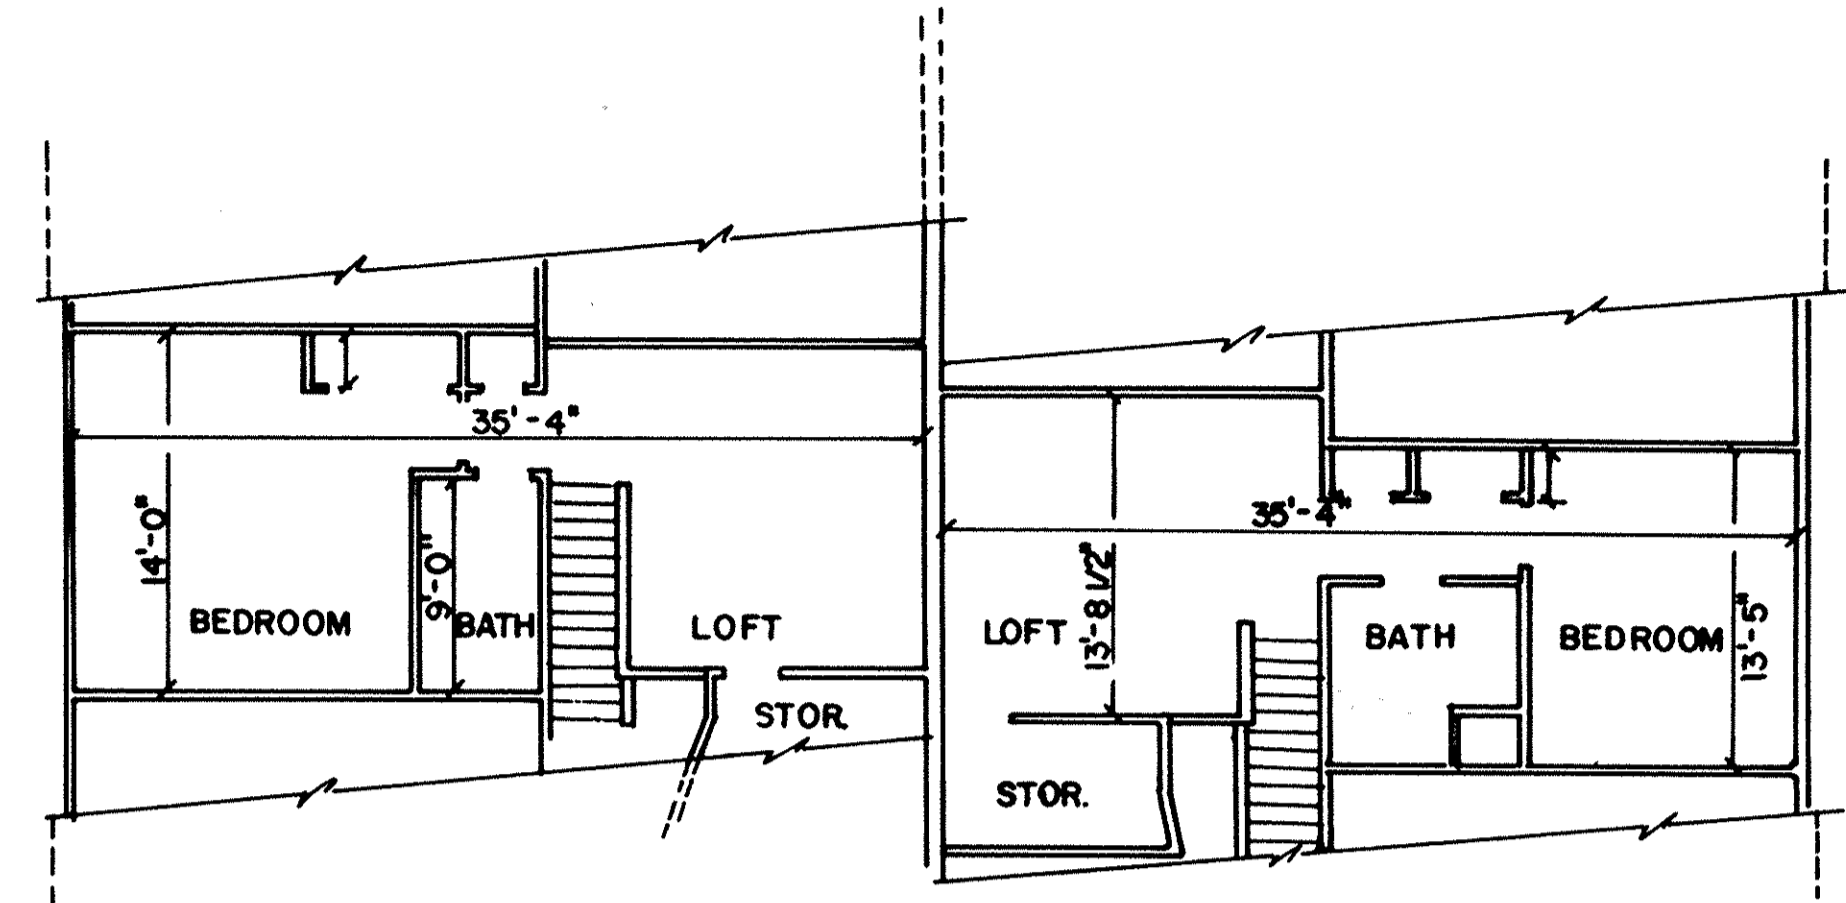

SECOND FLOOR PLAN
SCALE: 1/8" = 1'-0"

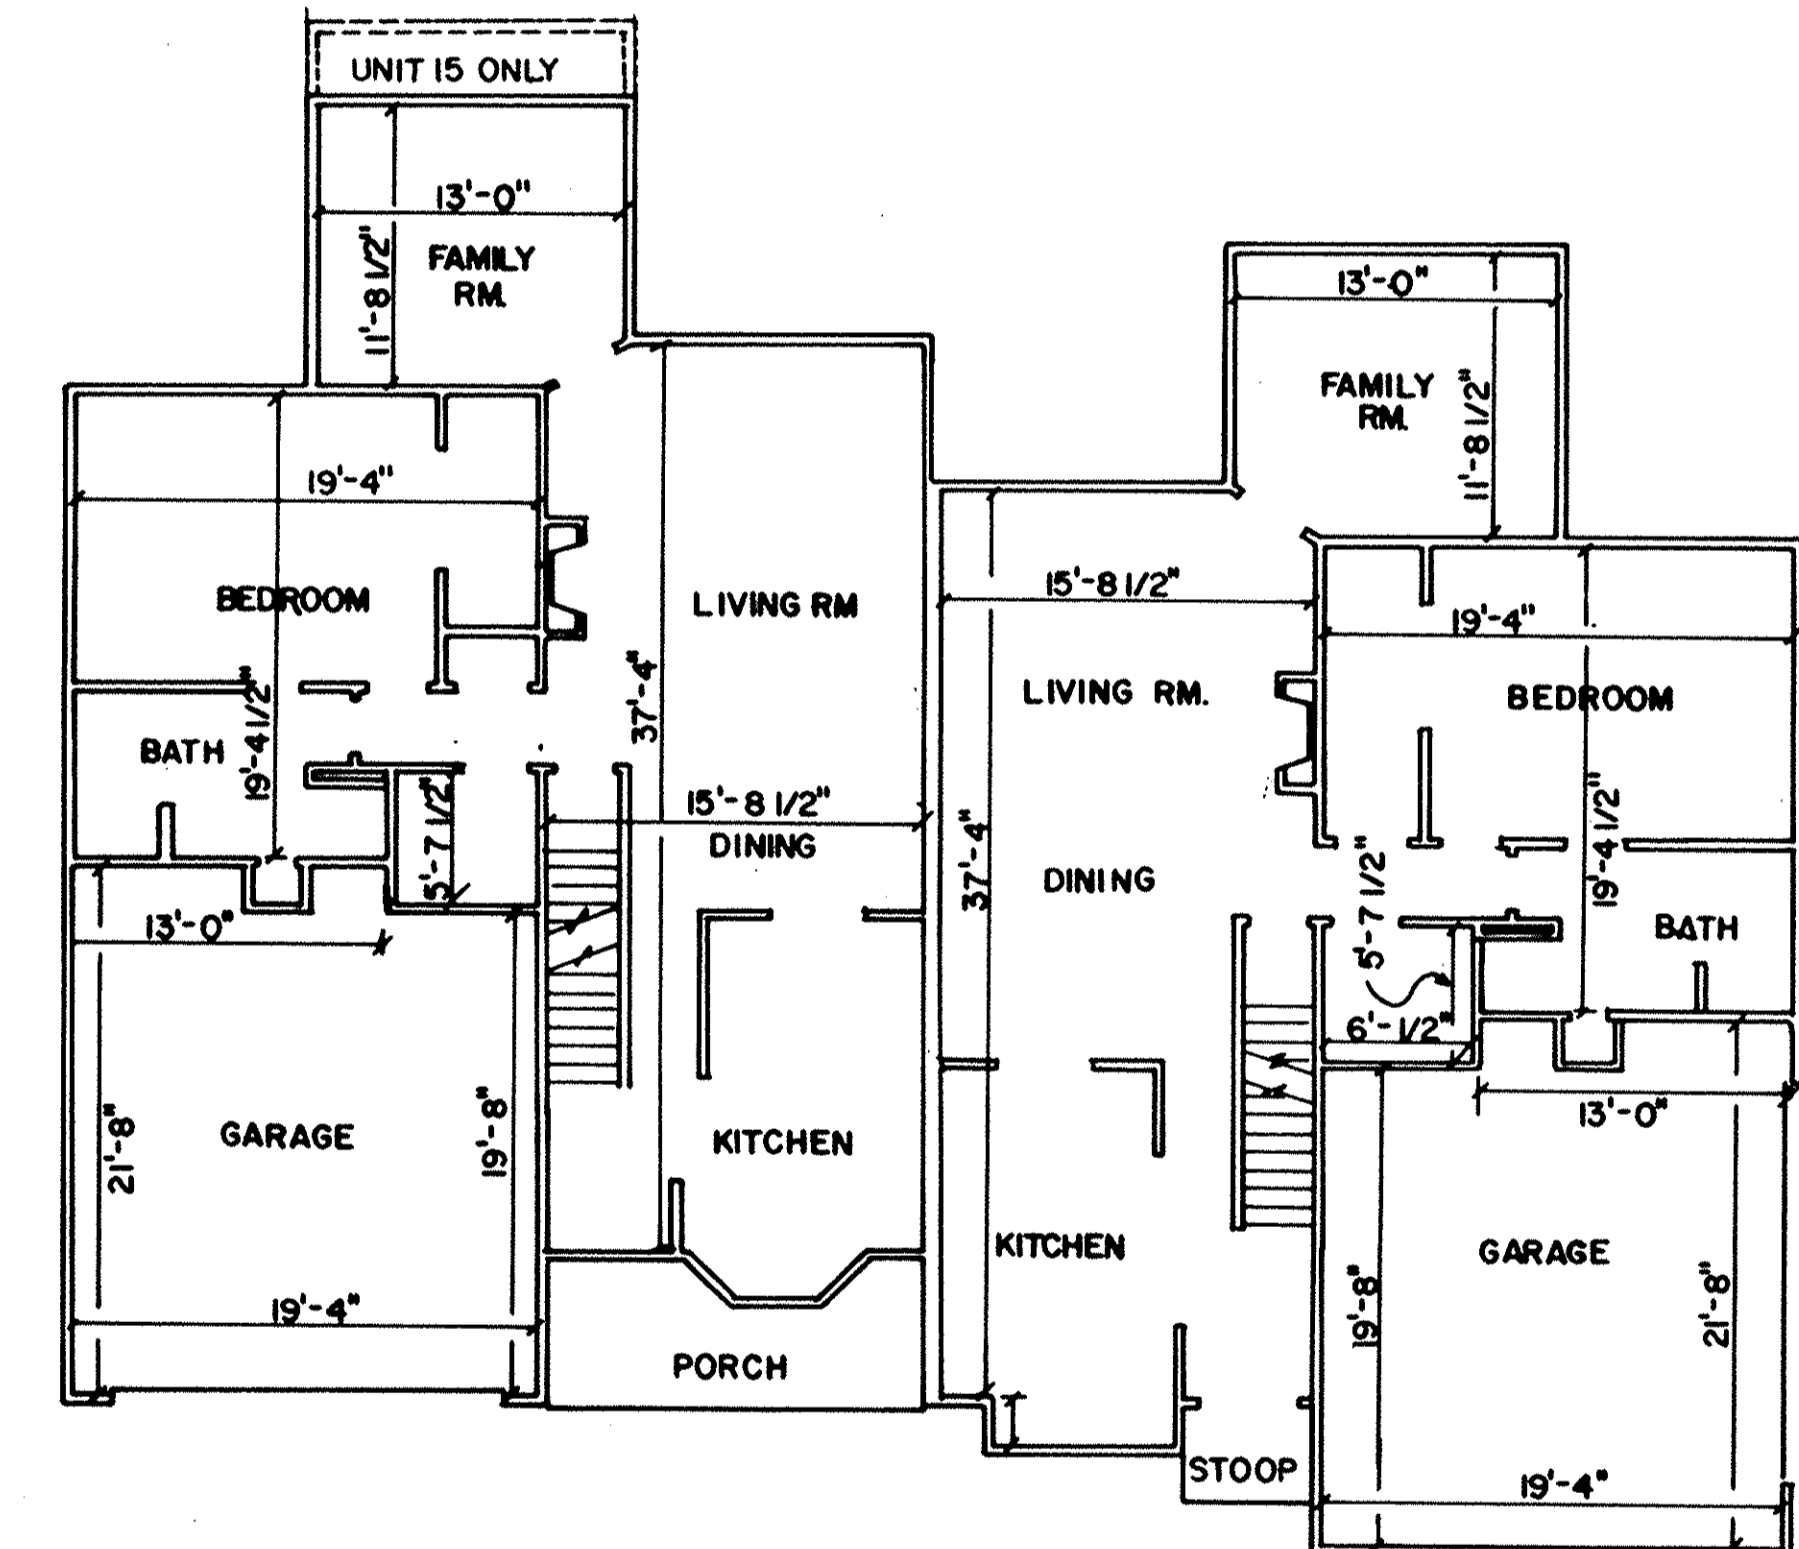

FIRST FLOOR PLAN
SCALE: 1/8" = 1'-0"

VILLAS AT HIGHLAND PARK PHASE 3
FOUNDATION PLAN
FLOOR PLANS

LORAIN COUNTY TAX
MAP DEPARTMENT COPY

