


CURVE TABLE				
CURVE	RADIUS	DELTA	LENGTH	BEARING
C-1	28.00'	49°43'34"	24.31'	S 66°06'42" W
C-2	28.00'	40°13'43"	19.66'	S 2°07'34" W
C-3	28.00'	89°58'17"	43.97'	S 45°59'50" W

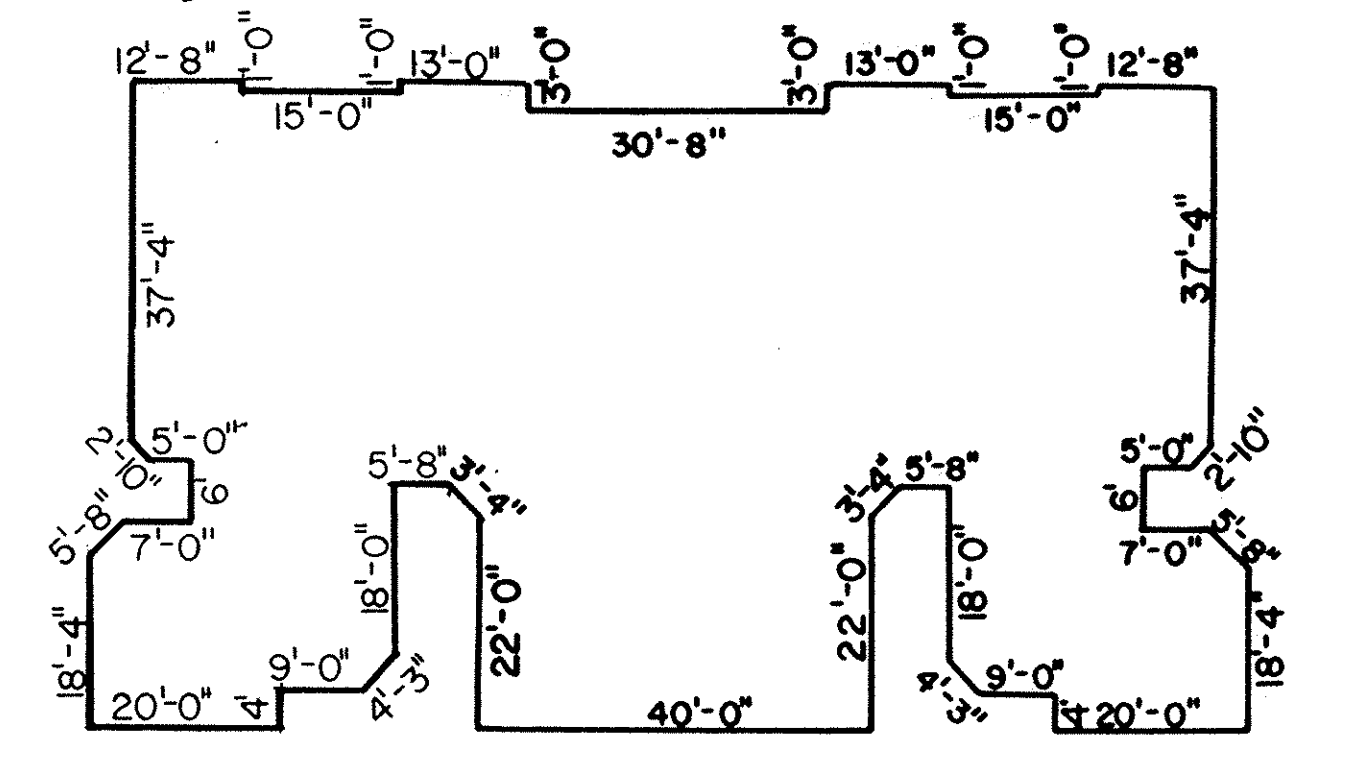

FOUNDATION PLAN
SCALE: 1" = 20'



OWNERSHIP TABLE			
UNIT NO.	SQ. FT.	ELEV. 1ST FL.	% OWNERSHIP
1-101	1388	723.40	2.2685
2-103	1626	723.40	2.6575
3-105	1769	723.40	2.8912
4-107	1388	723.40	2.2685
5-141	1388	719.38	2.2685
6-143	1626	719.38	2.6575
7-145	1769	719.38	2.8912
8-147	1388	719.38	2.2685
9-151	1388	719.53	2.2685
10-153	1626	719.53	2.6575
11-155	1769	719.53	2.8912
12-157	1388	719.53	2.2685
13-109	1388	722.30	2.2685
14-111	1626	722.30	2.6575
15-113	1769	722.30	2.8912
16-115	1388	722.30	2.2685
17-129	1388	720.10	2.2685
18-131	1626	720.10	2.6575
19-133	2177	720.10	3.5581
20-135	1769	720.10	2.8912
21-137	1626	720.10	2.6575
22-139	1388	720.10	2.2685
23-128	1388	719.53	2.2685
24-130	1626	719.45	2.6575
25-132	1769	719.45	2.8912
26-134	2177	719.45	3.5581
27-136	1626	719.50	2.6575
28-138	1388	719.47	2.2685
29-117	1388	721.20	2.2685
30-119	1626	721.21	2.6575
31-121	1769	721.21	2.8912
32-123	2177	721.24	3.5581
33-125	1626	721.25	2.6575
34-127	1388	721.22	2.2685
35-260	1388	724.73	2.2685
36-262	2177	724.68	3.5581
37-264	1626	724.66	2.6575
38-266	1388	724.66	2.2685
TOTAL	61,185		100

NOTE: AREA OF BASEMENTS ARE NOT USED IN DETERMINING CONDOMINIUM OWNERSHIP.


Recorded for Record JUL 21 1994
at 10:54 AM in PLAT RECORD
VOL 53 MARY ANN JAMISON
PAGES 40-43 inc
Lorain County Recorder

CERTIFICATION
THIS IS TO CERTIFY THAT THE ATTACHED DRAWINGS CORRECTLY REPRESENT THE BUILDINGS AS CONSTRUCTED AND THAT THERE ARE NO ENCROACHMENTS ON ADJACENT PROPERTIES.

David L. Elwell
DAVID L. ELWELL
REG. SURVEYOR NO. 6333

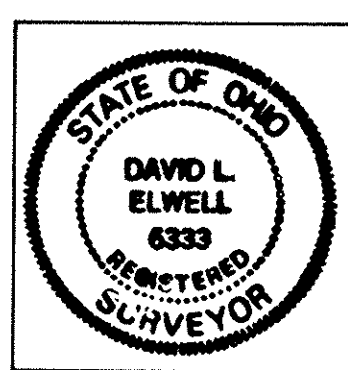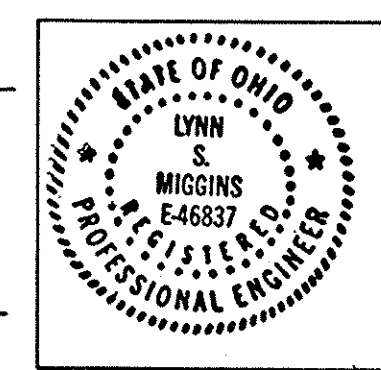


TRANSFERRED
IN COMPLIANCE WITH SEC. 319-222
CHILD REV. CODE
JUL 21 1994
JULIAN A. PIJOR
LORAIN COUNTY AUDITOR

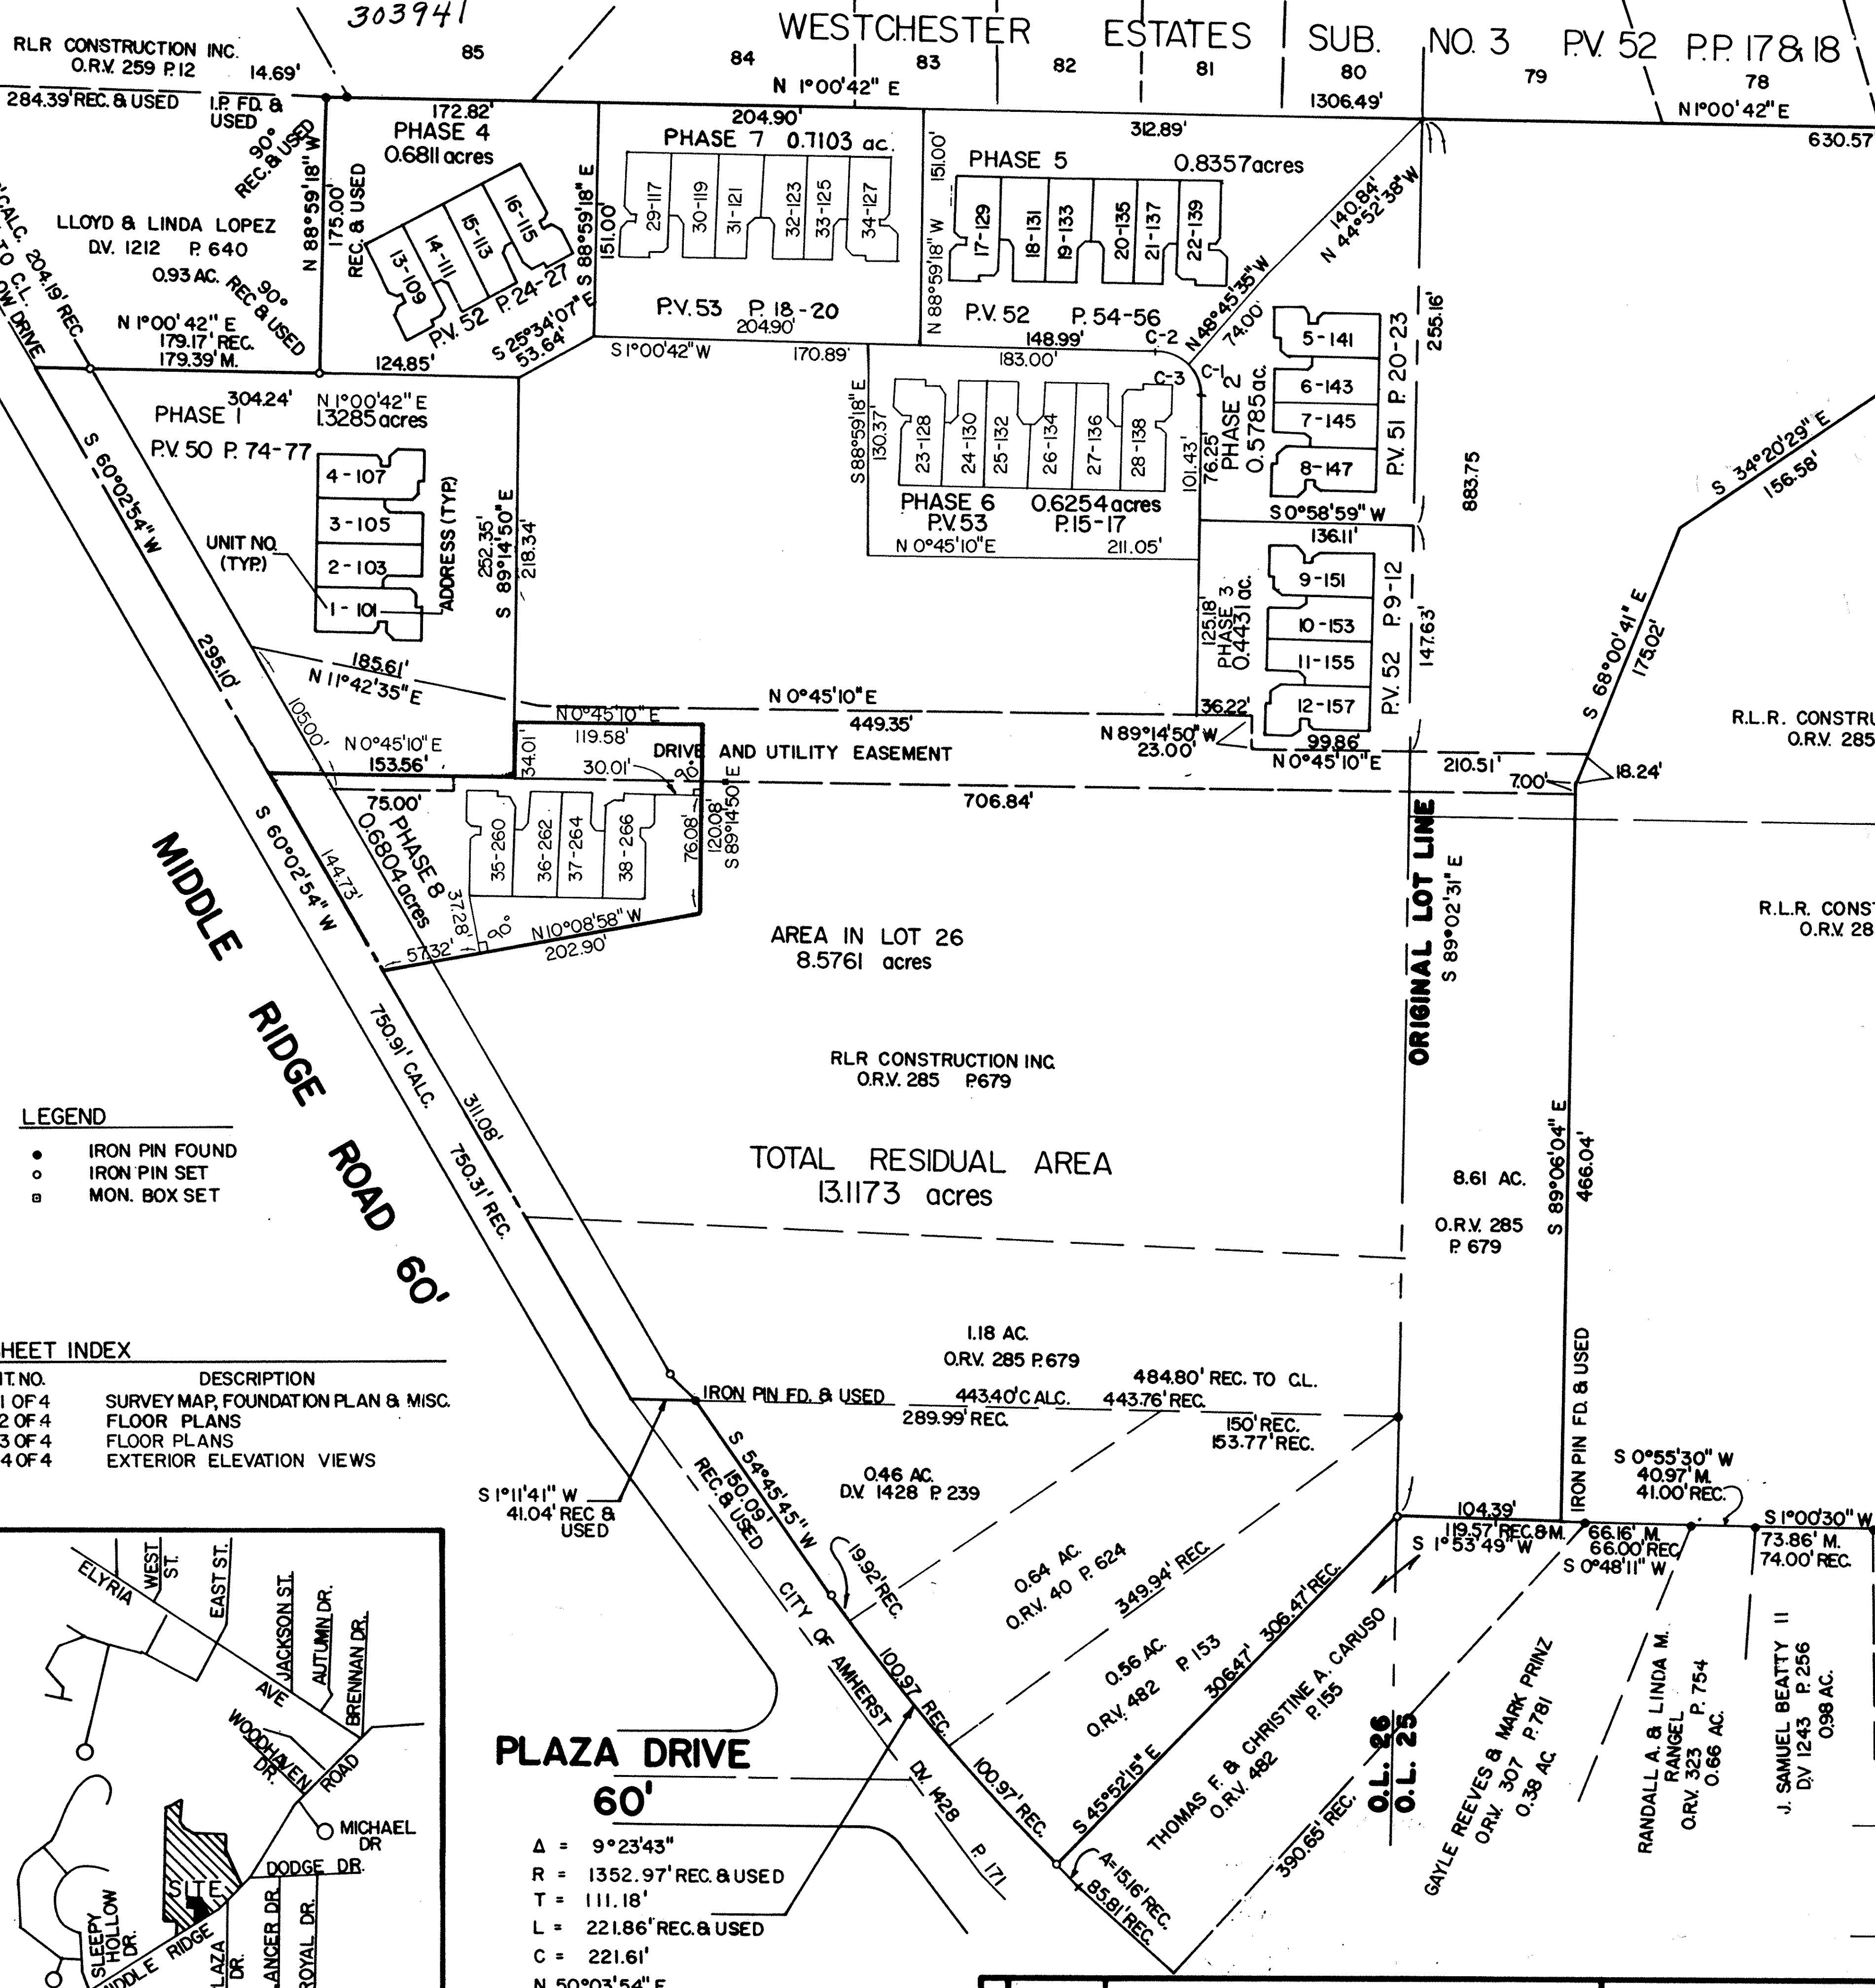

- LEGEND**
- IRON PIN FOUND
 - IRON PIN SET
 - MON. BOX SET

SHEET INDEX

SHT. NO.	DESCRIPTION
1 OF 4	SURVEY MAP, FOUNDATION PLAN & MISC.
2 OF 4	FLOOR PLANS
3 OF 4	FLOOR PLANS
4 OF 4	EXTERIOR ELEVATION VIEWS

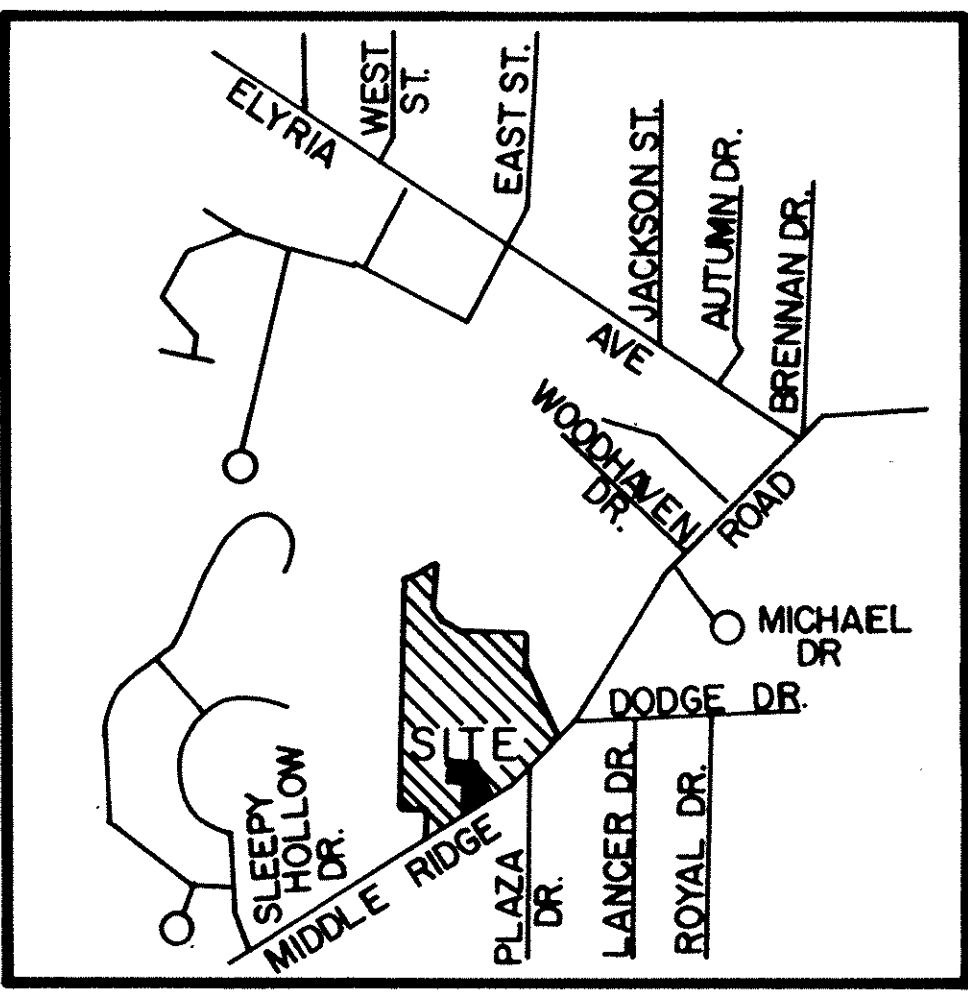

△ = 9°23'43"
R = 1352.97' REC. & USED
T = 111.18'
L = 221.86' REC. & USED
C = 221.61'
N 50°03'54" E

REVISIONS	DATE	DESCRIPTION


THE ENGLISH LAKES CONDOMINIUMS
PHASE 8
PART OF AMHERST TWP. O.L. 25 & 26
CITY OF AMHERST • COUNTY OF LORAIN • STATE OF OHIO

KS ASSOCIATES, INC.
ENGINEERS/SURVEYORS
424 Middle Avenue
P.O. Box 89
Elyria, Ohio 44036
Elyria (216) 322-6317 • Lorain (216) 244-5757

ASSOCIATES INCORPORATED


SHEET 1 OF 4
JOB NO. 89224-CP8

LORAIN COUNTY TAX MAP DEPARTMENT COPY

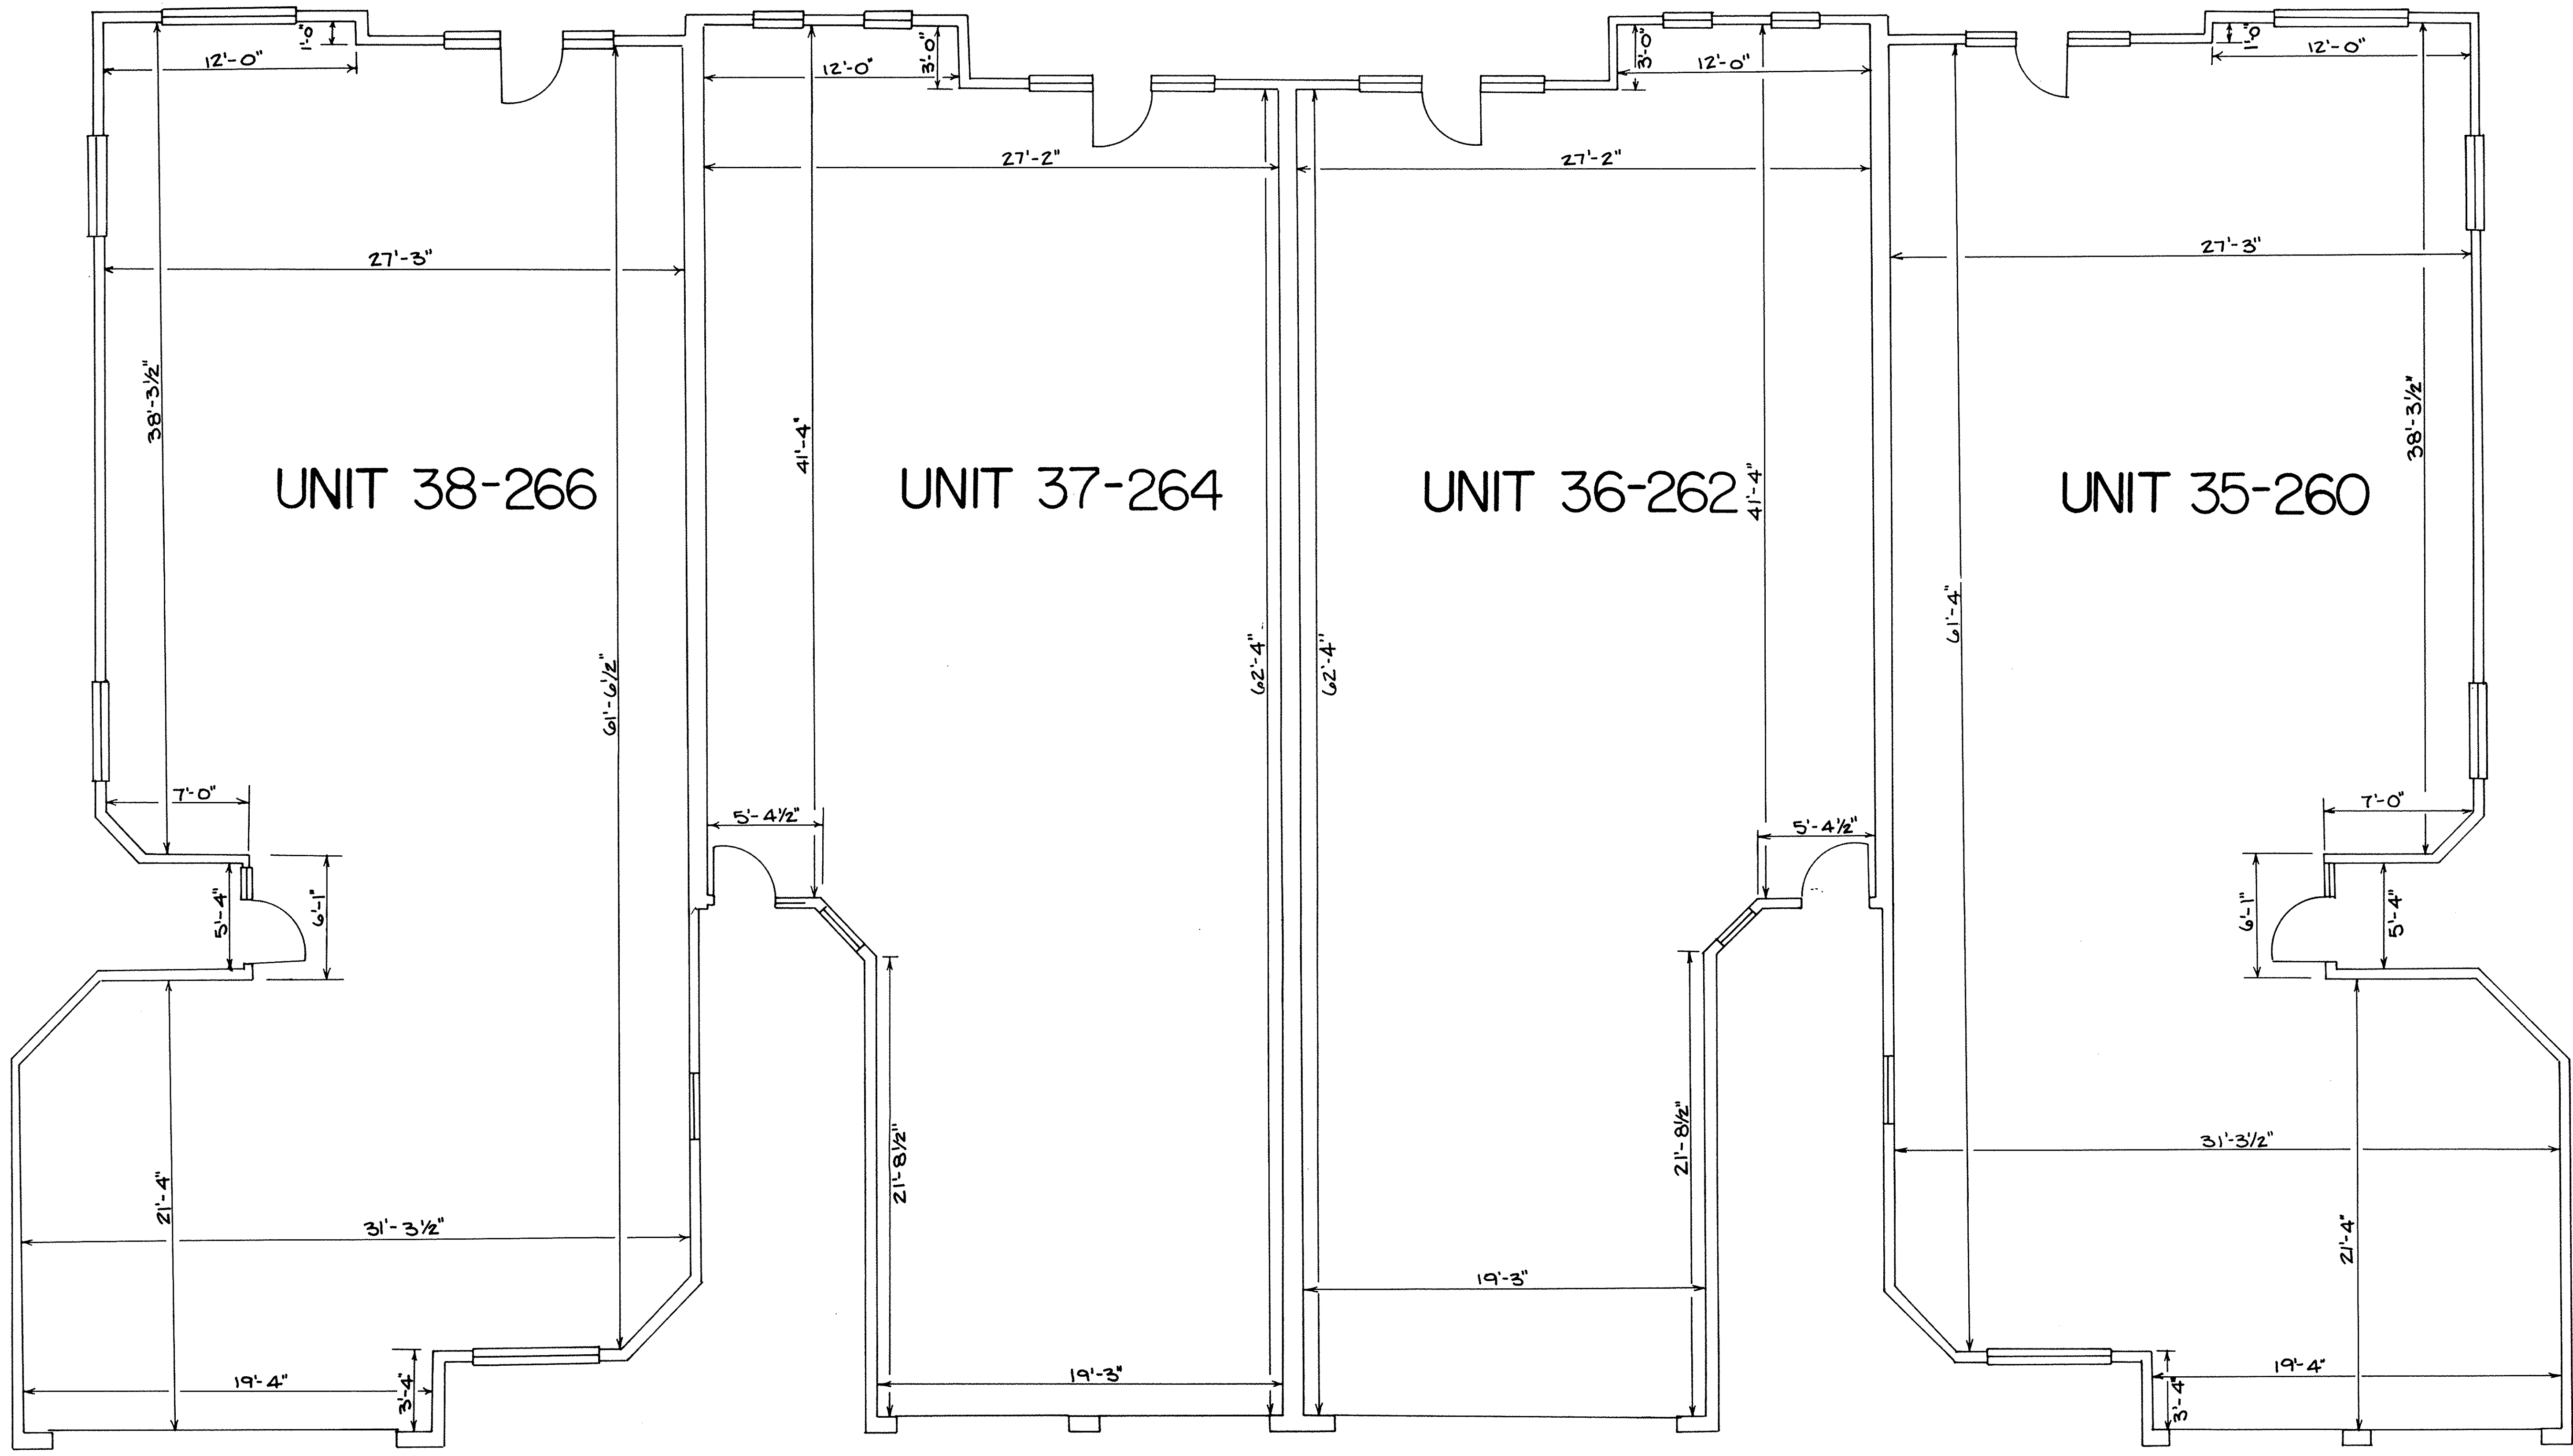


FIRST FLOOR PLAN
 SCALE: 1/4"=1'-0"

ENGLISH LAKES CONDOMINIUMS PHASE 8
 FIRST FLOOR PLAN

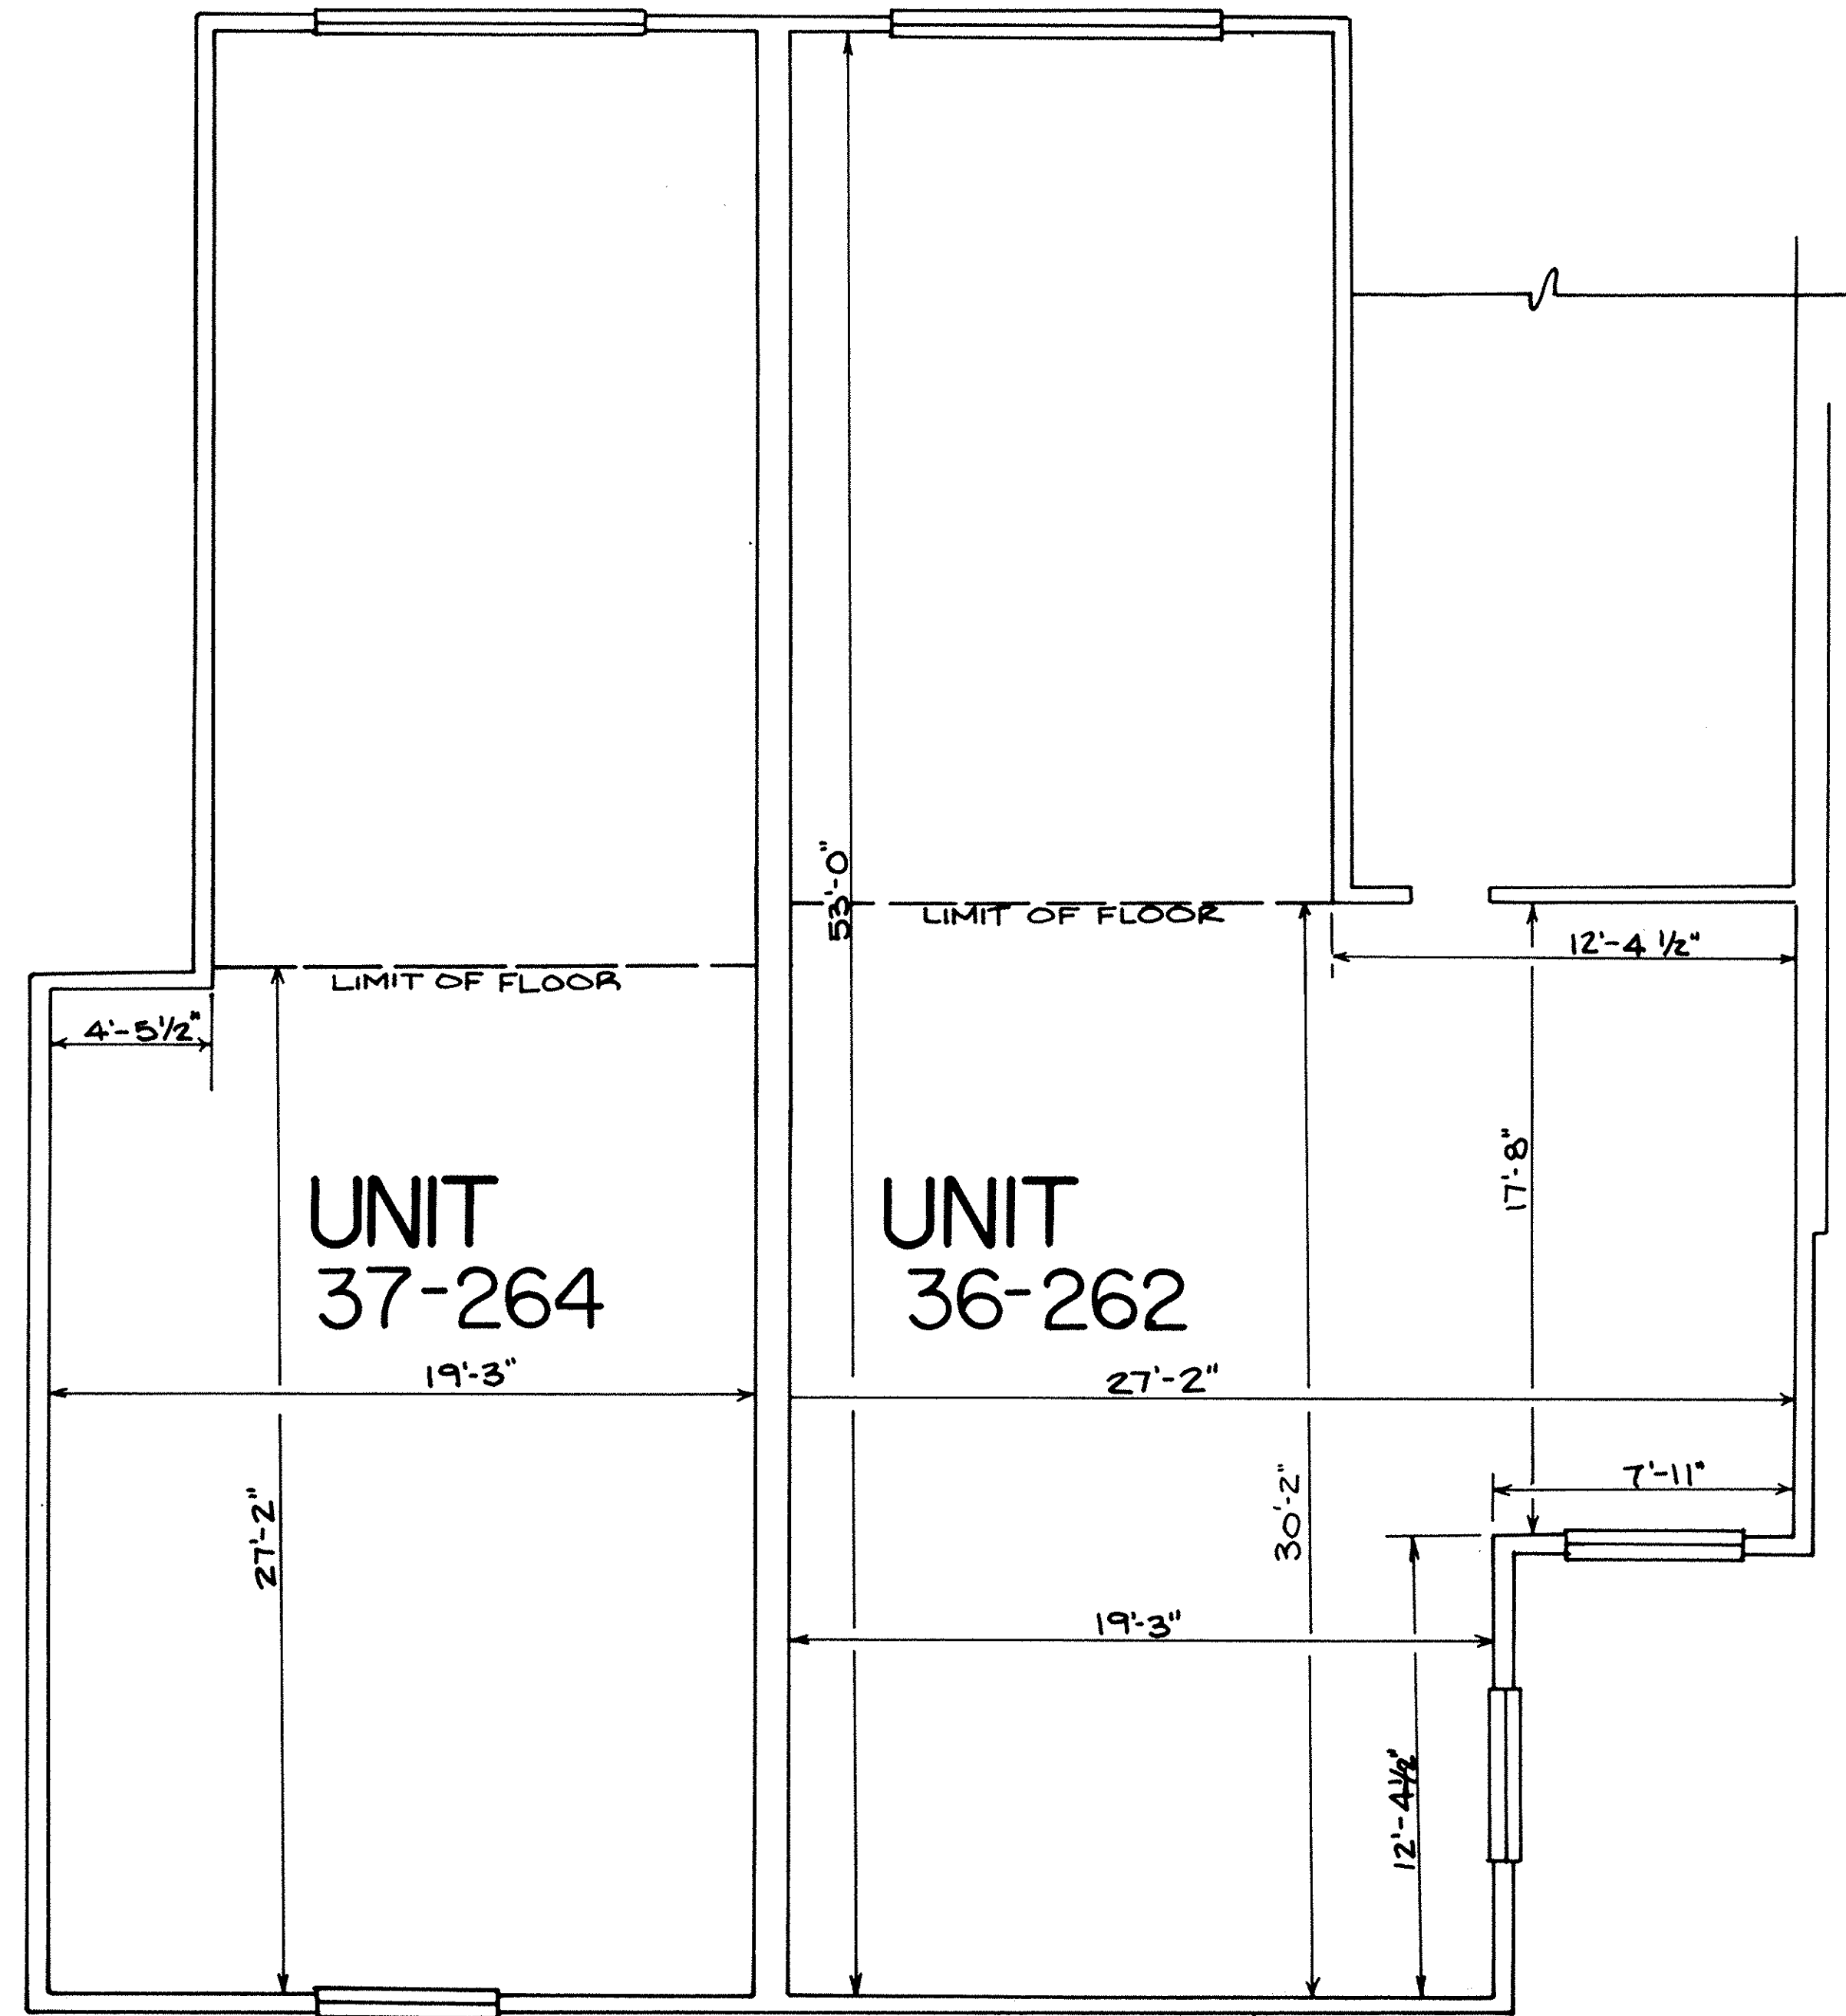

SECOND FLOOR PLAN
SCALE: 1/4" = 1'-0"

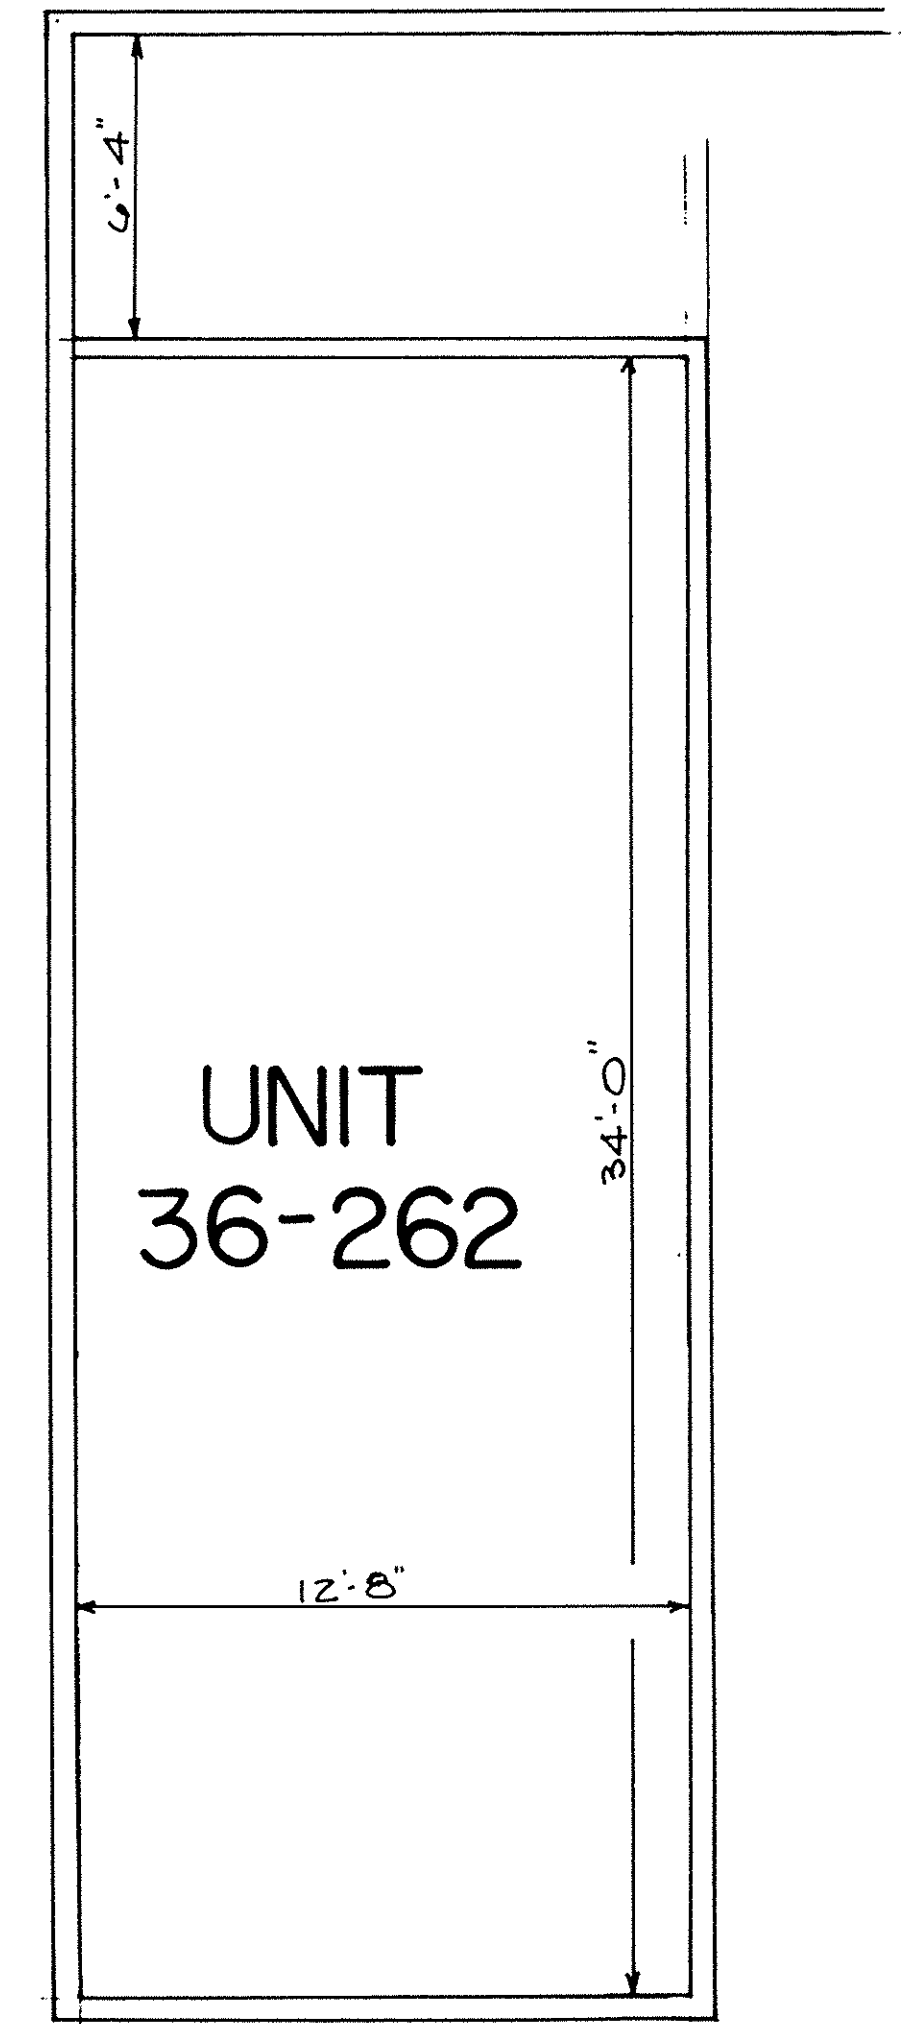


THIRD FLOOR PLAN
SCALE: 1/4" = 1'-0"


ENGLISH LAKES CONDOMINIUMS PHASE 8
SECOND FLOOR PLAN



FRONT ELEVATION

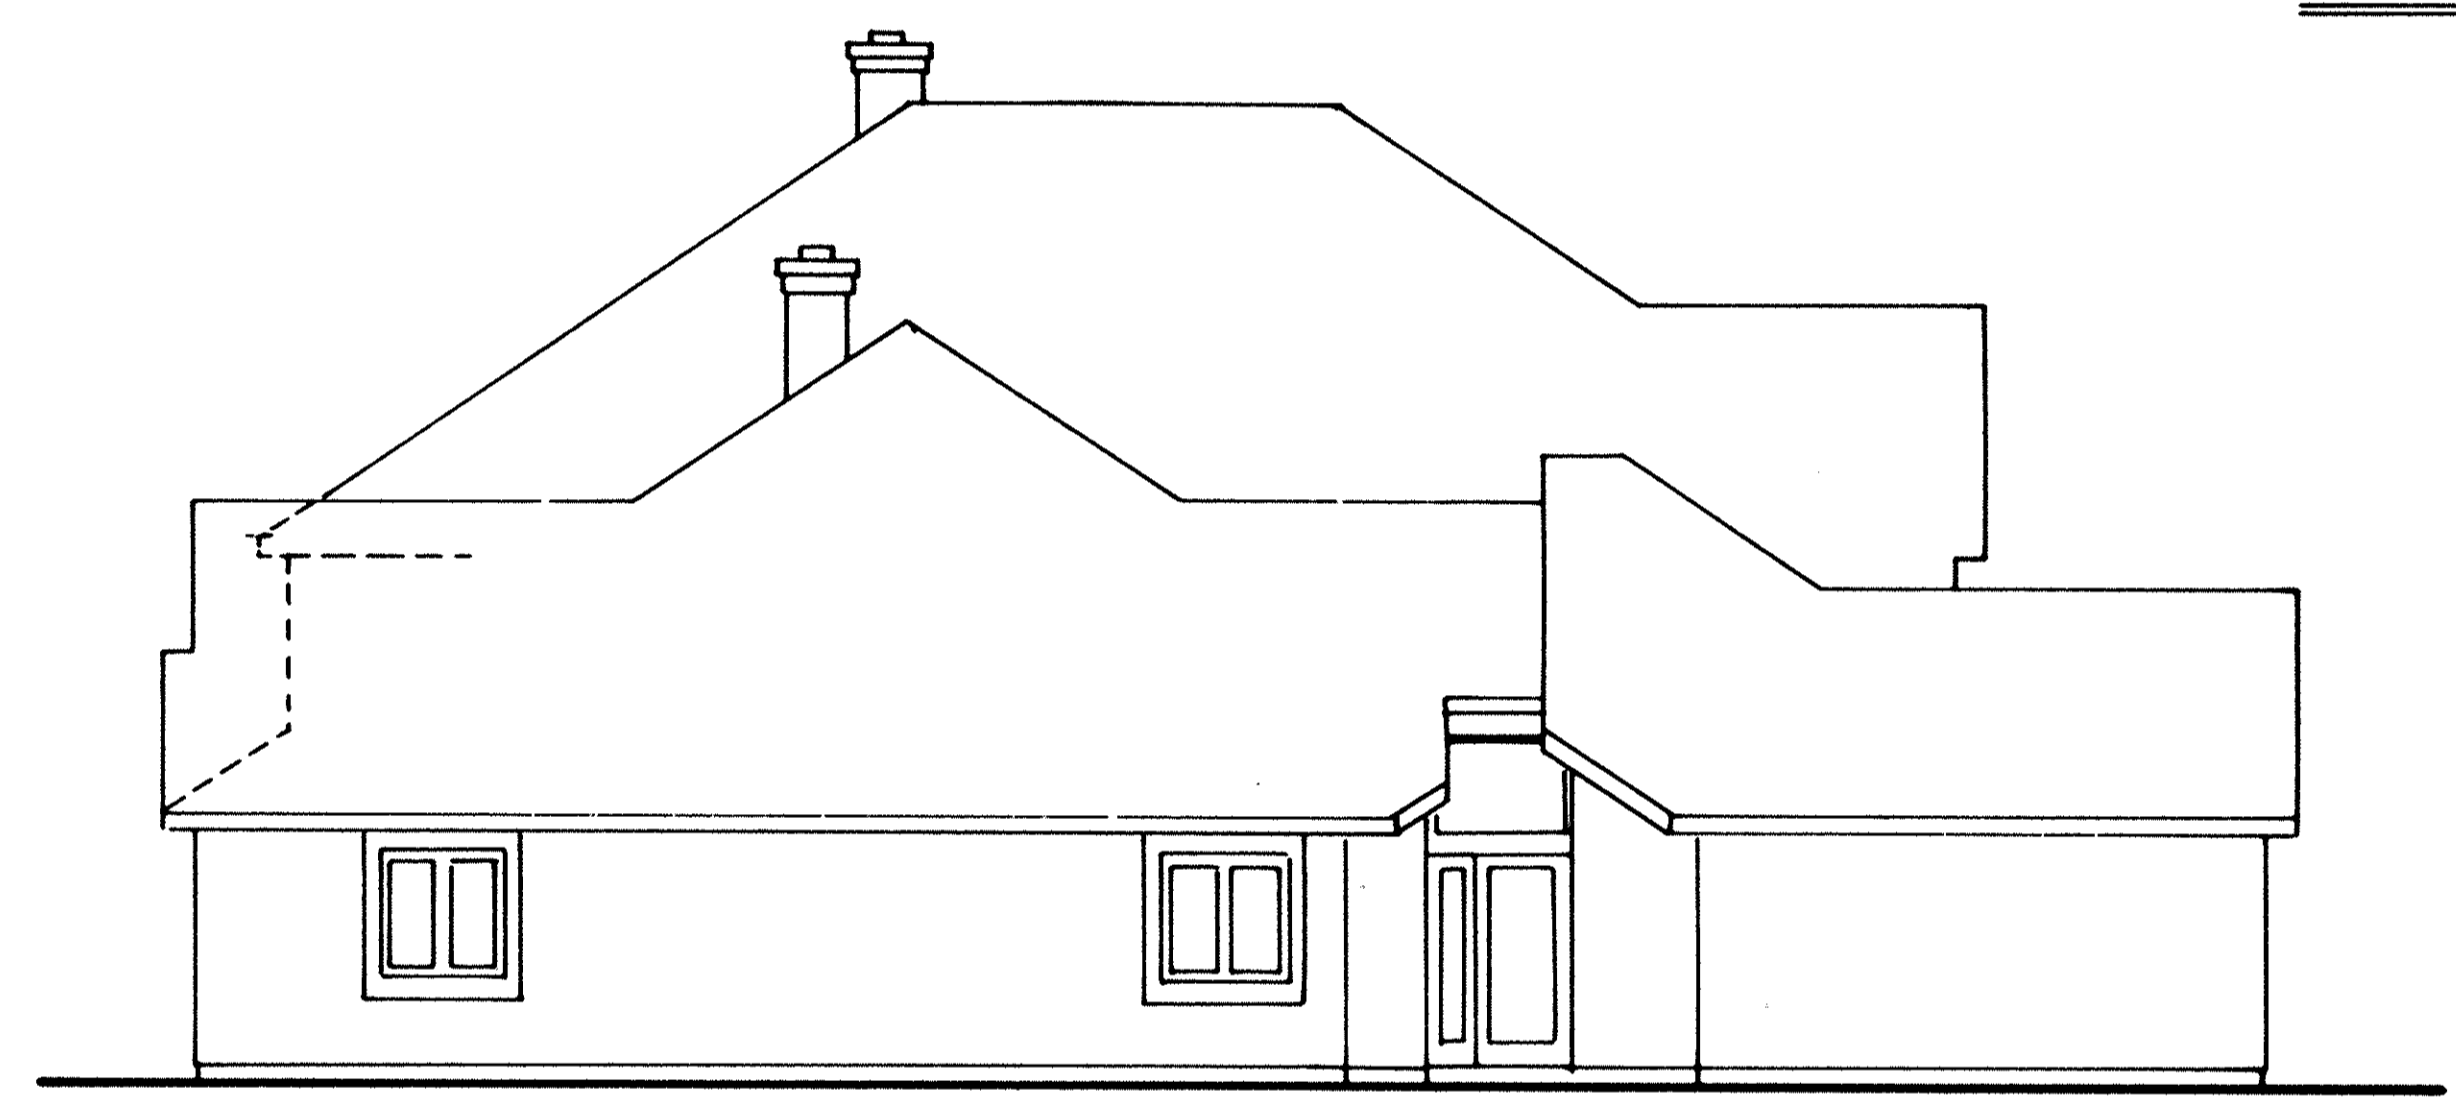

LEFT SIDE ELEVATION

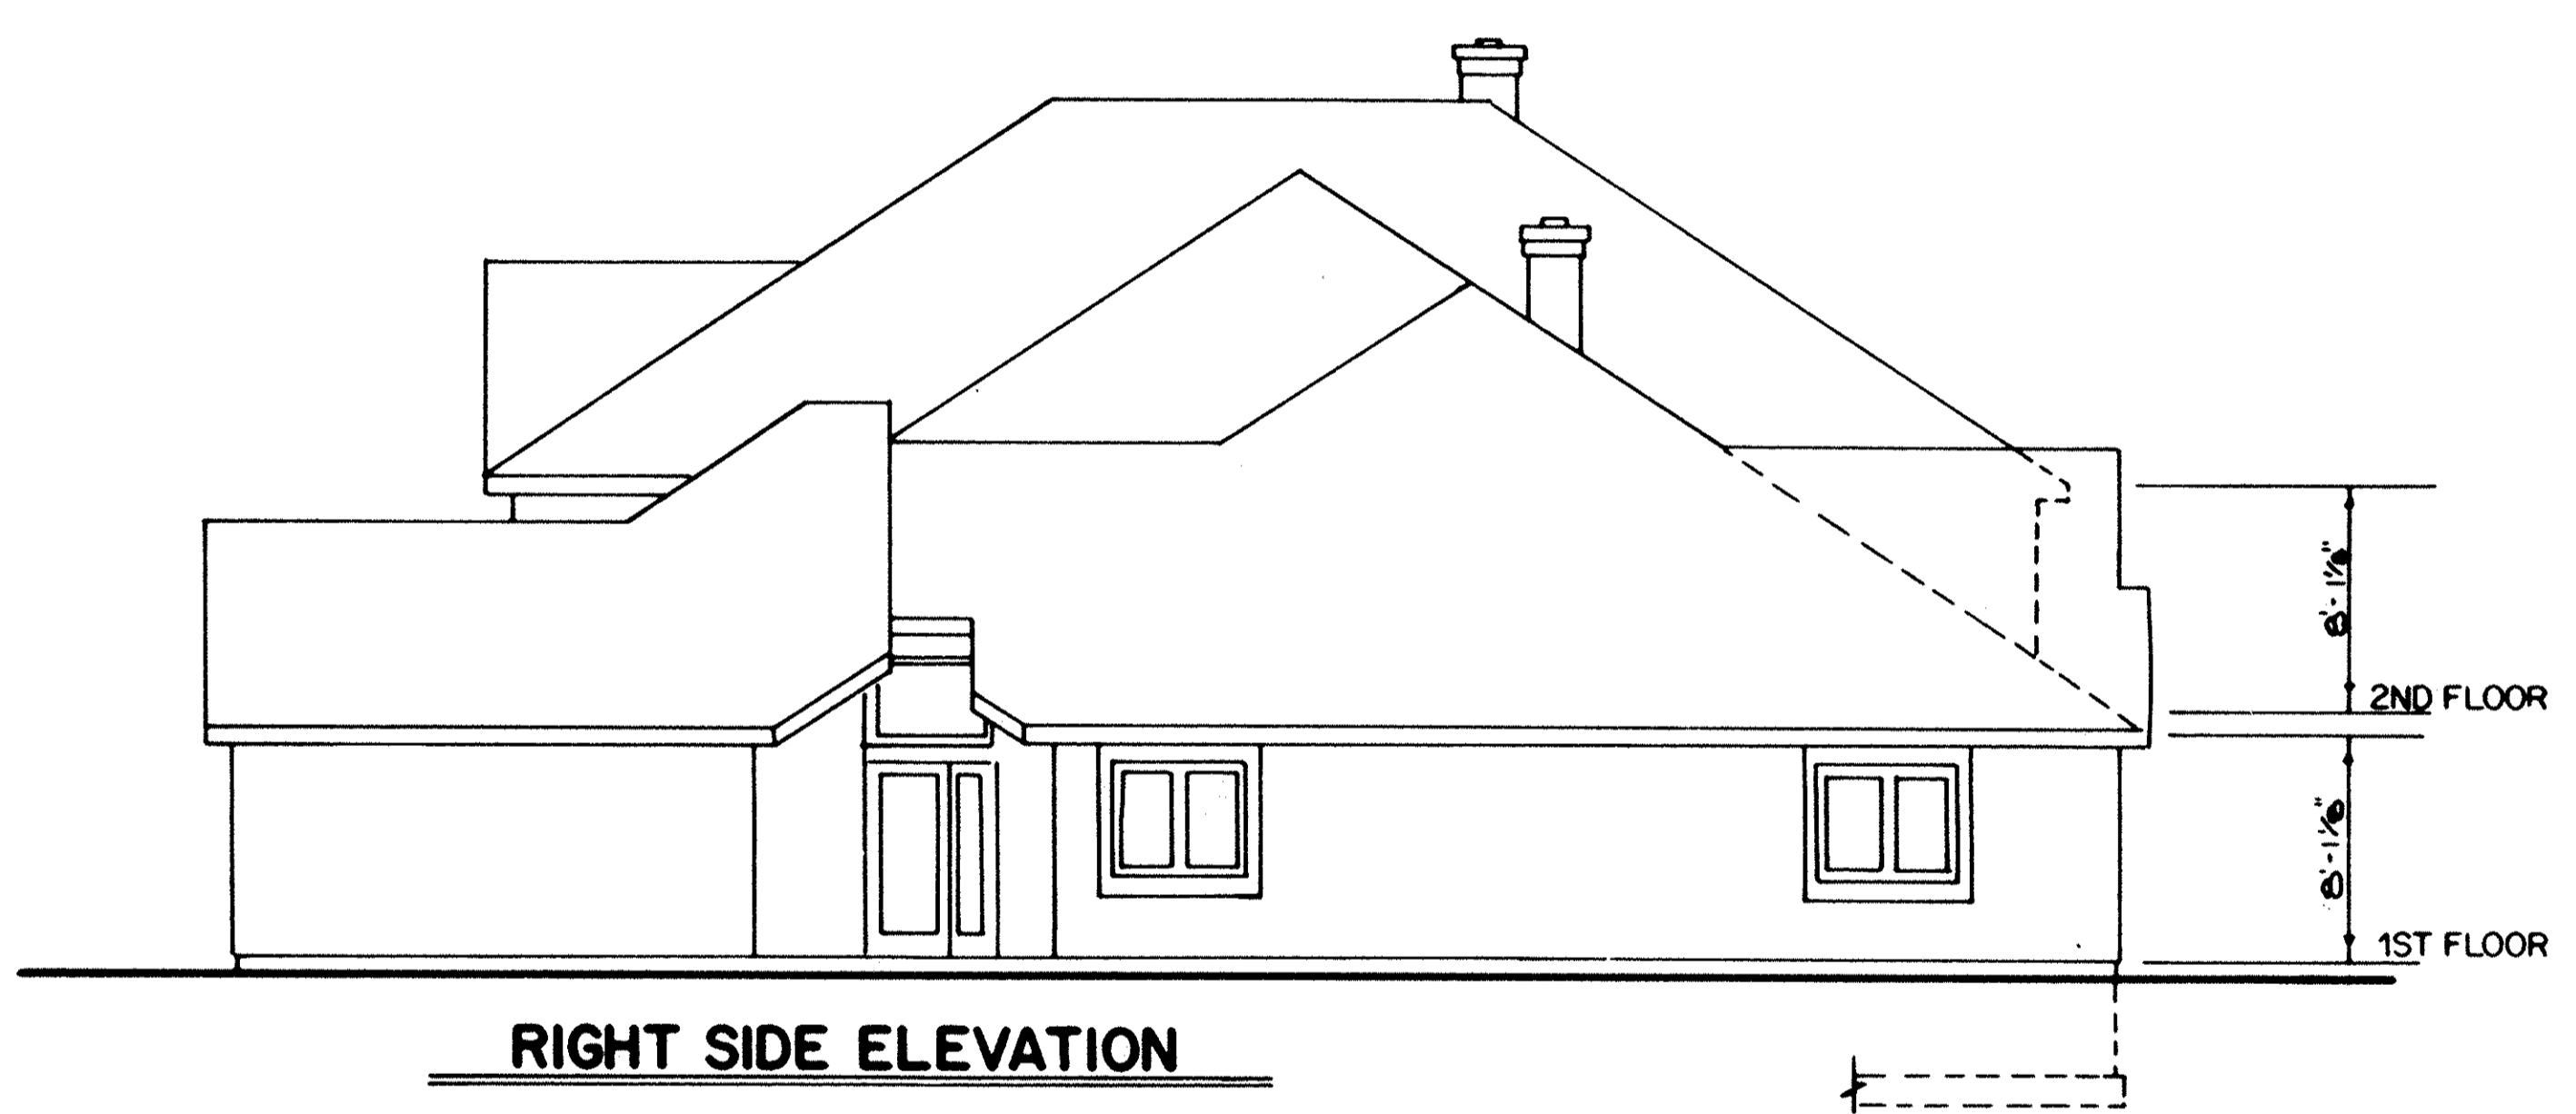

RIGHT SIDE ELEVATION



REAR ELEVATION

ENGLISH LAKES CONDOMINIUMS PHASE 8
EXTERIOR ELEVATIONS