

AREA MAP - NO SCALE

CERTIFICATION

THIS IS TO CERTIFY THAT THE ATTACHED DRAWINGS CORRECTLY REPRESENT THE BUILDINGS AS CONSTRUCTED AND THAT THERE ARE NO ENCROACHMENTS ON ADJACENT PROPERTIES.

David L. Elwell
DAVID L. ELWELL
REG. SURVEYOR NO. 6333





LORAIN COUNTY RECORDER

Lynn S. Miggins
LYNN S. MIGGINS
REG. ENGINEER NO. 46837




LORAIN COUNTY AUDITOR

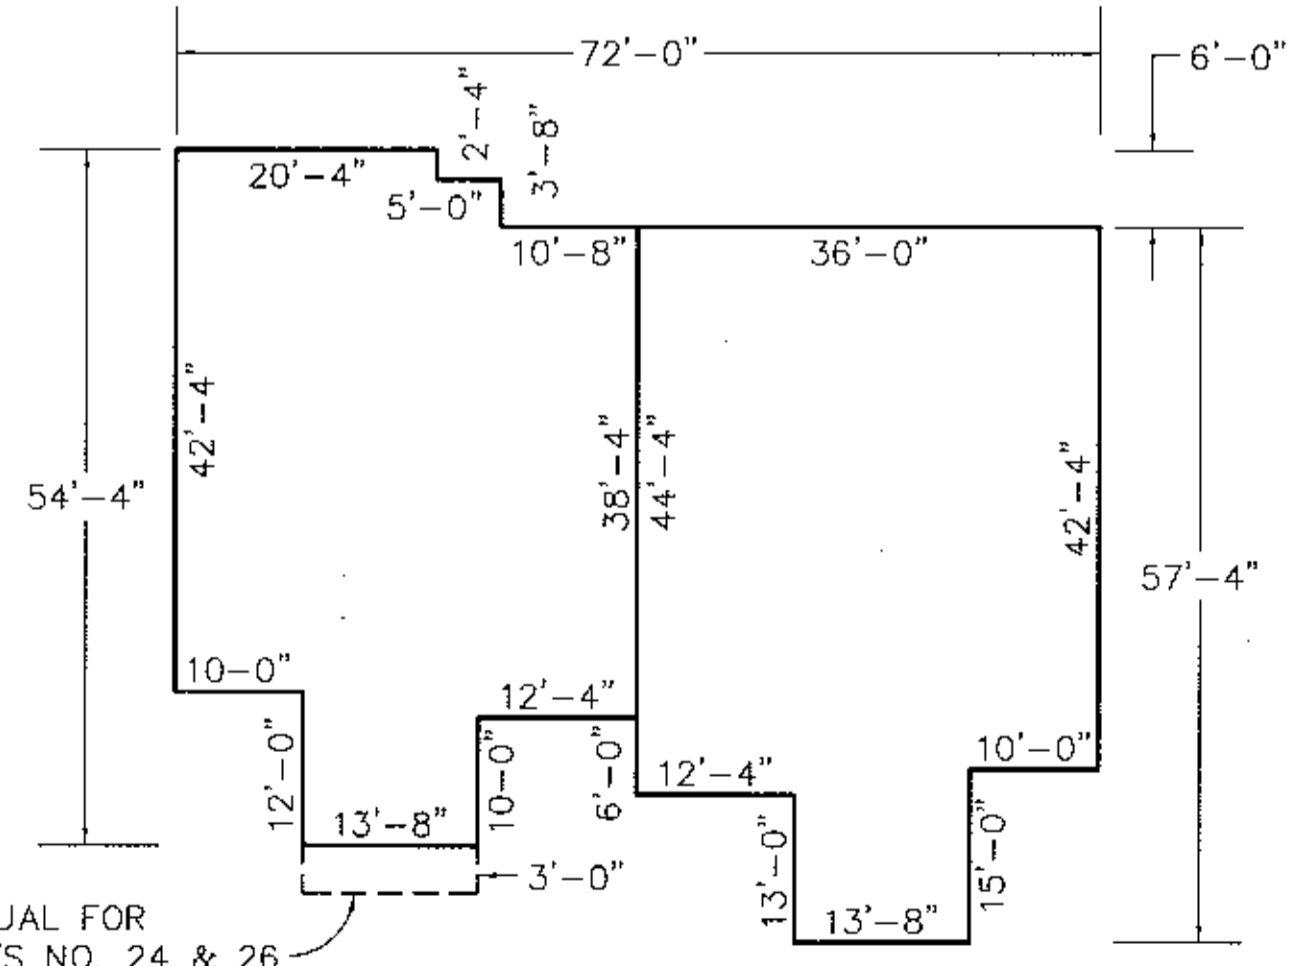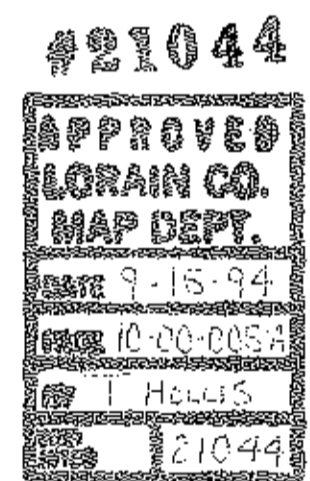

TYPICAL BUILDING DIMENSIONS

UNIT	SF AREA	% OWNER
1	1717	3.8246
2	1738	3.8713
3	1738	3.8713
4	1717	3.8246
5	1717	3.8246
6	1717	3.8246
7	1738	3.8713
8	1717	3.8246
9	1738	3.8713
10	1717	3.8246
11	1717	3.8246
12	1738	3.8713
13	1717	3.8246
14	1738	3.8713
15	1738	3.8713
16	1717	3.8246
17	1717	3.8246
18	1717	3.8246
19	1717	3.8246
20	1717	3.8246
21	1738	3.8713
22	1717	3.8246
23	1738	3.8713
24	1738	3.8713
25	1738	3.8713
26	1738	3.8713

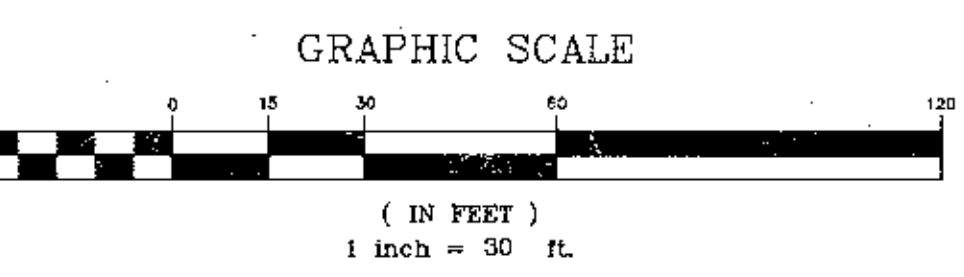


DATE: 8-25-94	REVISIONS
DRAWN BY: JEC/KVS/MJC/ABR	
CHKD BY: DLH	
P.R. 183	
DWG. NAME: 52014 SURV MAP	

VILLAS AT HIGHLAND PARK
CONDOMINIUMS PHASE 4
PART OF CARLISLE TOWNSHIP SECTION 5
CITY OF ELYRIA * COUNTY OF LORAIN * STATE OF OHIO


KS ASSOCIATES, INC.
ENGINEERS/SURVEYORS
424 Middle Avenue
P.O. Box 89
Elyria, Ohio 44036
ELYRIA (216) 322-6317 * LORAIN (216) 244-5757

ENGINEERS/SURVEYORS
SHEET 1 OF 3
JOB NO. 92-614CP4

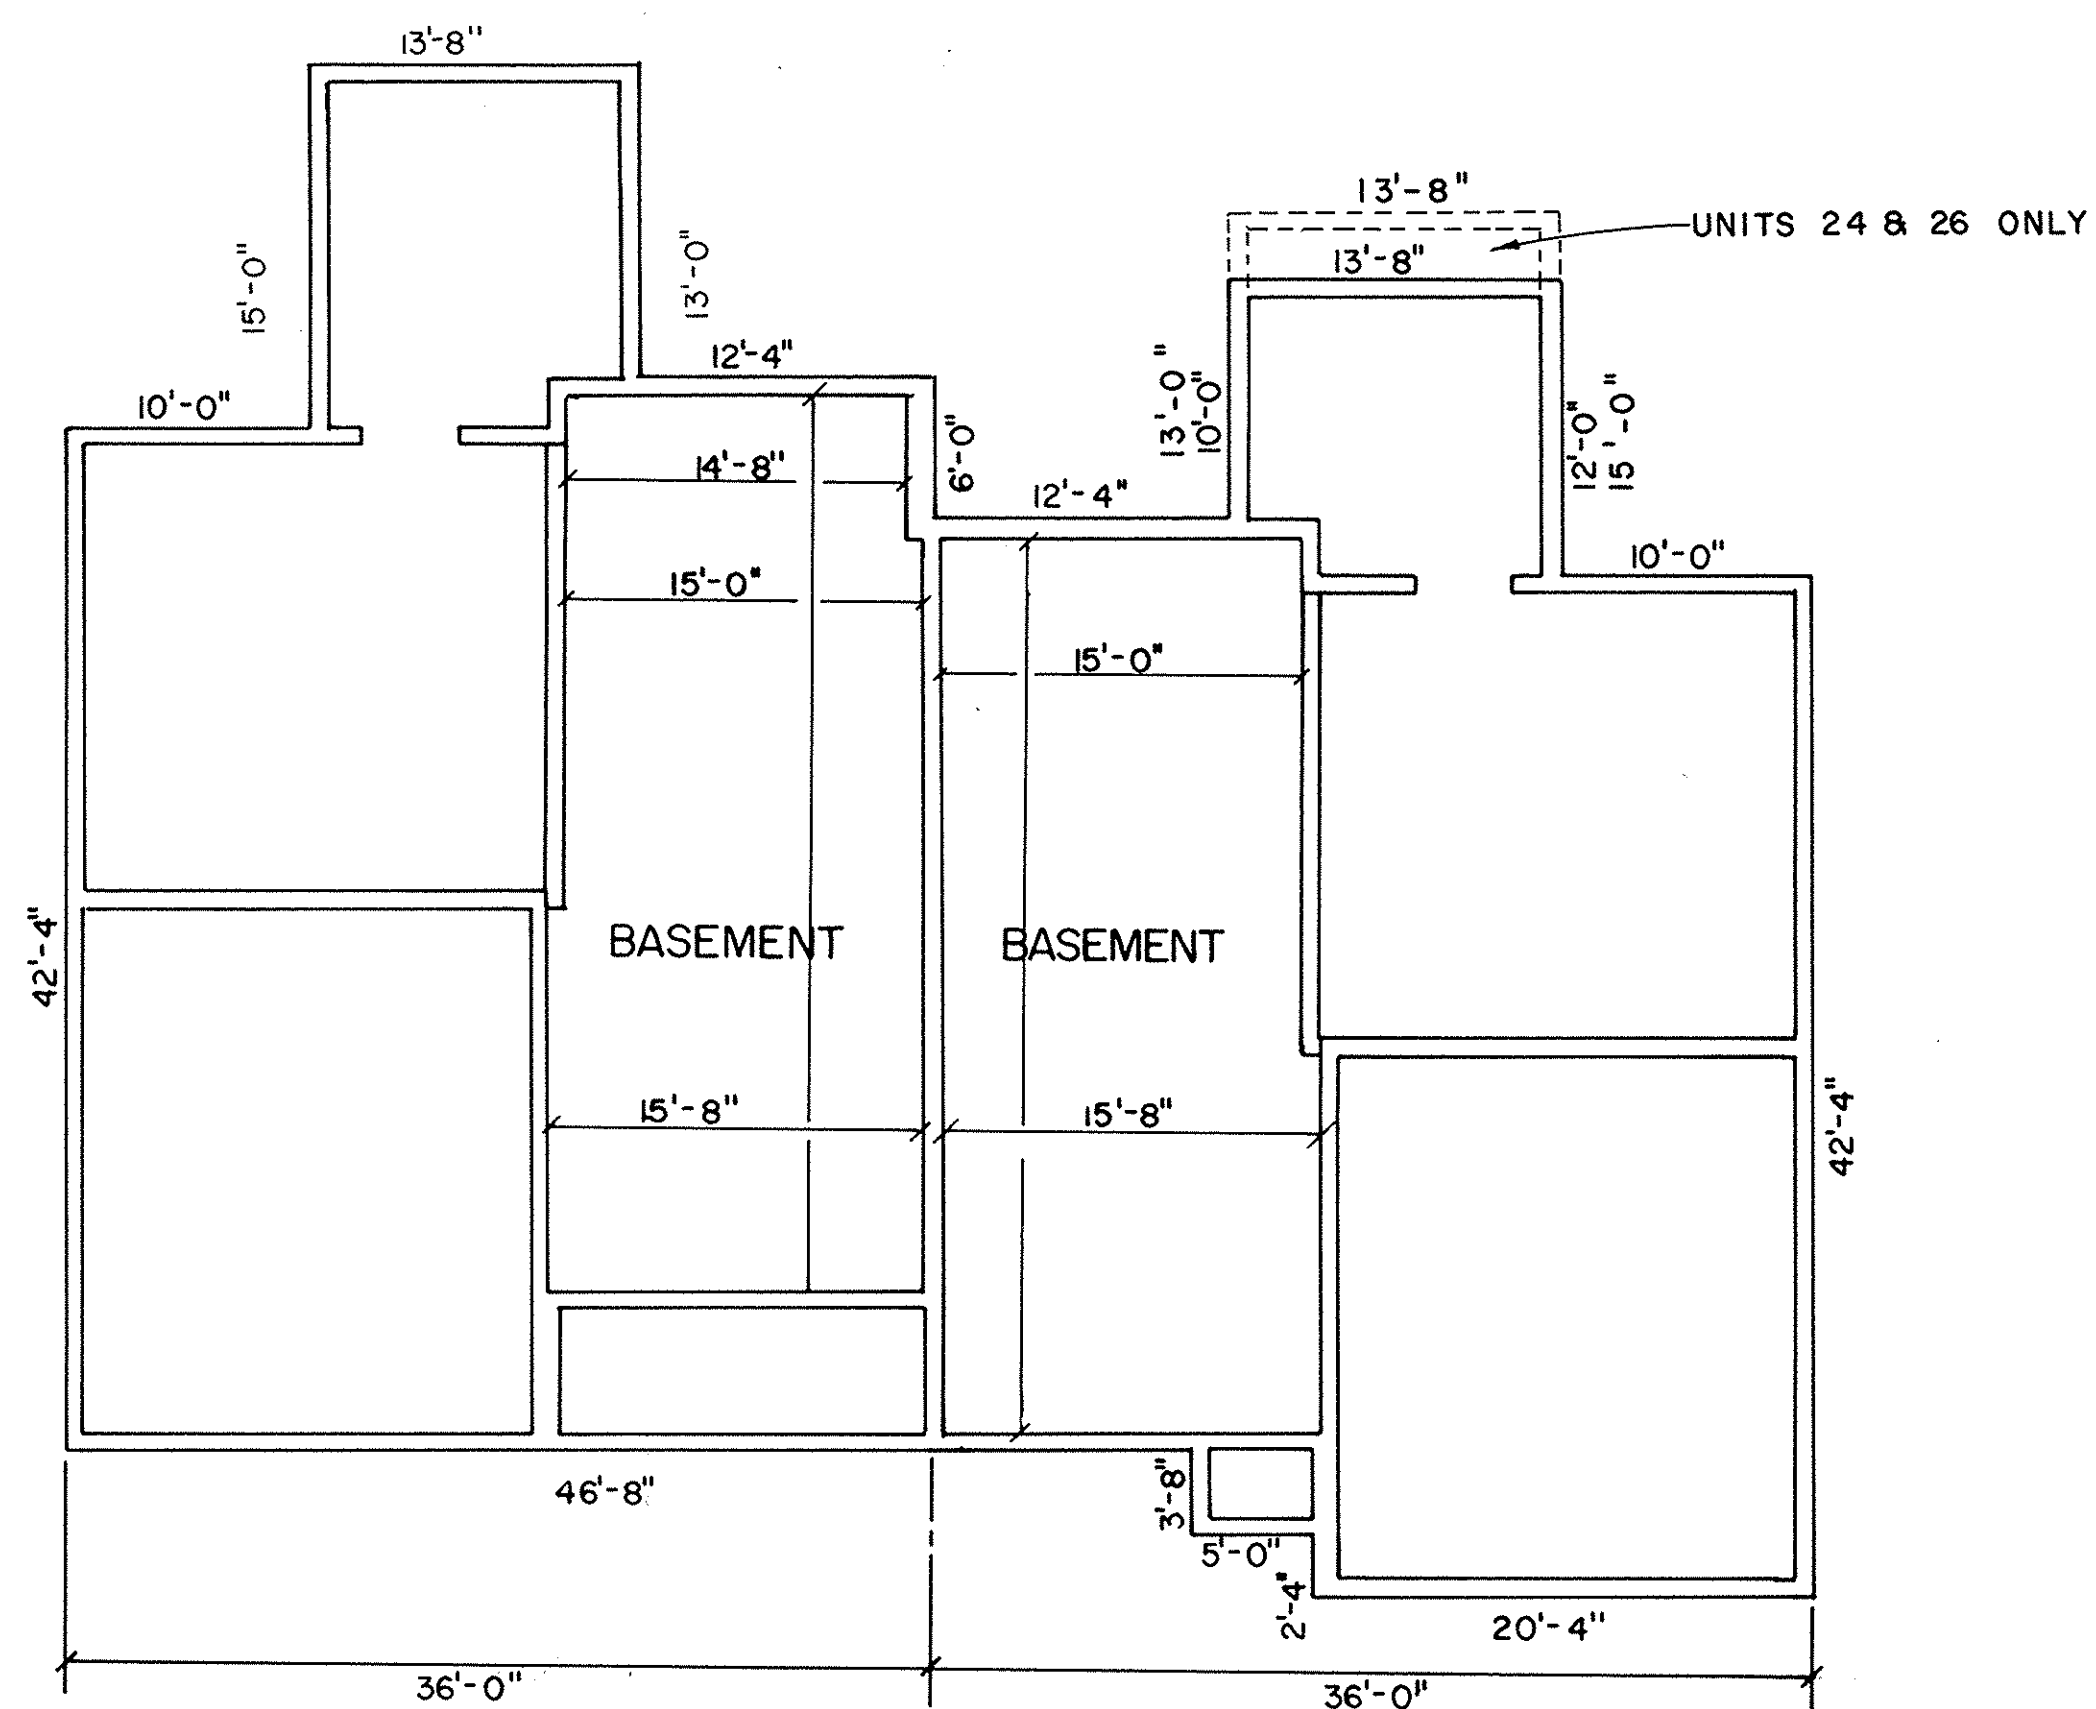


FOUNDATION PLAN
SCALE: 1/8" = 1'-0"

TYPICAL UNITS: 21, 22, 23, 24, 25 & 26

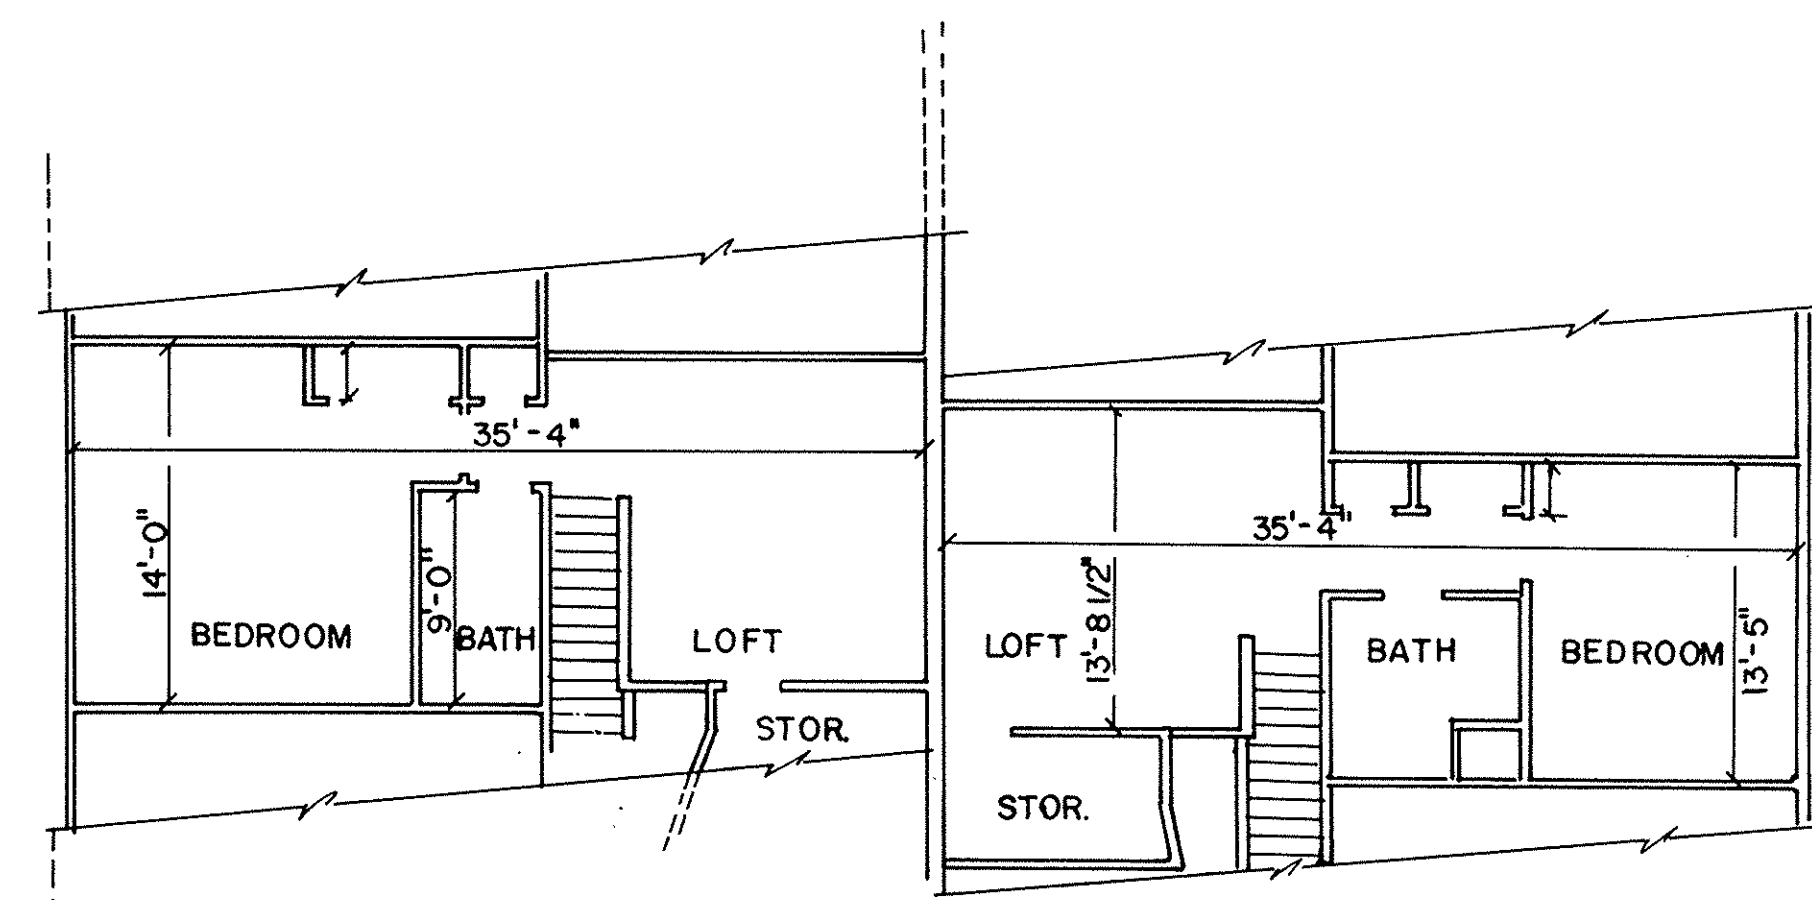

SECOND FLOOR PLAN
SCALE: 1/8" = 1'-0"

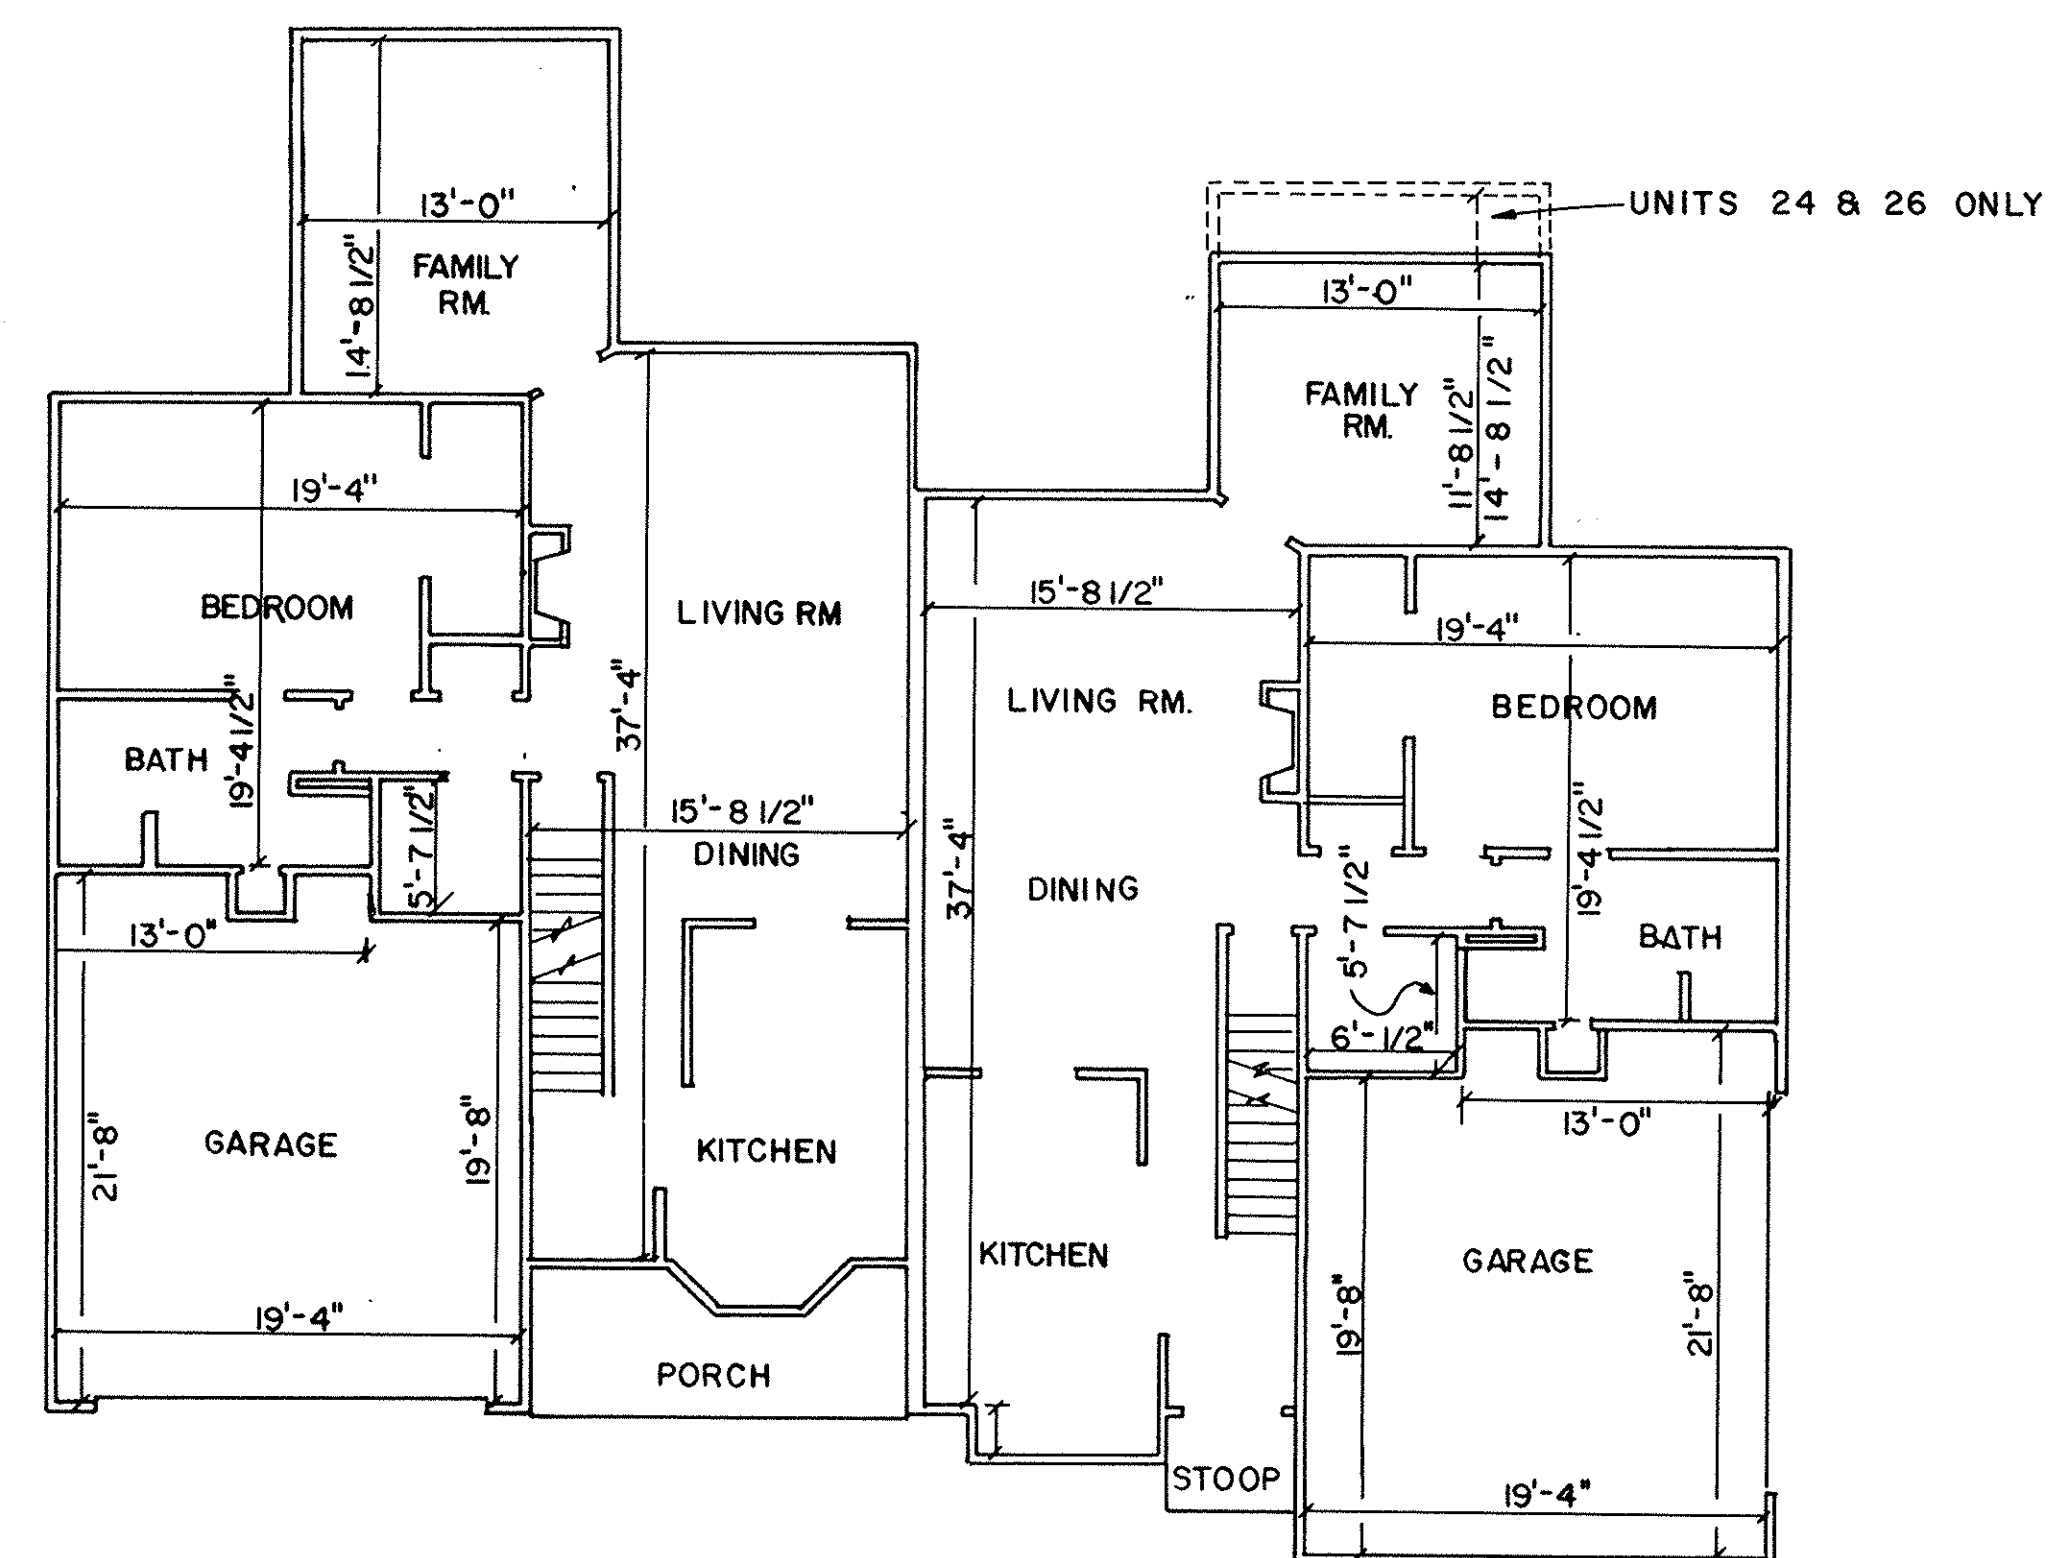


FIRST FLOOR PLAN
SCALE: 1/8" = 1'-0"

VILLAS AT HIGHLAND PARK PHASE 4
FOUNDATION PLAN
FLOOR PLANS


LORAIN COUNTY TAX
MAP DEPARTMENT COPY




FRONT ELEVATION

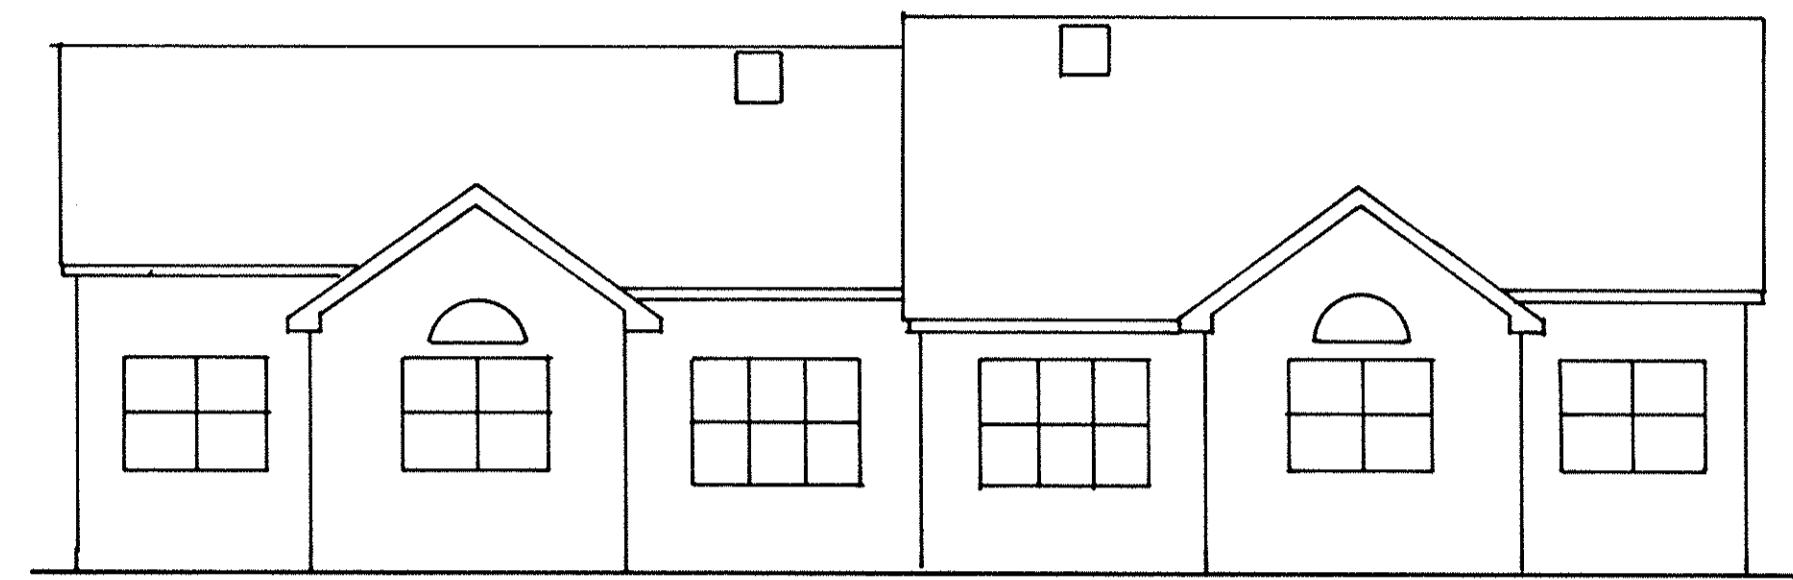

REAR ELEVATION

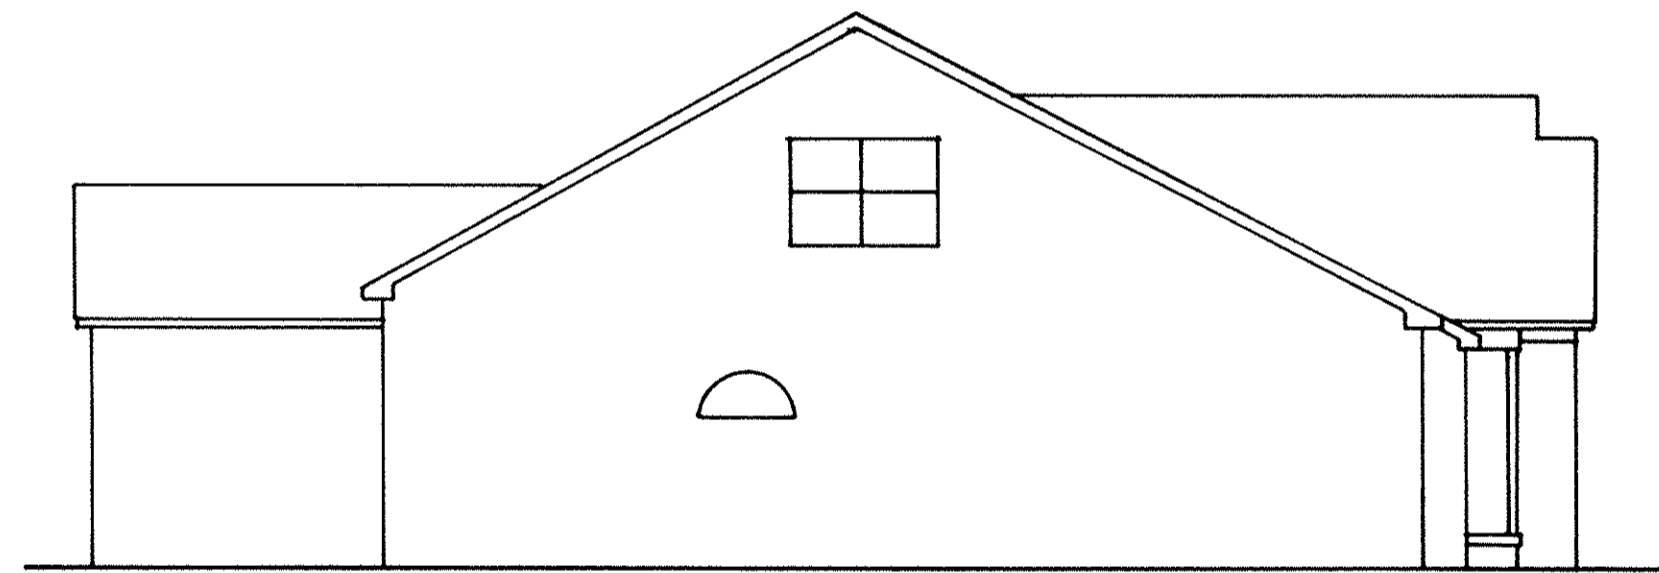

LEFT SIDE ELEVATION

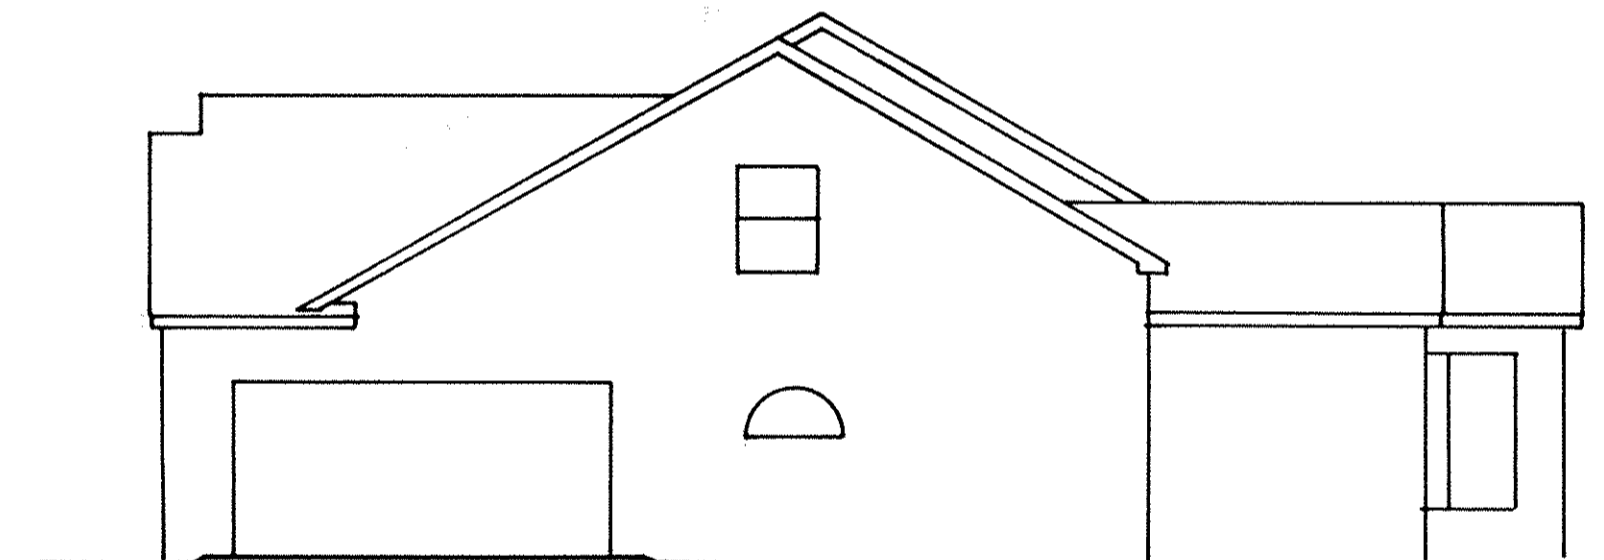

RIGHT SIDE ELEVATION

VILLAS AT HIGHLAND PARK PHASE 4
EXTERIOR ELEVATIONS

LORAIN COUNTY TAX
MAP DEPARTMENT COPY