


CURVE TABLE

CURVE	RADIUS	DELTA	LENGTH	CHORD	BEARING
C-1	28.00'	49°44'34"	24.31'	23.55'	S 66°06'42" W
C-2	28.00'	40°13'43"	19.66'	19.26'	S 21°07'34" W
C-3	28.00'	89°58'17"	43.97'	39.59'	S 45°59'50" W

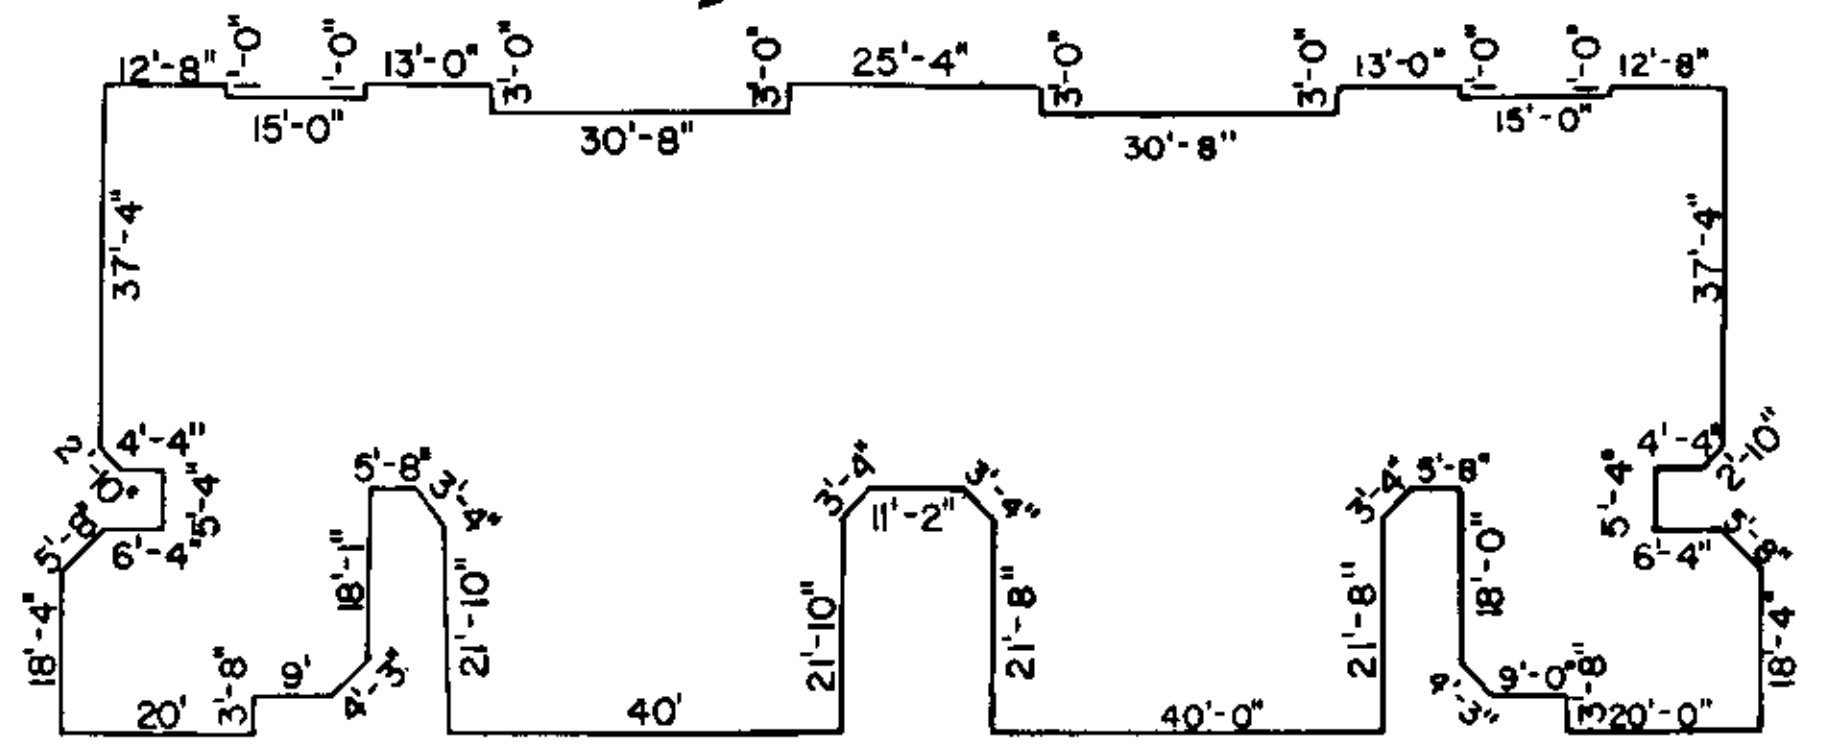

FOUNDATION PLAN
SCALE: 1" = 20'

OWNERSHIP TABLE


UNIT NO.	SQ. FT.	ELEV. 1ST FL.	% OWNERSHIP
1-101	1388	723.40	1.7022
2-103	1626	723.40	1.9941
3-105	1769	723.40	2.1695
4-107	1388	723.40	1.7022
5-141	1388	719.38	1.7022
6-143	1626	719.38	1.9941
7-145	1769	719.38	2.1695
8-147	1388	719.38	1.7022
9-151	1388	719.53	1.7022
10-153	1626	719.53	1.9941
11-155	1769	719.53	2.1695
12-157	1388	719.53	1.7022
13-109	1388	722.30	1.7022
14-111	1626	722.30	1.9941
15-113	1769	722.30	2.1695
16-115	1388	722.30	1.7022
17-129	1388	720.10	1.7022
18-131	1626	720.10	1.9941
19-133	2177	720.10	2.6698
20-135	1769	720.10	2.1695
21-137	1626	720.10	1.9941
22-139	1388	720.10	1.7022
23-128	1388	719.53	1.7022
24-130	1626	719.45	1.9941
25-132	1769	719.45	2.1695
26-134	2177	719.45	2.6698
27-136	1626	719.50	1.9941
28-138	1388	719.47	1.7022
29-117	1388	721.20	1.7022
30-119	1626	721.21	1.9941
31-121	1769	721.21	2.1695
32-123	2177	721.24	2.6698
33-125	1626	721.25	1.9941
34-127	1388	721.22	1.7022
35-260	1388	724.73	1.7022
36-262	2177	724.68	2.6698
37-264	1626	724.66	1.9941
38-266	1388	724.66	1.7022
39-116	1388	720.82	1.7022
40-118	1626	720.83	1.9941
41-120	2177	720.83	2.6698
42-122	1769	720.82	2.1695
43-124	1626	720.80	1.9941
44-126	1388	720.77	1.7022
45-361	1388	719.44	1.7022
46-363	1626	719.38	1.9941
47-365	2177	719.39	2.6698
48-367	1769	719.40	2.1695
49-369	1626	719.40	1.9941
50-371	1388	719.43	1.7022
81-541			100.00

NOTE: AREA OF BASEMENTS ARE NOT USED IN DETERMINING CONDOMINIUM OWNERSHIP.

CERTIFICATION
THIS IS TO CERTIFY THAT THE ATTACHED DRAWINGS CORRECTLY REPRESENT THE BUILDINGS AS CONSTRUCTED AND THAT THERE ARE NO ENCROACHMENTS ON ABUTTING PROPERTIES.

David L. Elwell
DAVID L. ELWELL
REG. SURVEYOR NO. 6333

Yvonne S. Miggins
YVONNE S. MIGGINS
REG. ENGINEER NO. 46837

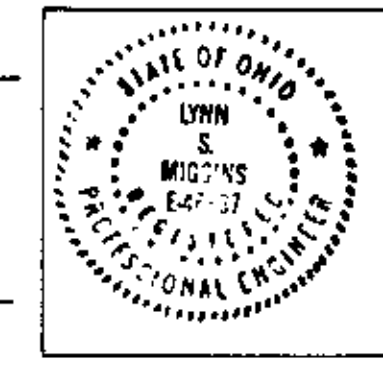

REVISIONS

NO.	DESCRIPTION


THE ENGLISH LAKES CONDOMINIUMS
PHASE 10

PART OF AMHERST TWP. O.L. 25 & 26
CITY OF AMHERST • COUNTY OF LORAIN • STATE OF OHIO


KS ASSOCIATES, INC.
ENGINEERS/SURVEYORS
424 Middle Avenue
P.O. Box 89
Elyria, Ohio 44036
Elyria (216) 322-6317 • Lorain (216) 244-5757




SHEET 3 OF 3
JOB NO. 89224-CPI

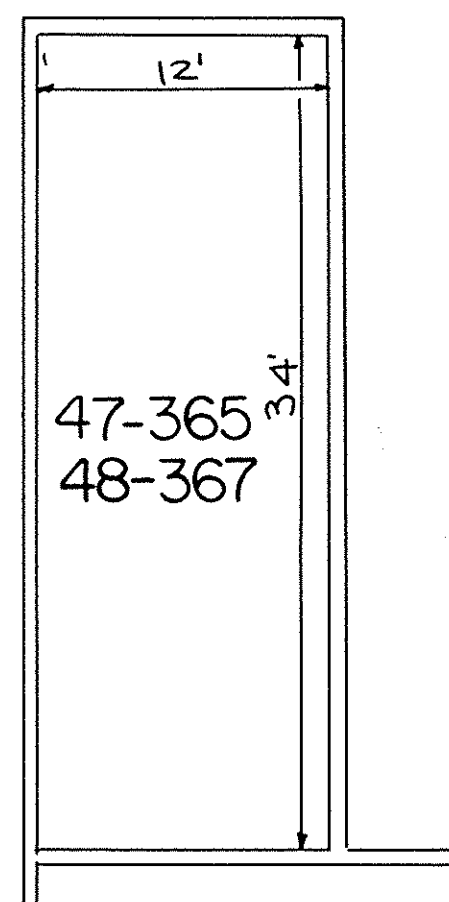

THIRD FLOOR PLAN
SCALE: 1/8" = 1'-0"

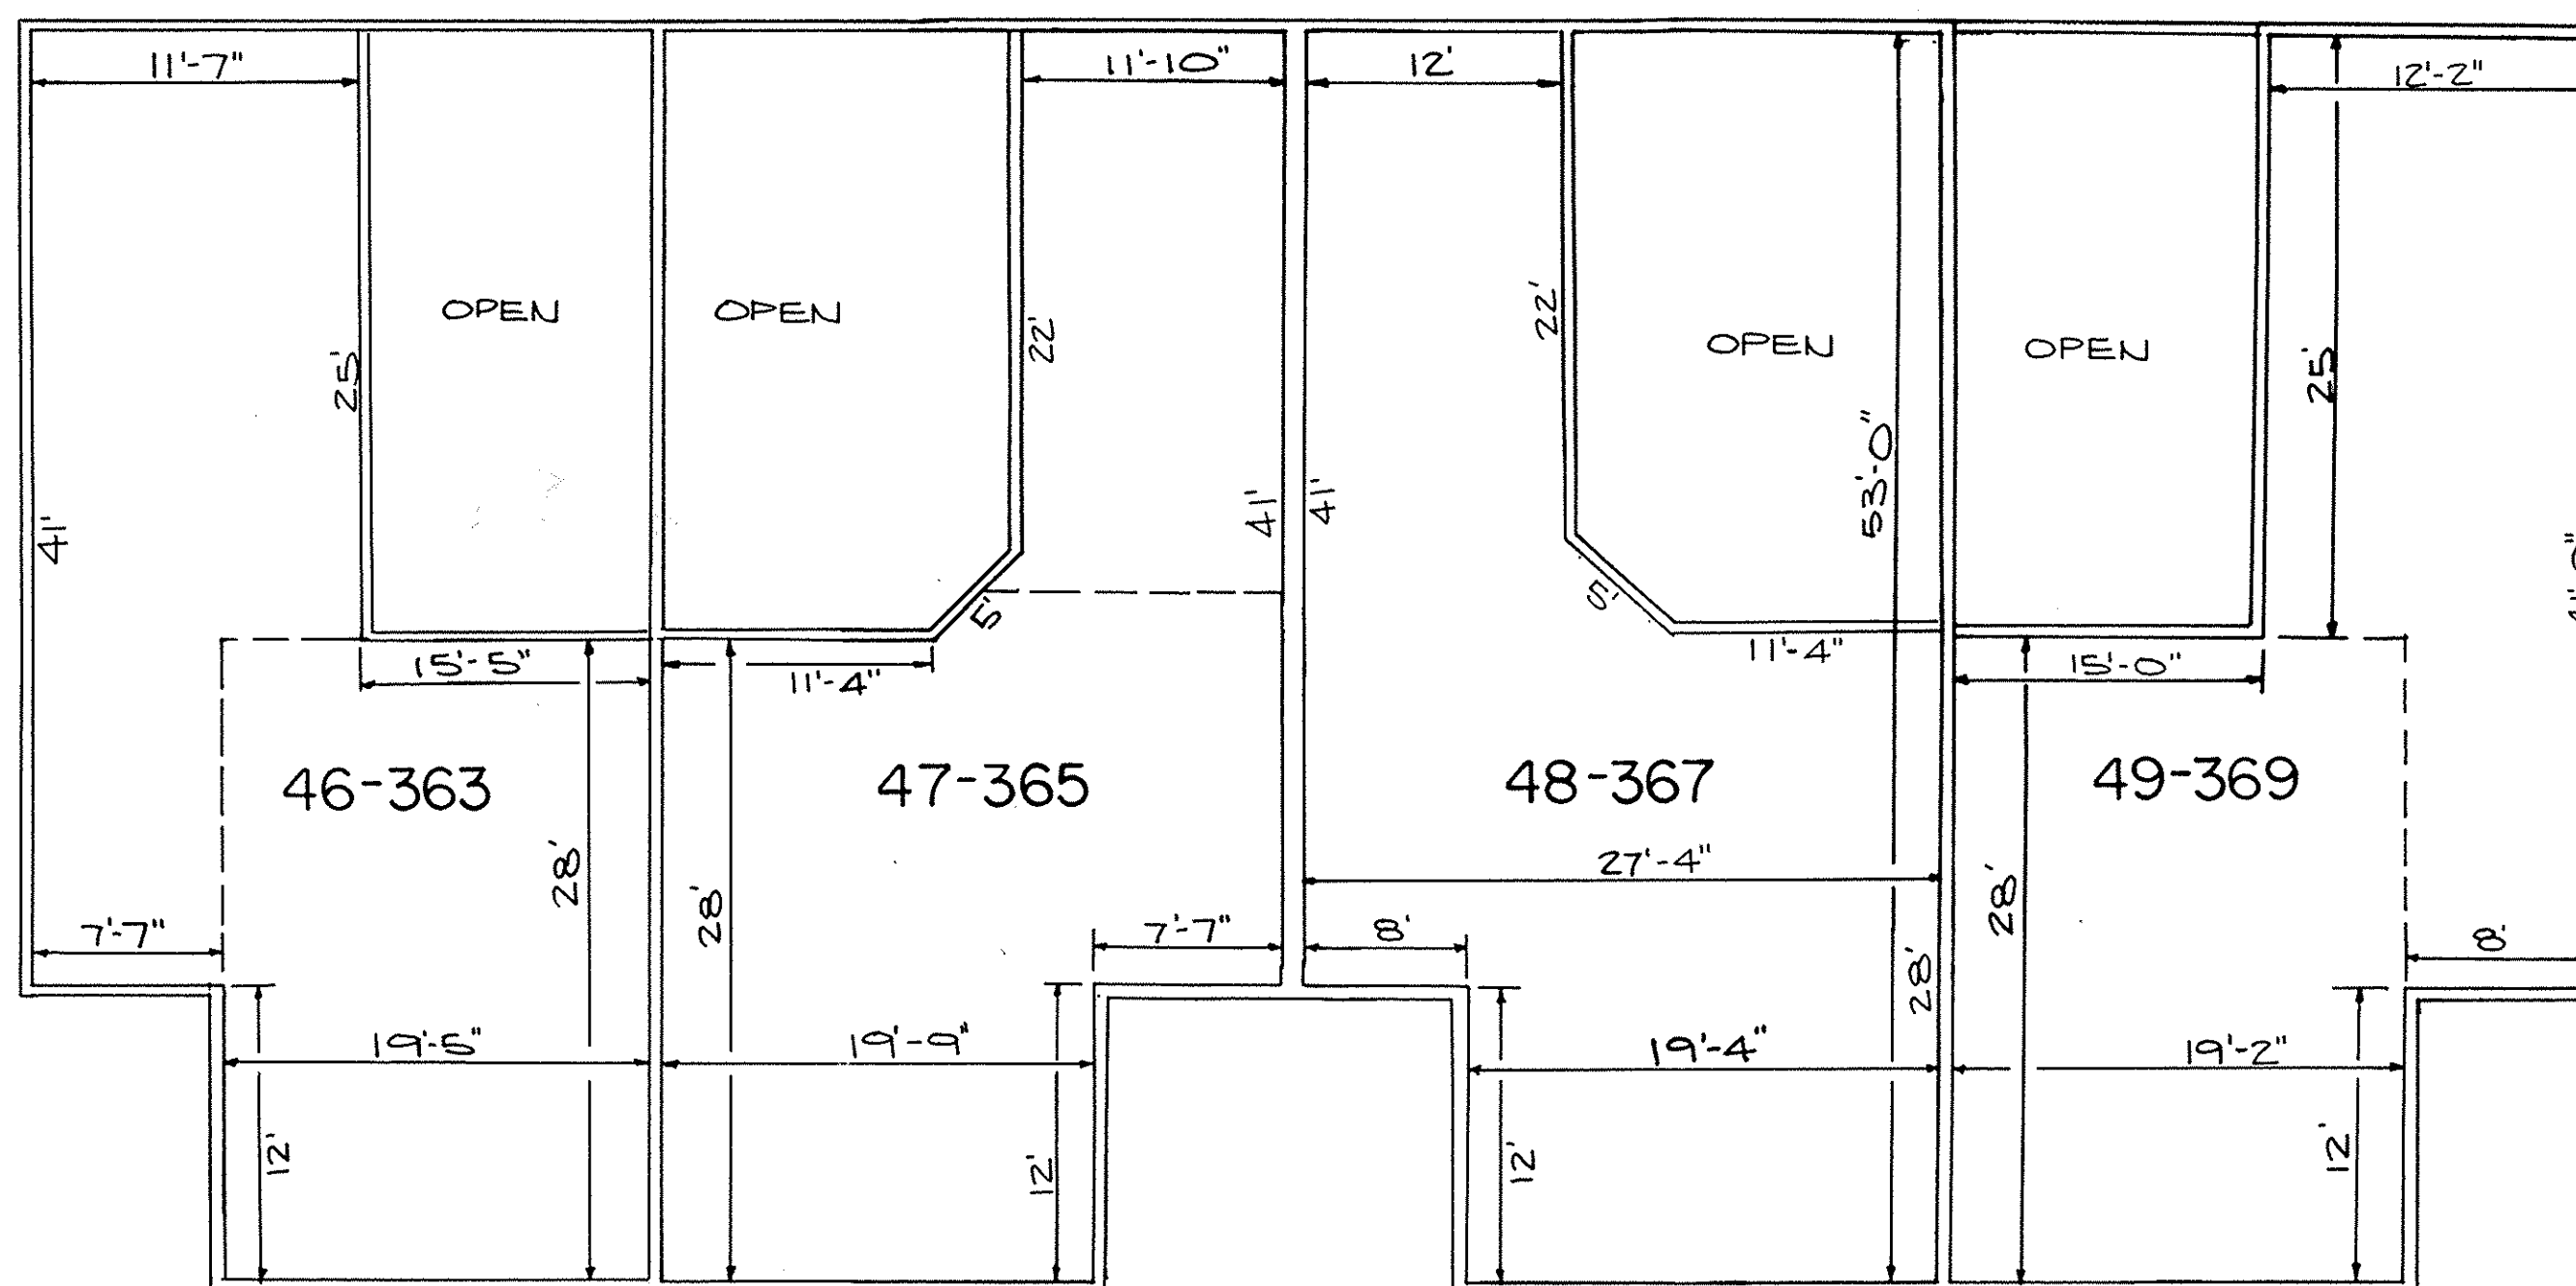

SECOND FLOOR PLAN
SCALE: 1/8" = 1'-0"

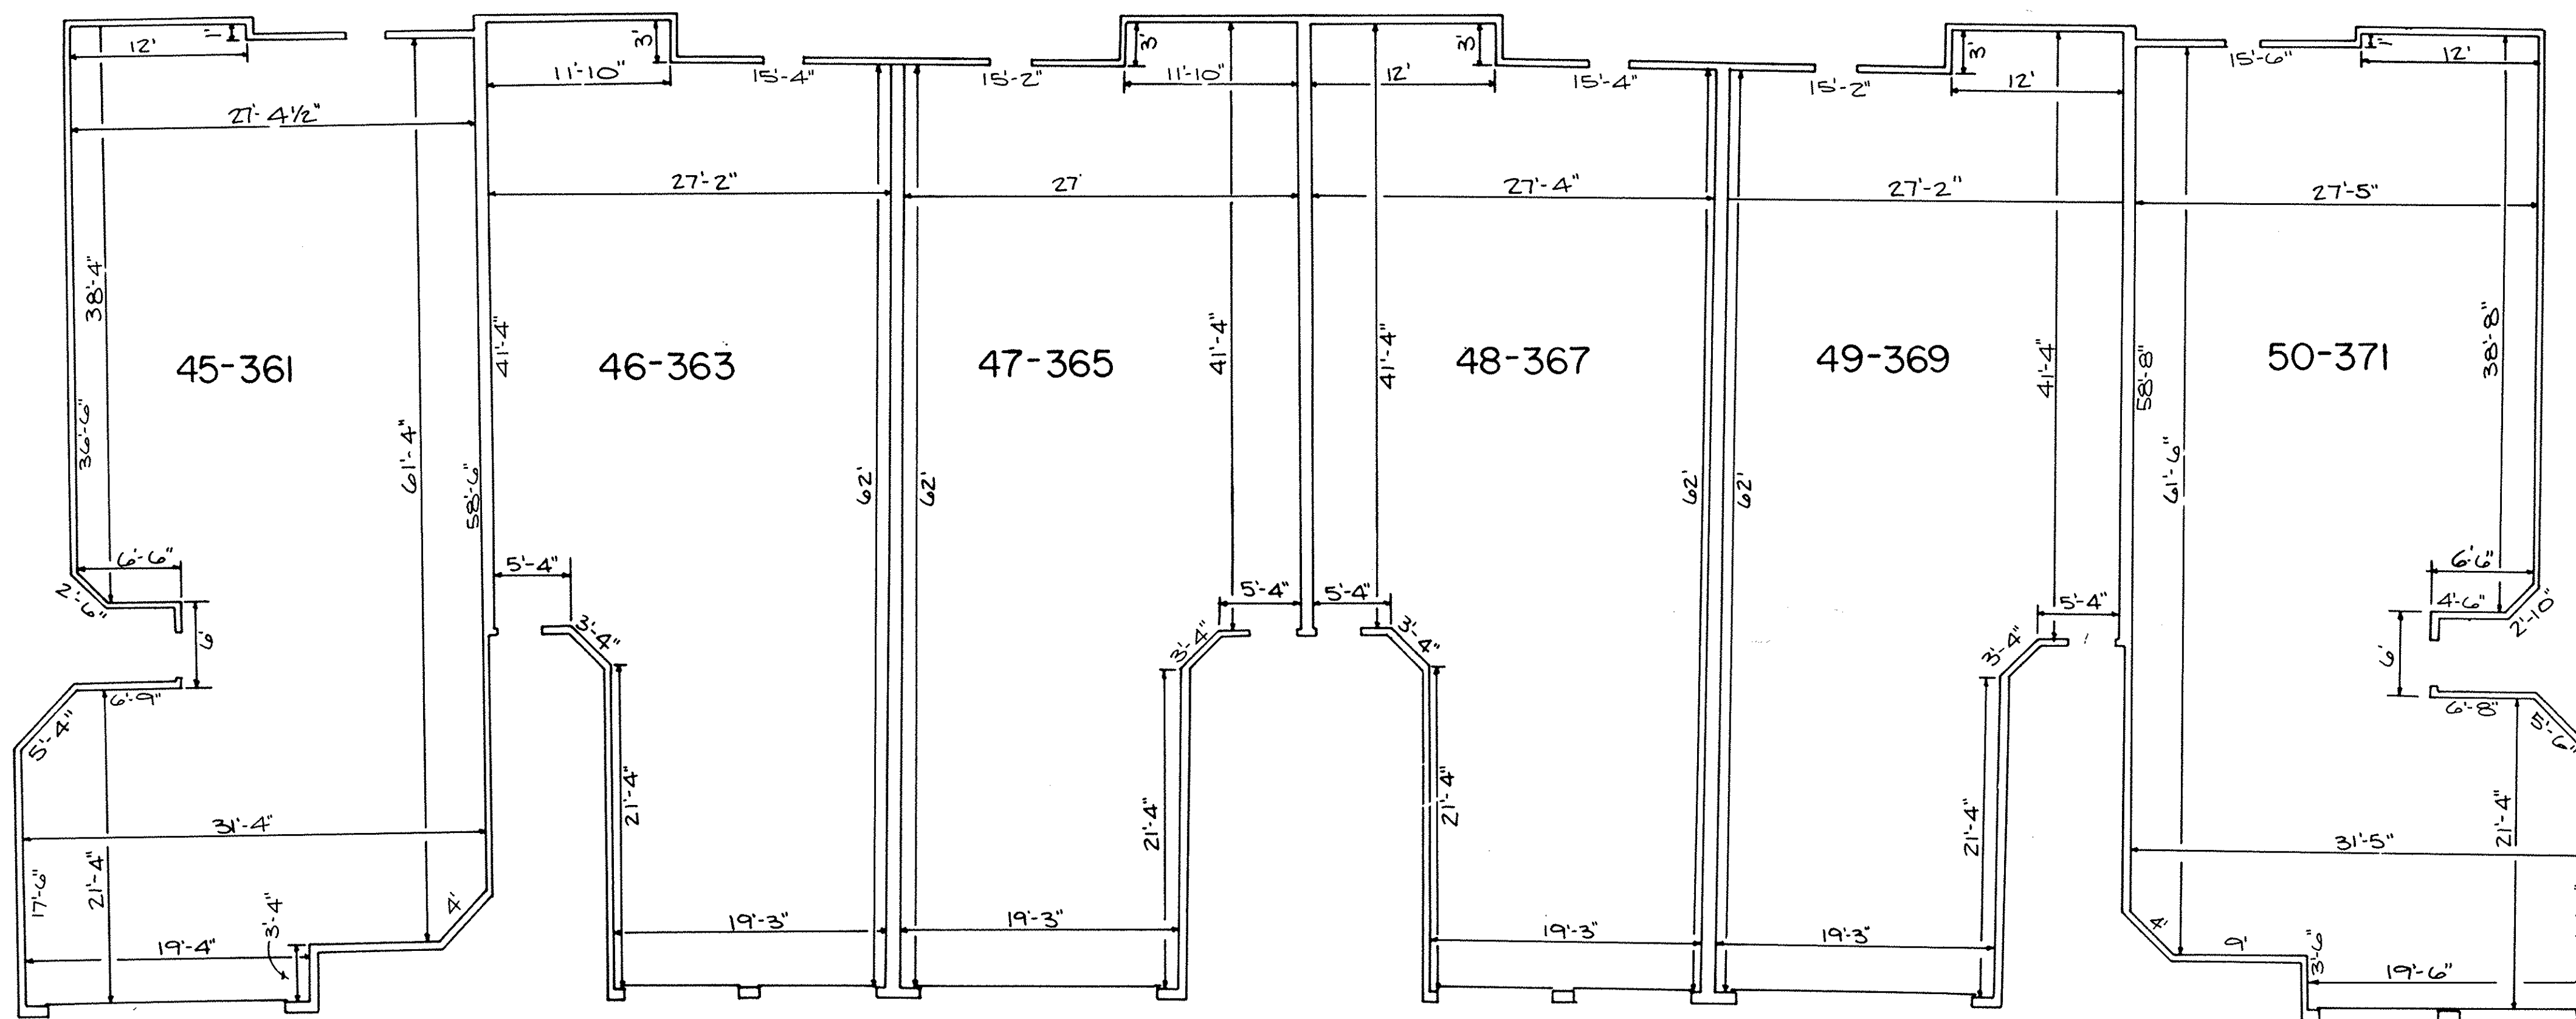

FIRST FLOOR PLAN
SCALE: 1/8" = 1'-0"

LORAIN COUNTY TAX
MAP DEPARTMENT COPY

REVISIONS		


THE ENGLISH LAKES CONDOMINIUMS
PHASE 10

FLOOR PLANS


KS ASSOCIATES, INC.
ENGINEERS/SURVEYORS
424 Middle Avenue
P.O. Box 89
Elyria, Ohio 44036
Elyria (216) 322-6317 • Lorain (216) 244-5757



SHEET
2 OF
3
JOB NO.
89-224-CP10

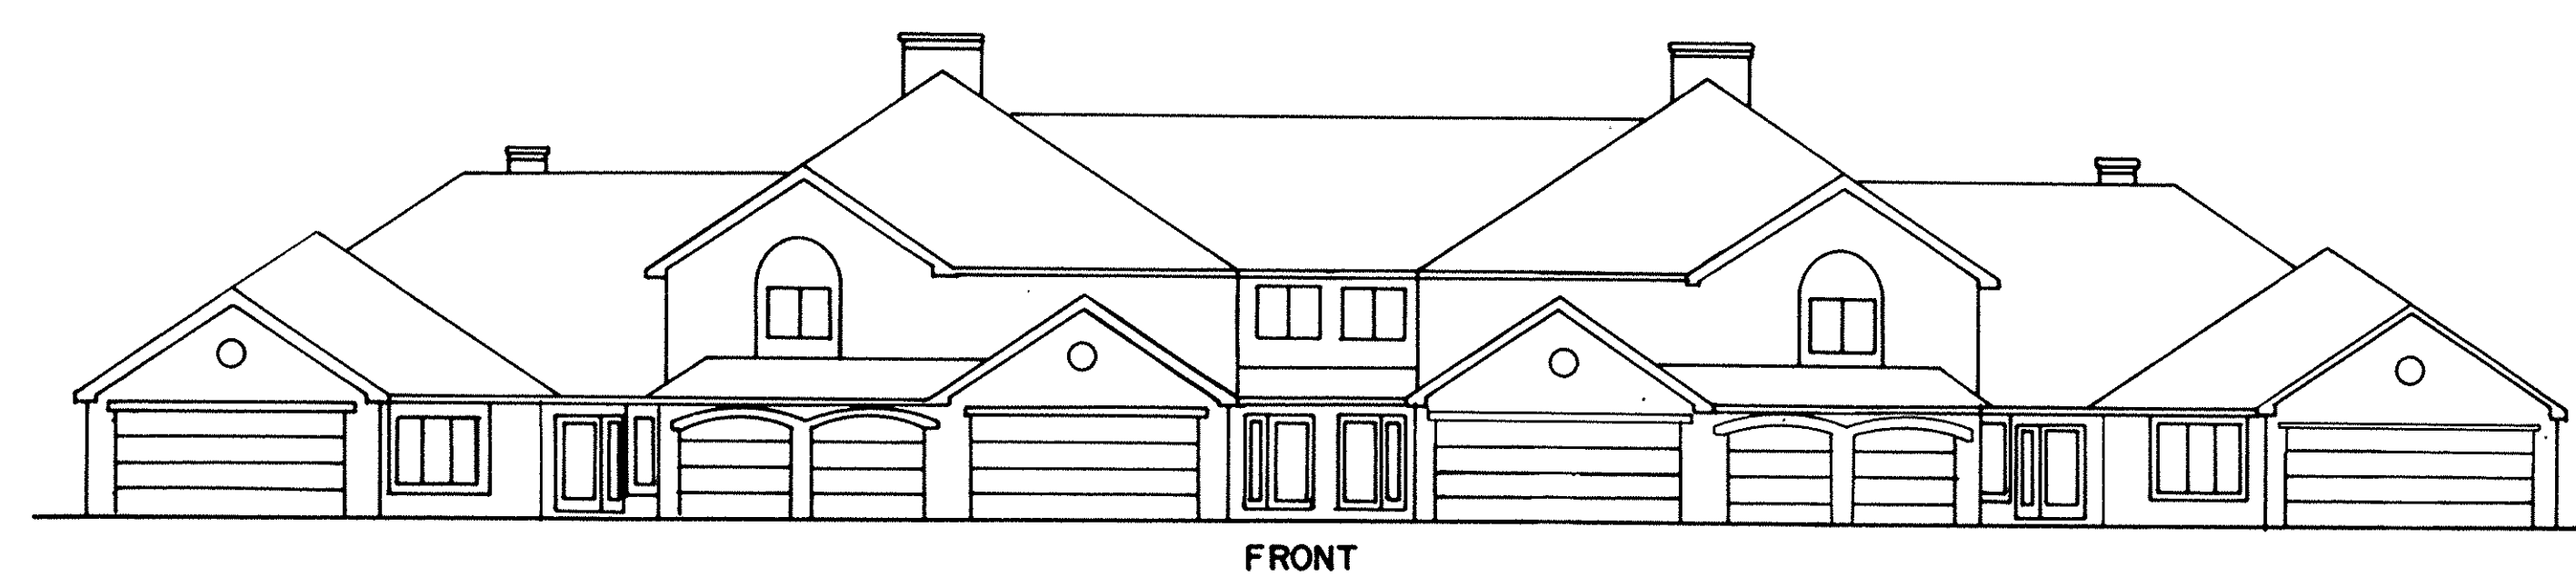


FRONT

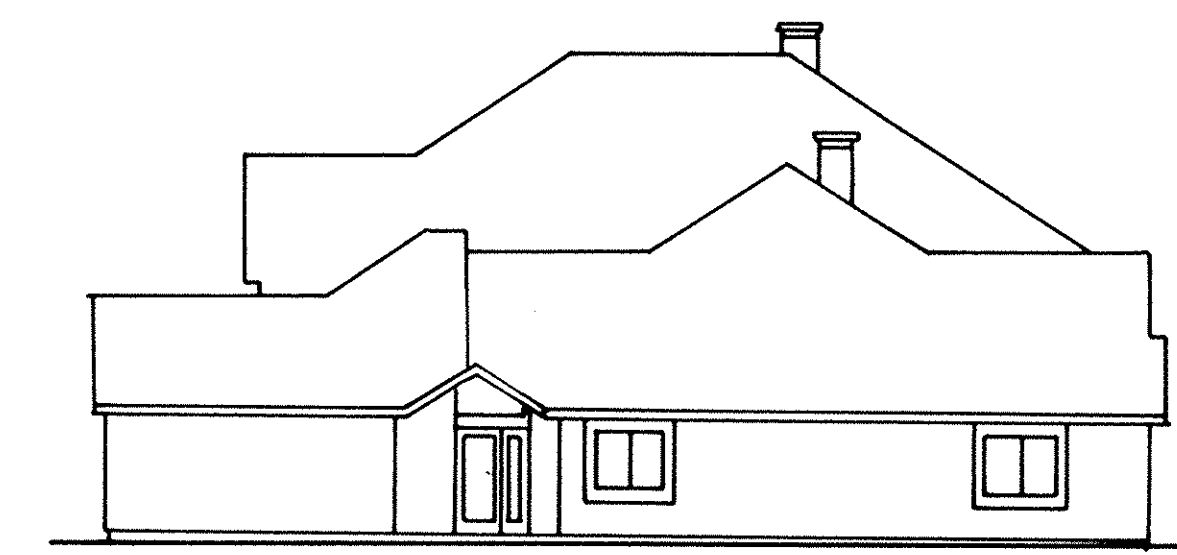

RIGHT



REAR

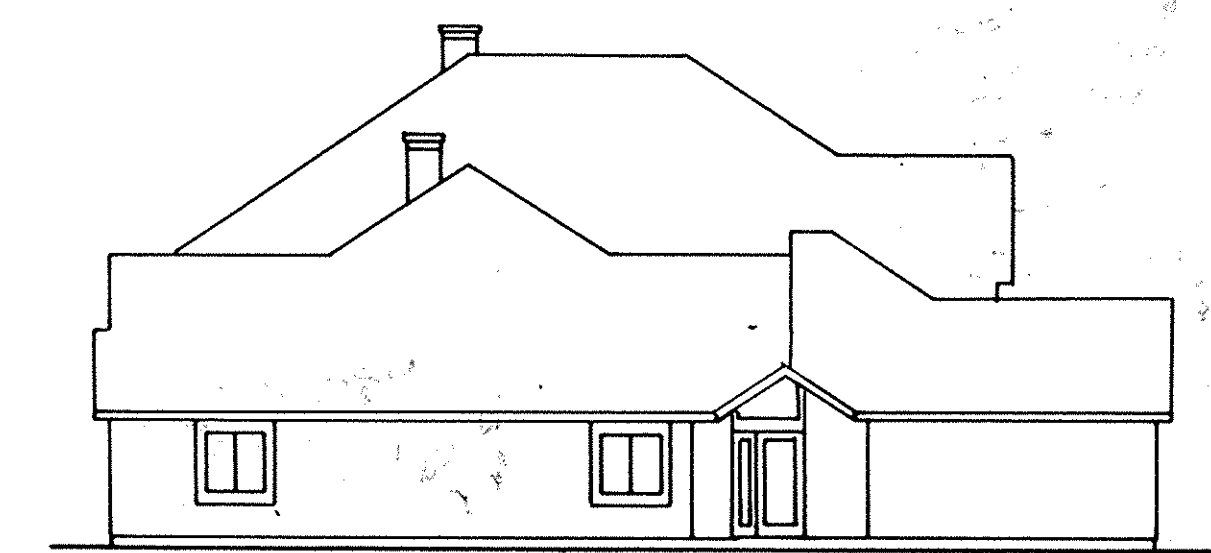

LEFT

LORAIN COUNTY TAX
MAP DEPARTMENT COPY

REVISIONS	

THE ENGLISH LAKES CONDOMINIUMS
PHASE 10

EXTERIOR ELEVATIONS

KS ASSOCIATES, INC.
 ENGINEERS/SURVEYORS
 424 Middle Avenue
 P.O. Box 89
 Elyria, Ohio 44036
 Elyria (216) 322-6317 • Lorain (216) 244-5757



SHEET
3 OF
3
JOB NO.
89-224-CP10