

# THE WOODLANDS OF VERMILION CONDOMINIUM NO. 1

## CITY OF VERMILION-COUNTY OF LORAIN-OHIO


### PART OF ORIGINAL BROWHELM TOWNSHIP LOT NO. 2

# PHASE 6

OAK KNOLL INVESTMENT CO.  
O.R. 192, PG. 281


BLDG NO.	UNIT NO.	UNIT AREA	% OWNERSHIP
1	1	1,088 S.F.	.0381
1	2	1,088 S.F.	.0381
1	3	1,138 S.F.	.0398
1	4	1,138 S.F.	.0398
1	5	1,088 S.F.	.0381
1	6	1,088 S.F.	.0381
1	7	1,138 S.F.	.0398
1	8	1,138 S.F.	.0398
2	9	1,668 S.F.	.0584
2	10	1,904 S.F.	.0666
2	11	1,668 S.F.	.0584
3	12	1,476 S.F.	.0517
3	13	1,516 S.F.	.0530
3	14	1,484 S.F.	.0519
4	15	1,597 S.F.	.0555
4	16	2,650 S.F.	.0896
5	17	1,392 S.F.	.0487
5	18	1,392 S.F.	.0487
6	19	1,884 S.F.	.0659
6	20	2,000 S.F.	.0670

SHEET NO.	DESCRIPTION
1	TITLE SHEET - SURVEY MAP & MISC.
2	WEST ELEVATIONS &
3	SECOND FLOOR PLAN
4	EAST, NORTH, SOUTH ELEVATION
5	FOUNDATION PLAN
6	FIRST FLOOR PLAN

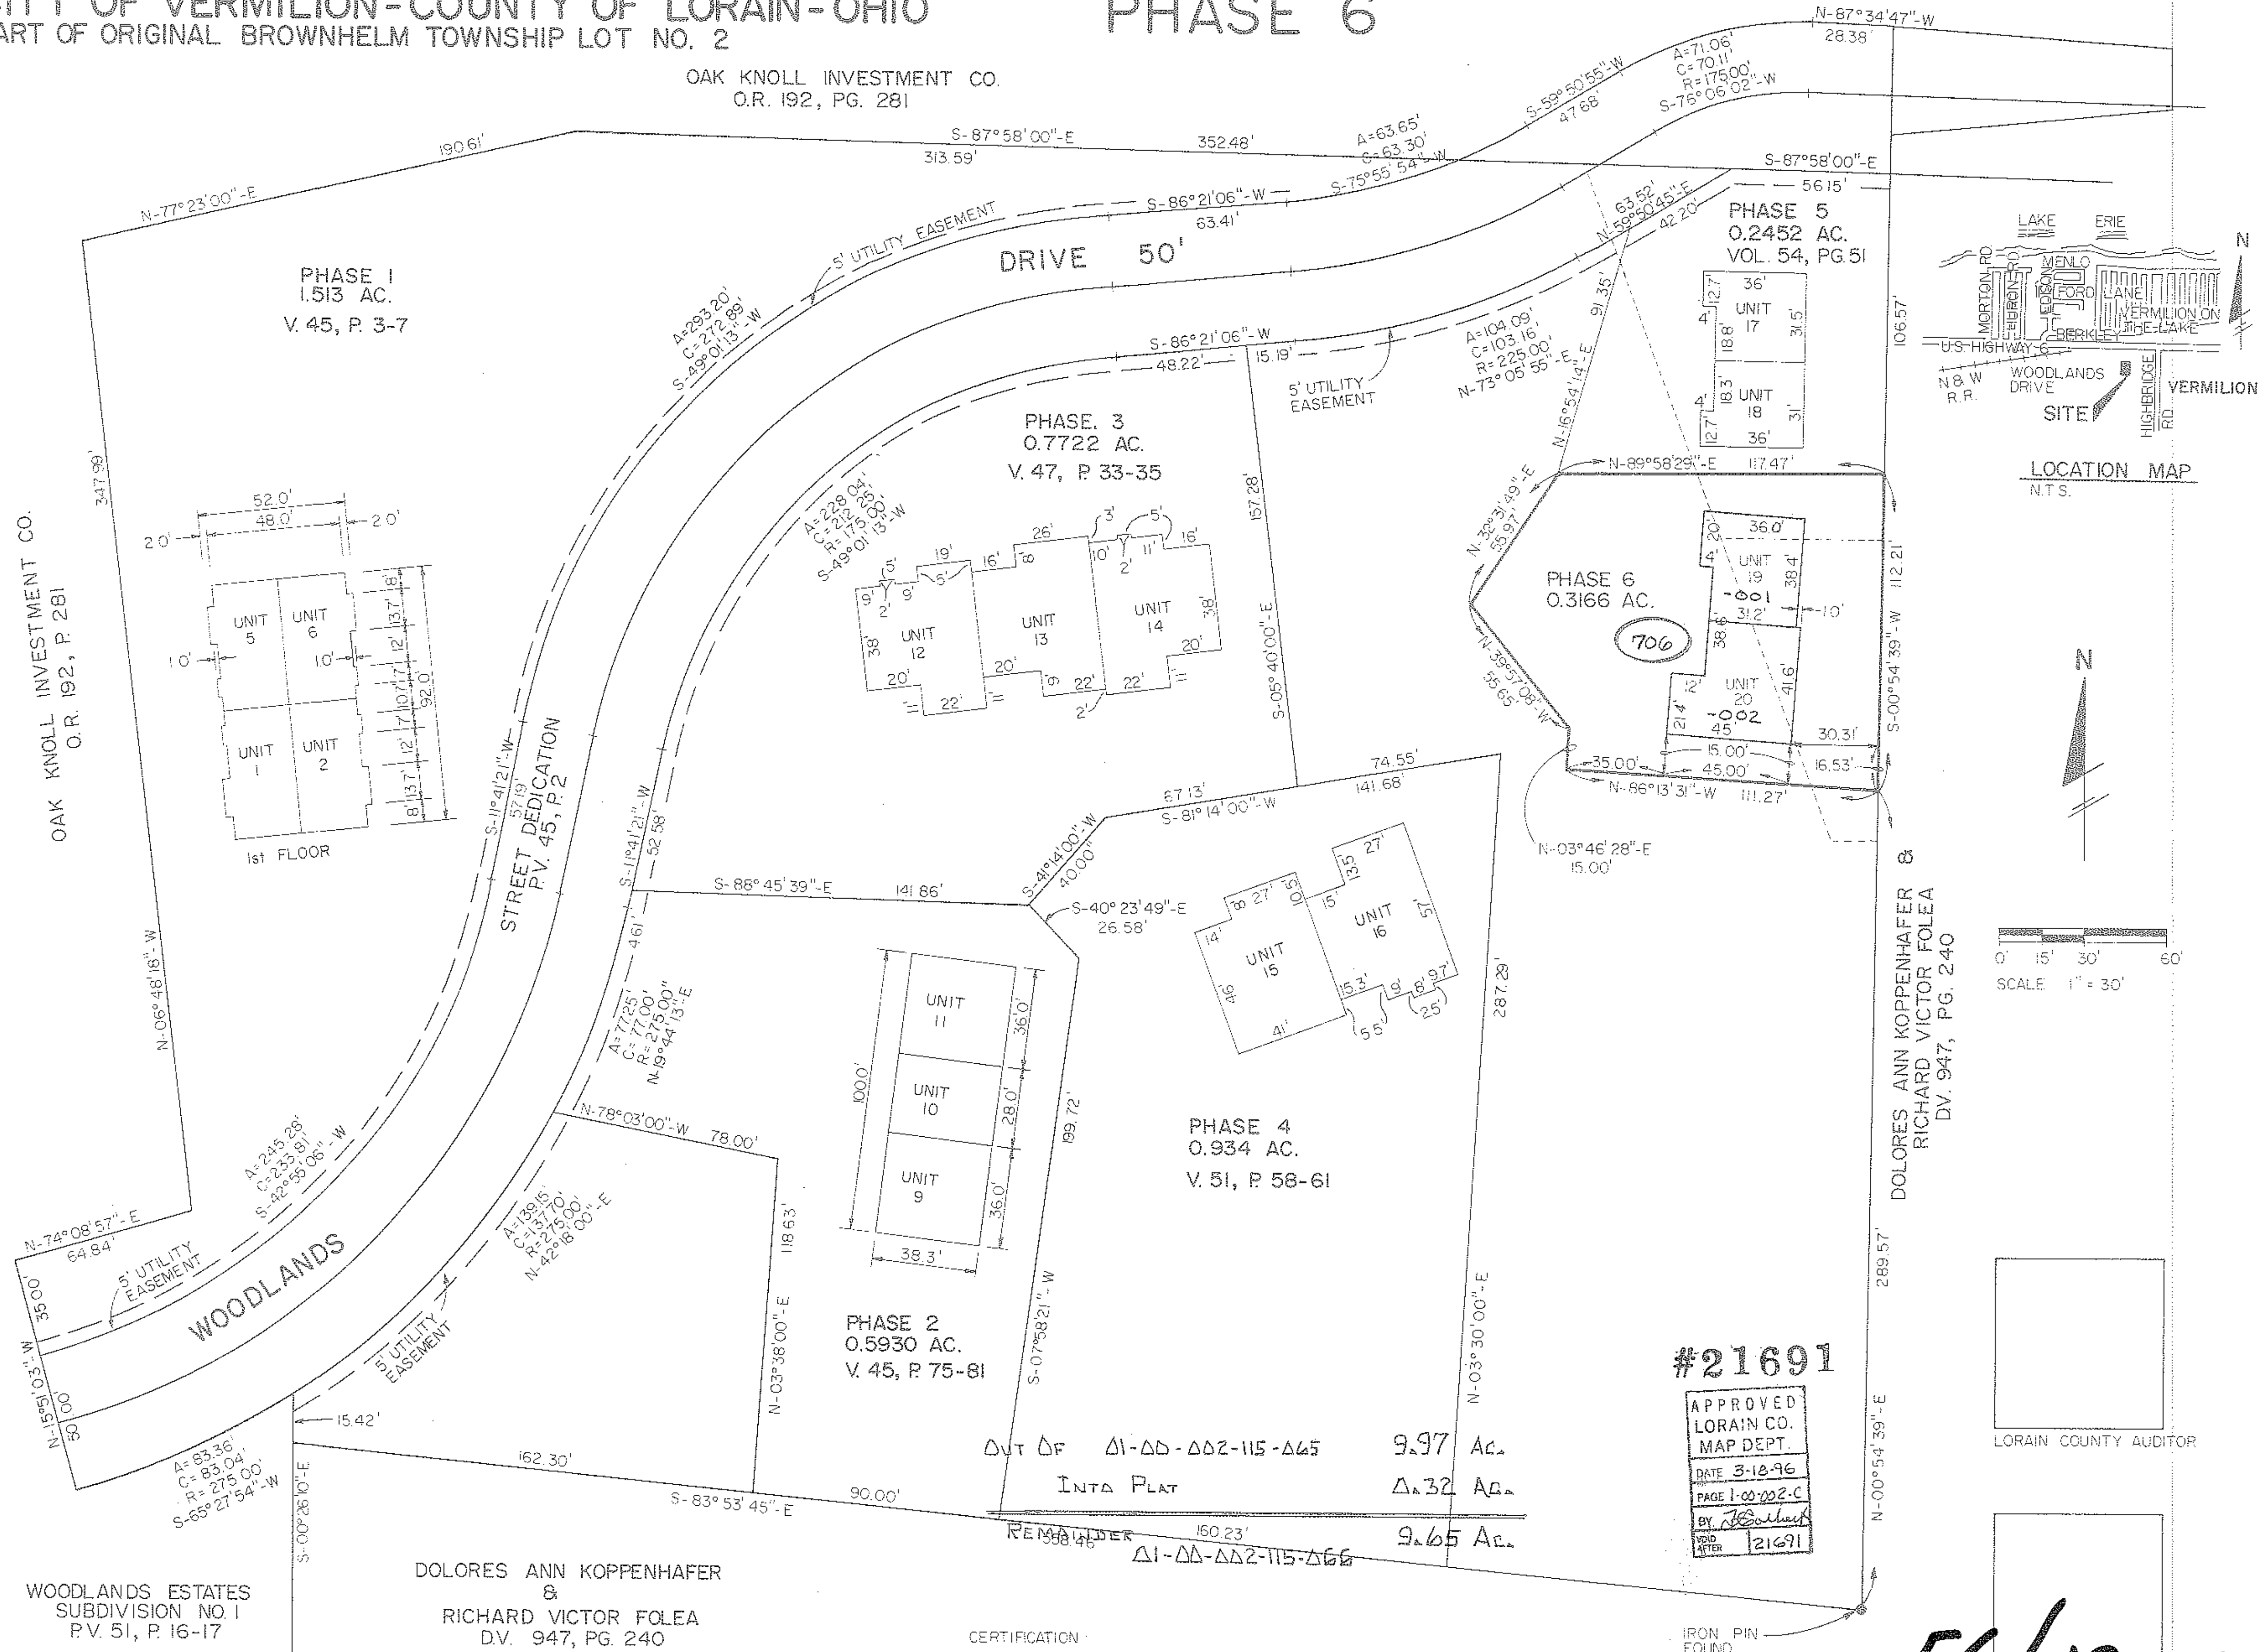


CERTIFICATION  
THIS IS TO CERTIFY THAT THE ATTACHED DRAWING CORRECTLY REPRESENTS THE BUILDING AS CONSTRUCTED AND THAT THERE ARE NO ENCROACHMENTS ON ADJUTING PROPERTIES.

*Lowell E. Bender*, Feb. 22, 1996

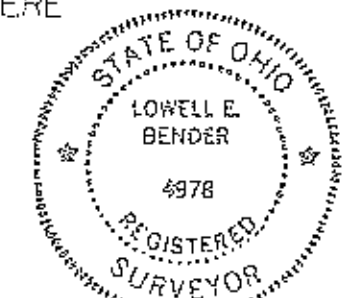

56/49-52

LORAIN COUNTY TAX  
MAP DEPARTMENT COPY

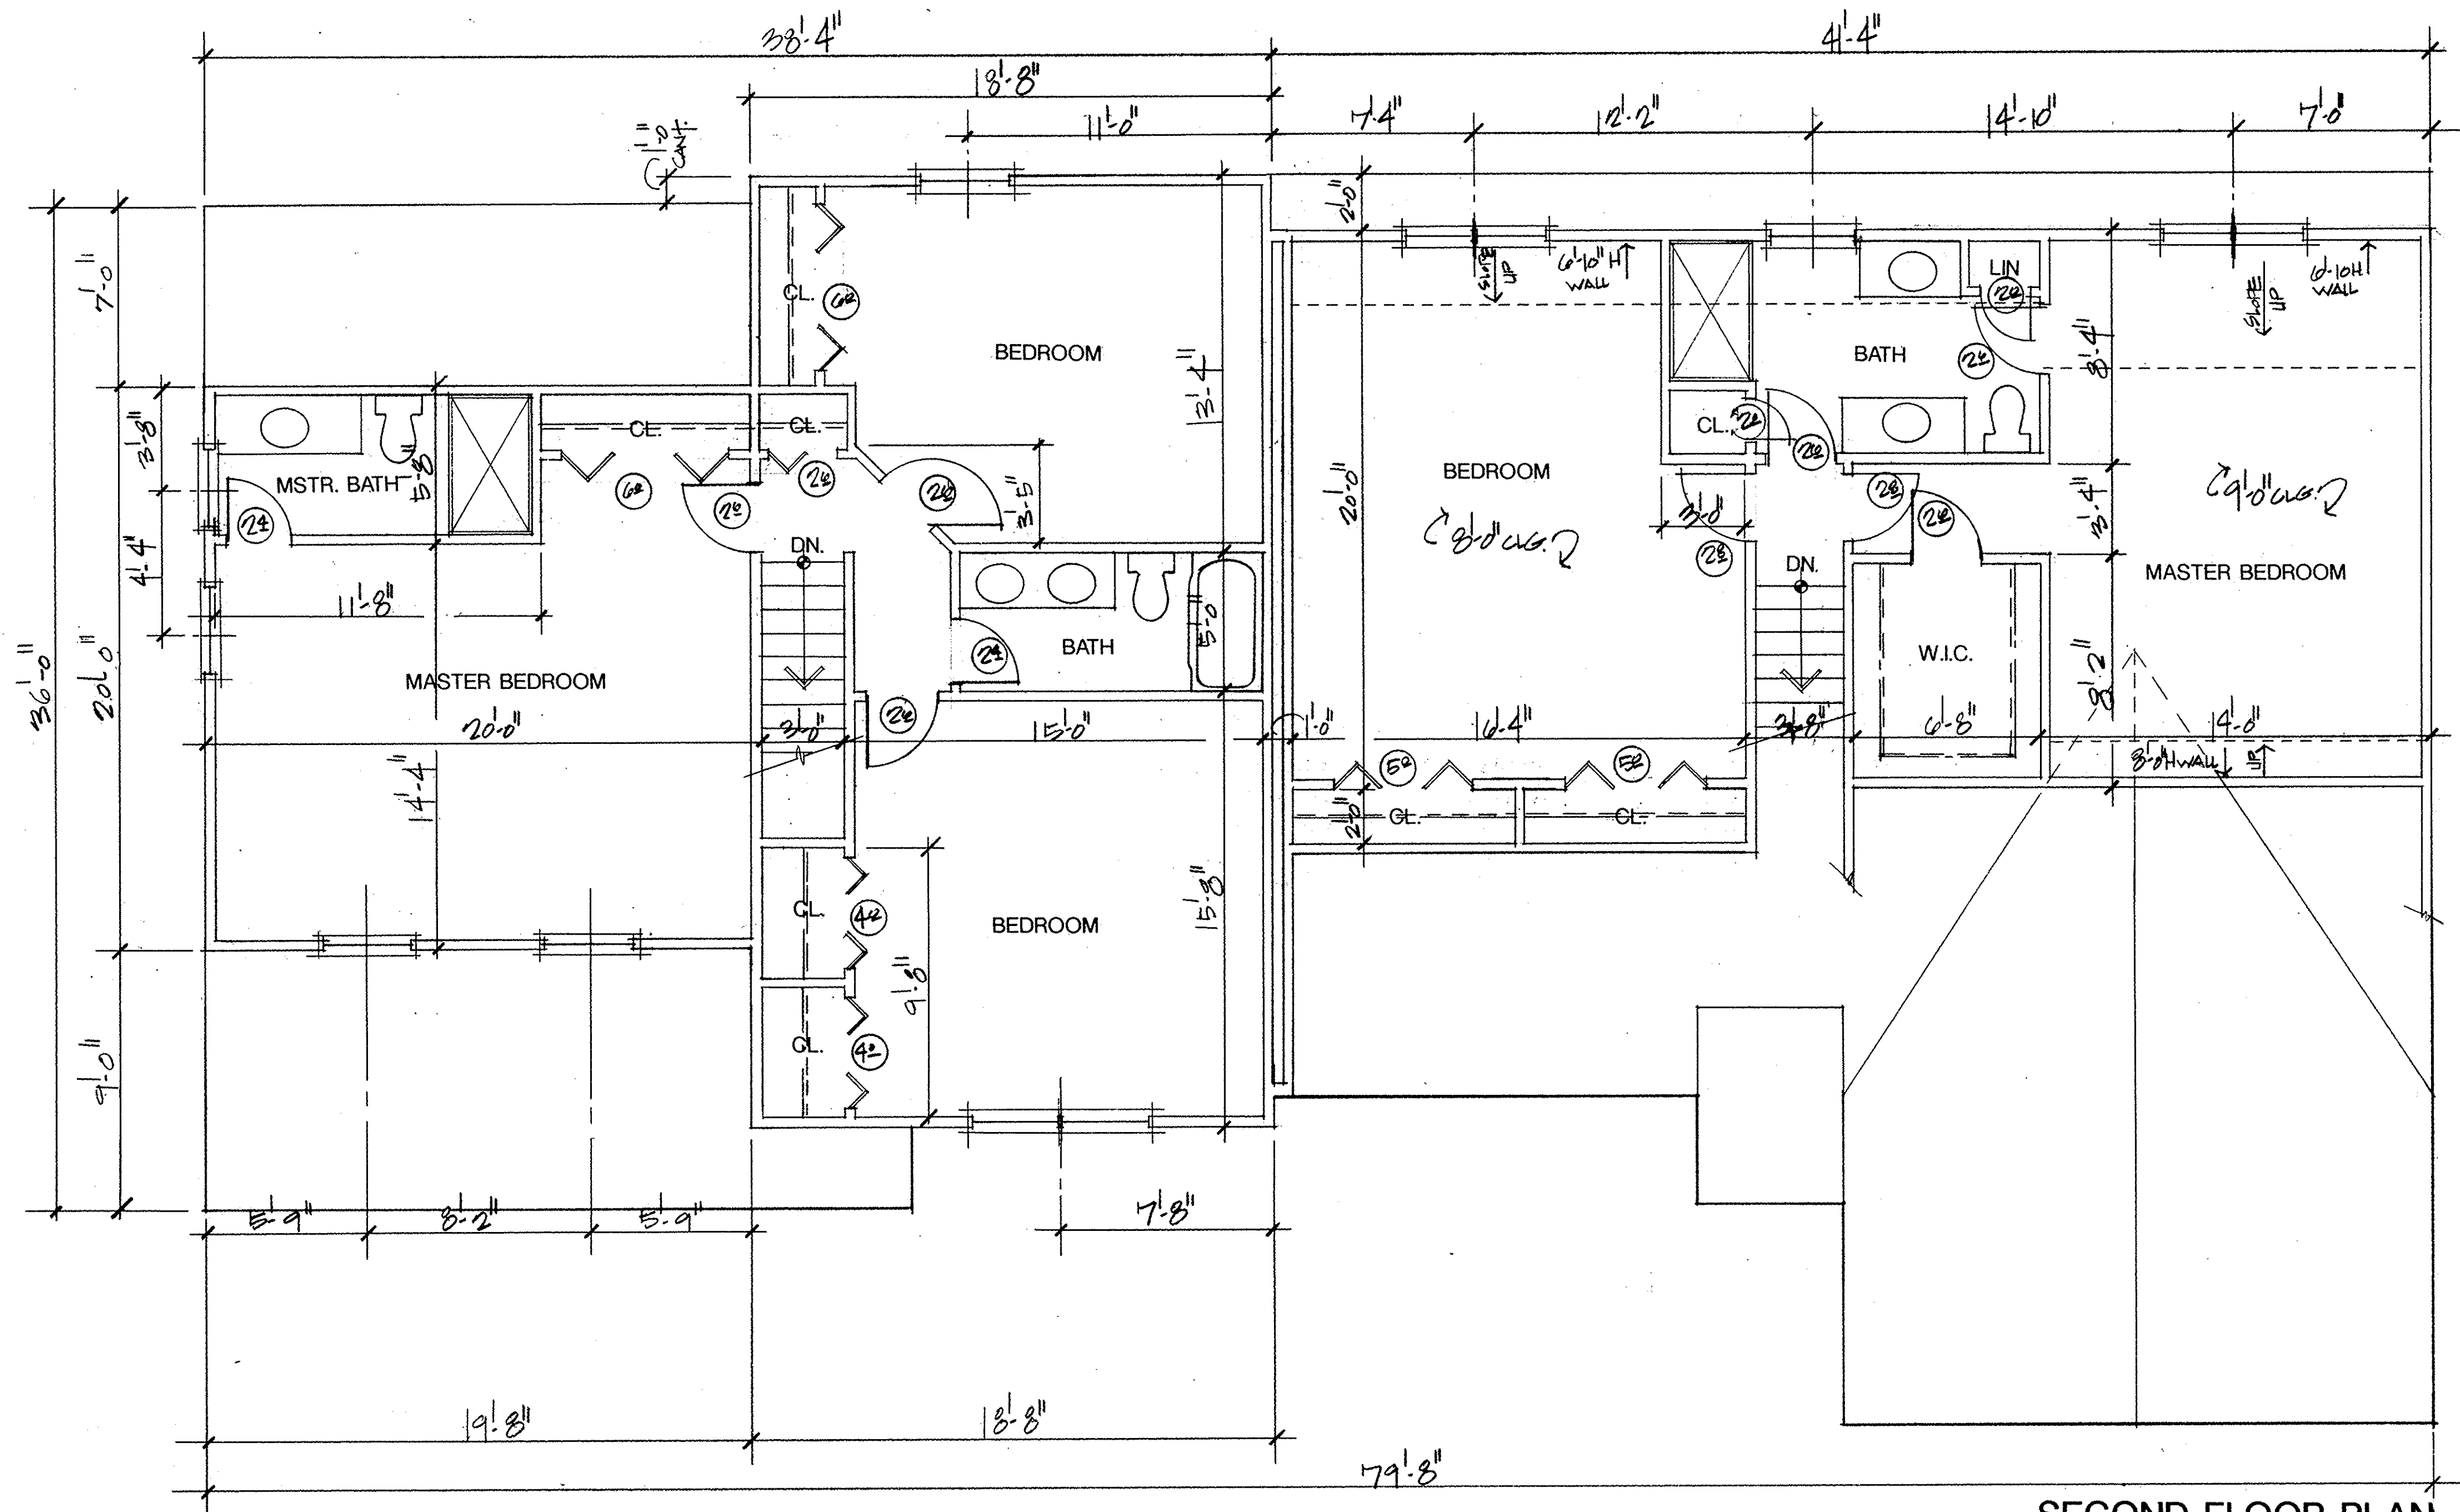

**SECOND FLOOR PLAN**  
 SCALE: 1/4" = 1'-0"  
 L- 1026 S.F. R- 847 S.F.



I CERTIFY THAT WITH THE EXCEPTION OF MINOR ARCHITECTURAL MODIFICATIONS MADE DURING CONSTRUCTION, THE DRAWINGS REPRESENT THE STRUCTURES AS BUILT.

*Mark W. Ruby*  
 Mark W. Ruby, Architect #9199


2/5/96  
 Date

REVISIONS	BY

**MARK W. RUBY**  
 ARCHITECT

514 N. LEAVITT ROAD, SUITE 2  
 ARLINGTON, OHIO 43001  
 (615) 998-2201

**BUILDING #6**  
**THE WOODLANDS OF**  
**VERMILION CONDOMINIUMS**  
 3975/3977 WOODLAND DR. VERMILION, OH.

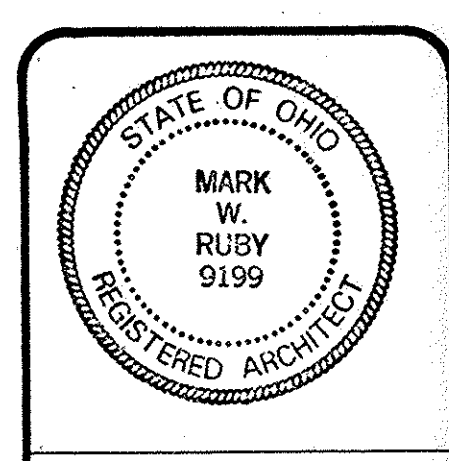

DATE 2/5/96  
 PROJ. 9601  
 SHEET

**2**



REVISIONS	BY


MARK W. RUBY  
ARCHITECT

514 N. LEAVITT ROAD SUITE 2  
AMHERST, OH 44001  
(216) 986-2001


BUILDING #6  
TITLE  
THE WOODLANDS OF  
VERMILION CONDOMINIUMS  
3975/3977 WOODLAND DR. VERMILION, OH.

STATE OF OHIO  
MARK W. RUBY  
REGISTERED ARCHITECT  
9199


DATE 2/5/96  
PROJ. 9601  
SHEET  
3  
56/51

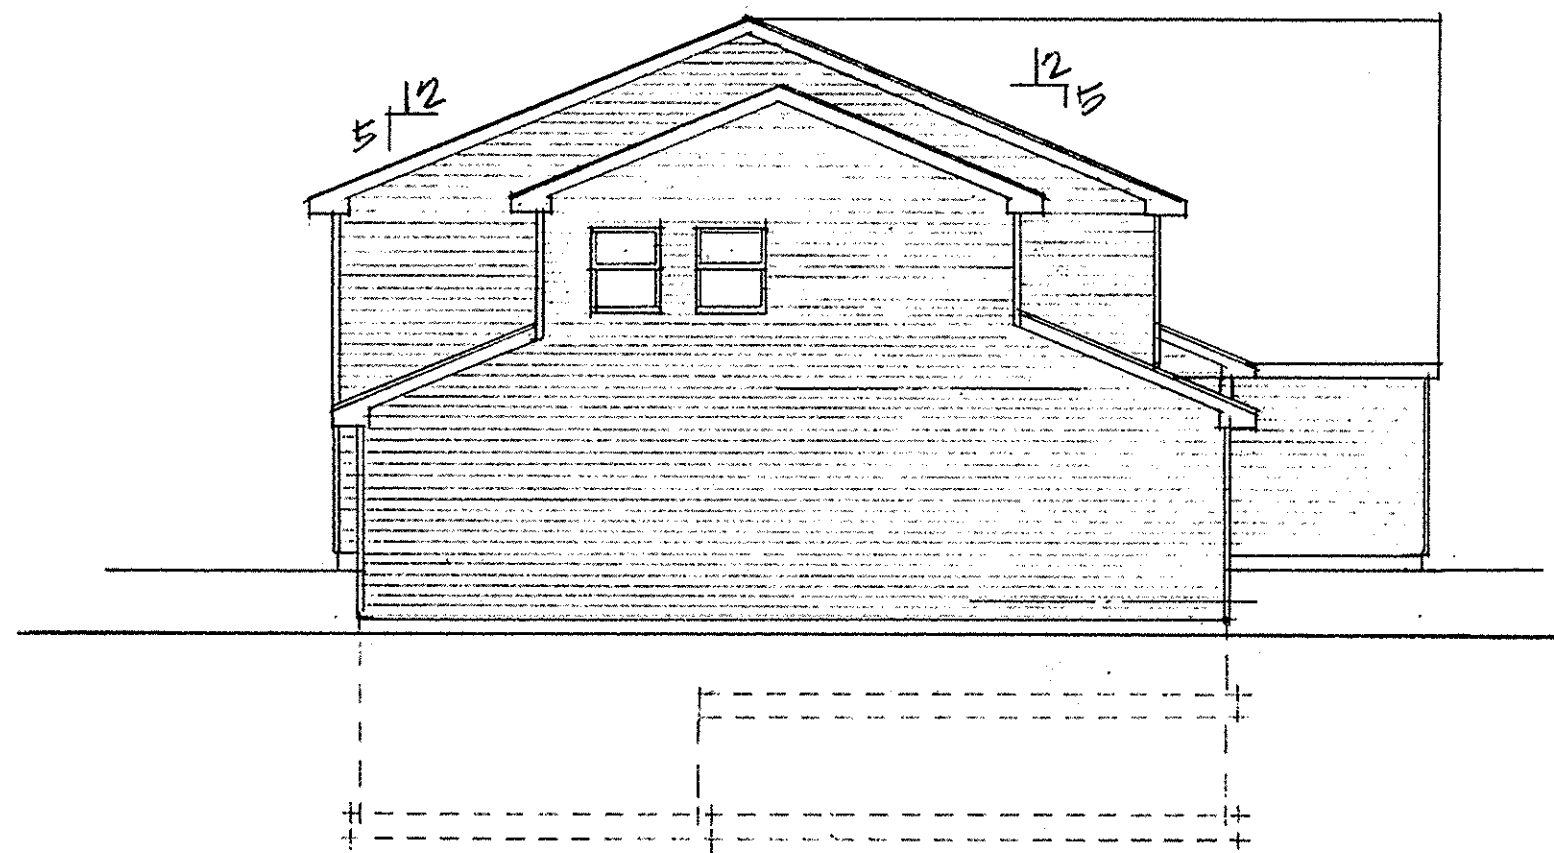

**NORTH ELEVATION**  
SCALE: 1/8"=1'-0"

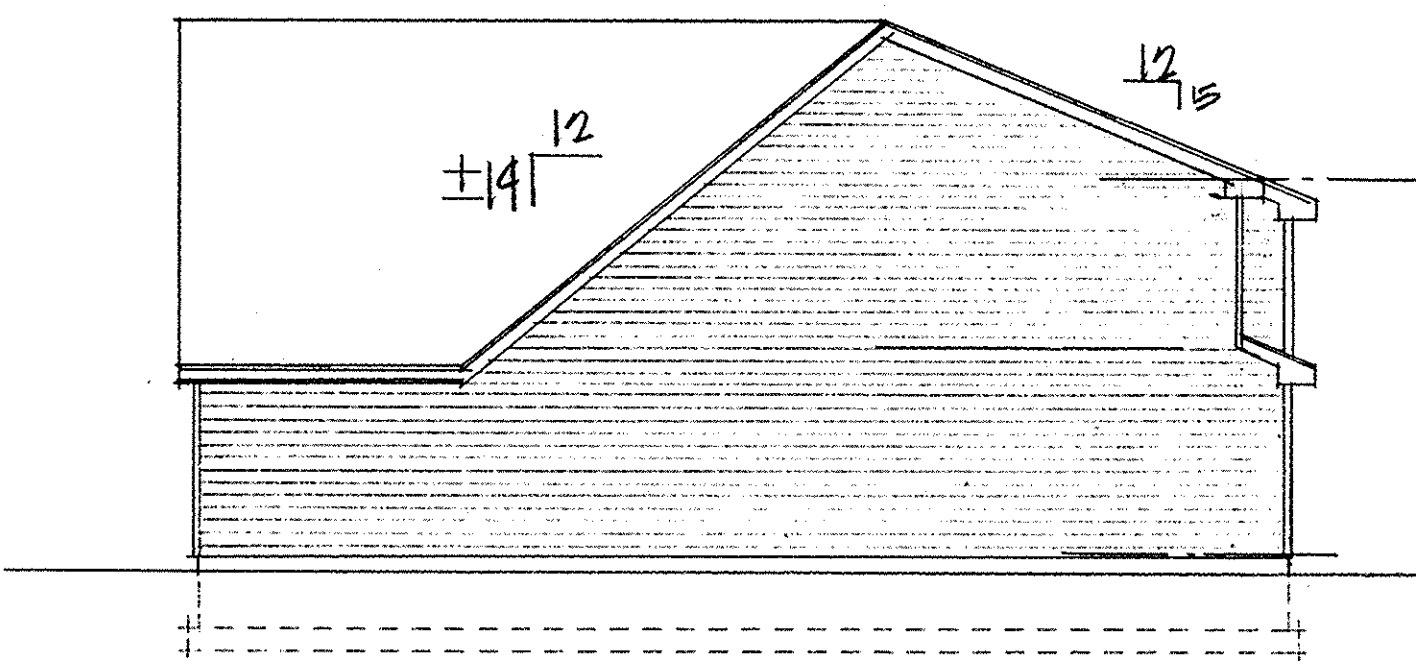

**SOUTH ELEVATION**  
SCALE: 1/8"=1'-0"

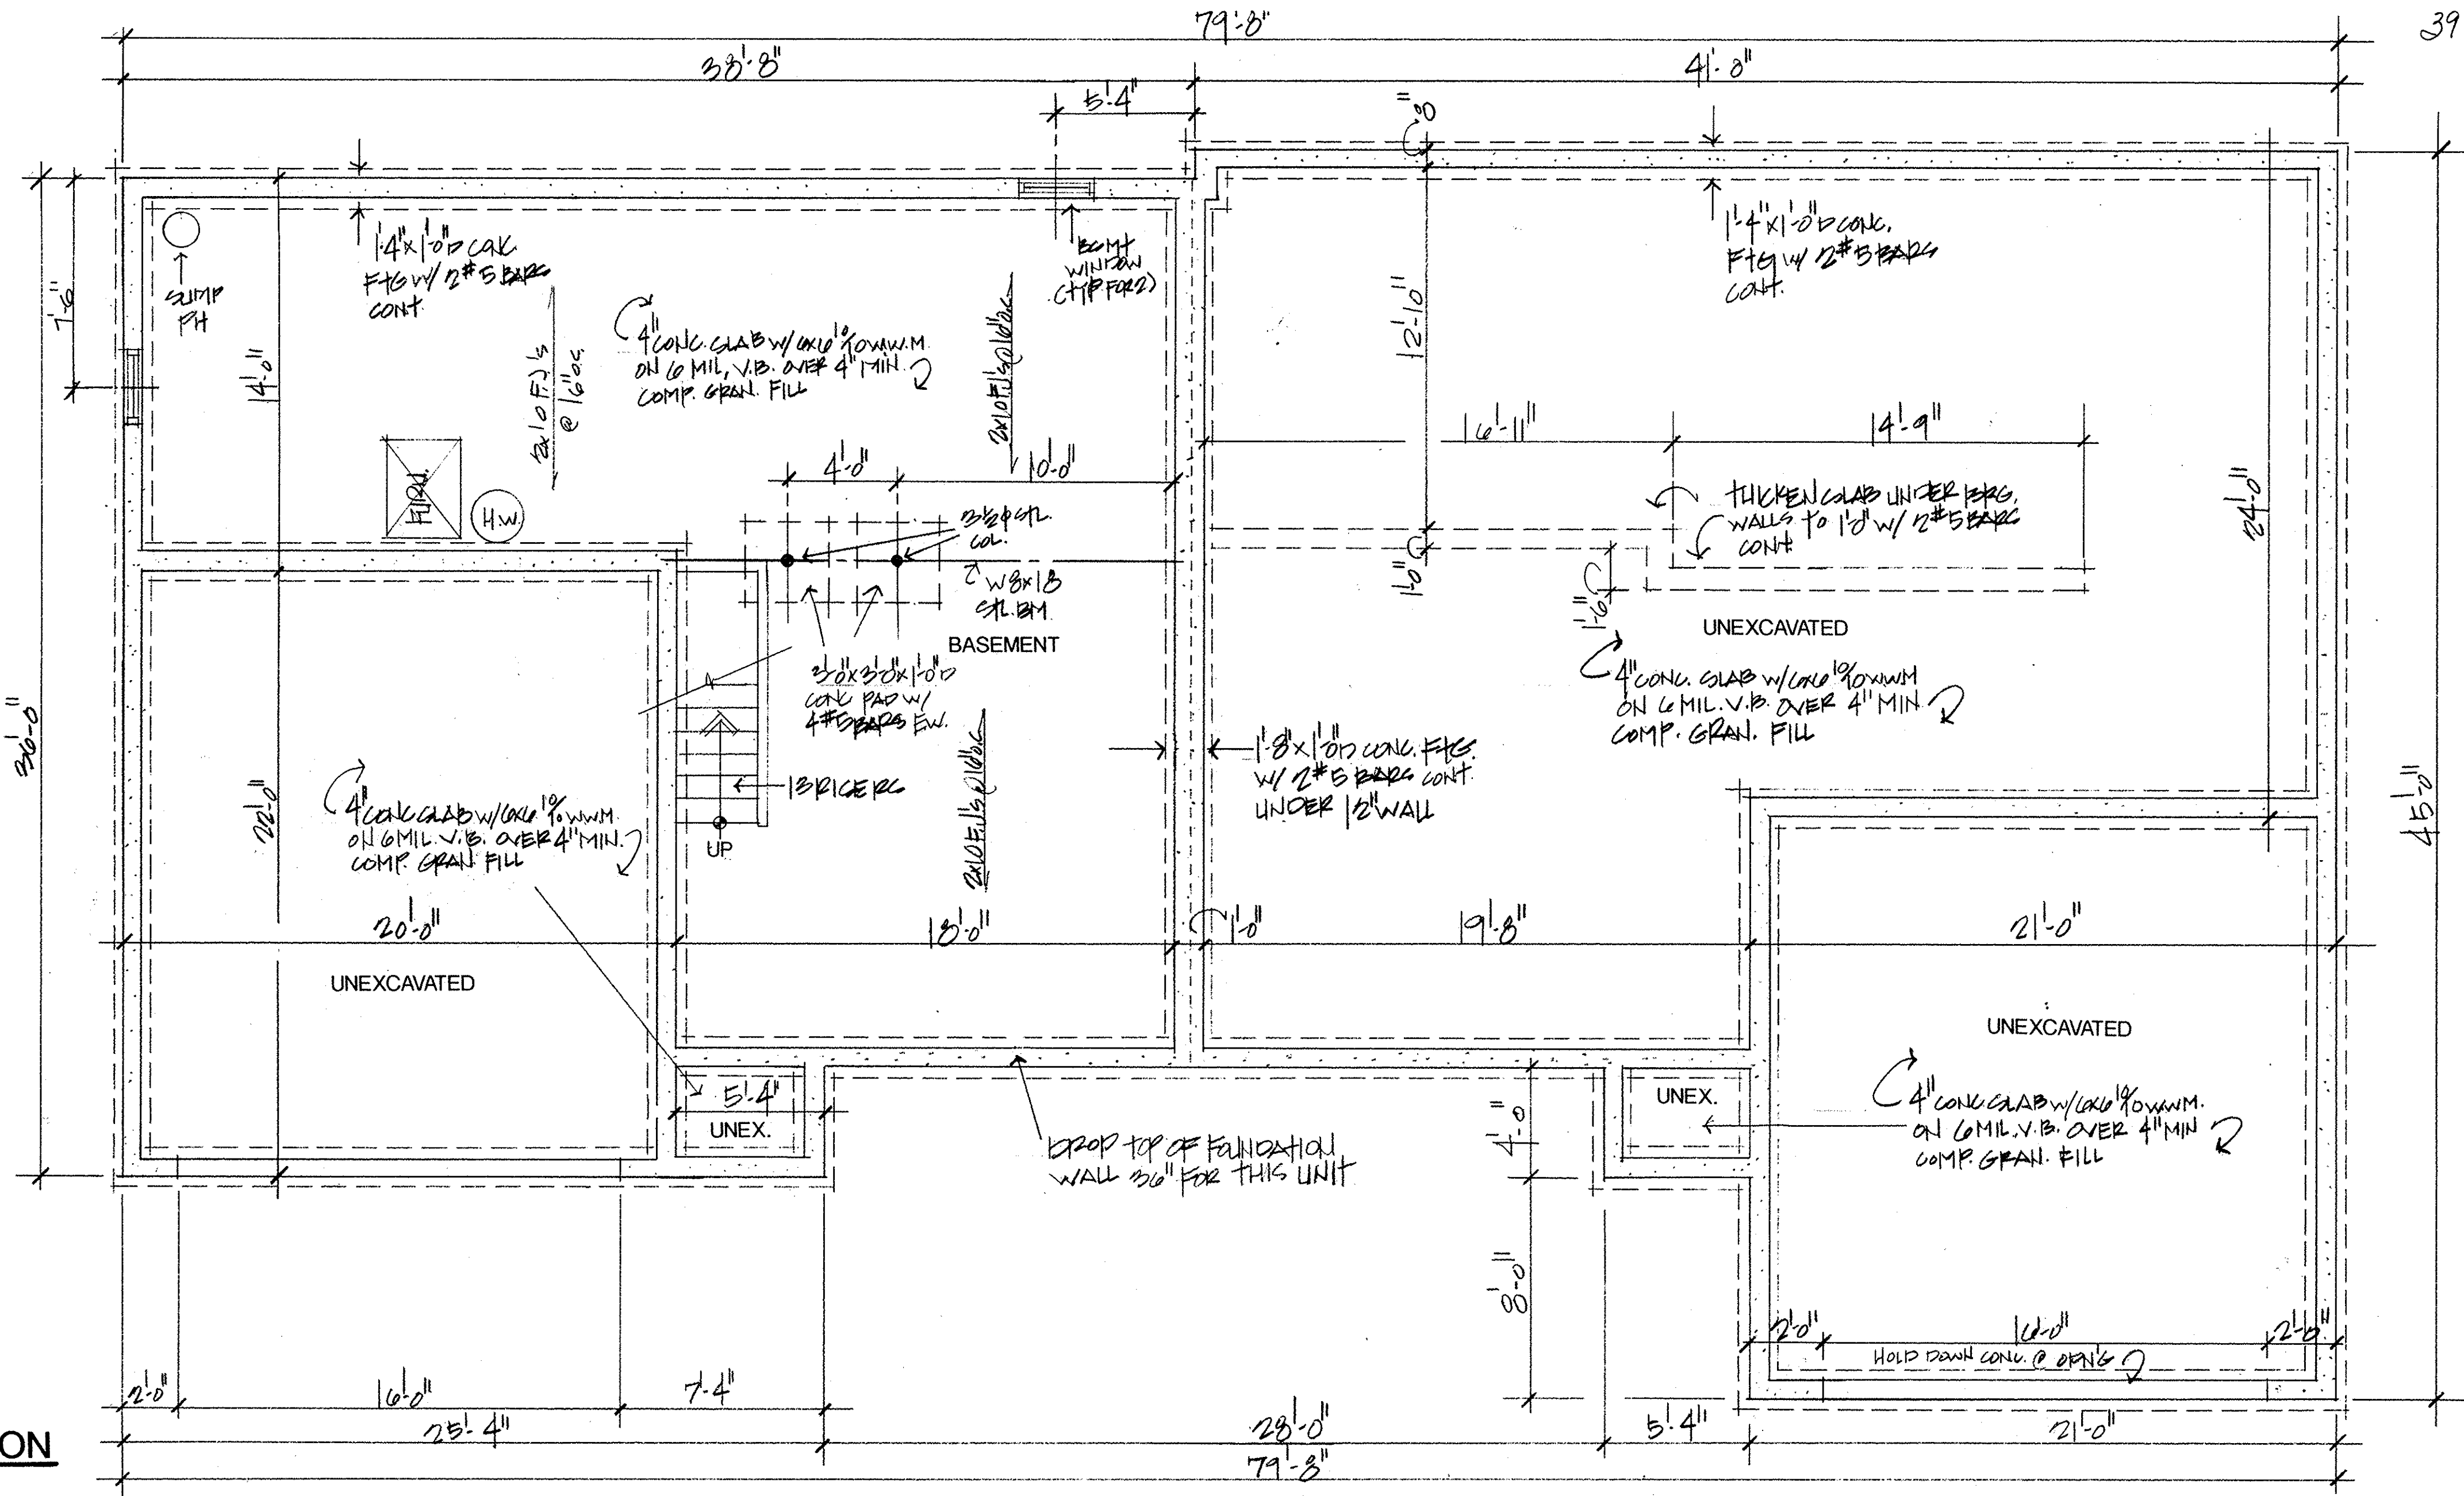

**FOUNDATION PLAN**  
SCALE: 1/4"=1'-0"




**EAST ELEVATION**  
SCALE: 1/4"=1'-0"

I CERTIFY THAT WITH THE EXCEPTION OF MINOR ARCHITECTURAL MODIFICATIONS MADE DURING CONSTRUCTION, THE DRAWINGS REPRESENT THE STRUCTURES AS BUILT.


*Mark W. Ruby*  
Mark W. Ruby, Architect #9199

2/5/96  
Date

**LORAIN COUNTY TAX  
MAP DEPARTMENT COPY**

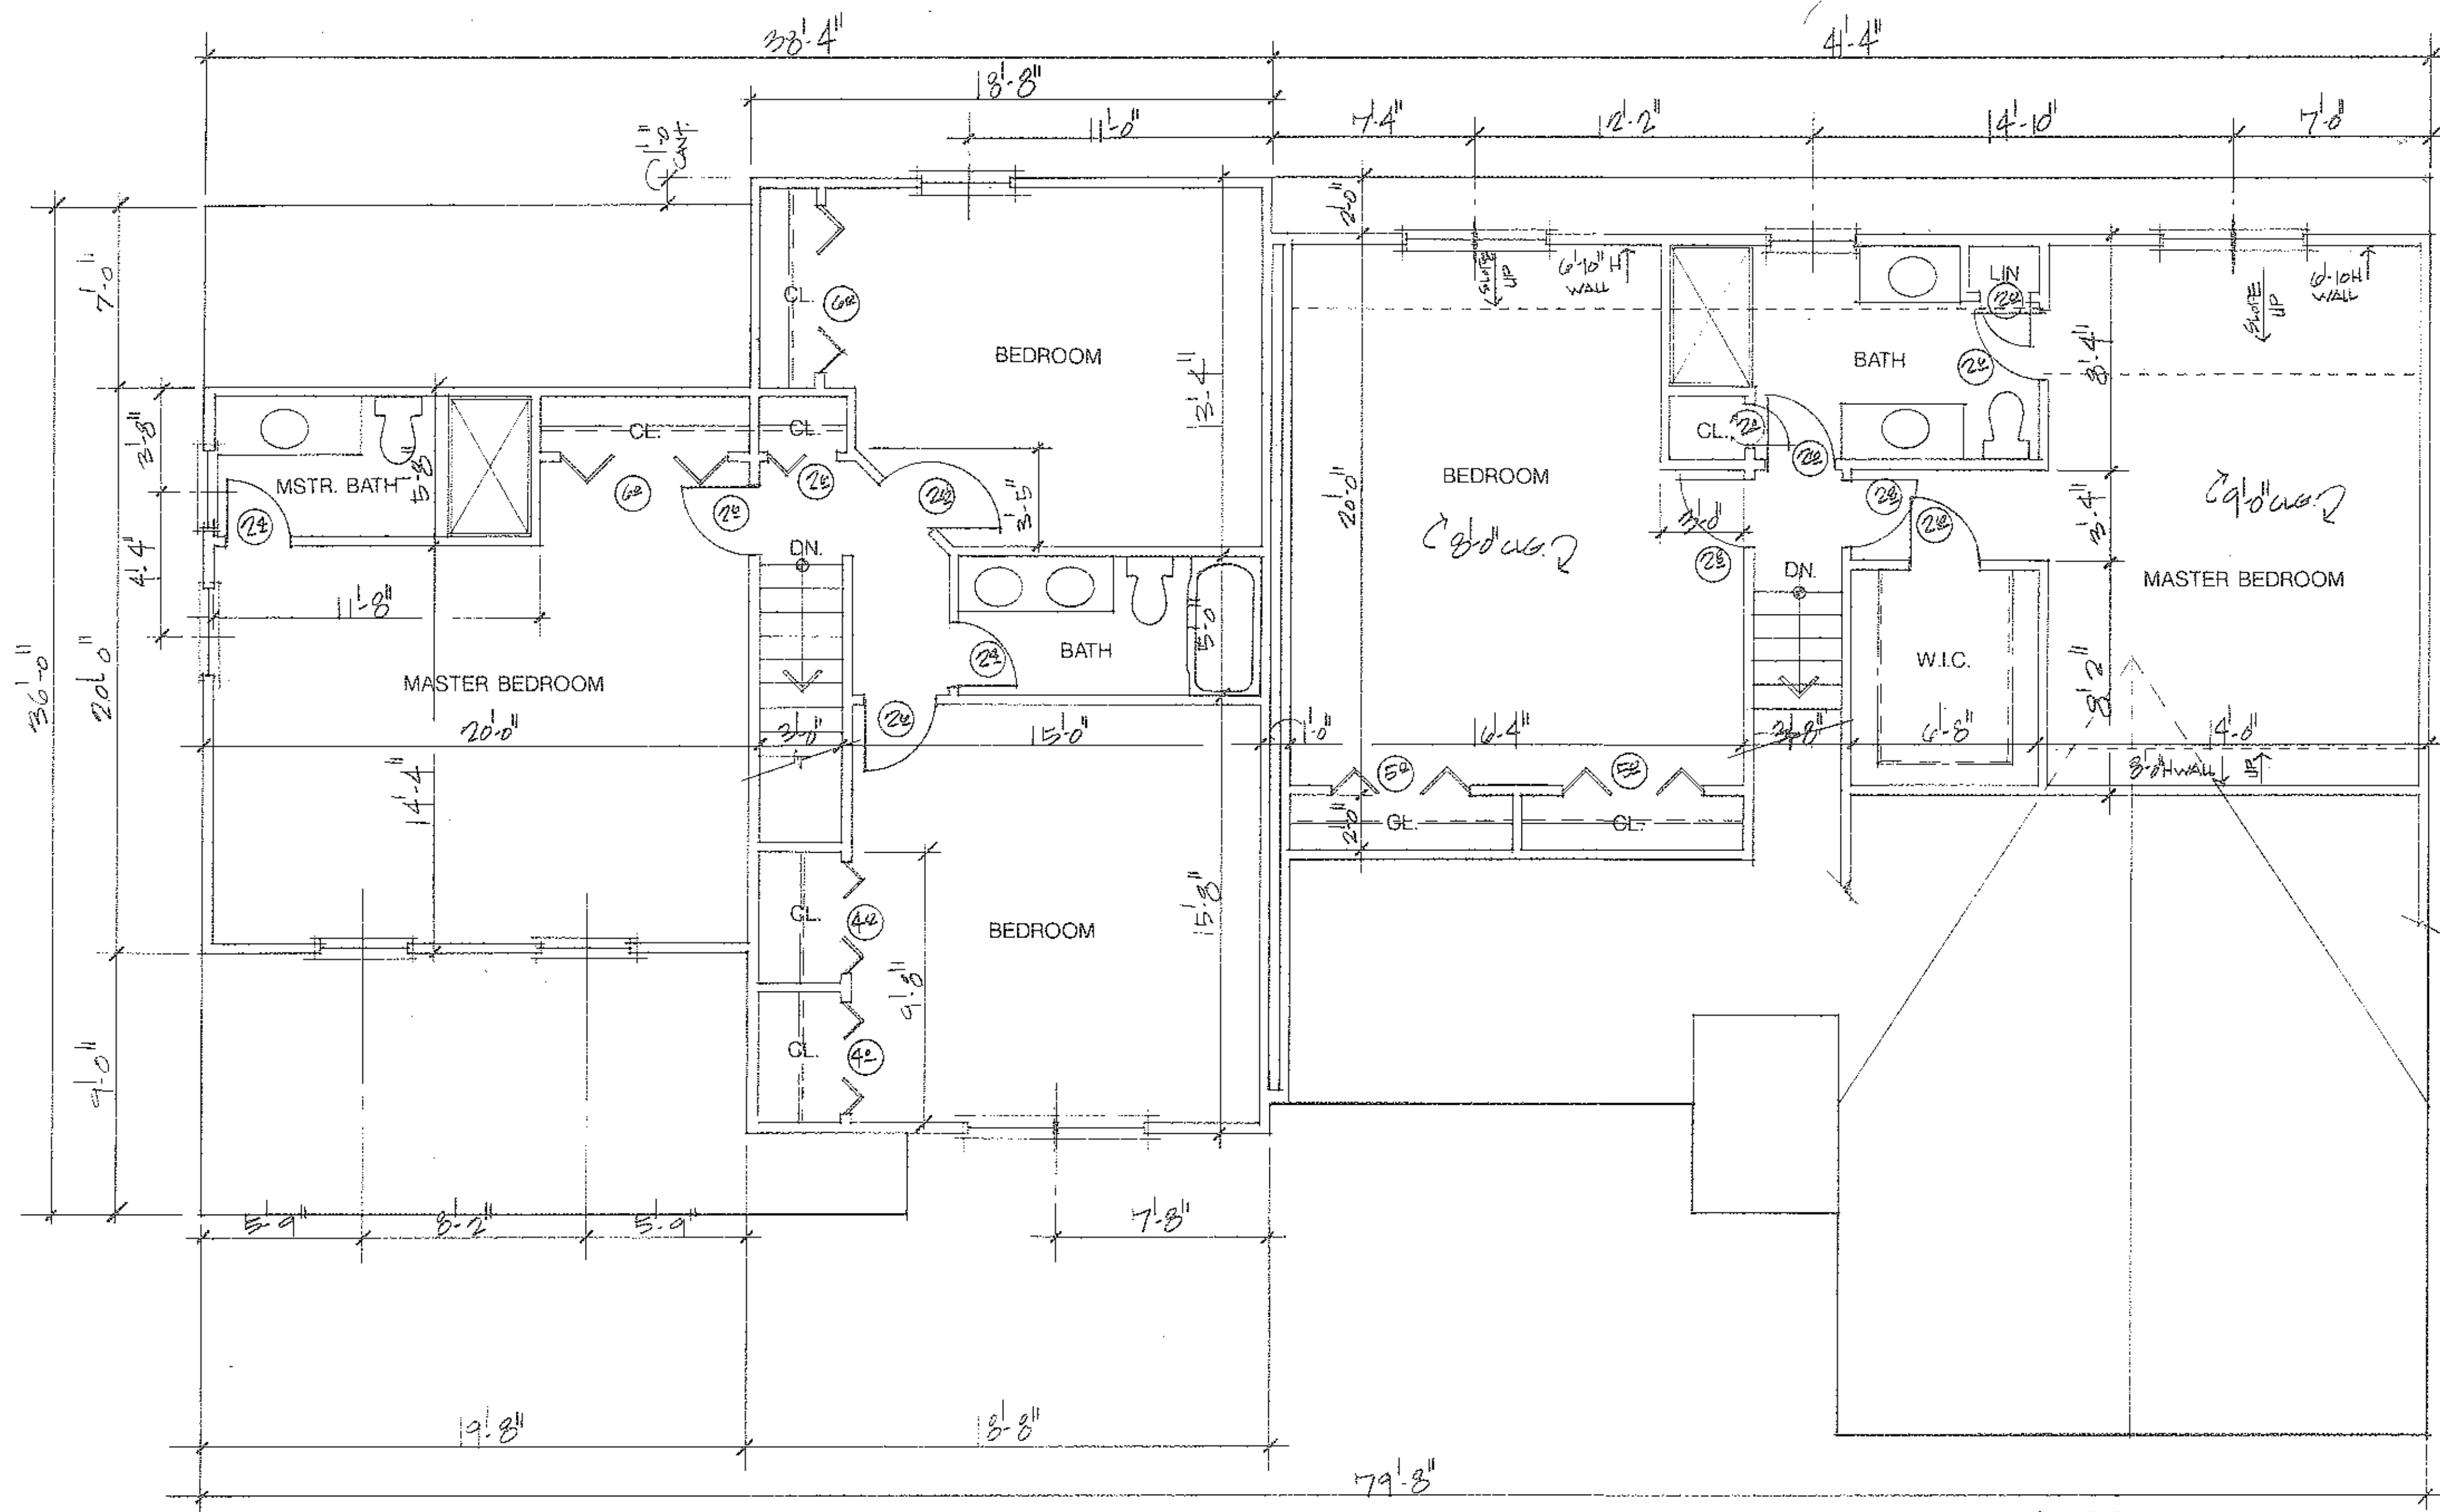

**SECOND FLOOR PLAN**  
 SCALE: 1/4" = 1'-0"  
 L. 1028 S.F. R. 847 S.F.

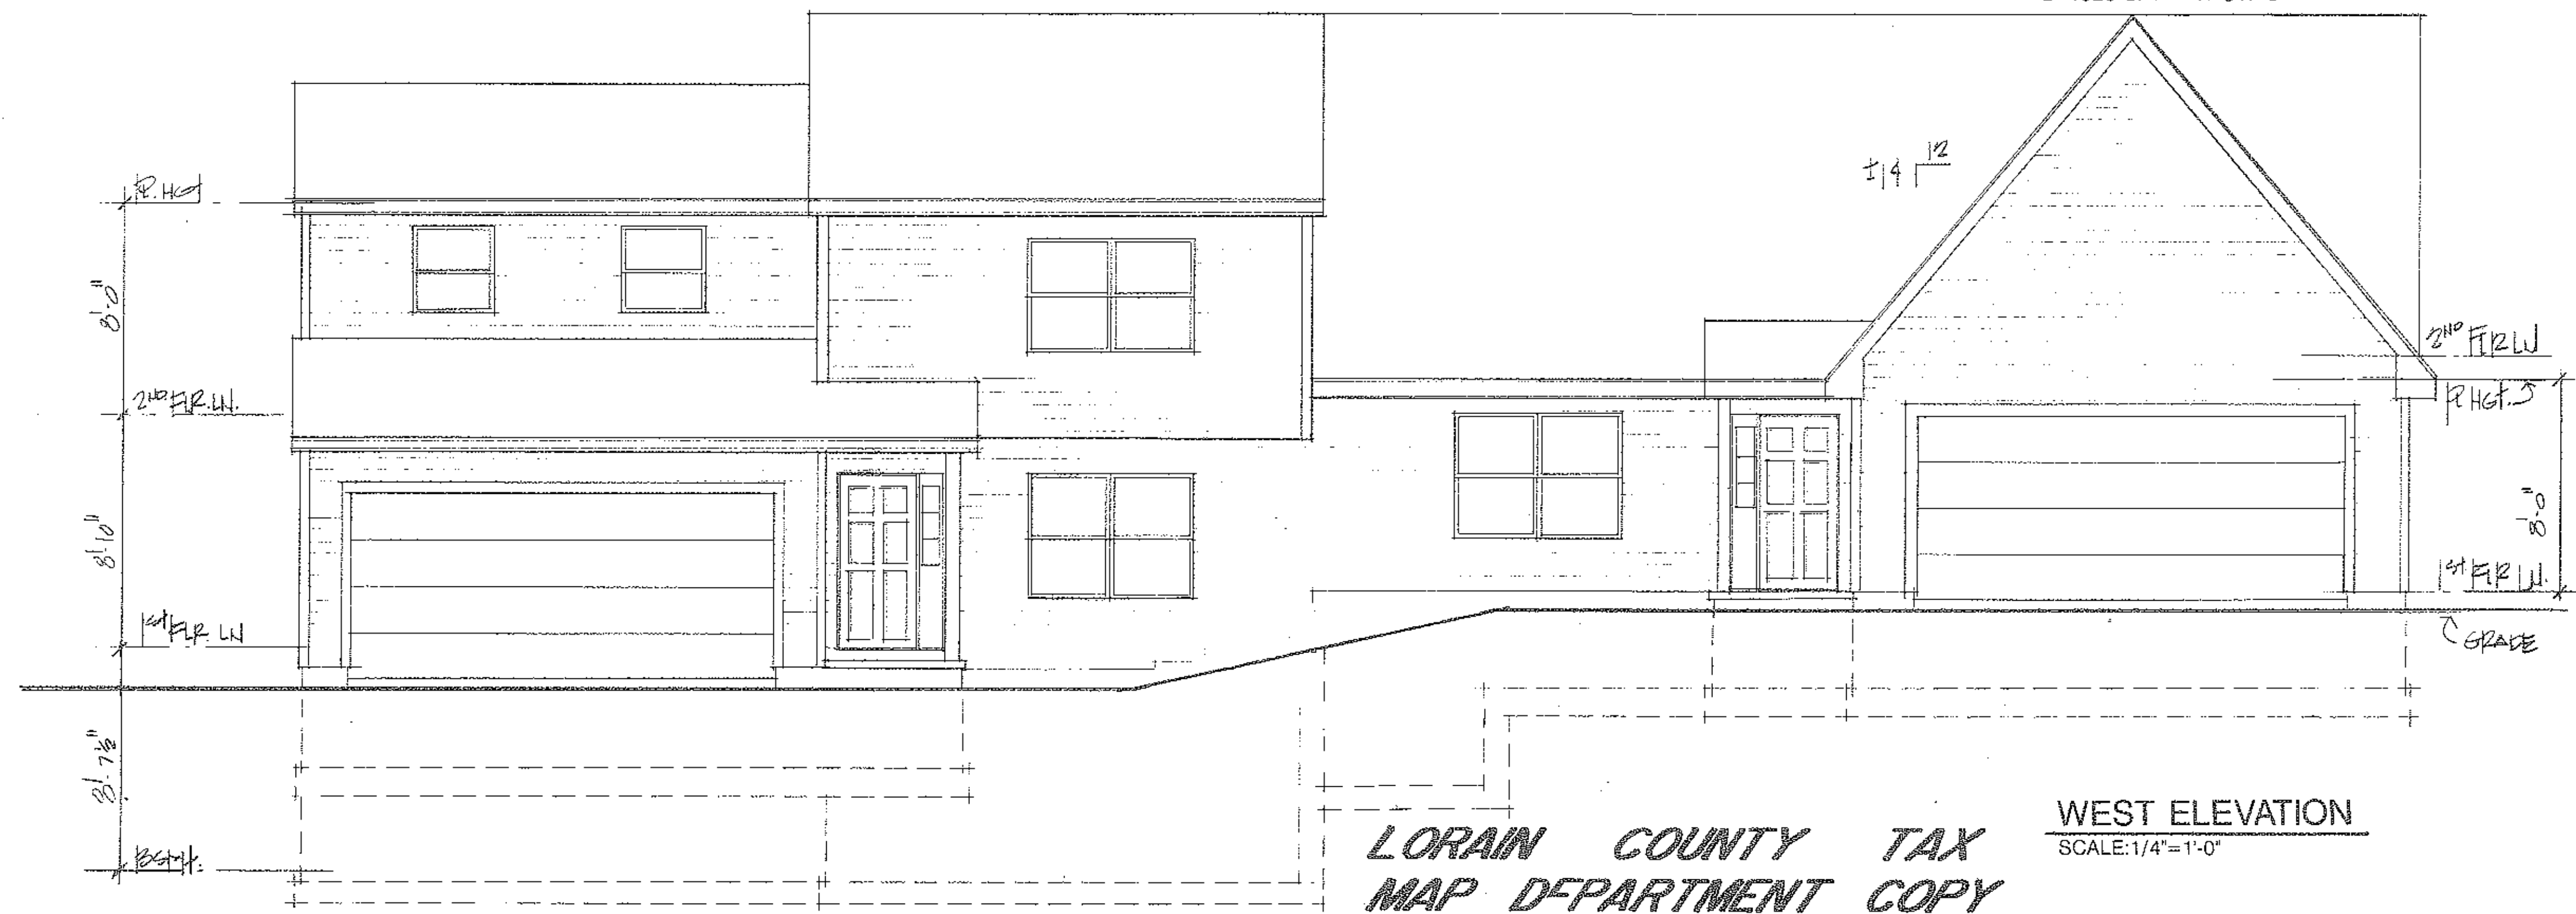

**LORAIN COUNTY TAX  
 MAP DEPARTMENT COPY**

**WEST ELEVATION**  
 SCALE: 1/4" = 1'-0"

I CERTIFY THAT WITH THE EXCEPTION OF MINOR ARCHITECTURAL MODIFICATIONS MADE DURING CONSTRUCTION, THE DRAWINGS REPRESENT THE STRUCTURES AS BUILT.

*Mark W. Ruby*  
 Mark W. Ruby, Architect #9199


2/5/96  
 Date

REVISIONS	BY

**MARK W. RUBY  
 ARCHITECT**

214 N. LEAHY ROAD SUITE B  
 VERMILION, OH 44089  
 (419) 937-2000

**BUILDING #6  
 THE WOODLANDS OF  
 VERMILION CONDOMINIUMS  
 3975/3977 WOODLAND DR. VERMILION, OH.**

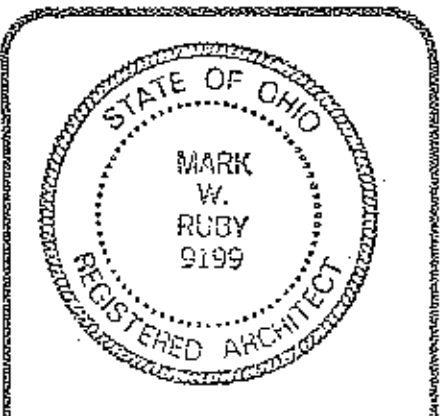

DATE 2/5/96  
 PROJ. 9601  
 SHEET