




528249

528249

FOUNDATION PLAN

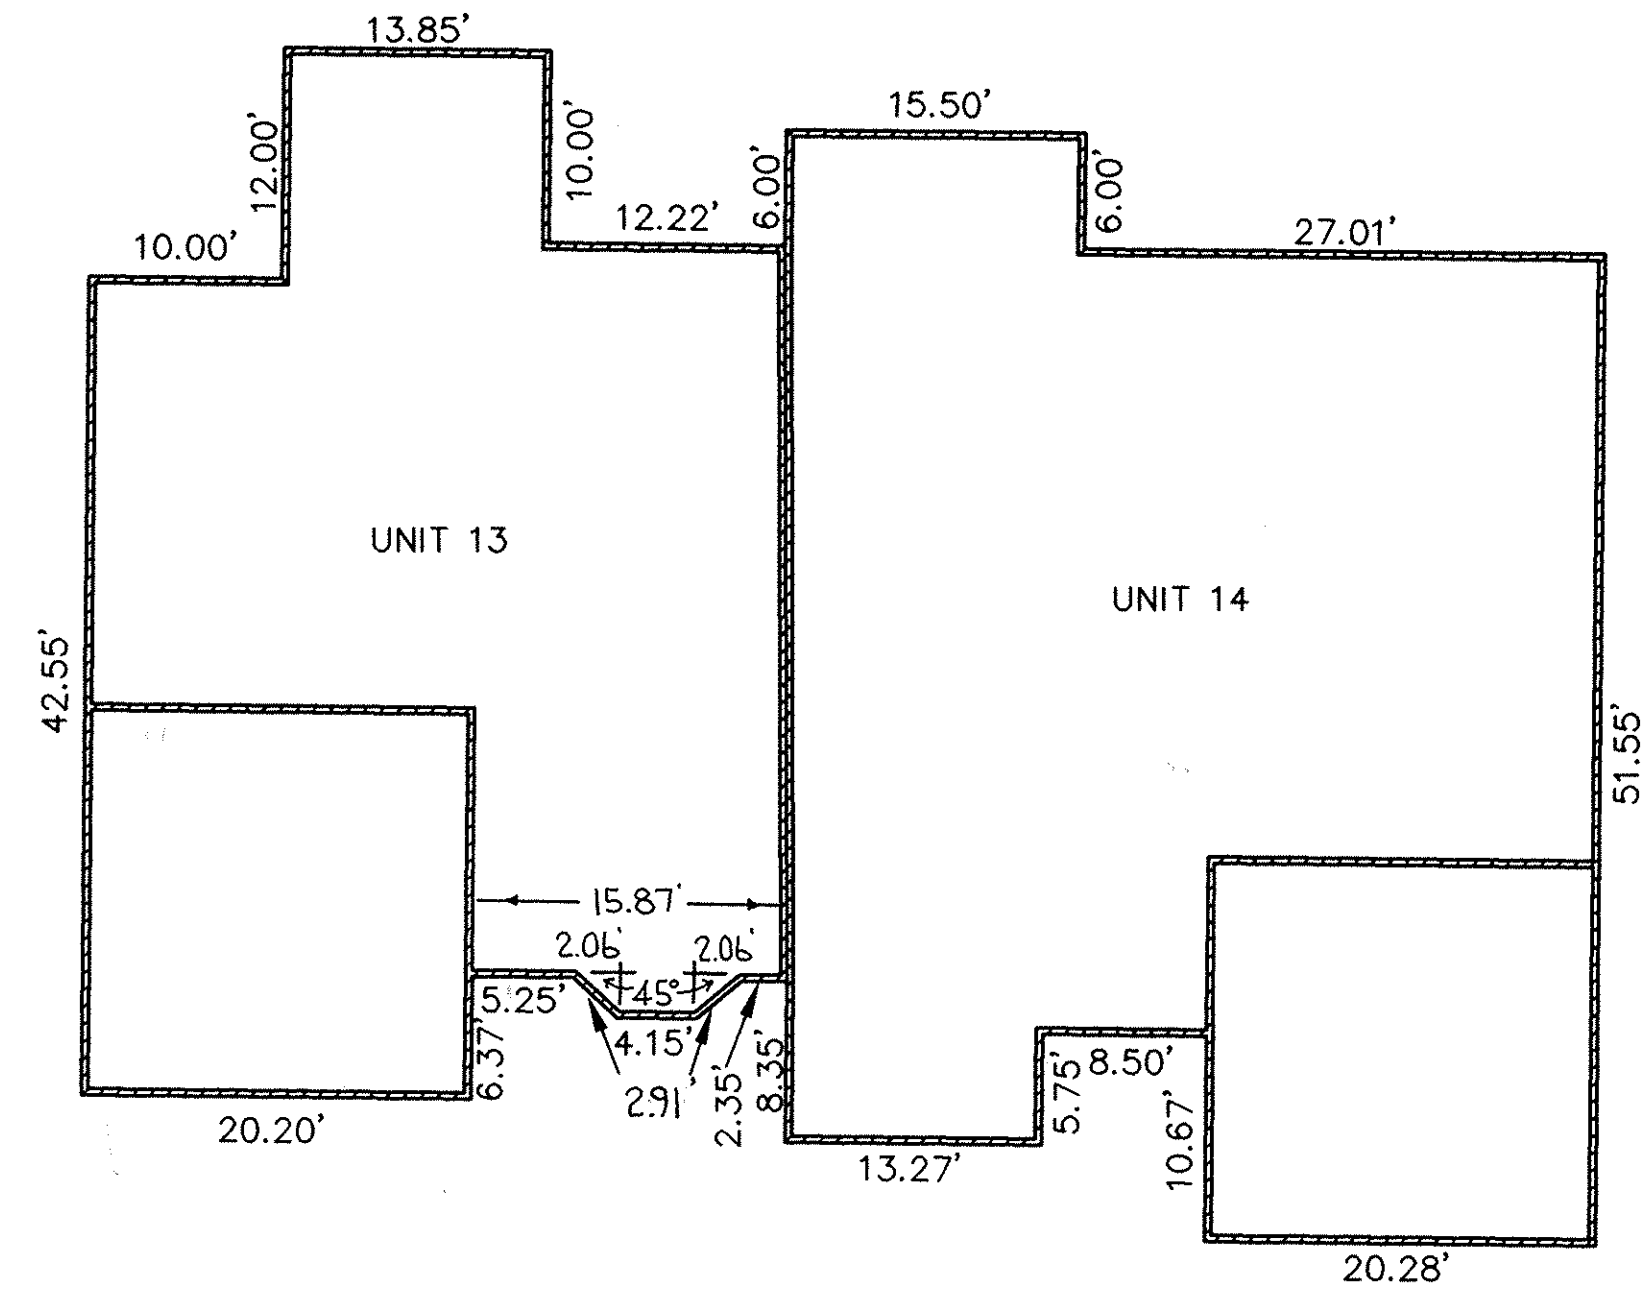

FLOOR PLAN

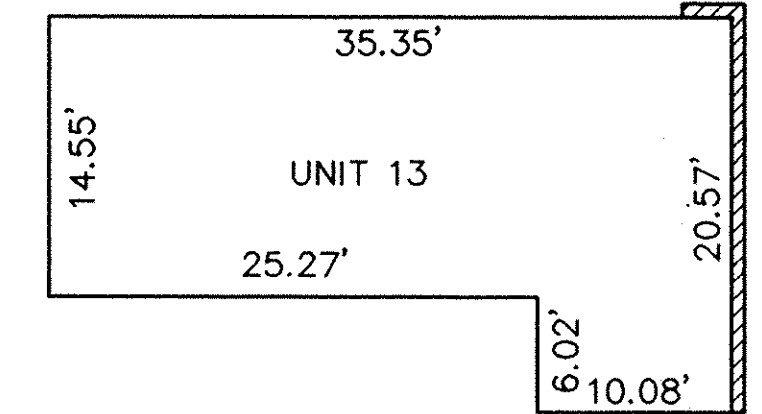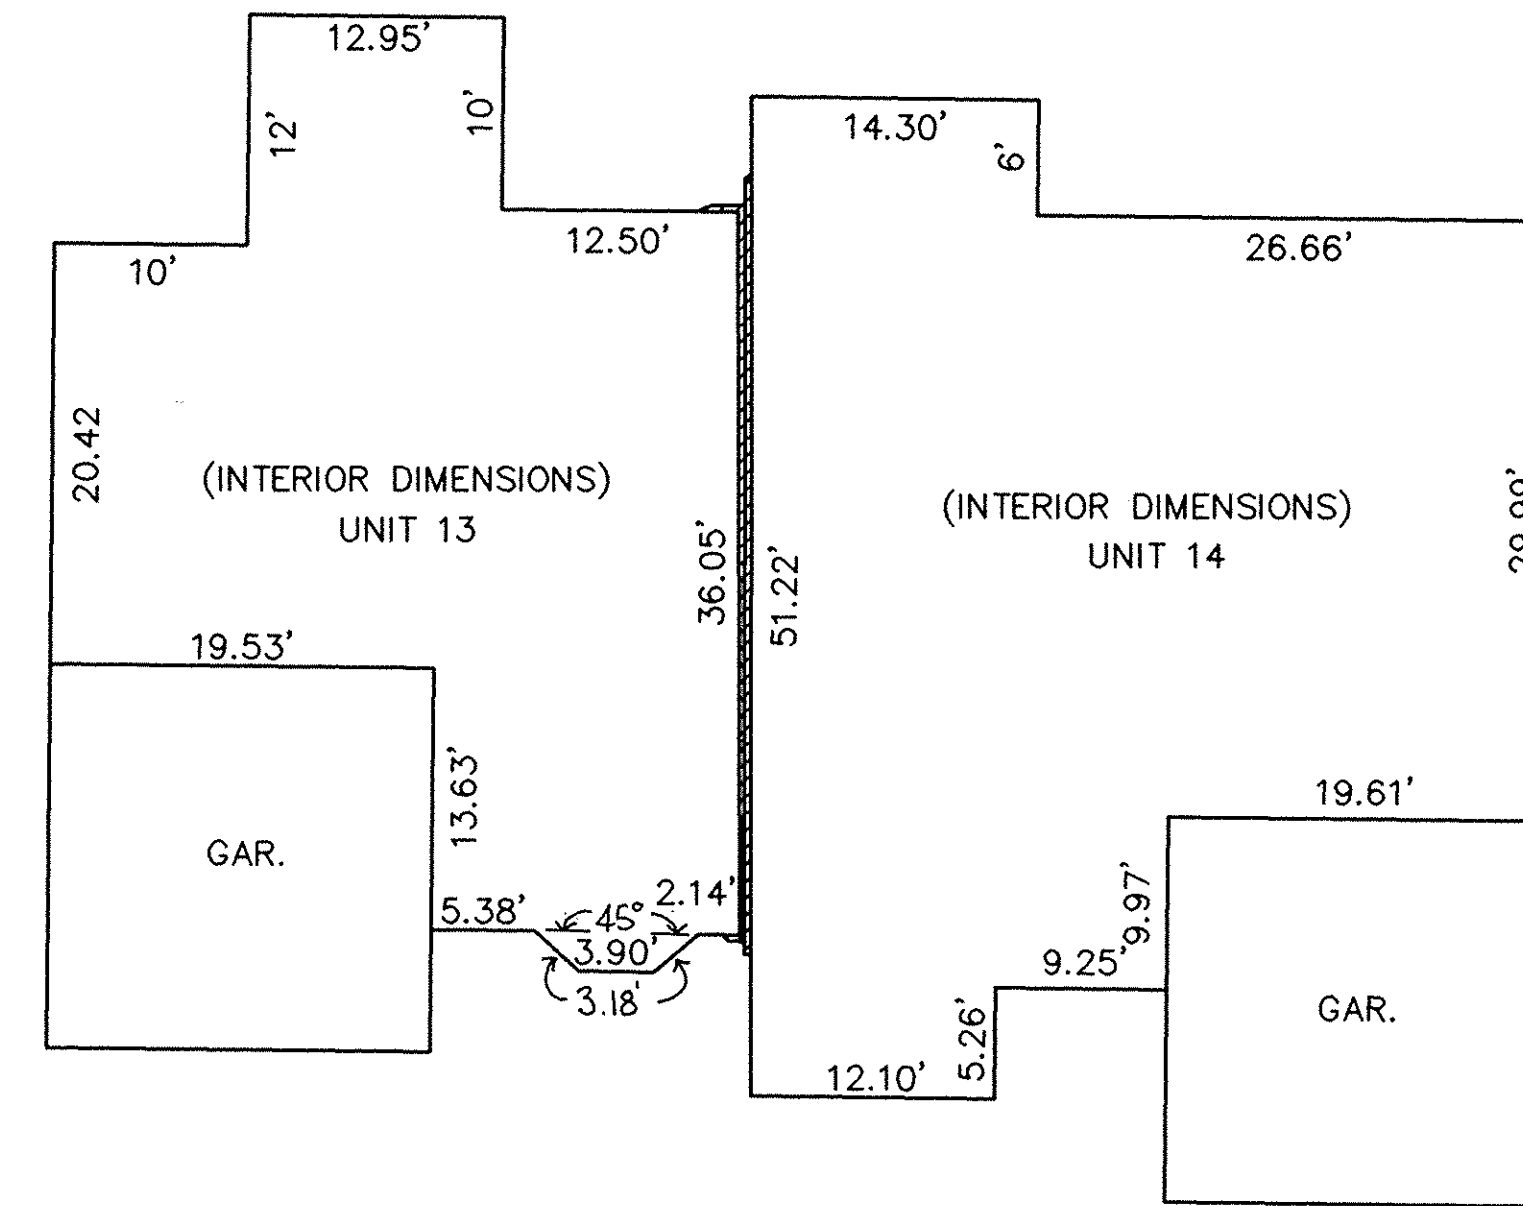

SECOND FLOOR (INTERIOR DIMENSIONS)

UNIT 14 (NO SECOND FLOOR)

SCALE: 1" = 10'

REVISIONS	DATE	BY	DESCRIPTION

**FOUNDATION PLAN & FLOOR PLAN
WINDGATE CONDOMINIUMS PHASE 2**

KS ASSOCIATES, INC.
 ENGINEERS/SURVEYORS
 424 Middle Avenue
 P.O. Box 89
 Elyria, Ohio 44036
 PHONE (216) 322-6317 * FAX (216) 284-0623



SHEET 2 OF 2
 JOB NO. 96098-CP2