



**CURVE TABLE**

CURVE	RADIUS	DELTA	LENGTH	CHORD	BEARING
C-1	28.00'	49°44'34"	24.31'	23.55'	S 66°06'42" W
C-2	28.00'	40°13'43"	19.66'	19.26'	S 21°07'34" W
C-3	28.00'	89°58'17"	43.97'	39.59'	S 45°59'50" W

**CERTIFICATION**  
THIS IS TO CERTIFY THAT THE ATTACHED DRAWINGS CORRECTLY REPRESENT THE BUILDINGS AS CONSTRUCTED AND THAT THERE ARE NO ENCROACHMENTS ON ADJUTING PROPERTIES.

*David L. Elwell*  
DAVID L. ELWELL  
REG. SURVEYOR NO. 6333

*Lynn S. Miggin*  
LYNN S. MIGGINS  
REG. ENGINEER NO. 46837

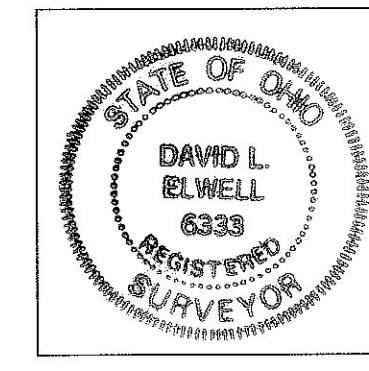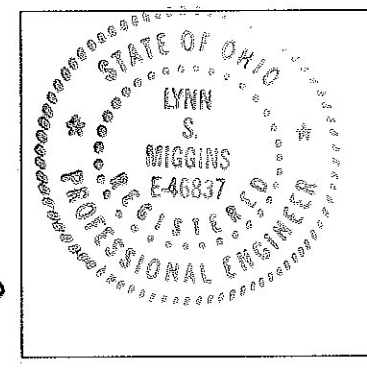

**TRANSFERRED**  
IN COMPLIANCE WITH SEC. 315.202  
OHIO REV. CODE  
MAR 13 1999

MARK R. STEWART  
LORAIN COUNTY AUDITOR  
RECEIVED FOR RECORD  
at 1:35 P.M. 1/21/99  
VOL. 62 MARY ANN JAMISON  
PAGE 177 Lorain County Recorder  
78.80  
DEC 48.00  
220.80

DATE	REVISIONS
1-8-99	
3-10-99	ADDED UNIT NUMBERS TO FOUNDATION PLAN
1-8-99	ORIGINAL ISSUE


**THE ENGLISH LAKES CONDOMINIUMS**  
**PHASE 20**  
PART OF AMHERST TOWNSHIP O.L.s 25 & 26  
CITY OF AMHERST \* COUNTY OF LORAIN \* STATE OF OHIO

**KS ASSOCIATES, INC.**  
ENGINEERS/SURVEYORS  
424 Middle Avenue  
P.O. Box 89  
Elyria, Ohio 44036  
PHONE: (440) 322-6317 \* FAX: (440) 284-0623


**KS ASSOCIATES INCORPORATED**

SHEET 1 OF 4  
JOB NO. 89224-CP20



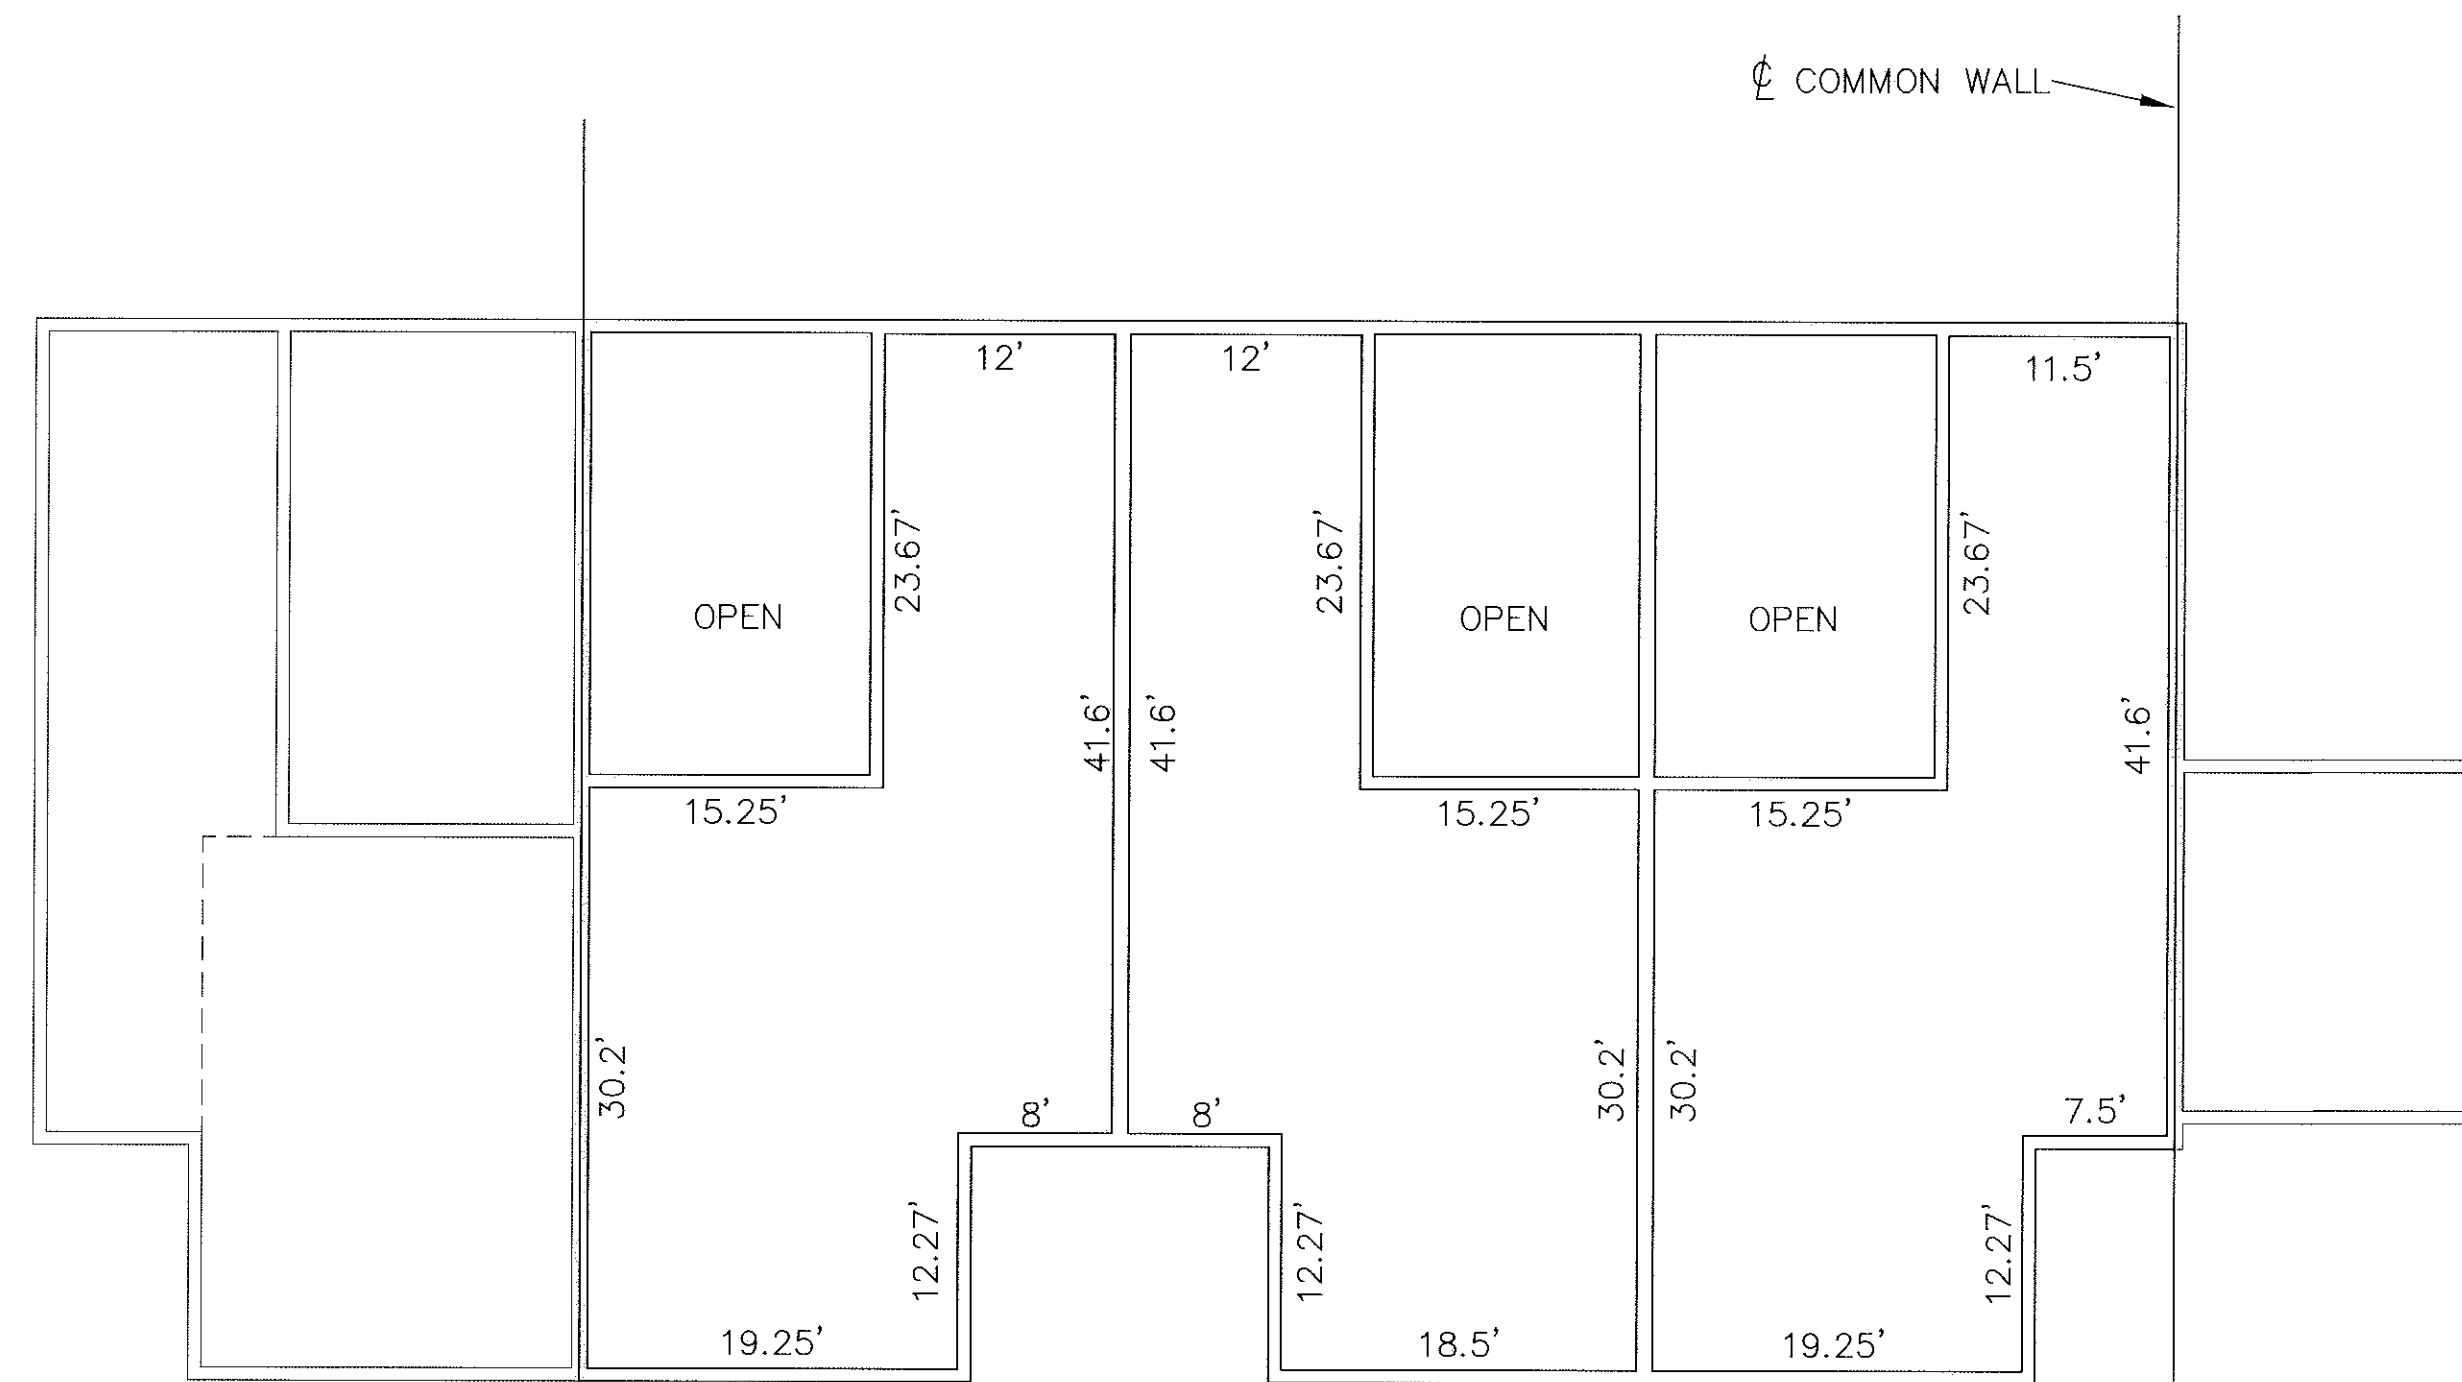

SECOND FLOOR PLAN  
SCALE: 1" = 10'

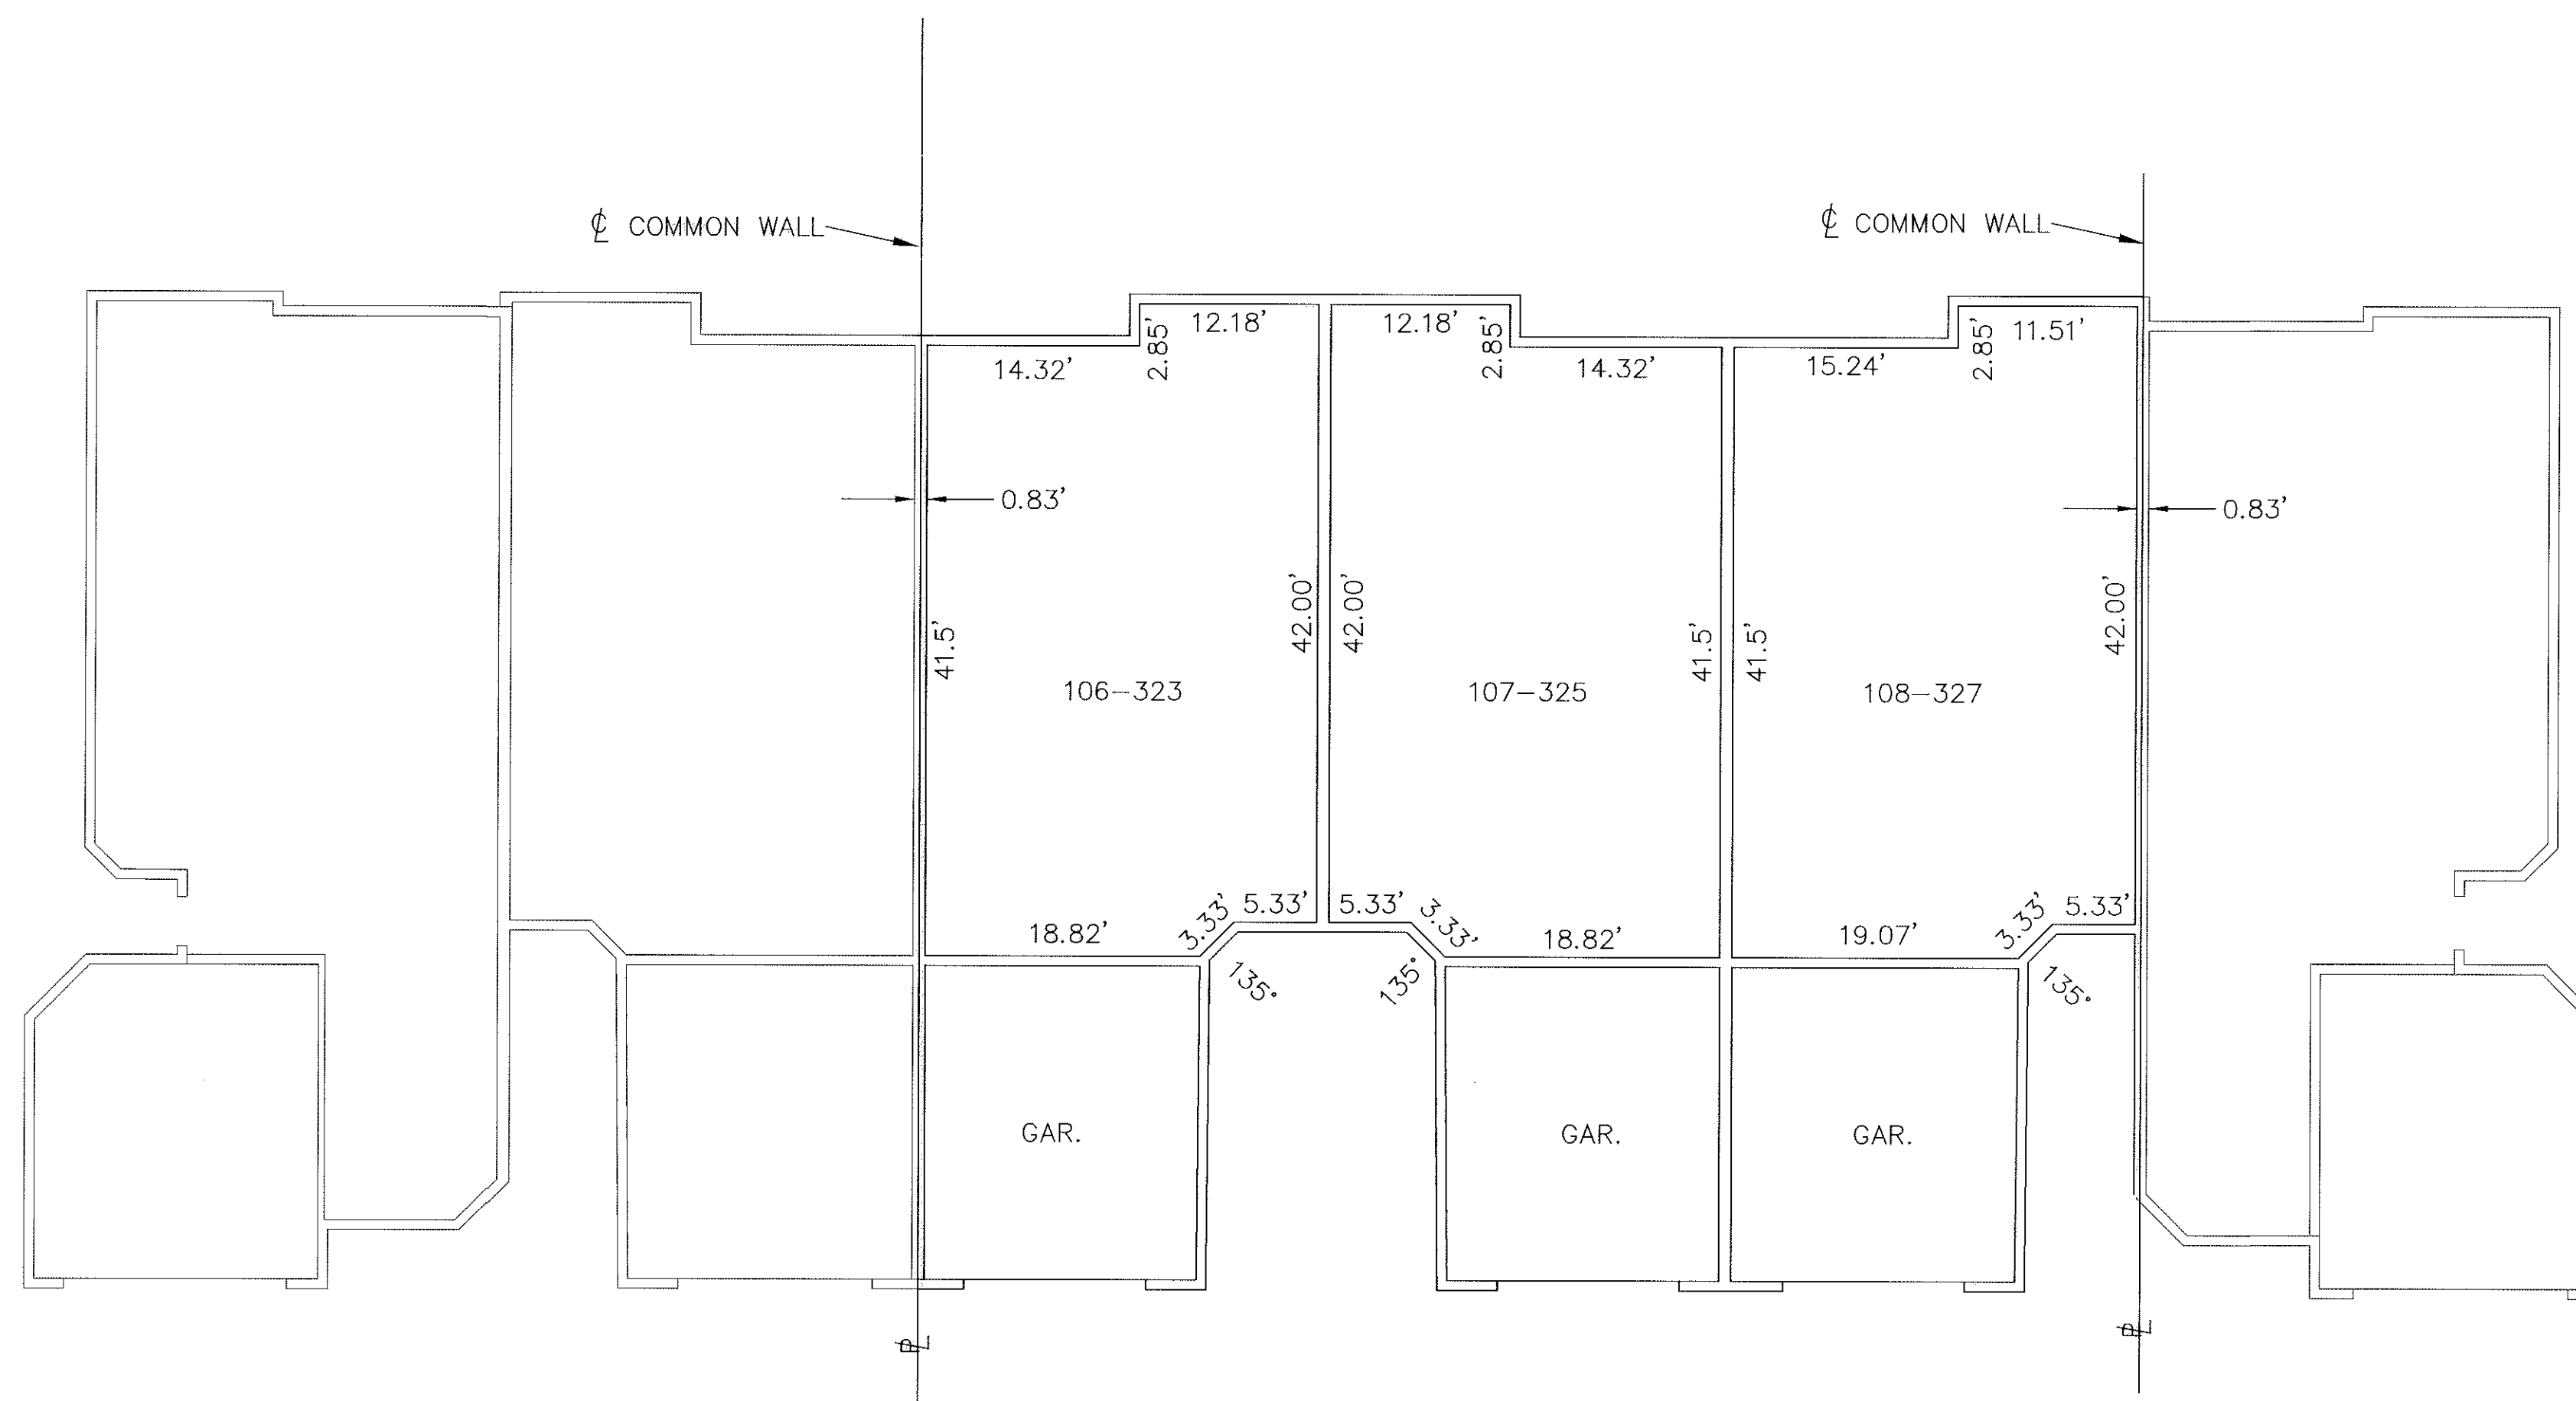

FIRST FLOOR PLAN  
SCALE: 1" = 10'

DATE: 1-8-99	REVISIONS	
DRAWN BY: AMK		
CH'D BY: DLE		
F.B.:		
DWG. NAME: R:\89224-20\20-PLAN01		





**THE ENGLISH LAKES CONDOMINIUMS  
PHASE 20**

PART OF AMHERST TOWNSHIP O.L.s 25 & 26  
CITY OF AMHERST \* COUNTY OF LORAIN \* STATE OF OHIO

**KS ASSOCIATES, INC.**  
ENGINEERS/SURVEYORS  
424 Middle Avenue  
P.O. Box 89  
Elyria, Ohio 44036  
PHONE: (440) 322-6317 \* FAX: (440) 284-0623



SHEET  
2 OF  
4  
JOB NO.  
89224-CP20

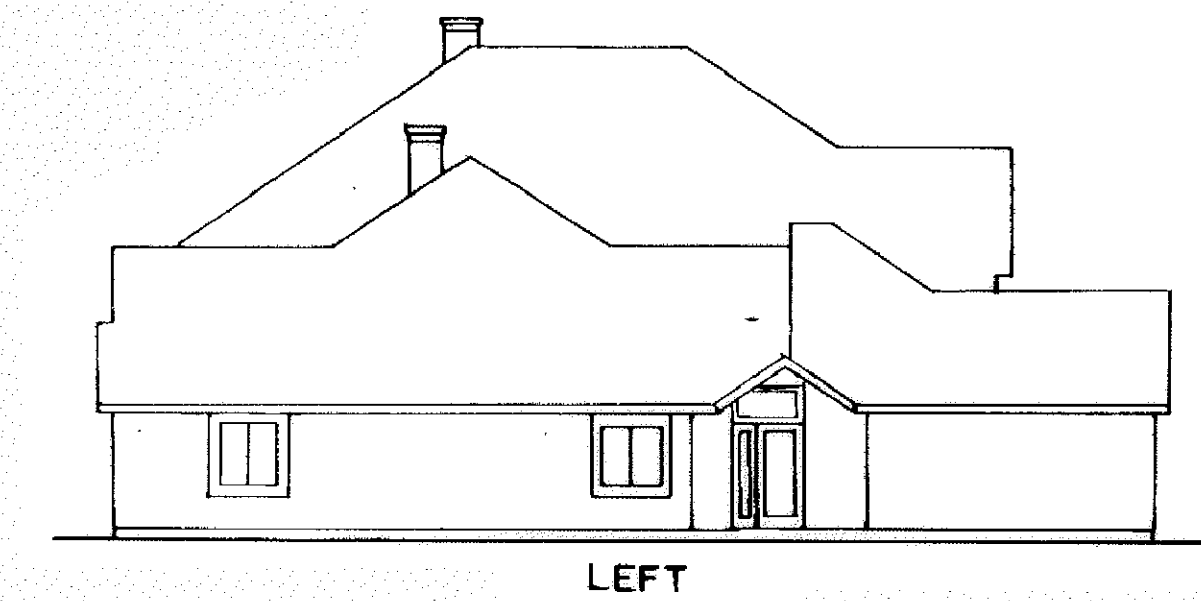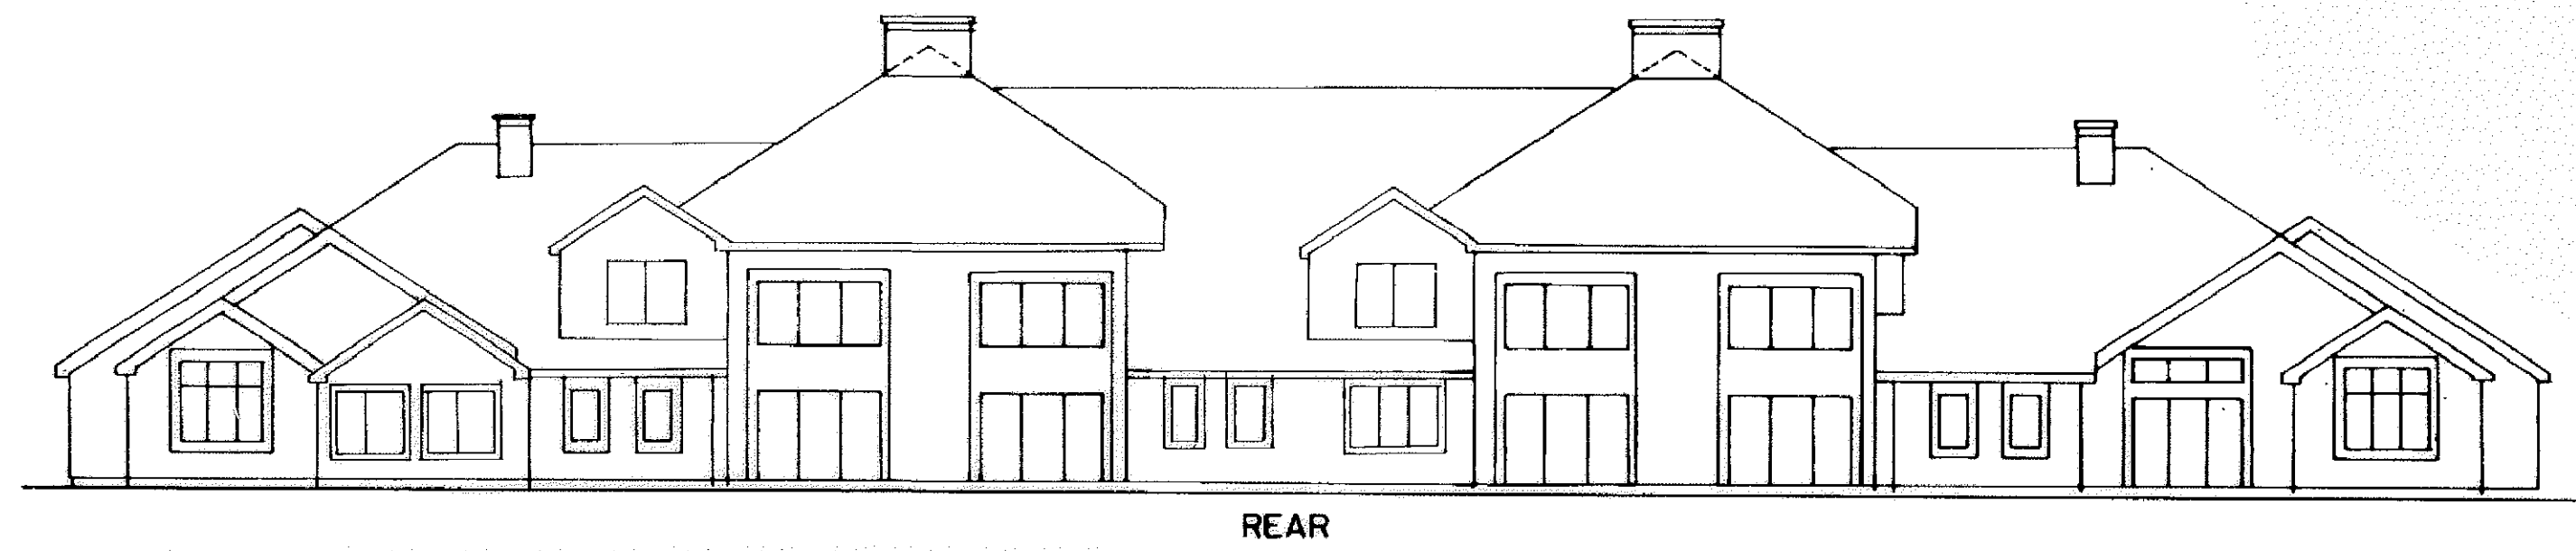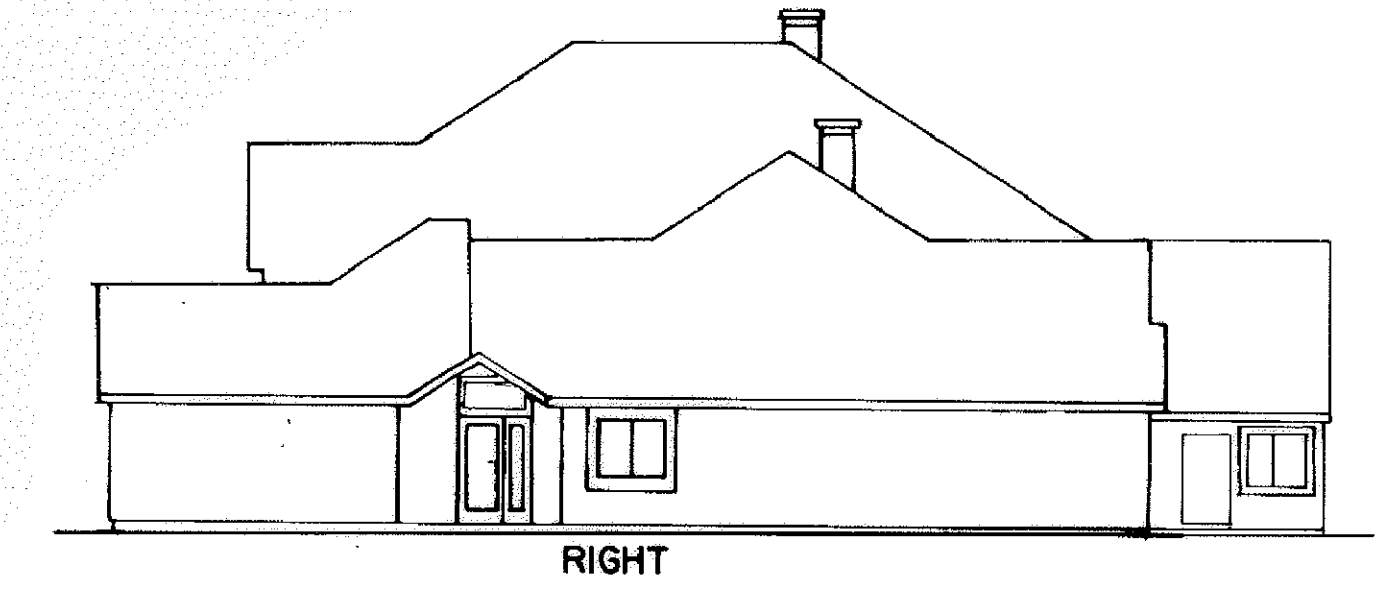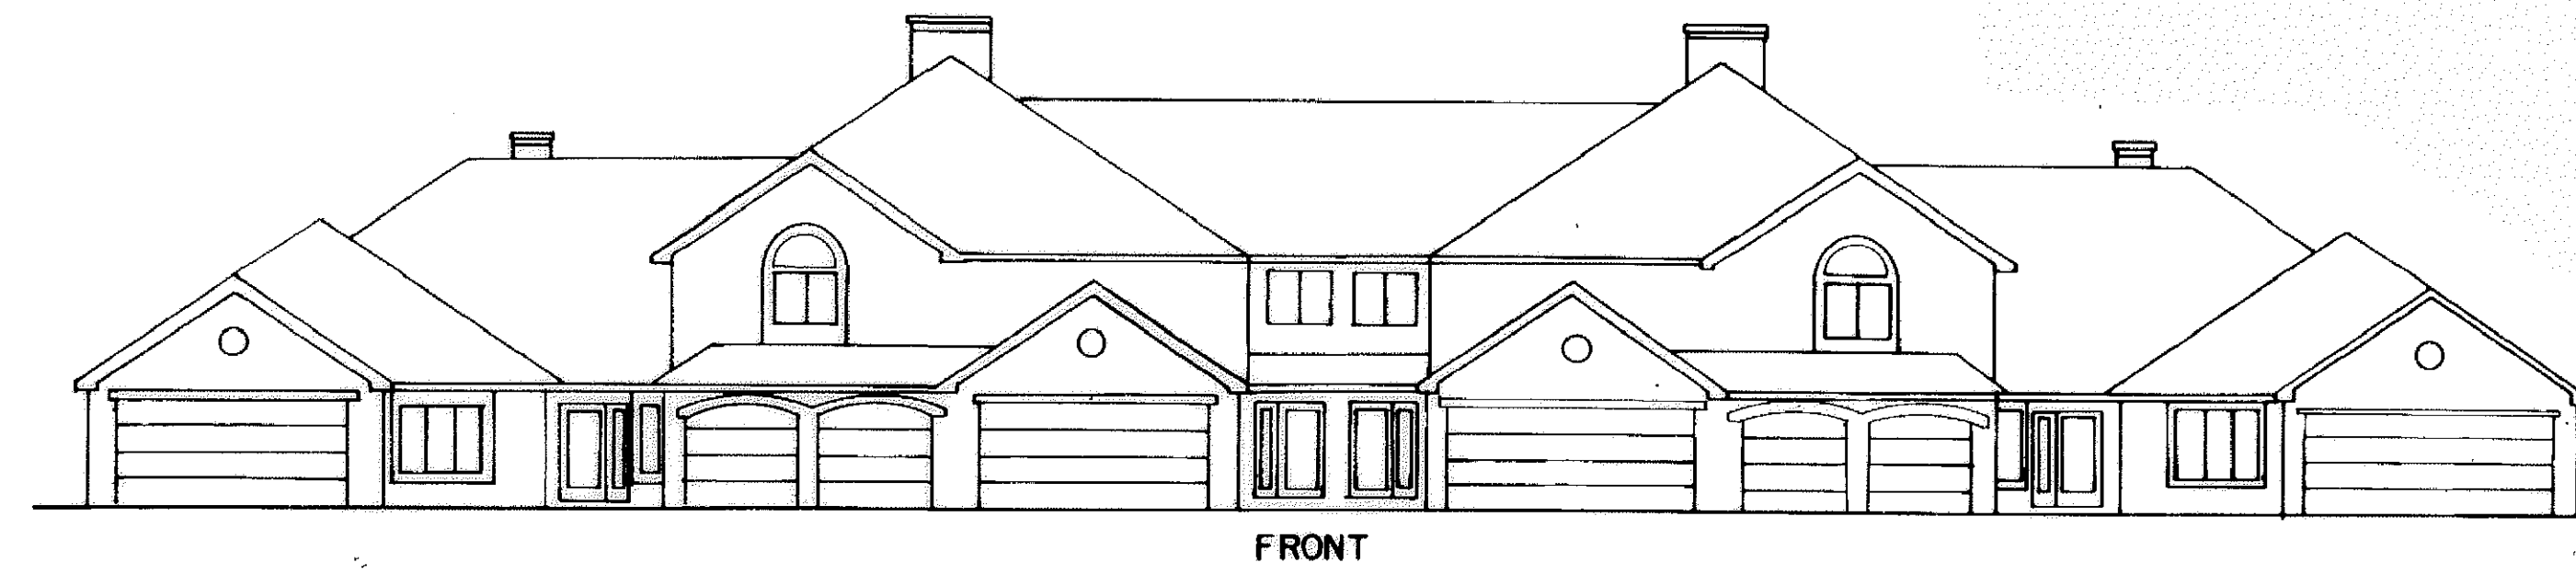


NOTE: BUILDING SHOWN IS FOR GENERAL APPEARANCE ONLY.  
 TYPICAL 6 UNIT FOR PROJECT.  
 VARIATIONS PER SPECIFIC BUILDING MAY OCCUR.

DATE: 1-8-99	REVISIONS	
DRAWN BY: AMK		
CH'D BY: DLE		
F.B.		
DWG. NAME: 89224-20\20-ELEV01		

THE ENGLISH LAKES CONDOMINIUMS  
 PHASE 20  
 EXTERIOR ELEVATIONS  
 PART OF AMHERST TOWNSHIP O.L.s 25 & 26  
 CITY OF AMHERST \* COUNTY OF LORAIN \* STATE OF OHIO

**KS ASSOCIATES, INC.**  
 ENGINEERS/SURVEYORS  
 424 Middle Avenue  
 P.O. Box 89  
 Elyria, Ohio 44036  
 PHONE (440) 322-6317 \* FAX (440) 284-0623

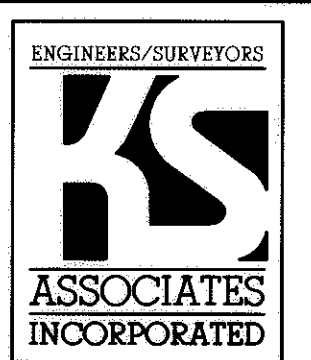

SHEET 3 OF 4  
 JOB NO. 89224-CP20

# OWNERSHIP LIST


UNIT NO.	SQ. FT.	ELEV. 1ST FL	% OWNERSHIP
1-101	1388	723.40	0.7719
2-103	1626	723.40	0.9042
3-105	1769	723.40	0.9838
4-107	1388	723.40	0.7719
5-141	1388	719.38	0.7719
6-143	1626	719.38	0.9042
7-145	1769	719.38	0.9838
8-147	1388	719.38	0.7719
9-151	1388	719.53	0.7719
10-153	1626	719.53	0.9042
11-155	1769	719.53	0.9838
12-157	1388	719.53	0.7719
13-109	1388	722.30	0.7719
14-111	1626	722.30	0.9042
15-113	1769	722.30	0.9838
16-115	1388	722.30	0.7719
17-129	1388	720.10	0.7719
18-131	1626	720.10	0.9042
19-133	2177	720.10	1.2107
20-135	1769	720.10	0.9838
21-137	1626	720.10	0.9042
22-139	1388	720.10	0.7719
23-128	1388	719.53	0.7719
24-130	1626	719.45	0.9042
25-132	1769	719.45	0.9838
26-134	2177	719.45	1.2107
27-136	1626	719.50	0.9042
28-138	1388	719.47	0.7719
29-117	1388	721.20	0.7719
30-119	1626	721.21	0.9042
31-121	1769	721.21	0.9838
32-123	2177	721.24	1.2107
33-125	1626	721.25	0.9042
34-127	1388	721.22	0.7719
35-260	1388	724.73	0.7719
36-262	2177	724.68	1.2107
37-264	1626	724.66	0.9042
38-266	1388	724.66	0.7719
39-116	1388	720.82	0.7719
40-118	1626	720.83	0.9042
41-120	2177	720.83	1.2107
42-122	1769	720.82	0.9838
43-124	1626	720.80	0.9042
44-126	1388	720.77	0.7719
45-361	1388	719.44	0.7719
46-363	1626	719.38	0.9042
47-365	2177	719.39	1.2107
48-367	2177	719.40	1.2107
49-369	1626	719.40	0.9042
50-371	1388	719.43	0.7719
51-373	1388	721.52	0.7719
52-375	1626	721.53	0.9042
53-377	1769	721.53	0.9838
54-379	1769	721.54	0.9838
55-381	1626	721.52	0.9042
56-383	1388	721.53	0.7719
57-261	1388	722.55	0.7719
58-263	1626	722.55	0.9042

UNIT NO.	SQ. FT.	ELEV. 1ST FL	% OWNERSHIP
59-265	1769	722.57	0.9838
60-267	1769	722.60	0.9838
61-269	1626	722.60	0.9042
62-271	1675	722.60	0.9315
63-273	1388	720.74	0.7719
64-275	1626	720.71	0.9042
65-277	2177	720.69	1.2107
66-279	1769	720.68	0.9838
67-281	1626	720.73	0.9042
68-283	1388	720.70	0.7719
69-278	1388	721.15	0.7719
70-276	1626	721.16	0.9042
71-274	2177	721.21	1.2107
72-272	1769	721.21	0.9838
73-270	1626	721.22	0.9042
74-268	1675	721.15	0.9315
75-398	1388	730.28	0.7719
76-396	1626	727.02	0.9042
77-394	1769	727.02	0.9838
78-392	1769	723.63	0.9838
79-390	1626	723.63	0.9042
80-388	1388	722.30	0.7719
81-385	1668	721.71	0.9276
82-387	1580	722.33	0.8787
83-389	1769	722.30	0.9838
84-391	2253	724.40	1.2529
85-393	2253	724.44	1.2529
86-395	2253	728.39	1.2529
87-397	1580	728.39	0.8787
88-399	1388	731.25	0.7719
89-314	1388	726.13	0.7719
90-312	1580	726.13	0.8787
91-310	1769	726.13	0.9838
92-308	2253	726.13	1.2529
93-306	2253	726.13	1.2529
94-304	1769	725.55	0.9838
95-302	1580	726.15	0.8787
96-300	1668	726.15	0.9276
97-319	1388	723.33	0.7719
98-321	1580	723.33	0.8787
99-329	1668	723.33	0.9276
100-318	1668	723.60	0.9276
101-320	1626	723.60	0.9042
102-322	1769	723.60	0.9838
103-324	2177	723.60	1.2107
104-326	1626	723.60	0.9042
105-328	1388	723.60	0.7719
106-323	1769	723.33	0.9838
107-325	1769	723.33	0.9838
108-327	1626	723.33	0.9042
TOTAL	179,819		100.00%

DATE: 1-8-99	REVISIONS	
DRAWN BY: AMK		
CHK'D BY: DLF		
F.B.		
DWG. NAME: B-89224-20/OWNER		

THE ENGLISH LAKES CONDOMINIUMS  
 PHASE 20  
 OWNERSHIP PERCENTAGES

KS ASSOCIATES, INC.  
 ENGINEERS/SURVEYORS  
 424 Middle Avenue  
 P.O. Box 89  
 Elyria, Ohio 44036  
 ELYRIA (440) 322-6317 \* LORAIN (440) 244-5757

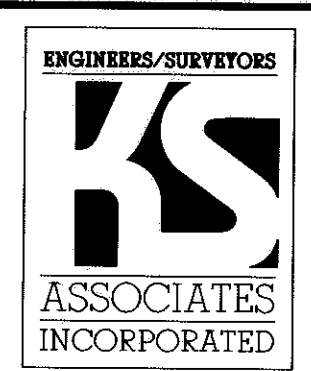

SHEET 4 OF 4  
 JOB NO. 89224-CP20