

I CERTIFY THAT WITH THE EXCEPTION OF MINOR ARCHITECTURAL MODIFICATIONS MADE DURING CONSTRUCTION, THE DRAWINGS REPRESENT THE STRUCTURES AS BUILT.

Mark W. Ruby
 Mark W. Ruby, Architect #9199

FOUNDATION PLAN
 SCALE: 1/4" = 1'-0"




1 TRANSFERRED
 IN COMPLIANCE WITH SSC 513-702
 FREE
 SEP 03 2004
 MARK R. STEWART
 LORAIN COUNTY AUDITOR

REVISIONS	BY


MARK W. RUBY
 ARCHITECT
 1110 COOPER FOSTER PARK ROAD
 AMHERST, OH. 44001
 (440) 986-2081

TITLE
**BUILDING #1
 DEER TRAIL
 CONDOMINIUMS**

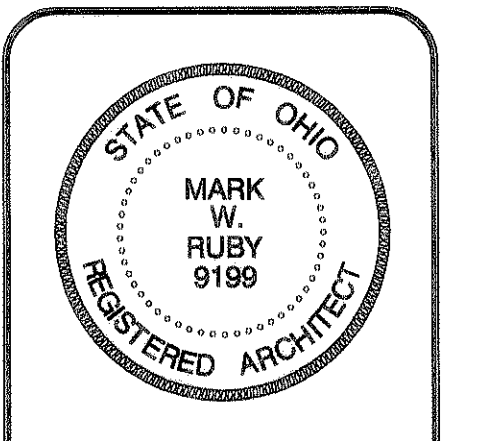

DATE 5/10/04
 PROJ. 0417
 SHEET

2 OF 4

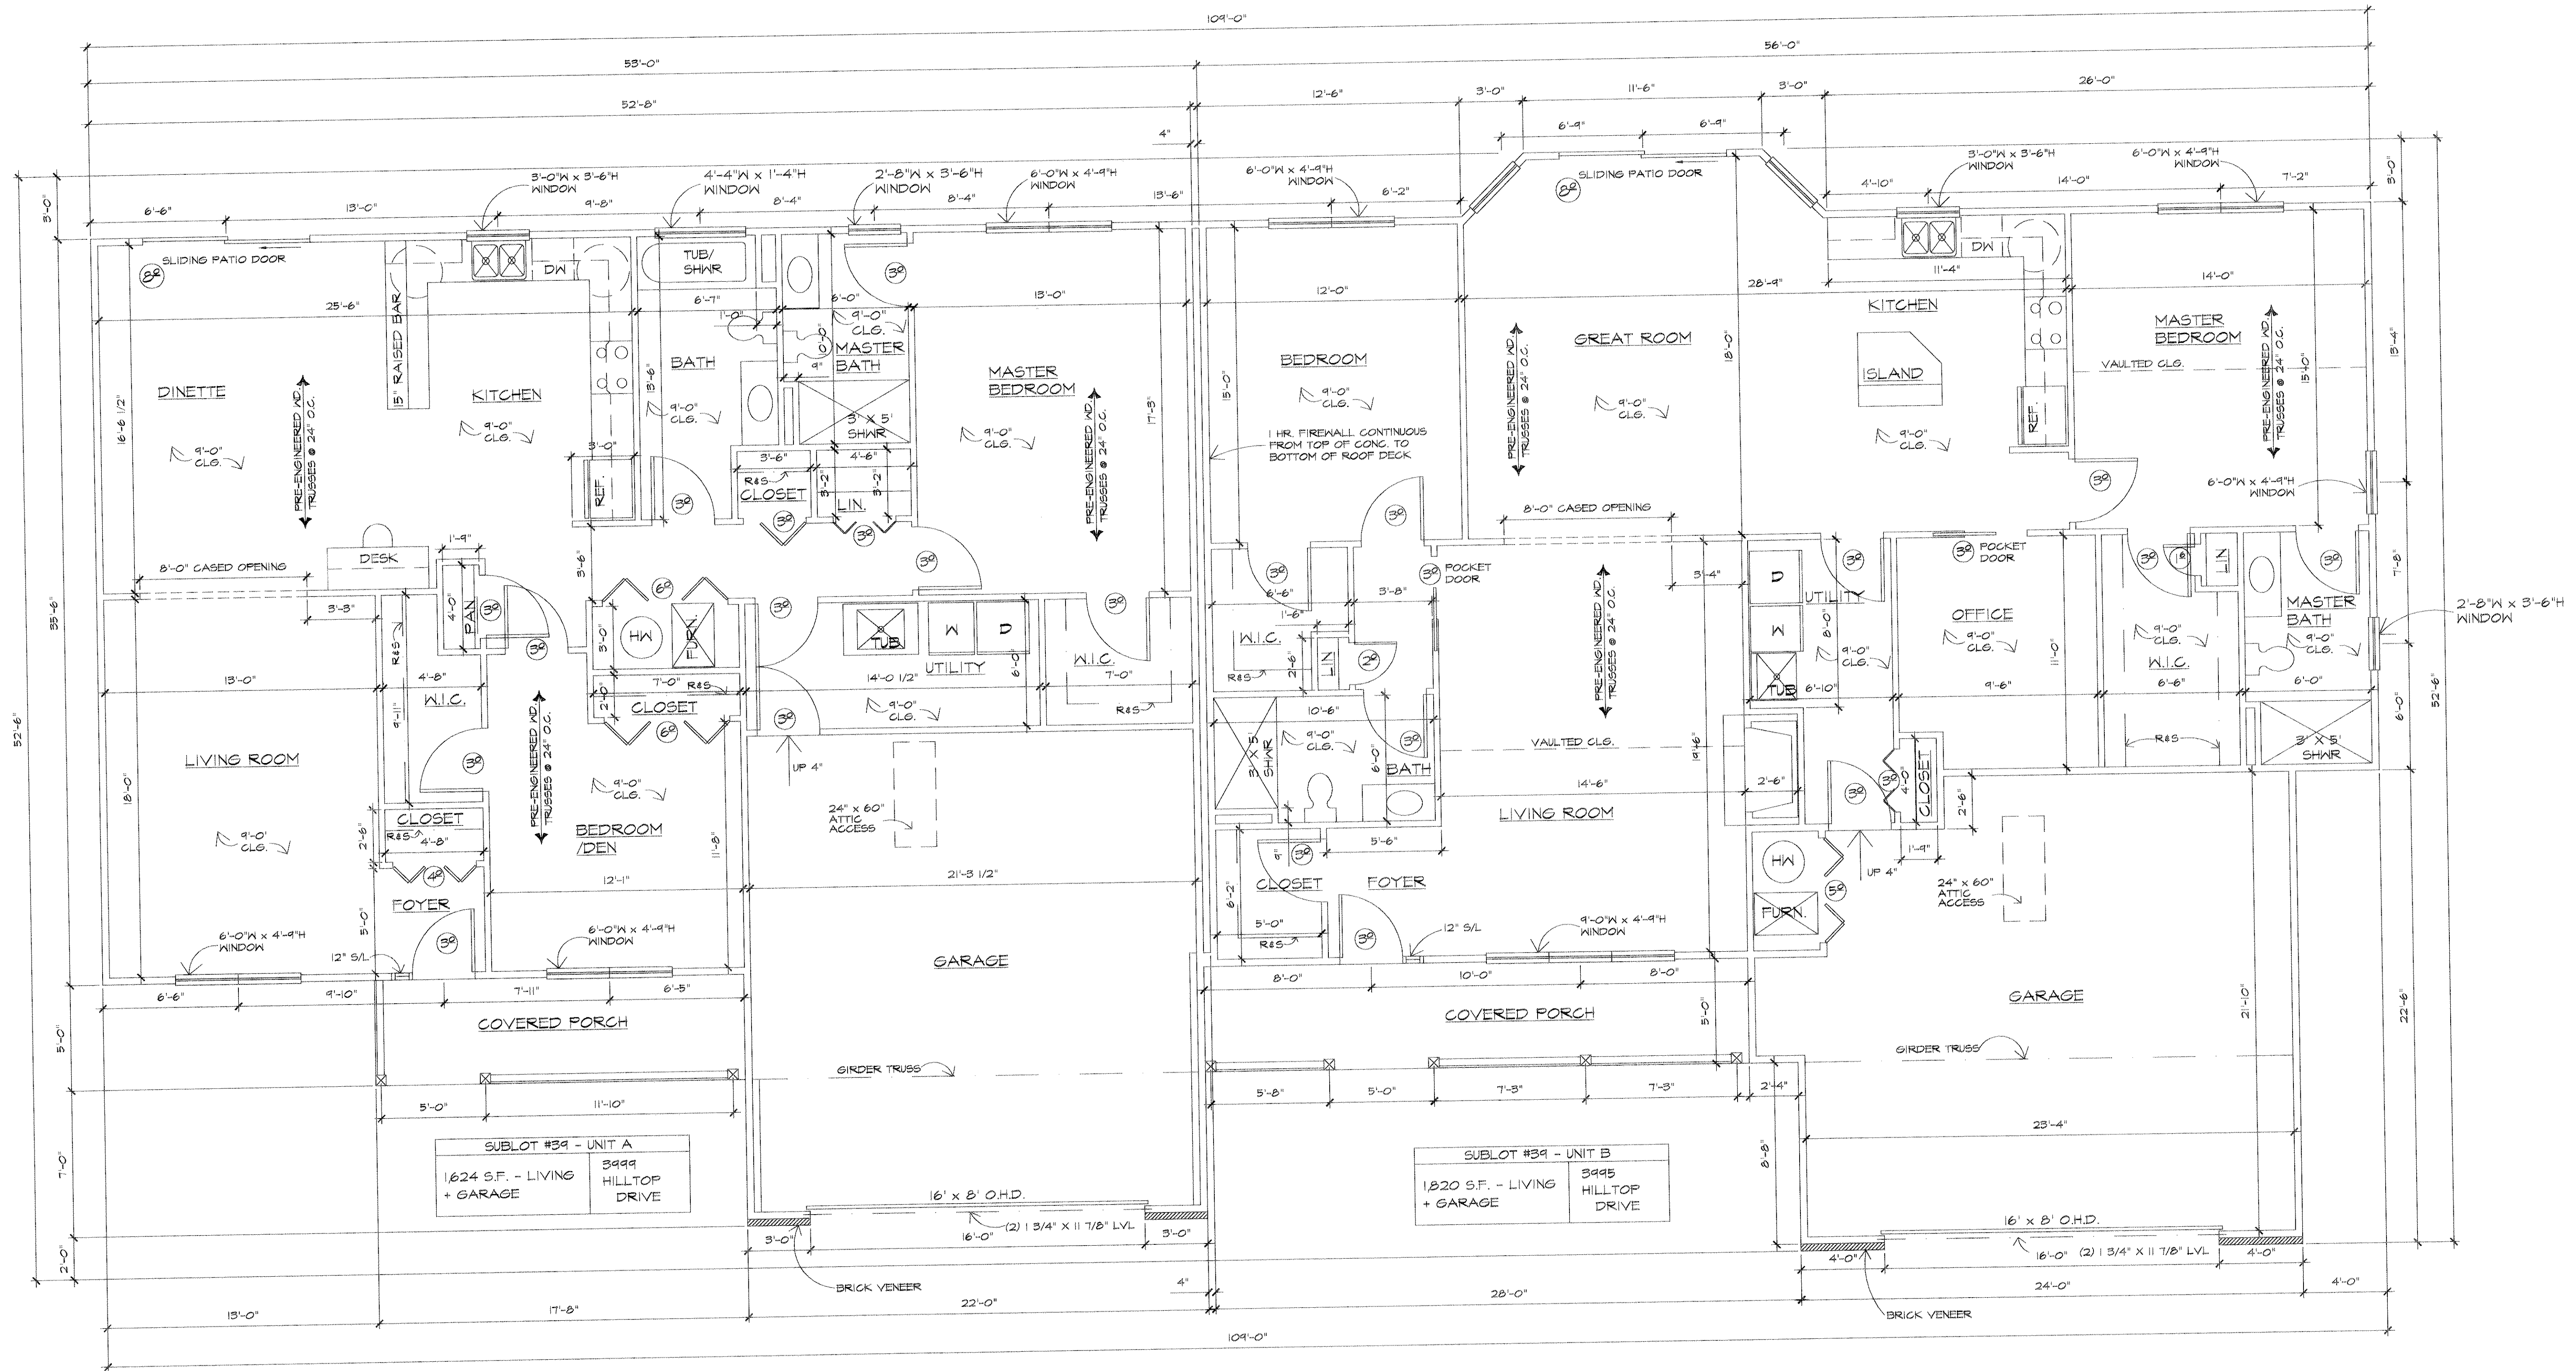


SUBLOT #39 - UNIT A
1624 S.F. - LIVING + GARAGE
3499 HILLTOP DRIVE

SUBLOT #39 - UNIT B
1,820 S.F. - LIVING + GARAGE
3495 HILLTOP DRIVE

I CERTIFY THAT WITH THE EXCEPTION OF MINOR ARCHITECTURAL MODIFICATIONS MADE DURING CONSTRUCTION, THE DRAWINGS REPRESENT THE STRUCTURES AS BUILT.

Mark W. Ruby
Mark W. Ruby, Architect #1199


FOUNDATION PLAN
SCALE: 1/4"=1'-0"

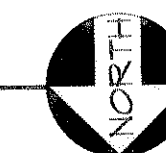

REVISIONS	BY


MARK W. RUBY
ARCHITECT
1110 COOPER FOSTER PARK ROAD
AMHERST, OH. 44001
(440) 986-2091

TITLE
BUILDING #1
DEER TRAIL
CONDOMINIUMS

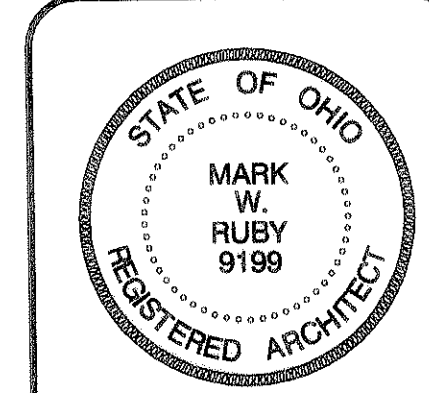


DATE 5/10/04
PROJ. 0417
SHEET


3 OF 4

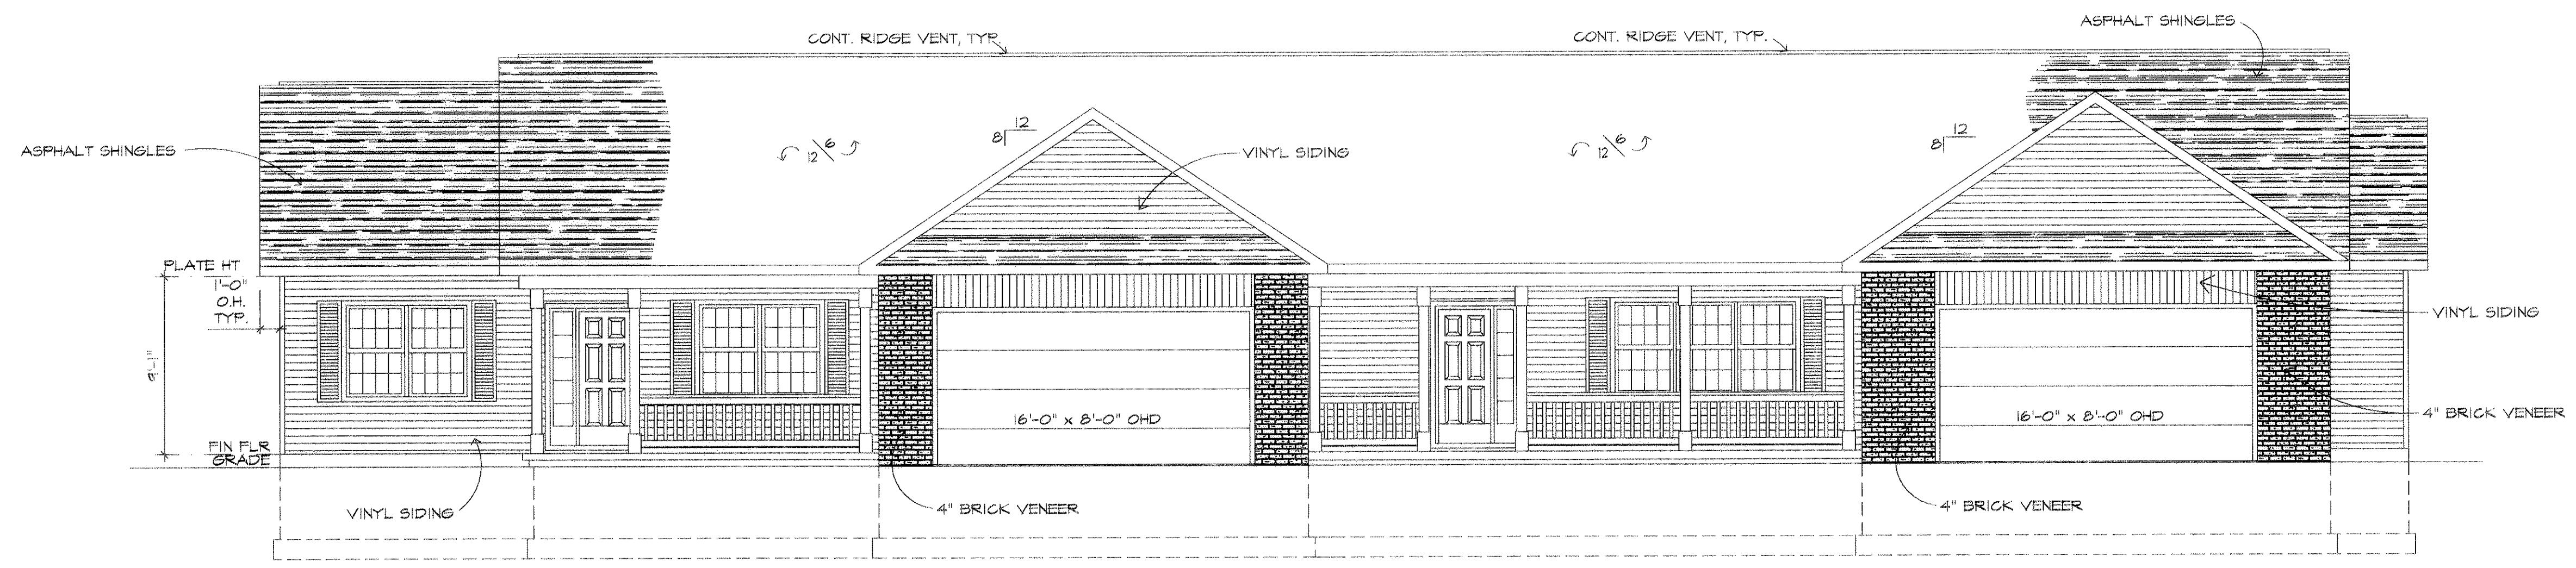


FRONT ELEVATION
SCALE: 3/16"=1'-0"

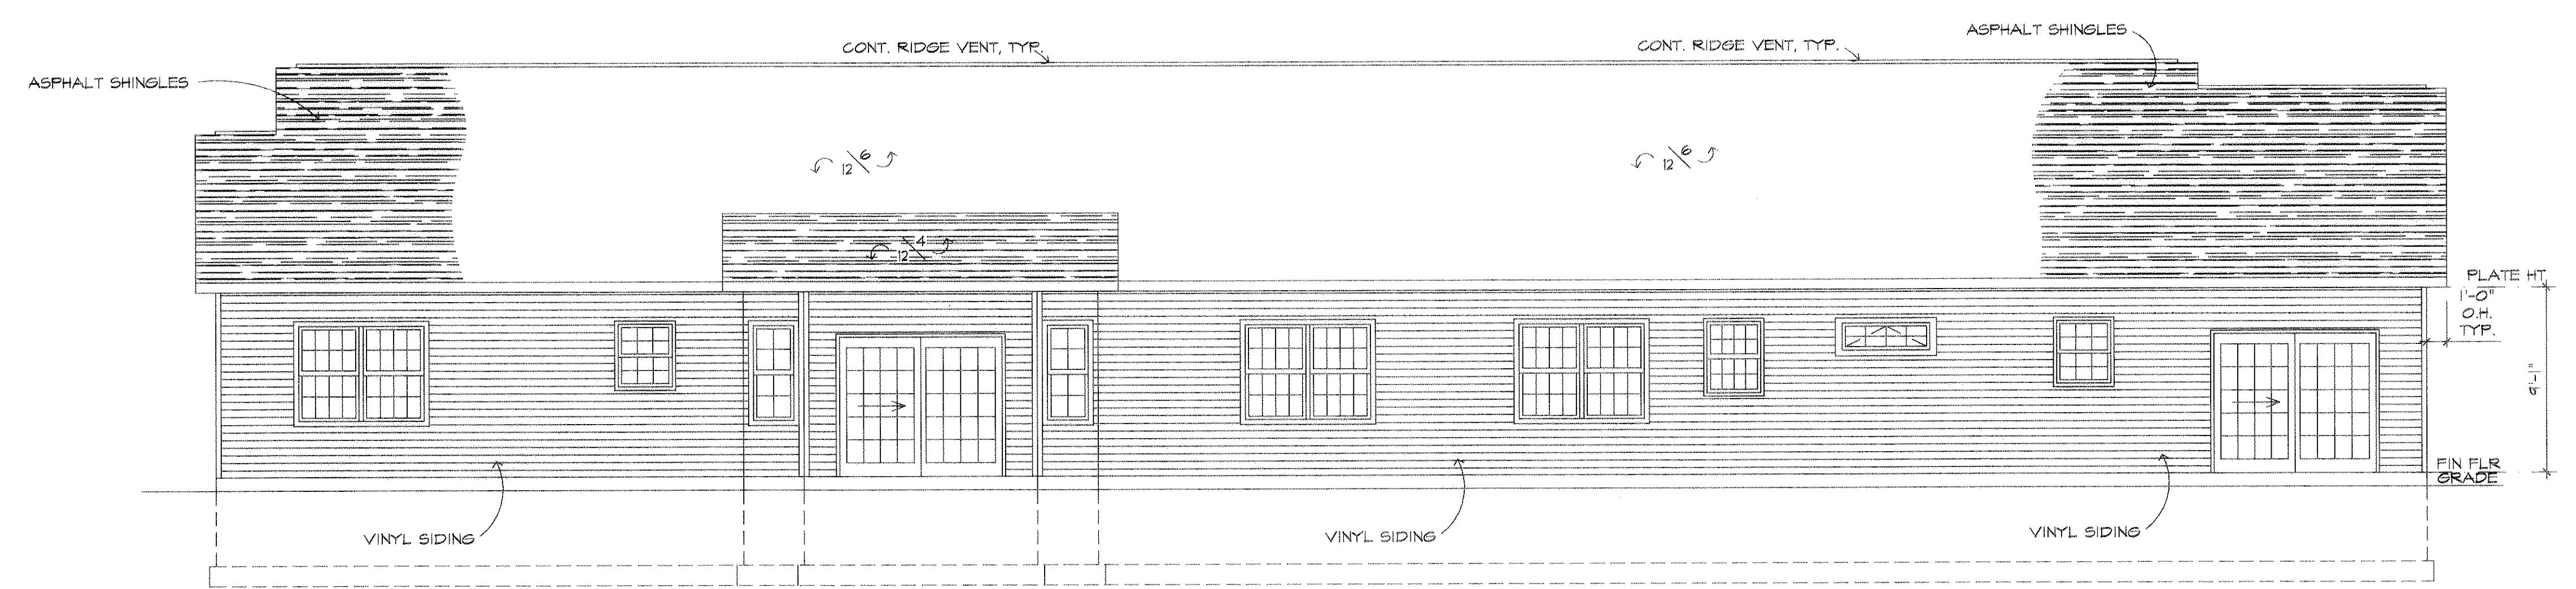

REAR ELEVATION
SCALE: 3/16"=1'-0"

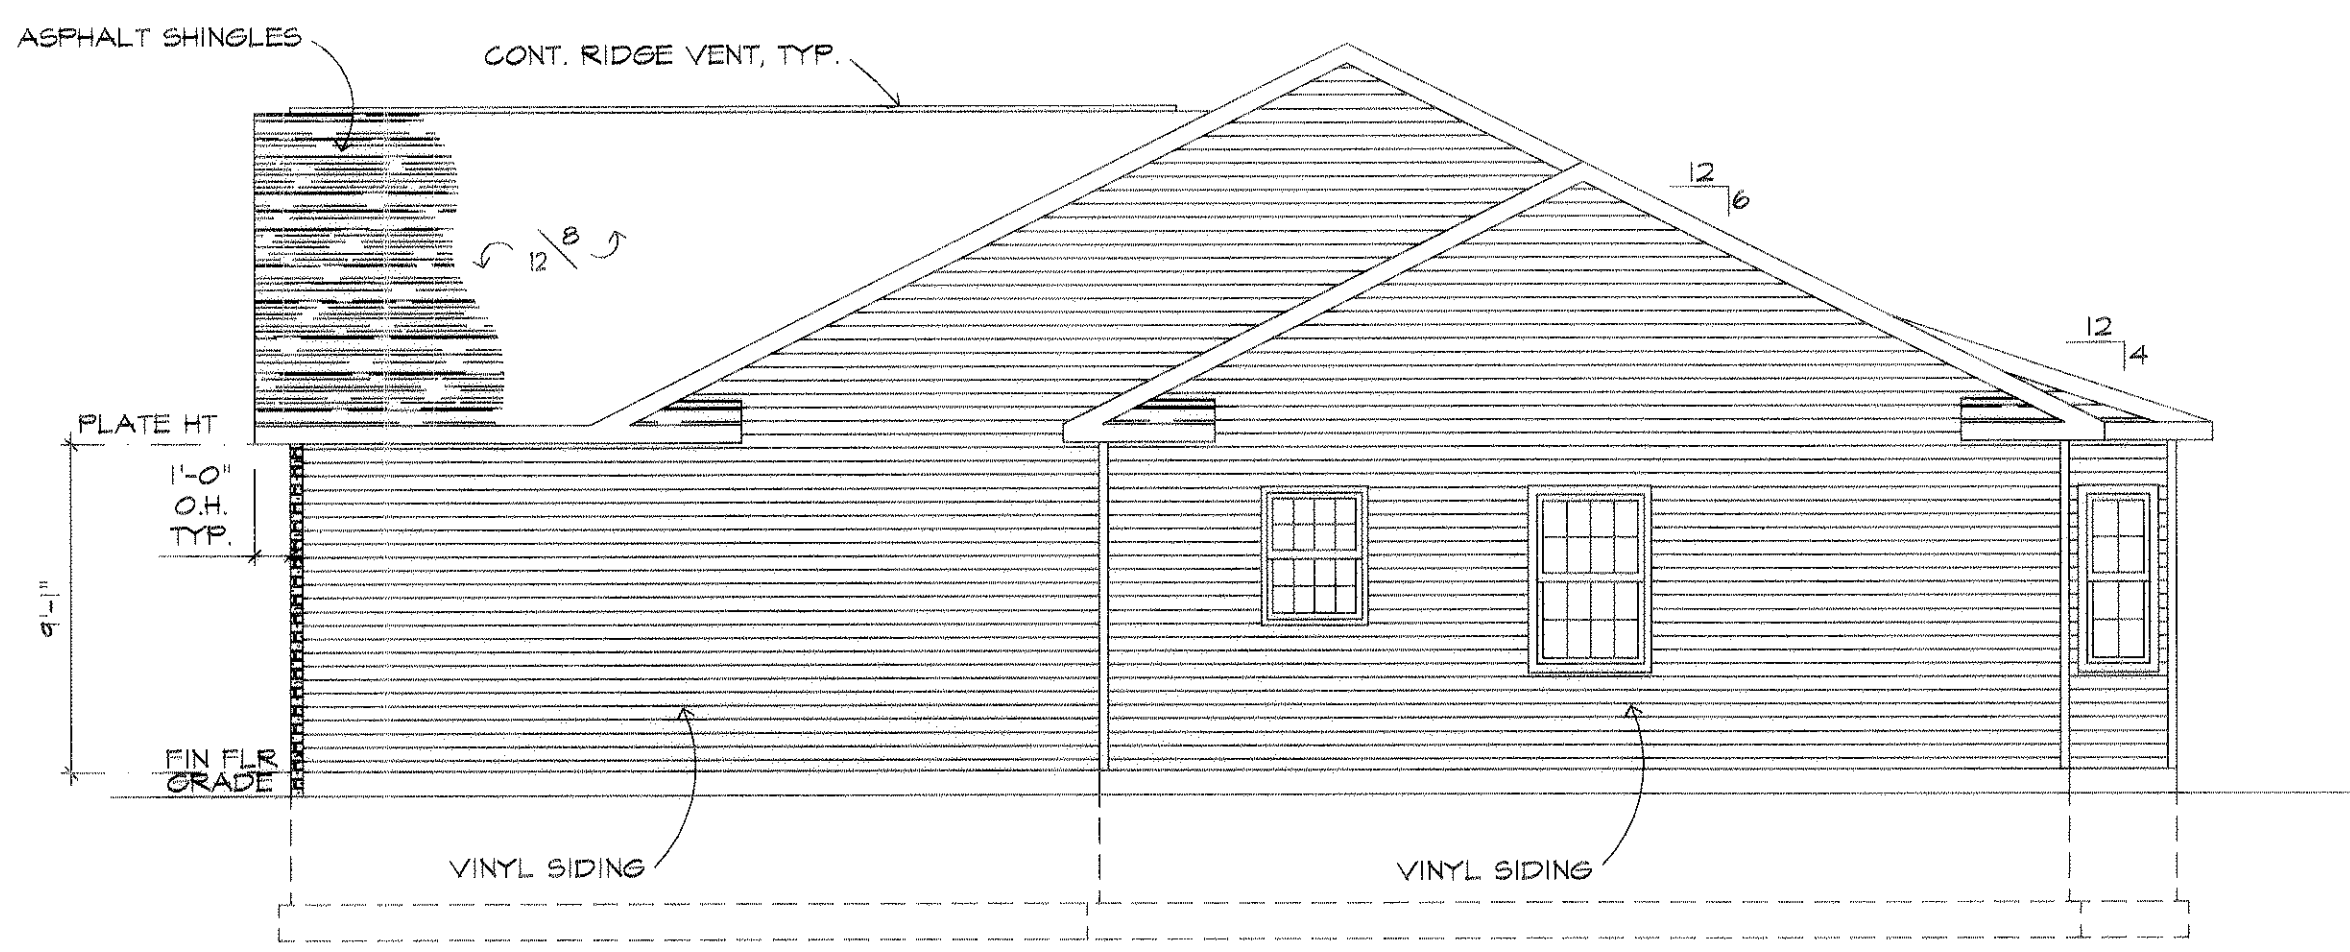

SIDE ELEVATION
SCALE: 3/16"=1'-0"

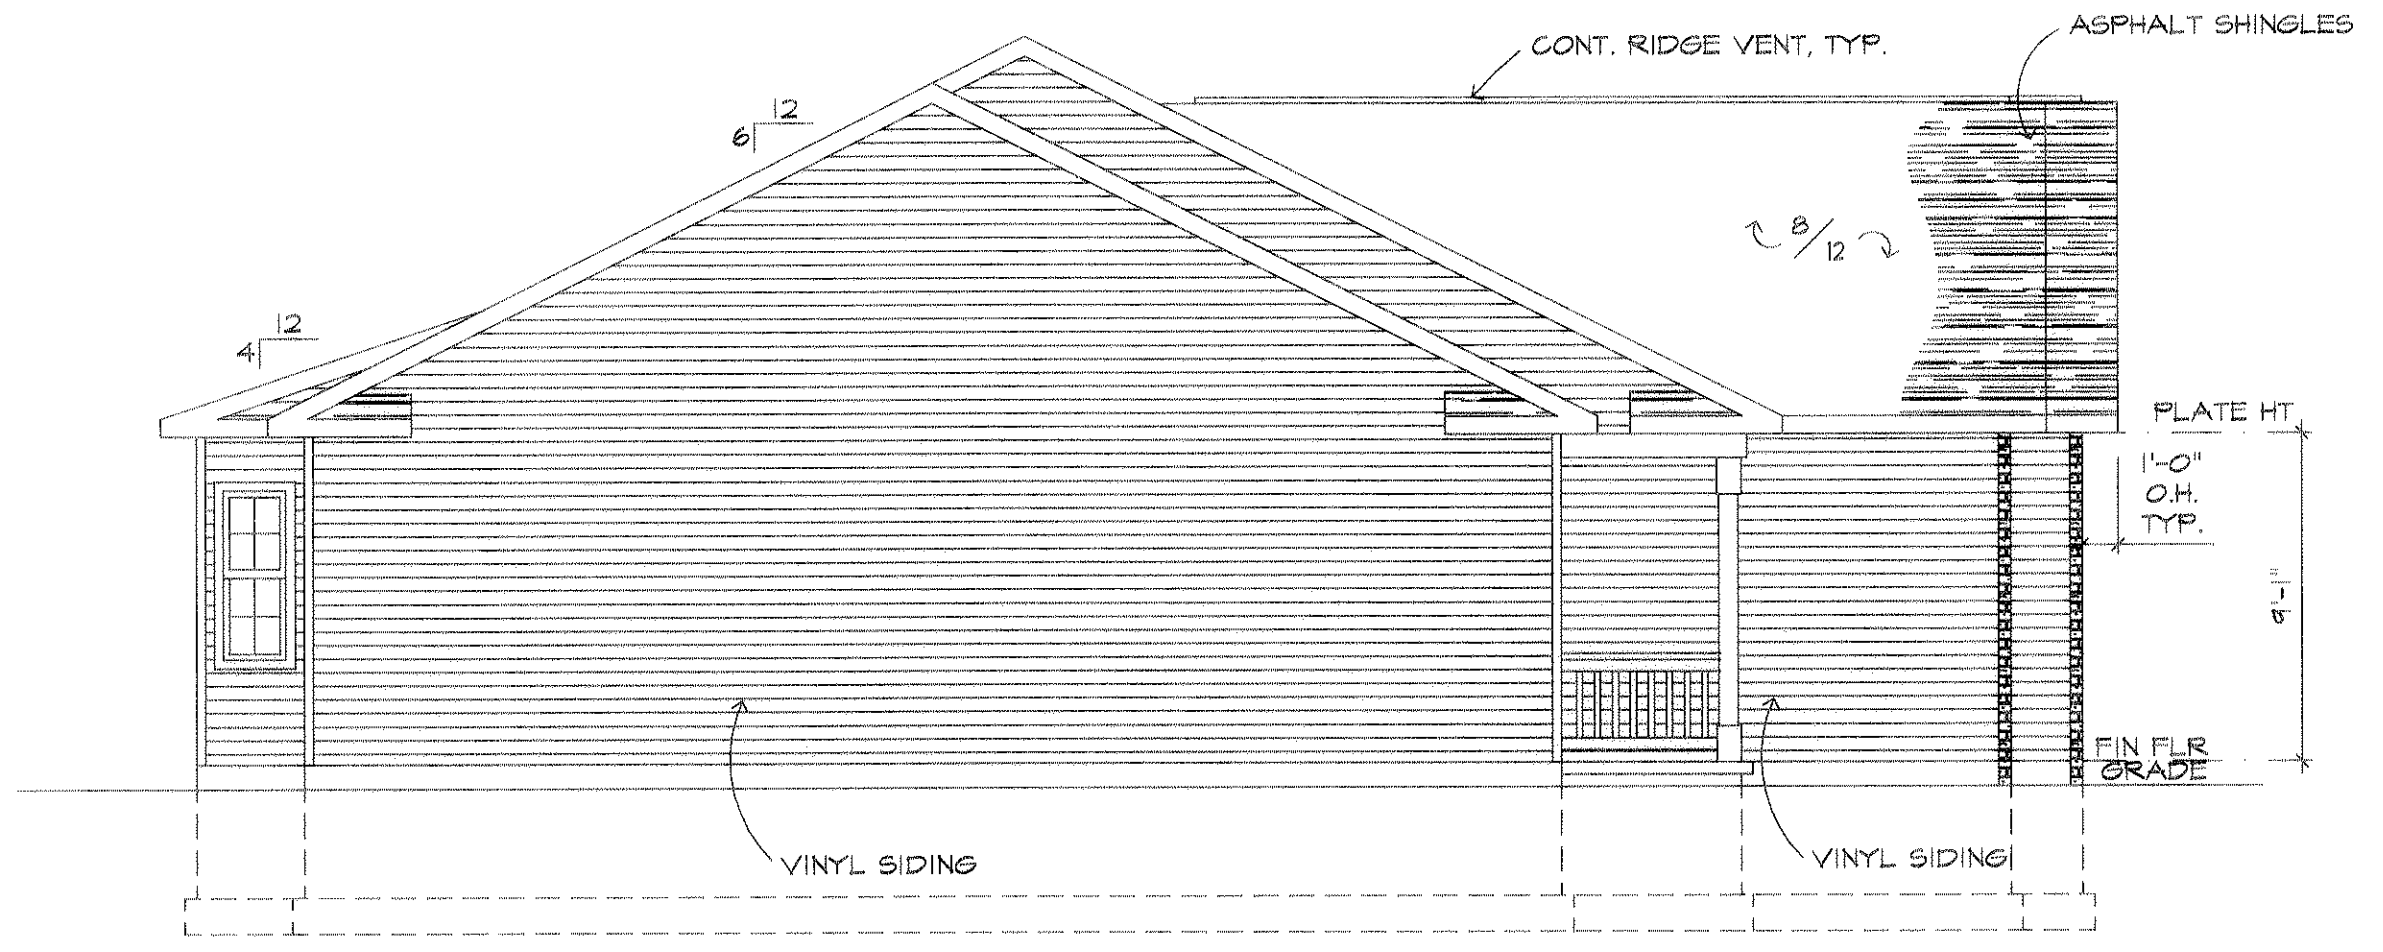

SIDE ELEVATION
SCALE: 3/16"=1'-0"


I CERTIFY THAT WITH THE EXCEPTION OF MINOR ARCHITECTURAL MODIFICATIONS MADE DURING CONSTRUCTION, THE DRAWINGS REPRESENT THE STRUCTURES AS BUILT.

Mark W. Ruby
Mark W. Ruby, Architect #9199

REVISIONS	BY

MARK W. RUBY
ARCHITECT
1110 COOPER FOSTER PARK ROAD
AMHERST, OH, 44001
(440) 986-2091

TITLE
BUILDING #1
DEER TRAIL
CONDOMINIUMS

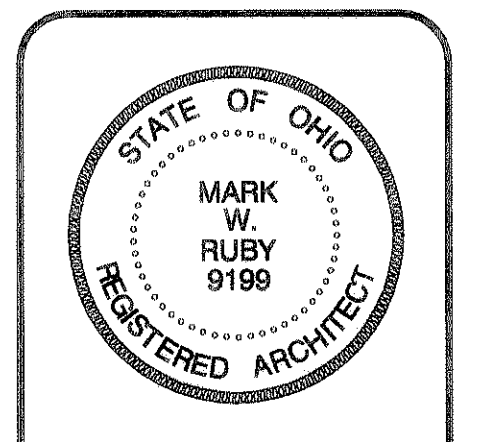

DATE 5/10/04
PROJ. 0417
SHEET