
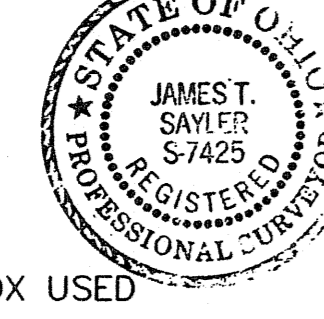


**CERTIFICATION**


THIS IS TO CERTIFY THAT THE ATTACHED DRAWINGS CORRECTLY REPRESENT THE BUILDINGS AS CONSTRUCTED AND THAT THERE ARE NO ENCROACHMENTS ON ADJUTING PROPERTIES.

JAMES T. SAYLER, P.E.  
PROFESSIONAL ENGINEER NO. E-52385

JAMES T. SAYLER  
PROFESSIONAL SURVEYOR NO. S-7425

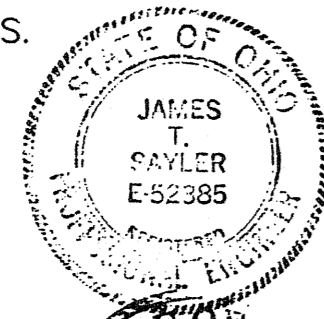

Ⓜ DENOTES 5/8" IRON PIN IN MON. BOX USED


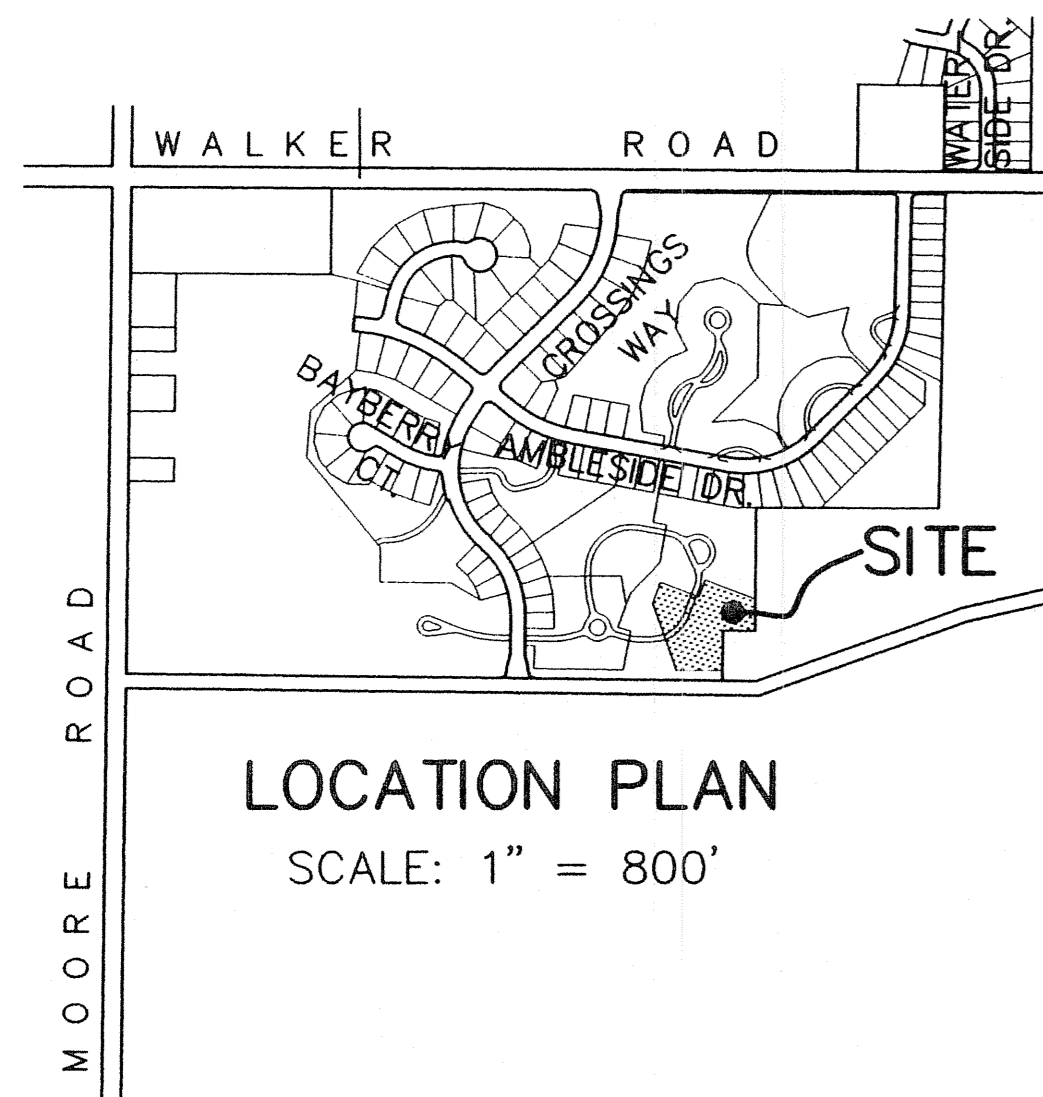


**ACREAGE BREAKDOWN:**

PHASE 1, PARCEL A.....	97,247 SQ. FT., - 2.2325 ACRES
PHASE 2, PARCELS B&E.....	188,594 SQ. FT., - 4.3295 ACRES
PHASE 3, PARCEL F.....	156,582 SQ. FT., - 3.5946 ACRES
PHASE 4, PARCEL G.....	201,422 SQ. FT., - 4.6240 ACRES
PHASE 5, PARCEL H.....	106,800 SQ. FT., - 2.4518 ACRES
PHASE 1 - 5 TOTAL.....	750,645 SQ. FT., -17.2324 ACRES

**SHEET INDEX**

SURVEY	SHEET
1	1
2	2

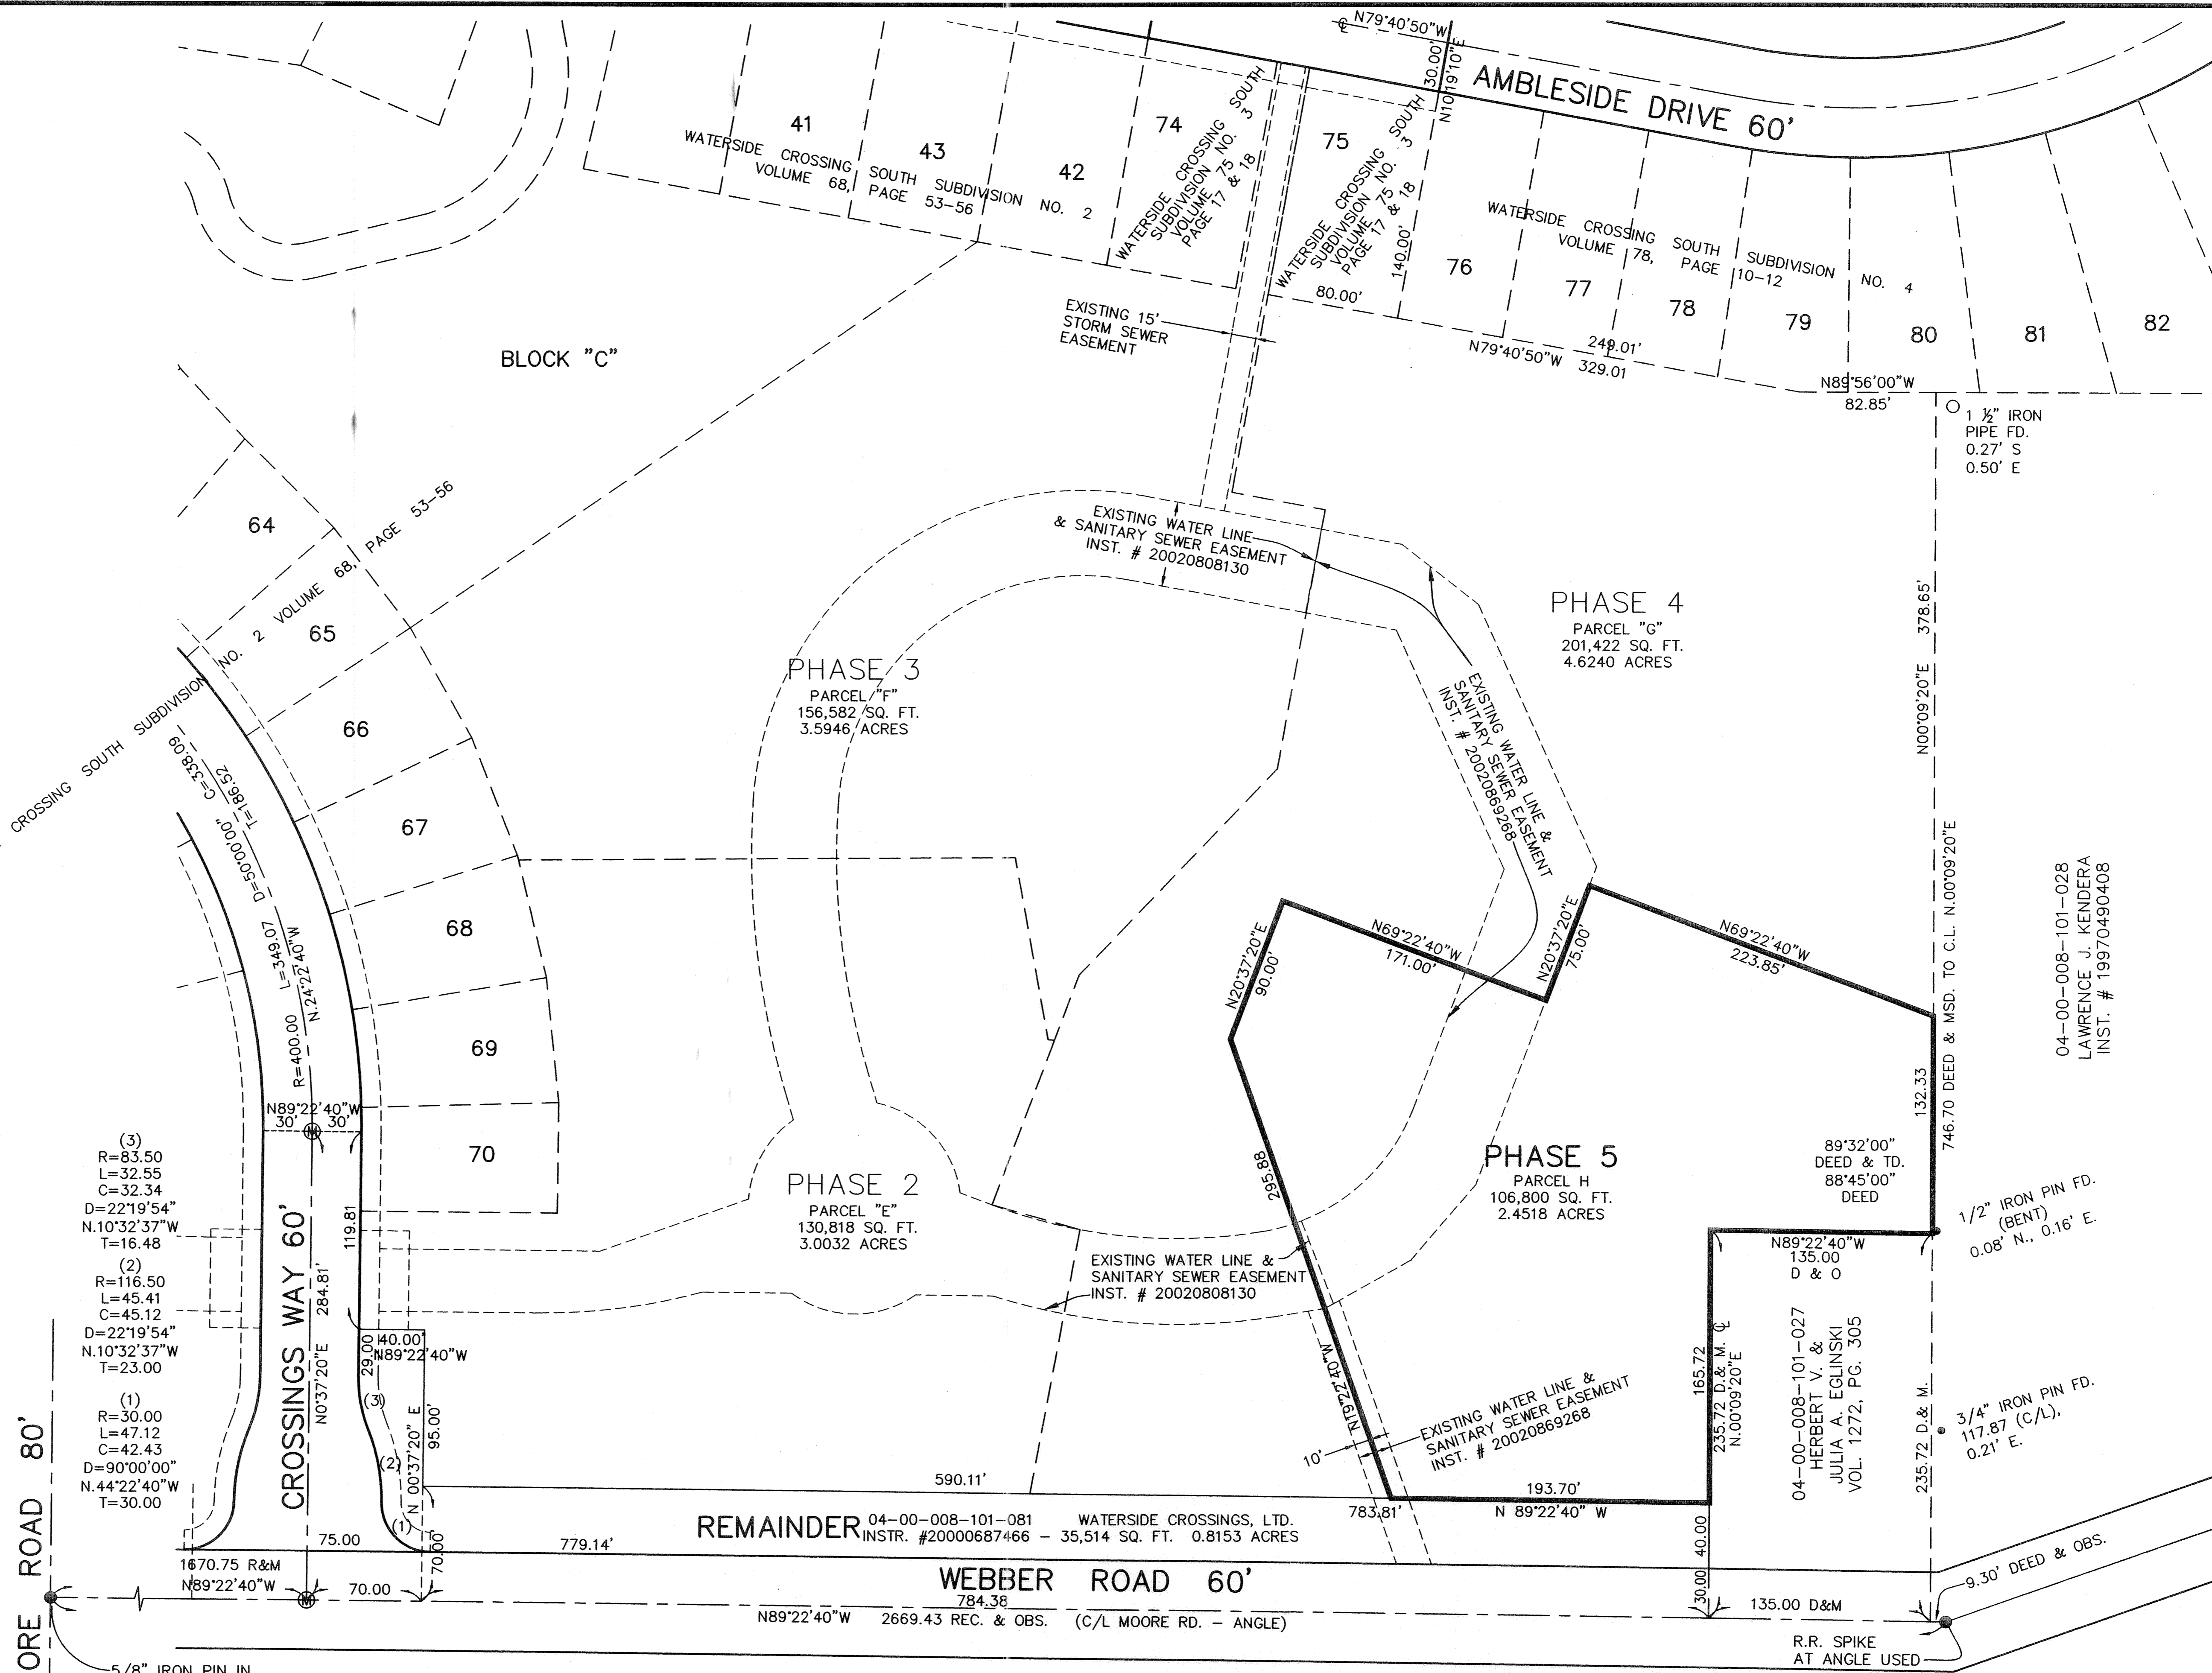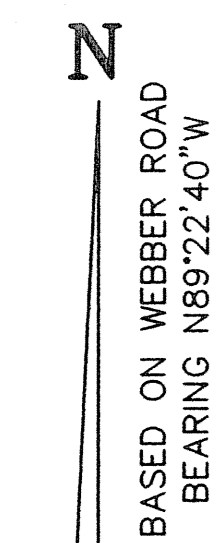


**REVISIONS**


**WATERSIDE CROSSINGS SOUTH CONDOMINIUM PHASE 5**  
OF PART OF ORIGINAL AVON TWP. SECTION NO. 8  
CITY OF AVON LAKE, LORAIN COUNTY, OHIO

**THE HENRY G. REITZ ENGINEERING COMPANY**  
4214 ROCKY RIVER DRIVE  
CLEVELAND, OHIO 44135  
PHONE: (216) 251-3033



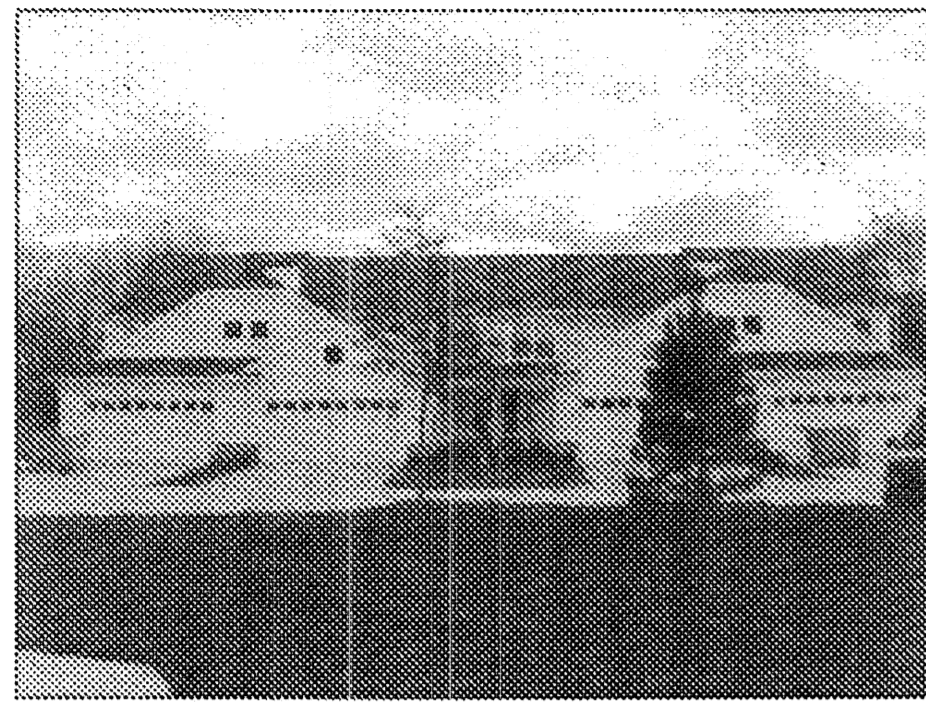

BUILDING 81 - 84 FRONT



BUILDING 81 - 84 REAR



BUILDING 85 - 88 FRONT





BUILDING 85 - 88 REAR



BUILDING 89 - 92 FRONT




BUILDING 89 - 92 REAR

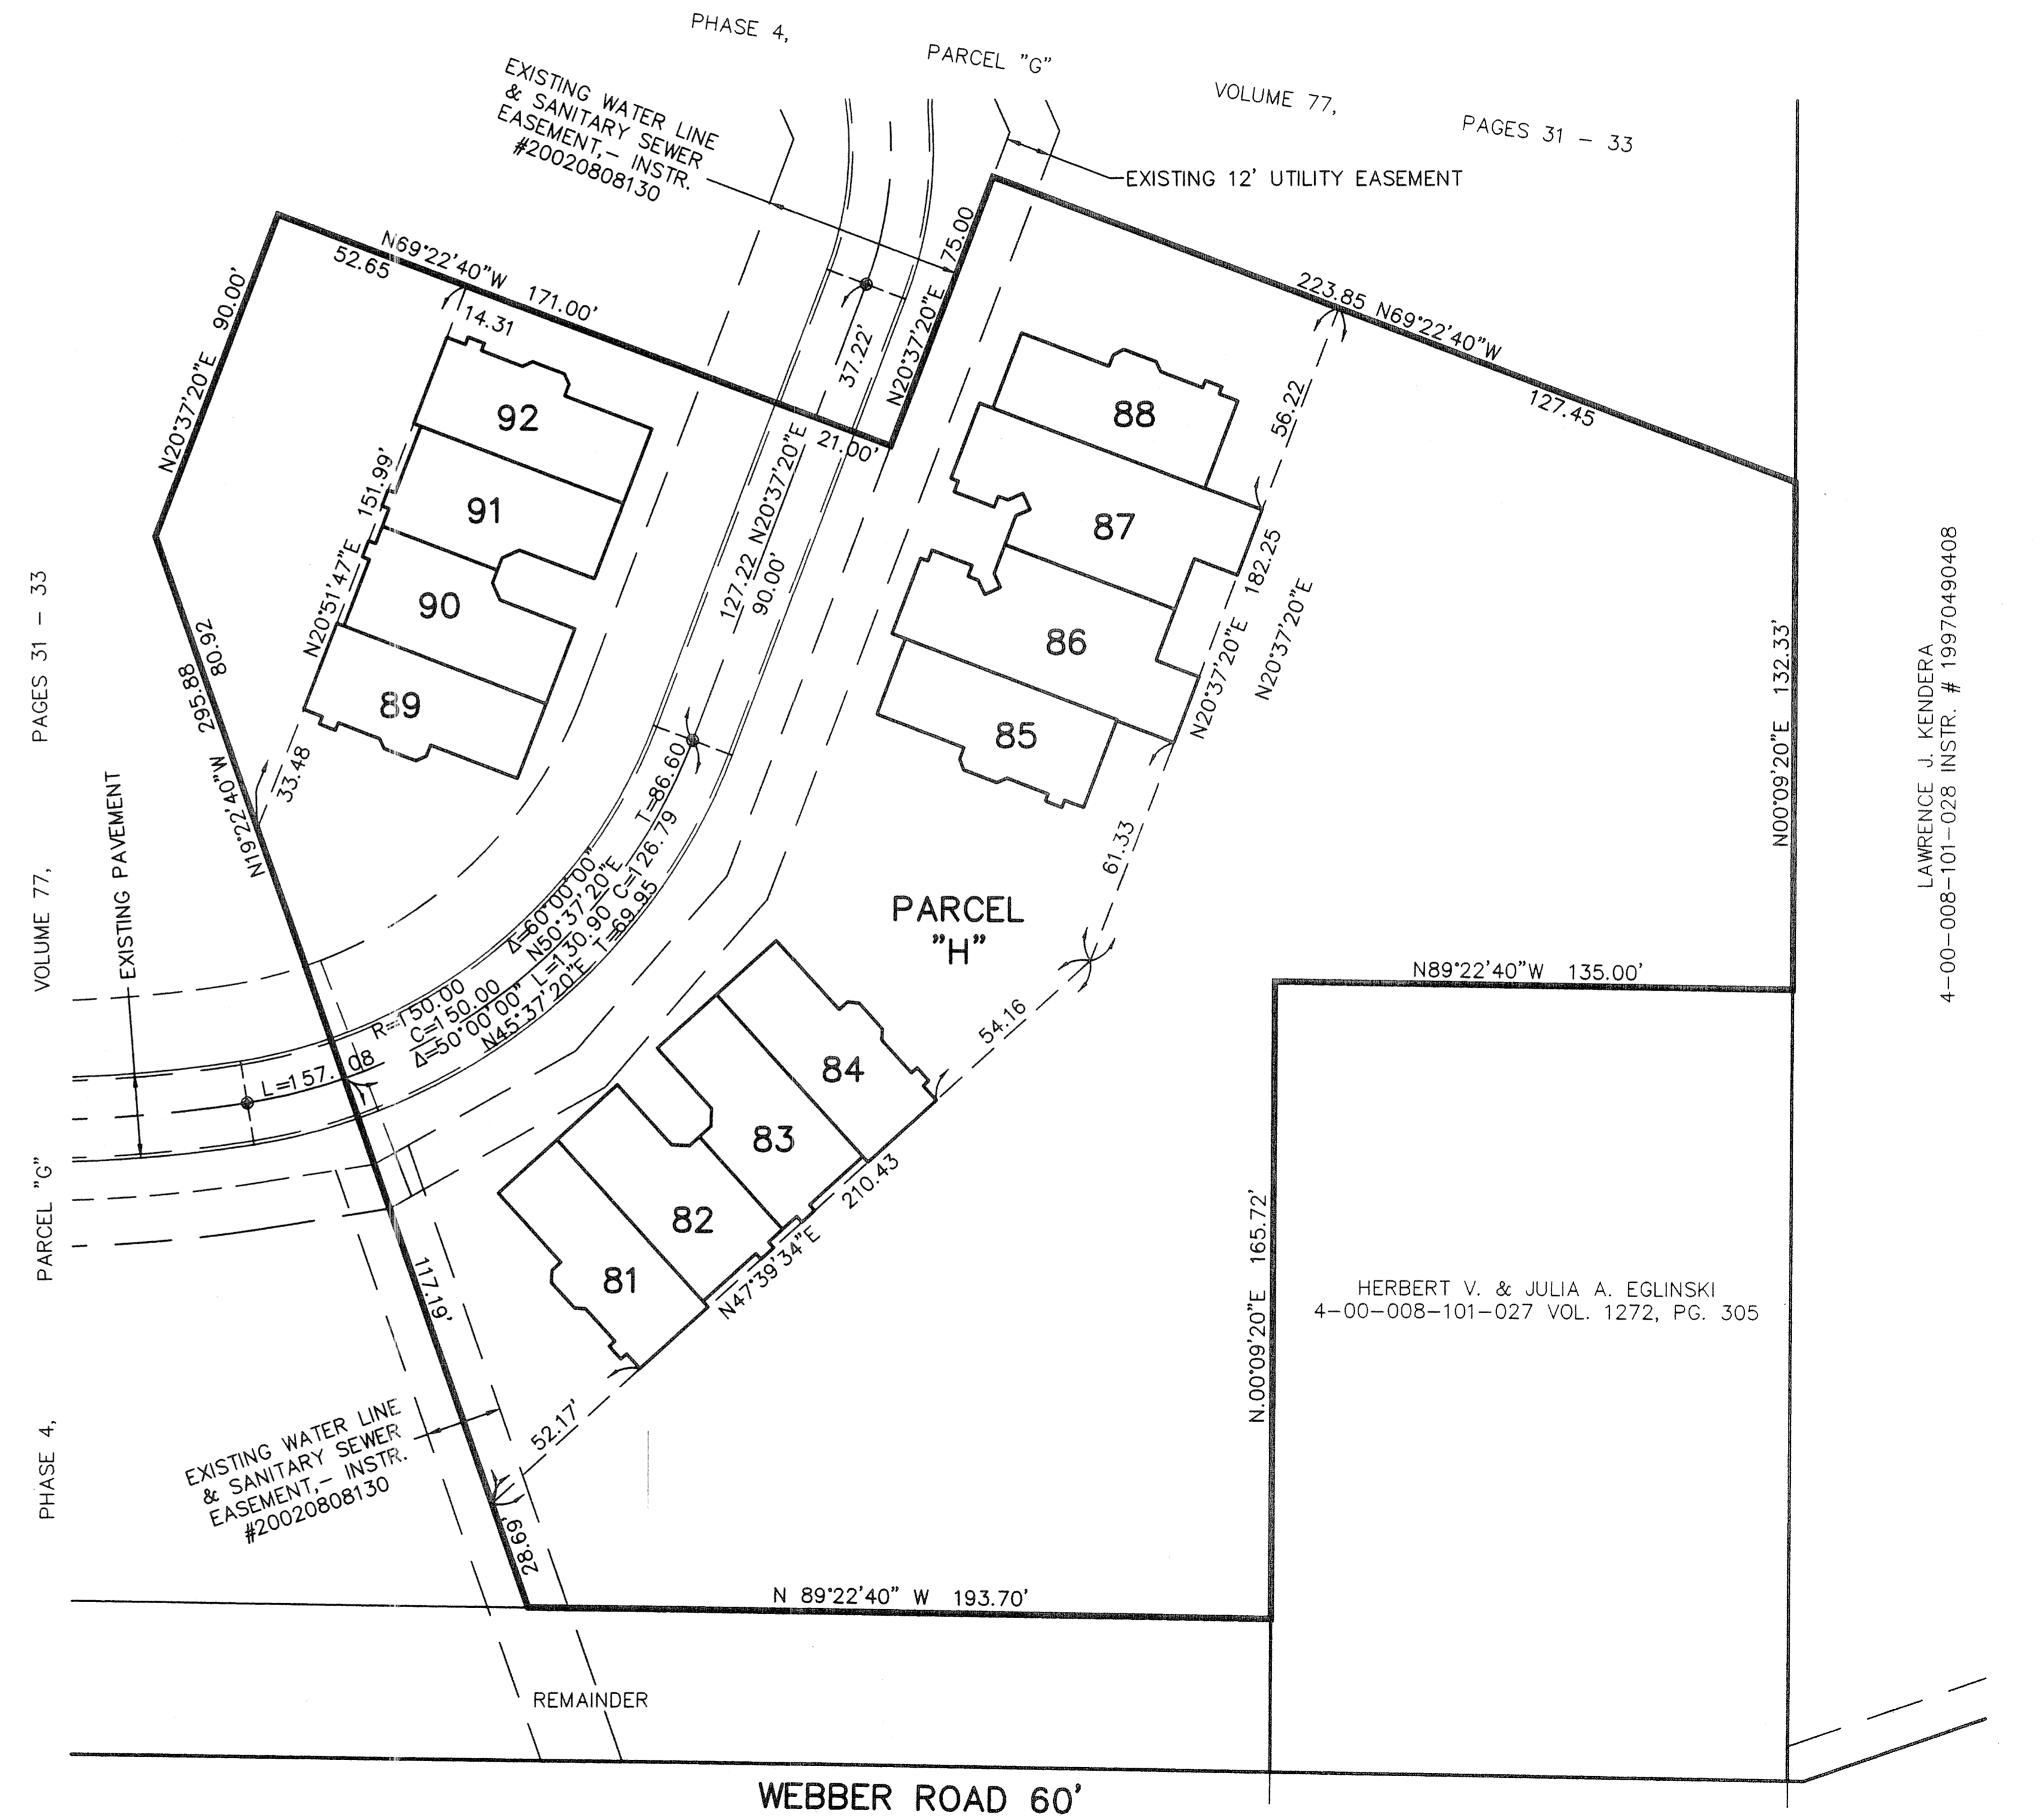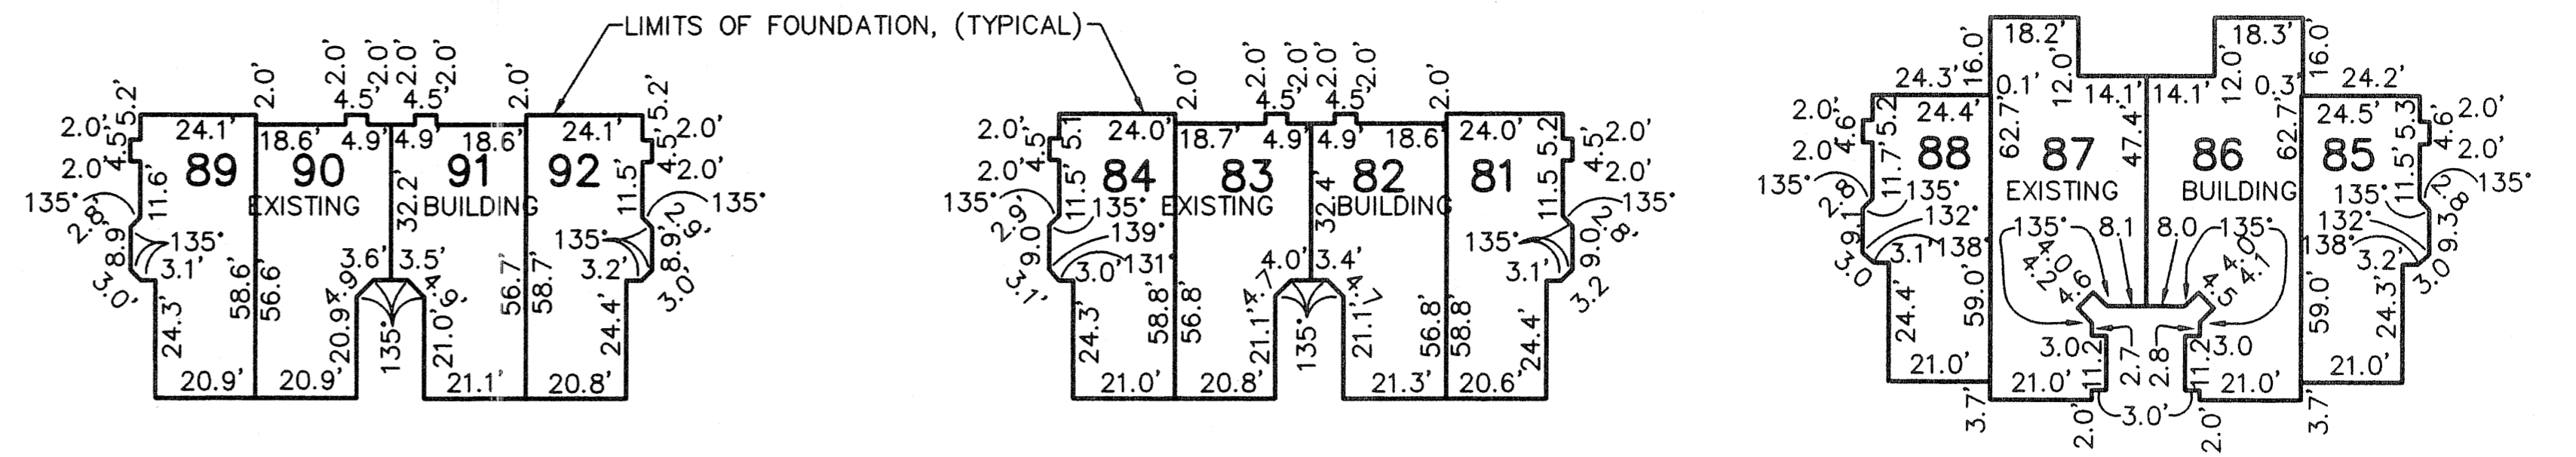

LAWRENCE J. KENDERA  
4-00-008-101-028 INSTR. # 19970490408

● DENOTES 3/8" DRILL HOLE USED

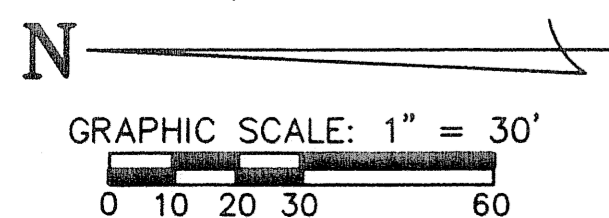

NOTES:

- 1.) ALL DIMENSIONS ARE TO THE OUTSIDE OF THE FOUNDATION WALLS.
- 2.) FOUNDATION CORNERS MEET AT 90 DEGREES, (UNLESS NOTED OTHERWISE).

REVISIONS	DATE	DESCRIPTION

**WATERSIDE CROSSINGS SOUTH  
CONDOMINIUM PHASE 5**  
OF PART OF ORIGINAL AVON TWP. SECTION NO. 8  
CITY OF AVON LAKE, LORAIN COUNTY, OHIO

**THE HENRY G. REITZ  
ENGINEERING COMPANY**  
4214 ROCKY RIVER DRIVE  
CLEVELAND, OHIO 44135  
PHONE: (216) 251-3033

2 / 2  
NOVEMBER  
2004