
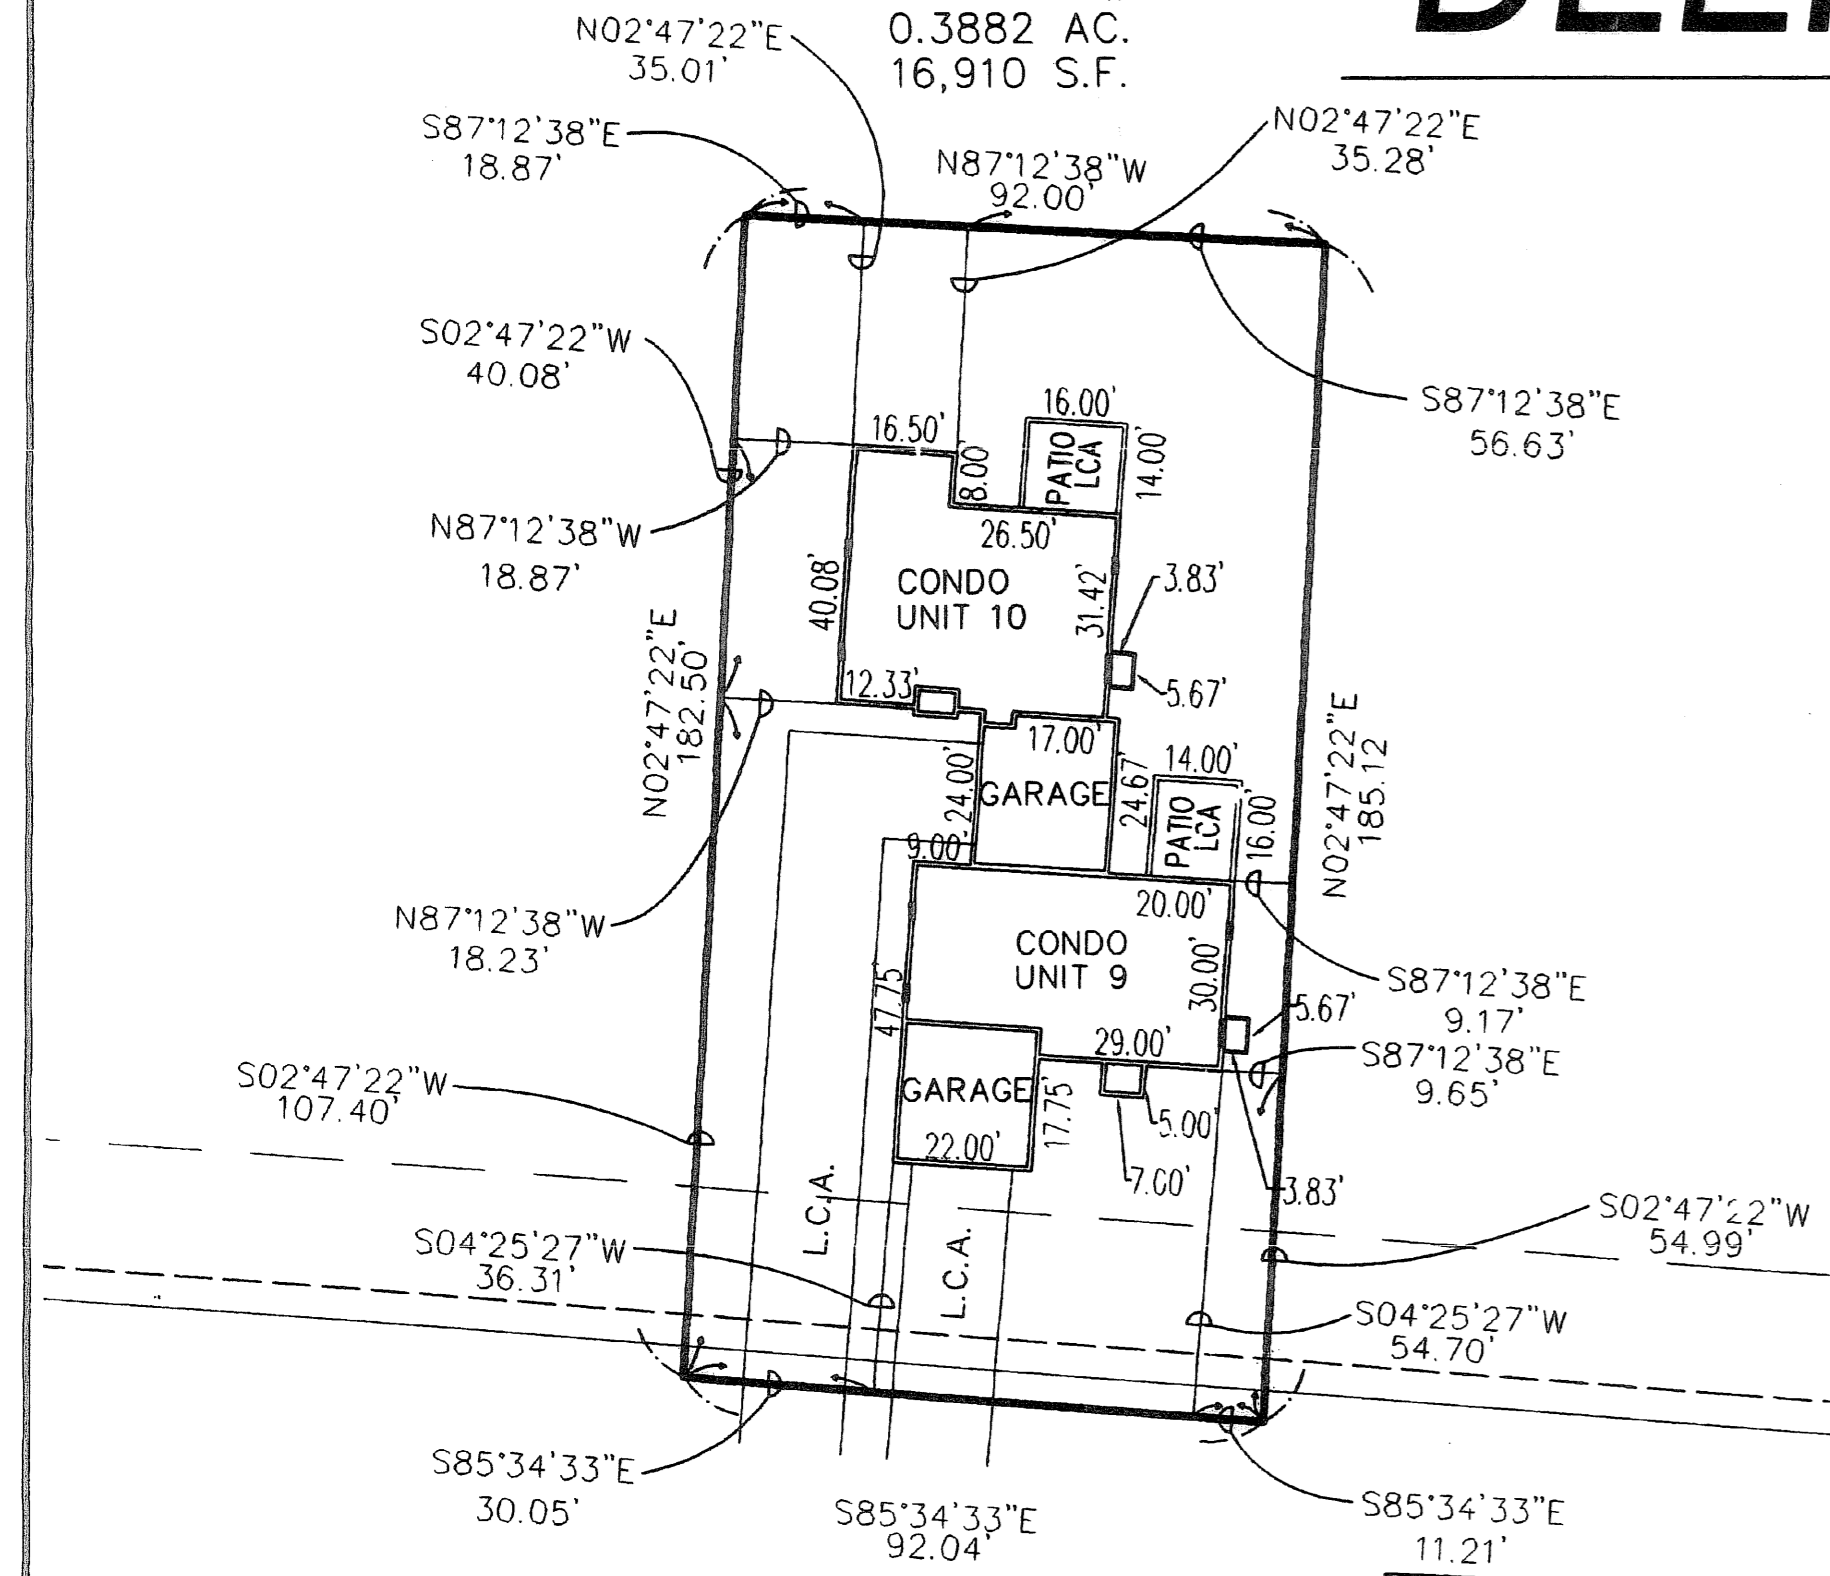


# DEER TRAIL CONDOMINIUMS PHASE #4

PART OF ORIGINAL BROWNHelm TOWNSHIP LOT 15  
 ALL OF SUBLot 32 OF HIGHLAND HEIGHTS SUBDIVISION NO. 3  
 RECORDED IN LORAIN COUNTY PLAT VOLUME 76, PAGES 76-78



SUBLot #32  
 0.3882 AC.  
 16,910 S.F.

AREA MAP - NO SCALE

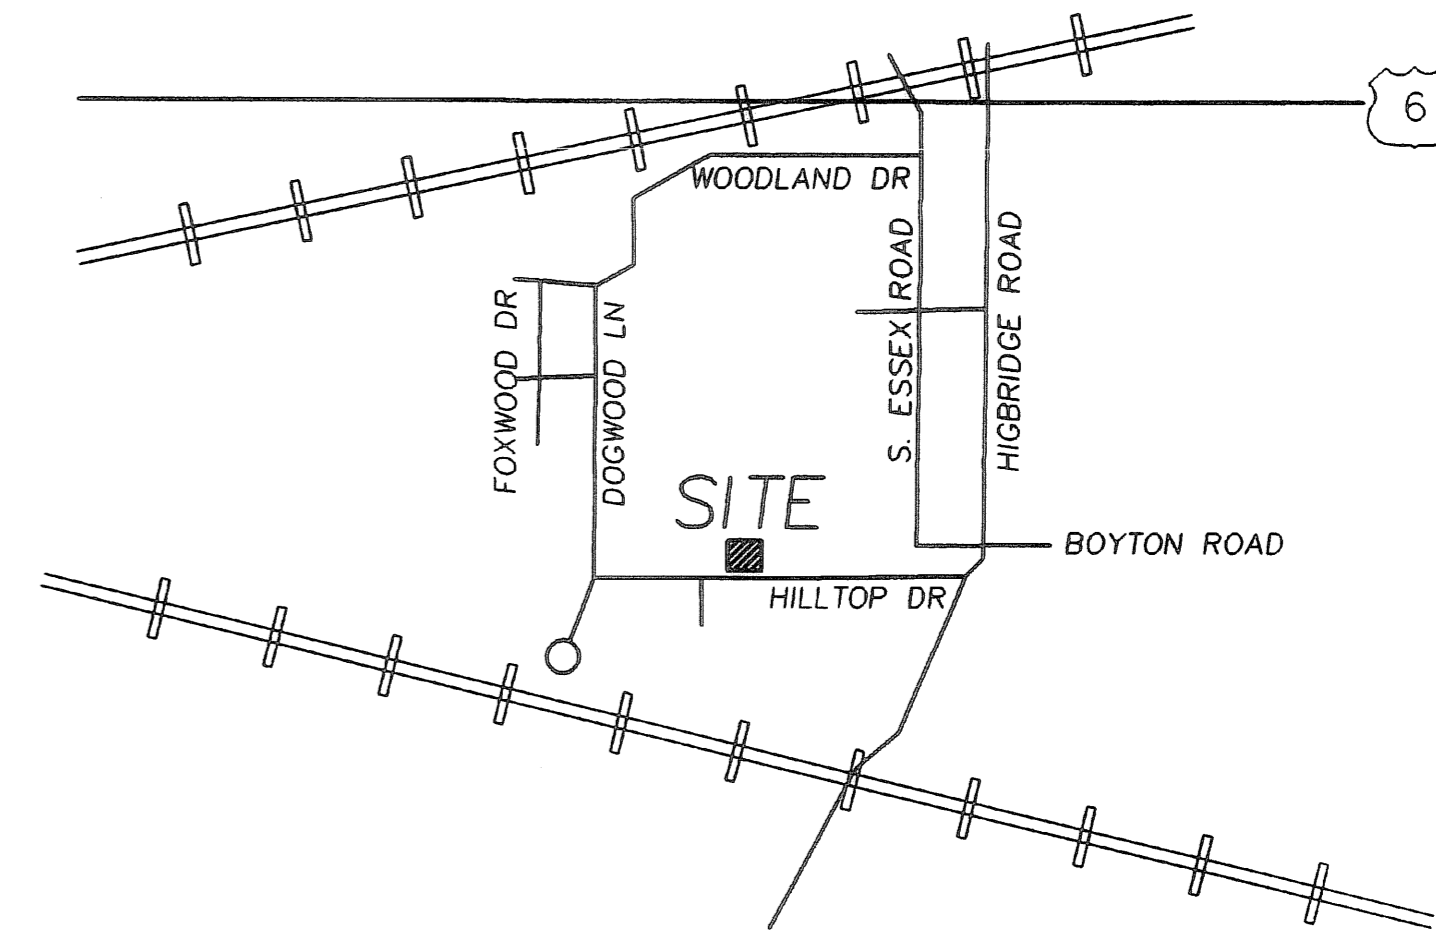

SCALE: 1" = 30'


LCA = LIMITED COMMON AREA

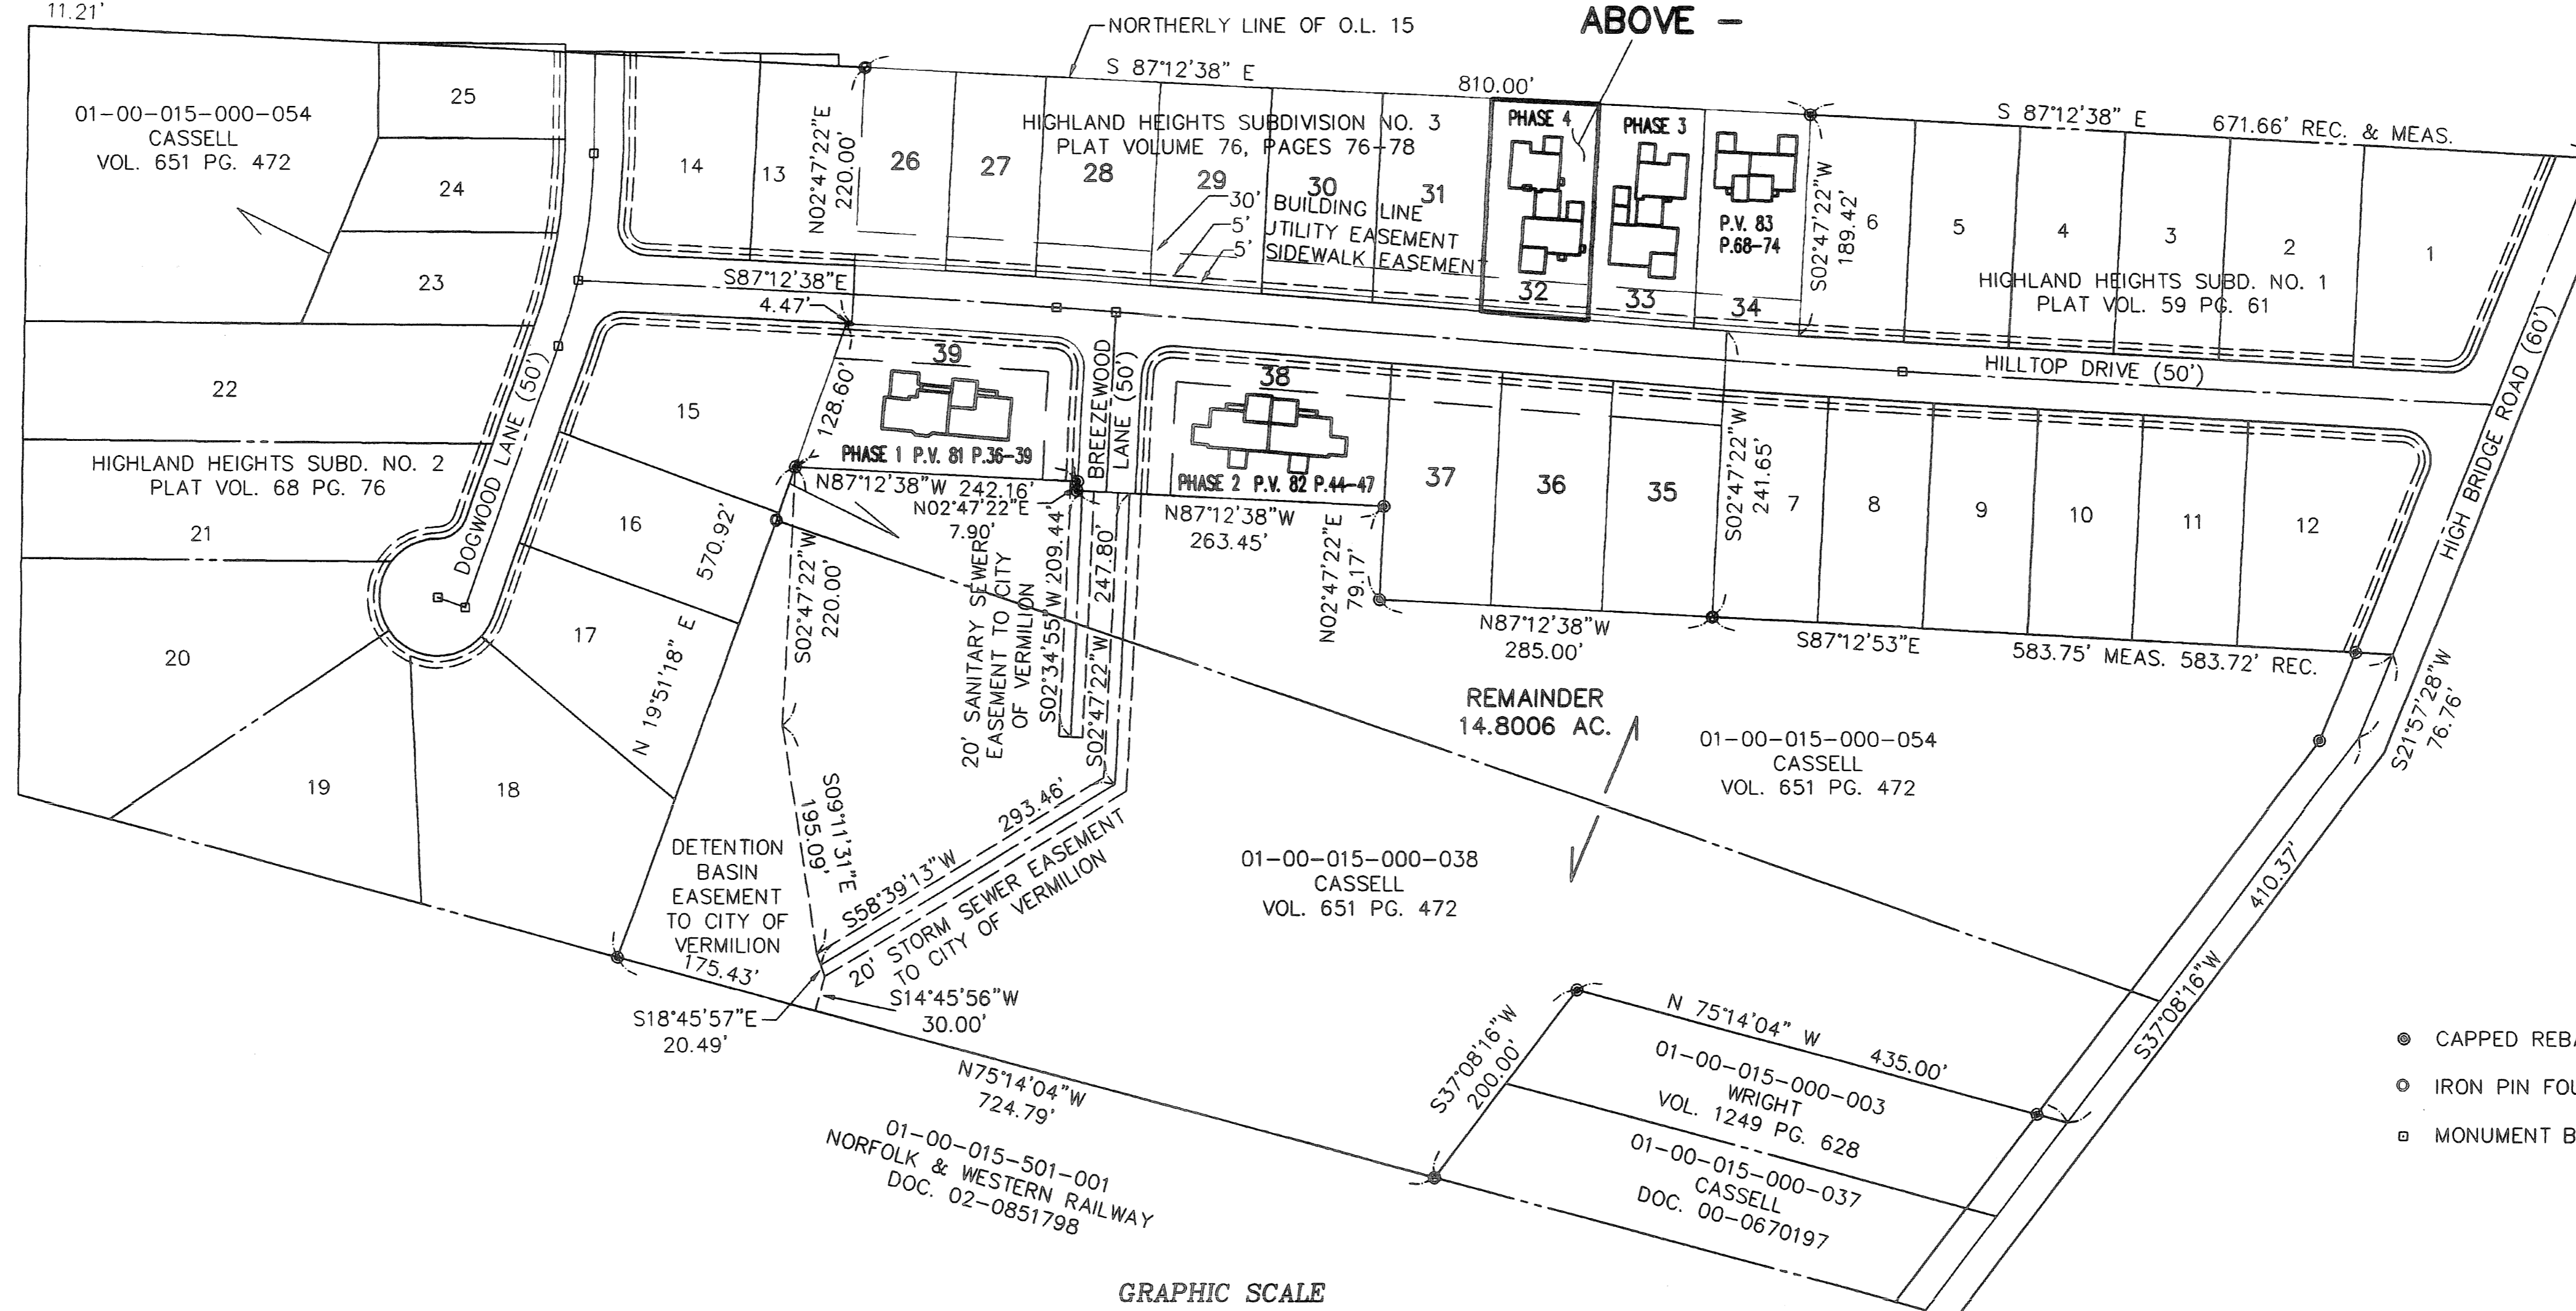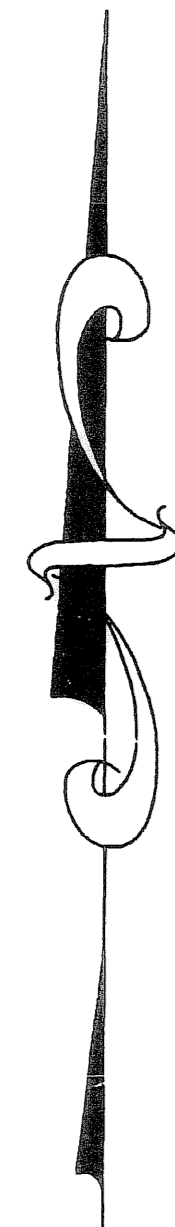

- SEE  
 DETAIL  
 ABOVE -

CERTIFICATION  
 THIS IS TO CERTIFY THAT THE ATTACHED DRAWINGS CORRECTLY  
 REPRESENTS THE BUILDING AS CONSTRUCTED AND THAT THERE  
 ARE NO ENCHROACHMENTS ON ADJUTING PROPERTIES.

*Dale Haywood 6/1/05*

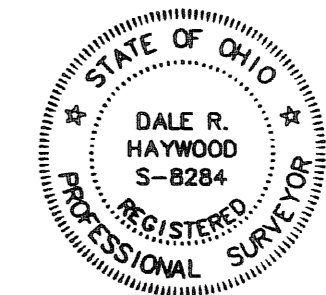

- CAPPED REBAR SET
- IRON PIN FOUND
- MONUMENT BOX FOUND


PREPARED FOR  
 KEN CASSELL  
 CASSELL REALTY  
 5425 LIBERTY AVENUE  
 VERMILION, OHIO 44089  
 (440) 967-3167


PREPARED BY

**HAYWOOD**  
 Civil Engineering & Land Surveying  
 "Committed to Service and Quality"

630 Cleveland Street Office: (440) 365-9831  
 Elyria, Ohio 44035 Fax: (440) 365-3426  
 www.haywoodcivilengineering.com

SHEET NO.	DESCRIPTION
1 OF 4	TITLE SHEET - SURVEY MAP & MISC
2 OF 4	- FOUNDATION PLAN
3 OF 4	- FLOOR PLAN
4 OF 4	- ELEVATIONS

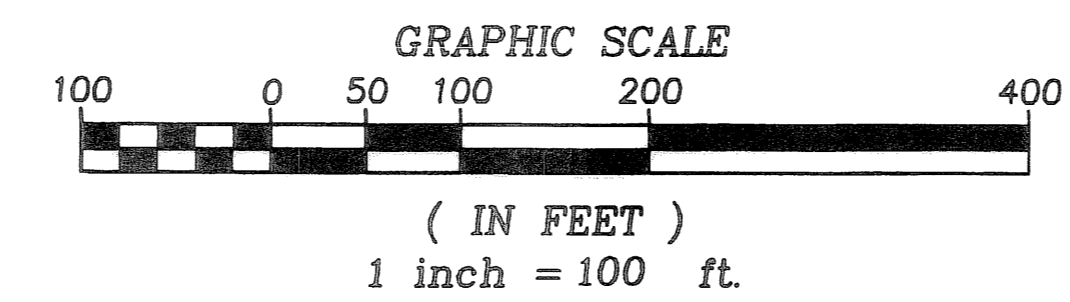


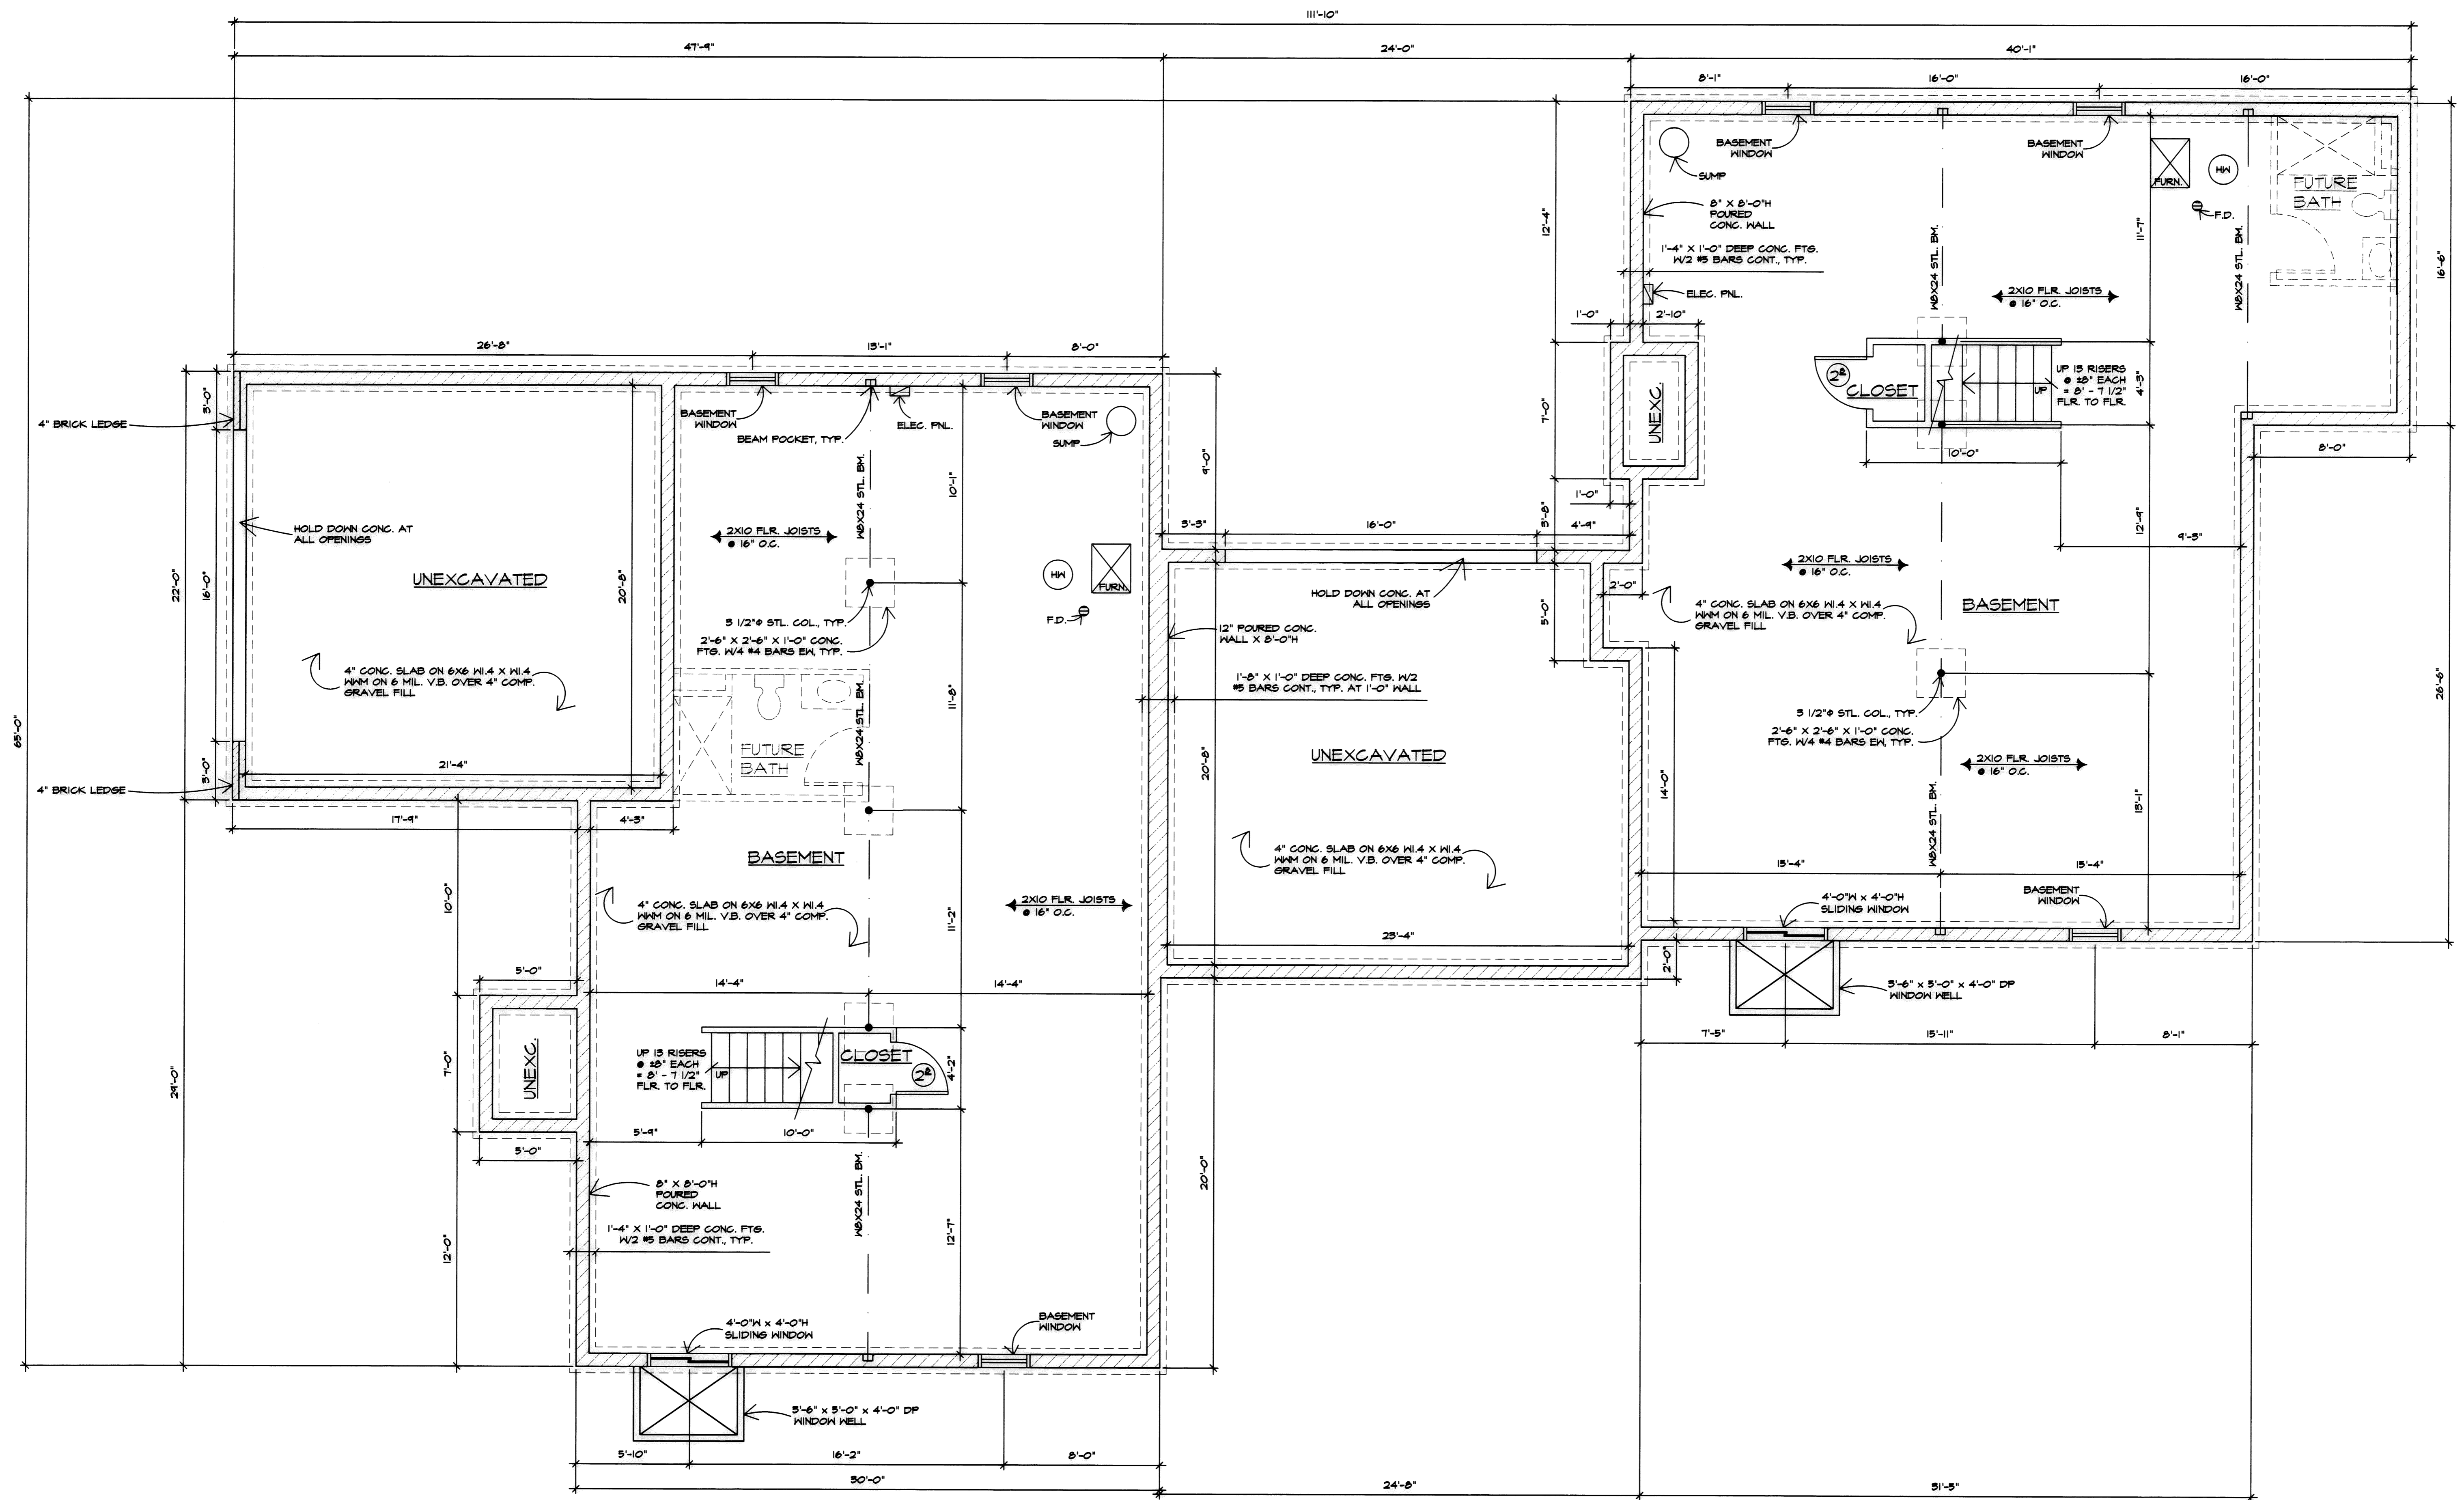

I CERTIFY THAT WITH THE EXCEPTION OF MINOR ARCHITECTURAL MODIFICATIONS MADE DURING CONSTRUCTION, THE DRAWINGS REPRESENT THE STRUCTURES AS BUILT.

*Mark W. Ruby*  
Mark W. Ruby, Architect #1159


FOUNDATION PLAN  
SCALE: 1/4"=1'-0"

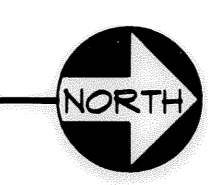

REVISIONS	BY


**MARK W. RUBY**  
ARCHITECT  
1110 COOPER FOSTER PARK ROAD  
AMHERST, OH. 44001  
(440) 986-2091

TITLE  
BUILDING #5  
DEER TRAIL  
CONDOMINIUMS

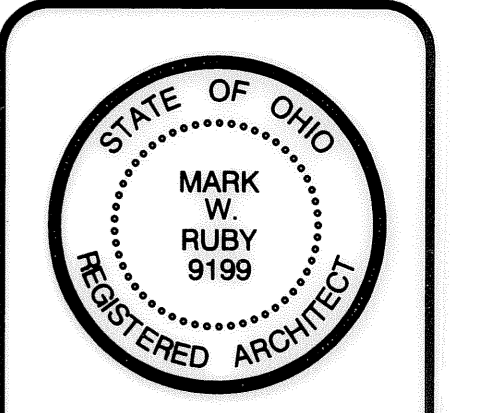

DATE 5/12/05  
PROJ. 0518  
SHEET

2 OF 4

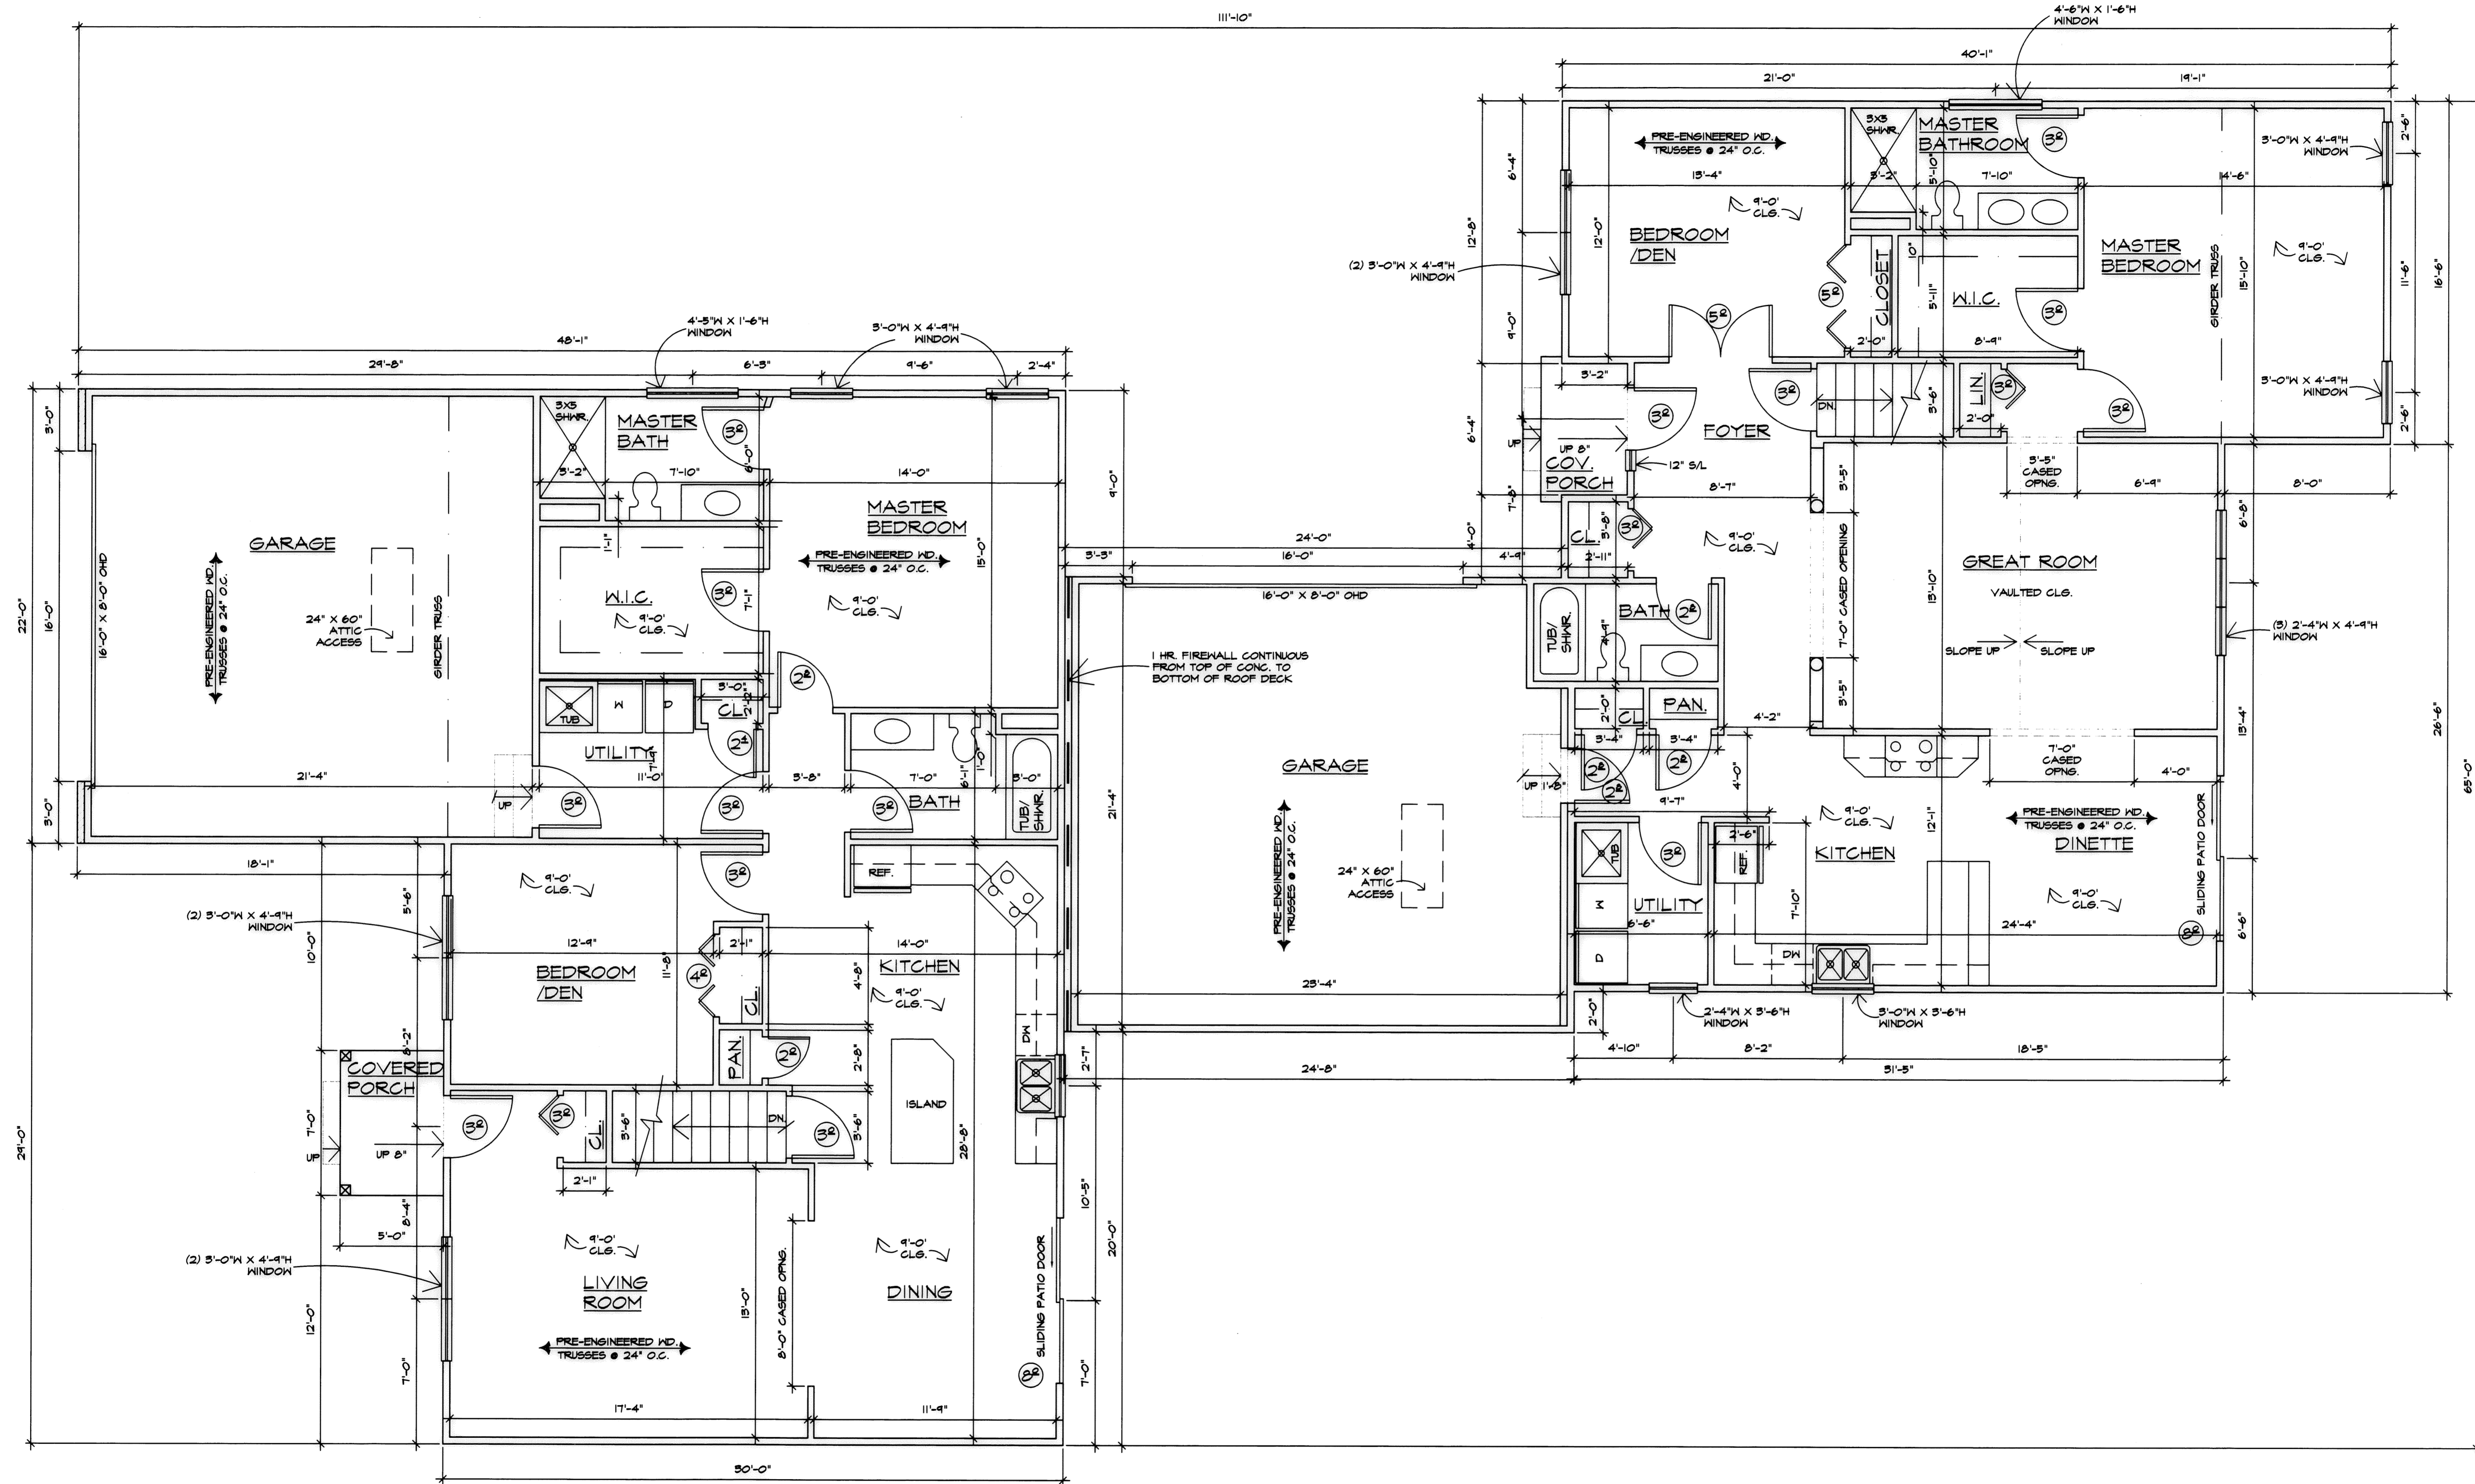

SUBLOT #32 - UNIT A	
1,442 S.F. - LIVING + GARAGE	3472 HILLTOP DRIVE

SUBLOT #32 - UNIT B	
1,498 S.F. - LIVING + GARAGE	3468 HILLTOP DRIVE

I CERTIFY THAT WITH THE EXCEPTION OF MINOR ARCHITECTURAL MODIFICATIONS MADE DURING CONSTRUCTION, THE DRAWINGS REPRESENT THE STRUCTURES AS BUILT.


*Mark W. Ruby*  
Mark W. Ruby, Architect

FLOOR PLAN  
SCALE: 1/4"=1'-0"  
NORTH

REVISIONS	BY

**MARK W. RUBY**  
ARCHITECT  
1110 COOPER FOSTER PARK ROAD  
AMHERST, OH. 44001  
(440) 966-2091

TITLE  
BUILDING #5  
DEER TRAIL  
CONDOMINIUMS

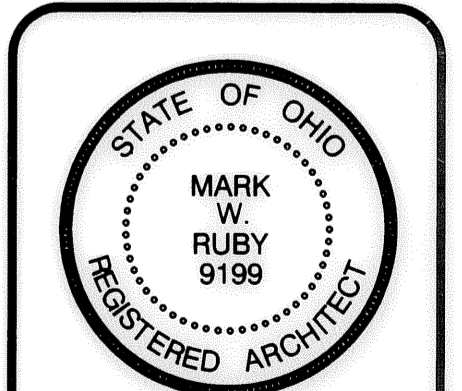


DATE 5/12/05  
PROJ. 0518  
SHEET


3 OF 4

103147 #2258


103147

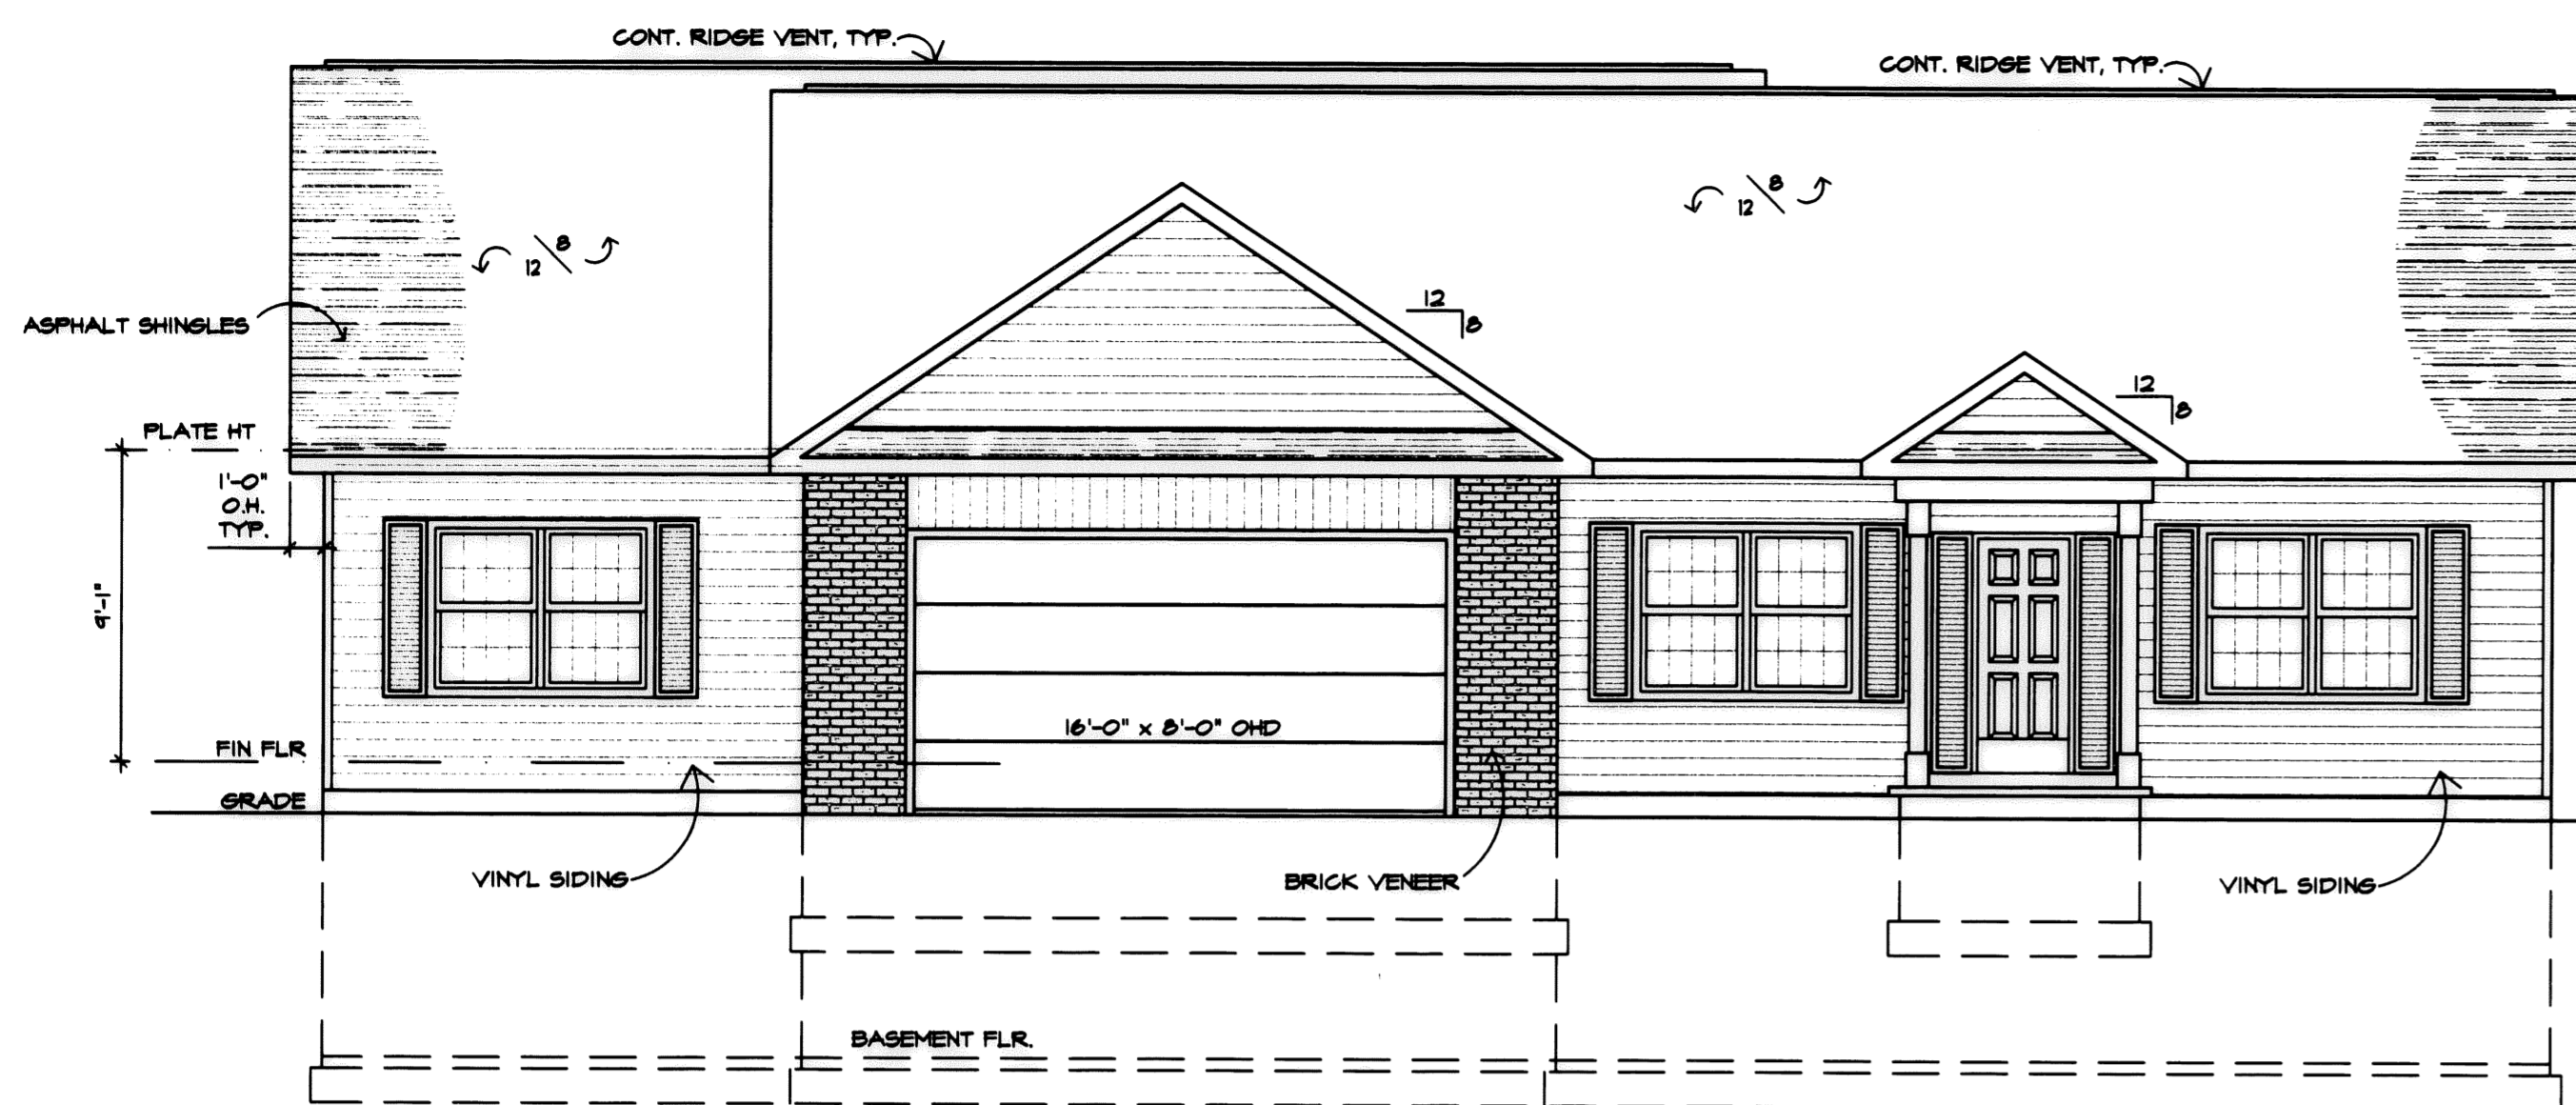


**SOUTH ELEVATION**  
SCALE: 3/16" = 1'-0"

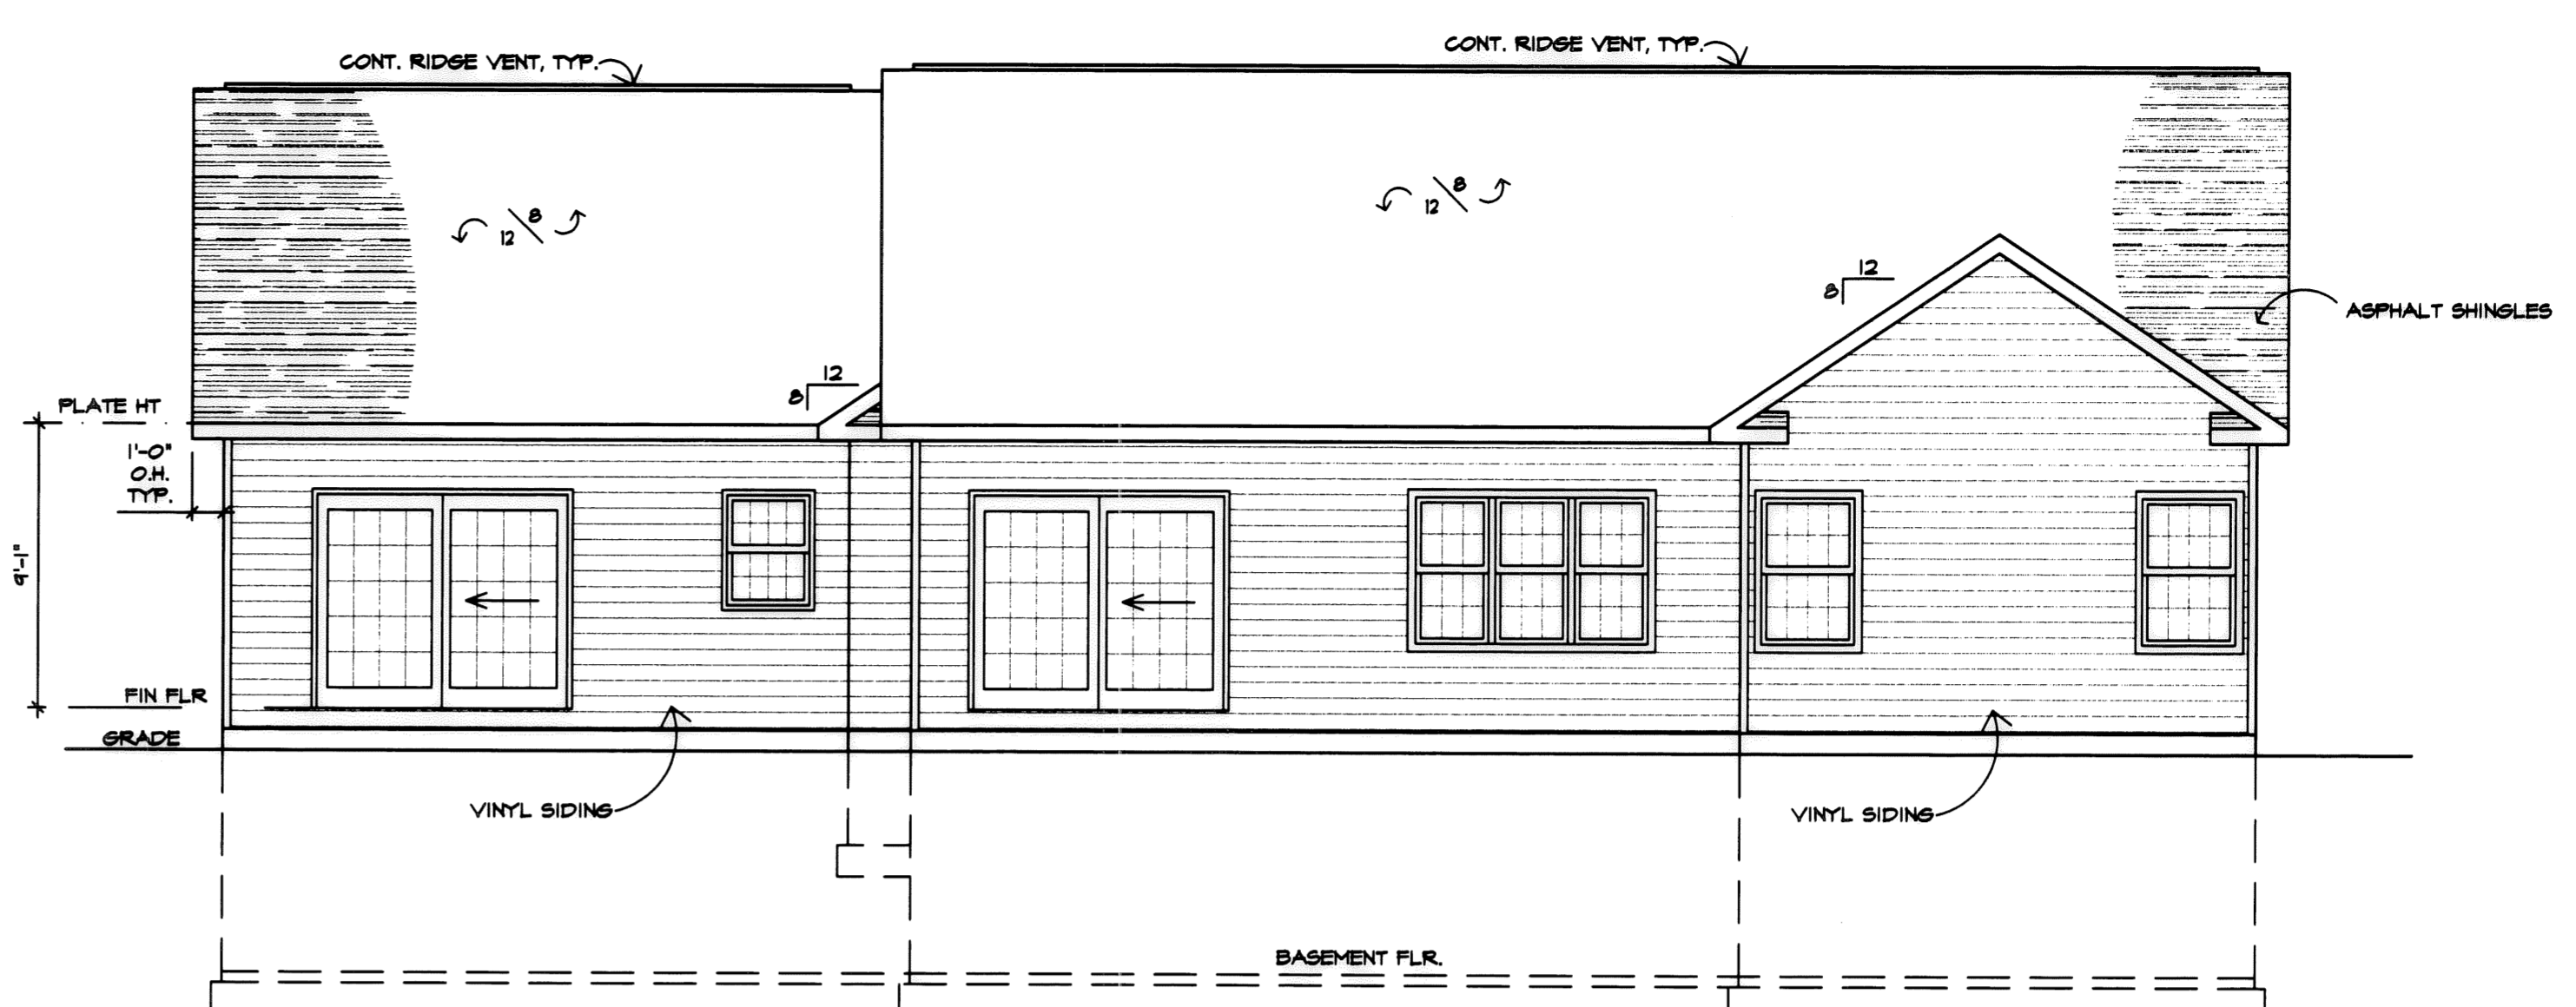

**NORTH ELEVATION**  
SCALE: 3/16" = 1'-0"

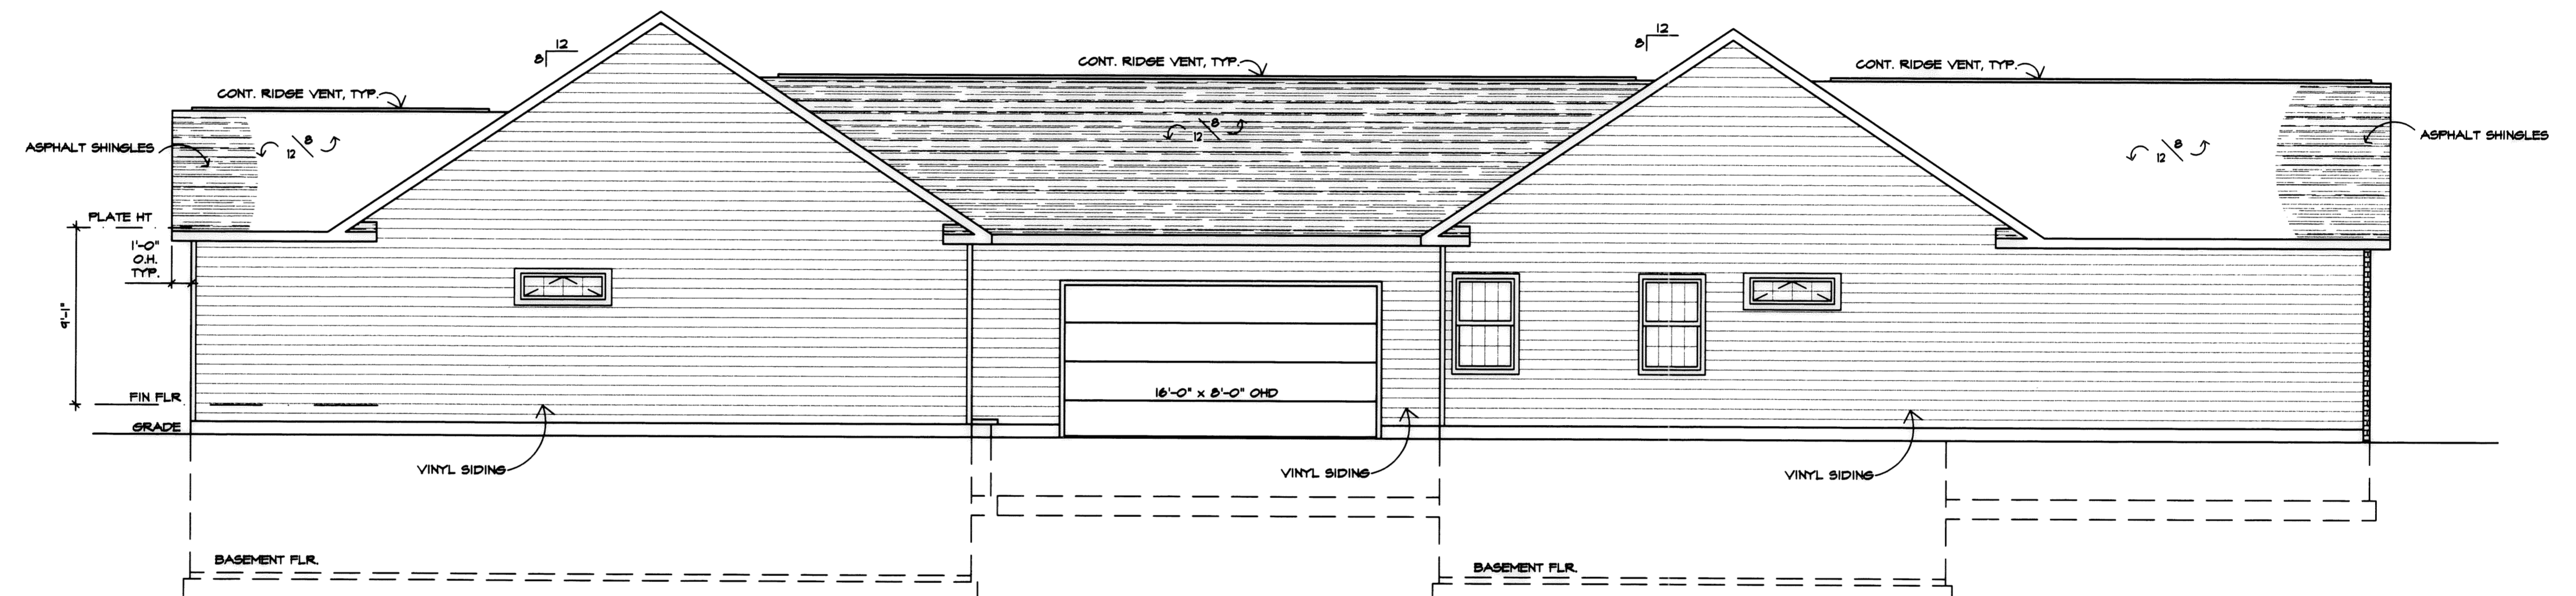

**WEST ELEVATION**  
SCALE: 3/16" = 1'-0"

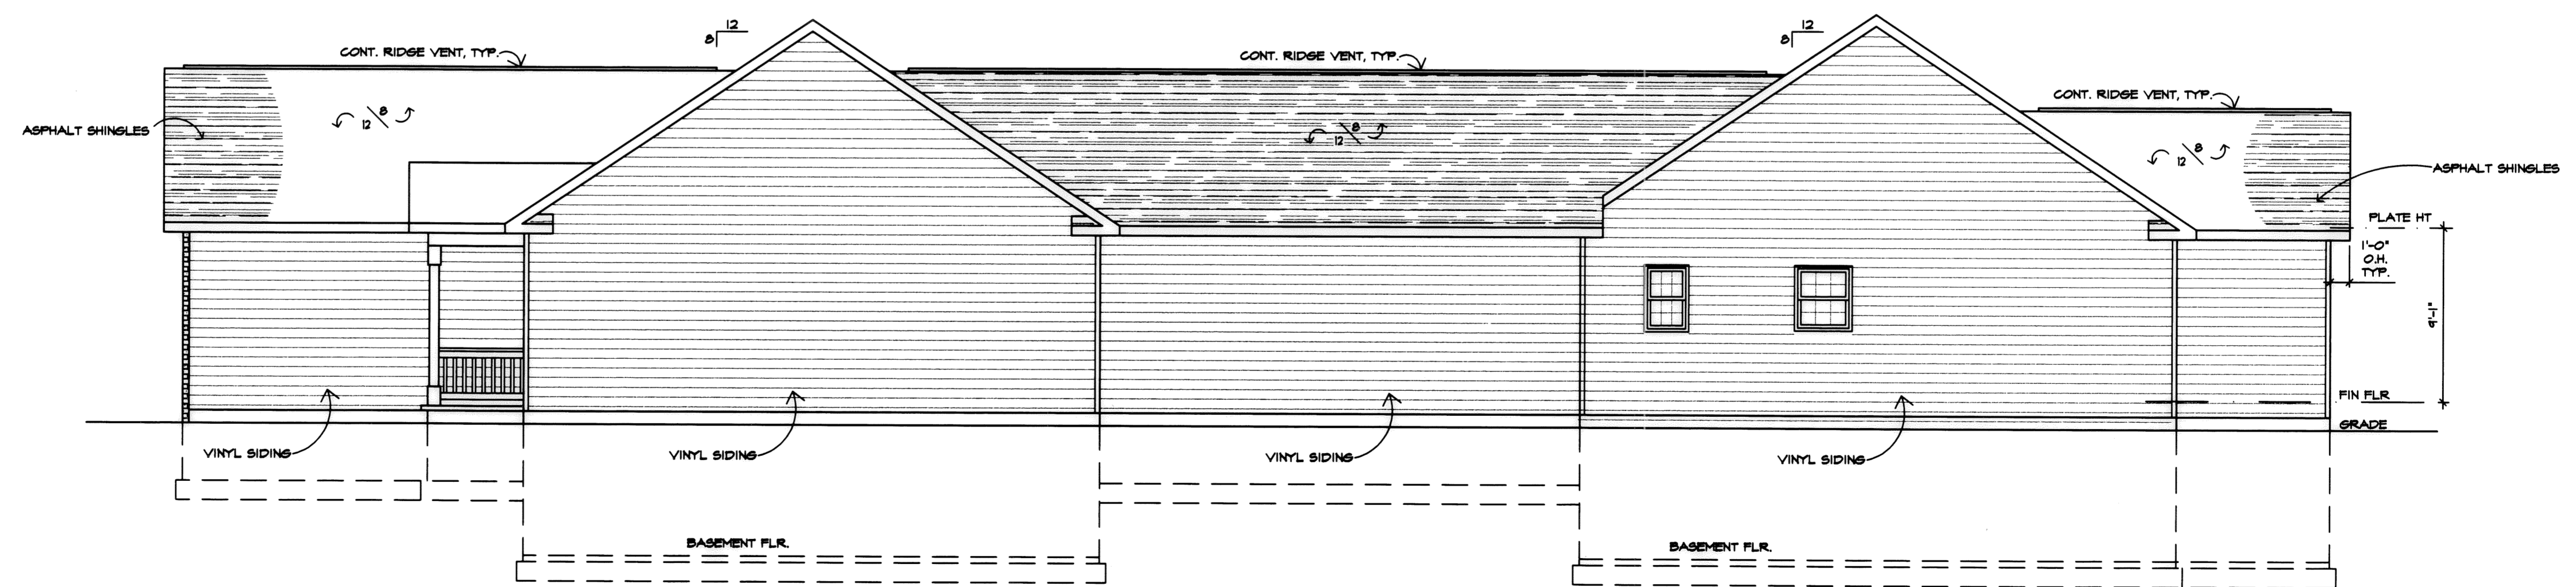

**EAST ELEVATION**  
SCALE: 3/16" = 1'-0"


I CERTIFY THAT WITH THE EXCEPTION OF MINOR ARCHITECTURAL MODIFICATIONS MADE DURING CONSTRUCTION, THE DRAWINGS REPRESENT THE STRUCTURES AS BUILT.

*Mark W. Ruby*  
Mark W. Ruby, Architect #9199

REVISIONS	BY

**MARK W. RUBY**  
ARCHITECT  
1110 COOPER FOSTER PARK ROAD  
AMHERST, OH 44001  
(440) 986-2091

BUILDING #5  
**DEER TRAIL**  
CONDOMINIUMS

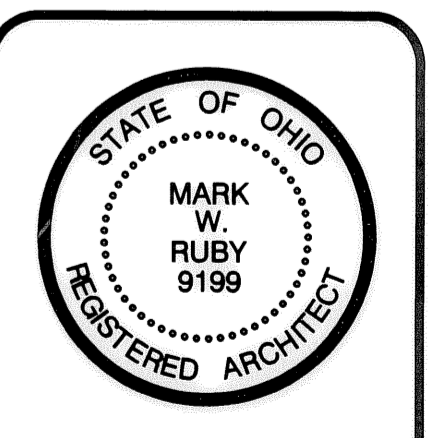

DATE 5/12/05  
PROJ. 0518  
SHEET

4 OF 4

Tax Map Dept. Copy # 05-00878

8718