





DEER TRAIL CONDOMINIUMS PHASE #5

PART OF ORIGINAL BROWNHelm TOWNSHIP LOT 15
 ALL OF SUBLot 35 OF HIGHLAND HEIGHTS SUBDIVISION NO. 3
 RECORDED IN LORAIN COUNTY PLAT VOLUME 76, PAGES 76-78
 COUNTY OF LORAIN, STATE OF OHIO

SUBLot #35
 0.4206 AC.
 18,320 S.F.

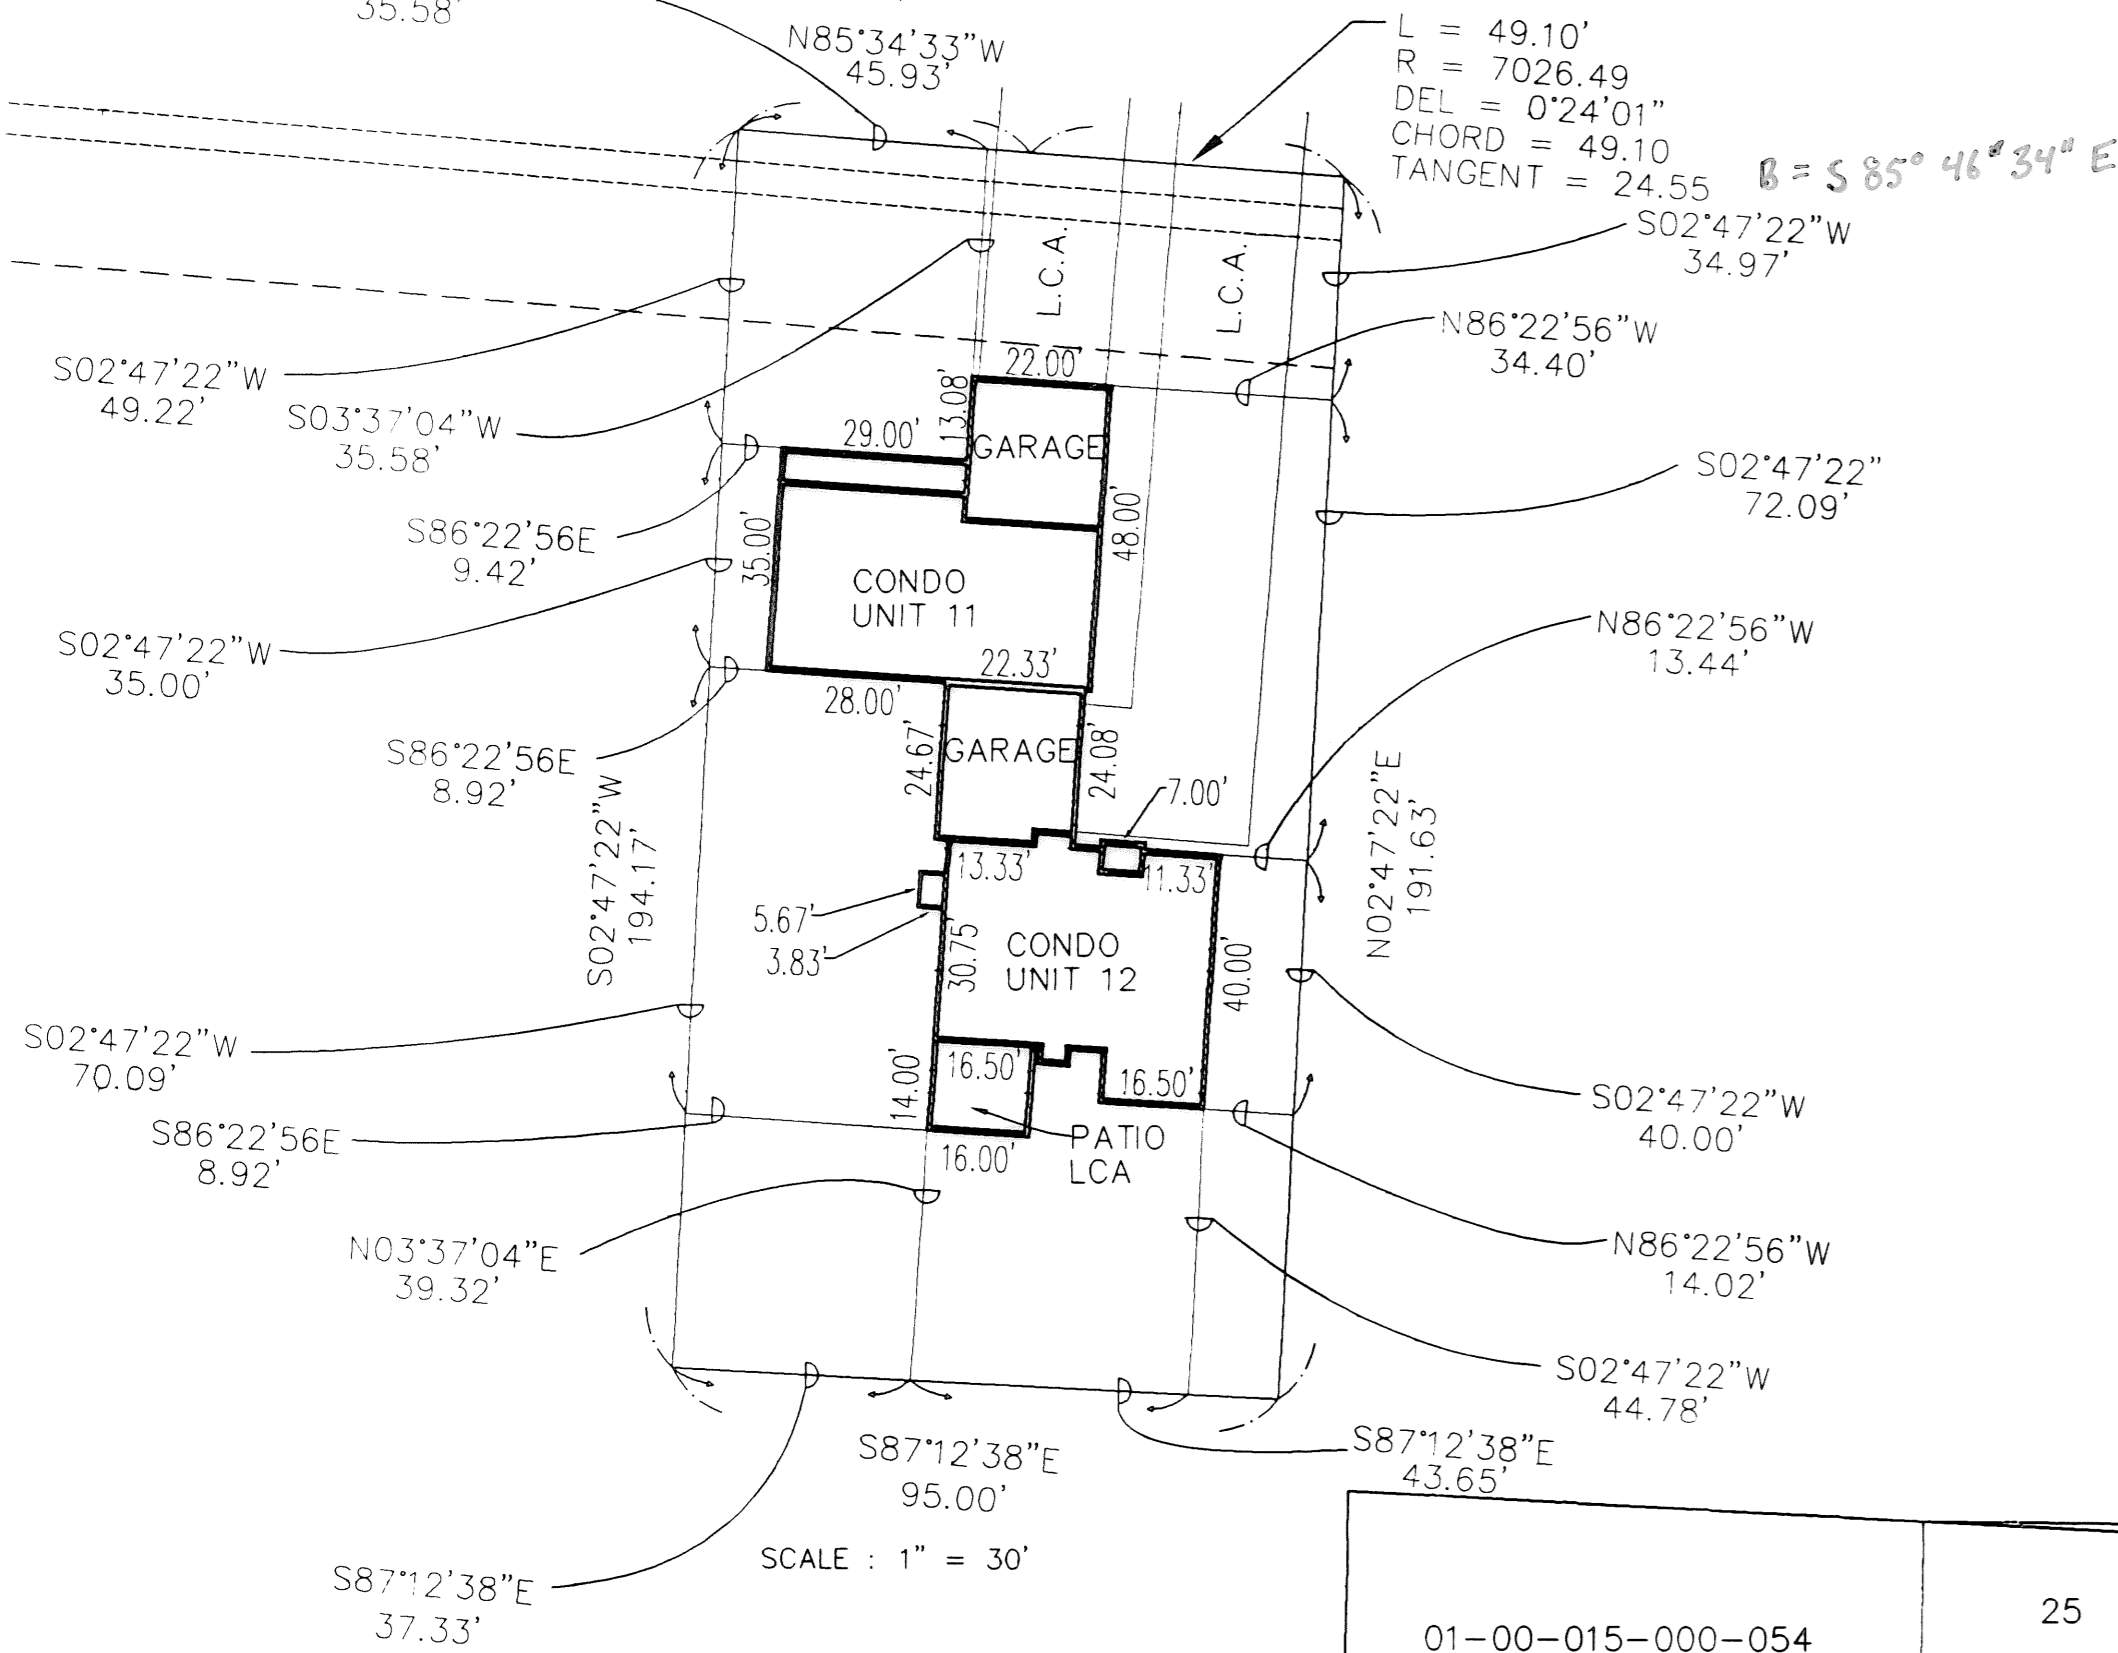


AREA MAP - NO SCALE

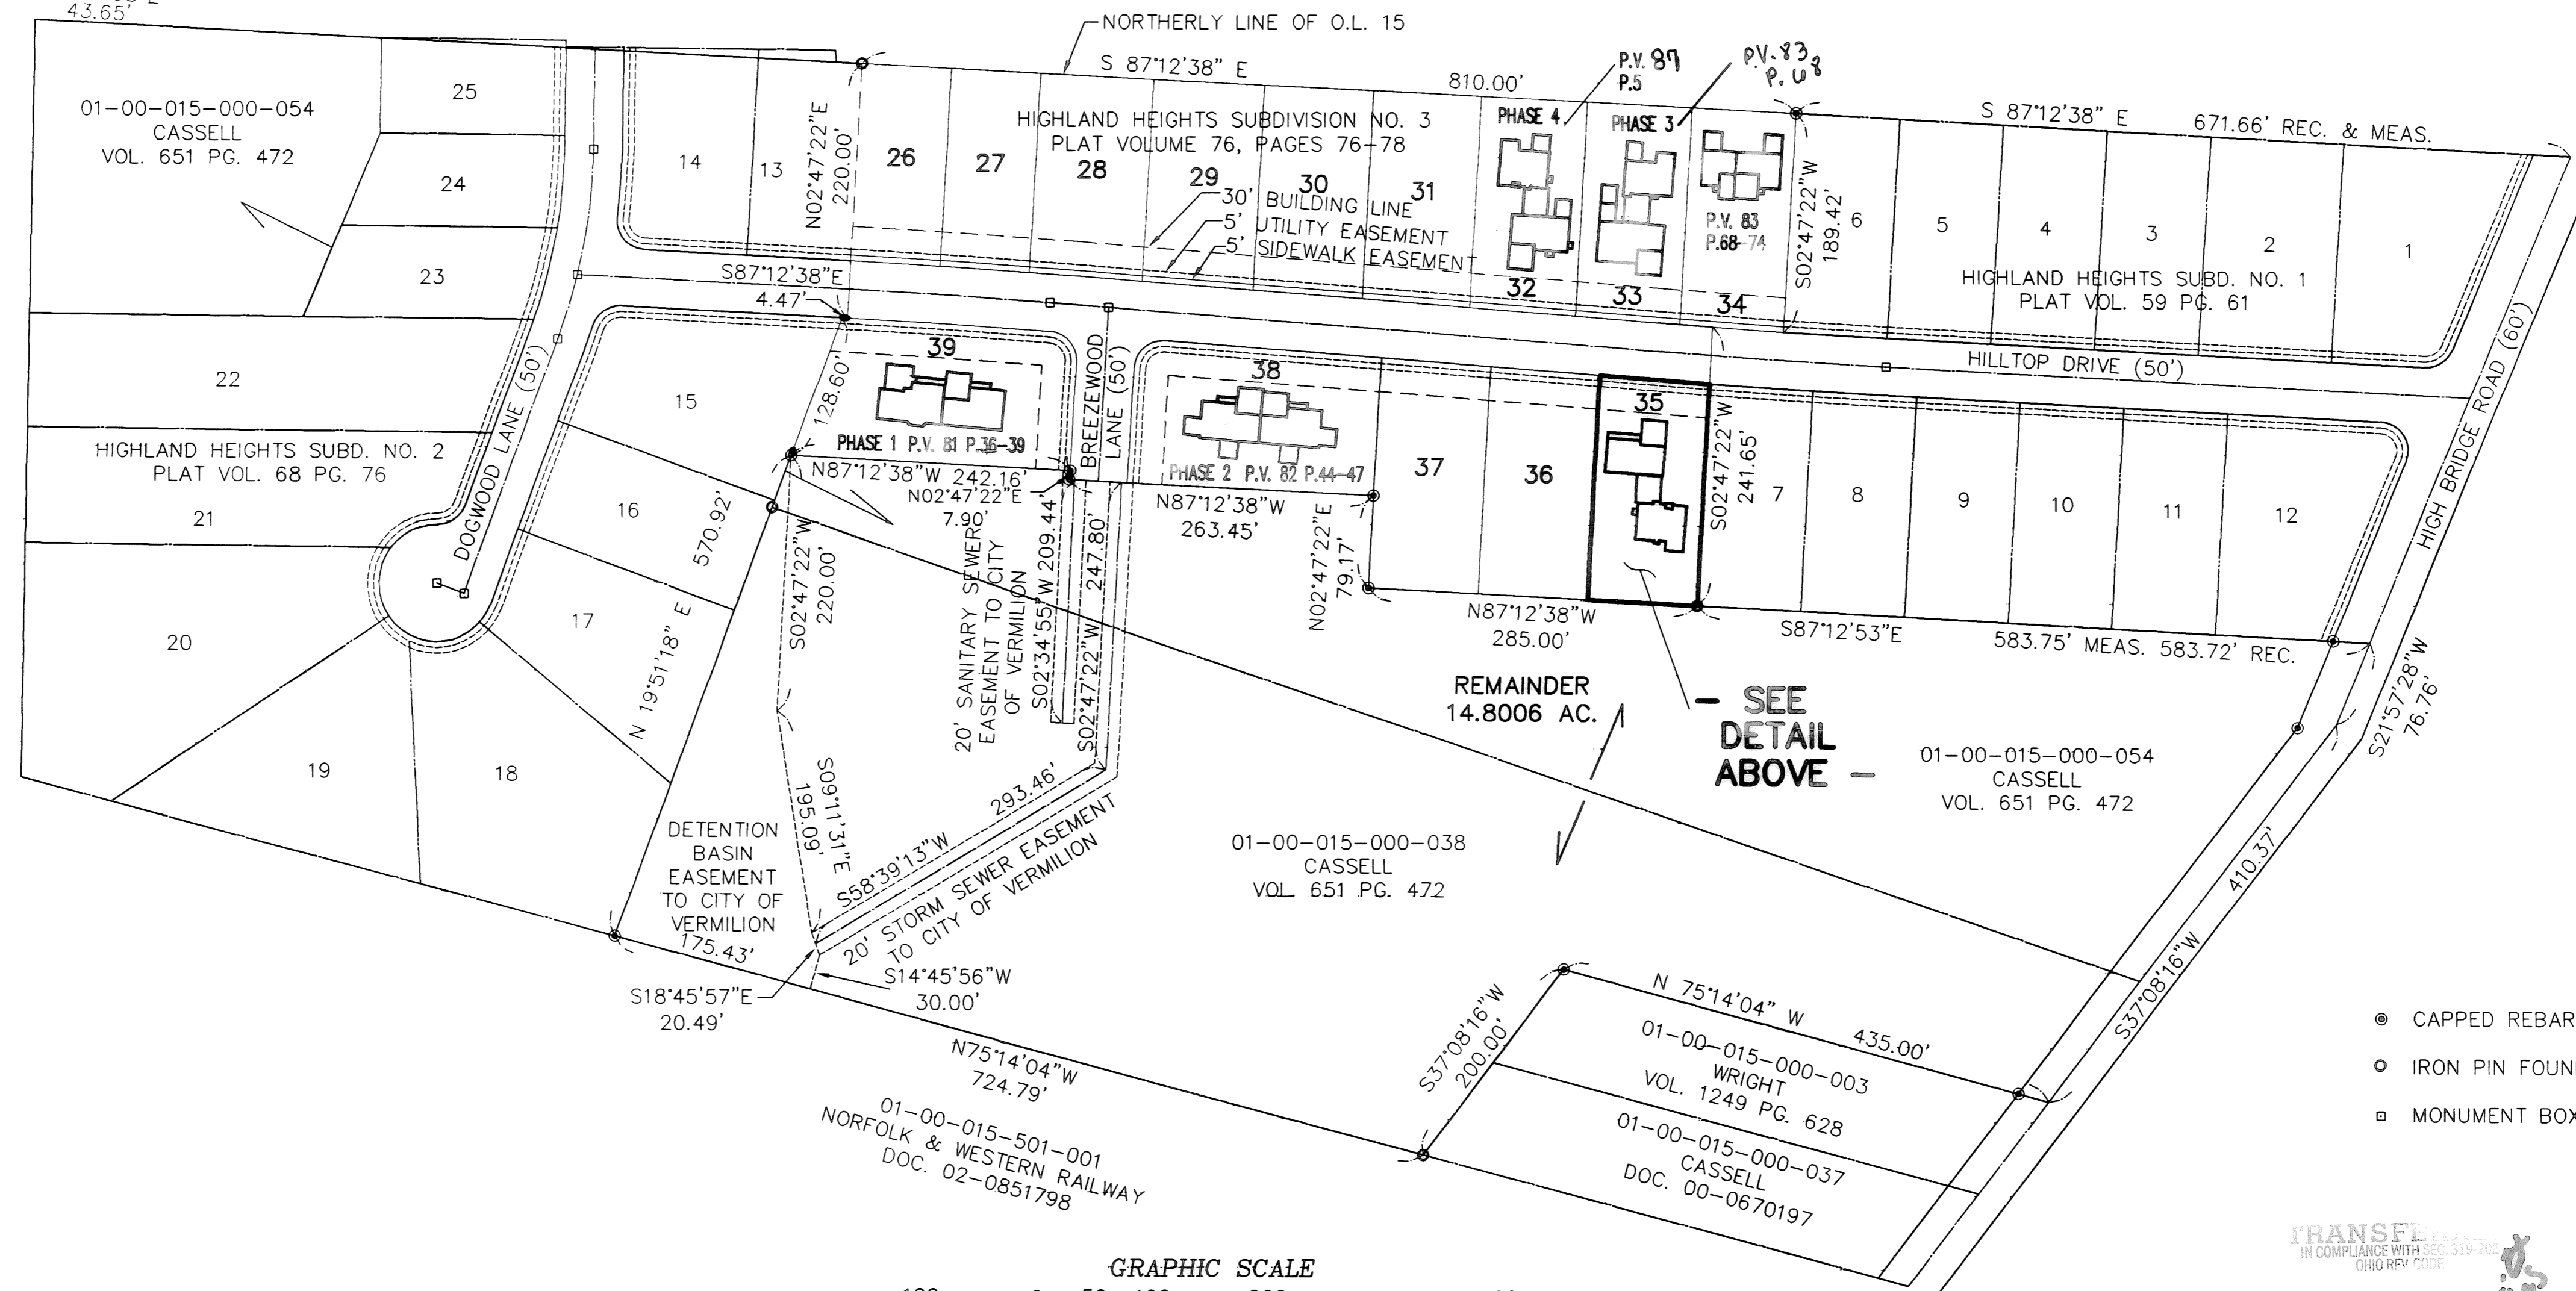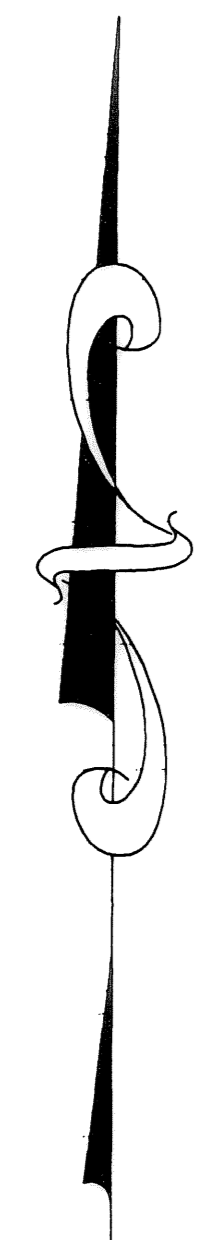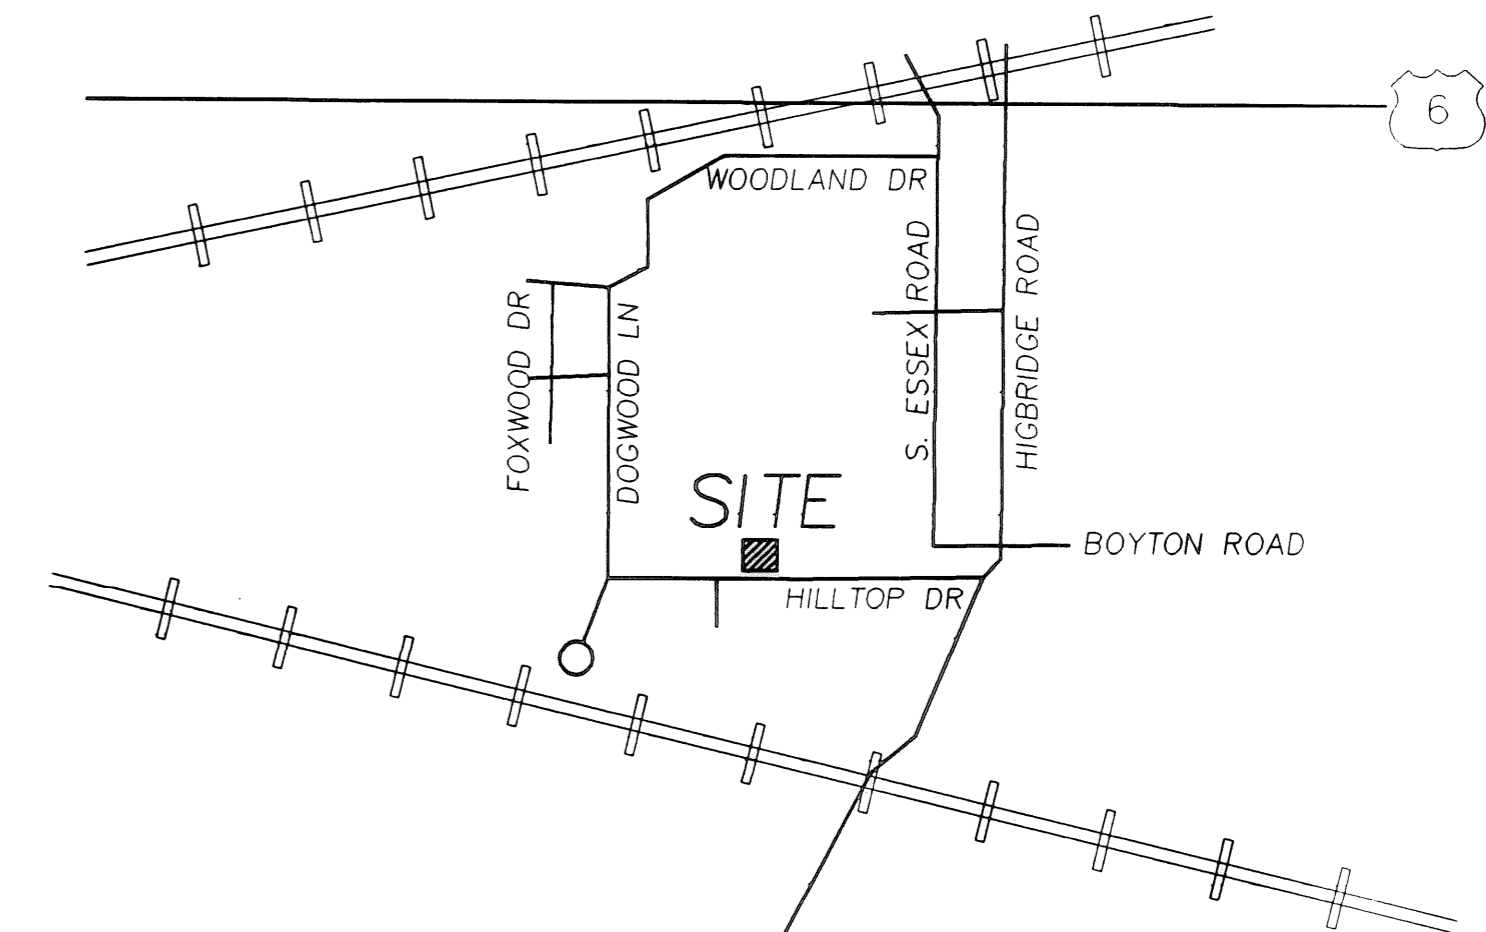

CERTIFICATION
 THIS IS TO CERTIFY THAT THE ATTACHED DRAWINGS CORRECTLY REPRESENTS THE BUILDING AS CONSTRUCTED AND THAT THERE ARE NO ENCHROACHMENTS ON ADJACENT PROPERTIES.

Dale Haywood 1/10/06

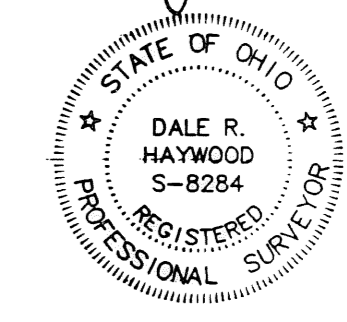

- CAPPED REBAR SET
- IRON PIN FOUND
- MONUMENT BOX FOUND


PREPARED FOR
 KEN CASSELL
 CASSELL REALTY
 5425 LIBERTY AVENUE
 VERMILION, OHIO 44089
 (440) 967-3167


TRANSFERRED
 IN COMPLIANCE WITH SEC. 319.02 OF
 OHIO REV. CODE
 FEB 15 2006
 MARK R. STEWART
 LORAIN COUNTY AUDITOR

PREPARED BY
HAYWOOD
 Civil Engineering & Land Surveying
 "Committed to Service and Quality"

475 N. Abbe Rd. Office: (440) 365-9831
 Elyria, Ohio 44035 Fax: (440) 365-3426
 www.haywoodcivilengineering.com

SHEET NO.	DESCRIPTION
1 OF 4	TITLE SHEET - SURVEY MAP & MISC
2 OF 4	- FOUNDATION PLAN
3 OF 4	- FLOOR PLAN
4 OF 4	- ELEVATIONS

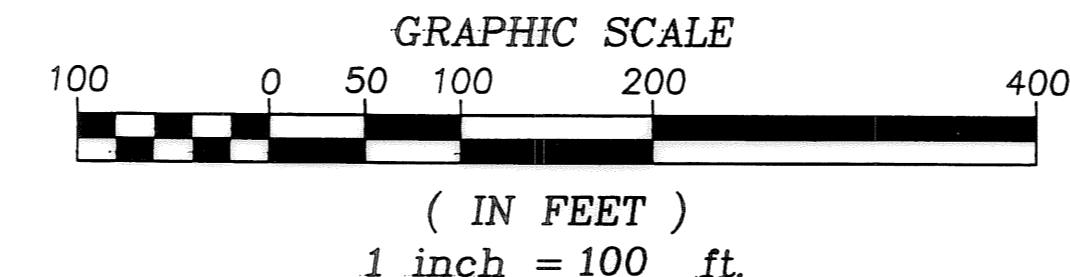

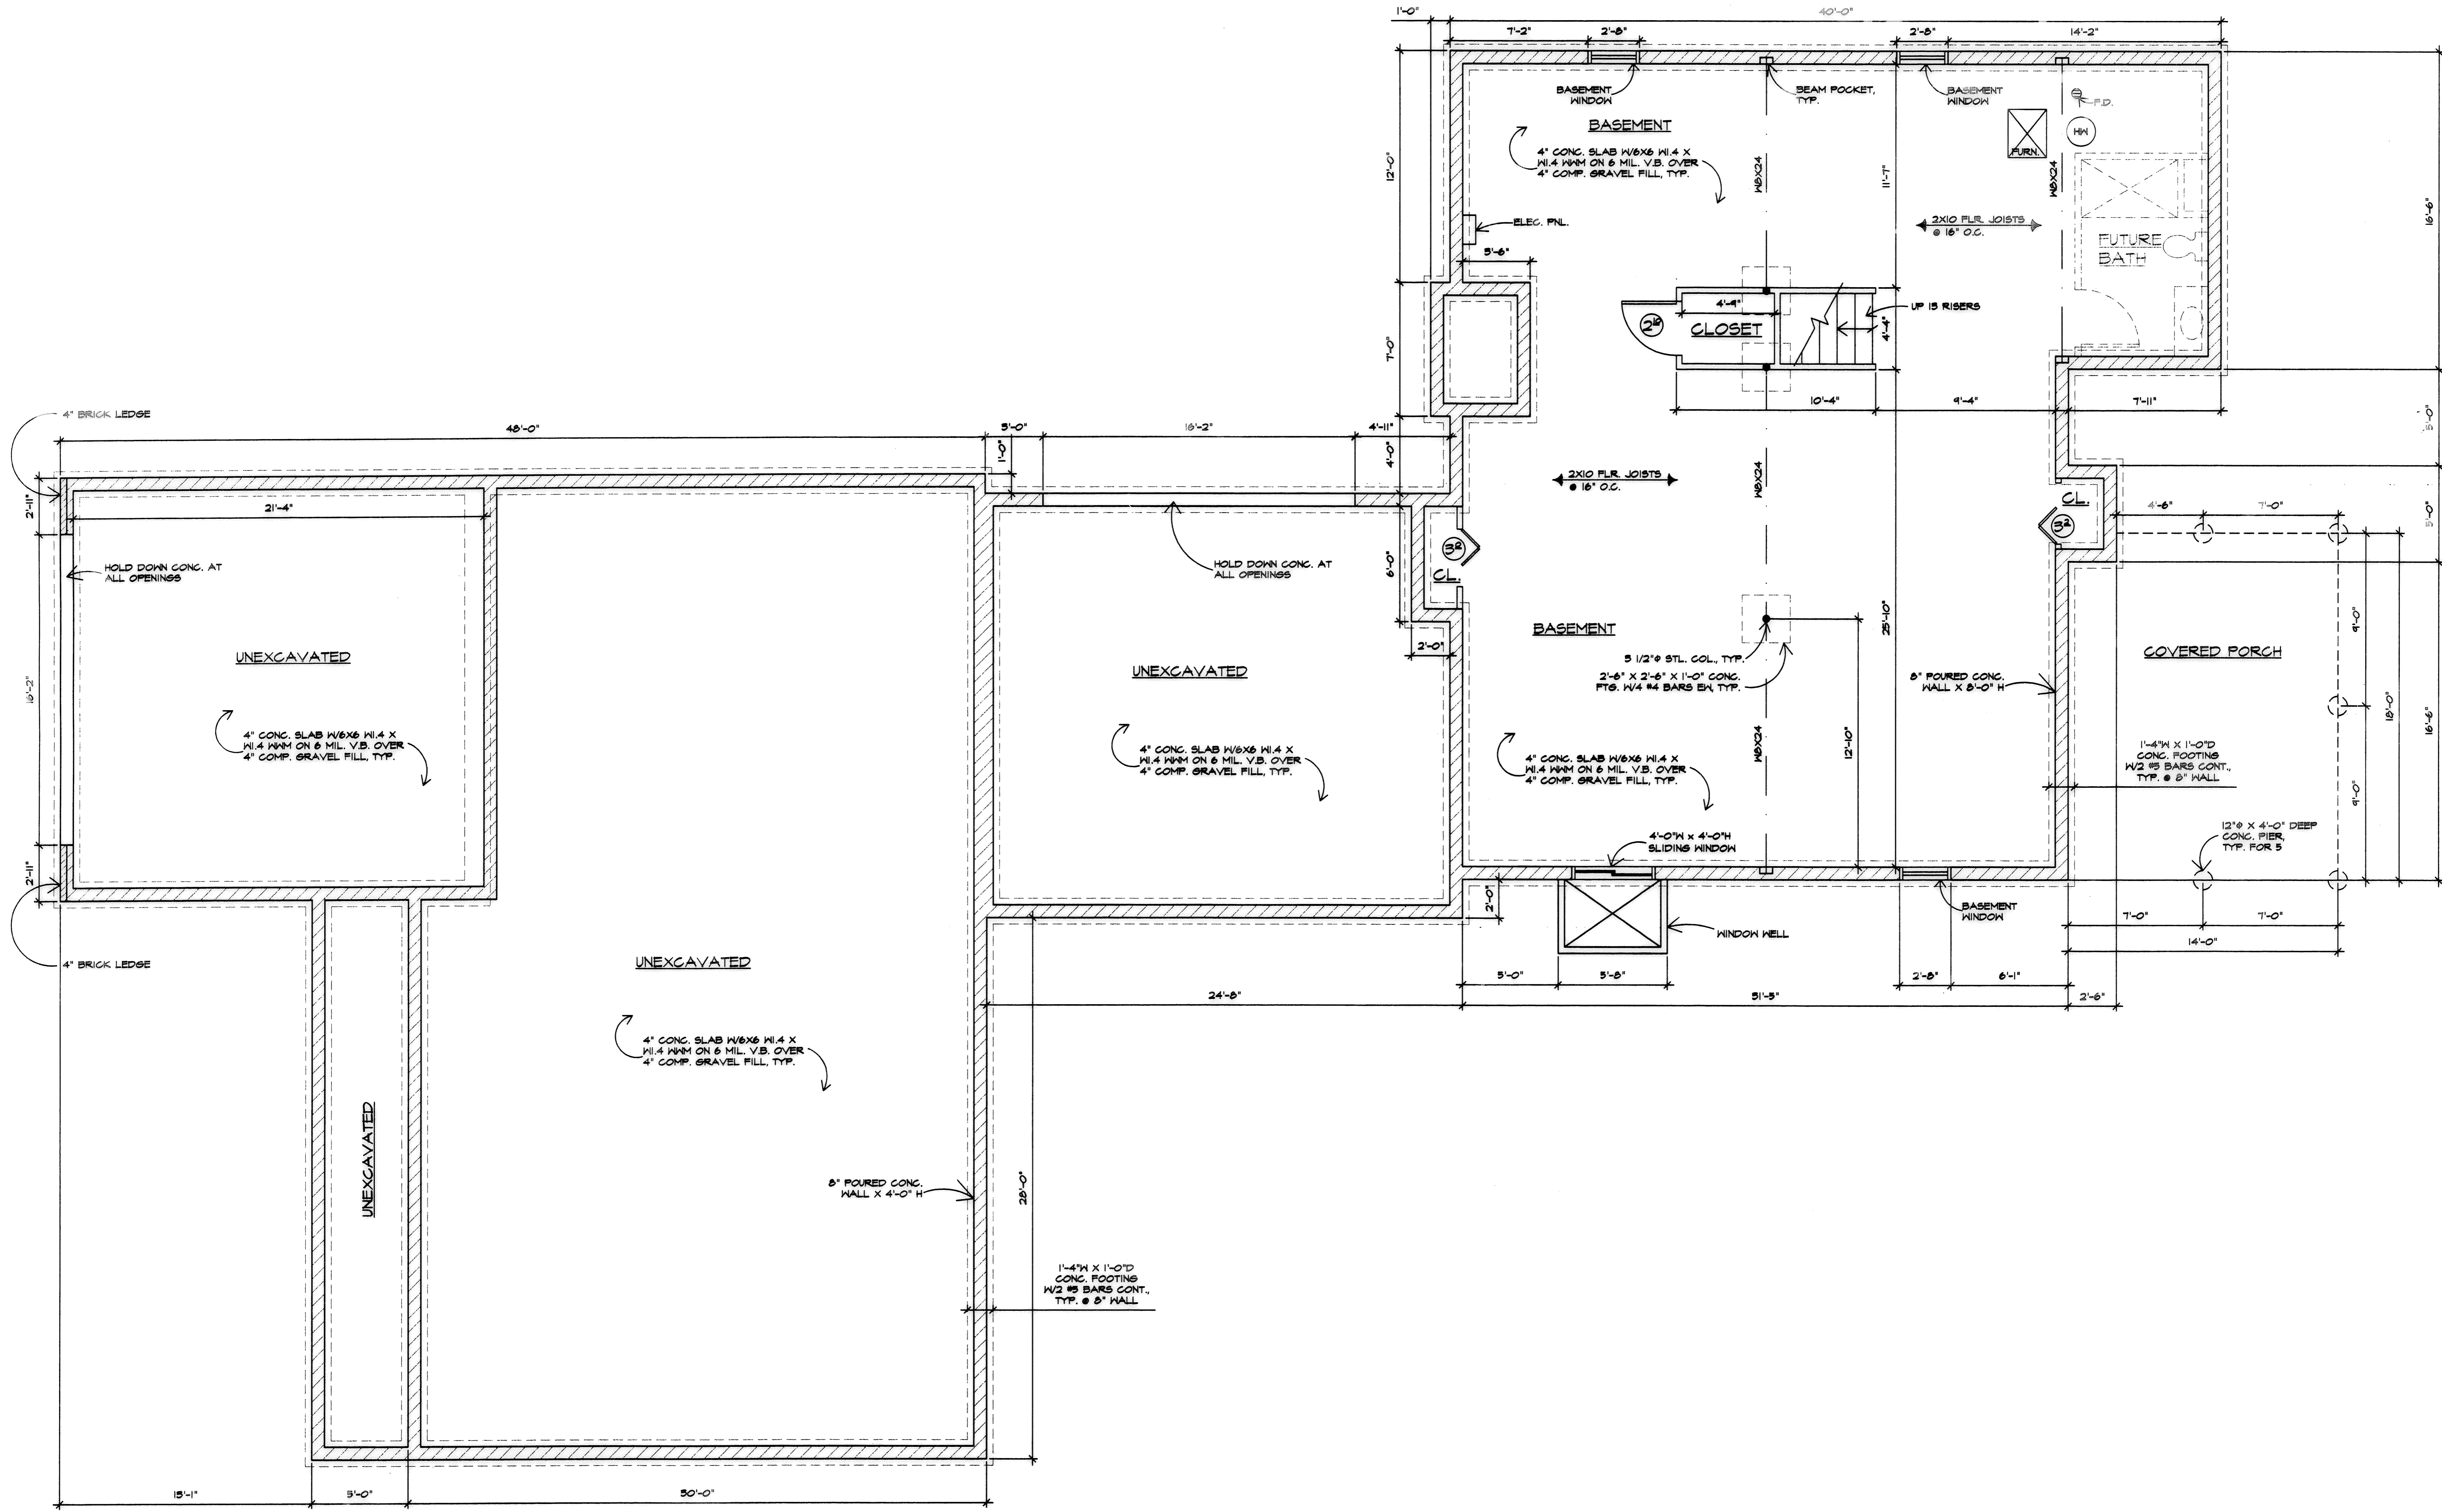

I CERTIFY THAT WITH THE EXCEPTION OF MINOR ARCHITECTURAL MODIFICATIONS MADE DURING CONSTRUCTION, THE DRAWINGS REPRESENT THE STRUCTURES AS BUILT.

Mark W. Ruby
 Mark W. Ruby, Architect #9199

FOUNDATION PLAN
 SCALE: 1/4"=1'-0"




REVISIONS	BY

MARK W. RUBY
 ARCHITECT

1110 COOPER FOSTER PARK ROAD
 AMHERST, OH. 44001
 (440) 966-2091


TITLE

BUILDING #6
 DEER TRAIL
 CONDOMINIUMS

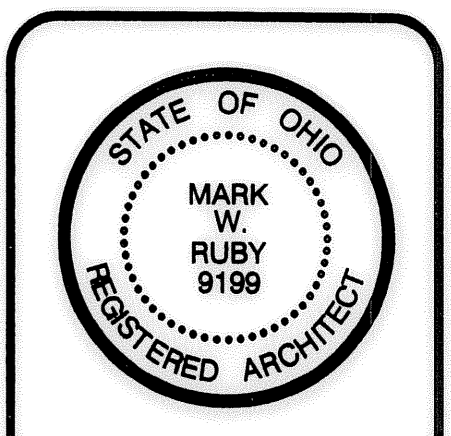

DATE 1/18/06
 PROJ. 0601
 SHEET

2 OF 4

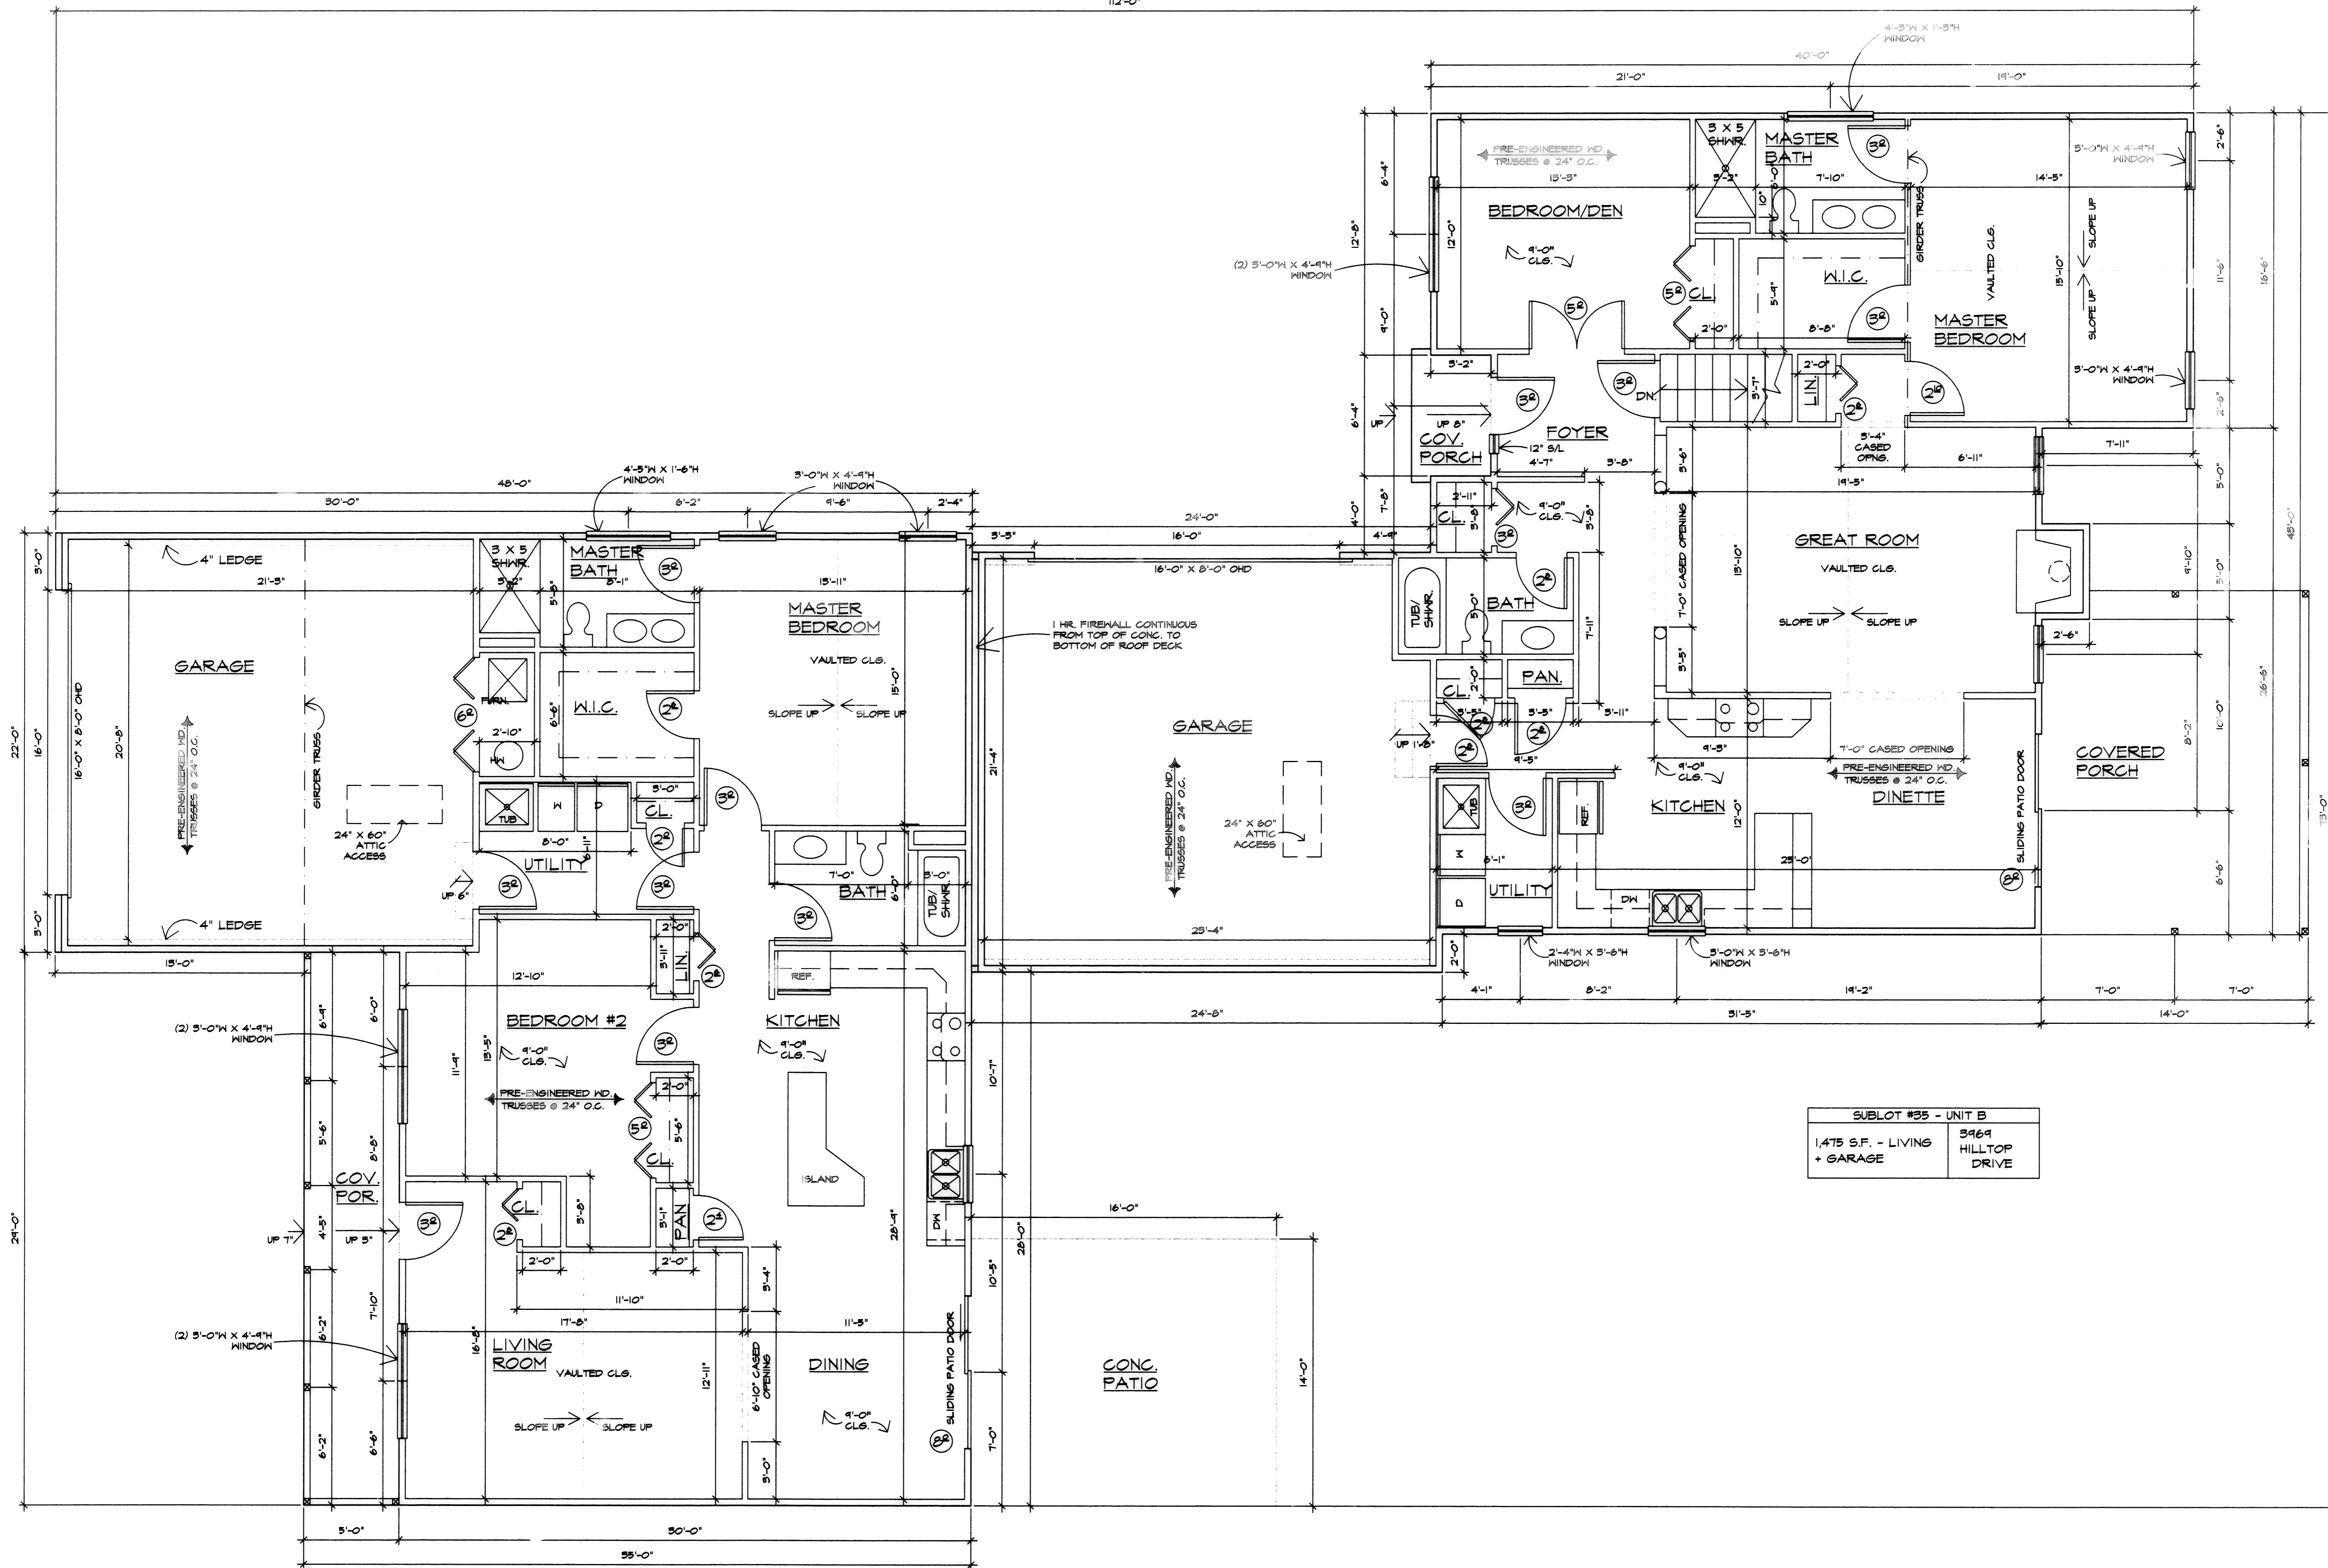

SUBLOT #35 - UNIT B
 1,475 S.F. - LIVING + GARAGE
 3969 HILLTOP DRIVE

SUBLOT #35 - UNIT A
 1,448 S.F. - LIVING + GARAGE
 3965 HILLTOP DRIVE


I CERTIFY THAT WITH THE EXCEPTION OF MINOR ARCHITECTURAL MODIFICATIONS MADE DURING CONSTRUCTION, THE DRAWINGS REPRESENT THE STRUCTURES AS BUILT.
 Mark W. Ruby, Architect 3/1/99

FLOOR PLAN
 SCALE: 1/4" = 1'-0"


NO.	REVISIONS	BY

MARK W. RUBY
 ARCHITECT
 1110 COOPER FOSTER PARK ROAD
 AMHERST, OH, 44001
 (440) 886-2091


TITLE
 BUILDING #6
 DEER TRAIL
 CONDOMINIUMS

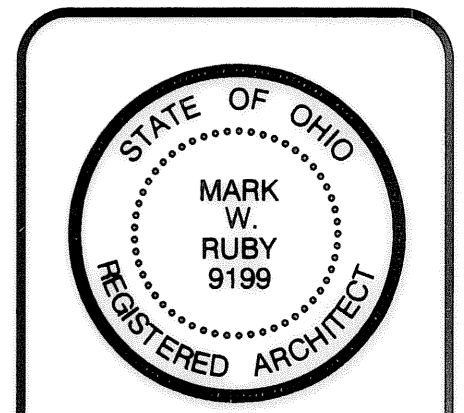


DATE 1/18/06
 PROJ. 0801
 SHEET

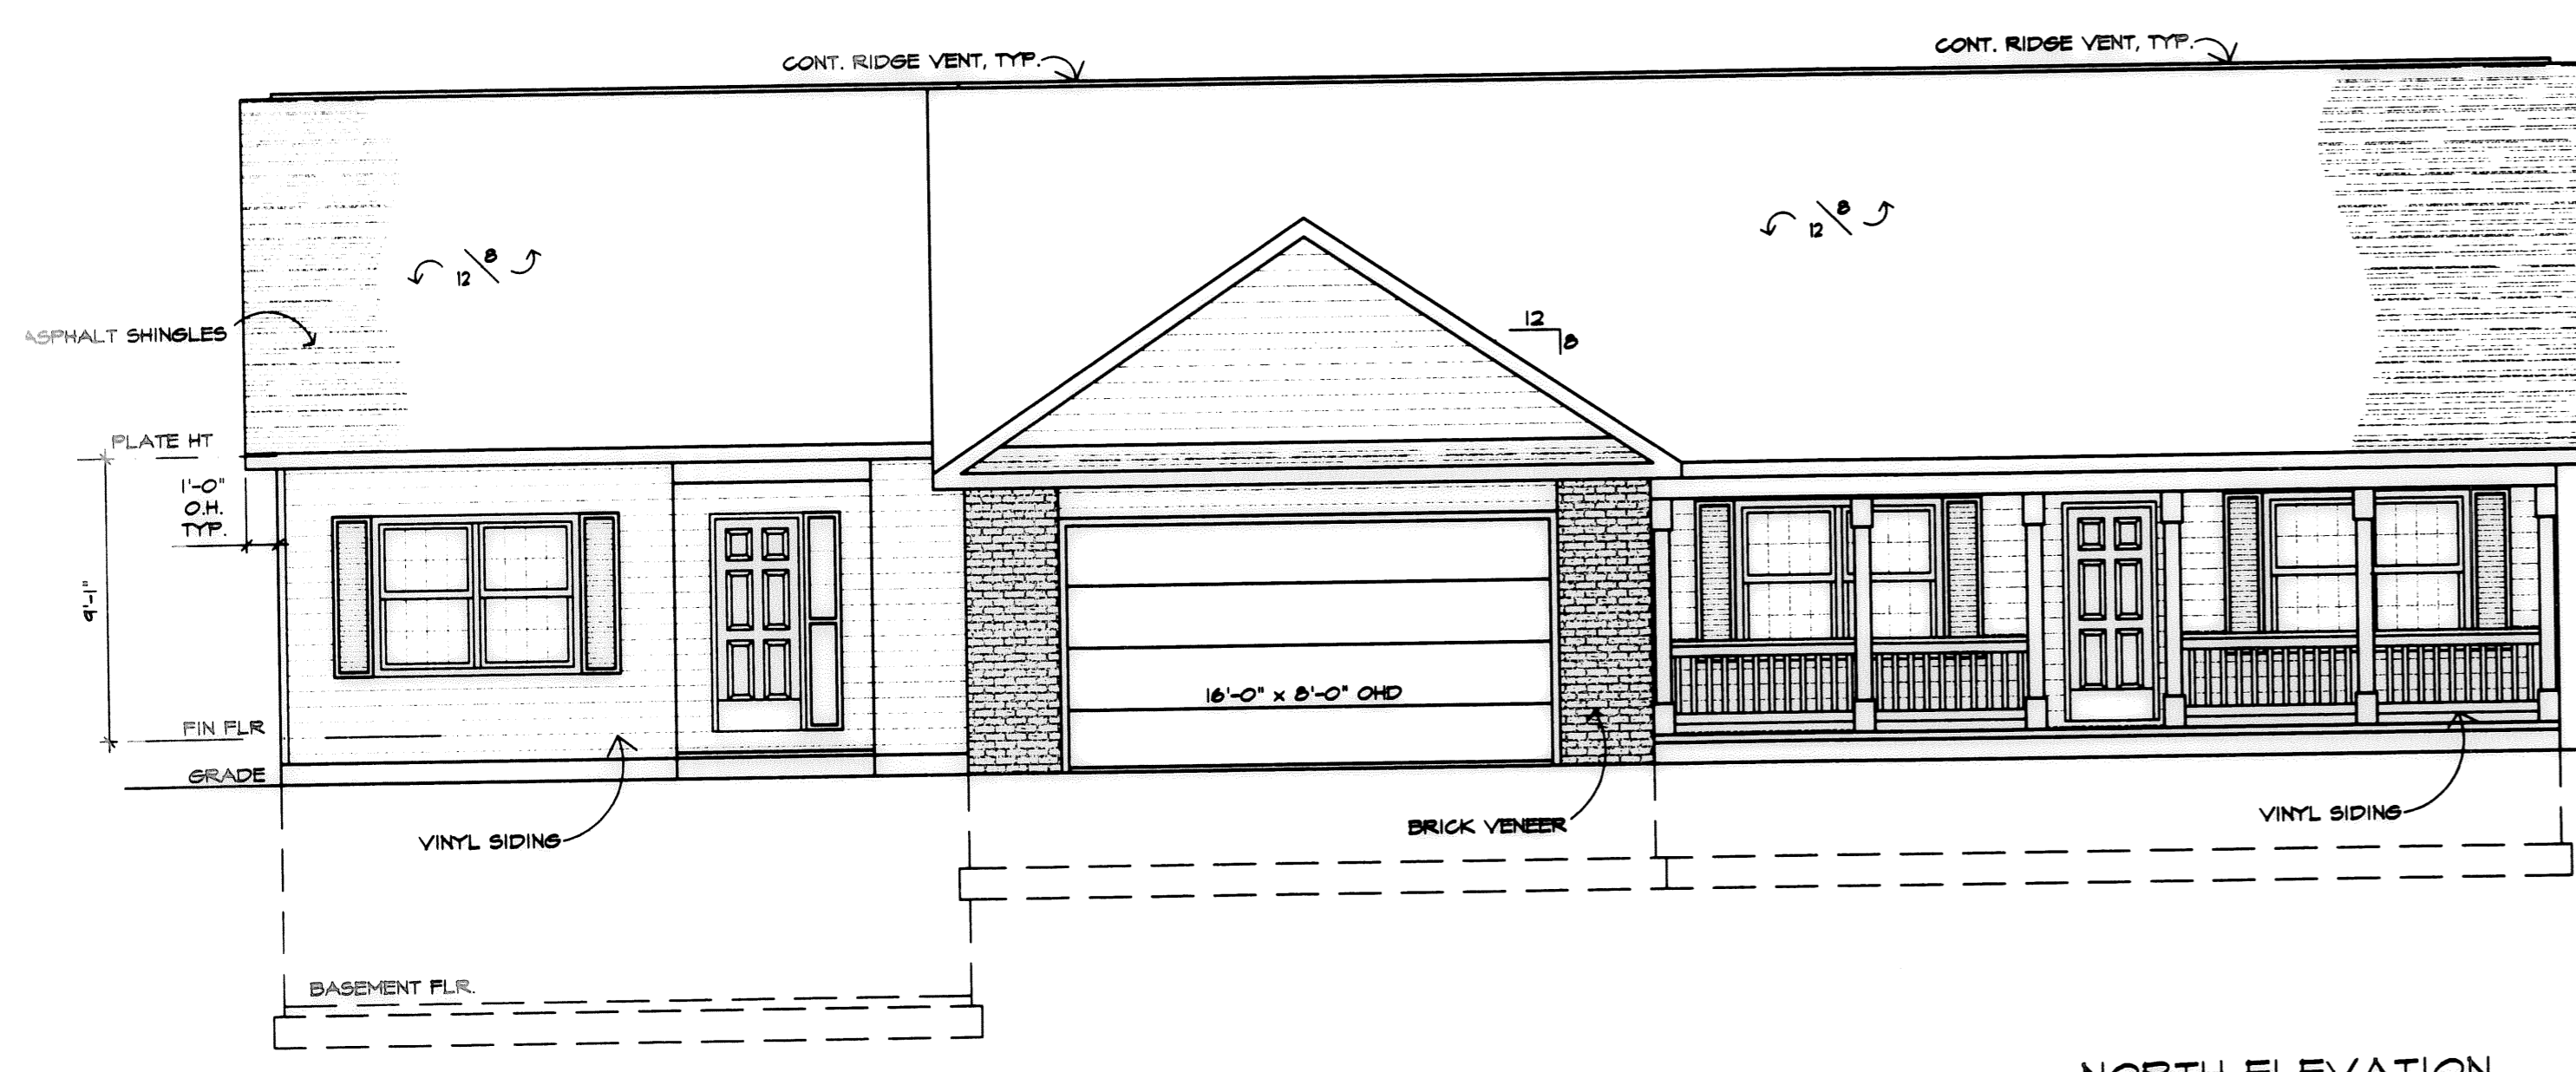


NORTH ELEVATION
SCALE: 3/16"=1'-0"

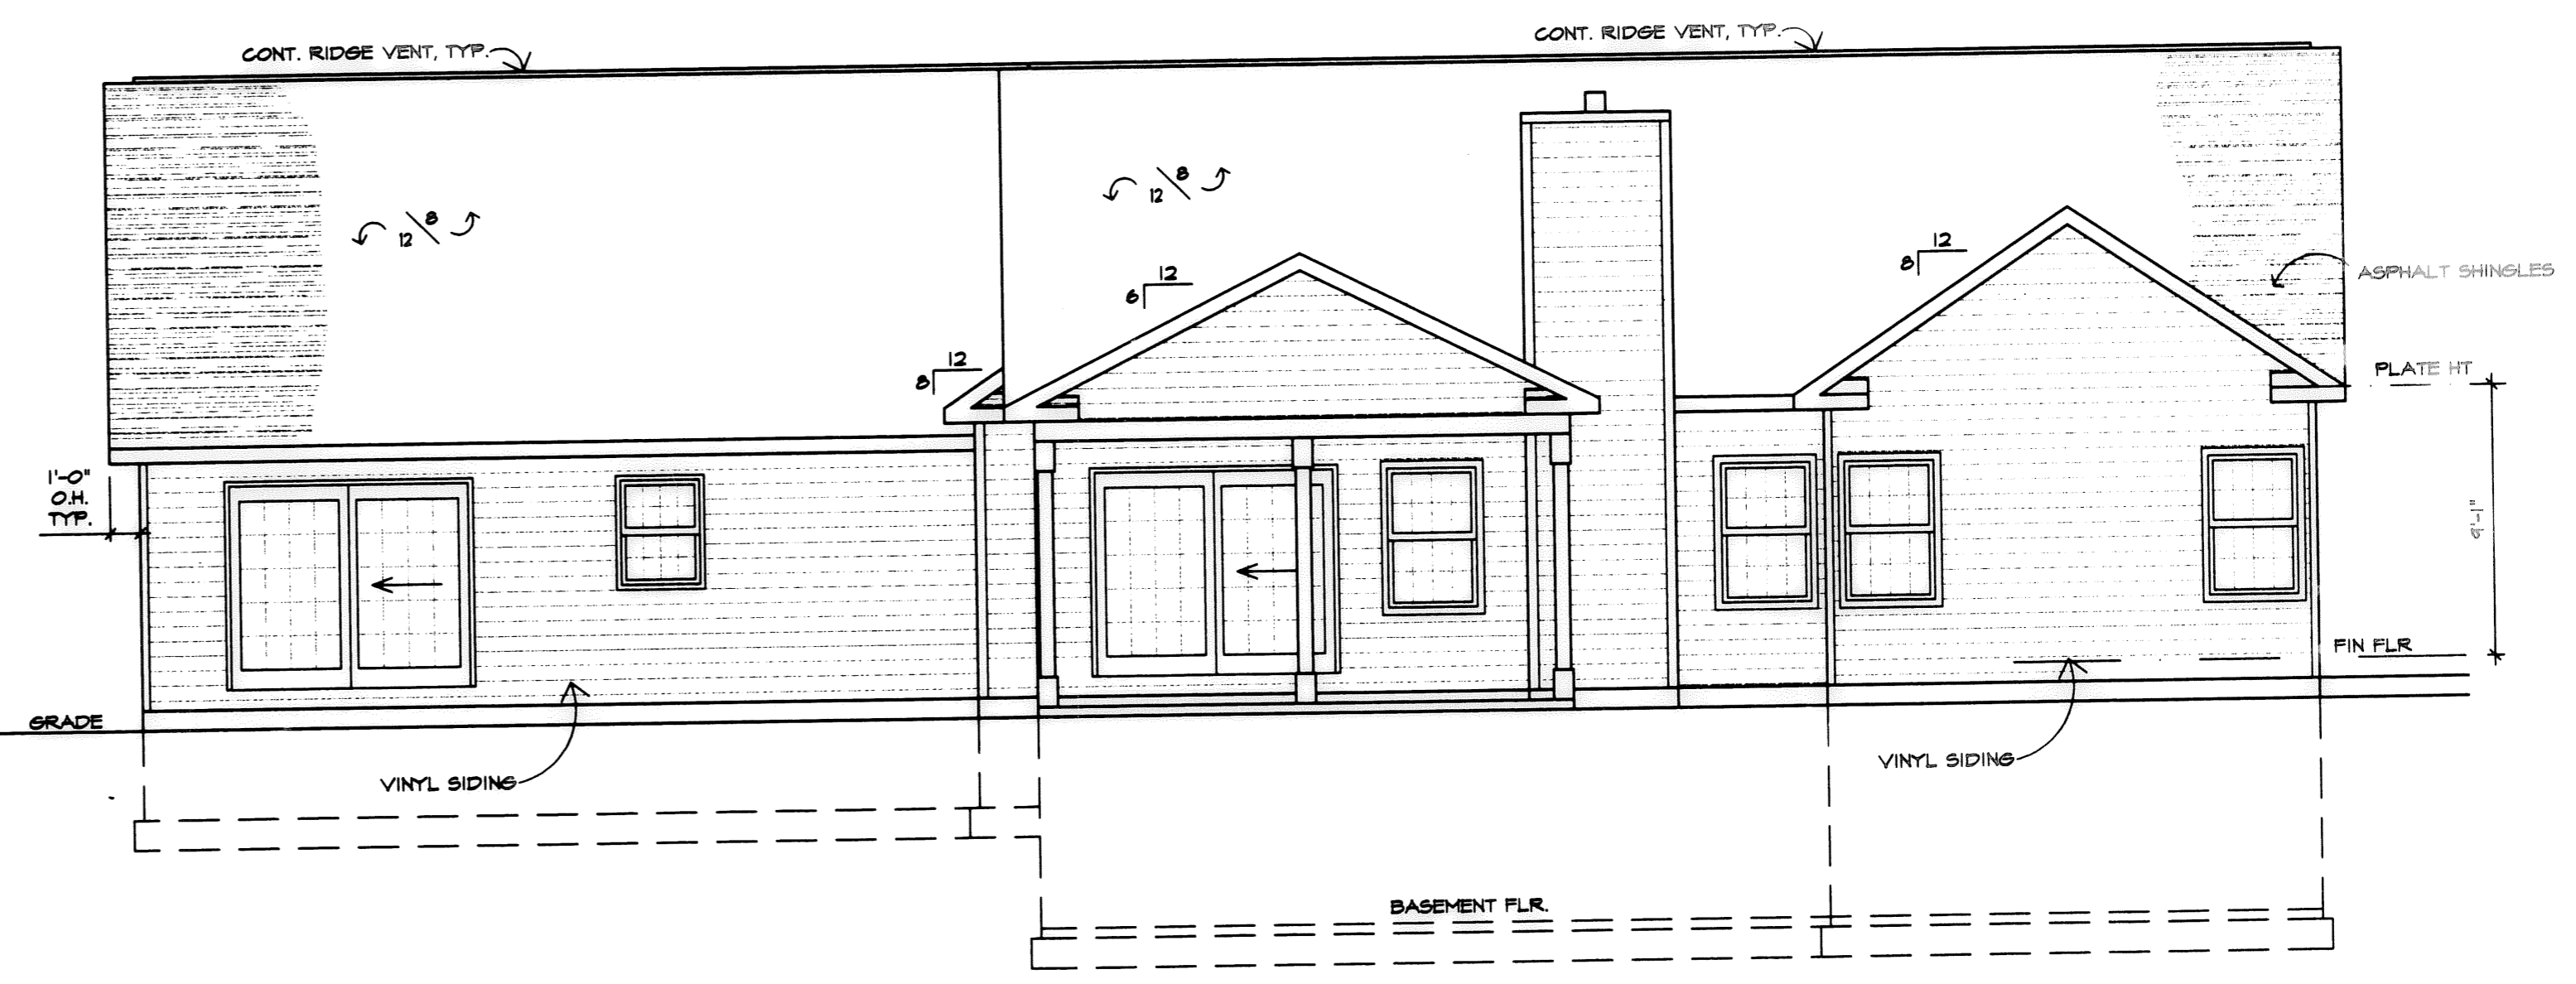

SOUTH ELEVATION
SCALE: 3/16"=1'-0"

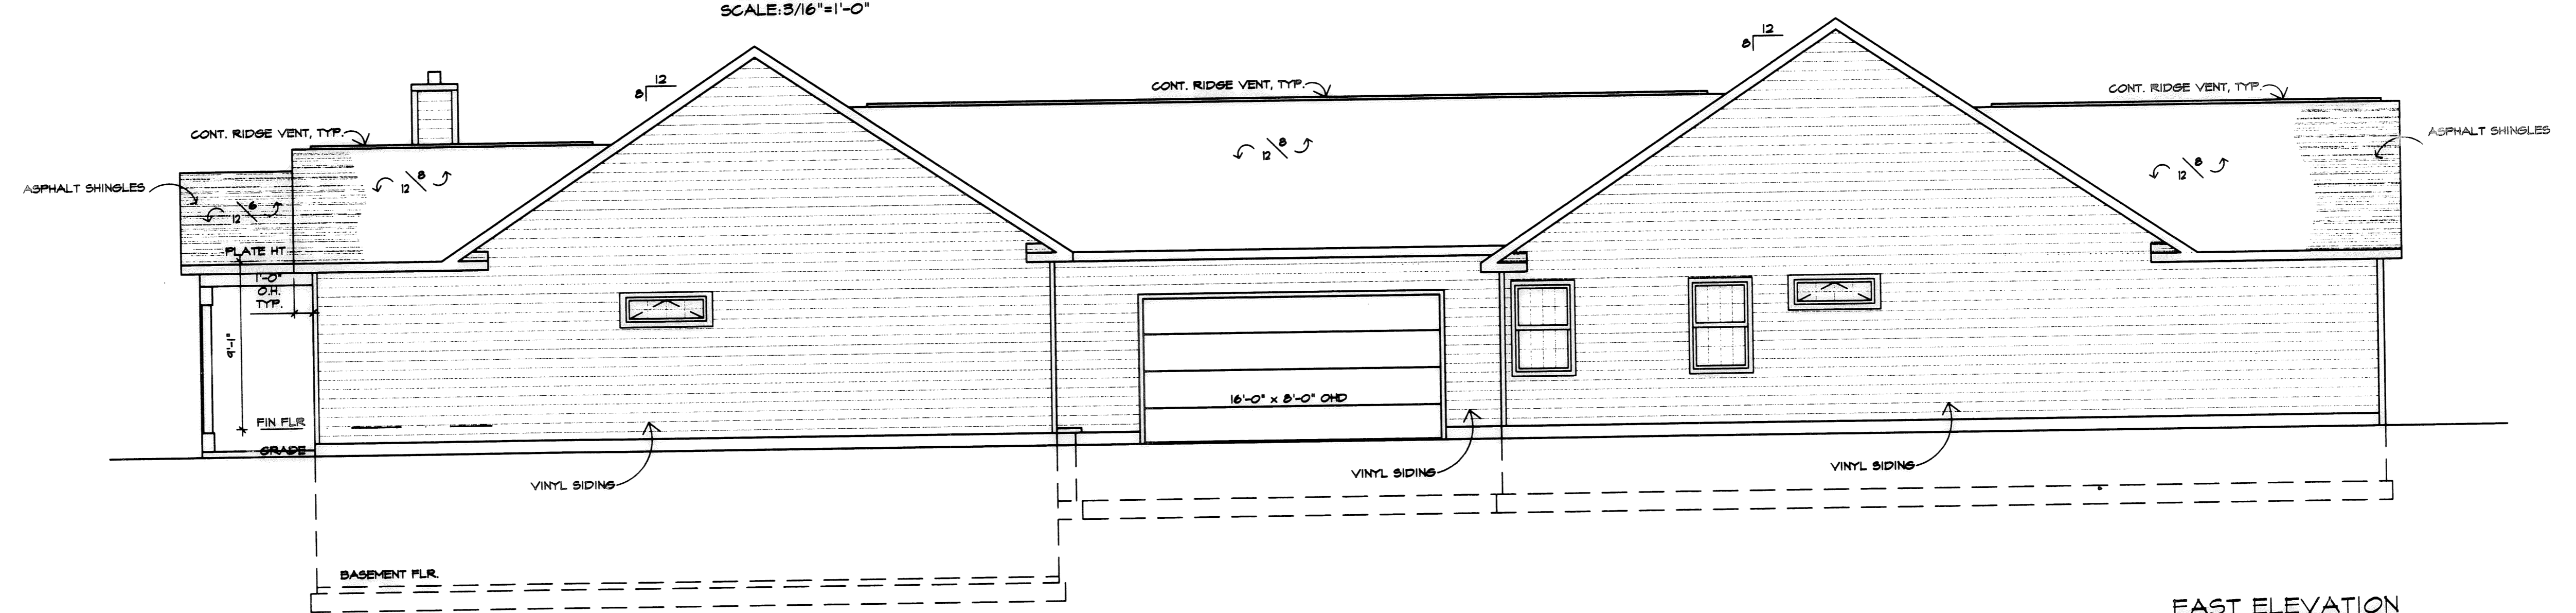

EAST ELEVATION
SCALE: 3/16"=1'-0"

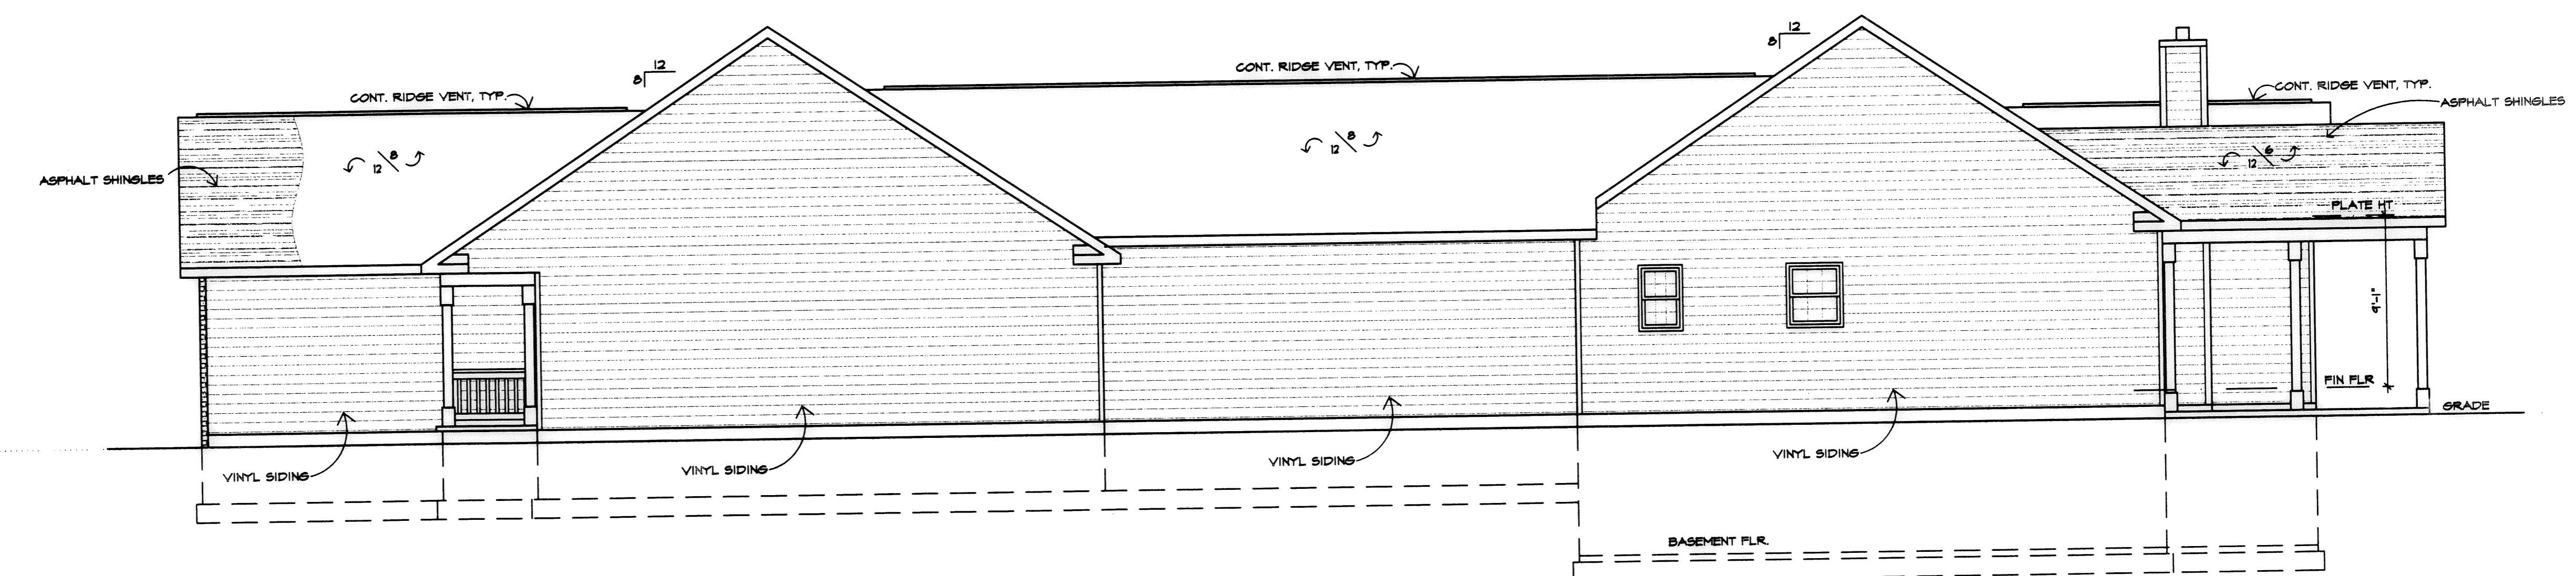

WEST ELEVATION
SCALE: 3/16"=1'-0"

I CERTIFY THAT WITH THE EXCEPTION OF MINOR ARCHITECTURAL MODIFICATIONS MADE DURING CONSTRUCTION, THE DRAWINGS REPRESENT THE STRUCTURES AS BUILT.


Mark W. Ruby
Mark W. Ruby, Architect #1999

REVISIONS	BY

MARK W. RUBY
ARCHITECT

1110 COOPER FOSTER PARK ROAD
AMHERST, OH. 44001
(440) 986-2091

BUILDING #6
DEER TRAIL
CONDOMINIUMS

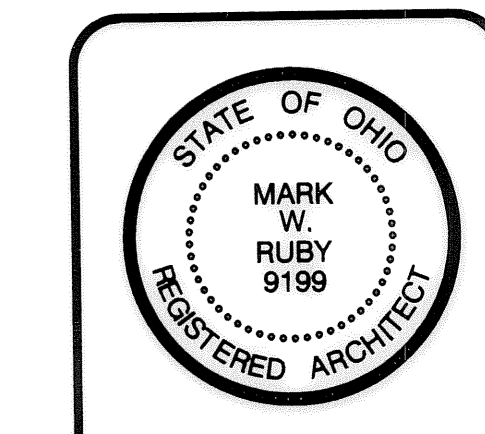

DATE 1/18/06
PROJ. 0601
SHEET