

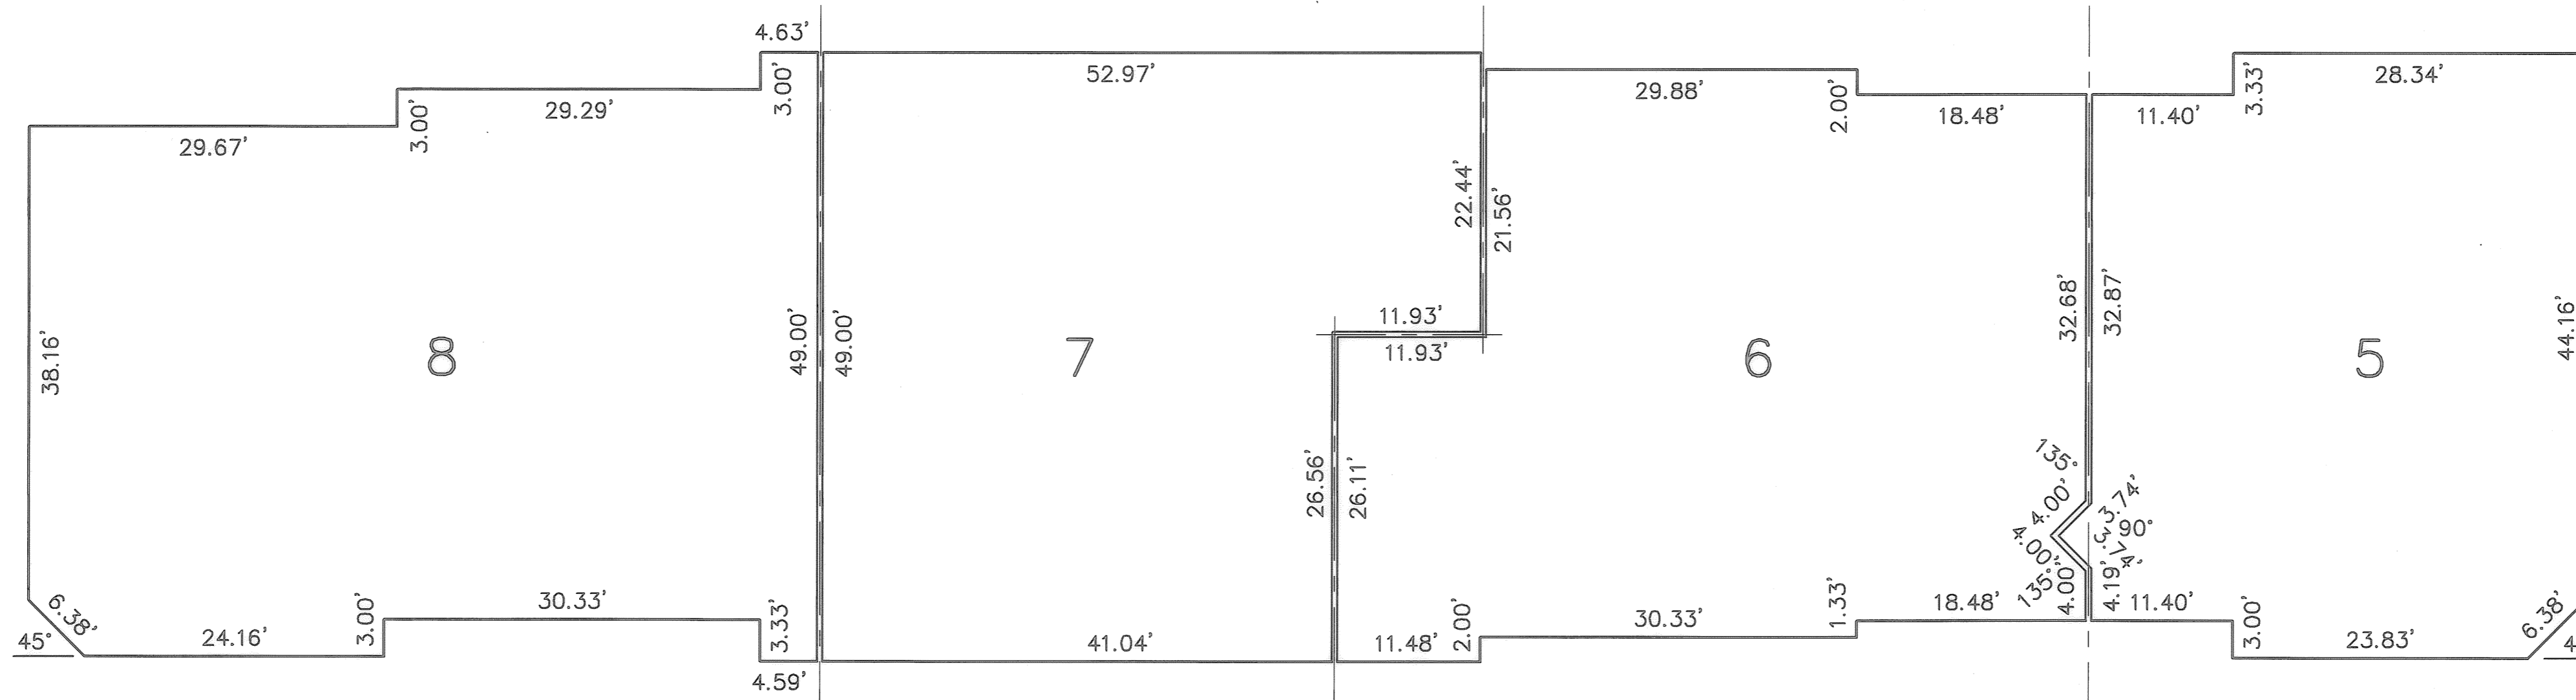


R:\01000\01355-cp2\control\dwg\1-PLAT02.dwg 8/9/2006 8:51:10 AM EDT

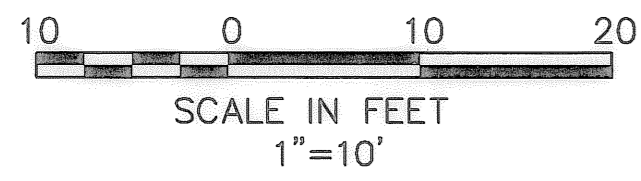

FIRST FLOOR PLAN
(INTERIOR DIMENSIONS)

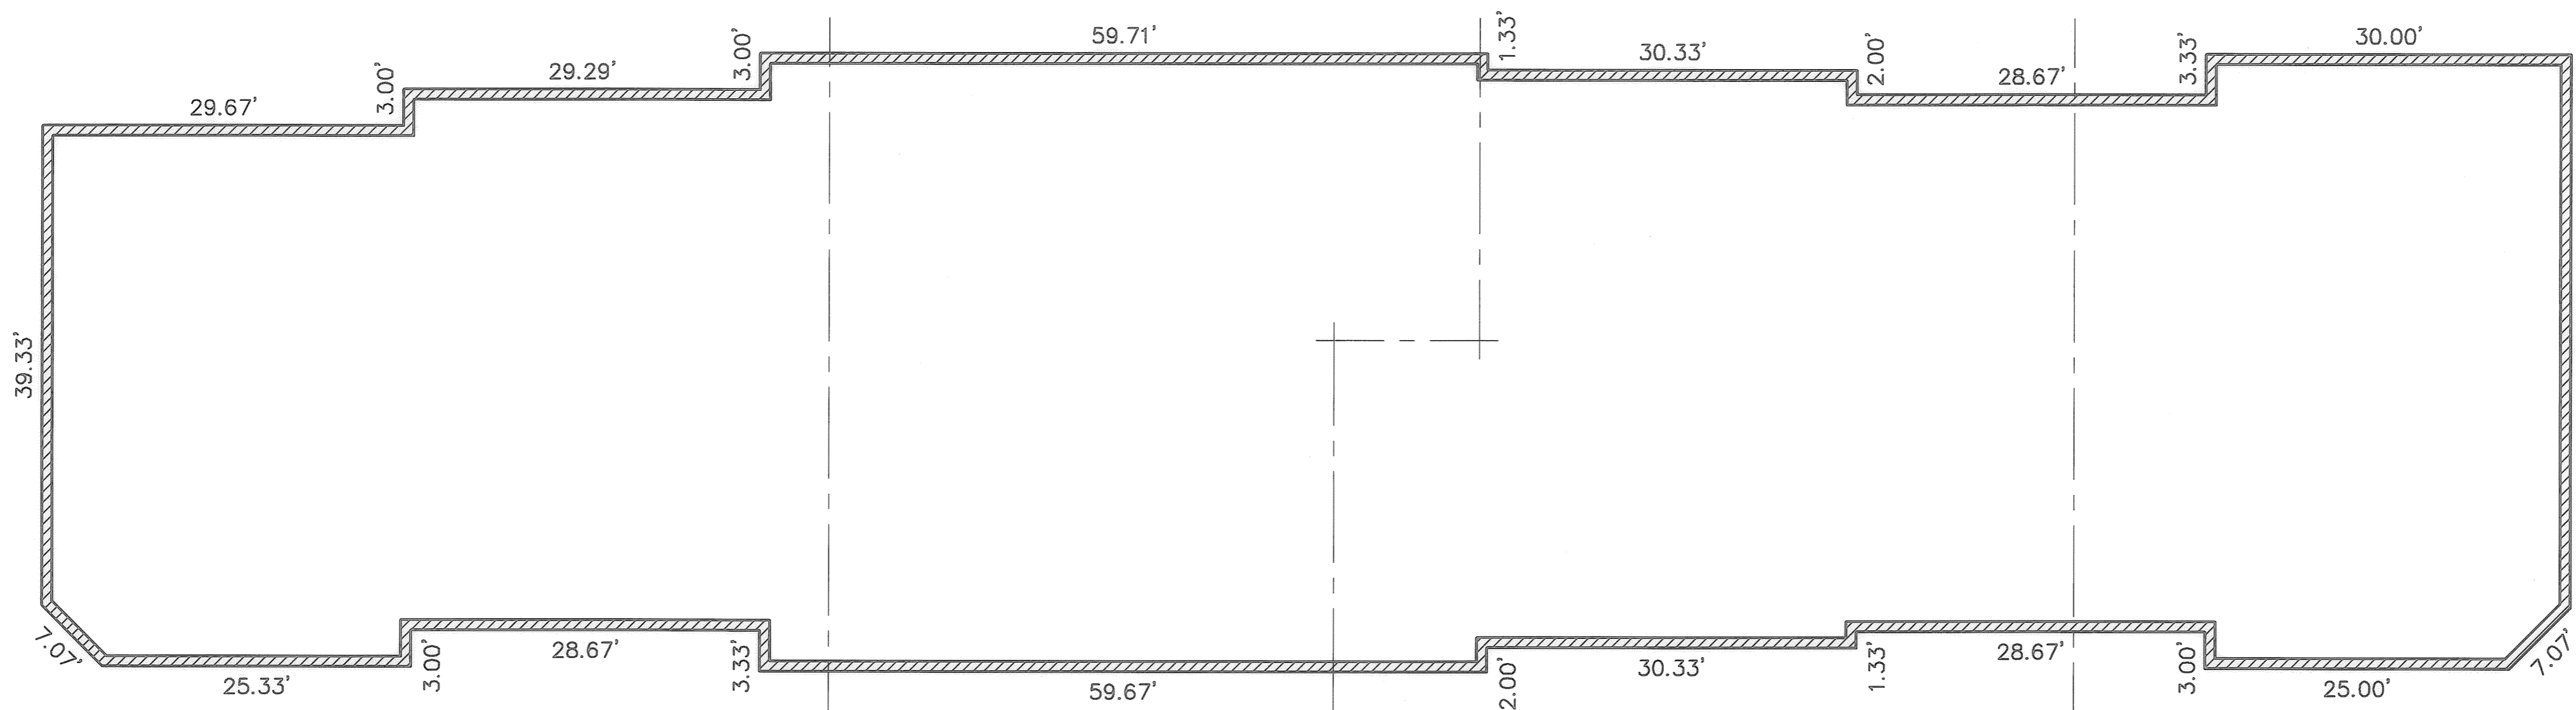



FOUNDATION PLAN
(EXTERIOR DIMENSIONS)

CERTIFICATION

THIS IS TO CERTIFY THAT THE ATTACHED DRAWINGS
CORRECTLY REPRESENT THE BUILDING AS CONSTRUCTED.

David L. Elwell 8-10-06
DAVID L. ELWELL
PROFESSIONAL SURVEYOR NO. 6333

Jeffrey R. Keefe 8-10-06
JEFFREY R. KEEFE
PROFESSIONAL ENGINEER-NO. 58389

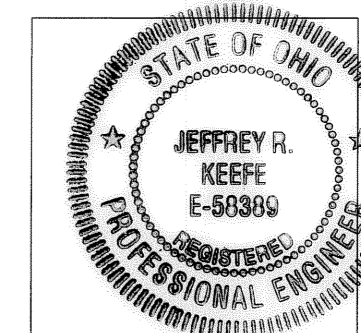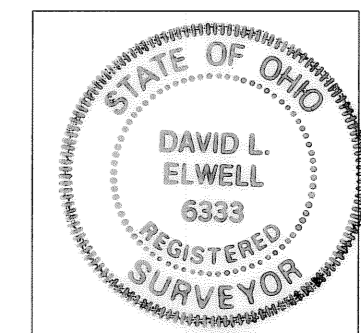

KS ASSOCIATES
KS Associates, Inc.
260 Burns Road, Suite 100
Elyria, OH 44035
P 440 365 4730
F 440 365 4790
www.ksassociates.com

**YORKSHIRE COMMONS
CONDOMINIUM PHASE NO. 2**
OF PART OF
ORIGINAL SHEFFIELD TOWNSHIP LOT NO. 1
VILLAGE OF SHEFFIELD COUNTY OF LORAIN STATE OF OHIO

SHEET
2
OF
3
JOB NO.
01355-CP2


DATE	DESCRIPTION	BY
08-09-06	ORIGINAL ISSUE	CPW

DATE	DRAWN BY	CHKD BY	DWG. NAME	PATH	F.B.
08-09-06	CPW		1-PLA102	01355-CP2	


R:\01000\01355-cp2\ddat\control\dwg\1-PLAT03.dwg 8/9/2006 8:51:13 AM EDT





FRONT ELEVATION

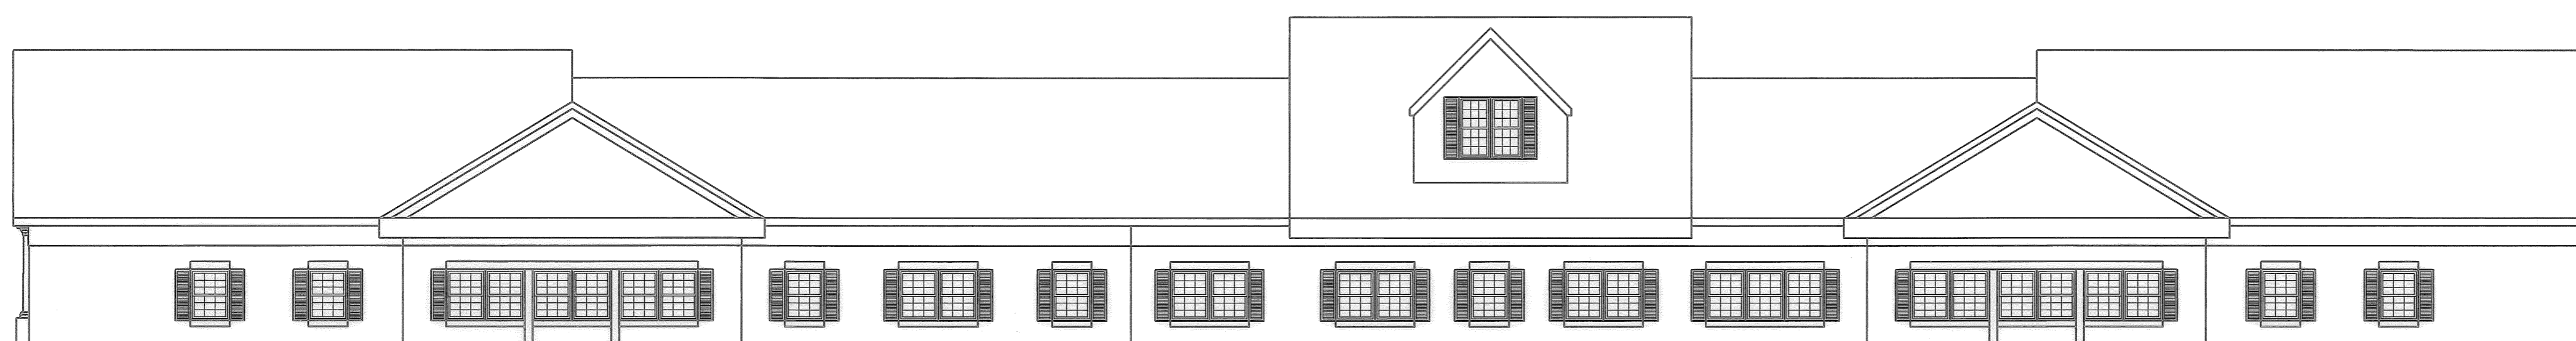

REAR ELEVATION

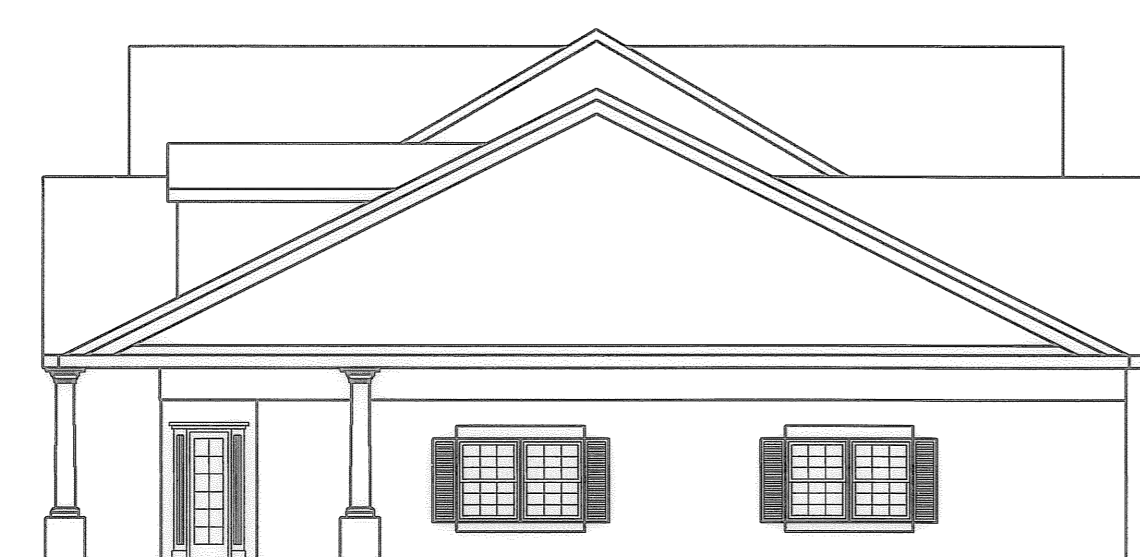

RIGHT SIDE ELEVATION

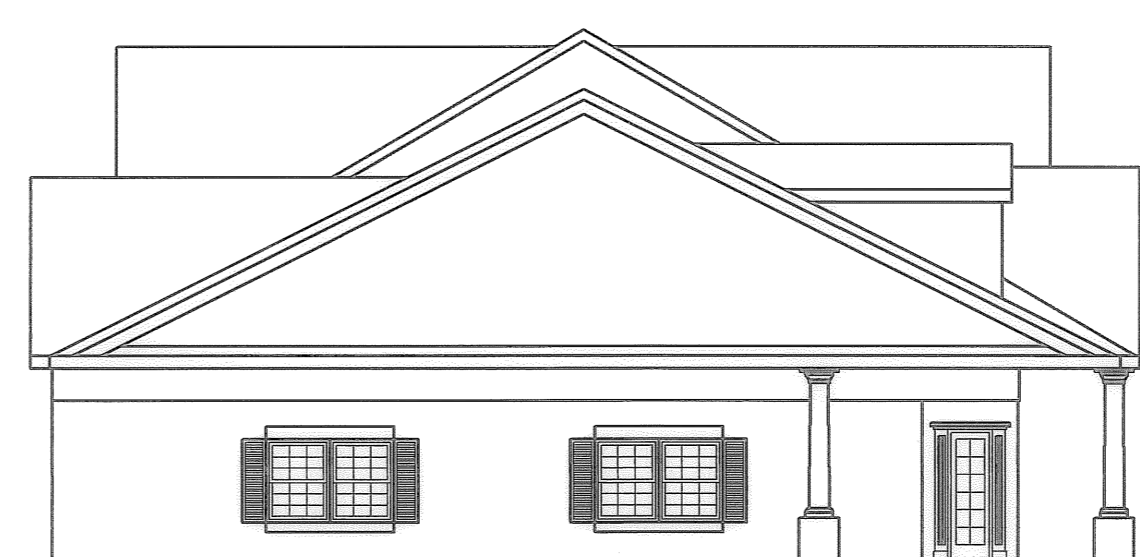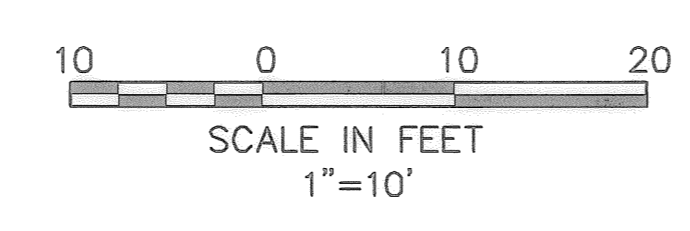


LEFT SIDE ELEVATION

NOTE: BUILDING STYLE SHOWN IS TYPICAL PER PROJECT.


CERTIFICATION

THIS IS TO CERTIFY THAT THE ATTACHED DRAWINGS CORRECTLY REPRESENT THE BUILDING AS CONSTRUCTED.

David L. Elwell 8-10-06
DAVID L. ELWELL
PROFESSIONAL SURVEYOR NO. 6333

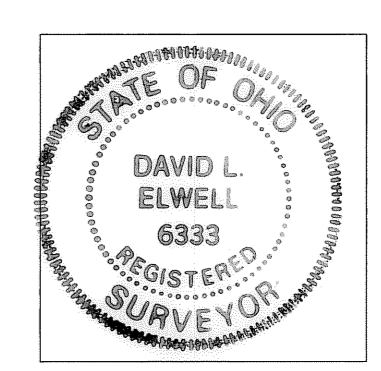

Jeffrey R. Keefe 8-10-06
JEFFREY R. KEEFE
PROFESSIONAL ENGINEER NO. 58389

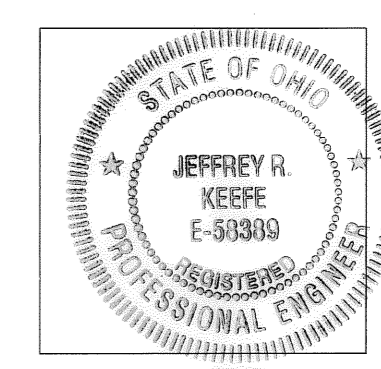

DATE	DESCRIPTION	BY
08-09-06	ORIGINAL ISSUE	CPW

DATE	DATE	DATE
08-09-06	08-09-06	08-09-06

KS Associates, Inc.
260 Burns Road, Suite 100
Elyria, OH 44035
P 440 365 4730
F 440 365 4790
www.kssassociates.com

**YORKSHIRE COMMONS
CONDOMINIUM PHASE NO. 2**
OF PART OF
ORIGINAL SHEFFIELD TOWNSHIP LOT NO. 1
VILLAGE OF SHEFFIELD COUNTY OF LORAIN STATE OF OHIO

SHEET 3	OF 3
JOB NO. 01355-CP2	