
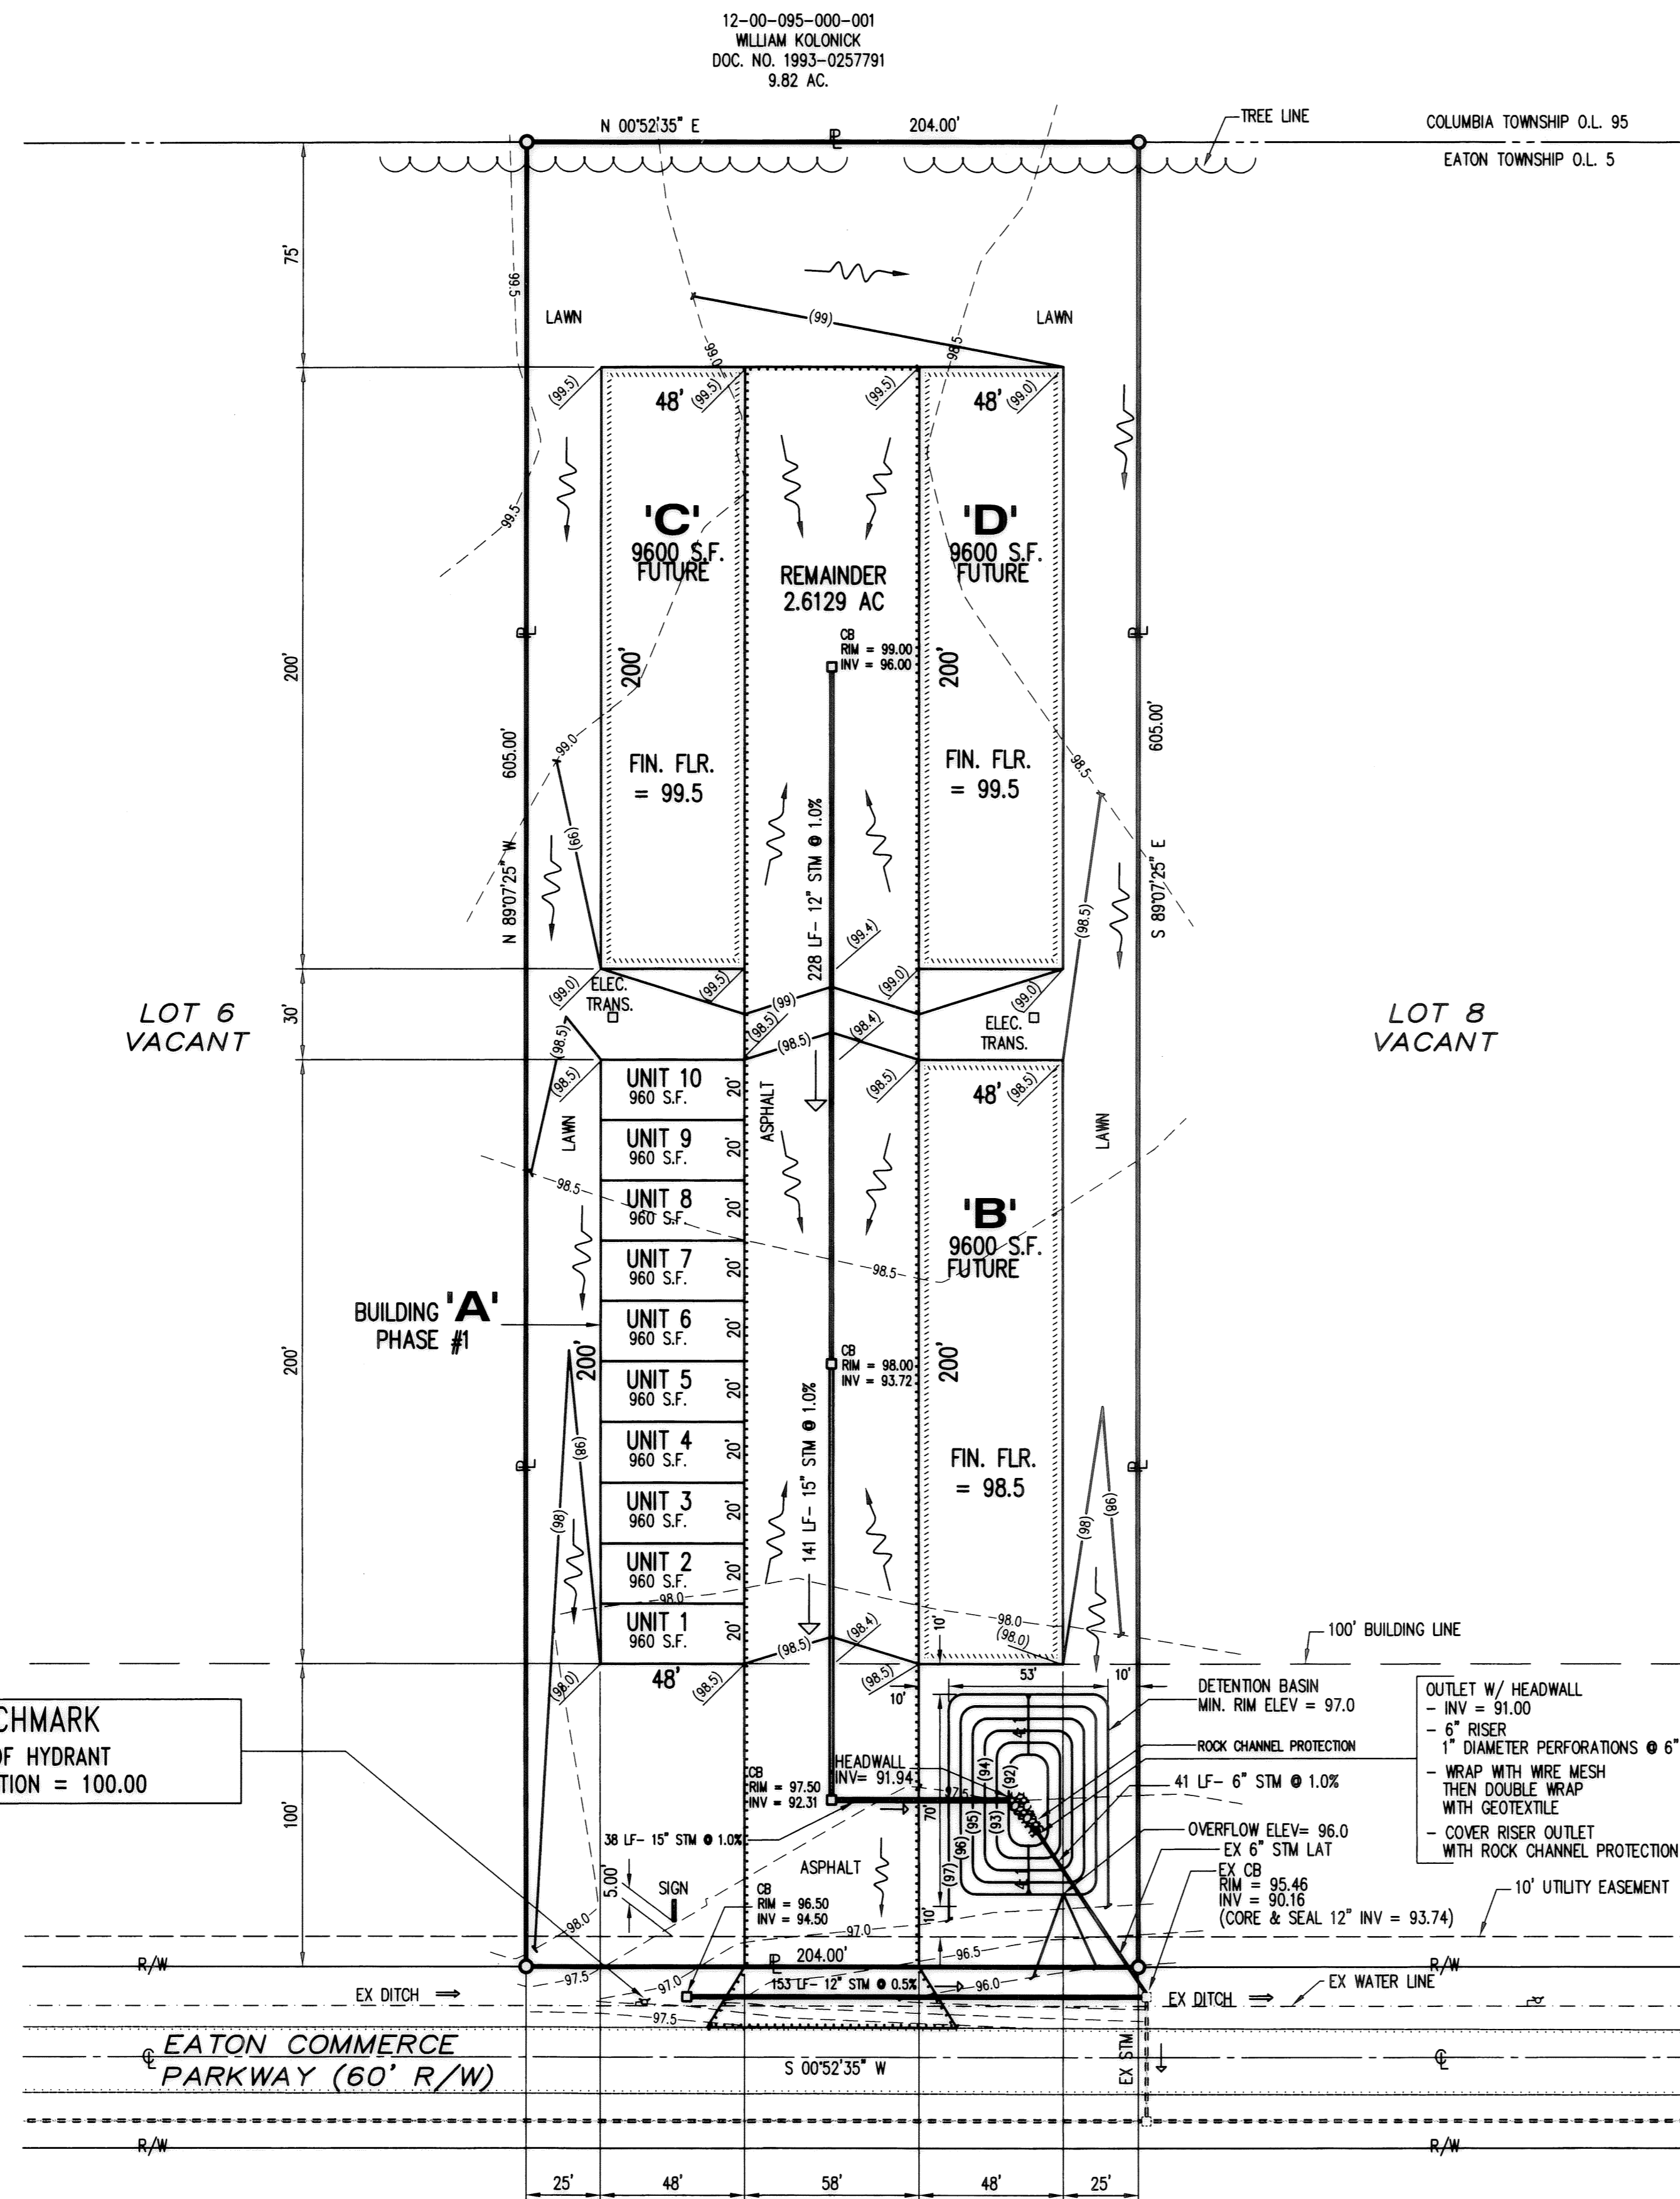


# Buckeye Storage Condominiums Phase #1



Eaton Township ~ Lorain County ~ State of Ohio  
Part of Original Eaton Township Lot 5

Sublot 7 Eaton Commerce Parkway  
Plat Volume 68 Page 15

P.P.N. 11-00-005-000-065  
2.83 ac.

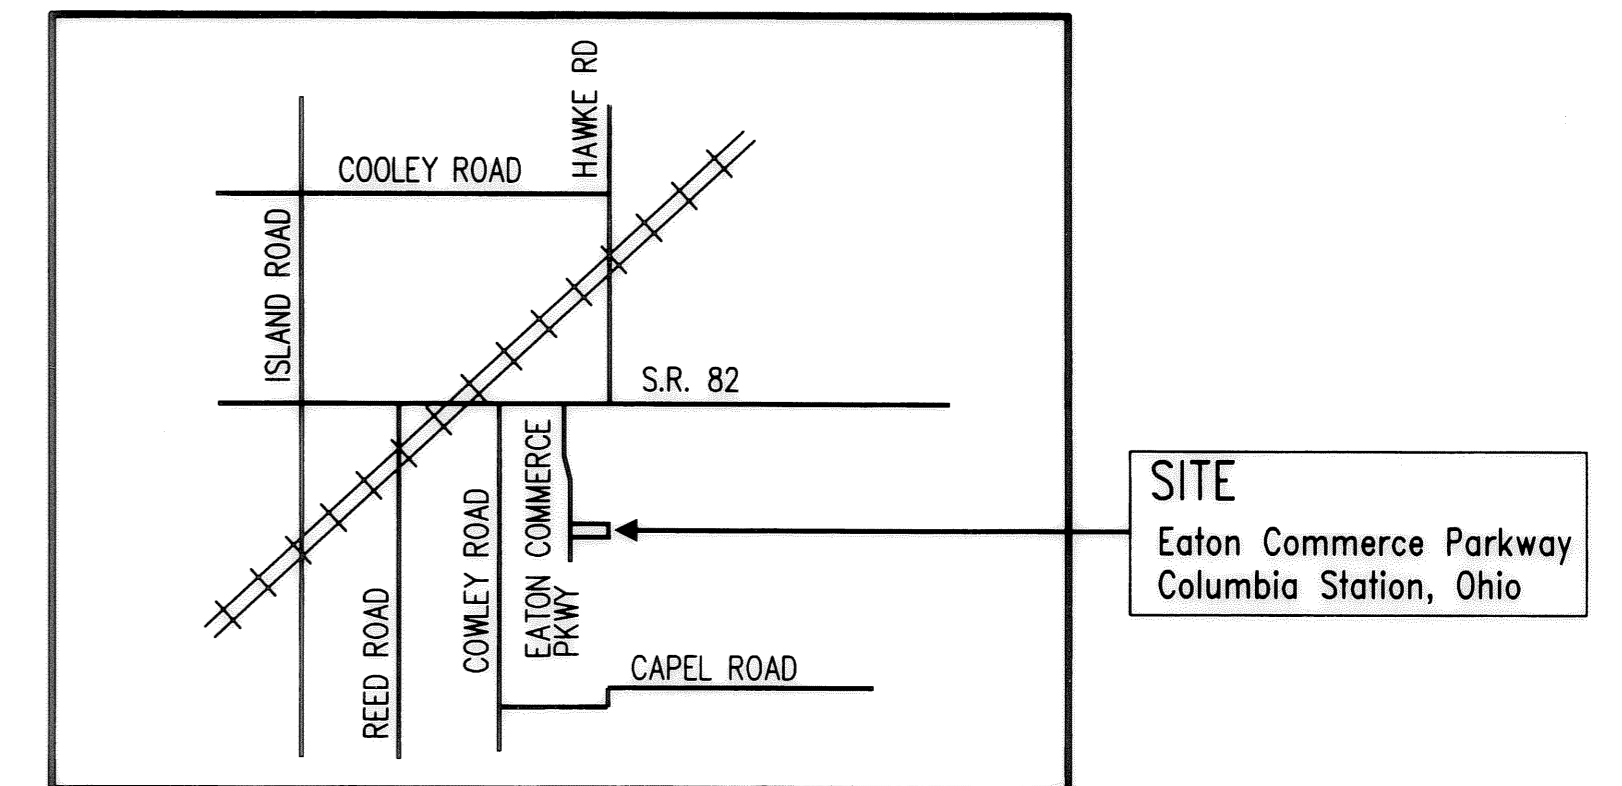

## Condominium Survey

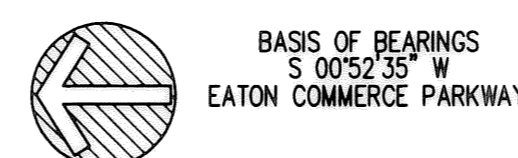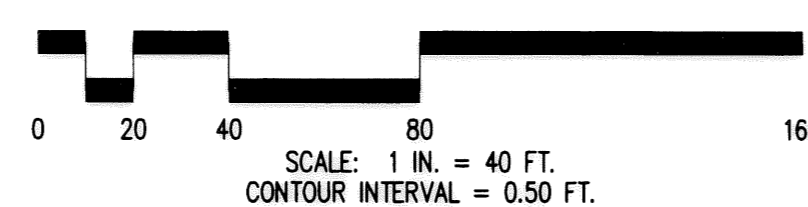

### LEGEND OF SYMBOLS & LINETYPES

	PROPERTY LINE		IRON PIN FOUND
	CENTERLINE		IRON PIN SET
	RIGHT-OF-WAY LINE		30" LONG, 5/8" REBAR WITH CAP STAMPED "HAYWOOD 8284"
	EASEMENT LINE		IRON PIN IN MONUMENT BOX
	SETBACK LINE		PK NAIL OR DRILL HOLE
	FENCE		PROPERTY CORNER NOT MONUMENTED

R., REC. = RECORD    M., MEAS. = MEASURED    P. = PLAT  
P.O.B. = PLACE OF BEGINNING    P.P.O.B. = PRINCIPAL PLACE OF BEGINNING  
L.C.A. = LIMITED COMMON AREA

### SURVEYOR'S CERTIFICATION

THIS IS TO CERTIFY THAT AT THE REQUEST OF BUCKEYE STORAGE CONDOMINIUMS I HAVE PREPARED THIS CONDOMINIUM SURVEY. THE ATTACHED DRAWINGS CORRECTLY REPRESENT THE BUILDING AS CONSTRUCTED AND THERE ARE NO ENCROACHMENTS ON ADJUTING PROPERTIES.


DIMENSIONS ARE IN FEET AND DECIMAL PARTS THEREOF. BEARINGS ARE TO AN ASSUMED MERIDIAN AND INTENDED TO DESCRIBE ANGLES ONLY. THE BASIS OF BEARINGS IS S 00°52'35" W FOR EATON COMMERCE PARKWAY.

THIS PLAT REPRESENTS A SURVEY IN WHICH THE TRAVERSE OF THE EXTERIOR BOUNDARIES OF THE TRACT WHEN COMPUTED FROM FIELD MEASUREMENTS CLOSED TO WITHIN A LIMIT OF ERROR OF ONE (1) FOOT TO TEN THOUSAND (10,000) FEET OF THE PERIMETER BEFORE BALANCING THE SURVEY.

THE SURVEY MEETS THE MINIMUM STANDARDS FOR LAND SURVEYS, IN SECTION 4733-37 OF THE OHIO ADMINISTRATIVE CODE. ADJACENT PROPERTY DESCRIPTIONS HAVE BEEN CONSIDERED IN PERFORMING THIS SURVEY.

FIELD SURVEY DATE: AUGUST 30, 2006

DRAWING REVISION DATE: SEPTEMBER 21, 2006  
JANUARY 5, 2007

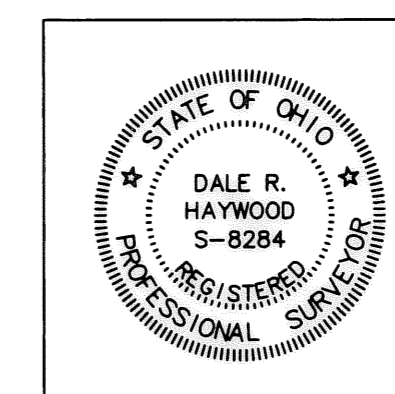

*Dale Haywood*  
Dale R. Haywood, P.S.  
Registered State of Ohio Surveyor No. 8284  
Date: 1/5/07

ADDITIONS OR DELETIONS TO THIS PLAT BY OTHER THAN THE SIGNING PARTY ARE PROHIBITED WITHOUT WRITTEN CONSENT BY THE SIGNING PARTY.

THIS SURVEY PLAT IS NOT VALID WITHOUT AN ORIGINAL SIGNATURE AND SEAL OF THE SIGNING PARTY.

Prepared By  
**HAYWOOD**  
Civil Engineering & Land Surveying, Inc.

475 N. Abbe Road  
Elyria, Ohio 44035  
www.haywoodcivilengineering.com  
(440) 365-9831 Office  
(440) 365-3460 Fax  
State of Ohio Certificate of Authorization No. 03-12

Prepared For  
Buckeye Storage Condominiums  
9298 Brooker Street, Suite 200  
Litchfield, Ohio 44253  
(330) 813-0044

